


Steps to help keep you safe

- **If you are working within 10 metres of our 33kV, 66kV, 132kV underground electricity cables or within 10 meters of an overhead electricity line you should call the relevant General Enquiries for free safety advice.**

Safety Documents – please download our informative safety documents to help ensure that you, your staff and the public are kept safe whilst working in the vicinity of electricity.

<https://www.nationalgrid.co.uk/customers-and-community/health-safety/public-safety-advice>

- **Make sure you have up to date plans** - remember that recent additions to our network or service connections between the main cable and a building or street lamp may not be shown.
- **Look for signs of service cables** - an electricity meter box or nearby streetlamp may give you an indication that service cables are present in your area of work.
- **Non NGED Network** - electricity cables, lines and equipment owned by others may also be present in addition to NGED network. They are unlikely to be shown on our plans.
- **Use a cable locator** - trace electricity cables and mark the position of them using paint or other waterproof marking on the ground.
- **Hand dig trial holes** - to confirm the position of cables in close proximity to your area of your work and use spades and shovels rather than picks, pins or forks.
- **Have an emergency plan** - so that everyone working on site understands what to do in the event of an underground electricity cable being damaged or contact being made with an overhead electricity line.
- **If you are working within 10 meters** of an overhead electricity line then it may be necessary for you to erect warning signs and markers, or height restriction goal posts. Ensure that you comply with the requirements of Health & Safety Executive guidance laid down in GS6, Avoidance of Danger from Overhead Electric Lines.
- **If you are erecting a structure** that could allow anyone standing on it, or its access device (ladder, scaffold, MEWP), to come within 3m of any overhead electric line then **you must inform us**. This is your duty and a legal requirement under the Electricity Safety, Quality & Continuity Regulations 2002.
- **If you cannot work safely** around the underground electricity cable or overhead electricity line, then you may need to get it moved to allow your works to go ahead. Call the general enquiry numbers above for guidance.
- **It is possible that cables or pipes may be embedded in concrete** - electricity cables embedded in concrete **MUST** be made 'dead' by Western Power Distribution or the cable owner before the concrete is broken out. Alternatively, another safe way of working should be agreed.
- **Cables are sometimes covered by tiles or a marker tape** - these can be concrete, polythene or earthenware and are a useful early warning of the presence of cables; you should avoid disturbing any tiles or tape to expose the cable. Not all cables have these warning indicators.

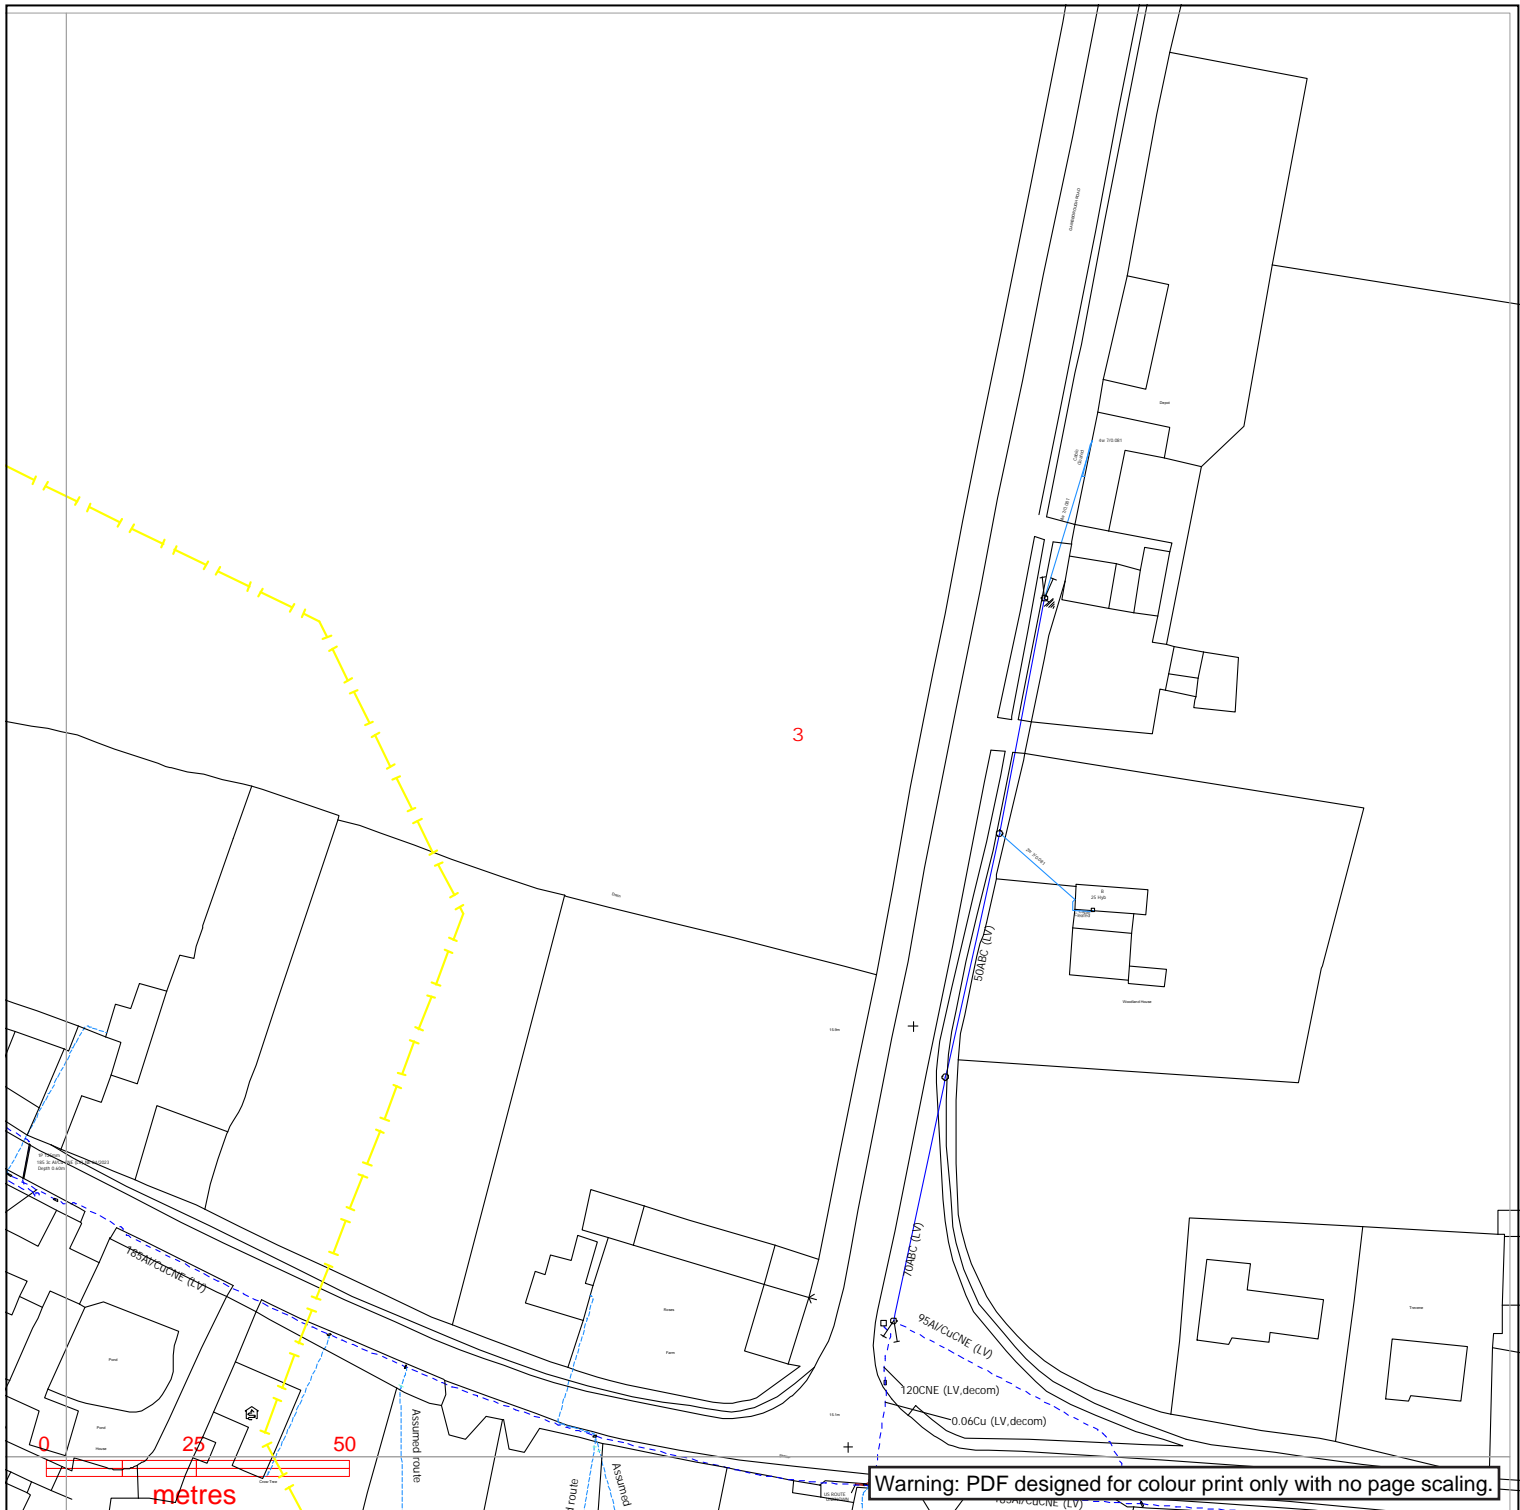

Warning: PDF designed for colour print only with no page scaling.



Contact Us

Mapping Enquiries:
All areas 0121 623 9780

General Enquiries:
All areas 0800 096 3080

Date Requested: 08/05/2023
Job Reference: 29406941
Site Location: 479024 384047
Requested by:
Mr Ben Evans
Your Scheme/Reference:
LM 203570/DK - 6

Exact Scales:
1:1250 Area or Circle dig site
1:500 Line dig site


Link Box	Overhead Line	Underground Cable	National Grid Telecoms	Pilot Cables
●	○ PL ○ Service ○ LV ○ HV (11kV) ○ HV (33kV) ○ HV (66kV) ○ HV (132kV)	---	--- PME Earth --- Underground Earth	○ Pole Mounted Transformer □ Ground Mounted Transformer
Site Location Line/Area	--- Assumed route			

IMPORTANT NOTICES

- This information is given as a guide only and its accuracy cannot be guaranteed. Services or recent additions to the network may not be shown.
- Cables, overhead lines & substations owned by other electricity network owners or private companies may be present and may not be shown.
- You should always verify exact locations of cables using a cable locator and by careful use of hand tools in accordance with HSE guidance note HSG47.
- When working within 10m of any overhead electric line you should follow the requirements of HSE Guidance Note GS6.
- For further advice on working near our electricity cables or lines, call our General Enquiries number.
- Advice should be sought from the National Grid Electricity Distribution General Enquiries team for any work that is to take place in proximity to 132kV underground cables and 132kV overhead lines.

Report damage immediately – KEEP EVERYONE AWAY FROM THE AREA
0800 6783 105

Crown Copyright © All Rights Reserved. Ordnance Survey Licence numbers: 100022432
NGED Copyright: This copy has been made by or with the authority of National Grid Electricity Distribution (NGED) pursuant to Section 47 of the Copyright Designs and Patents Act 1988 unless that Act provides a relevant exception to copyright the copy must not be copied without the prior permission of the copyright owner.

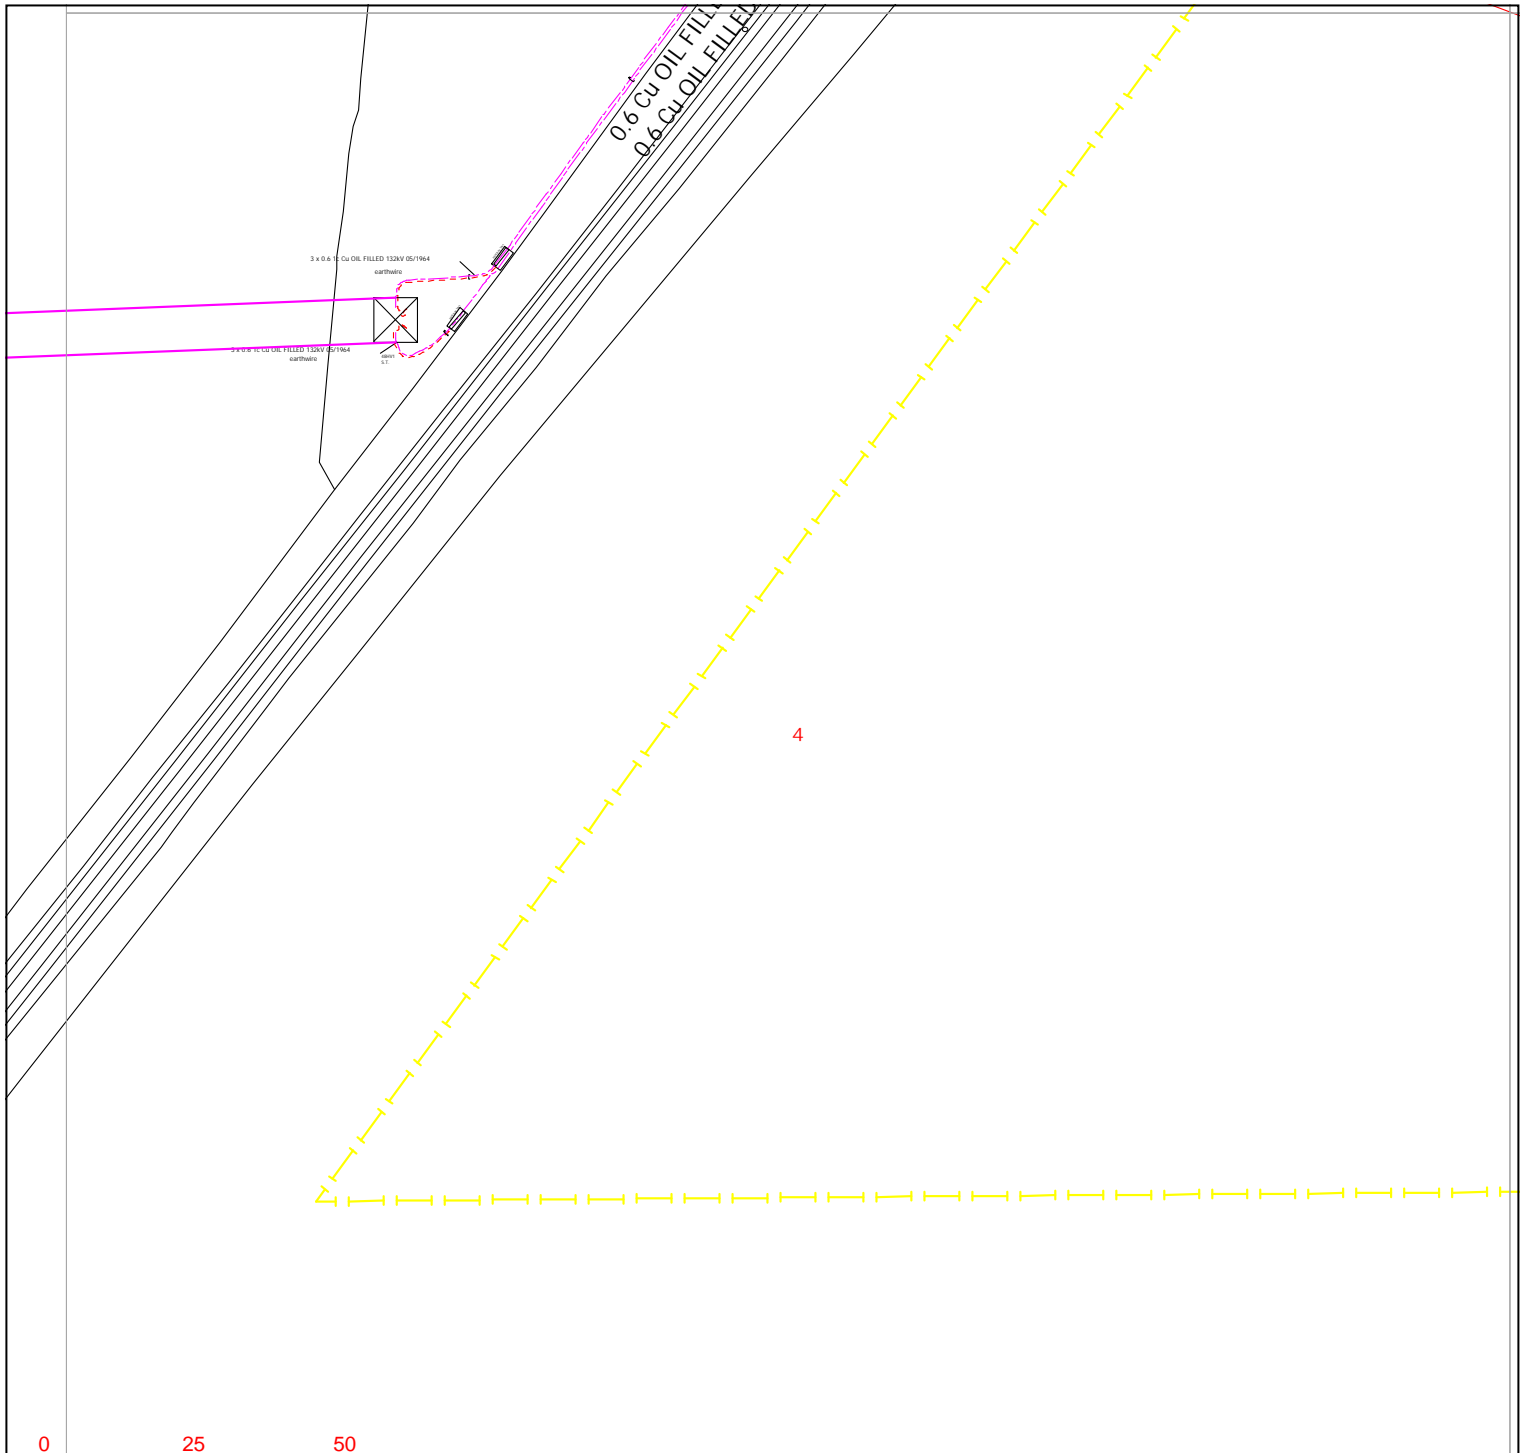

Warning: PDF designed for colour print only with no page scaling.

nationalgrid Electricity Distribution

Contact Us

Mapping Enquiries:
All areas 0121 623 9780

General Enquiries:
All areas 0800 096 3080

Date Requested: 08/05/2023
Job Reference: 29406941
Site Location: 479024 384047
Requested by:
Mr Ben Evans
Your Scheme/Reference:
LM 203570/DK - 6

Exact Scales:
1:1250 Area or Circle dig site
1:500 Line dig site


Link Box	Overhead Line	Underground Cable	National Grid Telecoms	Pilot Cables
●	<ul style="list-style-type: none"> ○ PL ○ Service ○ LV ○ HV (11kV) ○ HV (33kV) ○ HV (66kV) ○ HV (132kV) 	<ul style="list-style-type: none"> --- --- --- --- --- --- --- 	<ul style="list-style-type: none"> --- PME Earth ---E Underground Earth 	<ul style="list-style-type: none"> ○ Pole Mounted Transformer □ Ground Mounted Transformer
Site Location Line/Area	<ul style="list-style-type: none"> --- Site Location --- Line/Area 			

IMPORTANT NOTICES

- This information is given as a guide only and its accuracy cannot be guaranteed. Services or recent additions to the network may not be shown.
- Cables, overhead lines & substations owned by other electricity network owners or private companies may be present and may not be shown.
- You should always verify exact locations of cables using a cable locator and by careful use of hand tools in accordance with HSE guidance note HSG47.
- When working within 10m of any overhead electric line you should follow the requirements of HSE Guidance Note GS6.
- For further advice on working near our electricity cables or lines, call our General Enquiries number.
- Advice should be sought from the National Grid Electricity Distribution General Enquiries team for any work that is to take place in proximity to 132kV underground cables and 132kV overhead lines.

Report damage immediately – KEEP EVERYONE AWAY FROM THE AREA
0800 6783 105

Crown Copyright © All Rights Reserved. Ordnance Survey Licence numbers: 100022432
NGED Copyright: This copy has been made by or with the authority of National Grid Electricity Distribution (NGED) pursuant to Section 47 of the Copyright Designs and Patents Act 1988 unless that Act provides a relevant exception to copyright the copy must not be copied without the prior permission of the copyright owner.

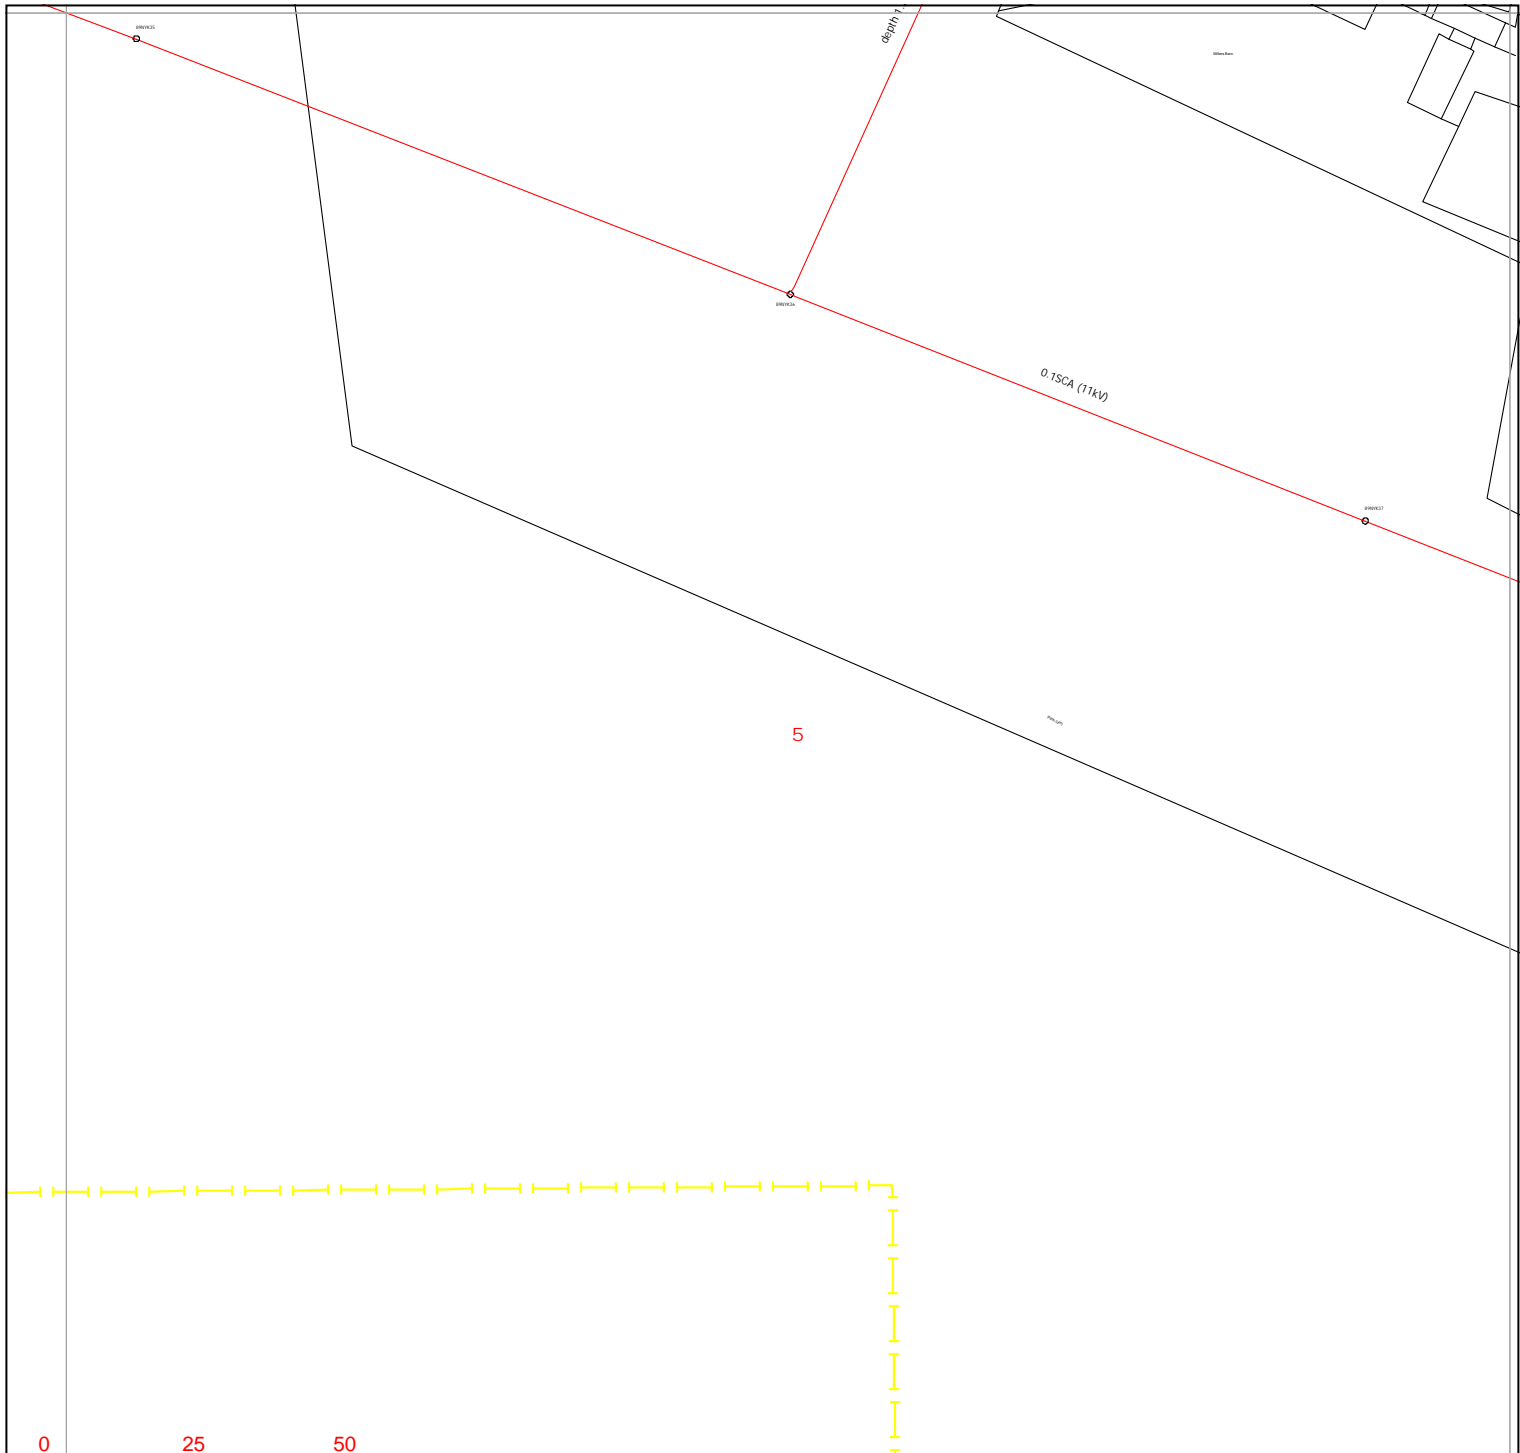

Warning: PDF designed for colour print only with no page scaling.



Contact Us
Mapping Enquiries:
 All areas 0121 623 9780
General Enquiries:
 All areas 0800 096 3080

Date Requested: 08/05/2023
 Job Reference: 29406941
 Site Location: 479024 384047
 Requested by:
 Mr Ben Evans
 Your Scheme/Reference:
 LM 203570/DK - 6

Exact Scales:
 1:1250 Area or Circle dig site
 1:500 Line dig site


Link Box	Overhead Line	Underground Cable	National Grid Telecoms	Pilot Cables
●				
Site Location Line/Area 				

IMPORTANT NOTICES

- This information is given as a guide only and its accuracy cannot be guaranteed. Services or recent additions to the network may not be shown.
- Cables, overhead lines & substations owned by other electricity network owners or private companies may be present and may not be shown.
- You should always verify exact locations of cables using a cable locator and by careful use of hand tools in accordance with HSE guidance note HSG47.
- When working within 10m of any overhead electric line you should follow the requirements of HSE Guidance Note GS6.
- For further advice on working near our electricity cables or lines, call our General Enquiries number.
- Advice should be sought from the National Grid Electricity Distribution General Enquiries team for any work that is to take place in proximity to 132kV underground cables and 132kV overhead lines.

Report damage immediately – KEEP EVERYONE AWAY FROM THE AREA
0800 6783 105

Crown Copyright © All Rights Reserved. Ordnance Survey Licence numbers: 100022432
 NGED Copyright: This copy has been made by or with the authority of National Grid Electricity Distribution (NGED) pursuant to Section 47 of the Copyright Designs and Patents Act 1988 unless that Act provides a relevant exception to copyright the copy must not be copied without the prior permission of the copyright owner.

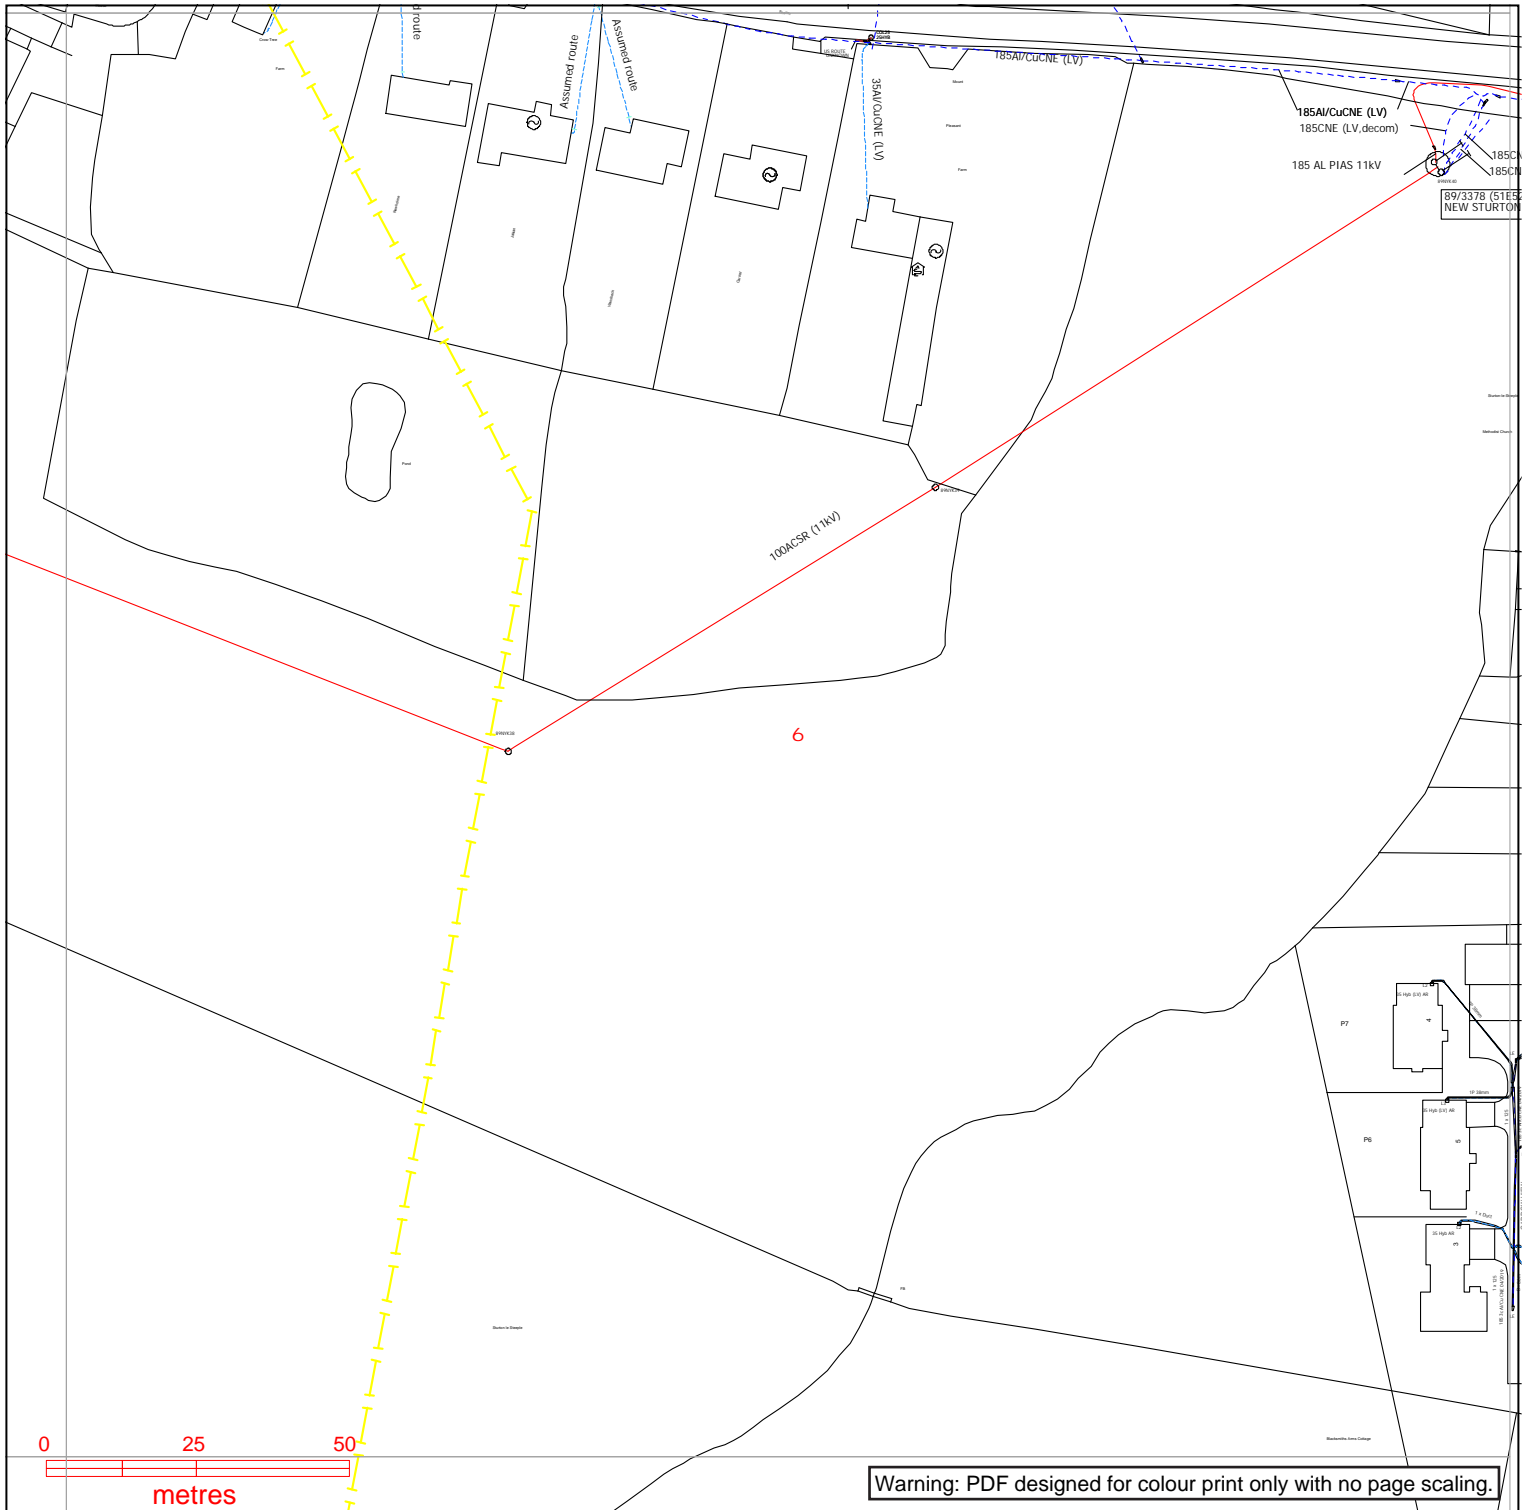

Warning: PDF designed for colour print only with no page scaling.

nationalgrid Electricity Distribution

Contact Us

Mapping Enquiries:
All areas 0121 623 9780

General Enquiries:
All areas 0800 096 3080

Date Requested: 08/05/2023
Job Reference: 29406941
Site Location: 479024 384047
Requested by:
Mr Ben Evans
Your Scheme/Reference:
LM 203570/DK - 6

Exact Scales:
1:1250 Area or Circle dig site
1:500 Line dig site


Link Box	Overhead Line	Underground Cable	National Grid Telecoms	Pilot Cables
●	○ PL ○ Service ○ LV ○ HV (11kV) ○ HV (33kV) ○ HV (66kV) ○ HV (132kV)	---	---	---
■	■	---	---	---
○	○	---	---	○
□	□	---	---	□
			⏏ PME Earth	
			⏏ Underground Earth	


IMPORTANT NOTICES





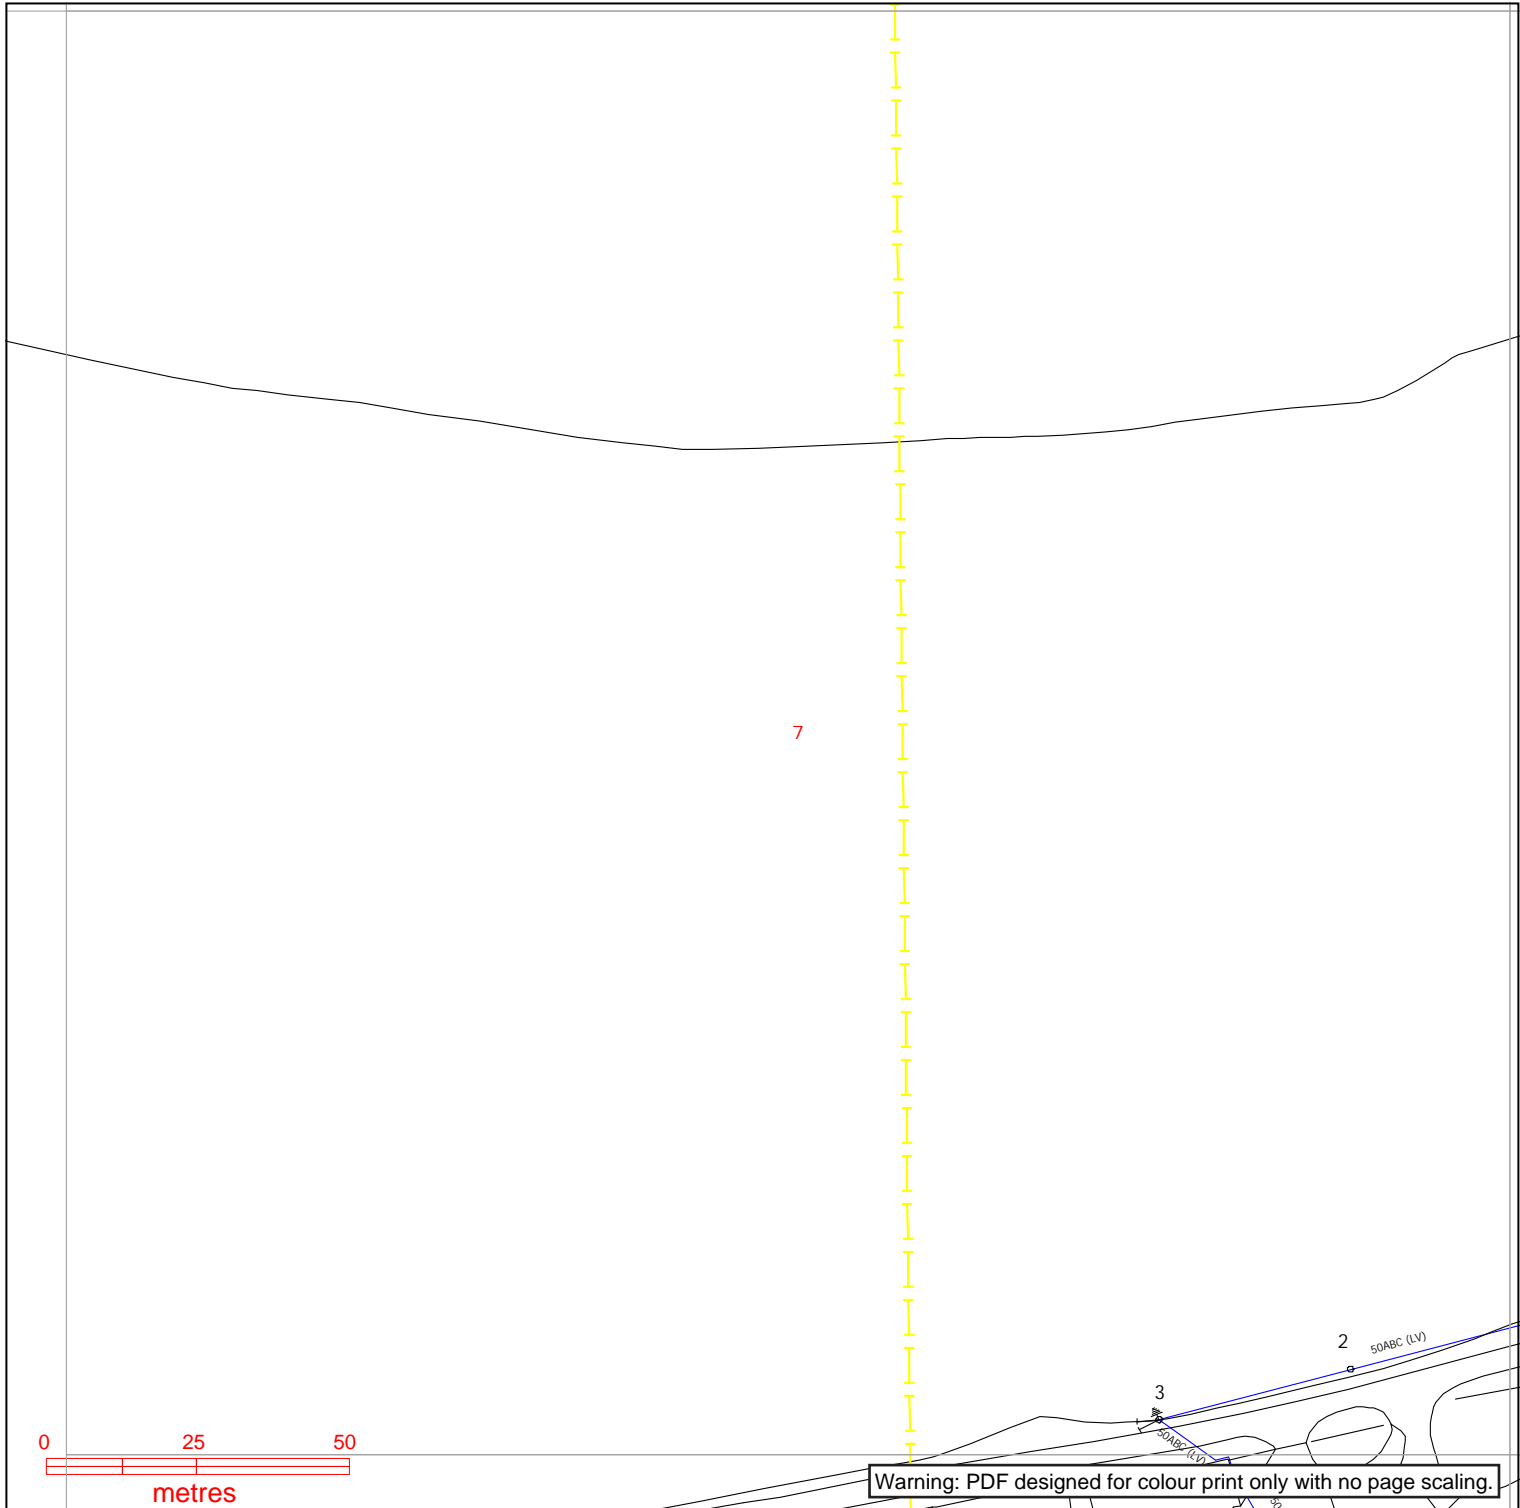


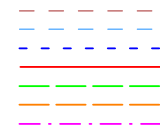





 

- This information is given as a guide only and its accuracy cannot be guaranteed. Services or recent additions to the network may not be shown.
- Cables, overhead lines & substations owned by other electricity network owners or private companies may be present and may not be shown.
- You should always verify exact locations of cables using a cable locator and by careful use of hand tools in accordance with HSE guidance note HSG47.
- When working within 10m of any overhead electric line you should follow the requirements of HSE Guidance Note GS6.
- For further advice on working near our electricity cables or lines, call our General Enquiries number.
- Advice should be sought from the National Grid Electricity Distribution General Enquiries team for any work that is to take place in proximity to 132kV underground cables and 132kV overhead lines.

Report damage immediately – KEEP EVERYONE AWAY FROM THE AREA
0800 6783 105

Crown Copyright © All Rights Reserved. Ordnance Survey Licence numbers: 100022432
NGED Copyright: This copy has been made by or with the authority of National Grid Electricity Distribution (NGED) pursuant to Section 47 of the Copyright Designs and Patents Act 1988 unless that Act provides a relevant exception to copyright the copy must not be copied without the prior permission of the copyright owner.




Contact Us
 Mapping Enquiries:
 All areas 0121 623 9780
 General Enquiries:
 All areas 0800 096 3080
 Date Requested: 08/05/2023
 Job Reference: 29406941
 Site Location: 479024 384047
 Requested by:
 Mr Ben Evans
 Your Scheme/Reference:
 LM 203570/DK - 6
 Exact Scales:
 1:1250 Area or Circle dig site
 1:500 Line dig site


Link Box	Overhead Line	Underground Cable	National Grid Telecoms	Pilot Cables
●	 PL  Service  LV  HV (11kV)  HV (33kV)  HV (66kV)  HV (132kV)		 PME Earth  Underground Earth	 Pole Mounted Transformer  Ground Mounted Transformer
 Site Location  Line/Area				

IMPORTANT NOTICES

- This information is given as a guide only and its accuracy cannot be guaranteed. Services or recent additions to the network may not be shown.
- Cables, overhead lines & substations owned by other electricity network owners or private companies may be present and may not be shown.
- You should always verify exact locations of cables using a cable locator and by careful use of hand tools in accordance with HSE guidance note HSG47.
- When working within 10m of any overhead electric line you should follow the requirements of HSE Guidance Note GS6.
- For further advice on working near our electricity cables or lines, call our General Enquiries number.
- Advice should be sought from the National Grid Electricity Distribution General Enquiries team for any work that is to take place in proximity to 132kV underground cables and 132kV overhead lines.

Report damage immediately – KEEP EVERYONE AWAY FROM THE AREA
0800 6783 105

Crown Copyright © All Rights Reserved. Ordnance Survey Licence numbers: 100022432
 NGED Copyright: This copy has been made by or with the authority of National Grid Electricity Distribution (NGED) pursuant to Section 47 of the Copyright Designs and Patents Act 1988 unless that Act provides a relevant exception to copyright the copy must not be copied without the prior permission of the copyright owner.

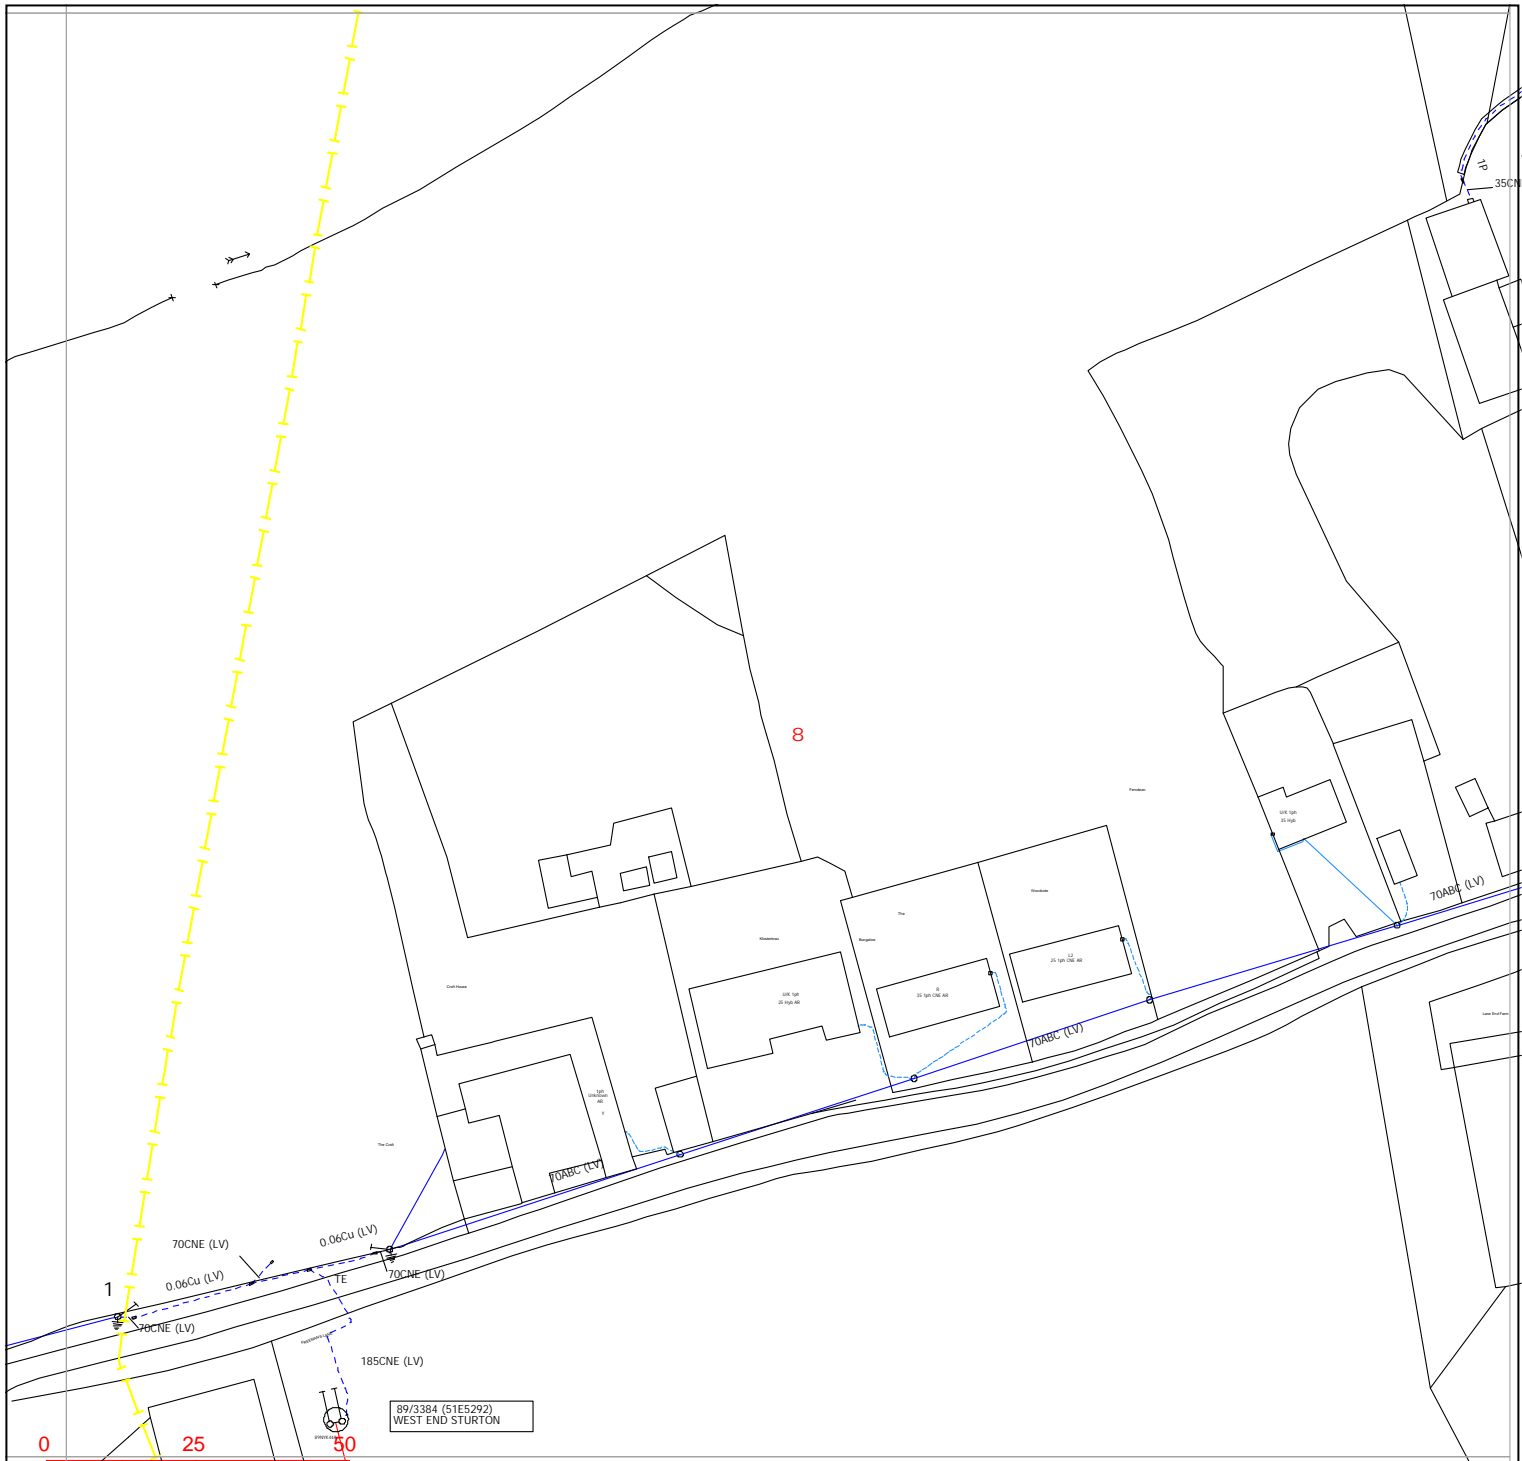

	<table border="0"> <tr> <td data-bbox="368 1556 566 1630"> Link Box ● </td> <td data-bbox="571 1556 805 1630"> Overhead Line ○—○ PL ○—○ Service ○—○ LV ○—○ HV (11kV) ○—○ HV (33kV) ○—○ HV (66kV) ○—○ HV (132kV) </td> <td data-bbox="810 1556 1045 1630"> Underground Cable --- PL --- Service --- LV --- HV (11kV) --- HV (33kV) --- HV (66kV) --- HV (132kV) </td> <td data-bbox="1050 1556 1284 1630"> National Grid Telecoms --- PME Earth ---E Underground Earth </td> <td data-bbox="1289 1556 1562 1630"> Pilot Cables ○ Pole Mounted Transformer □ Ground Mounted Transformer </td> </tr>
Contact Us Mapping Enquiries: All areas 0121 623 9780	IMPORTANT NOTICES <ul style="list-style-type: none"> This information is given as a guide only and its accuracy cannot be guaranteed. Services or recent additions to the network may not be shown. Cables, overhead lines & substations owned by other electricity network owners or private companies may be present and may not be shown. You should always verify exact locations of cables using a cable locator and by careful use of hand tools in accordance with HSE guidance note HSG47. When working within 10m of any overhead electric line you should follow the requirements of HSE Guidance Note GS6. For further advice on working near our electricity cables or lines, call our General Enquiries number. Advice should be sought from the National Grid Electricity Distribution General Enquiries team for any work that is to take place in proximity to 132kV underground cables and 132kV overhead lines. 									
General Enquiries: All areas 0800 096 3080	<p style="text-align: center;">Report damage immediately – KEEP EVERYONE AWAY FROM THE AREA 0800 6783 105</p>									
Date Requested: 08/05/2023 Job Reference: 29406941 Site Location: 479024 384047 Requested by: Mr Ben Evans Your Scheme/Reference: LM 203570/DK - 6	Crown Copyright © All Rights Reserved. Ordnance Survey Licence numbers: 100022432 NGED Copyright: This copy has been made by or with the authority of National Grid Electricity Distribution (NGED) pursuant to Section 47 of the Copyright Designs and Patents Act 1988 unless that Act provides a relevant exception to copyright the copy must not be copied without the prior permission of the copyright owner.									



Contact Us
 All areas 0121 623 9780

Mapping Enquiries:
 All areas 0121 623 9780

General Enquiries:
 All areas 0800 096 3080

Date Requested: 08/05/2023
 Job Reference: 29406941
 Site Location: 479024 384047
 Requested by:
 Mr Ben Evans
 Your Scheme/Reference:
 LM 203570/DK - 6

Exact Scales:
 1:1250 Area or Circle dig site
 1:500 Line dig site


Link Box	Overhead Line	Underground Cable	National Grid Telecoms	Pilot Cables
●	○ PL ○ Service ○ LV ○ HV (11kV) ○ HV (33kV) ○ HV (66kV) ○ HV (132kV)	--- --- --- --- ---	--- --- ---	--- --- ---
Site Location Line/Area 			PME Earth Underground Earth	Pole Mounted Transformer Ground Mounted Transformer

IMPORTANT NOTICES

- This information is given as a guide only and its accuracy cannot be guaranteed. Services or recent additions to the network may not be shown.
- Cables, overhead lines & substations owned by other electricity network owners or private companies may be present and may not be shown.
- You should always verify exact locations of cables using a cable locator and by careful use of hand tools in accordance with HSE guidance note HSG47.
- When working within 10m of any overhead electric line you should follow the requirements of HSE Guidance Note GS6.
- For further advice on working near our electricity cables or lines, call our General Enquiries number.
- Advice should be sought from the National Grid Electricity Distribution General Enquiries team for any work that is to take place in proximity to 132kV underground cables and 132kV overhead lines.

Report damage immediately – KEEP EVERYONE AWAY FROM THE AREA
0800 6783 105

Crown Copyright © All Rights Reserved. Ordnance Survey Licence numbers: 100022432
 NGED Copyright: This copy has been made by or with the authority of National Grid Electricity Distribution (NGED) pursuant to Section 47 of the Copyright Designs and Patents Act 1988 unless that Act provides a relevant exception to copyright the copy must not be copied without the prior permission of the copyright owner.

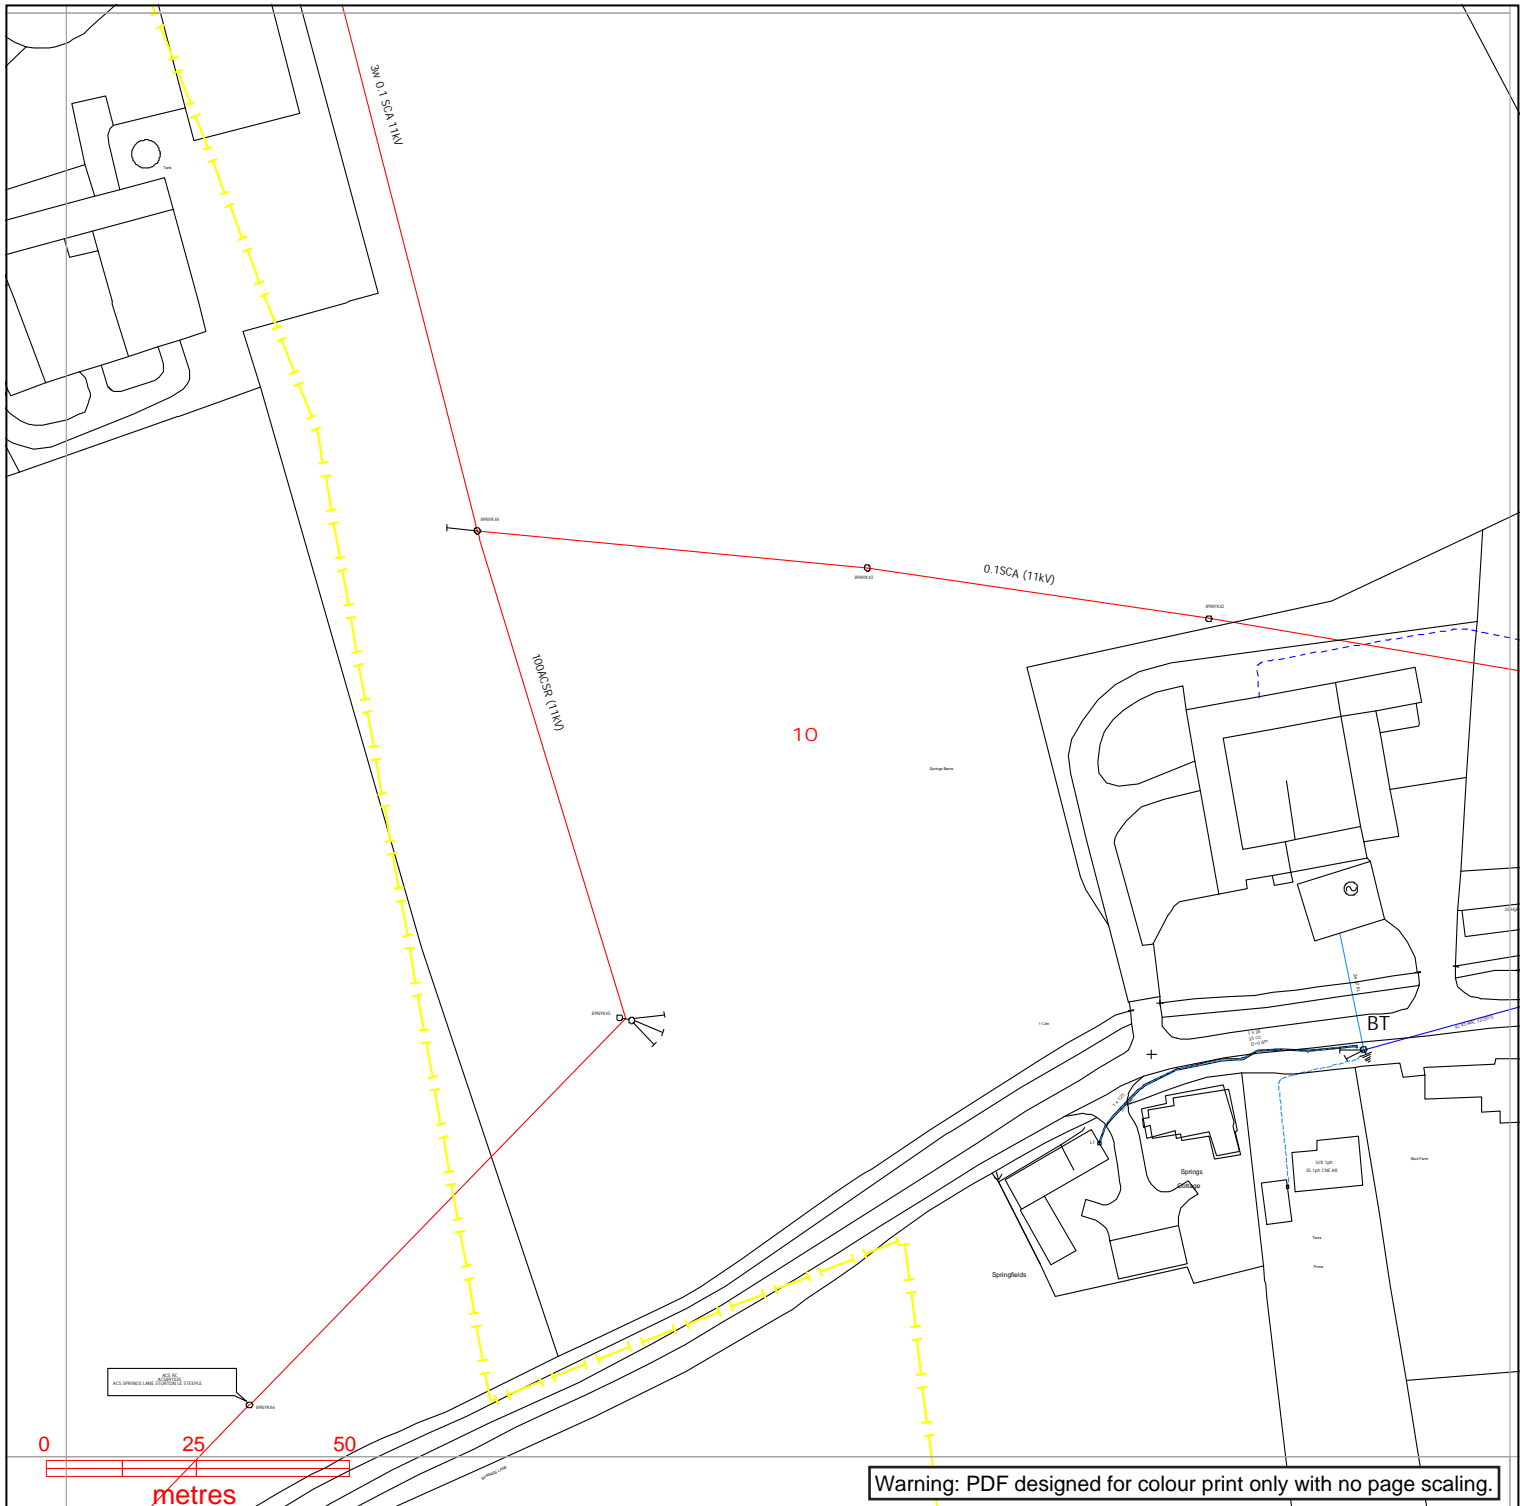

nationalgrid Electricity Distribution

Contact Us

Mapping Enquiries:
All areas 0121 623 9780

General Enquiries:
All areas 0800 096 3080

Date Requested: 08/05/2023
Job Reference: 29406941
Site Location: 479024 384047
Requested by:
Mr Ben Evans
Your Scheme/Reference:
LM 203570/DK - 6

Exact Scales:
1:1250 Area or Circle dig site
1:500 Line dig site


Link Box	Overhead Line	Underground Cable	National Grid Telecoms	Pilot Cables
●	○ PL ○ Service ○ LV ○ HV (11kV) ○ HV (33kV) ○ HV (66kV) ○ HV (132kV)	---	--- PME Earth ---E Underground Earth	○ Pole Mounted Transformer □ Ground Mounted Transformer
Site Location Line/Area	--- (Yellow dashed line)	---		

IMPORTANT NOTICES

- This information is given as a guide only and its accuracy cannot be guaranteed. Services or recent additions to the network may not be shown.
- Cables, overhead lines & substations owned by other electricity network owners or private companies may be present and may not be shown.
- You should always verify exact locations of cables using a cable locator and by careful use of hand tools in accordance with HSE guidance note HSG47.
- When working within 10m of any overhead electric line you should follow the requirements of HSE Guidance Note GS6.
- For further advice on working near our electricity cables or lines, call our General Enquiries number.
- Advice should be sought from the National Grid Electricity Distribution General Enquiries team for any work that is to take place in proximity to 132kV underground cables and 132kV overhead lines.

Report damage immediately – KEEP EVERYONE AWAY FROM THE AREA
0800 6783 105

Crown Copyright © All Rights Reserved. Ordnance Survey Licence numbers: 100022432
NGED Copyright: This copy has been made by or with the authority of National Grid Electricity Distribution (NGED) pursuant to Section 47 of the Copyright Designs and Patents Act 1988 unless that Act provides a relevant exception to copyright the copy must not be copied without the prior permission of the copyright owner.

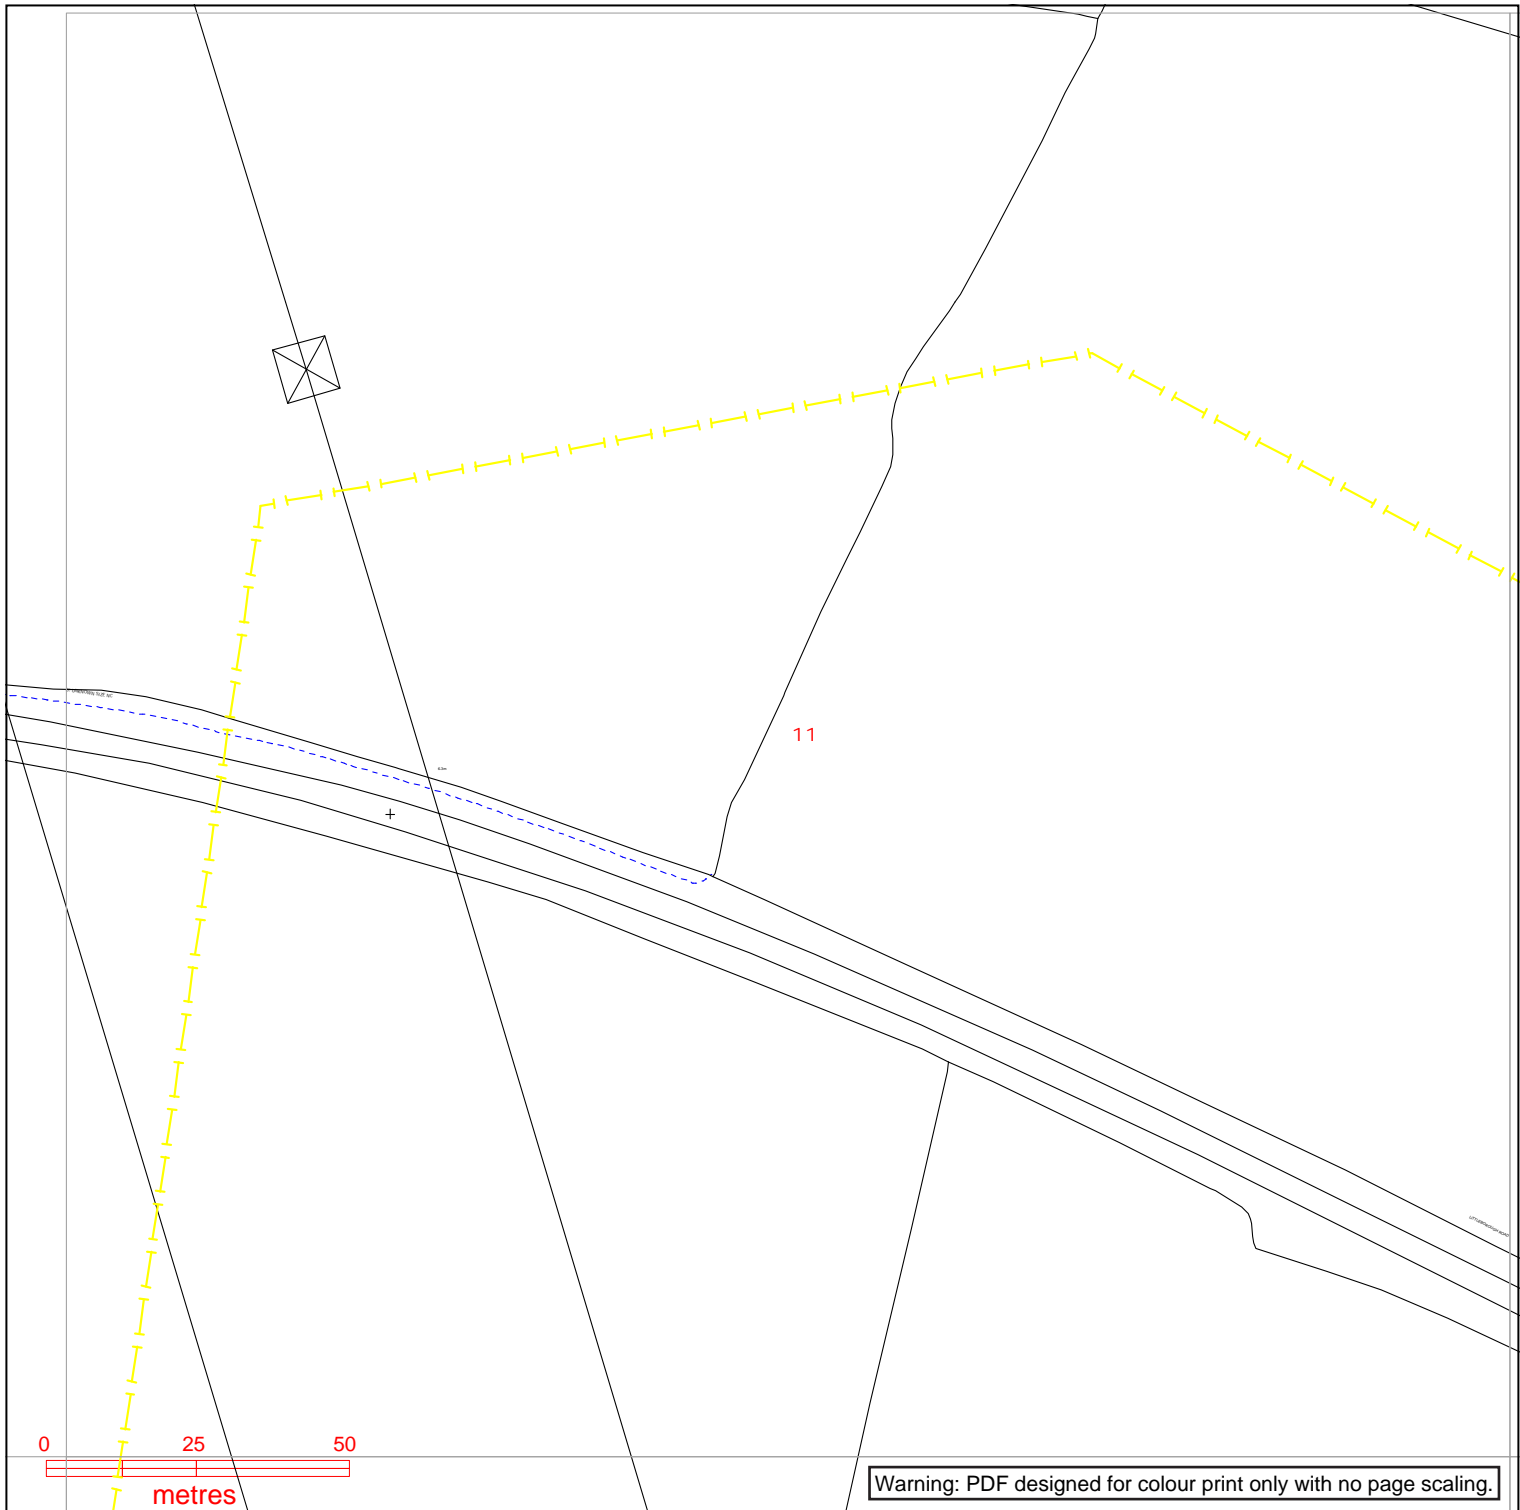

Warning: PDF designed for colour print only with no page scaling.

nationalgrid Electricity Distribution

Contact Us

Mapping Enquiries:
All areas 0121 623 9780

General Enquiries:
All areas 0800 096 3080

Date Requested: 08/05/2023
Job Reference: 29406941
Site Location: 479024 384047
Requested by:
Mr Ben Evans
Your Scheme/Reference:
LM 203570/DK - 6

Exact Scales:
1:1250 Area or Circle dig site
1:500 Line dig site


Link Box	Overhead Line	Underground Cable	National Grid Telecoms	Pilot Cables
●	○ PL ○ Service ○ LV ○ HV (11kV) ○ HV (33kV) ○ HV (66kV) ○ HV (132kV)	---	--- PME Earth ---E Underground Earth	○ Pole Mounted Transformer □ Ground Mounted Transformer
Site Location Line/Area	--- (various colors)	---		

IMPORTANT NOTICES

- This information is given as a guide only and its accuracy cannot be guaranteed. Services or recent additions to the network may not be shown.
- Cables, overhead lines & substations owned by other electricity network owners or private companies may be present and may not be shown.
- You should always verify exact locations of cables using a cable locator and by careful use of hand tools in accordance with HSE guidance note HSG47.
- When working within 10m of any overhead electric line you should follow the requirements of HSE Guidance Note GS6.
- For further advice on working near our electricity cables or lines, call our General Enquiries number.
- Advice should be sought from the National Grid Electricity Distribution General Enquiries team for any work that is to take place in proximity to 132kV underground cables and 132kV overhead lines.

Report damage immediately – KEEP EVERYONE AWAY FROM THE AREA
0800 6783 105

Crown Copyright © All Rights Reserved. Ordnance Survey Licence numbers: 100022432
NGED Copyright: This copy has been made by or with the authority of National Grid Electricity Distribution (NGED) pursuant to Section 47 of the Copyright Designs and Patents Act 1988 unless that Act provides a relevant exception to copyright the copy must not be copied without the prior permission of the copyright owner.

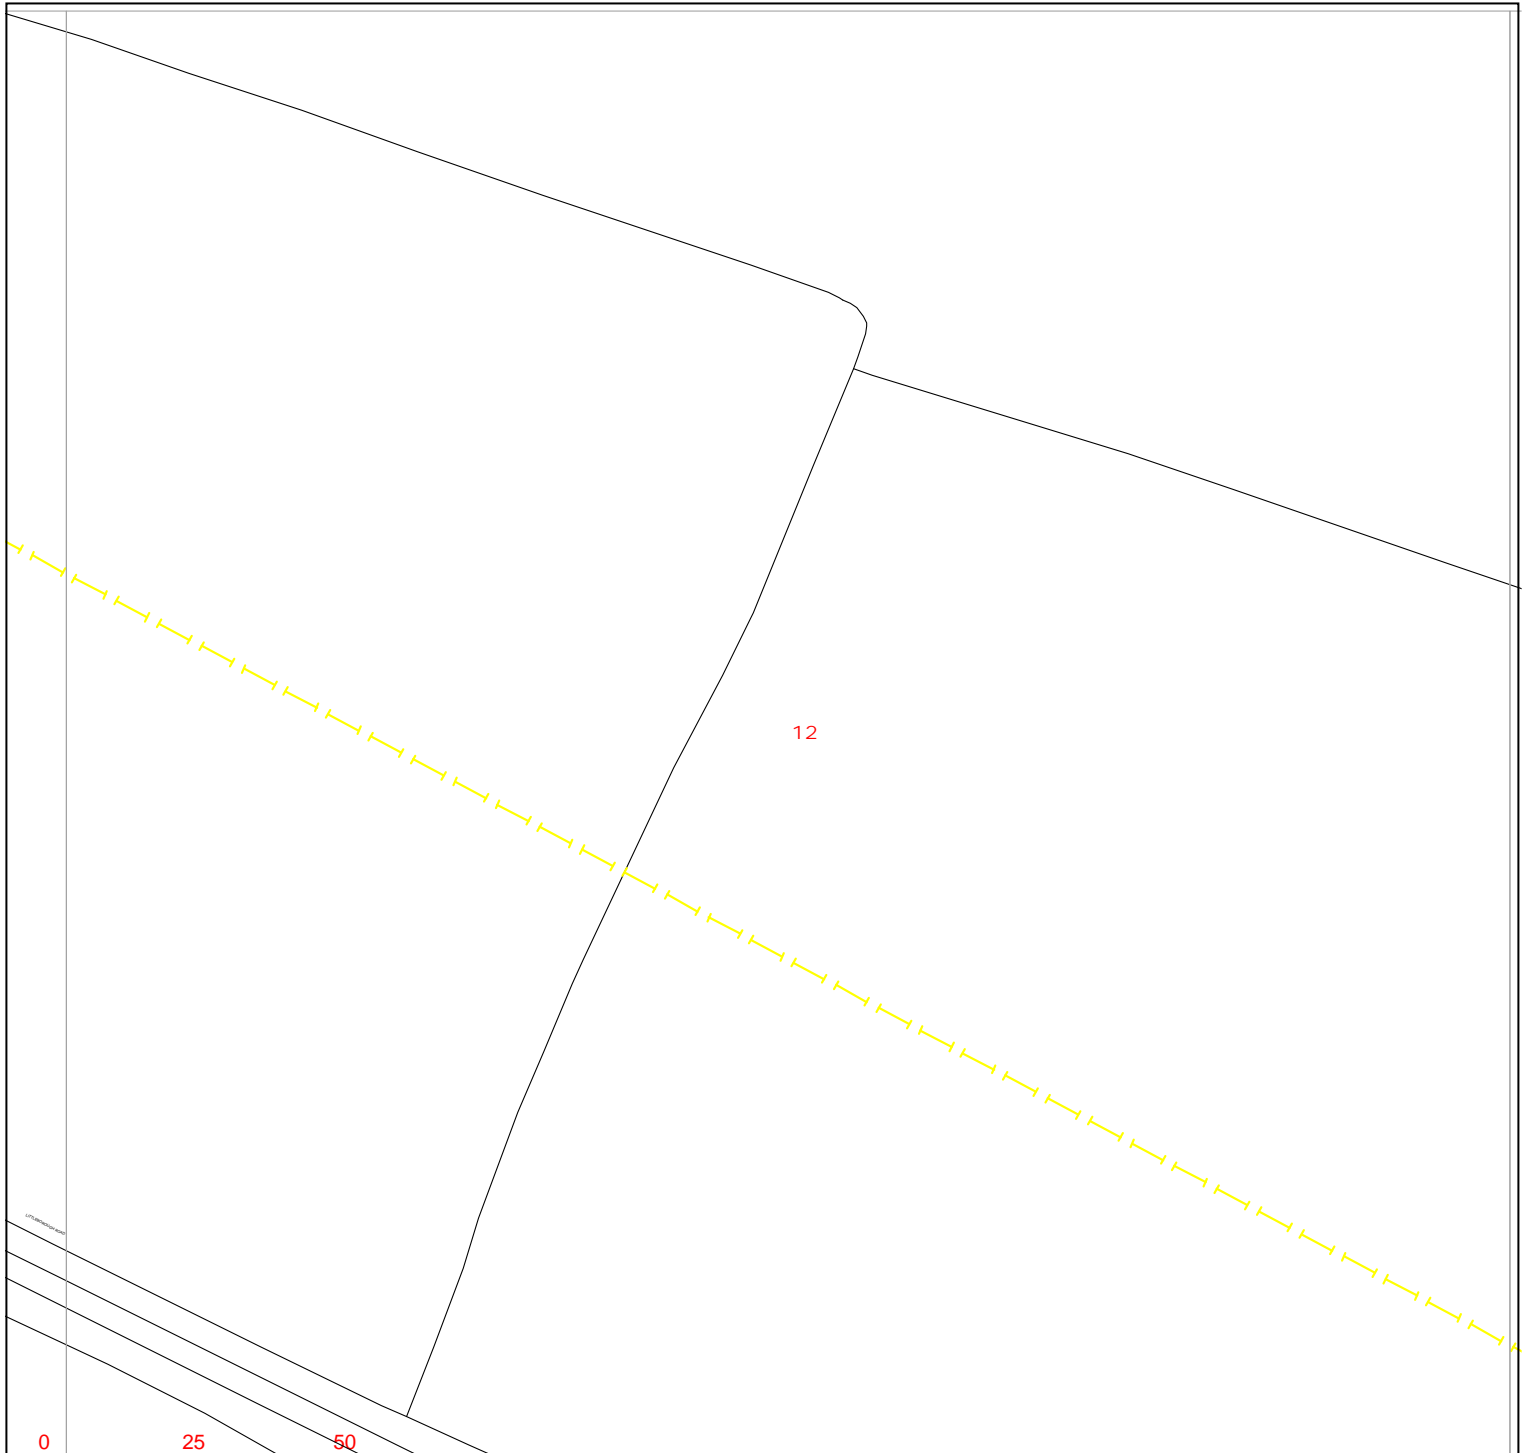

Warning: PDF designed for colour print only with no page scaling.

nationalgrid Electricity Distribution

Contact Us

Mapping Enquiries:
All areas 0121 623 9780

General Enquiries:
All areas 0800 096 3080

Date Requested: 08/05/2023
Job Reference: 29406941
Site Location: 479024 384047
Requested by:
Mr Ben Evans
Your Scheme/Reference:
LM 203570/DK - 6

Exact Scales:
1:1250 Area or Circle dig site
1:500 Line dig site


Link Box ●	Overhead Line ○ ○ PL ○ ○ Service ○ ○ LV ○ ○ HV (11kV) ○ ○ HV (33kV) ○ ○ HV (66kV) ○ ○ HV (132kV)	Underground Cable -	National Grid Telecoms - - - - - PME Earth -E- - - - - Underground Earth	Pilot Cables - - - - - ○ Pole Mounted Transformer □ Ground Mounted Transformer
----------------------	--	---	---	--

IMPORTANT NOTICES

- This information is given as a guide only and its accuracy cannot be guaranteed. Services or recent additions to the network may not be shown.
- Cables, overhead lines & substations owned by other electricity network owners or private companies may be present and may not be shown.
- You should always verify exact locations of cables using a cable locator and by careful use of hand tools in accordance with HSE guidance note HSG47.
- When working within 10m of any overhead electric line you should follow the requirements of HSE Guidance Note GS6.
- For further advice on working near our electricity cables or lines, call our General Enquiries number.
- Advice should be sought from the National Grid Electricity Distribution General Enquiries team for any work that is to take place in proximity to 132kV underground cables and 132kV overhead lines.

Report damage immediately – KEEP EVERYONE AWAY FROM THE AREA
0800 6783 105

Crown Copyright © All Rights Reserved. Ordnance Survey Licence numbers: 100022432
NGED Copyright: This copy has been made by or with the authority of National Grid Electricity Distribution (NGED) pursuant to Section 47 of the Copyright Designs and Patents Act 1988 unless that Act provides a relevant exception to copyright the copy must not be copied without the prior permission of the copyright owner.

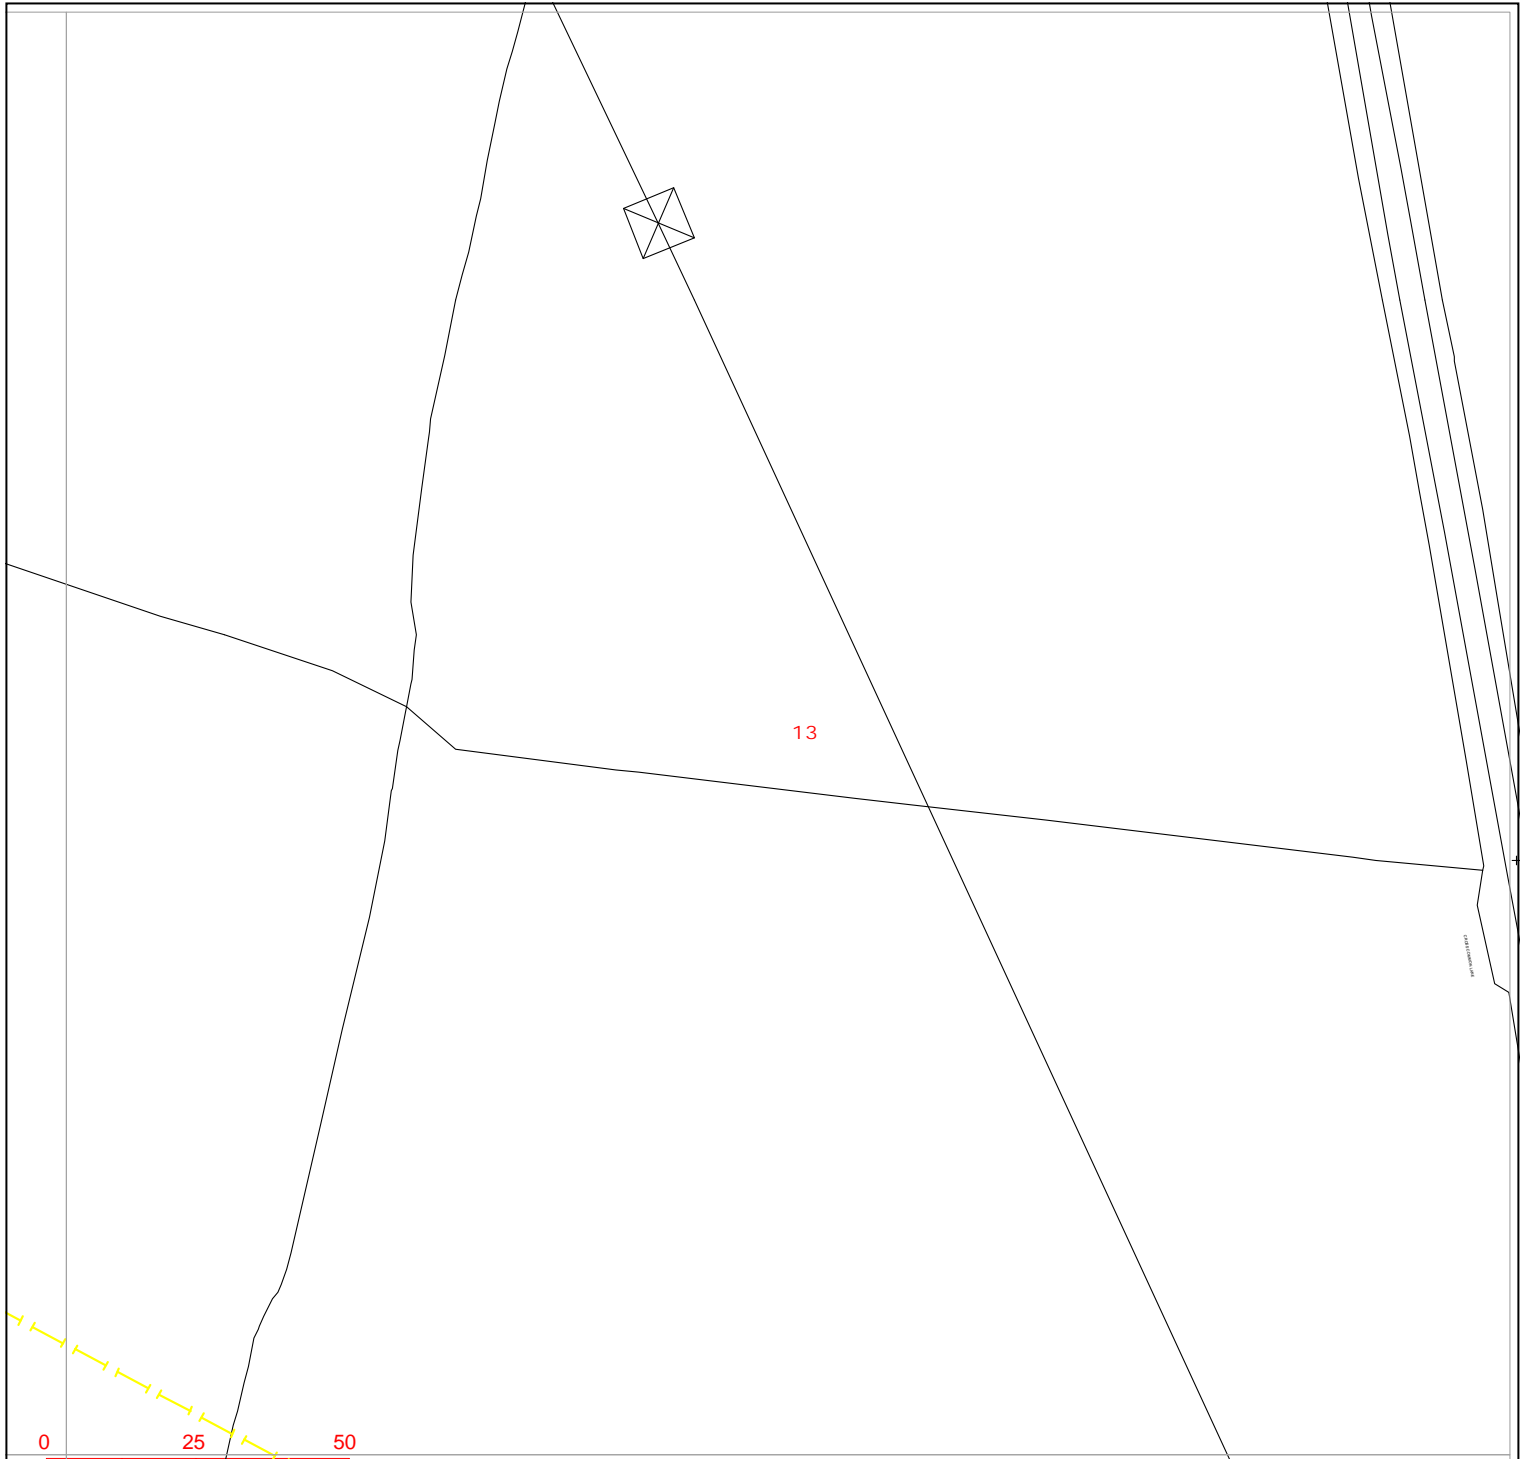

Warning: PDF designed for colour print only with no page scaling.

nationalgrid Electricity Distribution

Contact Us

Mapping Enquiries:
All areas 0121 623 9780

General Enquiries:
All areas 0800 096 3080

Date Requested: 08/05/2023
Job Reference: 29406941
Site Location: 479024 384047
Requested by:
Mr Ben Evans
Your Scheme/Reference:
LM 203570/DK - 6

Exact Scales:
1:1250 Area or Circle dig site
1:500 Line dig site


Link Box ●	Overhead Line ○—○ PL ○—○ Service ○—○ LV ○—○ HV (11kV) ○—○ HV (33kV) ○—○ HV (66kV) ○—○ HV (132kV)	Underground Cable -	National Grid Telecoms - - - - - PME Earth -E- - - - - Underground Earth	Pilot Cables ○ Pole Mounted Transformer □ Ground Mounted Transformer
----------------------	--	---	---	---

IMPORTANT NOTICES

- This information is given as a guide only and its accuracy cannot be guaranteed. Services or recent additions to the network may not be shown.
- Cables, overhead lines & substations owned by other electricity network owners or private companies may be present and may not be shown.
- You should always verify exact locations of cables using a cable locator and by careful use of hand tools in accordance with HSE guidance note HSG47.
- When working within 10m of any overhead electric line you should follow the requirements of HSE Guidance Note GS6.
- For further advice on working near our electricity cables or lines, call our General Enquiries number.
- Advice should be sought from the National Grid Electricity Distribution General Enquiries team for any work that is to take place in proximity to 132kV underground cables and 132kV overhead lines.

Report damage immediately – KEEP EVERYONE AWAY FROM THE AREA
0800 6783 105

Crown Copyright © All Rights Reserved. Ordnance Survey Licence numbers: 100022432
NGED Copyright: This copy has been made by or with the authority of National Grid Electricity Distribution (NGED) pursuant to Section 47 of the Copyright Designs and Patents Act 1988 unless that Act provides a relevant exception to copyright the copy must not be copied without the prior permission of the copyright owner.

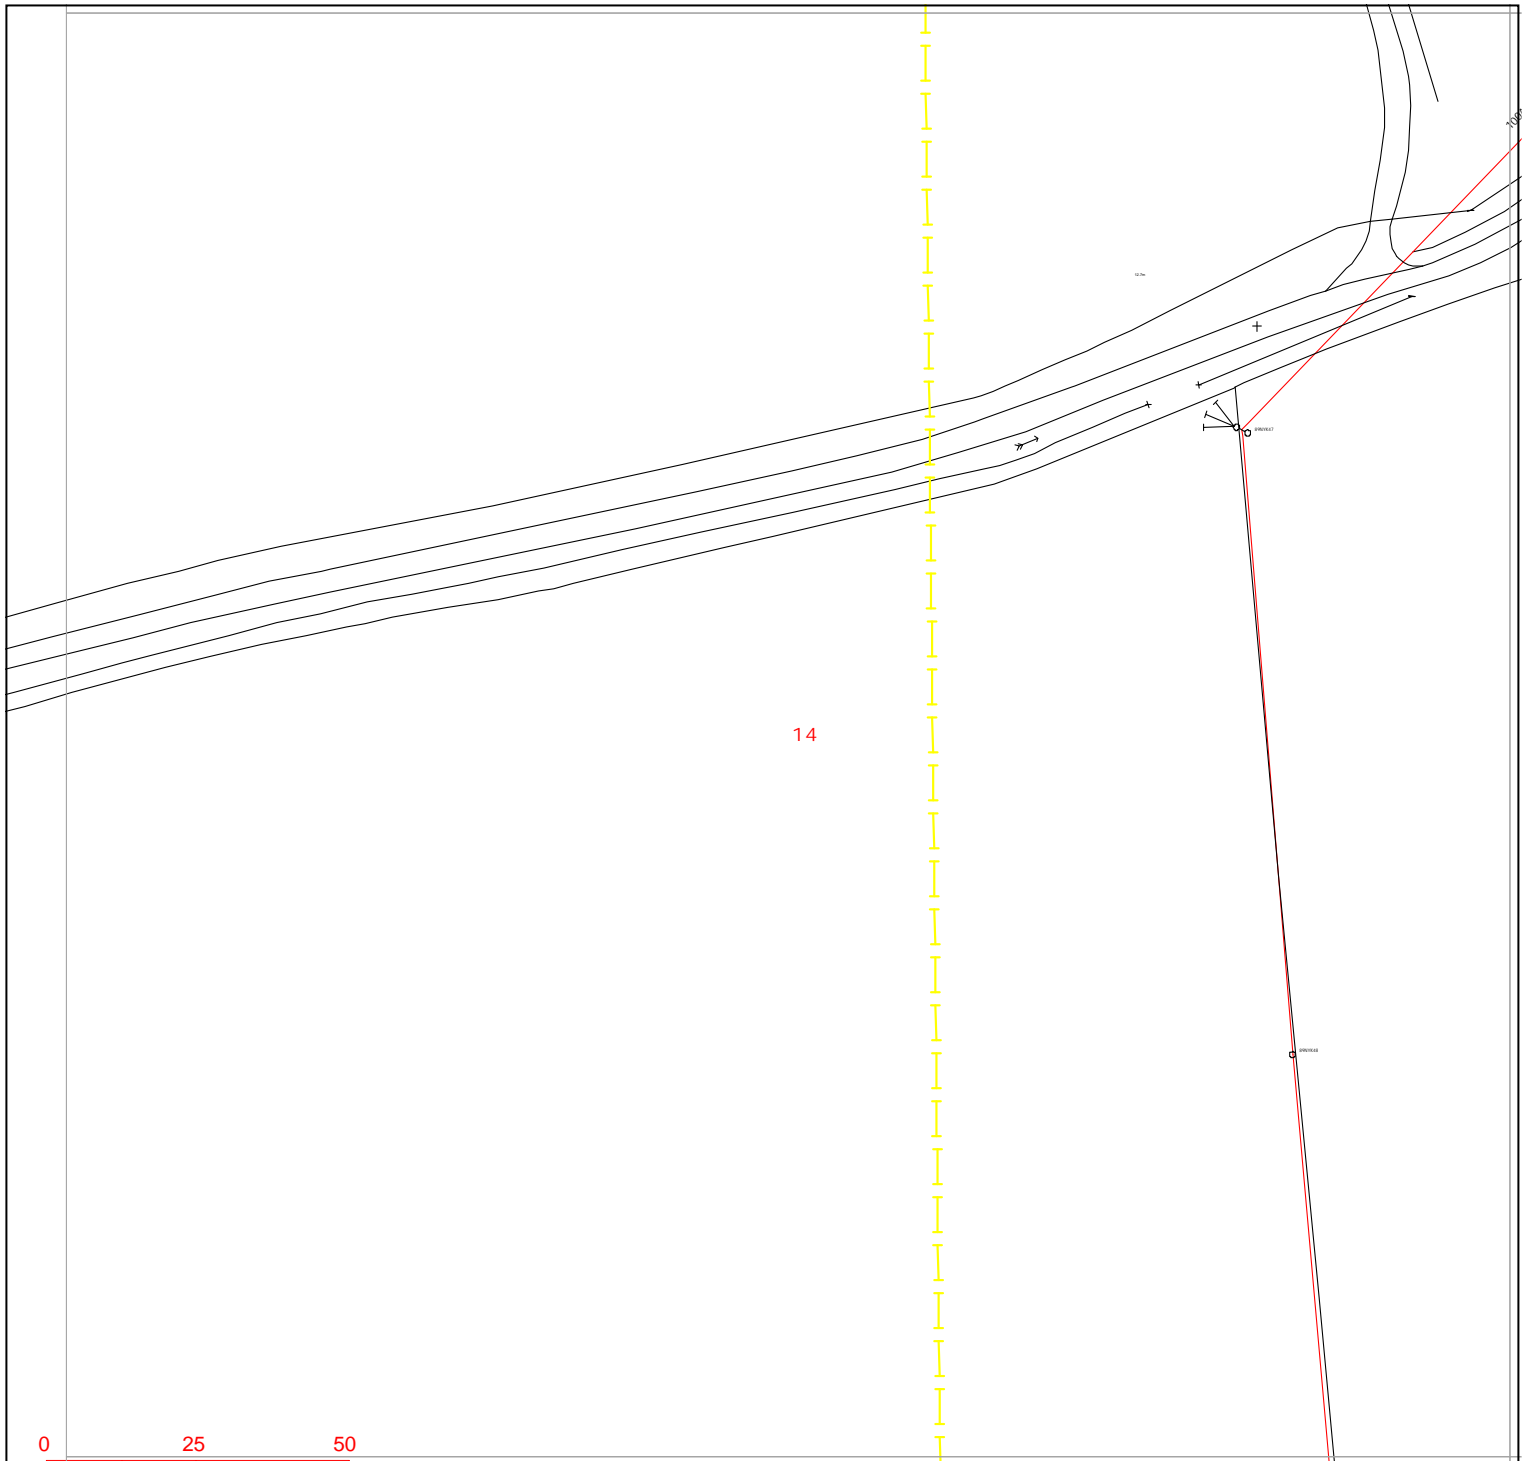

nationalgrid Electricity Distribution

Contact Us

Mapping Enquiries:
All areas 0121 623 9780

General Enquiries:
All areas 0800 096 3080

Date Requested: 08/05/2023
Job Reference: 29406941
Site Location: 479024 384047
Requested by:
Mr Ben Evans
Your Scheme/Reference:
LM 203570/DK - 6

Exact Scales:
1:1250 Area or Circle dig site
1:500 Line dig site


Link Box	Overhead Line	Underground Cable	National Grid Telecoms	Pilot Cables
●	<ul style="list-style-type: none"> ○ PL ○ Service ○ LV ○ HV (11kV) ○ HV (33kV) ○ HV (66kV) ○ HV (132kV) 	<ul style="list-style-type: none"> --- --- --- --- --- --- --- 	<ul style="list-style-type: none"> --- PME Earth ---E Underground Earth 	<ul style="list-style-type: none"> ○ Pole Mounted Transformer □ Ground Mounted Transformer
Site Location Line/Area	<ul style="list-style-type: none"> --- Site Location --- Line/Area 			

IMPORTANT NOTICES

- This information is given as a guide only and its accuracy cannot be guaranteed. Services or recent additions to the network may not be shown.
- Cables, overhead lines & substations owned by other electricity network owners or private companies may be present and may not be shown.
- You should always verify exact locations of cables using a cable locator and by careful use of hand tools in accordance with HSE guidance note HSG47.
- When working within 10m of any overhead electric line you should follow the requirements of HSE Guidance Note GS6.
- For further advice on working near our electricity cables or lines, call our General Enquiries number.
- Advice should be sought from the National Grid Electricity Distribution General Enquiries team for any work that is to take place in proximity to 132kV underground cables and 132kV overhead lines.

Report damage immediately – KEEP EVERYONE AWAY FROM THE AREA
0800 6783 105

Crown Copyright © All Rights Reserved. Ordnance Survey Licence numbers: 100022432
NGED Copyright: This copy has been made by or with the authority of National Grid Electricity Distribution (NGED) pursuant to Section 47 of the Copyright Designs and Patents Act 1988 unless that Act provides a relevant exception to copyright the copy must not be copied without the prior permission of the copyright owner.

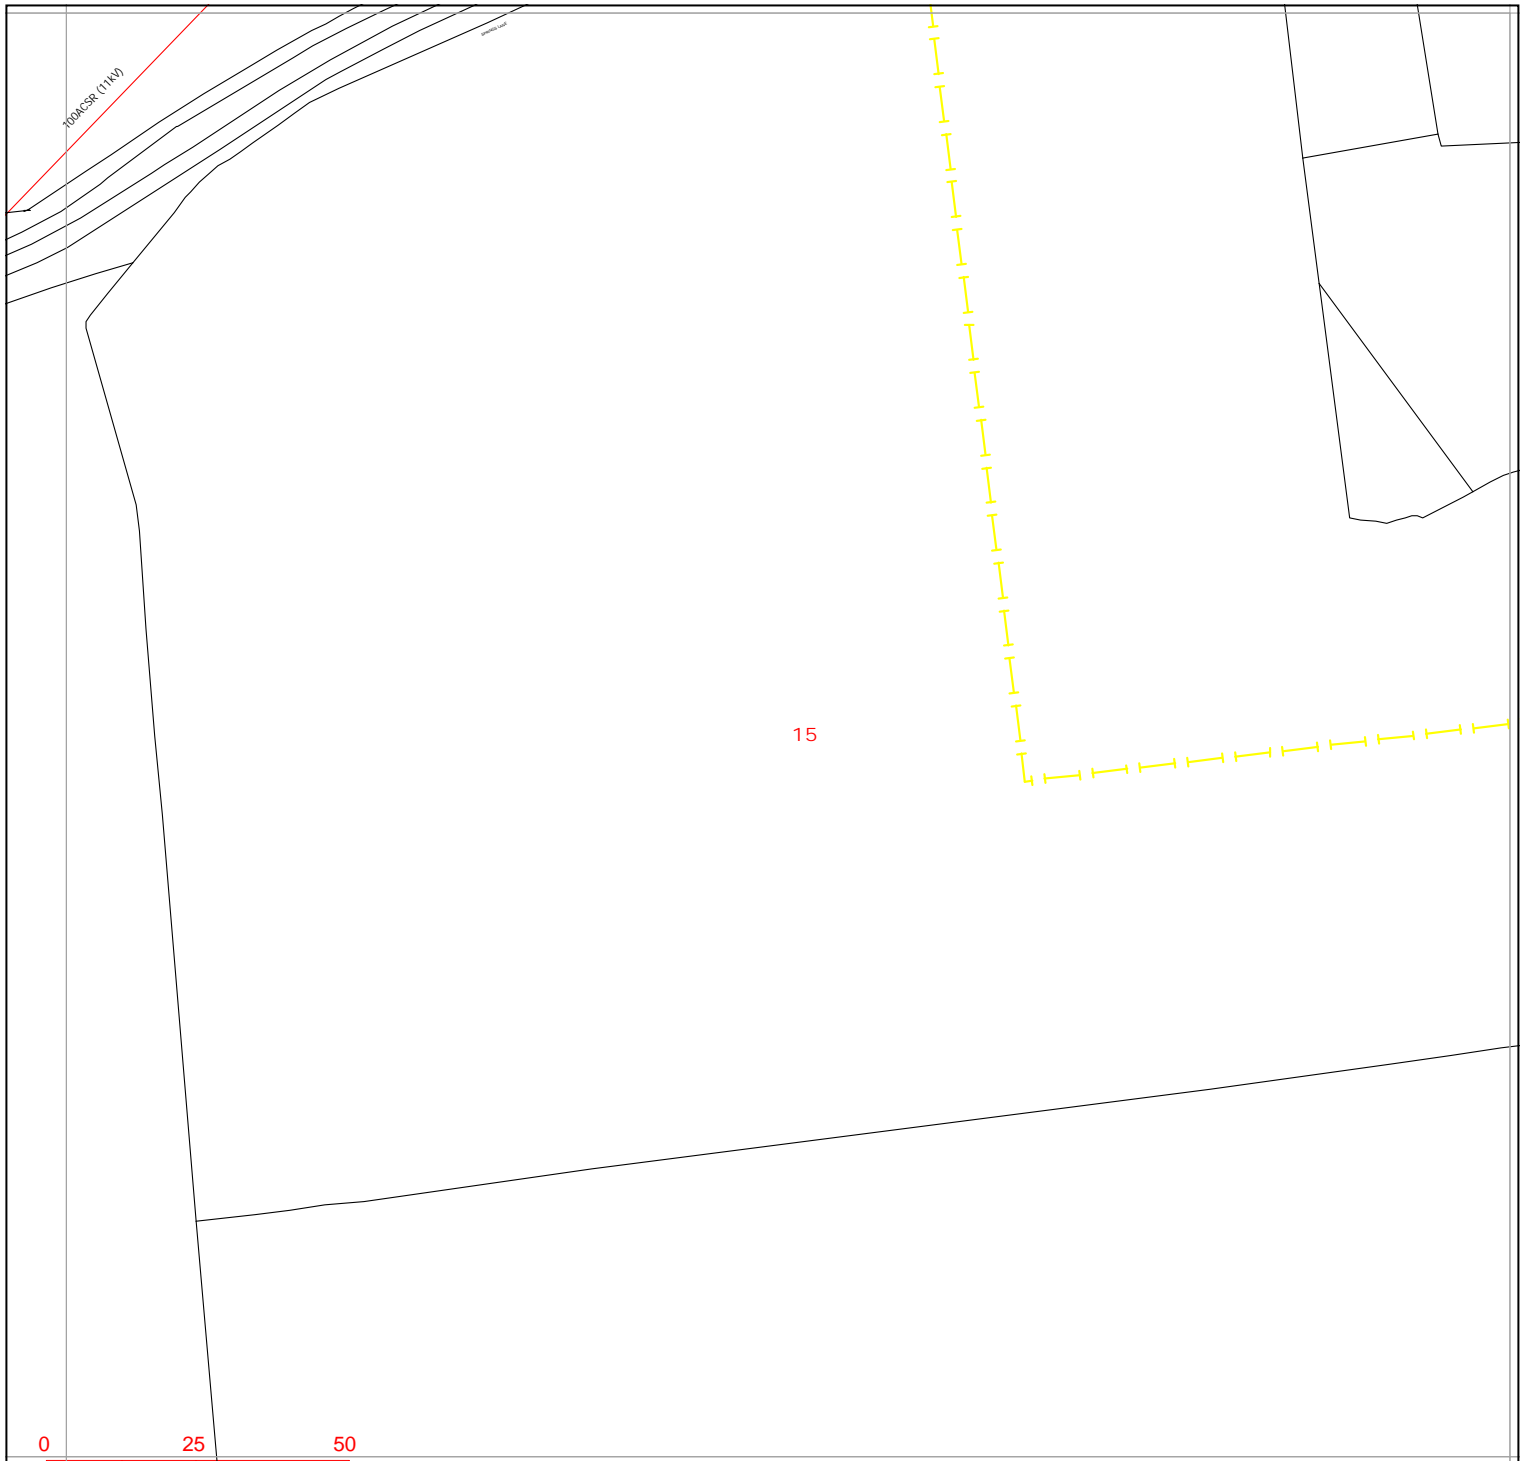

Warning: PDF designed for colour print only with no page scaling.



Contact Us
Mapping Enquiries:
 All areas 0121 623 9780
General Enquiries:
 All areas 0800 096 3080

Date Requested: 08/05/2023
 Job Reference: 29406941
 Site Location: 479024 384047
 Requested by:
 Mr Ben Evans
 Your Scheme/Reference:
 LM 203570/DK - 6

Exact Scales:
 1:1250 Area or Circle dig site
 1:500 Line dig site


Link Box ●	Overhead Line ○—○ PL ○—○ Service ○—○ LV ○—○ HV (11kV) ○—○ HV (33kV) ○—○ HV (66kV) □—□ HV (132kV)	Underground Cable -	National Grid Telecoms - - - - - PME Earth Underground Earth	Pilot Cables - - - - - ○ Pole Mounted Transformer □ Ground Mounted Transformer
----------------------	--	---	--	--

IMPORTANT NOTICES

- This information is given as a guide only and its accuracy cannot be guaranteed. Services or recent additions to the network may not be shown.
- Cables, overhead lines & substations owned by other electricity network owners or private companies may be present and may not be shown.
- You should always verify exact locations of cables using a cable locator and by careful use of hand tools in accordance with HSE guidance note HSG47.
- When working within 10m of any overhead electric line you should follow the requirements of HSE Guidance Note GS6.
- For further advice on working near our electricity cables or lines, call our General Enquiries number.
- Advice should be sought from the National Grid Electricity Distribution General Enquiries team for any work that is to take place in proximity to 132kV underground cables and 132kV overhead lines.

Report damage immediately – KEEP EVERYONE AWAY FROM THE AREA
0800 6783 105

Crown Copyright © All Rights Reserved. Ordnance Survey Licence numbers: 100022432
 NGED Copyright: This copy has been made by or with the authority of National Grid Electricity Distribution (NGED) pursuant to Section 47 of the Copyright Designs and Patents Act 1988 unless that Act provides a relevant exception to copyright the copy must not be copied without the prior permission of the copyright owner.

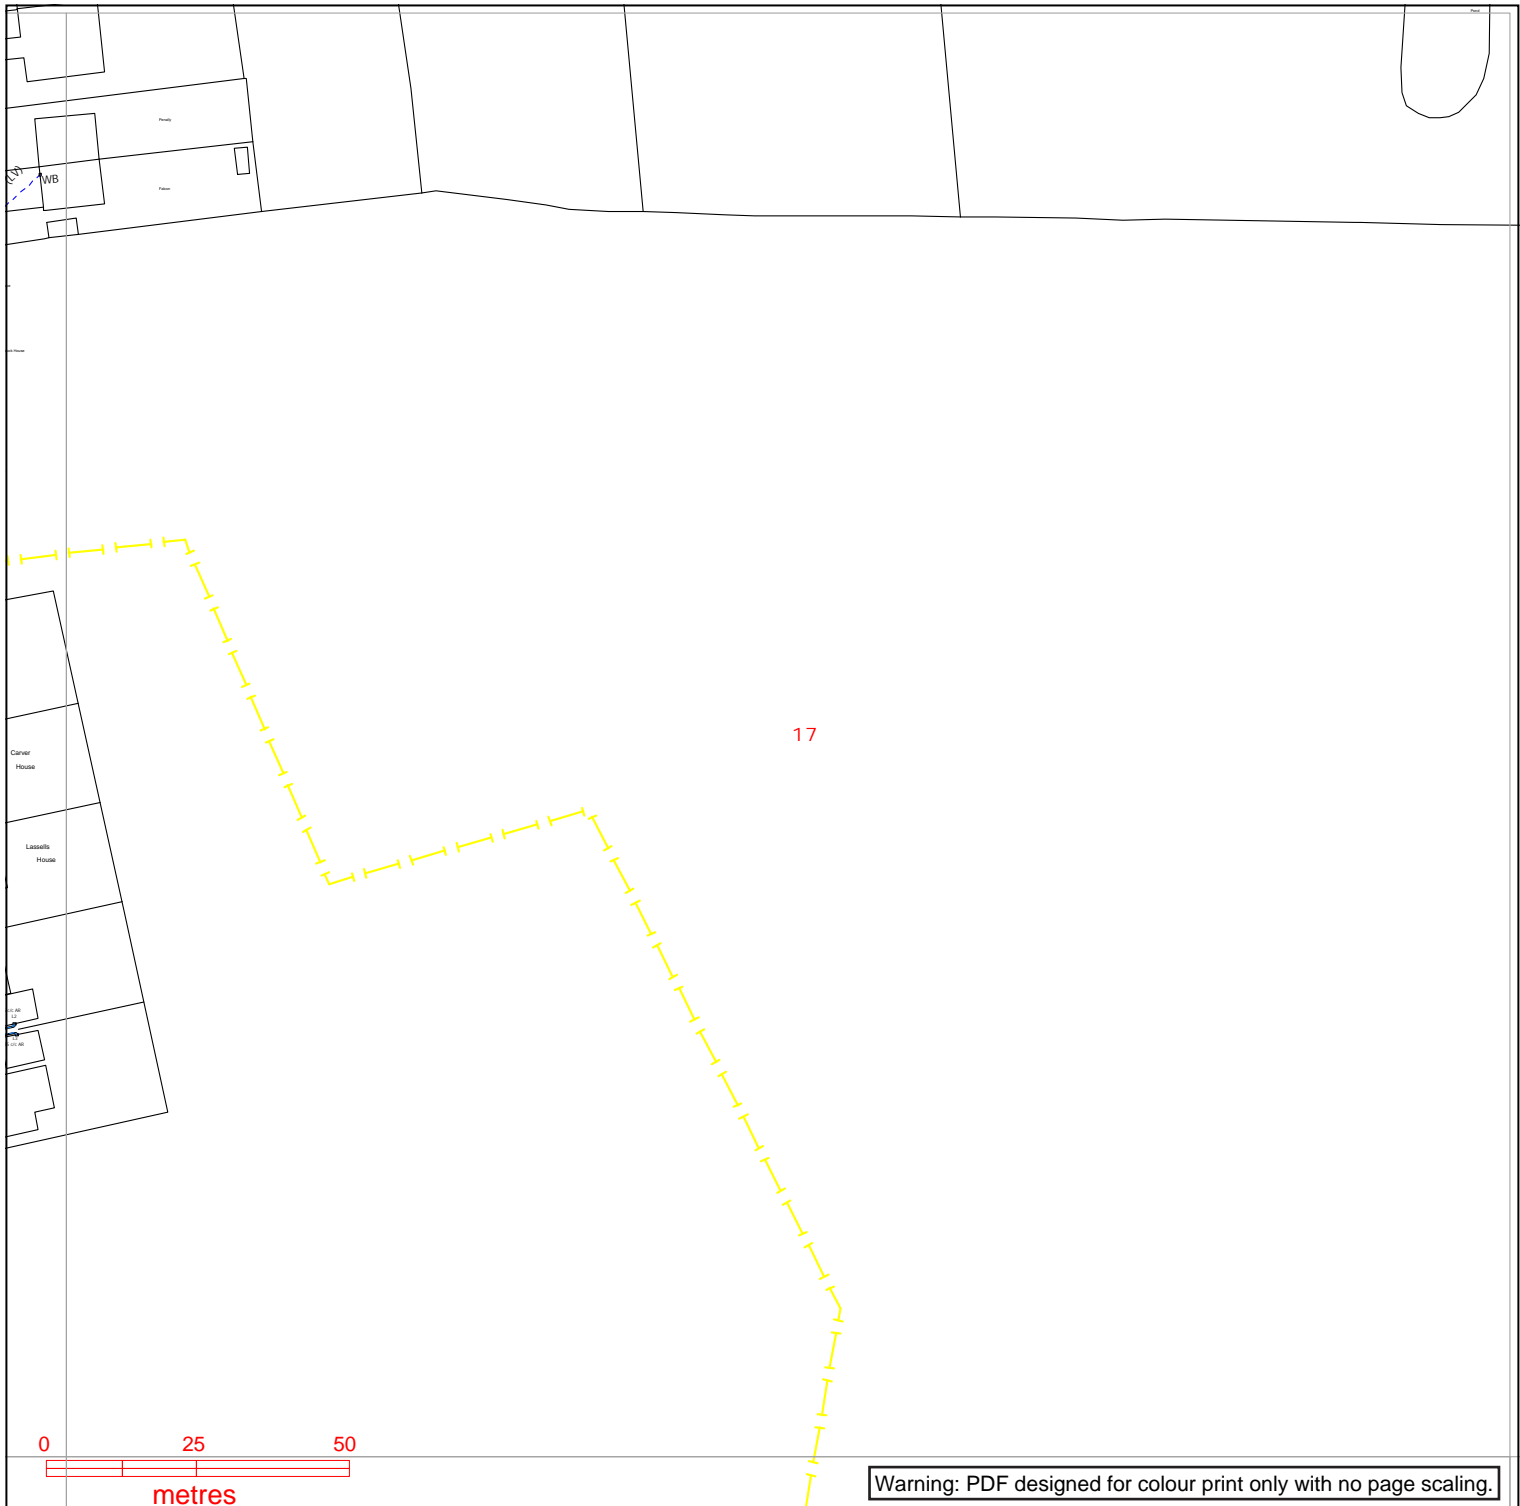

Contact Us

Mapping Enquiries:
All areas 0121 623 9780

General Enquiries:
All areas 0800 096 3080

Date Requested: 08/05/2023
Job Reference: 29406941
Site Location: 479024 384047
Requested by:
Mr Ben Evans
Your Scheme/Reference:
LM 203570/DK - 6

Exact Scales:
1:1250 Area or Circle dig site
1:500 Line dig site


Link Box ●	Overhead Line ○—○ PL ○—○ Service ○—○ LV ○—○ HV (11kV) ○—○ HV (33kV) ○—○ HV (66kV) ○—○ HV (132kV)	Underground Cable -	National Grid Telecoms - - - - - PME Earth Underground Earth	Pilot Cables ○ □ Pole Mounted Transformer Ground Mounted Transformer
----------------------	--	---	--	---

IMPORTANT NOTICES

- This information is given as a guide only and its accuracy cannot be guaranteed. Services or recent additions to the network may not be shown.
- Cables, overhead lines & substations owned by other electricity network owners or private companies may be present and may not be shown.
- You should always verify exact locations of cables using a cable locator and by careful use of hand tools in accordance with HSE guidance note HSG47.
- When working within 10m of any overhead electric line you should follow the requirements of HSE Guidance Note GS6.
- For further advice on working near our electricity cables or lines, call our General Enquiries number.
- Advice should be sought from the National Grid Electricity Distribution General Enquiries team for any work that is to take place in proximity to 132kV underground cables and 132kV overhead lines.

Report damage immediately – KEEP EVERYONE AWAY FROM THE AREA
0800 6783 105

Crown Copyright © All Rights Reserved. Ordnance Survey Licence numbers: 100022432
NGED Copyright: This copy has been made by or with the authority of National Grid Electricity Distribution (NGED) pursuant to Section 47 of the Copyright Designs and Patents Act 1988 unless that Act provides a relevant exception to copyright the copy must not be copied without the prior permission of the copyright owner.

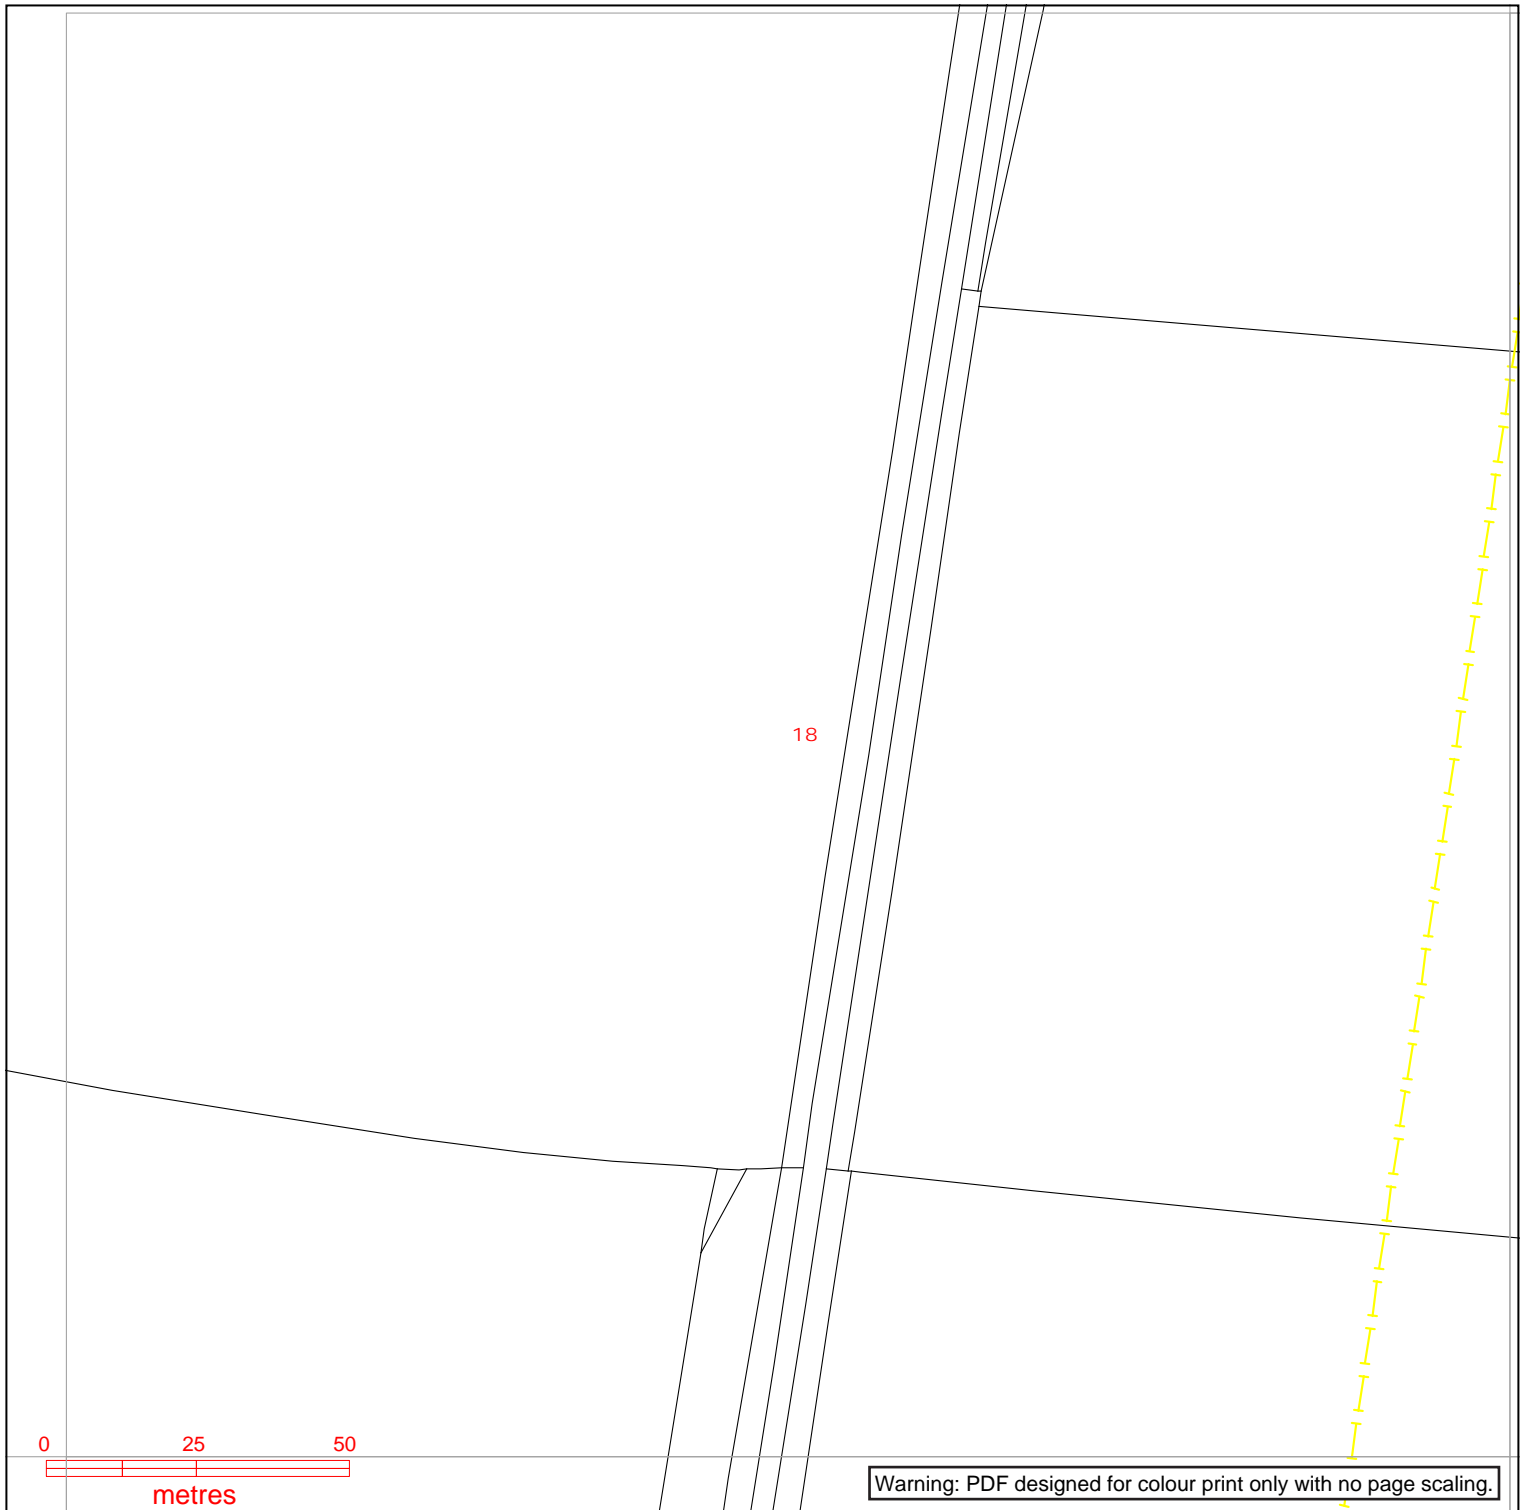

Warning: PDF designed for colour print only with no page scaling.

nationalgrid Electricity Distribution

Contact Us

Mapping Enquiries:
All areas 0121 623 9780

General Enquiries:
All areas 0800 096 3080

Date Requested: 08/05/2023
Job Reference: 29406941
Site Location: 479024 384047
Requested by:
Mr Ben Evans
Your Scheme/Reference:
LM 203570/DK - 6

Exact Scales:
1:1250 Area or Circle dig site
1:500 Line dig site


Link Box	Overhead Line	Underground Cable	National Grid Telecoms	Pilot Cables
●	○ PL ○ Service ○ LV ○ HV (11kV) ○ HV (33kV) ○ HV (66kV) ○ HV (132kV)	---	--- PME Earth ---E Underground Earth	○ Pole Mounted Transformer □ Ground Mounted Transformer
■	■	---		

IMPORTANT NOTICES

- This information is given as a guide only and its accuracy cannot be guaranteed. Services or recent additions to the network may not be shown.
- Cables, overhead lines & substations owned by other electricity network owners or private companies may be present and may not be shown.
- You should always verify exact locations of cables using a cable locator and by careful use of hand tools in accordance with HSE guidance note HSG47.
- When working within 10m of any overhead electric line you should follow the requirements of HSE Guidance Note GS6.
- For further advice on working near our electricity cables or lines, call our General Enquiries number.
- Advice should be sought from the National Grid Electricity Distribution General Enquiries team for any work that is to take place in proximity to 132kV underground cables and 132kV overhead lines.

Report damage immediately – KEEP EVERYONE AWAY FROM THE AREA
0800 6783 105

Crown Copyright © All Rights Reserved. Ordnance Survey Licence numbers: 100022432
NGED Copyright: This copy has been made by or with the authority of National Grid Electricity Distribution (NGED) pursuant to Section 47 of the Copyright Designs and Patents Act 1988 unless that Act provides a relevant exception to copyright the copy must not be copied without the prior permission of the copyright owner.

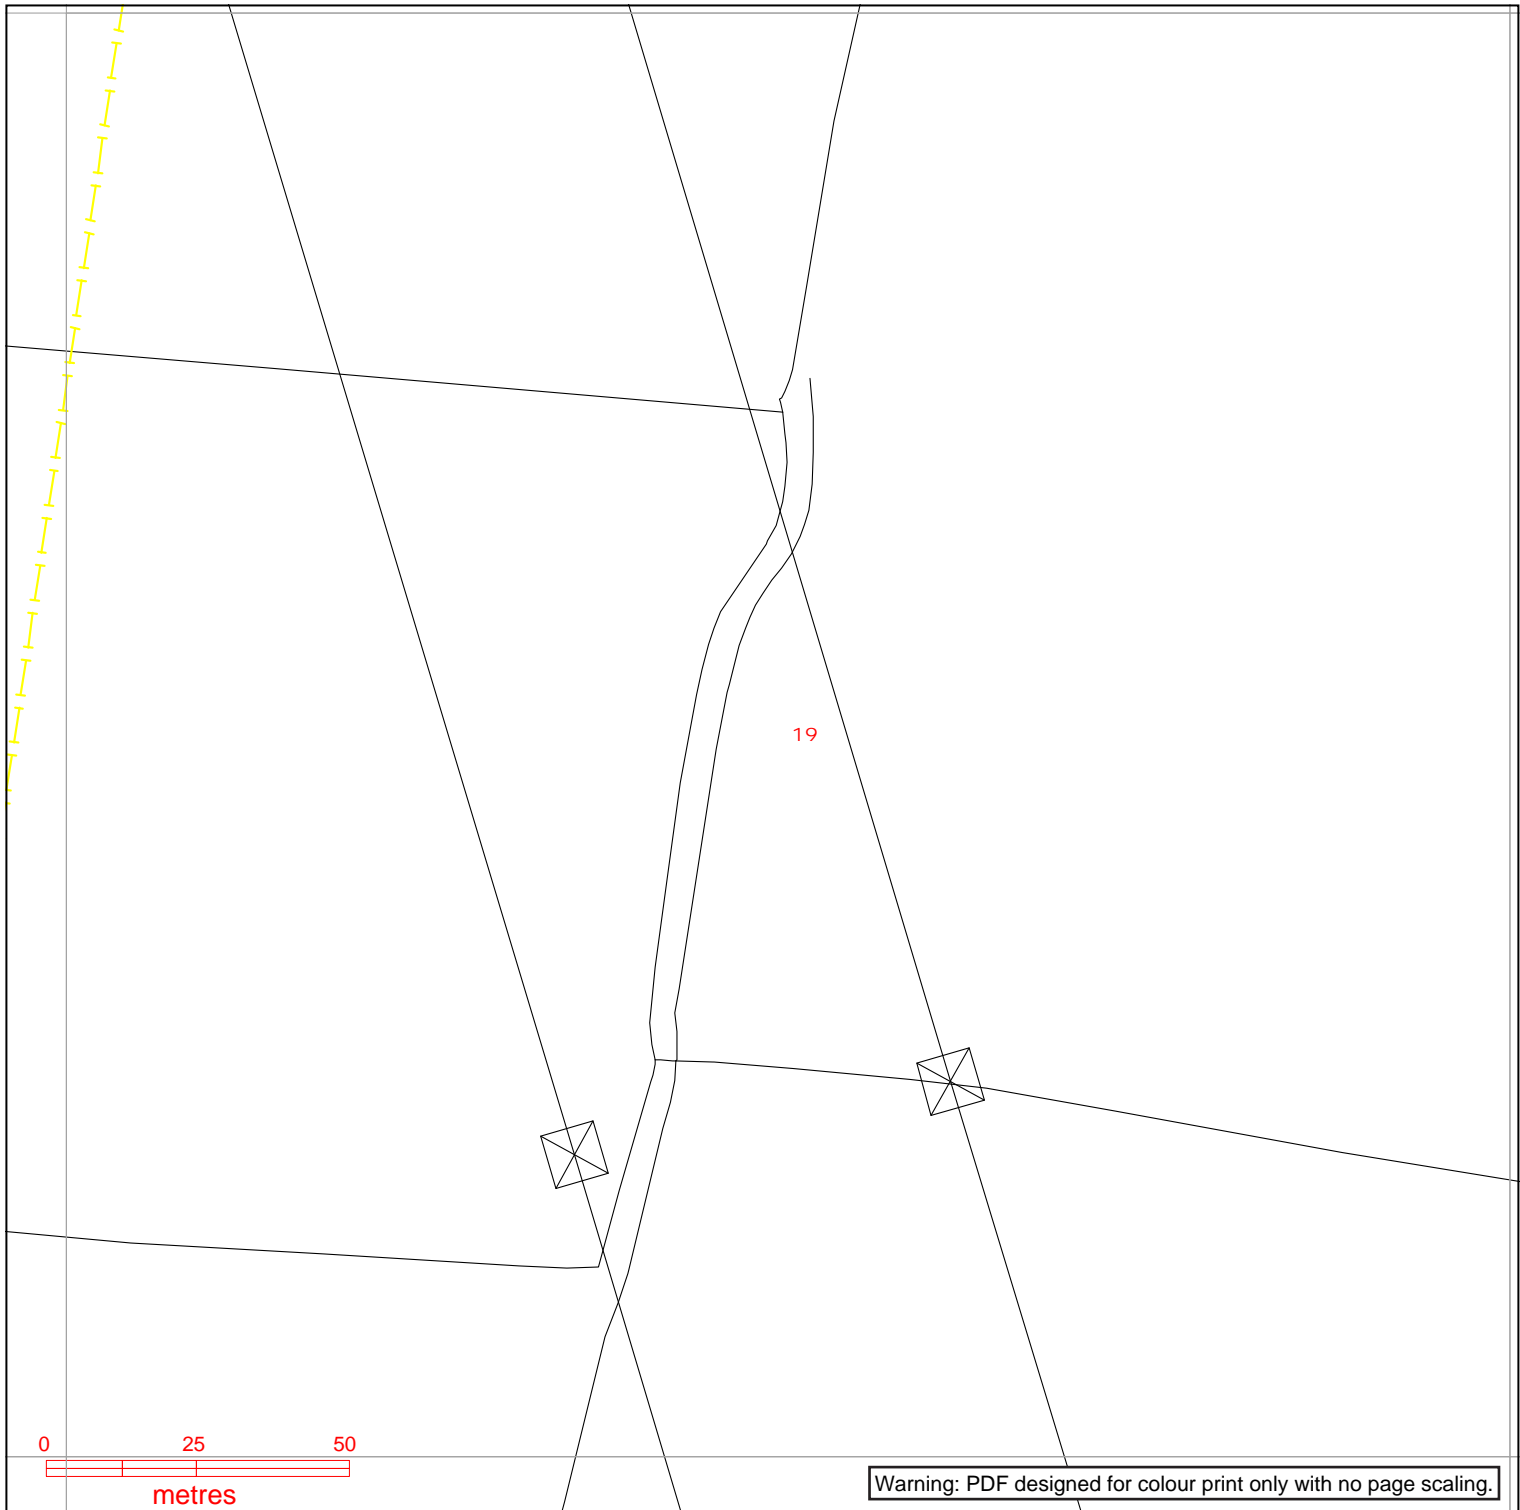

Warning: PDF designed for colour print only with no page scaling.

nationalgrid Electricity Distribution

Contact Us

Mapping Enquiries:
All areas 0121 623 9780

General Enquiries:
All areas 0800 096 3080

Date Requested: 08/05/2023
Job Reference: 29406941
Site Location: 479024 384047
Requested by:
Mr Ben Evans
Your Scheme/Reference:
LM 203570/DK - 6

Exact Scales:
1:1250 Area or Circle dig site
1:500 Line dig site


Link Box ●	Overhead Line ○ ○ PL ○ ○ Service ○ ○ LV ○ ○ HV (11kV) ○ ○ HV (33kV) ○ ○ HV (66kV) ○ ○ HV (132kV)	Underground Cable -	National Grid Telecoms - - - - - PME Earth -E- - - - - Underground Earth	Pilot Cables - - - - - ○ Pole Mounted Transformer □ Ground Mounted Transformer
----------------------	--	---	---	--

IMPORTANT NOTICES

- This information is given as a guide only and its accuracy cannot be guaranteed. Services or recent additions to the network may not be shown.
- Cables, overhead lines & substations owned by other electricity network owners or private companies may be present and may not be shown.
- You should always verify exact locations of cables using a cable locator and by careful use of hand tools in accordance with HSE guidance note HSG47.
- When working within 10m of any overhead electric line you should follow the requirements of HSE Guidance Note GS6.
- For further advice on working near our electricity cables or lines, call our General Enquiries number.
- Advice should be sought from the National Grid Electricity Distribution General Enquiries team for any work that is to take place in proximity to 132kV underground cables and 132kV overhead lines.

Report damage immediately – KEEP EVERYONE AWAY FROM THE AREA
0800 6783 105

Crown Copyright © All Rights Reserved. Ordnance Survey Licence numbers: 100022432
NGED Copyright: This copy has been made by or with the authority of National Grid Electricity Distribution (NGED) pursuant to Section 47 of the Copyright Designs and Patents Act 1988 unless that Act provides a relevant exception to copyright the copy must not be copied without the prior permission of the copyright owner.

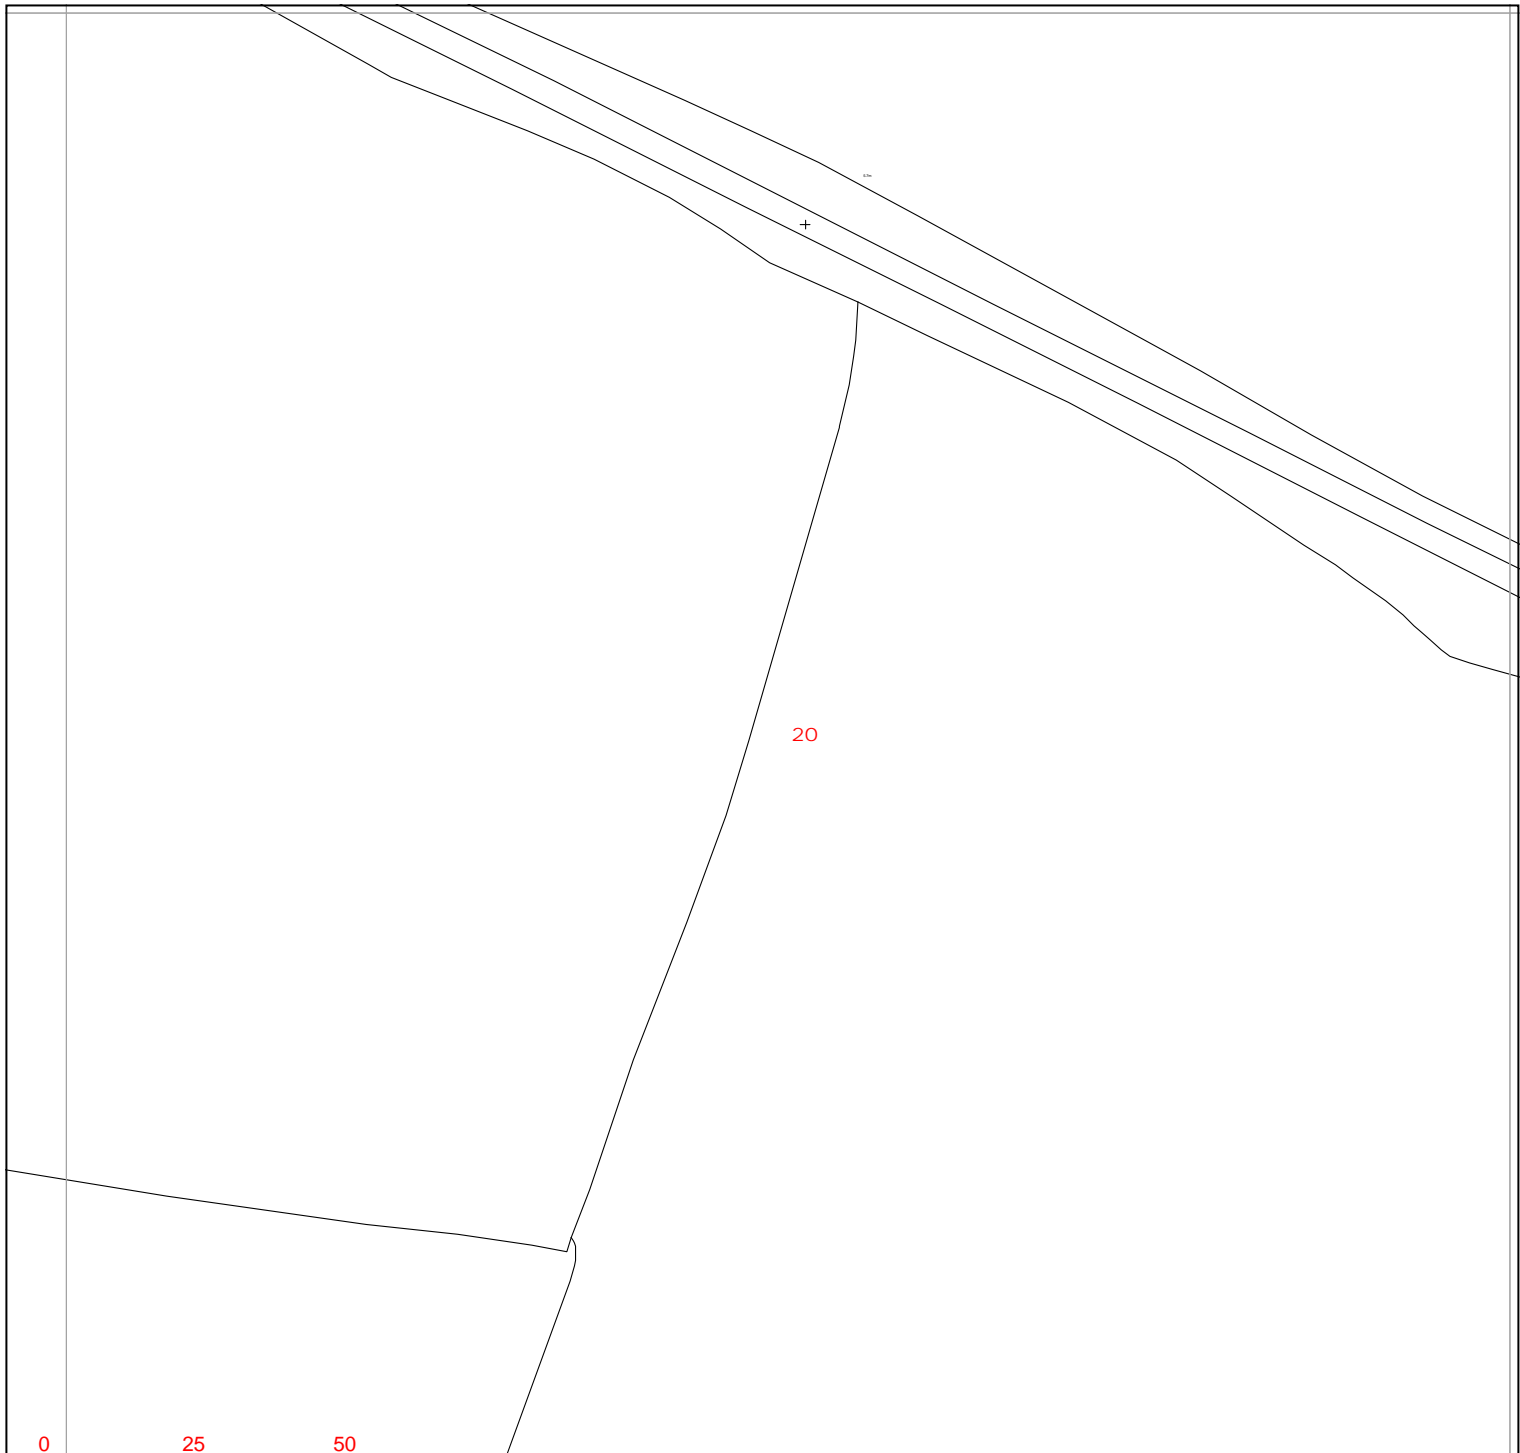

Warning: PDF designed for colour print only with no page scaling.



Contact Us
Mapping Enquiries:
 All areas 0121 623 9780
General Enquiries:
 All areas 0800 096 3080

Date Requested: 08/05/2023
 Job Reference: 29406941
 Site Location: 479024 384047
 Requested by:
 Mr Ben Evans
 Your Scheme/Reference:
 LM 203570/DK - 6

Link Box ●	Overhead Line 	Underground Cable 	National Grid Telecoms 	Pilot Cables
Site Location Line/Area 			PME Earth 	Pole Mounted Transformer
			Underground Earth 	Ground Mounted Transformer


IMPORTANT NOTICES

- This information is given as a guide only and its accuracy cannot be guaranteed. Services or recent additions to the network may not be shown.
- Cables, overhead lines & substations owned by other electricity network owners or private companies may be present and may not be shown.
- You should always verify exact locations of cables using a cable locator and by careful use of hand tools in accordance with HSE guidance note HSG47.
- When working within 10m of any overhead electric line you should follow the requirements of HSE Guidance Note GS6.
- For further advice on working near our electricity cables or lines, call our General Enquiries number.
- Advice should be sought from the National Grid Electricity Distribution General Enquiries team for any work that is to take place in proximity to 132kV underground cables and 132kV overhead lines.

Report damage immediately – KEEP EVERYONE AWAY FROM THE AREA
0800 6783 105

Exact Scales:
 1:1250 Area or Circle dig site
 1:500 Line dig site

Crown Copyright © All Rights Reserved. Ordnance Survey Licence numbers: 100022432
 NGED Copyright: This copy has been made by or with the authority of National Grid Electricity Distribution (NGED) pursuant to Section 47 of the Copyright Designs and Patents Act 1988 unless that Act provides a relevant exception to copyright the copy must not be copied without the prior permission of the copyright owner.

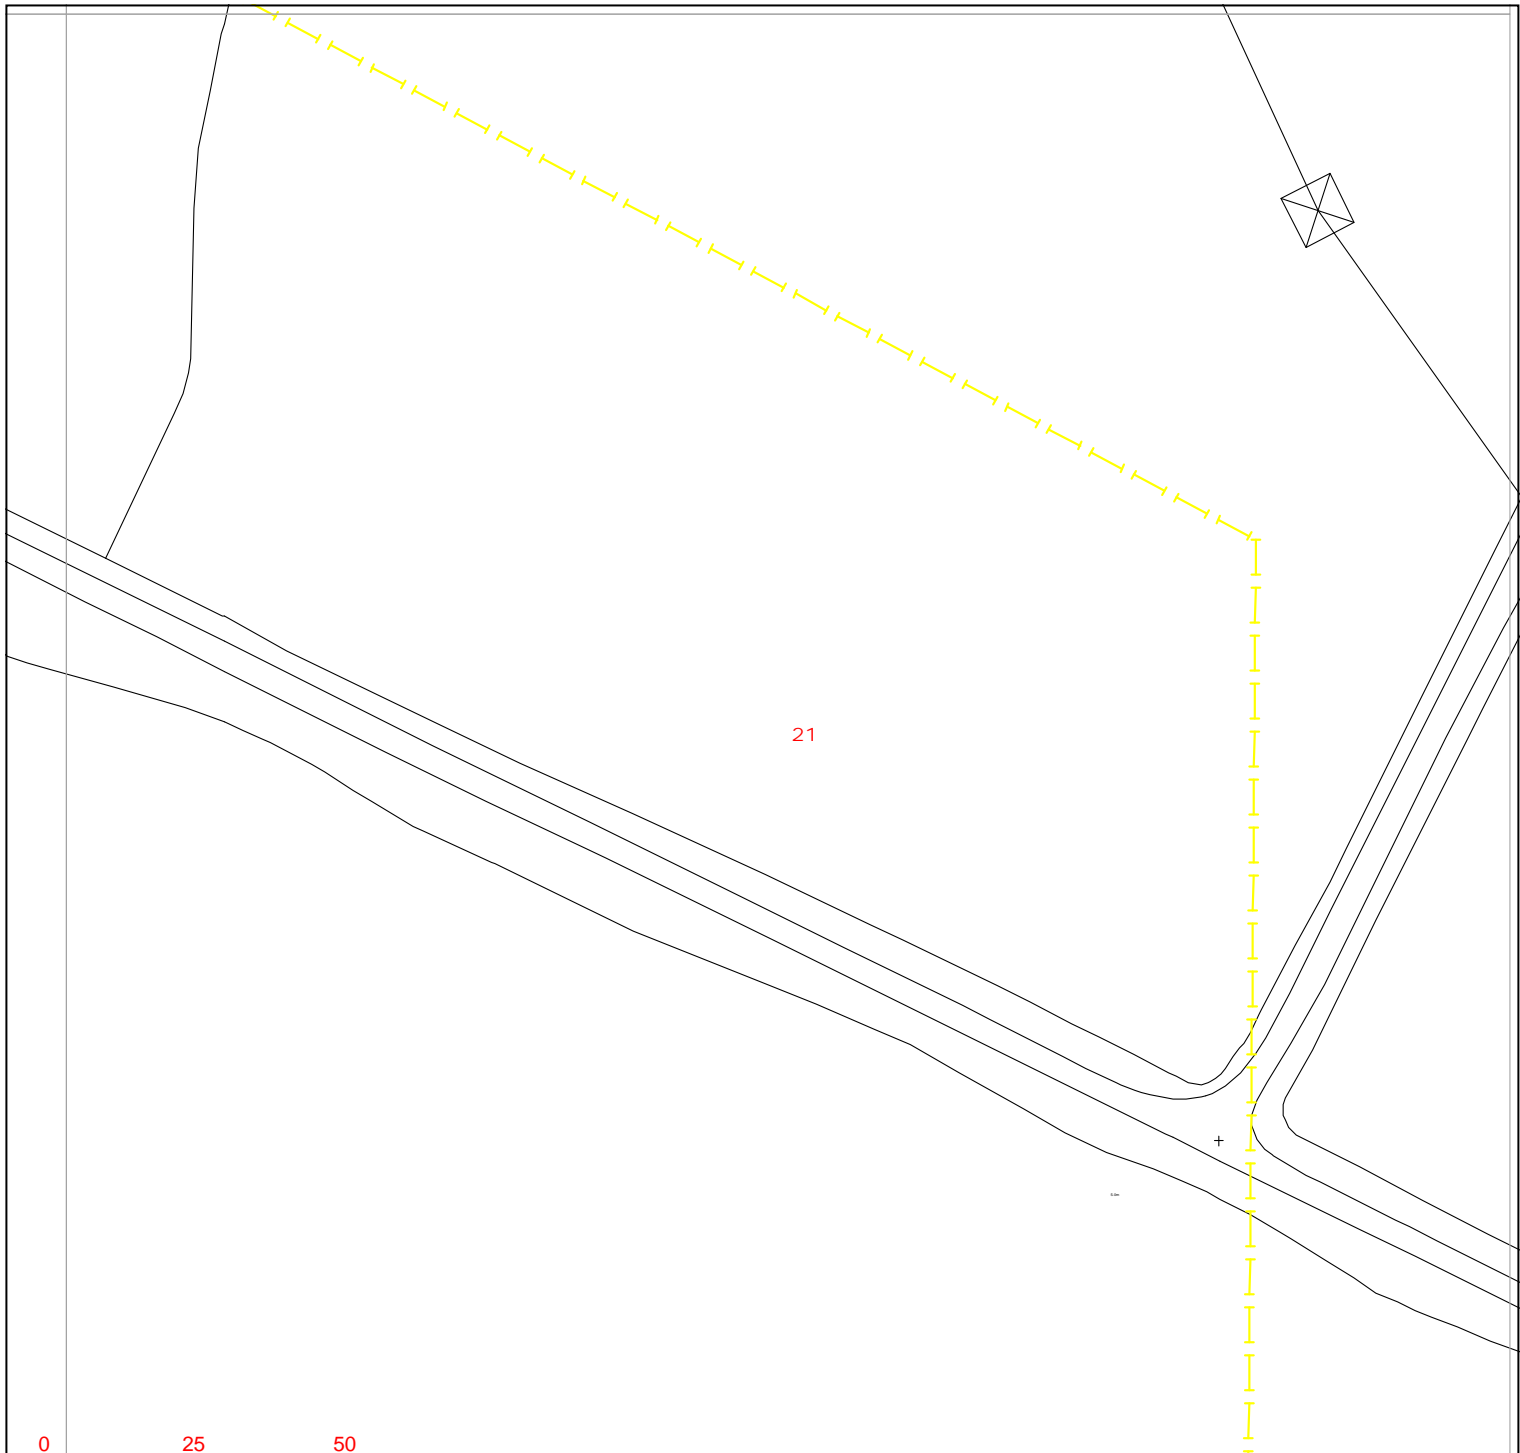

0 25 50
metres

Warning: PDF designed for colour print only with no page scaling.



Contact Us

Mapping Enquiries:
All areas 0121 623 9780

General Enquiries:
All areas 0800 096 3080

Date Requested: 08/05/2023
Job Reference: 29406941
Site Location: 479024 384047
Requested by:
Mr Ben Evans
Your Scheme/Reference:
LM 203570/DK - 6

Exact Scales:
1:1250 Area or Circle dig site
1:500 Line dig site


Link Box	Overhead Line	Underground Cable	National Grid Telecoms	Pilot Cables
●	<ul style="list-style-type: none"> ○ PL ○ Service ○ LV ○ HV (11kV) ○ HV (33kV) ○ HV (66kV) ○ HV (132kV) 	<ul style="list-style-type: none"> --- --- --- --- --- --- --- 	<ul style="list-style-type: none"> --- PME Earth ---E Underground Earth 	<ul style="list-style-type: none"> ○ Pole Mounted Transformer □ Ground Mounted Transformer

IMPORTANT NOTICES

- This information is given as a guide only and its accuracy cannot be guaranteed. Services or recent additions to the network may not be shown.
- Cables, overhead lines & substations owned by other electricity network owners or private companies may be present and may not be shown.
- You should always verify exact locations of cables using a cable locator and by careful use of hand tools in accordance with HSE guidance note HSG47.
- When working within 10m of any overhead electric line you should follow the requirements of HSE Guidance Note GS6.
- For further advice on working near our electricity cables or lines, call our General Enquiries number.
- Advice should be sought from the National Grid Electricity Distribution General Enquiries team for any work that is to take place in proximity to 132kV underground cables and 132kV overhead lines.

Report damage immediately – KEEP EVERYONE AWAY FROM THE AREA
0800 6783 105

Crown Copyright © All Rights Reserved. Ordnance Survey Licence numbers: 100022432
NGED Copyright: This copy has been made by or with the authority of National Grid Electricity Distribution (NGED) pursuant to Section 47 of the Copyright Designs and Patents Act 1988 unless that Act provides a relevant exception to copyright the copy must not be copied without the prior permission of the copyright owner.

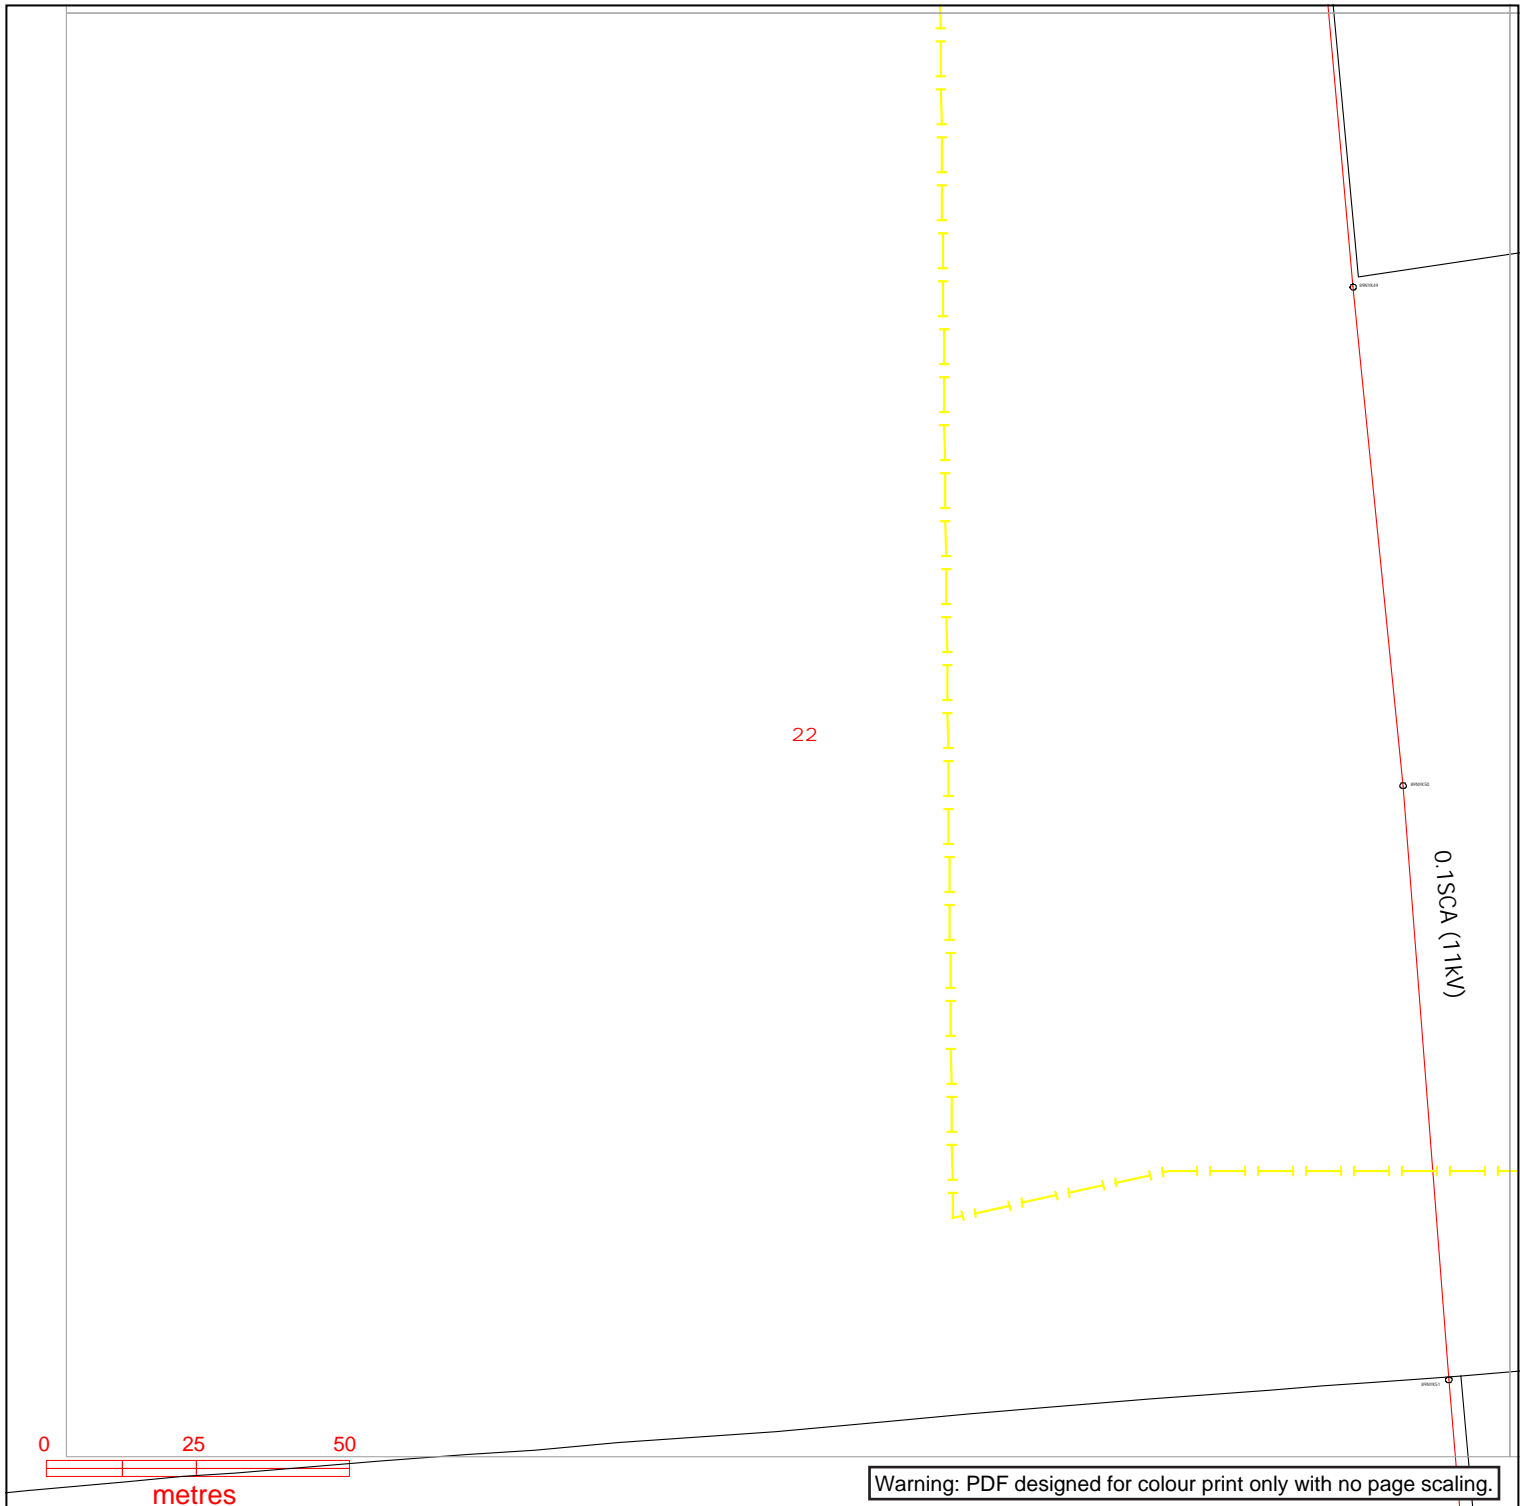

Warning: PDF designed for colour print only with no page scaling.

nationalgrid Electricity Distribution

Contact Us

Mapping Enquiries:
All areas 0121 623 9780

General Enquiries:
All areas 0800 096 3080

Date Requested: 08/05/2023
Job Reference: 29406941
Site Location: 479024 384047
Requested by:
Mr Ben Evans
Your Scheme/Reference:
LM 203570/DK - 6

Exact Scales:
1:1250 Area or Circle dig site
1:500 Line dig site

Link Box	Overhead Line	Underground Cable	National Grid Telecoms	Pilot Cables
●				
Site Location 				


IMPORTANT NOTICES

- This information is given as a guide only and its accuracy cannot be guaranteed. Services or recent additions to the network may not be shown.
- Cables, overhead lines & substations owned by other electricity network owners or private companies may be present and may not be shown.
- You should always verify exact locations of cables using a cable locator and by careful use of hand tools in accordance with HSE guidance note HSG47.
- When working within 10m of any overhead electric line you should follow the requirements of HSE Guidance Note GS6.
- For further advice on working near our electricity cables or lines, call our General Enquiries number.
- Advice should be sought from the National Grid Electricity Distribution General Enquiries team for any work that is to take place in proximity to 132kV underground cables and 132kV overhead lines.

Report damage immediately – KEEP EVERYONE AWAY FROM THE AREA
0800 6783 105

Crown Copyright © All Rights Reserved. Ordnance Survey Licence numbers: 100022432
 NGED Copyright: This copy has been made by or with the authority of National Grid Electricity Distribution (NGED) pursuant to Section 47 of the Copyright Designs and Patents Act 1988 unless that Act provides a relevant exception to copyright the copy must not be copied without the prior permission of the copyright owner.

23

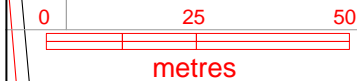

Warning: PDF designed for colour print only with no page scaling.



Contact Us

Mapping Enquiries:

All areas 0121 623 9780

General Enquiries:

All areas 0800 096 3080

Date Requested: 08/05/2023

Job Reference: 29406941

Site Location: 479024 384047

Requested by:

Mr Ben Evans

Your Scheme/Reference:

LM 203570/DK - 6

Exact Scales:

1:1250 Area or Circle dig site

1:500 Line dig site


Link Box	Overhead Line	Underground Cable	National Grid Telecoms	Pilot Cables
●				
●	<p>Site Location</p> <p>Line/Area</p>			

IMPORTANT NOTICES

- This information is given as a guide only and its accuracy cannot be guaranteed. Services or recent additions to the network may not be shown.
- Cables, overhead lines & substations owned by other electricity network owners or private companies may be present and may not be shown.
- You should always verify exact locations of cables using a cable locator and by careful use of hand tools in accordance with HSE guidance note HSG47.
- When working within 10m of any overhead electric line you should follow the requirements of HSE Guidance Note GS6.
- For further advice on working near our electricity cables or lines, call our General Enquiries number.
- Advice should be sought from the National Grid Electricity Distribution General Enquiries team for any work that is to take place in proximity to 132kV underground cables and 132kV overhead lines.

Report damage immediately – KEEP EVERYONE AWAY FROM THE AREA
0800 6783 105

Crown Copyright © All Rights Reserved. Ordnance Survey Licence numbers: 100022432
NGED Copyright: This copy has been made by or with the authority of National Grid Electricity Distribution (NGED) pursuant to Section 47 of the Copyright Designs and Patents Act 1988 unless that Act provides a relevant exception to copyright the copy must not be copied without the prior permission of the copyright owner.

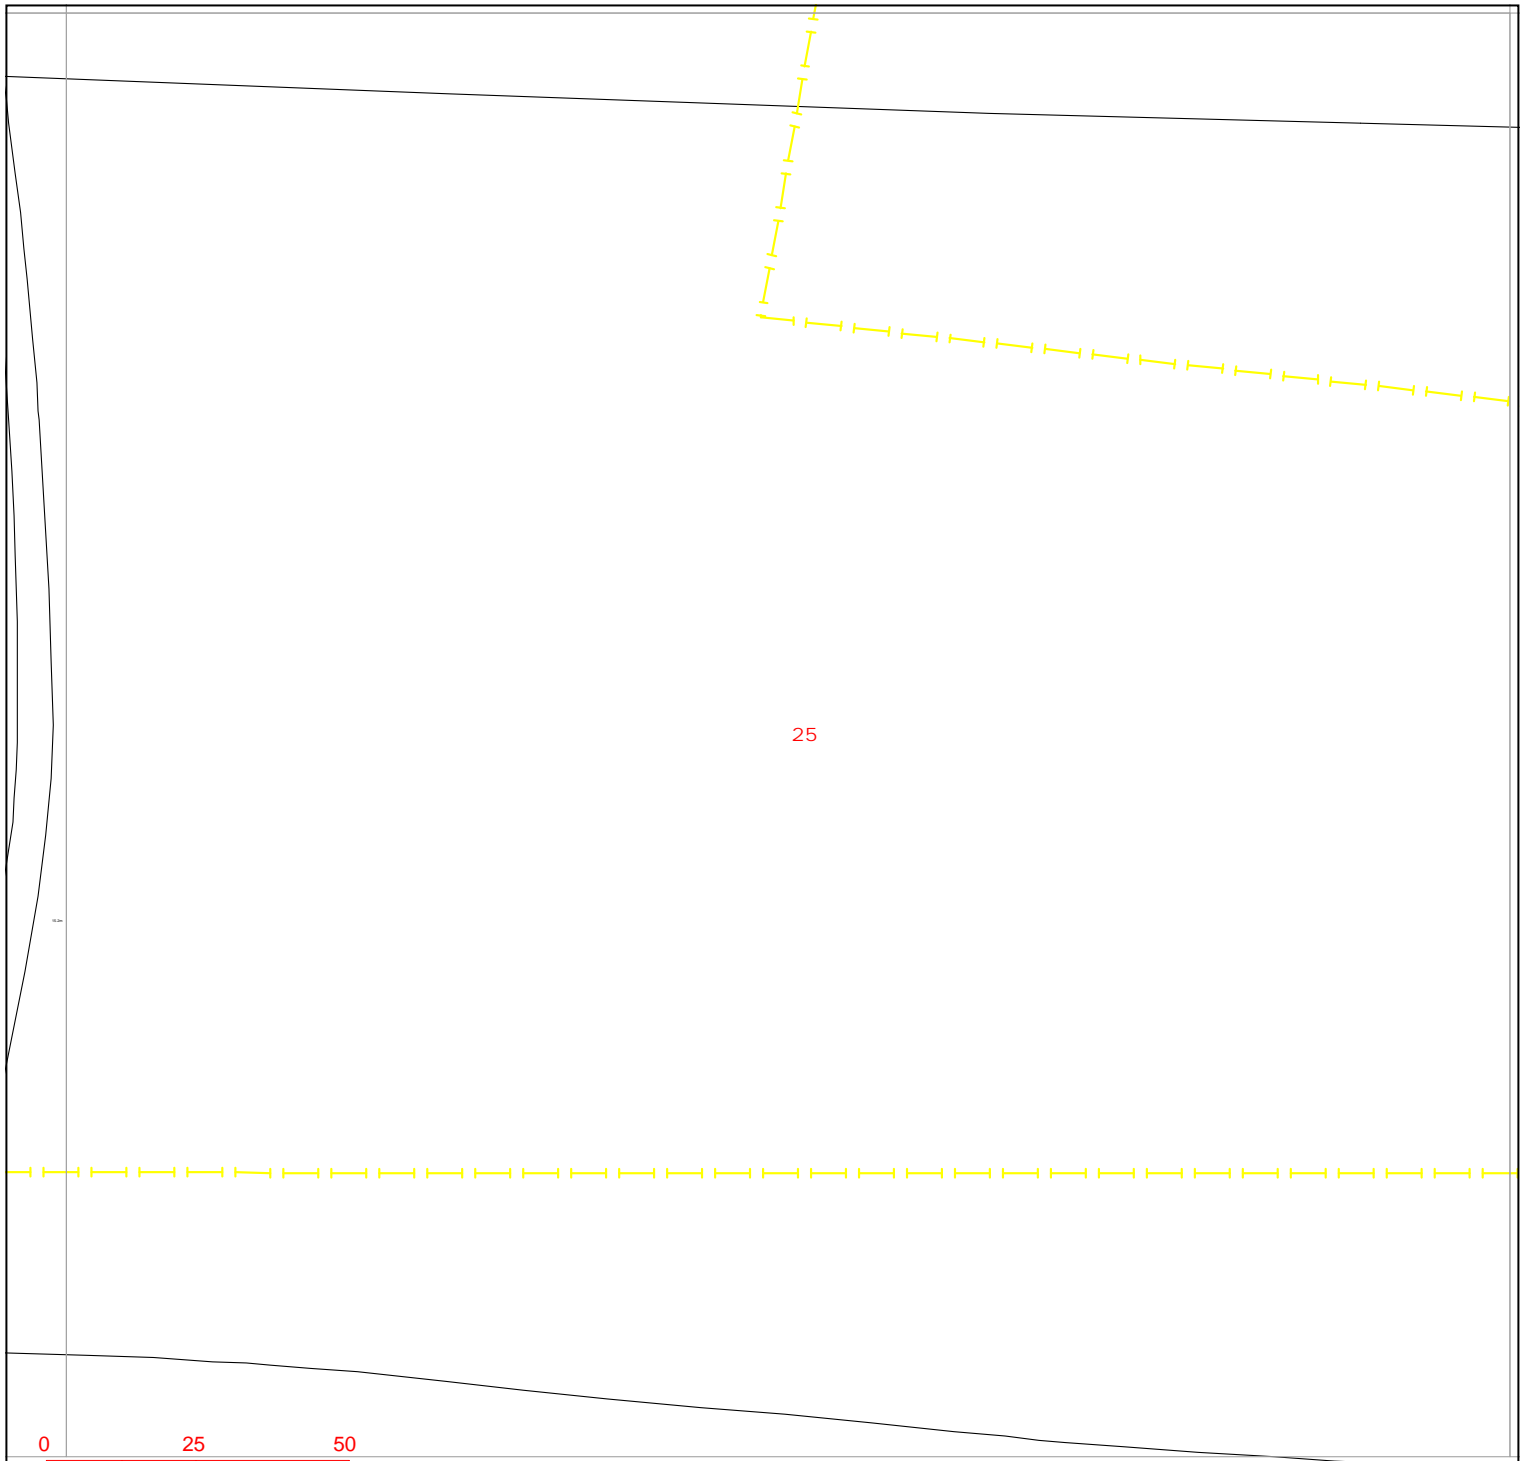

Warning: PDF designed for colour print only with no page scaling.

nationalgrid Electricity Distribution

Contact Us

Mapping Enquiries:
All areas 0121 623 9780

General Enquiries:
All areas 0800 096 3080

Date Requested: 08/05/2023
Job Reference: 29406941
Site Location: 479024 384047
Requested by:
Mr Ben Evans
Your Scheme/Reference:
LM 203570/DK - 6

Exact Scales:
1:1250 Area or Circle dig site
1:500 Line dig site


Link Box	Overhead Line	Underground Cable	National Grid Telecoms	Pilot Cables
●				
●				

IMPORTANT NOTICES

- This information is given as a guide only and its accuracy cannot be guaranteed. Services or recent additions to the network may not be shown.
- Cables, overhead lines & substations owned by other electricity network owners or private companies may be present and may not be shown.
- You should always verify exact locations of cables using a cable locator and by careful use of hand tools in accordance with HSE guidance note HSG47.
- When working within 10m of any overhead electric line you should follow the requirements of HSE Guidance Note GS6.
- For further advice on working near our electricity cables or lines, call our General Enquiries number.
- Advice should be sought from the National Grid Electricity Distribution General Enquiries team for any work that is to take place in proximity to 132kV underground cables and 132kV overhead lines.

Report damage immediately – KEEP EVERYONE AWAY FROM THE AREA
0800 6783 105

Crown Copyright © All Rights Reserved. Ordnance Survey Licence numbers: 100022432
NGED Copyright: This copy has been made by or with the authority of National Grid Electricity Distribution (NGED) pursuant to Section 47 of the Copyright Designs and Patents Act 1988 unless that Act provides a relevant exception to copyright the copy must not be copied without the prior permission of the copyright owner.

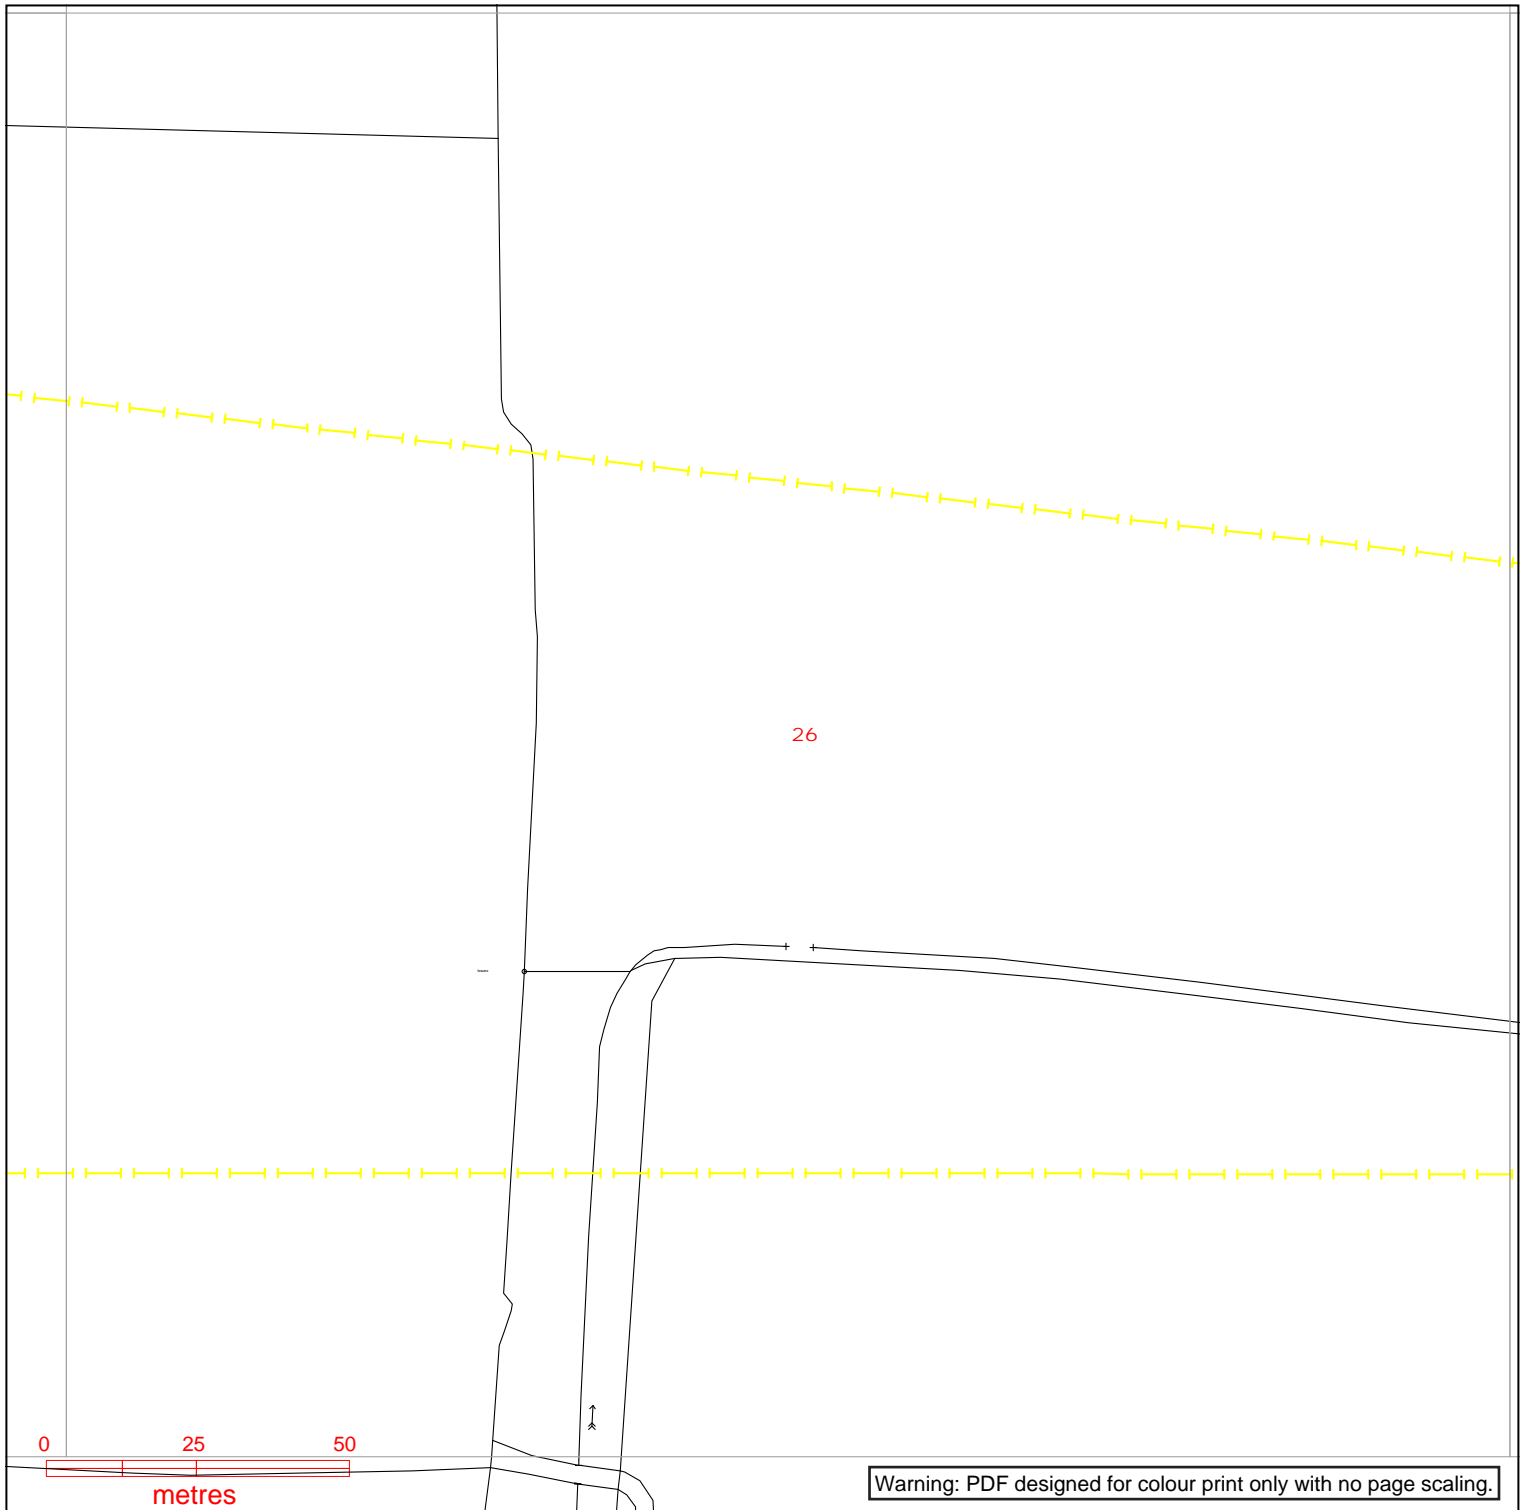

Warning: PDF designed for colour print only with no page scaling.

nationalgrid Electricity Distribution

Contact Us

Mapping Enquiries:
All areas 0121 623 9780

General Enquiries:
All areas 0800 096 3080

Date Requested: 08/05/2023
Job Reference: 29406941
Site Location: 479024 384047
Requested by:
Mr Ben Evans
Your Scheme/Reference:
LM 203570/DK - 6

Exact Scales:
1:1250 Area or Circle dig site
1:500 Line dig site


Link Box ●	Overhead Line ○—○ PL ○—○ Service ○—○ LV ○—○ HV (11kV) ○—○ HV (33kV) ○—○ HV (66kV) ○—○ HV (132kV)	Underground Cable -	National Grid Telecoms - - - - - PME Earth Underground Earth	Pilot Cables ○ Pole Mounted Transformer □ Ground Mounted Transformer
----------------------	--	---	--	---

IMPORTANT NOTICES

- This information is given as a guide only and its accuracy cannot be guaranteed. Services or recent additions to the network may not be shown.
- Cables, overhead lines & substations owned by other electricity network owners or private companies may be present and may not be shown.
- You should always verify exact locations of cables using a cable locator and by careful use of hand tools in accordance with HSE guidance note HSG47.
- When working within 10m of any overhead electric line you should follow the requirements of HSE Guidance Note GS6.
- For further advice on working near our electricity cables or lines, call our General Enquiries number.
- Advice should be sought from the National Grid Electricity Distribution General Enquiries team for any work that is to take place in proximity to 132kV underground cables and 132kV overhead lines.

Report damage immediately – KEEP EVERYONE AWAY FROM THE AREA
0800 6783 105

Crown Copyright © All Rights Reserved. Ordnance Survey Licence numbers: 100022432
NGED Copyright: This copy has been made by or with the authority of National Grid Electricity Distribution (NGED) pursuant to Section 47 of the Copyright Designs and Patents Act 1988 unless that Act provides a relevant exception to copyright the copy must not be copied without the prior permission of the copyright owner.

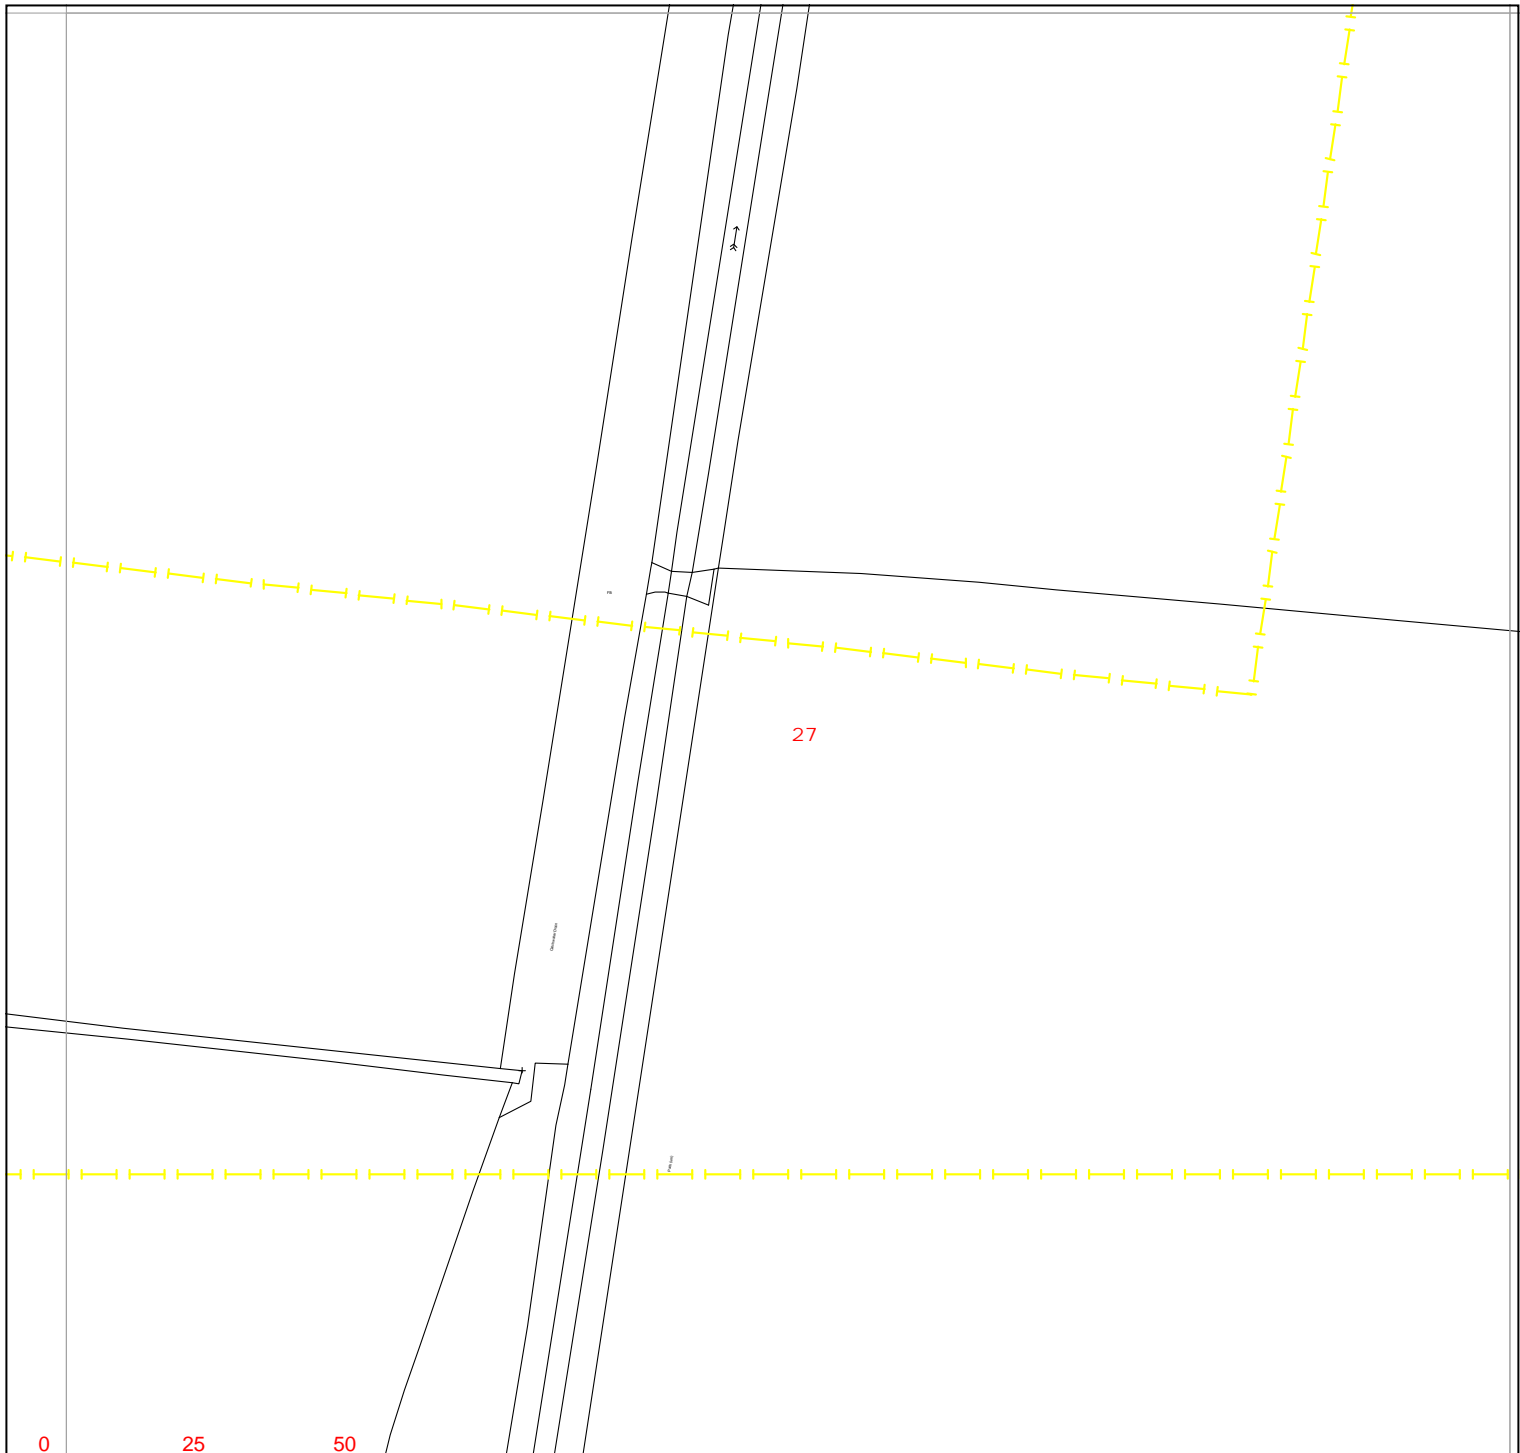

0 25 50
metres

Warning: PDF designed for colour print only with no page scaling.



Contact Us

Mapping Enquiries:
All areas 0121 623 9780

General Enquiries:
All areas 0800 096 3080

Date Requested: 08/05/2023
Job Reference: 29406941
Site Location: 479024 384047
Requested by:
Mr Ben Evans
Your Scheme/Reference:
LM 203570/DK - 6

Exact Scales:
1:1250 Area or Circle dig site
1:500 Line dig site


Link Box	Overhead Line	Underground Cable	National Grid Telecoms	Pilot Cables
●	<ul style="list-style-type: none"> ○ PL ○ Service ○ LV ○ HV (11kV) ○ HV (33kV) ○ HV (66kV) ○ HV (132kV) 	<ul style="list-style-type: none"> --- --- --- --- --- --- --- 	<ul style="list-style-type: none"> --- PME Earth ---E Underground Earth 	<ul style="list-style-type: none"> ○ Pole Mounted Transformer □ Ground Mounted Transformer
Site Location Line/Area	<ul style="list-style-type: none"> --- --- --- --- --- --- --- 			

IMPORTANT NOTICES

- This information is given as a guide only and its accuracy cannot be guaranteed. Services or recent additions to the network may not be shown.
- Cables, overhead lines & substations owned by other electricity network owners or private companies may be present and may not be shown.
- You should always verify exact locations of cables using a cable locator and by careful use of hand tools in accordance with HSE guidance note HSG47.
- When working within 10m of any overhead electric line you should follow the requirements of HSE Guidance Note GS6.
- For further advice on working near our electricity cables or lines, call our General Enquiries number.
- Advice should be sought from the National Grid Electricity Distribution General Enquiries team for any work that is to take place in proximity to 132kV underground cables and 132kV overhead lines.

Report damage immediately – KEEP EVERYONE AWAY FROM THE AREA
0800 6783 105

Crown Copyright © All Rights Reserved. Ordnance Survey Licence numbers: 100022432
NGED Copyright: This copy has been made by or with the authority of National Grid Electricity Distribution (NGED) pursuant to Section 47 of the Copyright Designs and Patents Act 1988 unless that Act provides a relevant exception to copyright the copy must not be copied without the prior permission of the copyright owner.

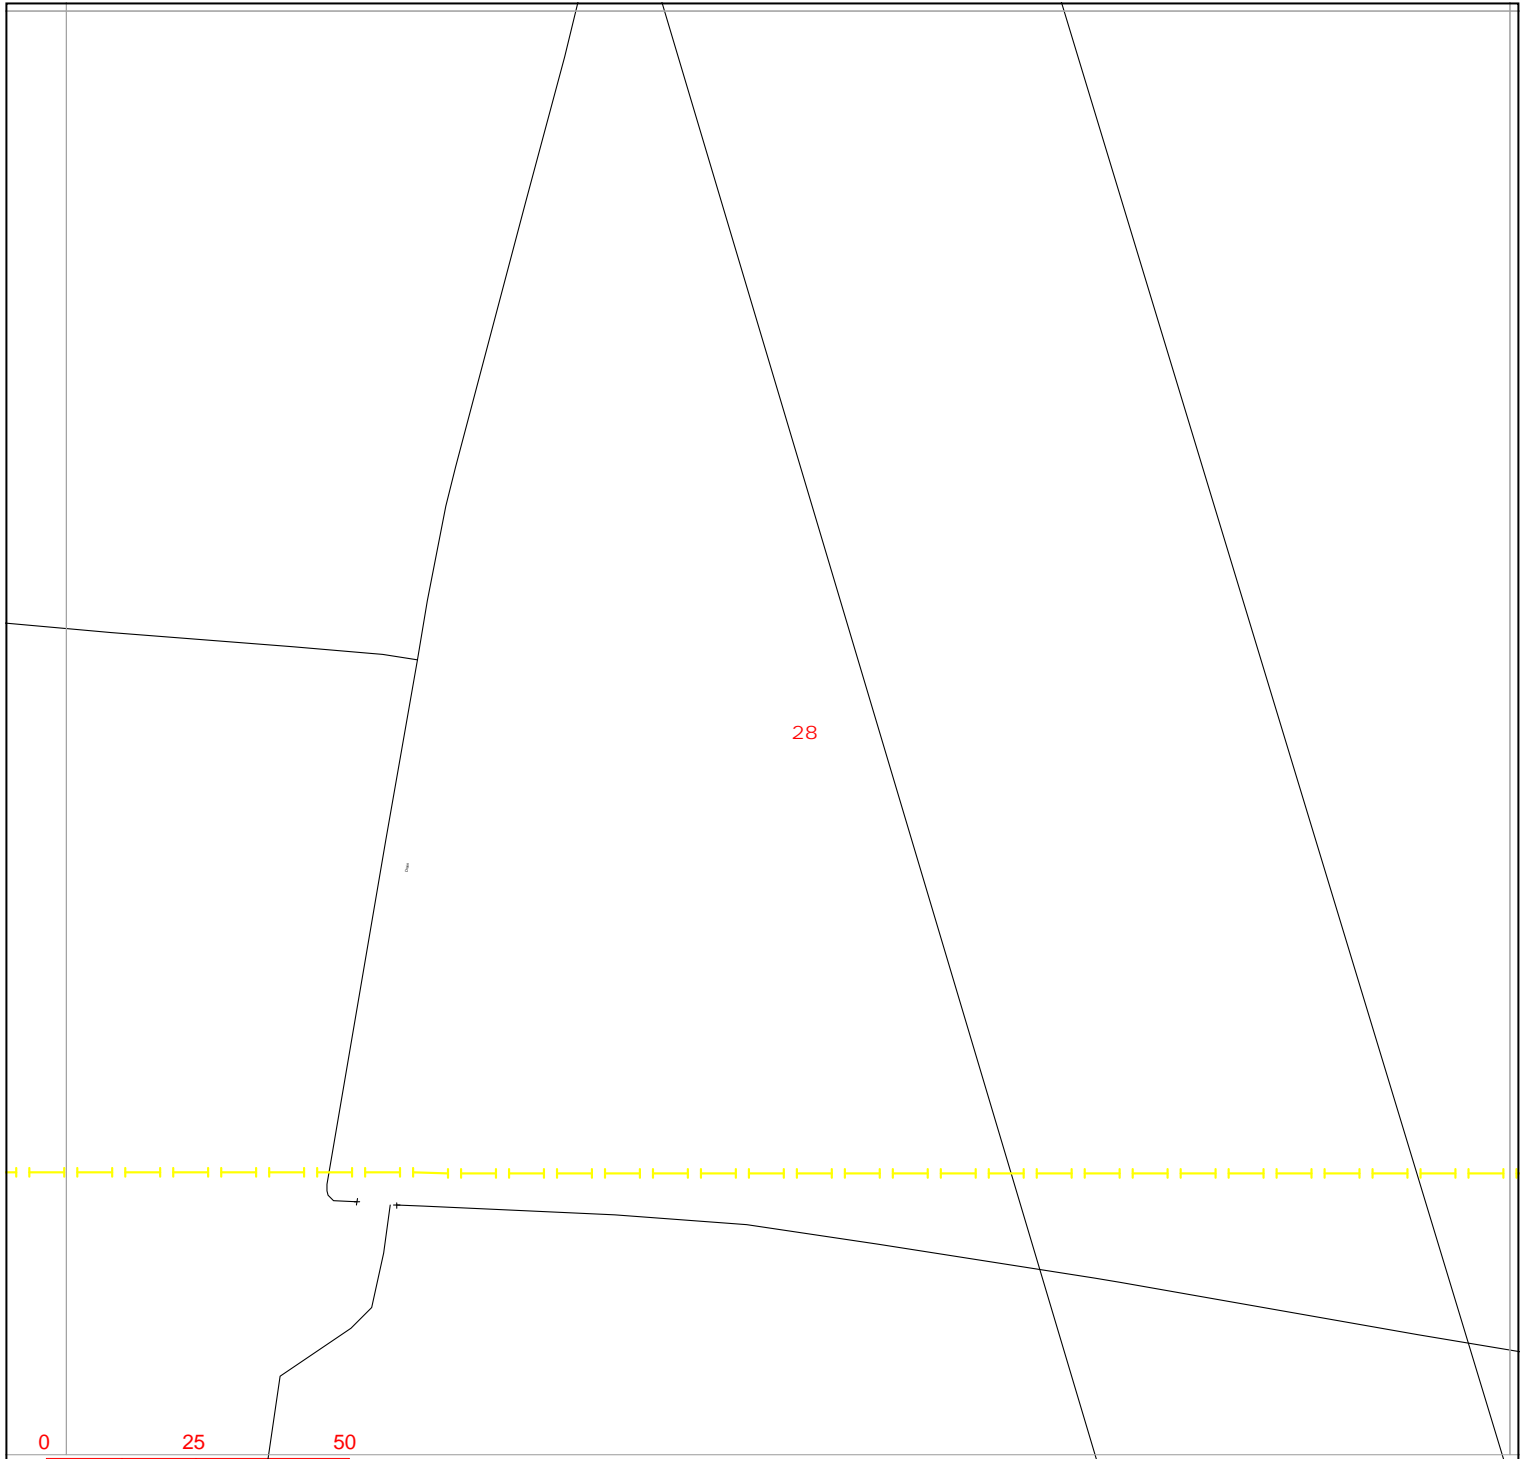

Warning: PDF designed for colour print only with no page scaling.

nationalgrid Electricity Distribution

Contact Us
All areas 0121 623 9780

Mapping Enquiries:
All areas 0121 623 9780

General Enquiries:
All areas 0800 096 3080

Date Requested: 08/05/2023
Job Reference: 29406941
Site Location: 479024 384047
Requested by:
Mr Ben Evans
Your Scheme/Reference:
LM 203570/DK - 6

Exact Scales:
1:1250 Area or Circle dig site
1:500 Line dig site

Link Box ●	Overhead Line ○—○ PL ○—○ Service ○—○ LV ○—○ HV (11kV) ○—○ HV (33kV) ○—○ HV (66kV) ○—○ HV (132kV)	Underground Cable -	National Grid Telecoms - - - - - PME Earth -E- - - - - Underground Earth	Pilot Cables ○ Pole Mounted Transformer □ Ground Mounted Transformer
----------------------	--	--	---	---


IMPORTANT NOTICES

- This information is given as a guide only and its accuracy cannot be guaranteed. Services or recent additions to the network may not be shown.
- Cables, overhead lines & substations owned by other electricity network owners or private companies may be present and may not be shown.
- You should always verify exact locations of cables using a cable locator and by careful use of hand tools in accordance with HSE guidance note HSG47.
- When working within 10m of any overhead electric line you should follow the requirements of HSE Guidance Note GS6.
- For further advice on working near our electricity cables or lines, call our General Enquiries number.
- Advice should be sought from the National Grid Electricity Distribution General Enquiries team for any work that is to take place in proximity to 132kV underground cables and 132kV overhead lines.

Report damage immediately – KEEP EVERYONE AWAY FROM THE AREA
0800 6783 105

Crown Copyright © All Rights Reserved. Ordnance Survey Licence numbers: 100022432
NGED Copyright: This copy has been made by or with the authority of National Grid Electricity Distribution (NGED) pursuant to Section 47 of the Copyright Designs and Patents Act 1988 unless that Act provides a relevant exception to copyright the copy must not be copied without the prior permission of the copyright owner.

29

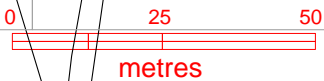

Warning: PDF designed for colour print only with no page scaling.




Contact Us

Mapping Enquiries:
All areas 0121 623 9780

General Enquiries:
All areas 0800 096 3080

Date Requested: 08/05/2023
Job Reference: 29406941
Site Location: 479024 384047
Requested by:
Mr Ben Evans
Your Scheme/Reference:
LM 203570/DK - 6

Exact Scales:
1:1250 Area or Circle dig site
1:500 Line dig site

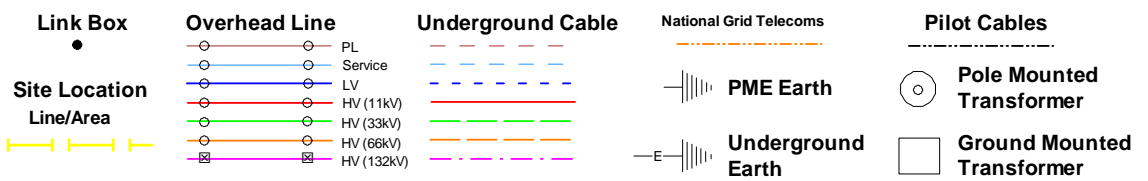


IMPORTANT NOTICES

- This information is given as a guide only and its accuracy cannot be guaranteed. Services or recent additions to the network may not be shown.
- Cables, overhead lines & substations owned by other electricity network owners or private companies may be present and may not be shown.
- You should always verify exact locations of cables using a cable locator and by careful use of hand tools in accordance with HSE guidance note HSG47.
- When working within 10m of any overhead electric line you should follow the requirements of HSE Guidance Note GS6.
- For further advice on working near our electricity cables or lines, call our General Enquiries number.
- Advice should be sought from the National Grid Electricity Distribution General Enquiries team for any work that is to take place in proximity to 132kV underground cables and 132kV overhead lines.

Report damage immediately – KEEP EVERYONE AWAY FROM THE AREA
0800 6783 105

Crown Copyright © All Rights Reserved. Ordnance Survey Licence numbers: 100022432
NGED Copyright: This copy has been made by or with the authority of National Grid Electricity Distribution (NGED) pursuant to Section 47 of the Copyright Designs and Patents Act 1988 unless that Act provides a relevant exception to copyright the copy must not be copied without the prior permission of the copyright owner.

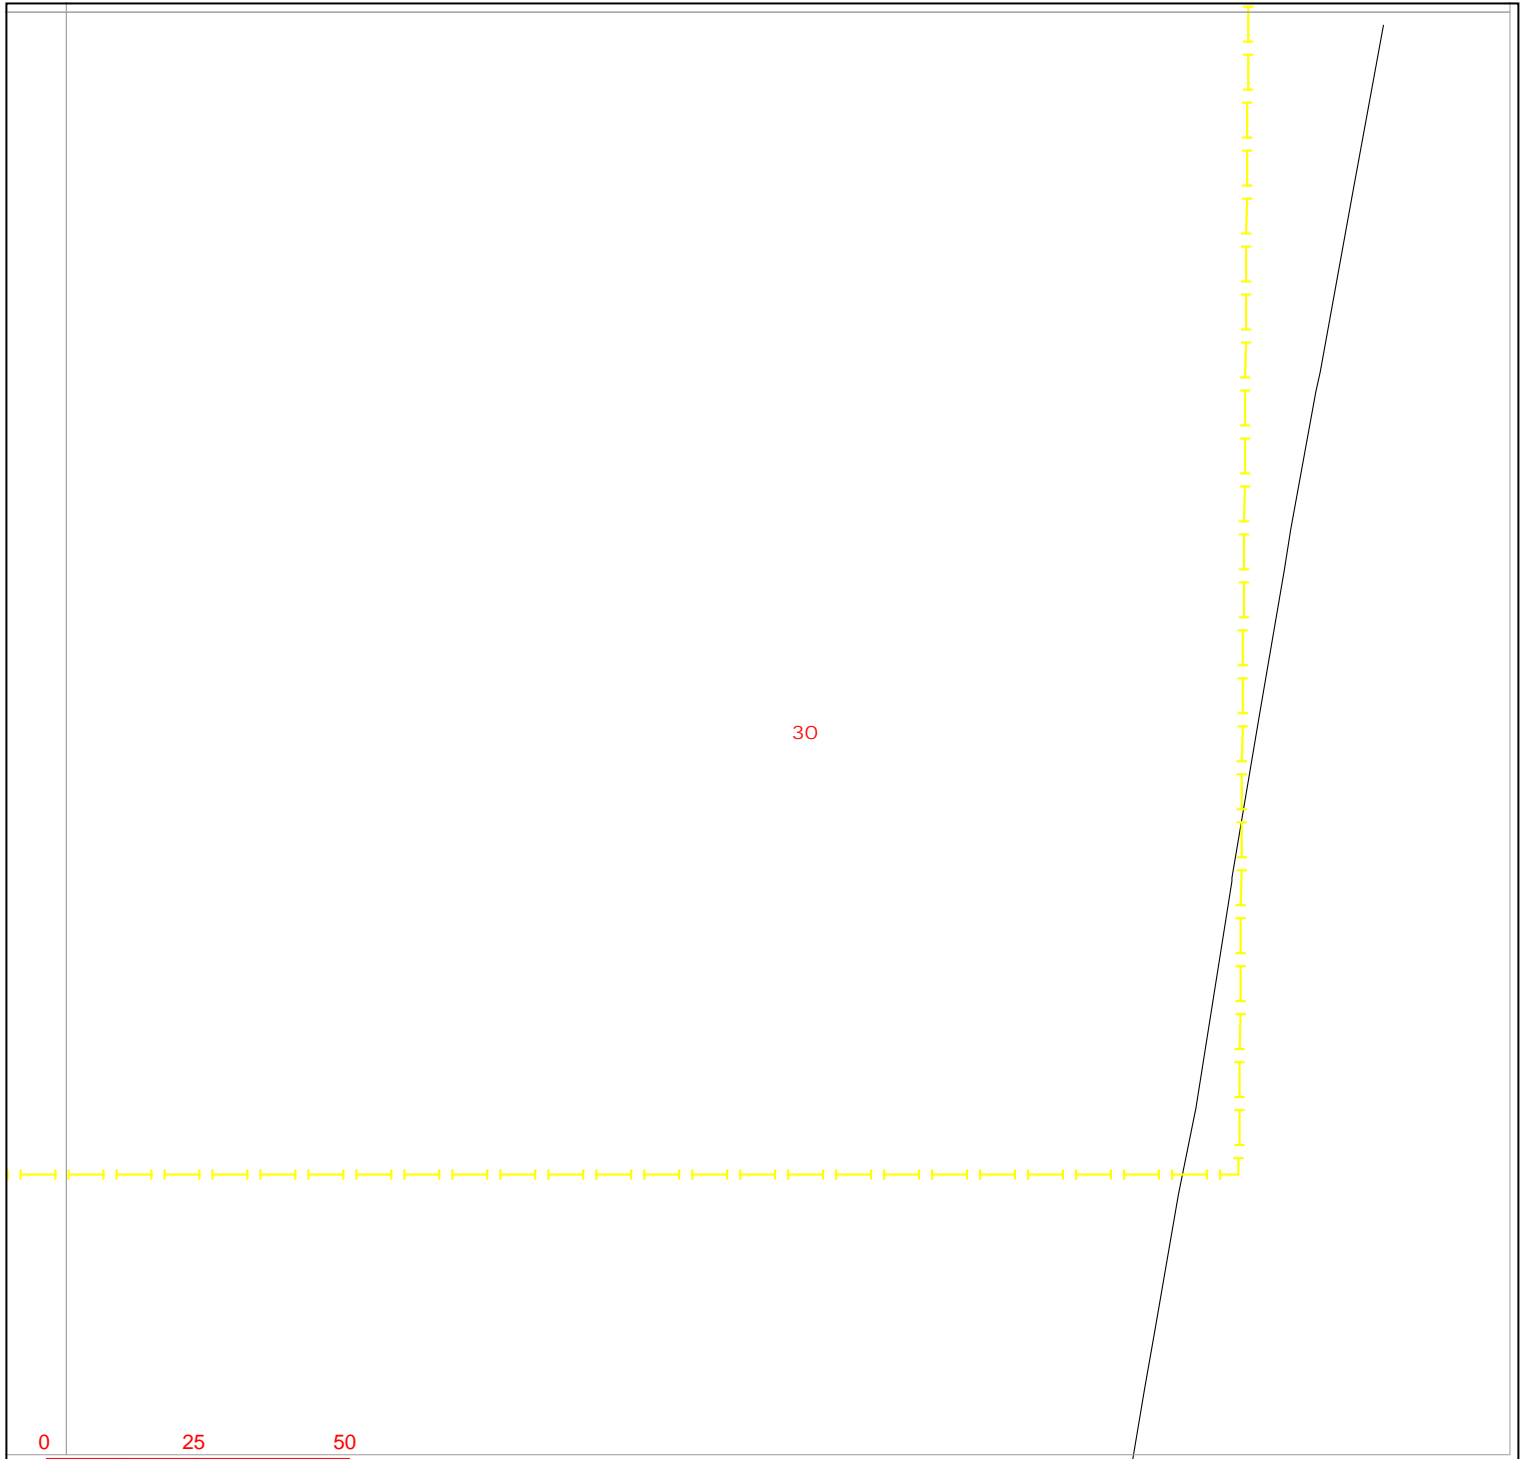

0 25 50
metres

Warning: PDF designed for colour print only with no page scaling.



Contact Us

Mapping Enquiries:
 All areas 0121 623 9780

General Enquiries:
 All areas 0800 096 3080

Date Requested: 08/05/2023
 Job Reference: 29406941
 Site Location: 479024 384047
 Requested by:
 Mr Ben Evans
 Your Scheme/Reference:
 LM 203570/DK - 6

Exact Scales:
 1:1250 Area or Circle dig site
 1:500 Line dig site


<p>Link Box ●</p> <p>Site Location Line/Area</p>	<p>Overhead Line</p> <ul style="list-style-type: none"> PL Service LV HV (11kV) HV (33kV) HV (66kV) HV (132kV) 	<p>Underground Cable</p> <ul style="list-style-type: none"> PL Service LV HV (11kV) HV (33kV) HV (66kV) HV (132kV) 	<p>National Grid Telecoms</p> <ul style="list-style-type: none"> National Grid Telecoms PME Earth Underground Earth 	<p>Pilot Cables</p> <ul style="list-style-type: none"> Pole Mounted Transformer Ground Mounted Transformer
---	---	---	--	---

IMPORTANT NOTICES

- This information is given as a guide only and its accuracy cannot be guaranteed. Services or recent additions to the network may not be shown.
- Cables, overhead lines & substations owned by other electricity network owners or private companies may be present and may not be shown.
- You should always verify exact locations of cables using a cable locator and by careful use of hand tools in accordance with HSE guidance note HSG47.
- When working within 10m of any overhead electric line you should follow the requirements of HSE Guidance Note GS6.
- For further advice on working near our electricity cables or lines, call our General Enquiries number.
- Advice should be sought from the National Grid Electricity Distribution General Enquiries team for any work that is to take place in proximity to 132kV underground cables and 132kV overhead lines.

Report damage immediately – KEEP EVERYONE AWAY FROM THE AREA
0800 6783 105

Crown Copyright © All Rights Reserved. Ordnance Survey Licence numbers: 100022432
 NGED Copyright: This copy has been made by or with the authority of National Grid Electricity Distribution (NGED) pursuant to Section 47 of the Copyright Designs and Patents Act 1988 unless that Act provides a relevant exception to copyright the copy must not be copied without the prior permission of the copyright owner.

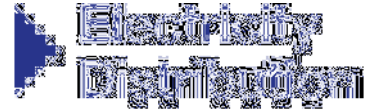

Our Ref: 29406942 Your Ref: LM 203570/DK - 7

Monday, 08 May 2023

Ben Evans
The Hub, 500 Park Avenue, Aztec West
Almondsbury
Bristol
BS32 4RZ

**National Grid Electricity
Distribution**
Mapping Centre
Toll End Road
Tipton
West Midlands
United Kingdom
DY4 0HH
www.nationalgrid.co.uk

Dear Ben Evans

Thank you for your enquiry dated Monday, 08 May 2023

I now enclose a copy of our plan showing existing National Grid Electricity Distribution (NGED) Electricity / National Grid Telecoms (NGT) apparatus in the vicinity of your proposed works. This information is given as a general guide only and its accuracy cannot be guaranteed. Please note that all NGED equipment on site should be assumed to be LIVE until NGED prove otherwise and provide you with confirmation to this effect in writing. Recent additions to our network, or service connections between the main cable and a building or street lamp may not be shown.

Map Response
T 0121 623 9780
NGED.MapResponse
@nationalgrid.co.uk

Damage to underground cables and contact with overhead lines can cause severe injury or may prove fatal. If you are excavating on site in the vicinity of either NGED Electrical apparatus or NGT Telecoms apparatus you must comply with the requirements of the following:-

Health & Safety Executive guidance HS(G)47, Avoiding Danger from underground services.

Work taking place in the vicinity of our plant is also regulated under the:-

Electricity at Work Regulations 1989, Health and Safety Act 1974, CDM Regulations 2015.
Safe working procedures should be defined and practiced

Please ensure that the use of mechanical excavators in the vicinity of our plant is kept to a minimum. NGT Telecoms ducts contain fibre cables, which are expensive to repair. Therefore, extreme care must be taken whilst working in the vicinity of these ducts, hand digging methods being used to determine their precise position.

If there are overhead lines crossing your site and your proposal involves building works which may infringe the clearance to our overhead system then you should call the relevant general enquiries number (see page 2 of this letter) for advice. Where overhead lines cross your site you must comply with the requirements of Health & Safety Executive guidance as laid down in GS6, Avoidance of Danger from Overhead Electric Lines.

National Grid Electricity
Distribution
South West - 02366894
South Wales - 02366985
East Midlands - 02366923
West Midlands - 03600574

Where diversions to NGED apparatus are needed to allow change to occur on site, the cost of these alterations may be charged to the persons responsible for the works.

If you require advice in connection with your proposals please contact the relevant general enquiries number (see page 2 of this letter)

Registered in
England and Wales


Following consultation the local NGED team will where necessary prepare detailed proposals and provide a quotation for any necessary alterations and/or development of our equipment on the site.

Registered Office:
Avonbank
Feeder Road
Bristol
BS2 0TB

This information is given as a guide only and its accuracy cannot be guaranteed. This plan is based on data from our Geographic Information System, which is updated every 24 hours to reflect changes to our network. The information contained in this plan reflects the most recent network GIS data, however changes to the network (including network additions and new service

Safety Documents:

<https://www.nationalgrid.co.uk/customers-and-community/health-safety/public-safety-advice>

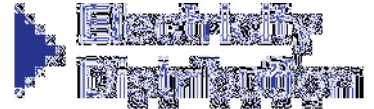

connections) may not be shown. You are advised to obtain an up to date plan on the date of commencing on-site works.

Yours sincerely
NGED Map Response Team

Contact Us

Emergency or Power Supply issues

In an emergency call 105, 24 hours a day.

Mapping Enquiries

If you have an enquiry relating to this letter or the attached map plan, please contact us using the following information:

Telephone 0121 623 9780
Email NGED.MapResponse@nationalgrid.co.uk

General Enquiries


If you have a general enquiry, please call us on the following telephone number:

All areas 0800 096 3080

LSBUD

If you have an enquiry relating to the use of the LSBUD website please contact LSBUD using the following information:

Telephone 0345 437 7365
Email enquiries@LSBUD.co.uk
Website www.LSBUD.co.uk

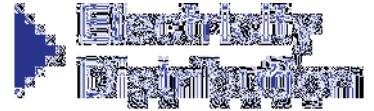


Steps to help keep you safe

- **If you are working within 10 metres of our 33kV, 66kV, 132kV underground electricity cables or within 10 meters of an overhead electricity line you should call the relevant General Enquiries for free safety advice.**

Safety Documents – please download our informative safety documents to help ensure that you, your staff and the public are kept safe whilst working in the vicinity of electricity.

<https://www.nationalgrid.co.uk/customers-and-community/health-safety/public-safety-advice>

- **Make sure you have up to date plans** - remember that recent additions to our network or service connections between the main cable and a building or street lamp may not be shown.
- **Look for signs of service cables** - an electricity meter box or nearby streetlamp may give you an indication that service cables are present in your area of work.
- **Non NGED Network** - electricity cables, lines and equipment owned by others may also be present in addition to NGED network. They are unlikely to be shown on our plans.
- **Use a cable locator** - trace electricity cables and mark the position of them using paint or other waterproof marking on the ground.
- **Hand dig trial holes** - to confirm the position of cables in close proximity to your area of your work and use spades and shovels rather than picks, pins or forks.
- **Have an emergency plan** - so that everyone working on site understands what to do in the event of an underground electricity cable being damaged or contact being made with an overhead electricity line.
- **If you are working within 10 meters** of an overhead electricity line then it may be necessary for you to erect warning signs and markers, or height restriction goal posts. Ensure that you comply with the requirements of Health & Safety Executive guidance laid down in GS6, Avoidance of Danger from Overhead Electric Lines.
- **If you are erecting a structure** that could allow anyone standing on it, or its access device (ladder, scaffold, MEWP), to come within 3m of any overhead electric line then **you must inform us**. This is your duty and a legal requirement under the Electricity Safety, Quality & Continuity Regulations 2002.
- **If you cannot work safely** around the underground electricity cable or overhead electricity line, then you may need to get it moved to allow your works to go ahead. Call the general enquiry numbers above for guidance.
- **It is possible that cables or pipes may be embedded in concrete** - electricity cables embedded in concrete **MUST** be made 'dead' by Western Power Distribution or the cable owner before the concrete is broken out. Alternatively, another safe way of working should be agreed.
- **Cables are sometimes covered by tiles or a marker tape** - these can be concrete, polythene or earthenware and are a useful early warning of the presence of cables; you should avoid disturbing any tiles or tape to expose the cable. Not all cables have these warning indicators.

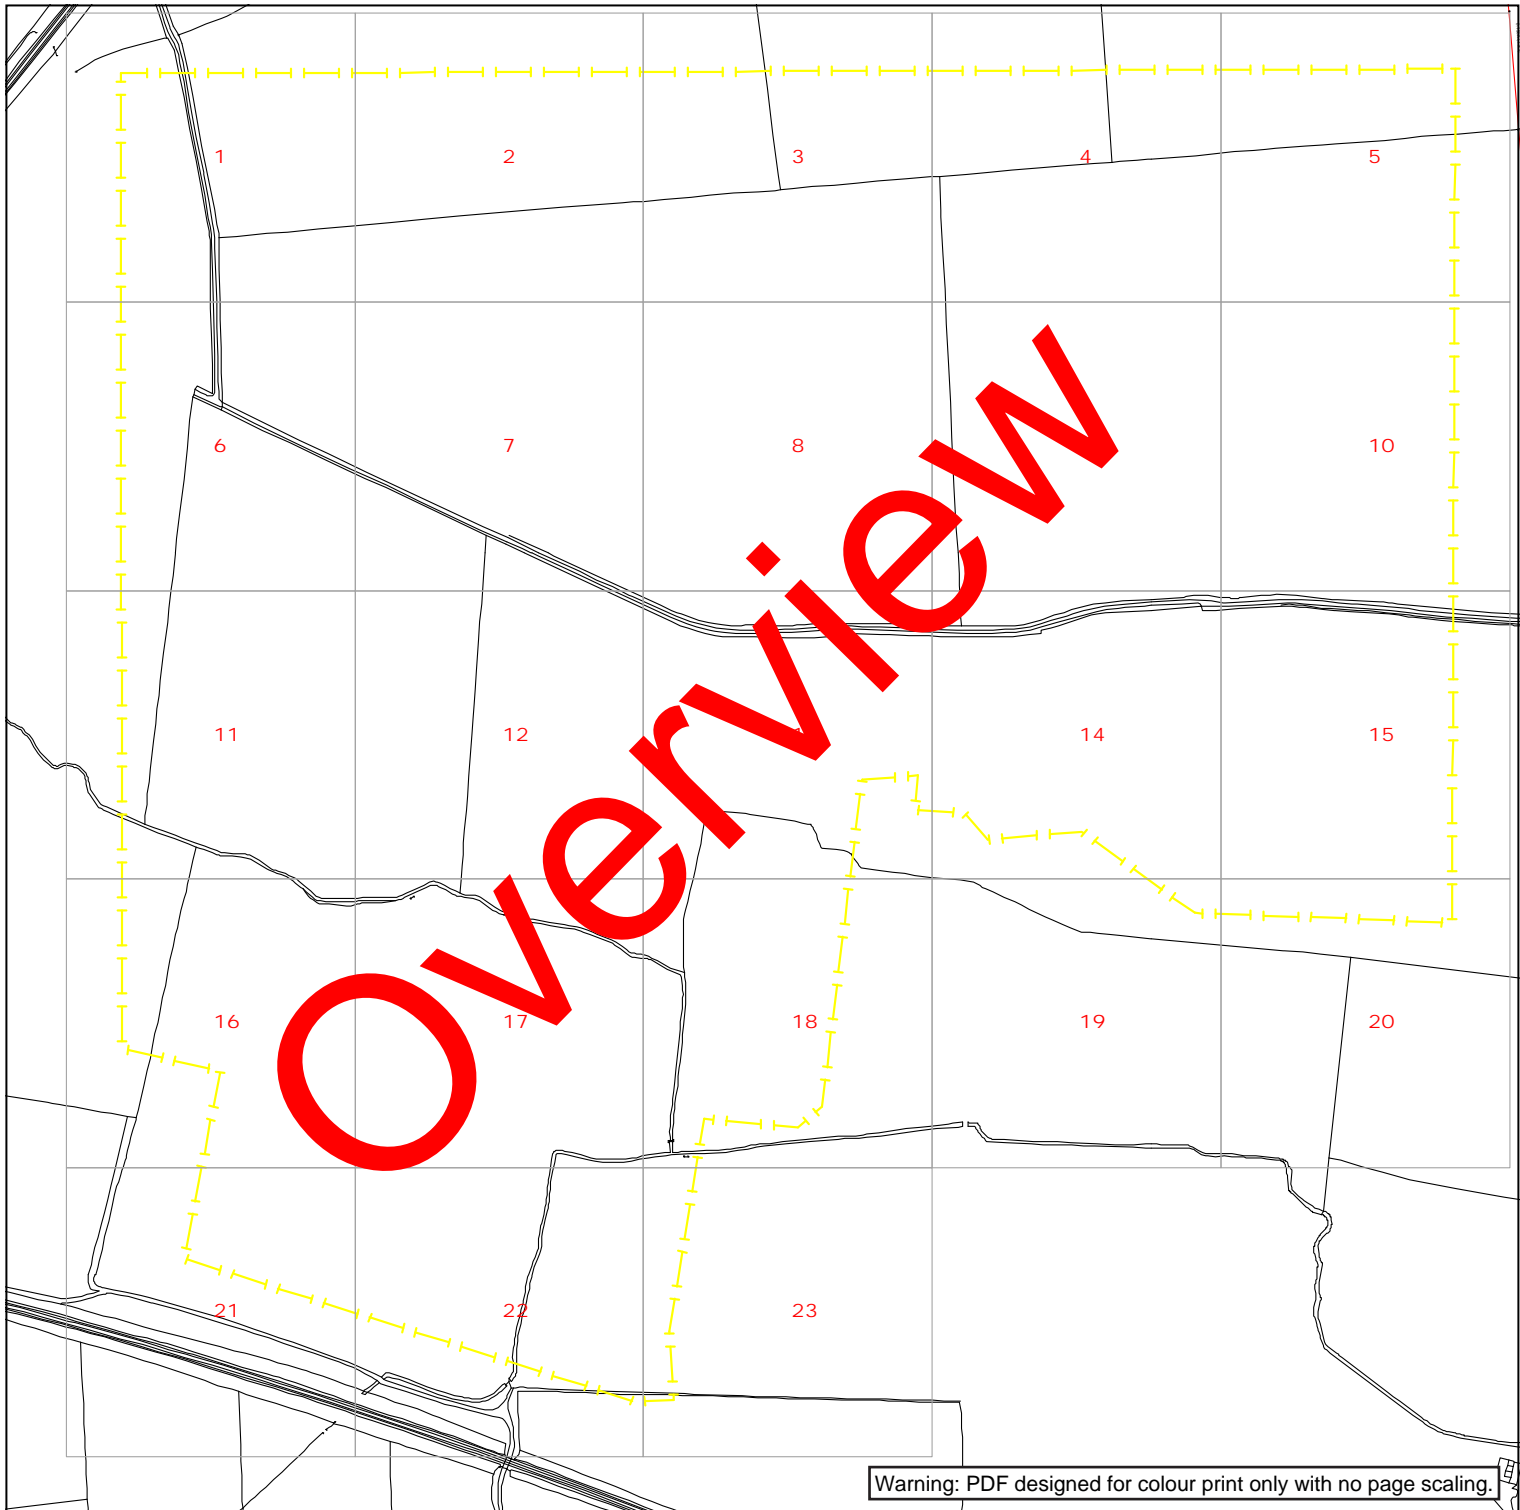

Warning: PDF designed for colour print only with no page scaling.

nationalgrid Electricity Distribution

Contact Us

Mapping Enquiries:
All areas 0121 623 9780

General Enquiries:
All areas 0800 096 3080

Date Requested: 08/05/2023
Job Reference: 29406942
Site Location: 477702 382850
Requested by:
Mr Ben Evans
Your Scheme/Reference:
LM 203570/DK - 7


Link Box ●	Overhead Line ○—○ PL ○—○ Service ○—○ LV ○—○ HV (11kV) ○—○ HV (33kV) ○—○ HV (66kV) ○—○ HV (132kV)	Underground Cable -	National Grid Telecoms - - - - - PME Earth Underground Earth	Pilot Cables ○ Pole Mounted Transformer □ Ground Mounted Transformer
----------------------	--	---	--	---

IMPORTANT NOTICES

- This information is given as a guide only and its accuracy cannot be guaranteed. Services or recent additions to the network may not be shown.
- Cables, overhead lines & substations owned by other electricity network owners or private companies may be present and may not be shown.
- You should always verify exact locations of cables using a cable locator and by careful use of hand tools in accordance with HSE guidance note HSG47.
- When working within 10m of any overhead electric line you should follow the requirements of HSE Guidance Note GS6.
- For further advice on working near our electricity cables or lines, call our General Enquiries number.
- Advice should be sought from the National Grid Electricity Distribution General Enquiries team for any work that is to take place in proximity to 132kV underground cables and 132kV overhead lines.

Report damage immediately – KEEP EVERYONE AWAY FROM THE AREA
0800 6783 105

Crown Copyright © All Rights Reserved. Ordnance Survey Licence numbers: 100022432
NGED Copyright: This copy has been made by or with the authority of National Grid Electricity Distribution (NGED) pursuant to Section 47 of the Copyright Designs and Patents Act 1988 unless that Act provides a relevant exception to copyright the copy must not be copied without the prior permission of the copyright owner.

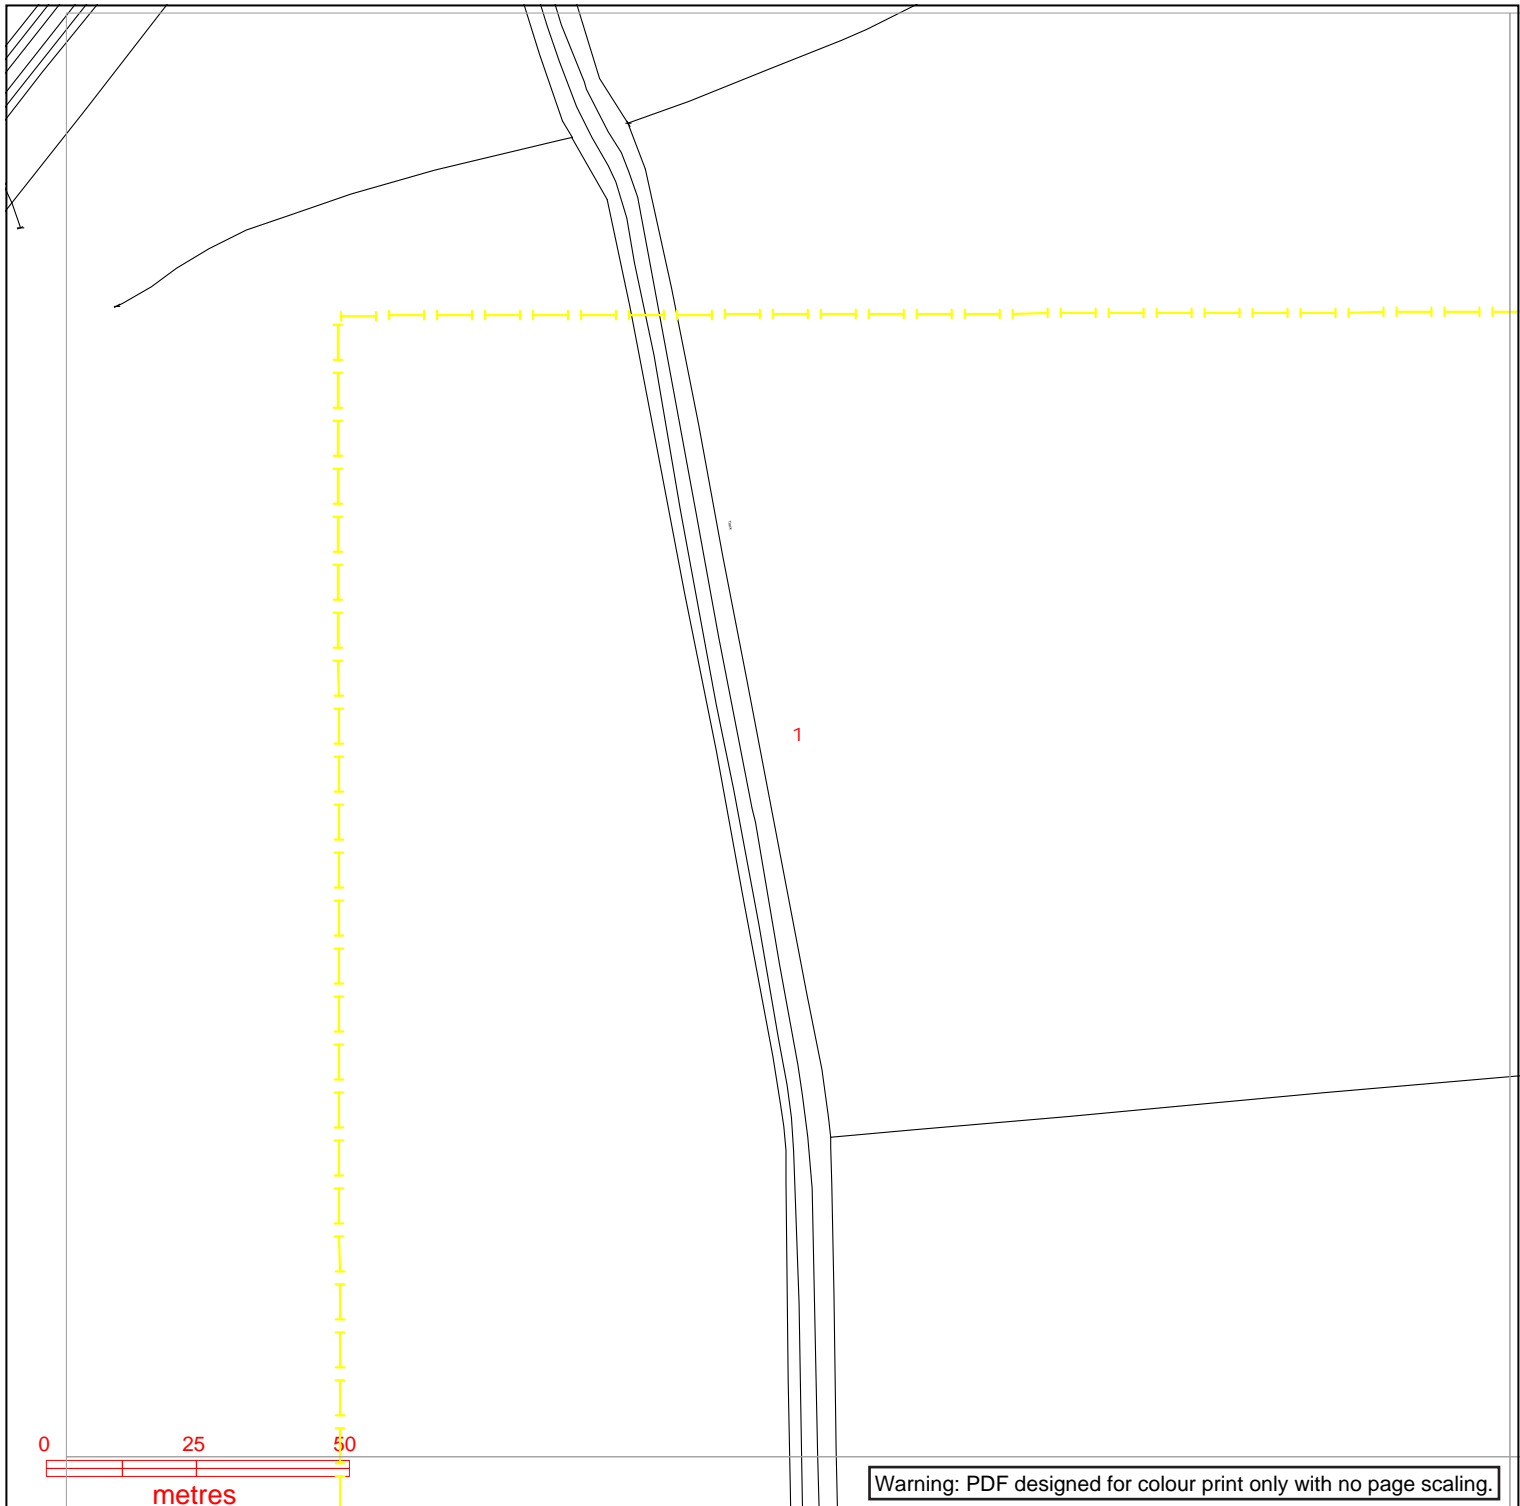

Warning: PDF designed for colour print only with no page scaling.

nationalgrid Electricity Distribution

Contact Us

Mapping Enquiries:
All areas 0121 623 9780

General Enquiries:
All areas 0800 096 3080

Date Requested: 08/05/2023
Job Reference: 29406942
Site Location: 477702 382850
Requested by:
Mr Ben Evans
Your Scheme/Reference:
LM 203570/DK - 7

Exact Scales:
1:1250 Area or Circle dig site
1:500 Line dig site


Link Box ●	Overhead Line ○—○ PL ○—○ Service ○—○ LV ○—○ HV (11kV) ○—○ HV (33kV) ○—○ HV (66kV) ○—○ HV (132kV)	Underground Cable -	National Grid Telecoms - - - - - PME Earth -E- - - - - Underground Earth	Pilot Cables ○ Pole Mounted Transformer □ Ground Mounted Transformer
----------------------	--	---	---	---

IMPORTANT NOTICES

- This information is given as a guide only and its accuracy cannot be guaranteed. Services or recent additions to the network may not be shown.
- Cables, overhead lines & substations owned by other electricity network owners or private companies may be present and may not be shown.
- You should always verify exact locations of cables using a cable locator and by careful use of hand tools in accordance with HSE guidance note HSG47.
- When working within 10m of any overhead electric line you should follow the requirements of HSE Guidance Note GS6.
- For further advice on working near our electricity cables or lines, call our General Enquiries number.
- Advice should be sought from the National Grid Electricity Distribution General Enquiries team for any work that is to take place in proximity to 132kV underground cables and 132kV overhead lines.

Report damage immediately – KEEP EVERYONE AWAY FROM THE AREA
0800 6783 105

Crown Copyright © All Rights Reserved. Ordnance Survey Licence numbers: 100022432
NGED Copyright: This copy has been made by or with the authority of National Grid Electricity Distribution (NGED) pursuant to Section 47 of the Copyright Designs and Patents Act 1988 unless that Act provides a relevant exception to copyright the copy must not be copied without the prior permission of the copyright owner.

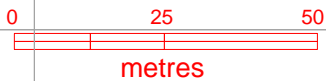

Warning: PDF designed for colour print only with no page scaling.




Contact Us

Mapping Enquiries:
All areas 0121 623 9780

General Enquiries:
All areas 0800 096 3080

Date Requested: 08/05/2023
Job Reference: 29406942
Site Location: 477702 382850
Requested by:
Mr Ben Evans
Your Scheme/Reference:
LM 203570/DK - 7

Exact Scales:
1:1250 Area or Circle dig site
1:500 Line dig site

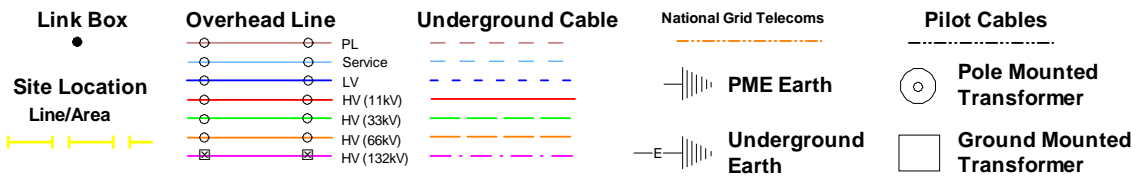


IMPORTANT NOTICES

- This information is given as a guide only and its accuracy cannot be guaranteed. Services or recent additions to the network may not be shown.
- Cables, overhead lines & substations owned by other electricity network owners or private companies may be present and may not be shown.
- You should always verify exact locations of cables using a cable locator and by careful use of hand tools in accordance with HSE guidance note HSG47.
- When working within 10m of any overhead electric line you should follow the requirements of HSE Guidance Note GS6.
- For further advice on working near our electricity cables or lines, call our General Enquiries number.
- Advice should be sought from the National Grid Electricity Distribution General Enquiries team for any work that is to take place in proximity to 132kV underground cables and 132kV overhead lines.

Report damage immediately – KEEP EVERYONE AWAY FROM THE AREA
0800 6783 105

Crown Copyright © All Rights Reserved. Ordnance Survey Licence numbers: 100022432
NGED Copyright: This copy has been made by or with the authority of National Grid Electricity Distribution (NGED) pursuant to Section 47 of the Copyright Designs and Patents Act 1988 unless that Act provides a relevant exception to copyright the copy must not be copied without the prior permission of the copyright owner.

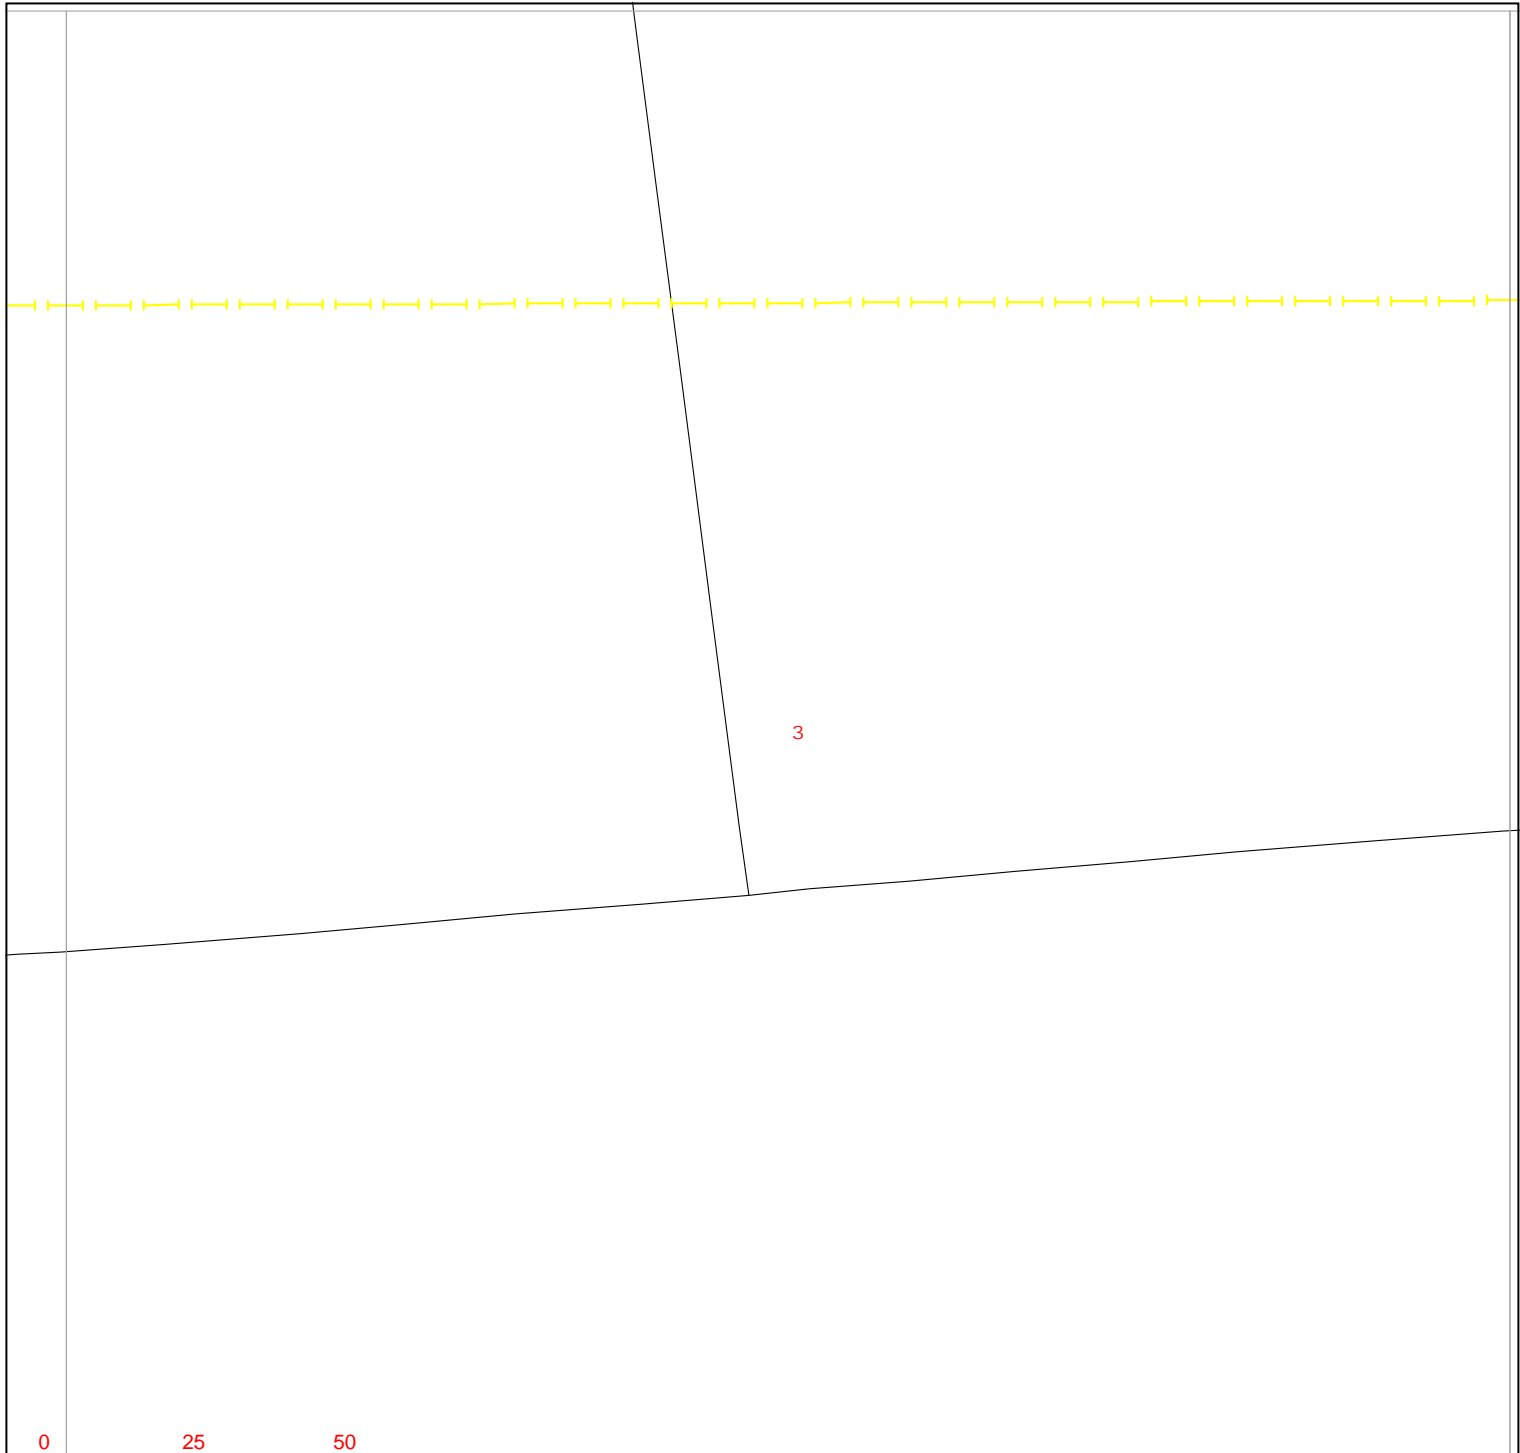

Warning: PDF designed for colour print only with no page scaling.

nationalgrid Electricity Distribution

Contact Us

Mapping Enquiries:
All areas 0121 623 9780

General Enquiries:
All areas 0800 096 3080

Date Requested: 08/05/2023
Job Reference: 29406942
Site Location: 477702 382850
Requested by:
Mr Ben Evans
Your Scheme/Reference:
LM 203570/DK - 7

Exact Scales:
1:1250 Area or Circle dig site
1:500 Line dig site


Link Box ●	Overhead Line ○—○ PL ○—○ Service ○—○ LV ○—○ HV (11kV) ○—○ HV (33kV) ○—○ HV (66kV) ○—○ HV (132kV)	Underground Cable -	National Grid Telecoms - - - - - PME Earth -E- - - - - Underground Earth	Pilot Cables ○ Pole Mounted Transformer □ Ground Mounted Transformer
----------------------	--	---	---	---

IMPORTANT NOTICES

- This information is given as a guide only and its accuracy cannot be guaranteed. Services or recent additions to the network may not be shown.
- Cables, overhead lines & substations owned by other electricity network owners or private companies may be present and may not be shown.
- You should always verify exact locations of cables using a cable locator and by careful use of hand tools in accordance with HSE guidance note HSG47.
- When working within 10m of any overhead electric line you should follow the requirements of HSE Guidance Note GS6.
- For further advice on working near our electricity cables or lines, call our General Enquiries number.
- Advice should be sought from the National Grid Electricity Distribution General Enquiries team for any work that is to take place in proximity to 132kV underground cables and 132kV overhead lines.

Report damage immediately – KEEP EVERYONE AWAY FROM THE AREA
0800 6783 105

Crown Copyright © All Rights Reserved. Ordnance Survey Licence numbers: 100022432
NGED Copyright: This copy has been made by or with the authority of National Grid Electricity Distribution (NGED) pursuant to Section 47 of the Copyright Designs and Patents Act 1988 unless that Act provides a relevant exception to copyright the copy must not be copied without the prior permission of the copyright owner.

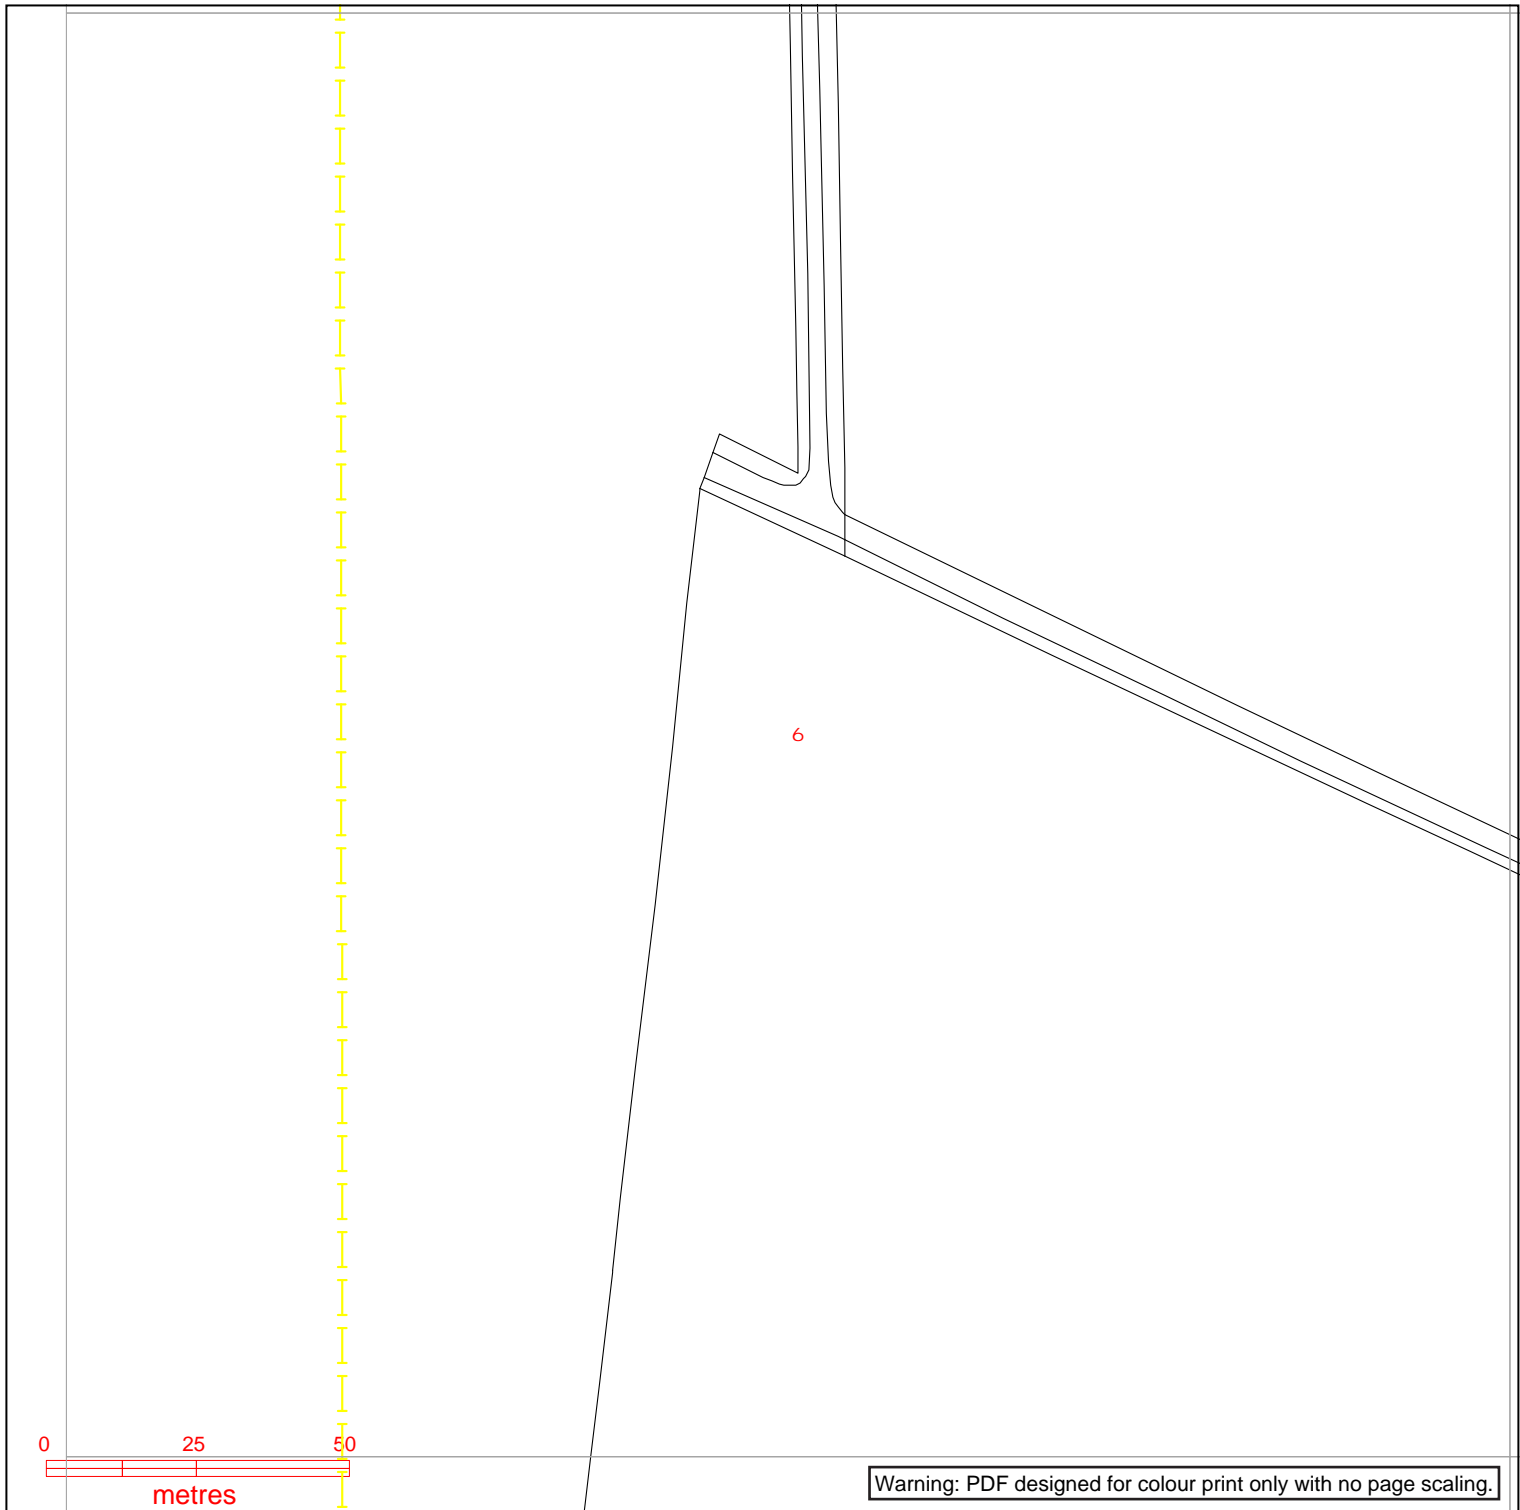

nationalgrid Electricity Distribution

Contact Us

Mapping Enquiries:
All areas 0121 623 9780

General Enquiries:
All areas 0800 096 3080

Date Requested: 08/05/2023
Job Reference: 29406942
Site Location: 477702 382850
Requested by:
Mr Ben Evans
Your Scheme/Reference:
LM 203570/DK - 7

Exact Scales:
1:1250 Area or Circle dig site
1:500 Line dig site


Link Box ●	Overhead Line ○ ○ PL ○ ○ Service ○ ○ LV ○ ○ HV (11kV) ○ ○ HV (33kV) ○ ○ HV (66kV) ○ ○ HV (132kV)	Underground Cable -	National Grid Telecoms - - - - - PME Earth -E- - - - - Underground Earth	Pilot Cables - - - - - ○ Pole Mounted Transformer □ Ground Mounted Transformer
----------------------	--	---	---	--

IMPORTANT NOTICES

- This information is given as a guide only and its accuracy cannot be guaranteed. Services or recent additions to the network may not be shown.
- Cables, overhead lines & substations owned by other electricity network owners or private companies may be present and may not be shown.
- You should always verify exact locations of cables using a cable locator and by careful use of hand tools in accordance with HSE guidance note HSG47.
- When working within 10m of any overhead electric line you should follow the requirements of HSE Guidance Note GS6.
- For further advice on working near our electricity cables or lines, call our General Enquiries number.
- Advice should be sought from the National Grid Electricity Distribution General Enquiries team for any work that is to take place in proximity to 132kV underground cables and 132kV overhead lines.

Report damage immediately – KEEP EVERYONE AWAY FROM THE AREA
0800 6783 105

Crown Copyright © All Rights Reserved. Ordnance Survey Licence numbers: 100022432
NGED Copyright: This copy has been made by or with the authority of National Grid Electricity Distribution (NGED) pursuant to Section 47 of the Copyright Designs and Patents Act 1988 unless that Act provides a relevant exception to copyright the copy must not be copied without the prior permission of the copyright owner.

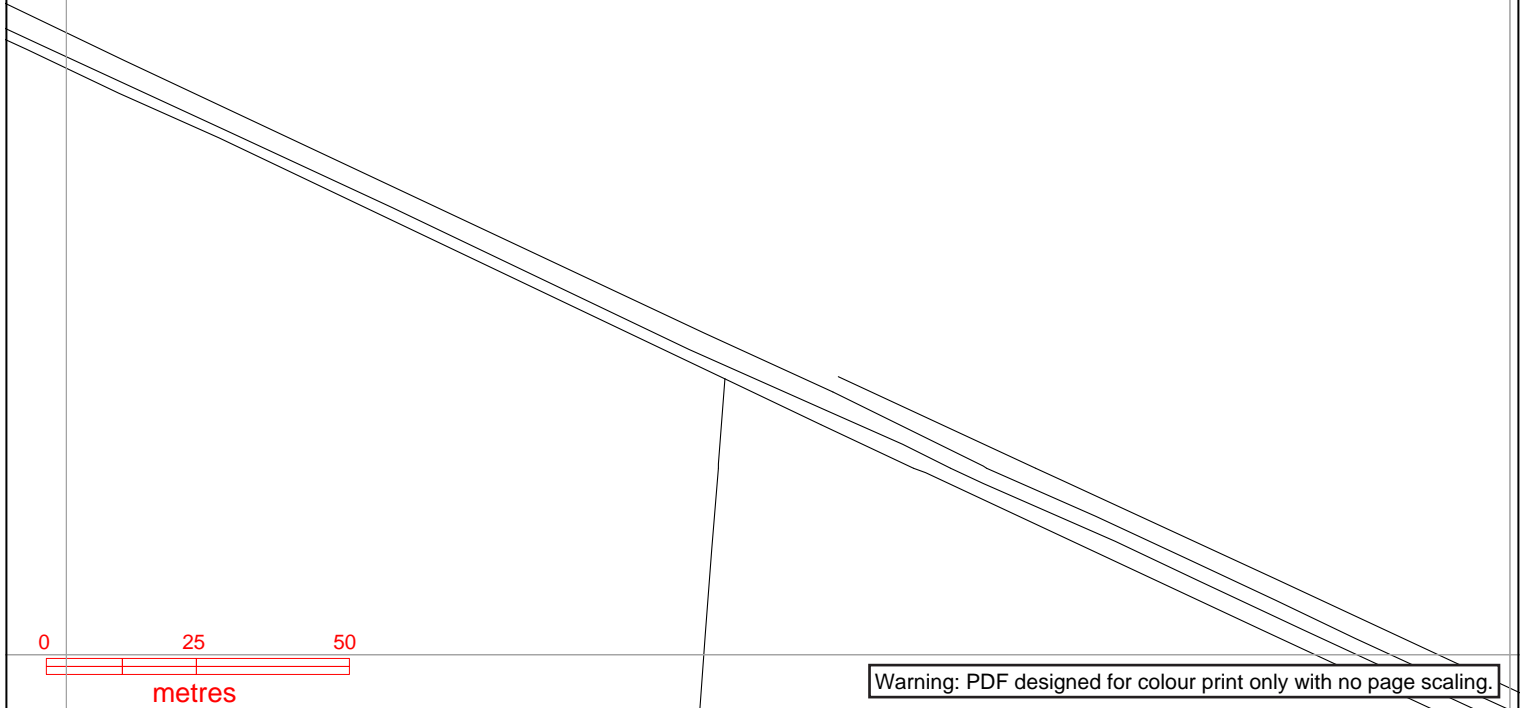

Contact Us

Mapping Enquiries:
All areas 0121 623 9780

General Enquiries:
All areas 0800 096 3080

Date Requested: 08/05/2023
Job Reference: 29406942
Site Location: 477702 382850
Requested by:
Mr Ben Evans
Your Scheme/Reference:
LM 203570/DK - 7

Exact Scales:
1:1250 Area or Circle dig site
1:500 Line dig site


Link Box ●	Overhead Line ○—○ PL ○—○ Service ○—○ LV ○—○ HV (11kV) ○—○ HV (33kV) ○—○ HV (66kV) ○—○ HV (132kV)	Underground Cable -	National Grid Telecoms - - - - - PME Earth -E- - - - - Underground Earth	Pilot Cables ○ Pole Mounted Transformer □ Ground Mounted Transformer
----------------------	--	---	---	---

IMPORTANT NOTICES

- This information is given as a guide only and its accuracy cannot be guaranteed. Services or recent additions to the network may not be shown.
- Cables, overhead lines & substations owned by other electricity network owners or private companies may be present and may not be shown.
- You should always verify exact locations of cables using a cable locator and by careful use of hand tools in accordance with HSE guidance note HSG47.
- When working within 10m of any overhead electric line you should follow the requirements of HSE Guidance Note GS6.
- For further advice on working near our electricity cables or lines, call our General Enquiries number.
- Advice should be sought from the National Grid Electricity Distribution General Enquiries team for any work that is to take place in proximity to 132kV underground cables and 132kV overhead lines.

Report damage immediately – KEEP EVERYONE AWAY FROM THE AREA
0800 6783 105

Crown Copyright © All Rights Reserved. Ordnance Survey Licence numbers: 100022432
NGED Copyright: This copy has been made by or with the authority of National Grid Electricity Distribution (NGED) pursuant to Section 47 of the Copyright Designs and Patents Act 1988 unless that Act provides a relevant exception to copyright the copy must not be copied without the prior permission of the copyright owner.

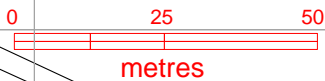

Warning: PDF designed for colour print only with no page scaling.




Contact Us
 All areas 0121 623 9780

Mapping Enquiries:
 All areas 0121 623 9780

General Enquiries:
 All areas 0800 096 3080

Date Requested: 08/05/2023
 Job Reference: 29406942
 Site Location: 477702 382850
 Requested by:
 Mr Ben Evans
 Your Scheme/Reference:
 LM 203570/DK - 7

Exact Scales:
 1:1250 Area or Circle dig site
 1:500 Line dig site

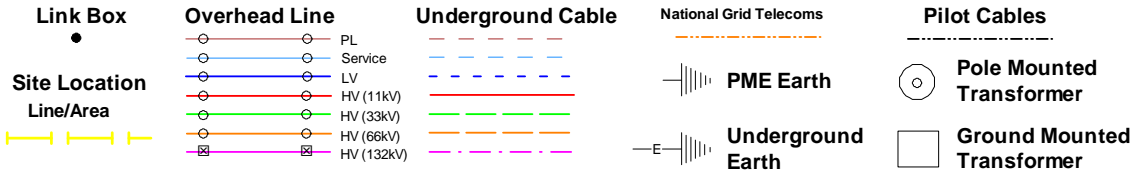

IMPORTANT NOTICES

- This information is given as a guide only and its accuracy cannot be guaranteed. Services or recent additions to the network may not be shown.
- Cables, overhead lines & substations owned by other electricity network owners or private companies may be present and may not be shown.
- You should always verify exact locations of cables using a cable locator and by careful use of hand tools in accordance with HSE guidance note HSG47.
- When working within 10m of any overhead electric line you should follow the requirements of HSE Guidance Note GS6.
- For further advice on working near our electricity cables or lines, call our General Enquiries number.
- Advice should be sought from the National Grid Electricity Distribution General Enquiries team for any work that is to take place in proximity to 132kV underground cables and 132kV overhead lines.

Report damage immediately – KEEP EVERYONE AWAY FROM THE AREA
0800 6783 105

Crown Copyright © All Rights Reserved. Ordnance Survey Licence numbers: 100022432
 NGED Copyright: This copy has been made by or with the authority of National Grid Electricity Distribution (NGED) pursuant to Section 47 of the Copyright Designs and Patents Act 1988 unless that Act provides a relevant exception to copyright the copy must not be copied without the prior permission of the copyright owner.



Warning: PDF designed for colour print only with no page scaling.

nationalgrid Electricity Distribution

Contact Us

Mapping Enquiries:
All areas 0121 623 9780

General Enquiries:
All areas 0800 096 3080

Date Requested: 08/05/2023
Job Reference: 29406942
Site Location: 477702 382850
Requested by:
Mr Ben Evans
Your Scheme/Reference:
LM 203570/DK - 7

Exact Scales:
1:1250 Area or Circle dig site
1:500 Line dig site

Link Box ●	Overhead Line ○—○ PL ○—○ Service ○—○ LV ○—○ HV (11kV) ○—○ HV (33kV) ○—○ HV (66kV) ○—○ HV (132kV)	Underground Cable -	National Grid Telecoms - - - - - PME Earth -E- - - - - Underground Earth	Pilot Cables ○ Pole Mounted Transformer □ Ground Mounted Transformer
----------------------	--	---	---	---

IMPORTANT NOTICES

- This information is given as a guide only and its accuracy cannot be guaranteed. Services or recent additions to the network may not be shown.
- Cables, overhead lines & substations owned by other electricity network owners or private companies may be present and may not be shown.
- You should always verify exact locations of cables using a cable locator and by careful use of hand tools in accordance with HSE guidance note HSG47.
- When working within 10m of any overhead electric line you should follow the requirements of HSE Guidance Note GS6.
- For further advice on working near our electricity cables or lines, call our General Enquiries number.
- Advice should be sought from the National Grid Electricity Distribution General Enquiries team for any work that is to take place in proximity to 132kV underground cables and 132kV overhead lines.

Report damage immediately – KEEP EVERYONE AWAY FROM THE AREA
0800 6783 105

Crown Copyright © All Rights Reserved. Ordnance Survey Licence numbers: 100022432
NGED Copyright: This copy has been made by or with the authority of National Grid Electricity Distribution (NGED) pursuant to Section 47 of the Copyright Designs and Patents Act 1988 unless that Act provides a relevant exception to copyright the copy must not be copied without the prior permission of the copyright owner.

10



Warning: PDF designed for colour print only with no page scaling.



Contact Us

Mapping Enquiries:

All areas 0121 623 9780

General Enquiries:

All areas 0800 096 3080

Date Requested: 08/05/2023

Job Reference: 29406942

Site Location: 477702 382850

Requested by:

Mr Ben Evans


Your Scheme/Reference:

LM 203570/DK - 7

Exact Scales:

1:1250 Area or Circle dig site

1:500 Line dig site

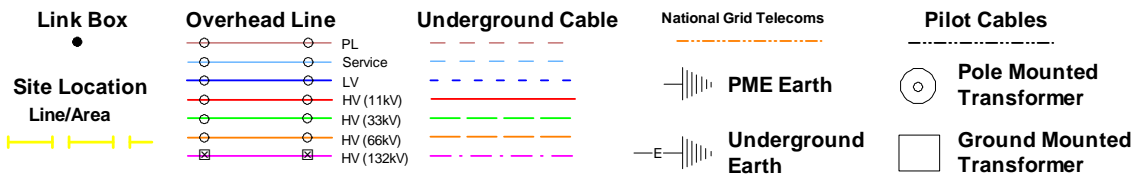


IMPORTANT NOTICES

- This information is given as a guide only and its accuracy cannot be guaranteed. Services or recent additions to the network may not be shown.
- Cables, overhead lines & substations owned by other electricity network owners or private companies may be present and may not be shown.
- You should always verify exact locations of cables using a cable locator and by careful use of hand tools in accordance with HSE guidance note HSG47.
- When working within 10m of any overhead electric line you should follow the requirements of HSE Guidance Note GS6.
- For further advice on working near our electricity cables or lines, call our General Enquiries number.
- Advice should be sought from the National Grid Electricity Distribution General Enquiries team for any work that is to take place in proximity to 132kV underground cables and 132kV overhead lines.

**Report damage immediately – KEEP EVERYONE AWAY FROM THE AREA
0800 6783 105**

Crown Copyright © All Rights Reserved. Ordnance Survey Licence numbers: 100022432
NGED Copyright: This copy has been made by or with the authority of National Grid Electricity Distribution (NGED) pursuant to Section 47 of the Copyright Designs and Patents Act 1988 unless that Act provides a relevant exception to copyright the copy must not be copied without the prior permission of the copyright owner.

12

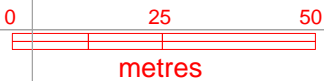

Warning: PDF designed for colour print only with no page scaling.




Contact Us

Mapping Enquiries:
All areas 0121 623 9780

General Enquiries:
All areas 0800 096 3080

Date Requested: 08/05/2023
Job Reference: 29406942
Site Location: 477702 382850
Requested by:
Mr Ben Evans
Your Scheme/Reference:
LM 203570/DK - 7

Exact Scales:
1:1250 Area or Circle dig site
1:500 Line dig site

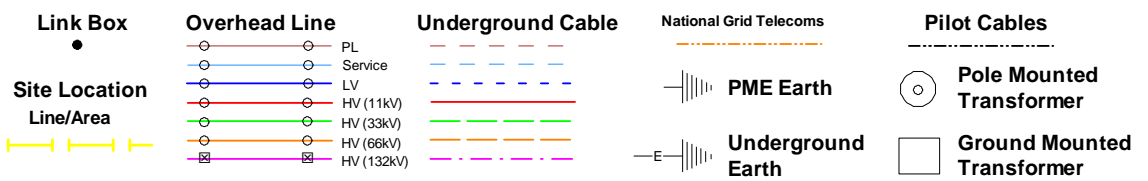


IMPORTANT NOTICES

- This information is given as a guide only and its accuracy cannot be guaranteed. Services or recent additions to the network may not be shown.
- Cables, overhead lines & substations owned by other electricity network owners or private companies may be present and may not be shown.
- You should always verify exact locations of cables using a cable locator and by careful use of hand tools in accordance with HSE guidance note HSG47.
- When working within 10m of any overhead electric line you should follow the requirements of HSE Guidance Note GS6.
- For further advice on working near our electricity cables or lines, call our General Enquiries number.
- Advice should be sought from the National Grid Electricity Distribution General Enquiries team for any work that is to take place in proximity to 132kV underground cables and 132kV overhead lines.

Report damage immediately – KEEP EVERYONE AWAY FROM THE AREA
0800 6783 105

Crown Copyright © All Rights Reserved. Ordnance Survey Licence numbers: 100022432
NGED Copyright: This copy has been made by or with the authority of National Grid Electricity Distribution (NGED) pursuant to Section 47 of the Copyright Designs and Patents Act 1988 unless that Act provides a relevant exception to copyright the copy must not be copied without the prior permission of the copyright owner.

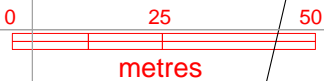

Warning: PDF designed for colour print only with no page scaling.




Contact Us

Mapping Enquiries:
All areas 0121 623 9780

General Enquiries:
All areas 0800 096 3080

Date Requested: 08/05/2023
Job Reference: 29406942
Site Location: 477702 382850
Requested by:
Mr Ben Evans
Your Scheme/Reference:
LM 203570/DK - 7

Exact Scales:
1:1250 Area or Circle dig site
1:500 Line dig site

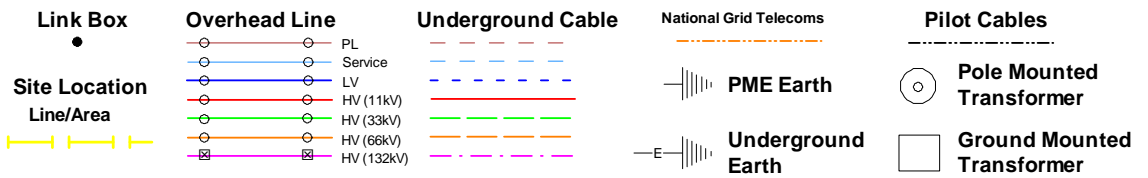


IMPORTANT NOTICES

- This information is given as a guide only and its accuracy cannot be guaranteed. Services or recent additions to the network may not be shown.
- Cables, overhead lines & substations owned by other electricity network owners or private companies may be present and may not be shown.
- You should always verify exact locations of cables using a cable locator and by careful use of hand tools in accordance with HSE guidance note HSG47.
- When working within 10m of any overhead electric line you should follow the requirements of HSE Guidance Note GS6.
- For further advice on working near our electricity cables or lines, call our General Enquiries number.
- Advice should be sought from the National Grid Electricity Distribution General Enquiries team for any work that is to take place in proximity to 132kV underground cables and 132kV overhead lines.

Report damage immediately – KEEP EVERYONE AWAY FROM THE AREA
0800 6783 105

Crown Copyright © All Rights Reserved. Ordnance Survey Licence numbers: 100022432
NGED Copyright: This copy has been made by or with the authority of National Grid Electricity Distribution (NGED) pursuant to Section 47 of the Copyright Designs and Patents Act 1988 unless that Act provides a relevant exception to copyright the copy must not be copied without the prior permission of the copyright owner.

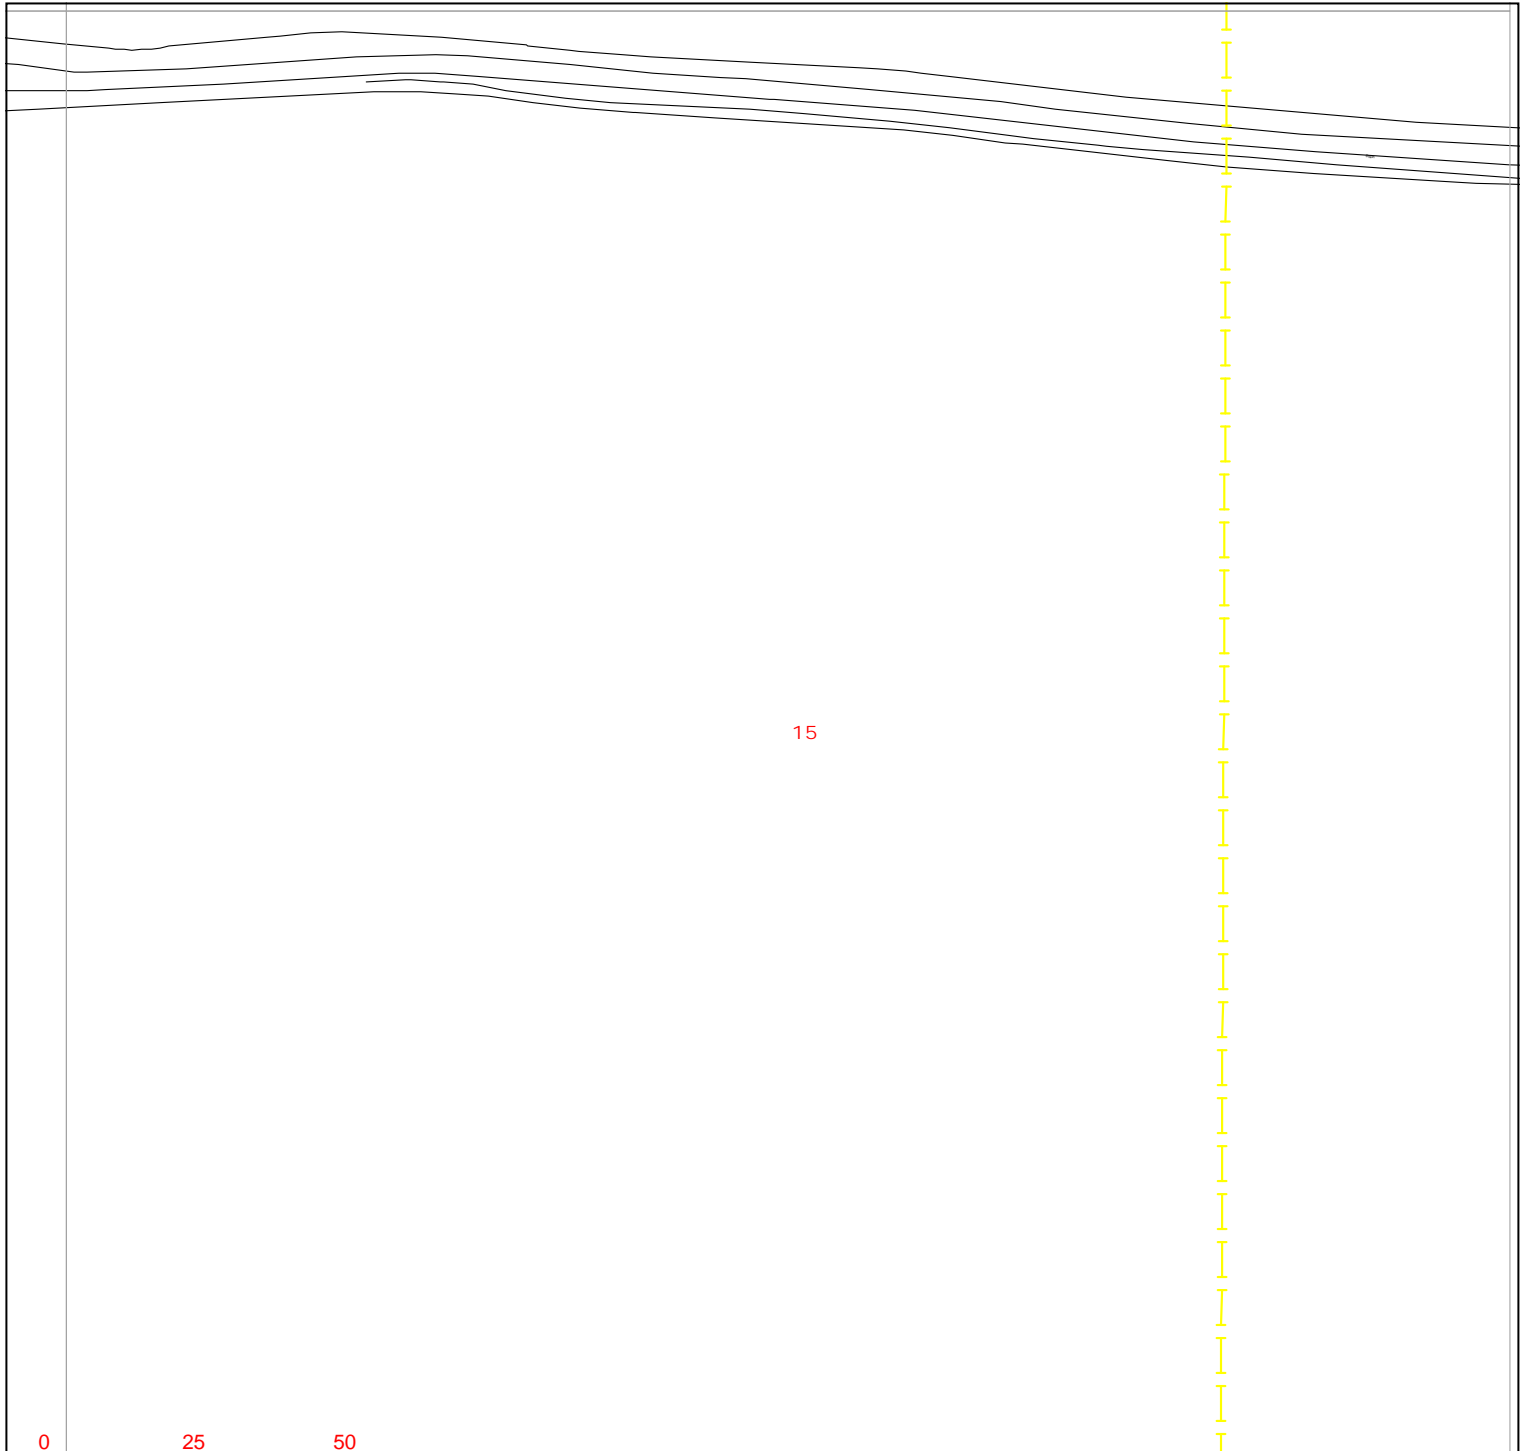


Warning: PDF designed for colour print only with no page scaling.



Contact Us
 Mapping Enquiries:
 All areas 0121 623 9780
 General Enquiries:
 All areas 0800 096 3080

Date Requested: 08/05/2023
 Job Reference: 29406942
 Site Location: 477702 382850
 Requested by:
 Mr Ben Evans
 Your Scheme/Reference:
 LM 203570/DK - 7

Exact Scales:
 1:1250 Area or Circle dig site
 1:500 Line dig site

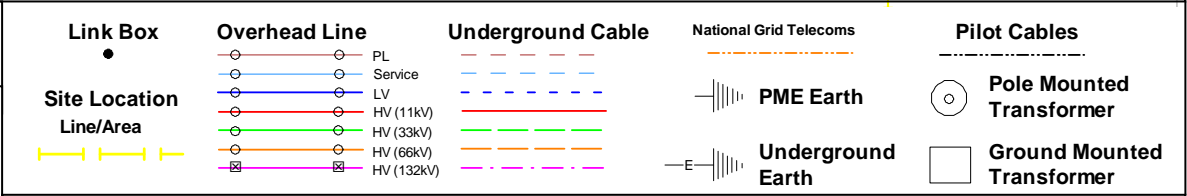


IMPORTANT NOTICES

- This information is given as a guide only and its accuracy cannot be guaranteed. Services or recent additions to the network may not be shown.
- Cables, overhead lines & substations owned by other electricity network owners or private companies may be present and may not be shown.
- You should always verify exact locations of cables using a cable locator and by careful use of hand tools in accordance with HSE guidance note HSG47.
- When working within 10m of any overhead electric line you should follow the requirements of HSE Guidance Note GS6.
- For further advice on working near our electricity cables or lines, call our General Enquiries number.
- Advice should be sought from the National Grid Electricity Distribution General Enquiries team for any work that is to take place in proximity to 132kV underground cables and 132kV overhead lines.

Report damage immediately – KEEP EVERYONE AWAY FROM THE AREA
0800 6783 105

Crown Copyright © All Rights Reserved. Ordnance Survey Licence numbers: 100022432
 NGED Copyright: This copy has been made by or with the authority of National Grid Electricity Distribution (NGED) pursuant to Section 47 of the Copyright Designs and Patents Act 1988 unless that Act provides a relevant exception to copyright the copy must not be copied without the prior permission of the copyright owner.

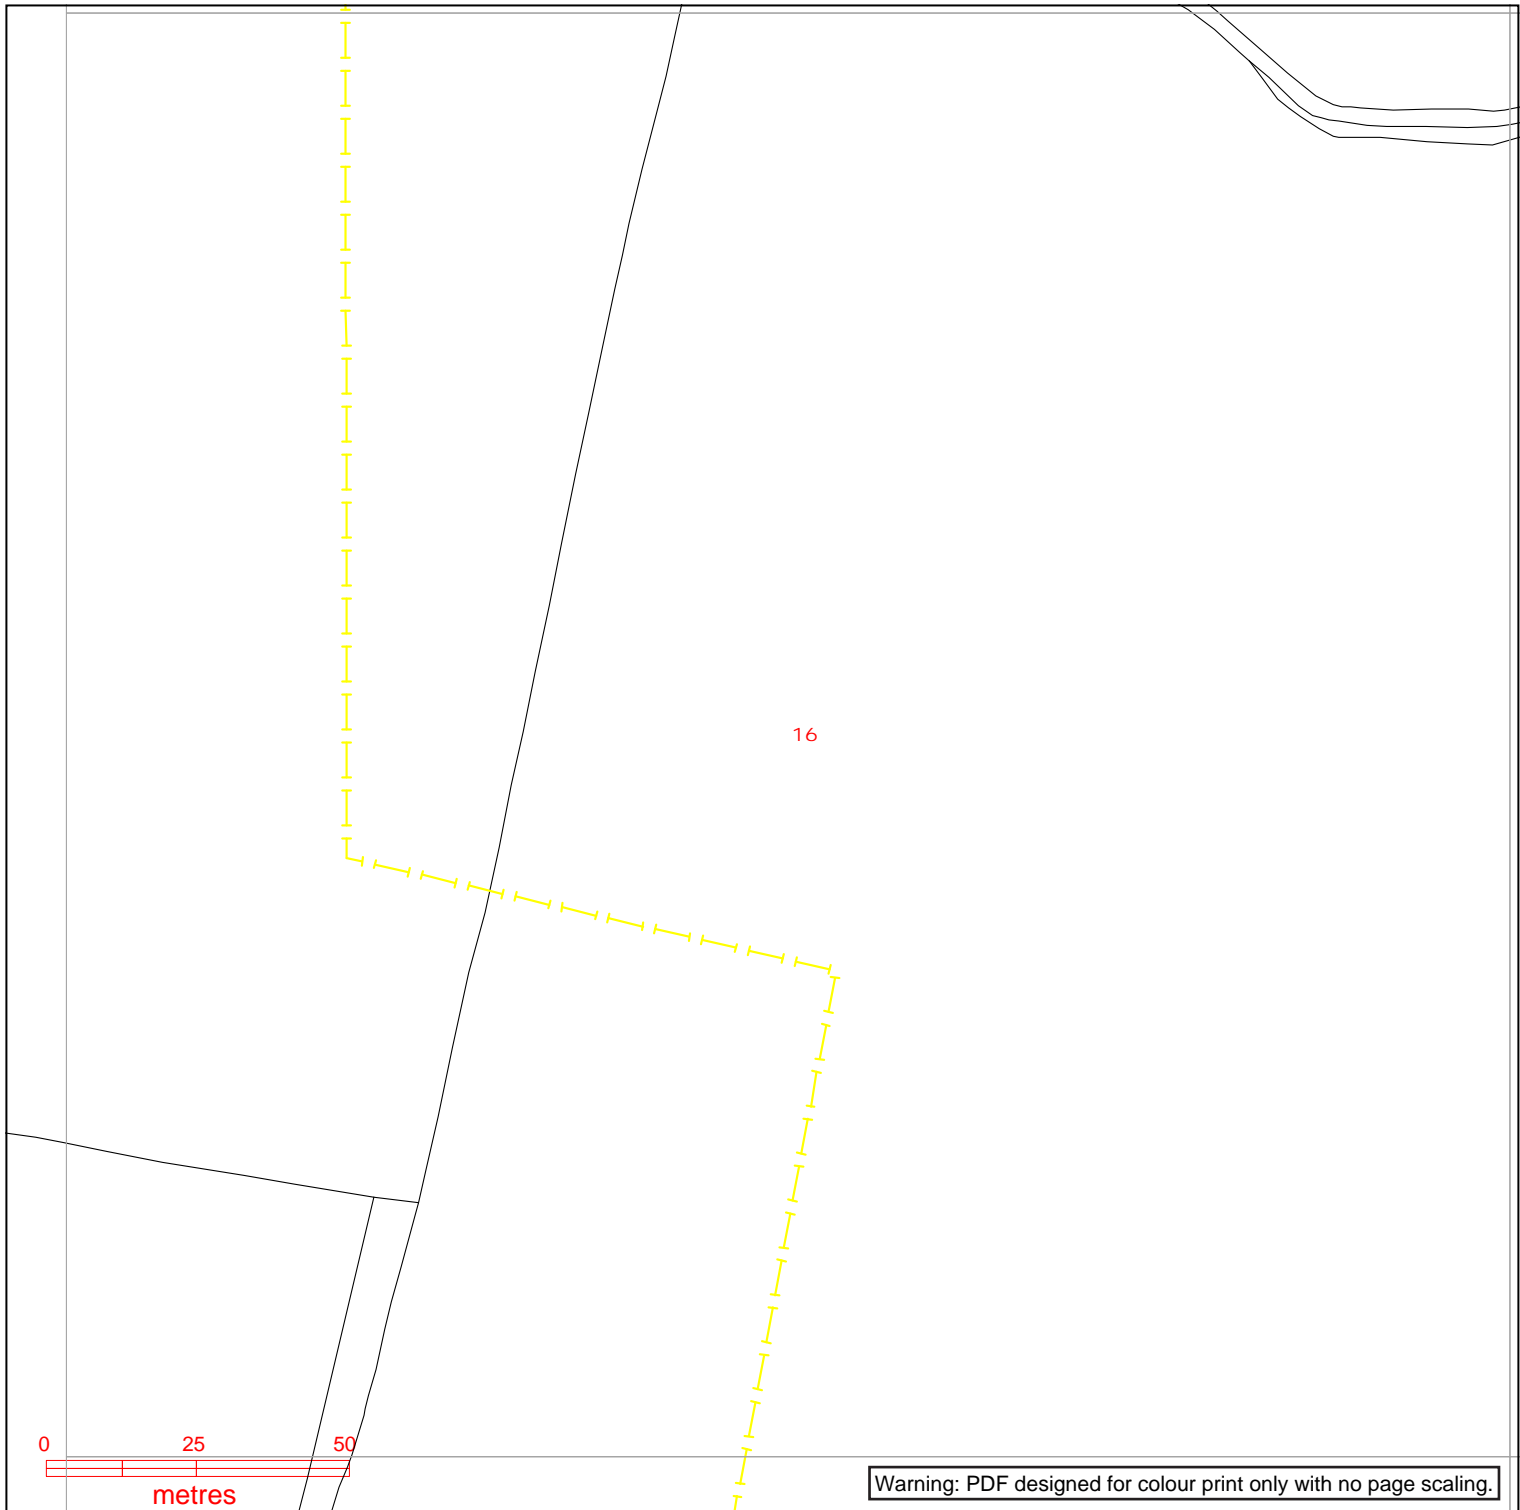

Warning: PDF designed for colour print only with no page scaling.

nationalgrid Electricity Distribution

Contact Us

Mapping Enquiries:
All areas 0121 623 9780

General Enquiries:
All areas 0800 096 3080

Date Requested: 08/05/2023
Job Reference: 29406942
Site Location: 477702 382850
Requested by:
Mr Ben Evans
Your Scheme/Reference:
LM 203570/DK - 7

Exact Scales:
1:1250 Area or Circle dig site
1:500 Line dig site

<p>Link Box</p> <p>●</p> <p>Site Location</p> <p>Line/Area</p> <p>— — — — —</p>	<p>Overhead Line</p> <p>○ — ○ PL</p> <p>○ — ○ Service</p> <p>○ — ○ LV</p> <p>○ — ○ HV (11kV)</p> <p>○ — ○ HV (33kV)</p> <p>○ — ○ HV (66kV)</p> <p>□ — □ HV (132kV)</p>	<p>Underground Cable</p> <p>— — — — —</p> <p>— — — — —</p> <p>— — — — —</p> <p>— — — — —</p> <p>— — — — —</p>	<p>National Grid Telecoms</p> <p>— — — — —</p> <p>— — — — — PME Earth</p> <p>— — — — — Underground Earth</p>	<p>Pilot Cables</p> <p>○ — ○</p> <p>□ — □</p> <p>○ Pole Mounted Transformer</p> <p>□ Ground Mounted Transformer</p>
---	---	--	---	--

IMPORTANT NOTICES


- This information is given as a guide only and its accuracy cannot be guaranteed. Services or recent additions to the network may not be shown.
- Cables, overhead lines & substations owned by other electricity network owners or private companies may be present and may not be shown.
- You should always verify exact locations of cables using a cable locator and by careful use of hand tools in accordance with HSE guidance note HSG47.
- When working within 10m of any overhead electric line you should follow the requirements of HSE Guidance Note GS6.
- For further advice on working near our electricity cables or lines, call our General Enquiries number.
- Advice should be sought from the National Grid Electricity Distribution General Enquiries team for any work that is to take place in proximity to 132kV underground cables and 132kV overhead lines.

Report damage immediately – KEEP EVERYONE AWAY FROM THE AREA
0800 6783 105

Crown Copyright © All Rights Reserved. Ordnance Survey Licence numbers: 100022432
NGED Copyright: This copy has been made by or with the authority of National Grid Electricity Distribution (NGED) pursuant to Section 47 of the Copyright Designs and Patents Act 1988 unless that Act provides a relevant exception to copyright the copy must not be copied without the prior permission of the copyright owner.



17

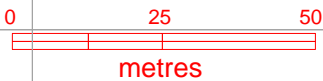

Warning: PDF designed for colour print only with no page scaling.

nationalgrid Electricity Distribution

Contact Us

Mapping Enquiries:
All areas 0121 623 9780

General Enquiries:
All areas 0800 096 3080

Date Requested: 08/05/2023
Job Reference: 29406942
Site Location: 477702 382850
Requested by:
Mr Ben Evans
Your Scheme/Reference:
LM 203570/DK - 7

Exact Scales:
1:1250 Area or Circle dig site
1:500 Line dig site


Link Box ●	Overhead Line ○—○ PL ○—○ Service ○—○ LV ○—○ HV (11kV) ○—○ HV (33kV) ○—○ HV (66kV) ○—○ HV (132kV)	Underground Cable -	National Grid Telecoms - - - - - PME Earth -E- - - - - Underground Earth	Pilot Cables ○ Pole Mounted Transformer □ Ground Mounted Transformer
----------------------	--	---	---	---

IMPORTANT NOTICES

- This information is given as a guide only and its accuracy cannot be guaranteed. Services or recent additions to the network may not be shown.
- Cables, overhead lines & substations owned by other electricity network owners or private companies may be present and may not be shown.
- You should always verify exact locations of cables using a cable locator and by careful use of hand tools in accordance with HSE guidance note HSG47.
- When working within 10m of any overhead electric line you should follow the requirements of HSE Guidance Note GS6.
- For further advice on working near our electricity cables or lines, call our General Enquiries number.
- Advice should be sought from the National Grid Electricity Distribution General Enquiries team for any work that is to take place in proximity to 132kV underground cables and 132kV overhead lines.

Report damage immediately – KEEP EVERYONE AWAY FROM THE AREA
0800 6783 105

Crown Copyright © All Rights Reserved. Ordnance Survey Licence numbers: 100022432
NGED Copyright: This copy has been made by or with the authority of National Grid Electricity Distribution (NGED) pursuant to Section 47 of the Copyright Designs and Patents Act 1988 unless that Act provides a relevant exception to copyright the copy must not be copied without the prior permission of the copyright owner.

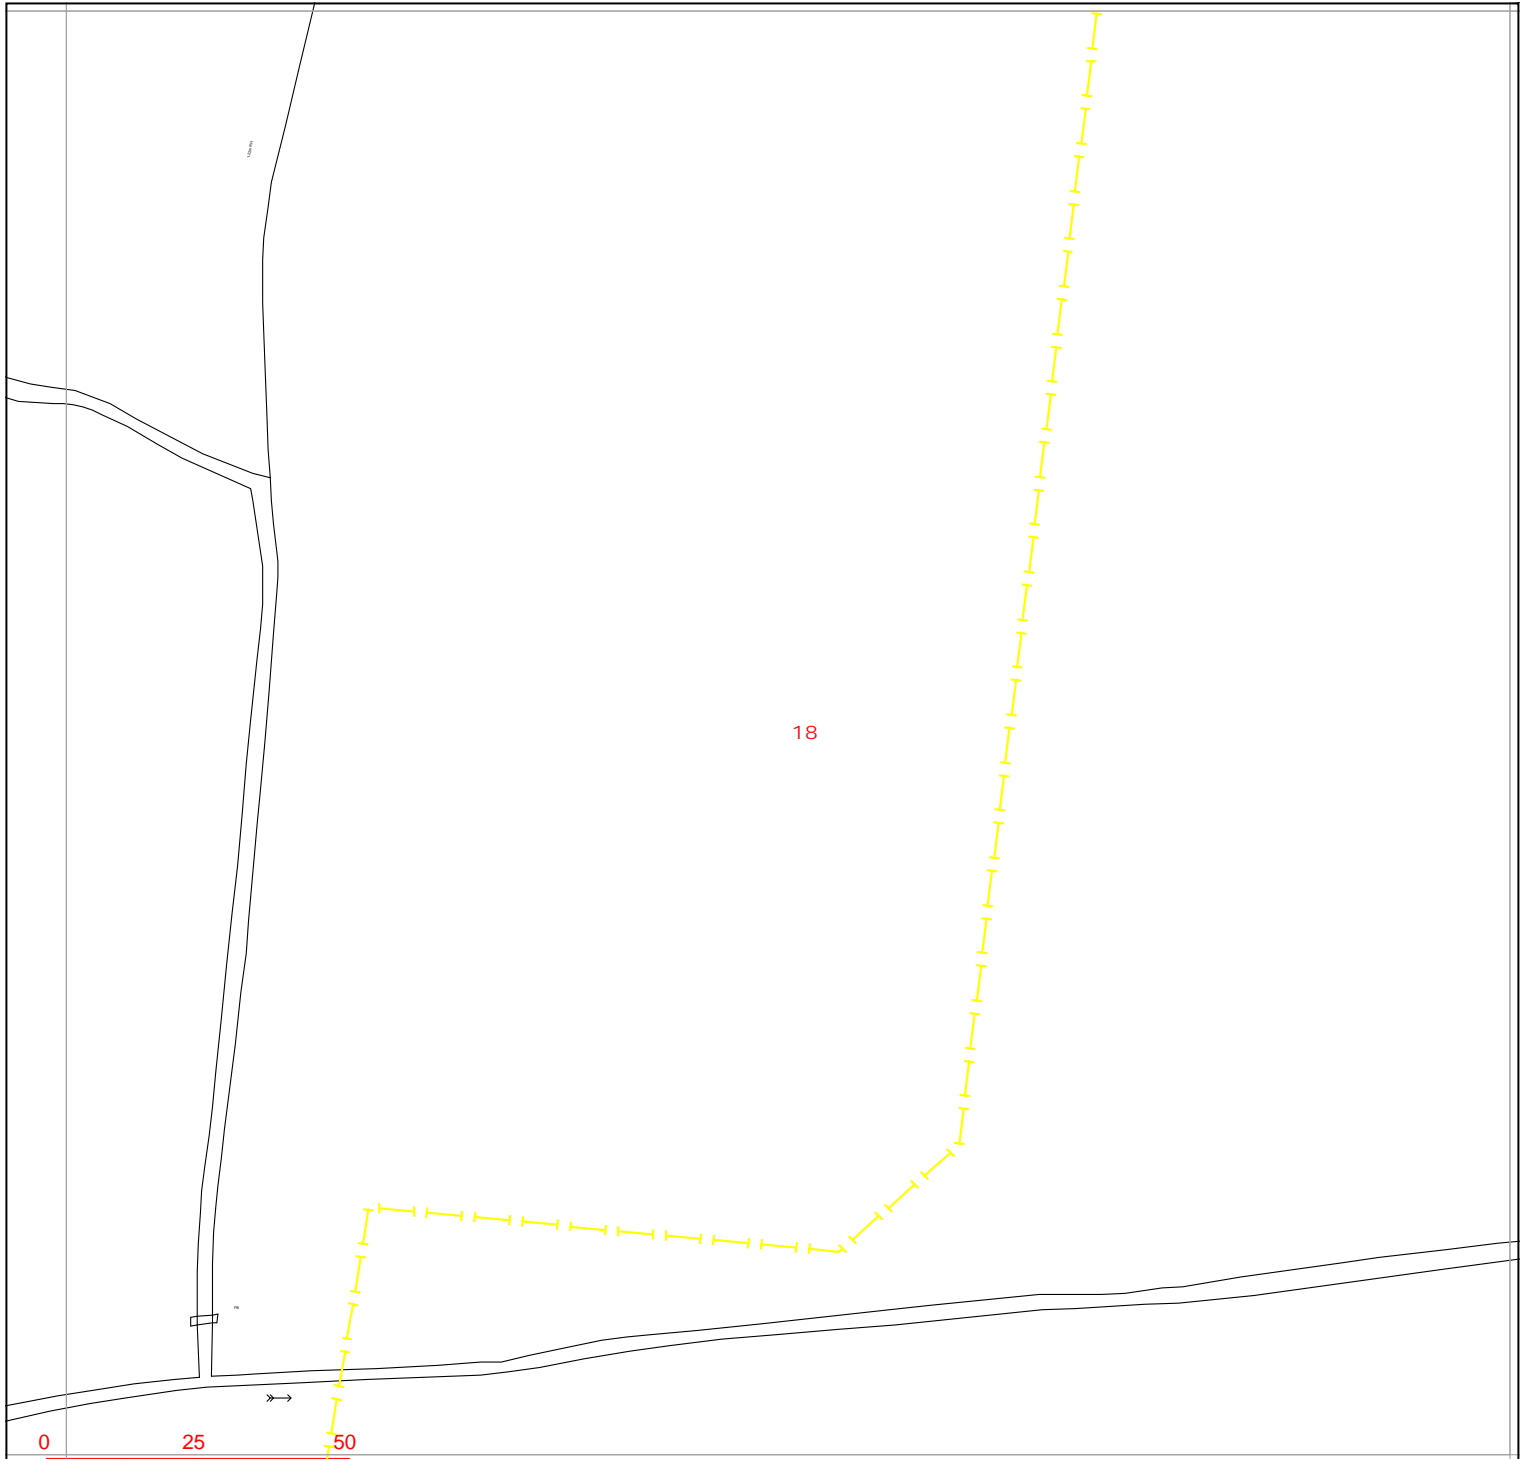

Warning: PDF designed for colour print only with no page scaling.

nationalgrid Electricity Distribution

Contact Us

Mapping Enquiries:
All areas 0121 623 9780

General Enquiries:
All areas 0800 096 3080

Date Requested: 08/05/2023
Job Reference: 29406942
Site Location: 477702 382850
Requested by:
Mr Ben Evans
Your Scheme/Reference:
LM 203570/DK - 7

Exact Scales:
1:1250 Area or Circle dig site
1:500 Line dig site

Link Box ●	Overhead Line ○—○ PL ○—○ Service ○—○ LV ○—○ HV (11kV) ○—○ HV (33kV) ○—○ HV (66kV) ○—○ HV (132kV)	Underground Cable -	National Grid Telecoms - - - - - PME Earth Underground Earth	Pilot Cables ○ Pole Mounted Transformer □ Ground Mounted Transformer
----------------------	--	---	--	---

IMPORTANT NOTICES


- This information is given as a guide only and its accuracy cannot be guaranteed. Services or recent additions to the network may not be shown.
- Cables, overhead lines & substations owned by other electricity network owners or private companies may be present and may not be shown.
- You should always verify exact locations of cables using a cable locator and by careful use of hand tools in accordance with HSE guidance note HSG47.
- When working within 10m of any overhead electric line you should follow the requirements of HSE Guidance Note GS6.
- For further advice on working near our electricity cables or lines, call our General Enquiries number.
- Advice should be sought from the National Grid Electricity Distribution General Enquiries team for any work that is to take place in proximity to 132kV underground cables and 132kV overhead lines.

Report damage immediately – KEEP EVERYONE AWAY FROM THE AREA
0800 6783 105

Crown Copyright © All Rights Reserved. Ordnance Survey Licence numbers: 100022432
NGED Copyright: This copy has been made by or with the authority of National Grid Electricity Distribution (NGED) pursuant to Section 47 of the Copyright Designs and Patents Act 1988 unless that Act provides a relevant exception to copyright the copy must not be copied without the prior permission of the copyright owner.



19

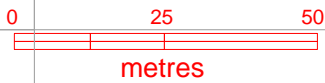

Warning: PDF designed for colour print only with no page scaling.

nationalgrid Electricity Distribution

Contact Us

Mapping Enquiries:
All areas 0121 623 9780

General Enquiries:
All areas 0800 096 3080

Date Requested: 08/05/2023
Job Reference: 29406942
Site Location: 477702 382850
Requested by:
Mr Ben Evans
Your Scheme/Reference:
LM 203570/DK - 7

Exact Scales:
1:1250 Area or Circle dig site
1:500 Line dig site


Link Box ●	Overhead Line ○—○ PL ○—○ Service ○—○ LV ○—○ HV (11kV) ○—○ HV (33kV) ○—○ HV (66kV) ○—○ HV (132kV)	Underground Cable -	National Grid Telecoms - - - - - PME Earth -E- - - - - Underground Earth	Pilot Cables - - - - - ○ Pole Mounted Transformer □ Ground Mounted Transformer
----------------------	--	---	---	--

IMPORTANT NOTICES

- This information is given as a guide only and its accuracy cannot be guaranteed. Services or recent additions to the network may not be shown.
- Cables, overhead lines & substations owned by other electricity network owners or private companies may be present and may not be shown.
- You should always verify exact locations of cables using a cable locator and by careful use of hand tools in accordance with HSE guidance note HSG47.
- When working within 10m of any overhead electric line you should follow the requirements of HSE Guidance Note GS6.
- For further advice on working near our electricity cables or lines, call our General Enquiries number.
- Advice should be sought from the National Grid Electricity Distribution General Enquiries team for any work that is to take place in proximity to 132kV underground cables and 132kV overhead lines.

Report damage immediately – KEEP EVERYONE AWAY FROM THE AREA
0800 6783 105

Crown Copyright © All Rights Reserved. Ordnance Survey Licence numbers: 100022432
NGED Copyright: This copy has been made by or with the authority of National Grid Electricity Distribution (NGED) pursuant to Section 47 of the Copyright Designs and Patents Act 1988 unless that Act provides a relevant exception to copyright the copy must not be copied without the prior permission of the copyright owner.

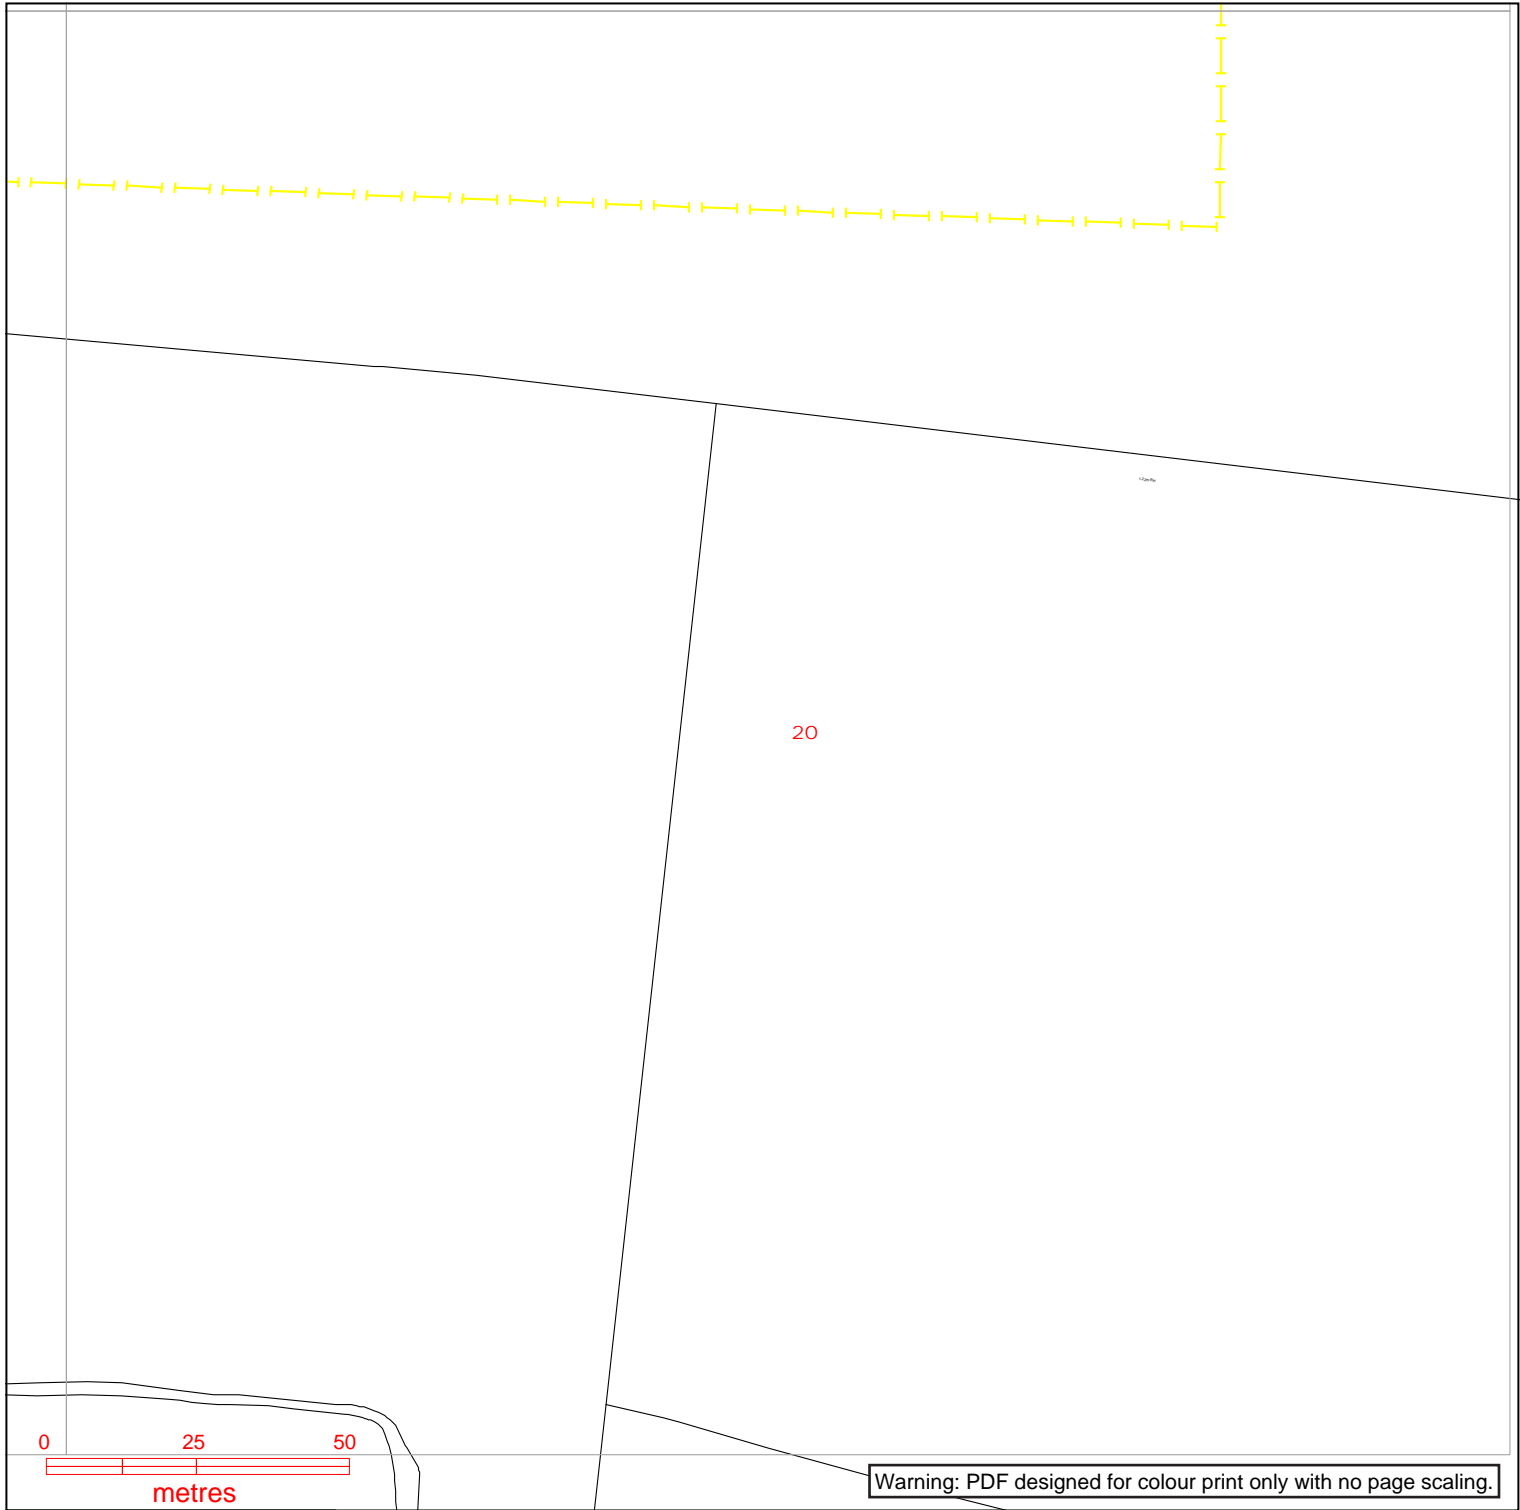

Warning: PDF designed for colour print only with no page scaling.

nationalgrid Electricity Distribution

Contact Us

Mapping Enquiries:
All areas 0121 623 9780

General Enquiries:
All areas 0800 096 3080

Date Requested: 08/05/2023
Job Reference: 29406942
Site Location: 477702 382850
Requested by:
Mr Ben Evans
Your Scheme/Reference:
LM 203570/DK - 7

Exact Scales:
1:1250 Area or Circle dig site
1:500 Line dig site


Link Box ●	Overhead Line ○—○ PL ○—○ Service ○—○ LV ○—○ HV (11kV) ○—○ HV (33kV) ○—○ HV (66kV) ○—○ HV (132kV)	Underground Cable -	National Grid Telecoms - - - - - PME Earth Underground Earth	Pilot Cables ○ Pole Mounted Transformer □ Ground Mounted Transformer
----------------------	--	---	--	---

IMPORTANT NOTICES

- This information is given as a guide only and its accuracy cannot be guaranteed. Services or recent additions to the network may not be shown.
- Cables, overhead lines & substations owned by other electricity network owners or private companies may be present and may not be shown.
- You should always verify exact locations of cables using a cable locator and by careful use of hand tools in accordance with HSE guidance note HSG47.
- When working within 10m of any overhead electric line you should follow the requirements of HSE Guidance Note GS6.
- For further advice on working near our electricity cables or lines, call our General Enquiries number.
- Advice should be sought from the National Grid Electricity Distribution General Enquiries team for any work that is to take place in proximity to 132kV underground cables and 132kV overhead lines.

Report damage immediately – KEEP EVERYONE AWAY FROM THE AREA
0800 6783 105

Crown Copyright © All Rights Reserved. Ordnance Survey Licence numbers: 100022432
NGED Copyright: This copy has been made by or with the authority of National Grid Electricity Distribution (NGED) pursuant to Section 47 of the Copyright Designs and Patents Act 1988 unless that Act provides a relevant exception to copyright the copy must not be copied without the prior permission of the copyright owner.

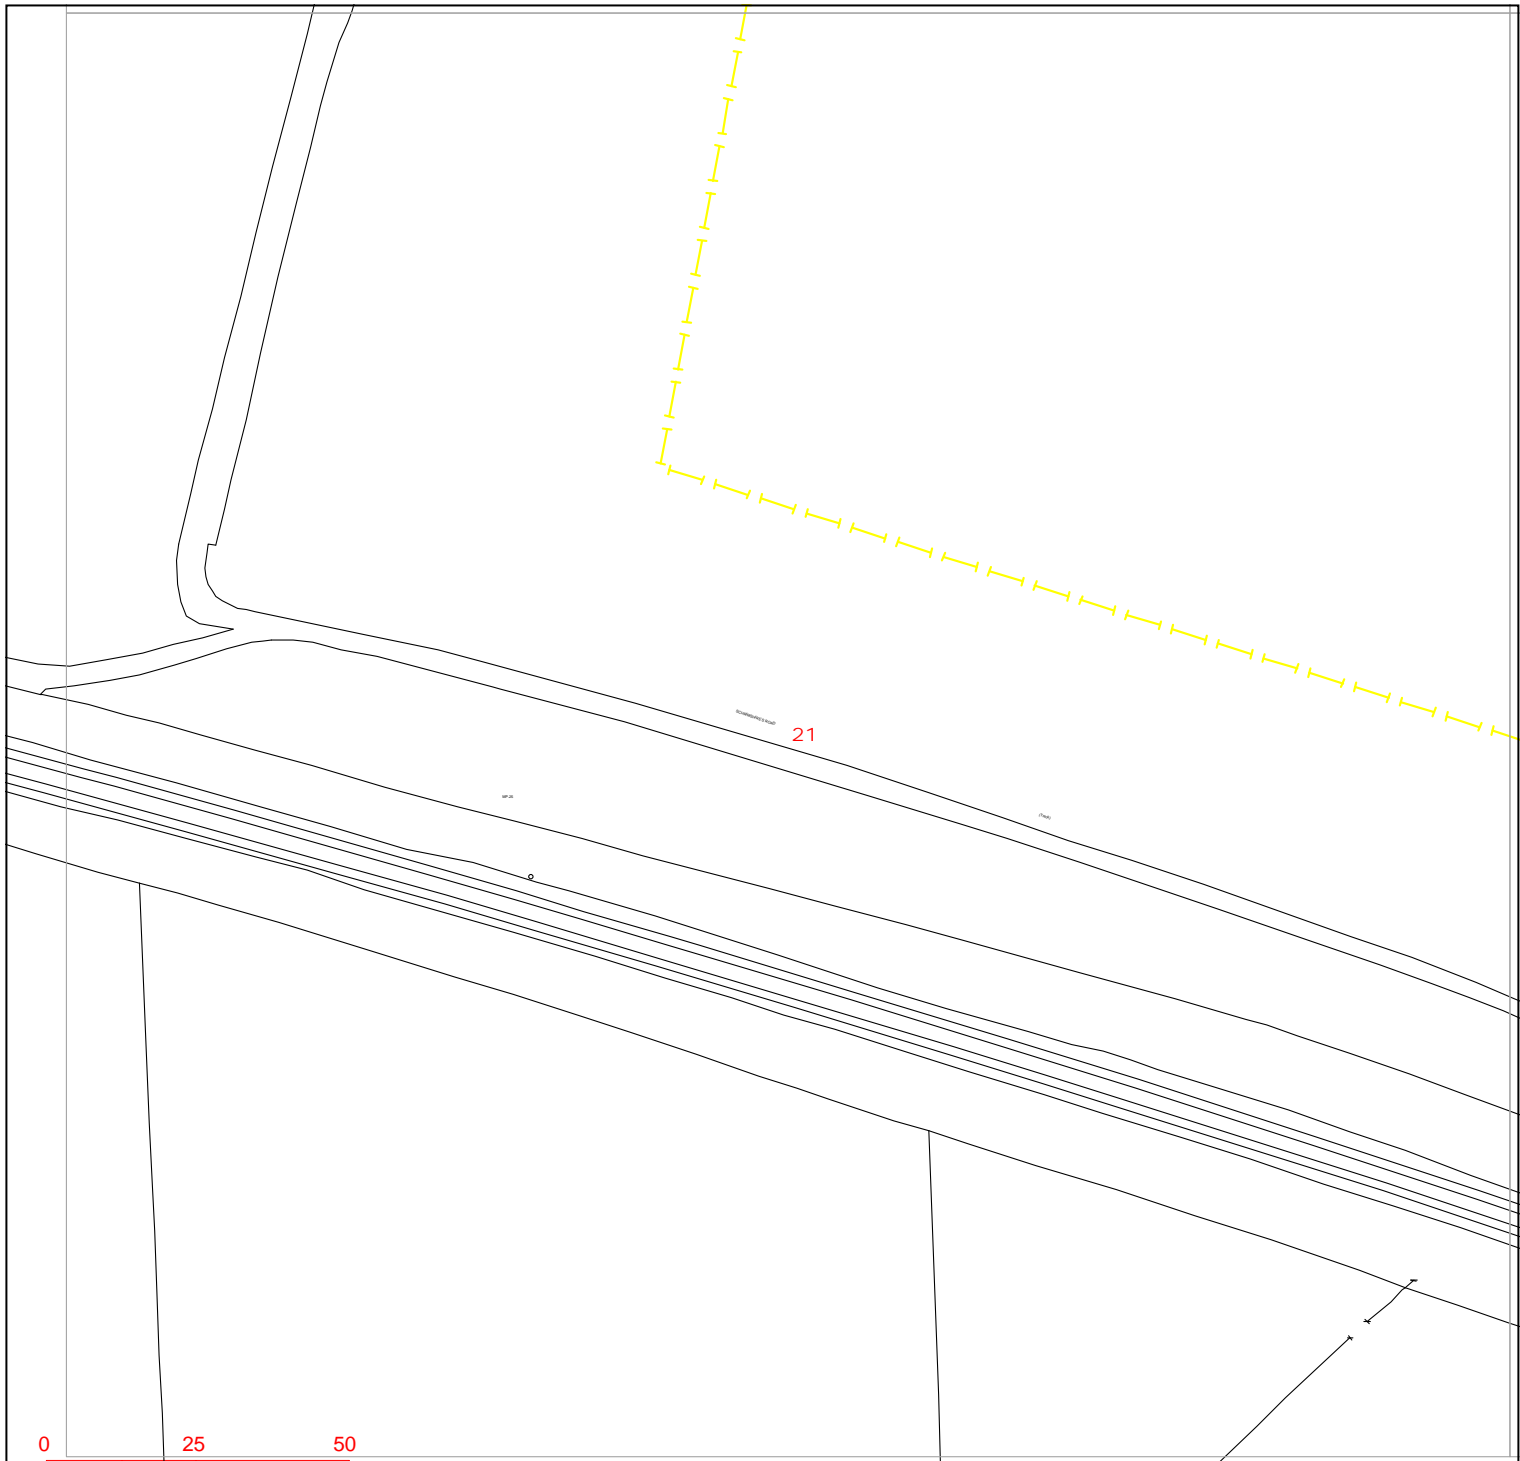

Warning: PDF designed for colour print only with no page scaling.

nationalgrid Electricity Distribution

Contact Us

Mapping Enquiries:
All areas 0121 623 9780

General Enquiries:
All areas 0800 096 3080

Date Requested: 08/05/2023
Job Reference: 29406942
Site Location: 477702 382850
Requested by:
Mr Ben Evans
Your Scheme/Reference:
LM 203570/DK - 7

Exact Scales:
1:1250 Area or Circle dig site
1:500 Line dig site


Link Box	Overhead Line	Underground Cable	National Grid Telecoms	Pilot Cables
●	<ul style="list-style-type: none"> ○ PL ○ Service ○ LV ○ HV (11kV) ○ HV (33kV) ○ HV (66kV) ○ HV (132kV) 	<ul style="list-style-type: none"> --- --- --- --- --- --- 	<ul style="list-style-type: none"> —E— —E— 	<ul style="list-style-type: none"> ○ Pole Mounted Transformer □ Ground Mounted Transformer

IMPORTANT NOTICES

- This information is given as a guide only and its accuracy cannot be guaranteed. Services or recent additions to the network may not be shown.
- Cables, overhead lines & substations owned by other electricity network owners or private companies may be present and may not be shown.
- You should always verify exact locations of cables using a cable locator and by careful use of hand tools in accordance with HSE guidance note HSG47.
- When working within 10m of any overhead electric line you should follow the requirements of HSE Guidance Note GS6.
- For further advice on working near our electricity cables or lines, call our General Enquiries number.
- Advice should be sought from the National Grid Electricity Distribution General Enquiries team for any work that is to take place in proximity to 132kV underground cables and 132kV overhead lines.

Report damage immediately – KEEP EVERYONE AWAY FROM THE AREA
0800 6783 105

Crown Copyright © All Rights Reserved. Ordnance Survey Licence numbers: 100022432
NGED Copyright: This copy has been made by or with the authority of National Grid Electricity Distribution (NGED) pursuant to Section 47 of the Copyright Designs and Patents Act 1988 unless that Act provides a relevant exception to copyright the copy must not be copied without the prior permission of the copyright owner.

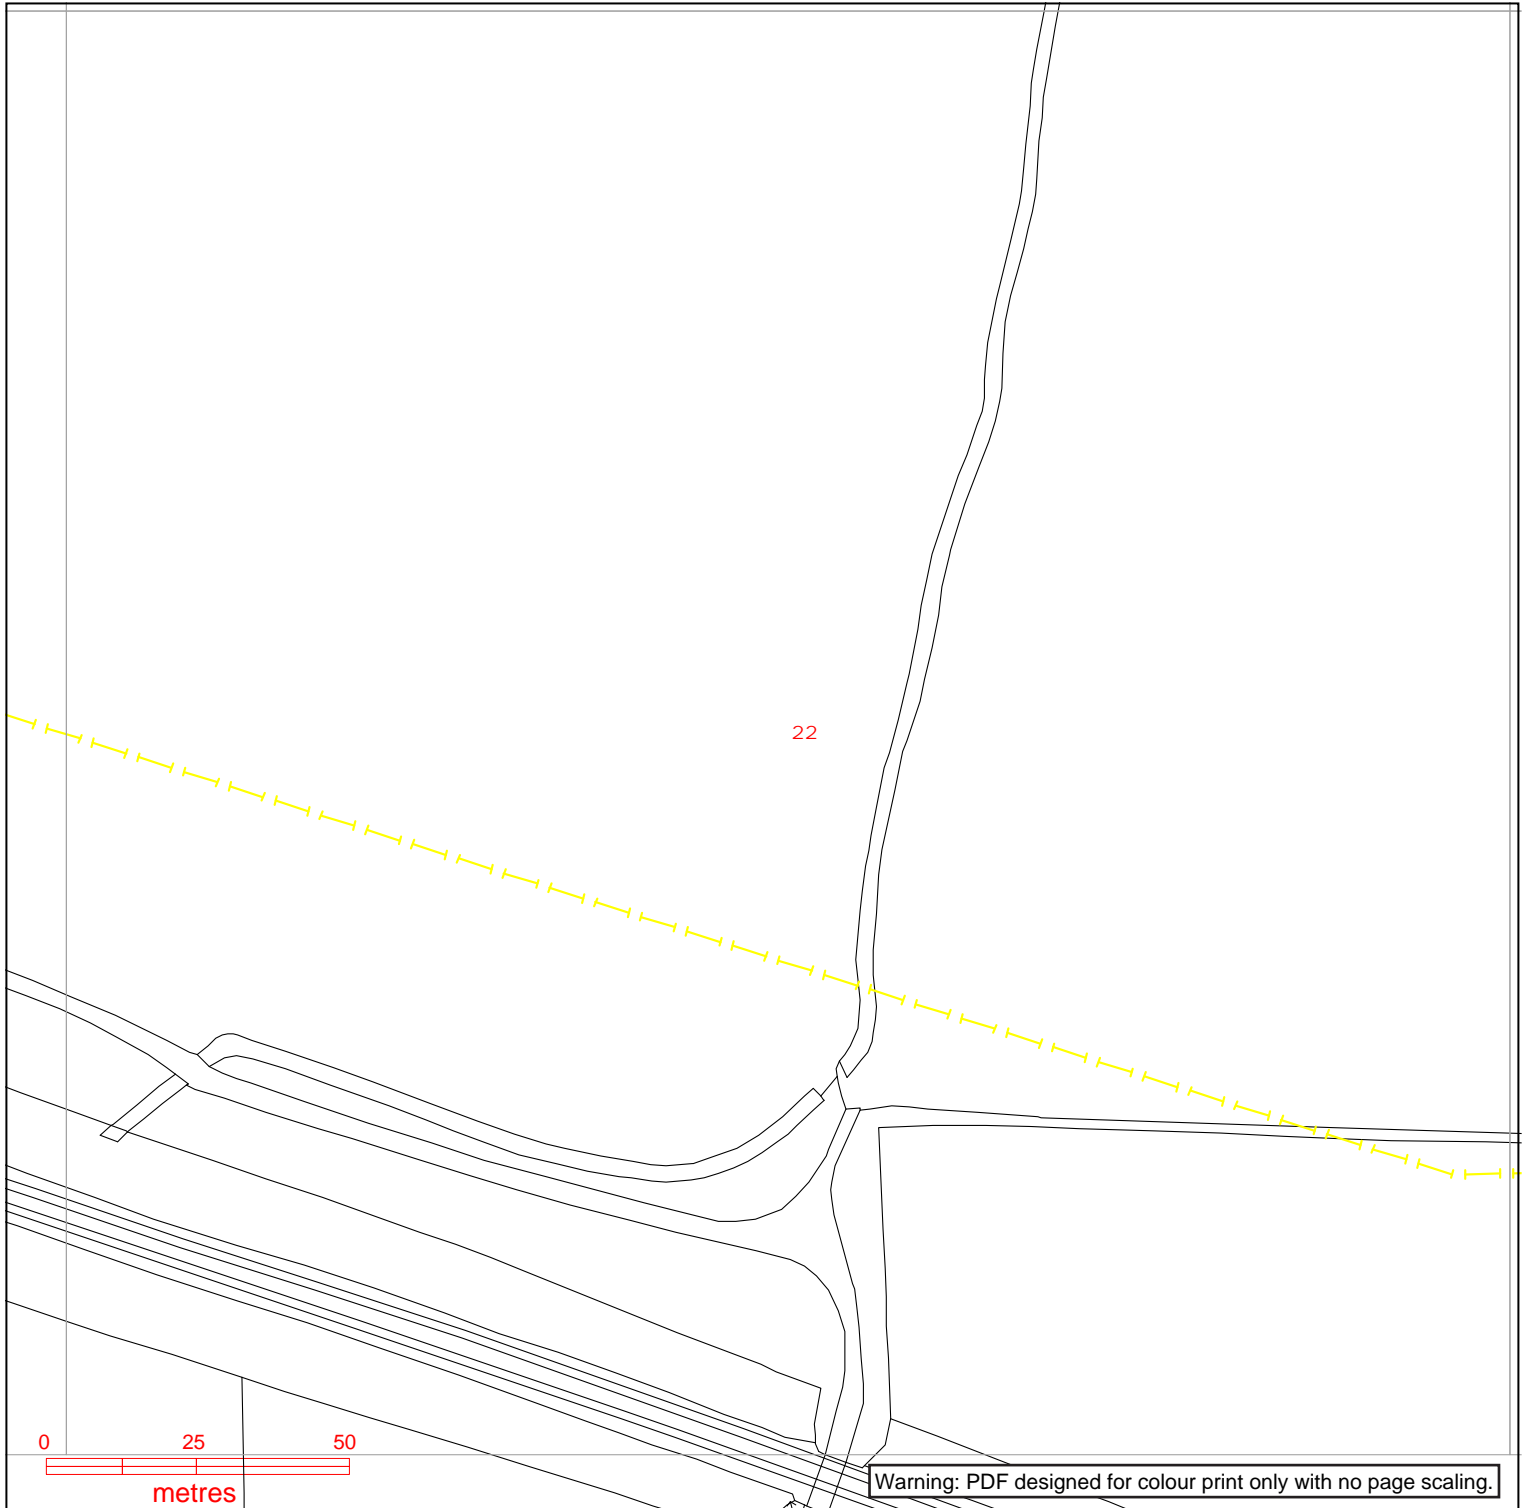

Warning: PDF designed for colour print only with no page scaling.

nationalgrid Electricity Distribution

Contact Us

Mapping Enquiries:
All areas 0121 623 9780

General Enquiries:
All areas 0800 096 3080

Date Requested: 08/05/2023
Job Reference: 29406942
Site Location: 477702 382850
Requested by:
Mr Ben Evans
Your Scheme/Reference:
LM 203570/DK - 7

Exact Scales:
1:1250 Area or Circle dig site
1:500 Line dig site


Link Box	Overhead Line	Underground Cable	National Grid Telecoms	Pilot Cables
●	○ PL ○ Service ○ LV ○ HV (11kV) ○ HV (33kV) ○ HV (66kV) ○ HV (132kV)	--- --- --- ---	--- --- --- ---	○ Pole Mounted Transformer □ Ground Mounted Transformer
---	---	---	⎓ PME Earth ⎓ Underground Earth	

IMPORTANT NOTICES

- This information is given as a guide only and its accuracy cannot be guaranteed. Services or recent additions to the network may not be shown.
- Cables, overhead lines & substations owned by other electricity network owners or private companies may be present and may not be shown.
- You should always verify exact locations of cables using a cable locator and by careful use of hand tools in accordance with HSE guidance note HSG47.
- When working within 10m of any overhead electric line you should follow the requirements of HSE Guidance Note GS6.
- For further advice on working near our electricity cables or lines, call our General Enquiries number.
- Advice should be sought from the National Grid Electricity Distribution General Enquiries team for any work that is to take place in proximity to 132kV underground cables and 132kV overhead lines.

Report damage immediately – KEEP EVERYONE AWAY FROM THE AREA
0800 6783 105

Crown Copyright © All Rights Reserved. Ordnance Survey Licence numbers: 100022432
NGED Copyright: This copy has been made by or with the authority of National Grid Electricity Distribution (NGED) pursuant to Section 47 of the Copyright Designs and Patents Act 1988 unless that Act provides a relevant exception to copyright the copy must not be copied without the prior permission of the copyright owner.

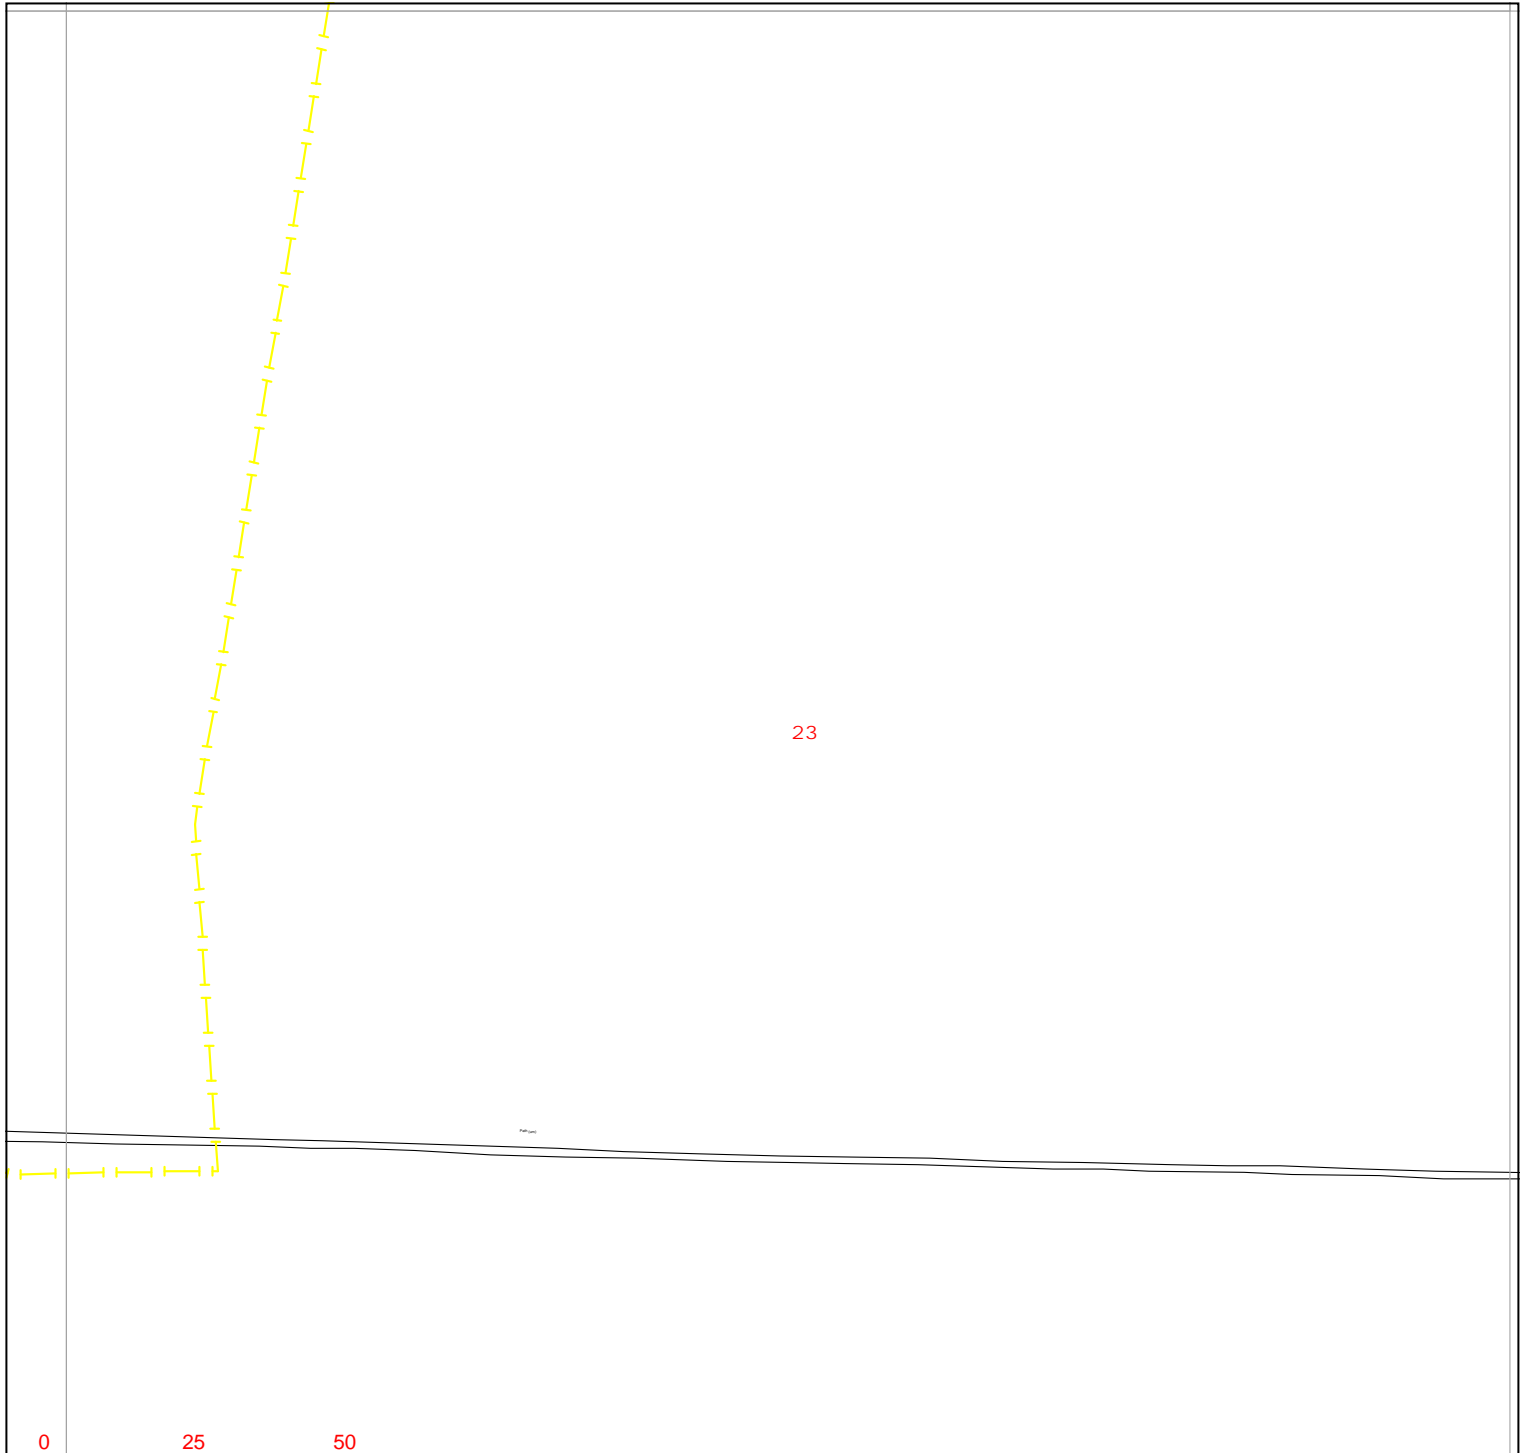

Warning: PDF designed for colour print only with no page scaling.

nationalgrid Electricity Distribution

Contact Us

Mapping Enquiries:
All areas 0121 623 9780

General Enquiries:
All areas 0800 096 3080

Date Requested: 08/05/2023
Job Reference: 29406942
Site Location: 477702 382850
Requested by:
Mr Ben Evans
Your Scheme/Reference:
LM 203570/DK - 7

Exact Scales:
1:1250 Area or Circle dig site
1:500 Line dig site


Link Box ●	Overhead Line ○—○ PL ○—○ Service ○—○ LV ○—○ HV (11kV) ○—○ HV (33kV) ○—○ HV (66kV) ○—○ HV (132kV)	Underground Cable -	National Grid Telecoms - - - - - PME Earth -E- - - - - Underground Earth	Pilot Cables ○ Pole Mounted Transformer □ Ground Mounted Transformer
----------------------	--	---	---	---

IMPORTANT NOTICES

- This information is given as a guide only and its accuracy cannot be guaranteed. Services or recent additions to the network may not be shown.
- Cables, overhead lines & substations owned by other electricity network owners or private companies may be present and may not be shown.
- You should always verify exact locations of cables using a cable locator and by careful use of hand tools in accordance with HSE guidance note HSG47.
- When working within 10m of any overhead electric line you should follow the requirements of HSE Guidance Note GS6.
- For further advice on working near our electricity cables or lines, call our General Enquiries number.
- Advice should be sought from the National Grid Electricity Distribution General Enquiries team for any work that is to take place in proximity to 132kV underground cables and 132kV overhead lines.

Report damage immediately – KEEP EVERYONE AWAY FROM THE AREA
0800 6783 105

Crown Copyright © All Rights Reserved. Ordnance Survey Licence numbers: 100022432
NGED Copyright: This copy has been made by or with the authority of National Grid Electricity Distribution (NGED) pursuant to Section 47 of the Copyright Designs and Patents Act 1988 unless that Act provides a relevant exception to copyright the copy must not be copied without the prior permission of the copyright owner.

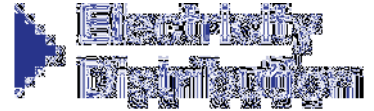

Our Ref: 29406944 Your Ref: LM 203570/DK - 8

Monday, 08 May 2023

Ben Evans
The Hub, 500 Park Avenue, Aztec West
Almondsbury
Bristol
BS32 4RZ

**National Grid Electricity
Distribution**
Mapping Centre
Toll End Road
Tipton
West Midlands
United Kingdom
DY4 0HH
www.nationalgrid.co.uk

Dear Ben Evans

Thank you for your enquiry dated Monday, 08 May 2023

I now enclose a copy of our plan showing existing National Grid Electricity Distribution (NGED) Electricity / National Grid Telecoms (NGT) apparatus in the vicinity of your proposed works. This information is given as a general guide only and its accuracy cannot be guaranteed. Please note that all NGED equipment on site should be assumed to be LIVE until NGED prove otherwise and provide you with confirmation to this effect in writing. Recent additions to our network, or service connections between the main cable and a building or street lamp may not be shown.

Map Response
T 0121 623 9780
NGED.MapResponse
@nationalgrid.co.uk

Damage to underground cables and contact with overhead lines can cause severe injury or may prove fatal. If you are excavating on site in the vicinity of either NGED Electrical apparatus or NGT Telecoms apparatus you must comply with the requirements of the following:-

Health & Safety Executive guidance HS(G)47, Avoiding Danger from underground services.

Work taking place in the vicinity of our plant is also regulated under the:-

Electricity at Work Regulations 1989, Health and Safety Act 1974, CDM Regulations 2015.
Safe working procedures should be defined and practiced

Please ensure that the use of mechanical excavators in the vicinity of our plant is kept to a minimum. NGT Telecoms ducts contain fibre cables, which are expensive to repair. Therefore, extreme care must be taken whilst working in the vicinity of these ducts, hand digging methods being used to determine their precise position.

If there are overhead lines crossing your site and your proposal involves building works which may infringe the clearance to our overhead system then you should call the relevant general enquiries number (see page 2 of this letter) for advice. Where overhead lines cross your site you must comply with the requirements of Health & Safety Executive guidance as laid down in GS6, Avoidance of Danger from Overhead Electric Lines.

National Grid Electricity
Distribution
South West - 02366894
South Wales - 02366985
East Midlands - 02366923
West Midlands - 03600574

Where diversions to NGED apparatus are needed to allow change to occur on site, the cost of these alterations may be charged to the persons responsible for the works.

If you require advice in connection with your proposals please contact the relevant general enquiries number (see page 2 of this letter)

Registered in
England and Wales


Following consultation the local NGED team will where necessary prepare detailed proposals and provide a quotation for any necessary alterations and/or development of our equipment on the site.

Registered Office:
Avonbank
Feeder Road
Bristol
BS2 0TB

This information is given as a guide only and its accuracy cannot be guaranteed. This plan is based on data from our Geographic Information System, which is updated every 24 hours to reflect changes to our network. The information contained in this plan reflects the most recent network GIS data, however changes to the network (including network additions and new service

Safety Documents:

<https://www.nationalgrid.co.uk/customers-and-community/health-safety/public-safety-advice>

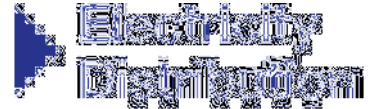

connections) may not be shown. You are advised to obtain an up to date plan on the date of commencing on-site works.

Yours sincerely
NGED Map Response Team

Contact Us

Emergency or Power Supply issues

In an emergency call 105, 24 hours a day.

Mapping Enquiries

If you have an enquiry relating to this letter or the attached map plan, please contact us using the following information:

Telephone 0121 623 9780
Email NGED.MapResponse@nationalgrid.co.uk

General Enquiries


If you have a general enquiry, please call us on the following telephone number:

All areas 0800 096 3080

LSBUD

If you have an enquiry relating to the use of the LSBUD website please contact LSBUD using the following information:

Telephone 0345 437 7365
Email enquiries@LSBUD.co.uk
Website www.LSBUD.co.uk

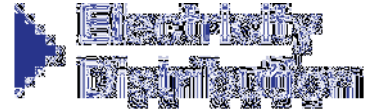


Steps to help keep you safe

- **If you are working within 10 metres of our 33kV, 66kV, 132kV underground electricity cables or within 10 meters of an overhead electricity line you should call the relevant General Enquiries for free safety advice.**

Safety Documents – please download our informative safety documents to help ensure that you, your staff and the public are kept safe whilst working in the vicinity of electricity.

<https://www.nationalgrid.co.uk/customers-and-community/health-safety/public-safety-advice>

- **Make sure you have up to date plans** - remember that recent additions to our network or service connections between the main cable and a building or street lamp may not be shown.
- **Look for signs of service cables** - an electricity meter box or nearby streetlamp may give you an indication that service cables are present in your area of work.
- **Non NGED Network** - electricity cables, lines and equipment owned by others may also be present in addition to NGED network. They are unlikely to be shown on our plans.
- **Use a cable locator** - trace electricity cables and mark the position of them using paint or other waterproof marking on the ground.
- **Hand dig trial holes** - to confirm the position of cables in close proximity to your area of your work and use spades and shovels rather than picks, pins or forks.
- **Have an emergency plan** - so that everyone working on site understands what to do in the event of an underground electricity cable being damaged or contact being made with an overhead electricity line.
- **If you are working within 10 meters** of an overhead electricity line then it may be necessary for you to erect warning signs and markers, or height restriction goal posts. Ensure that you comply with the requirements of Health & Safety Executive guidance laid down in GS6, Avoidance of Danger from Overhead Electric Lines.
- **If you are erecting a structure** that could allow anyone standing on it, or its access device (ladder, scaffold, MEWP), to come within 3m of any overhead electric line then **you must inform us**. This is your duty and a legal requirement under the Electricity Safety, Quality & Continuity Regulations 2002.
- **If you cannot work safely** around the underground electricity cable or overhead electricity line, then you may need to get it moved to allow your works to go ahead. Call the general enquiry numbers above for guidance.
- **It is possible that cables or pipes may be embedded in concrete** - electricity cables embedded in concrete **MUST** be made 'dead' by Western Power Distribution or the cable owner before the concrete is broken out. Alternatively, another safe way of working should be agreed.
- **Cables are sometimes covered by tiles or a marker tape** - these can be concrete, polythene or earthenware and are a useful early warning of the presence of cables; you should avoid disturbing any tiles or tape to expose the cable. Not all cables have these warning indicators.

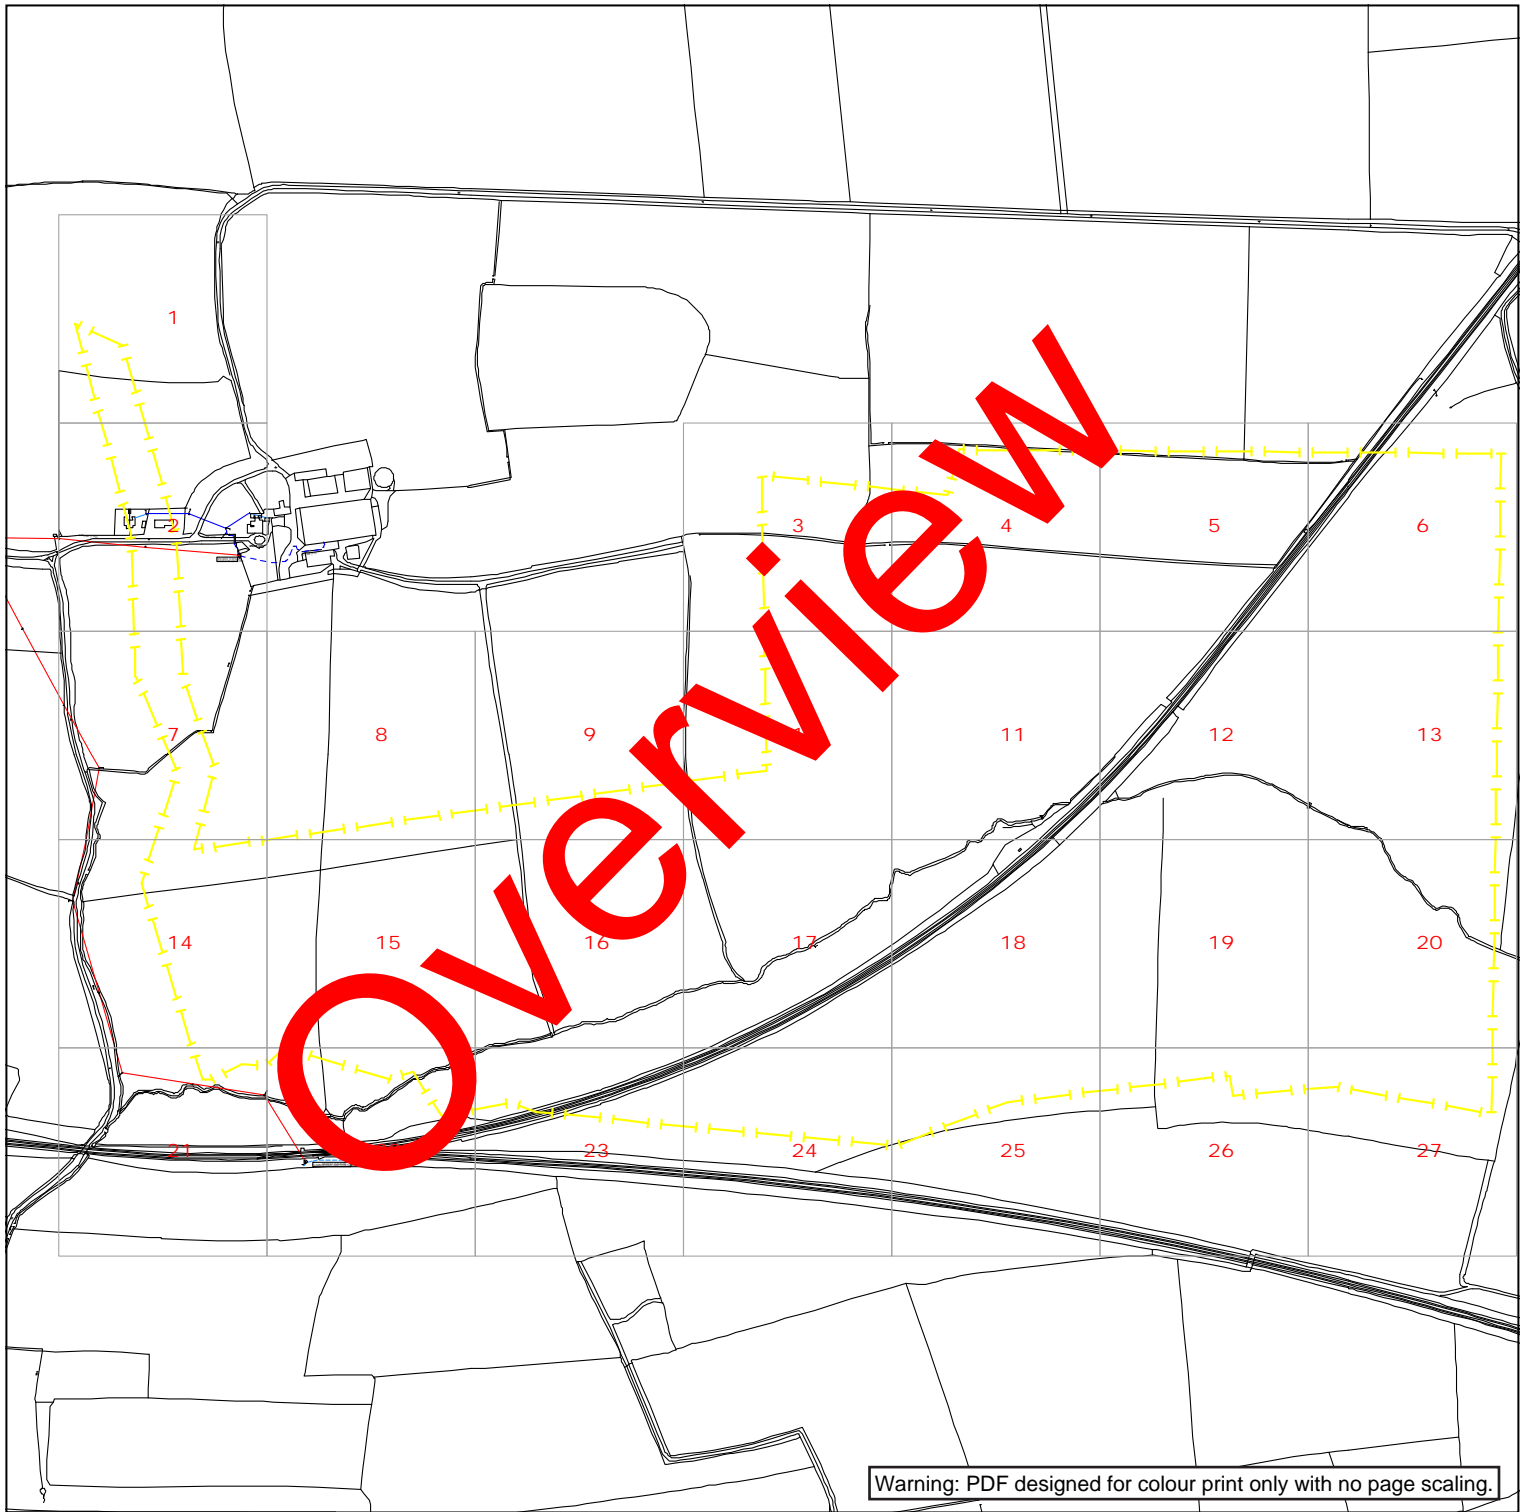

Warning: PDF designed for colour print only with no page scaling.

nationalgrid Electricity Distribution

Contact Us

Mapping Enquiries:
All areas 0121 623 9780

General Enquiries:
All areas 0800 096 3080

Date Requested: 08/05/2023
Job Reference: 29406944
Site Location: 476361 383022
Requested by:
Mr Ben Evans
Your Scheme/Reference:
LM 203570/DK - 8


Link Box	Overhead Line	Underground Cable	National Grid Telecoms	Pilot Cables
●	○ PL ○ Service ○ LV ○ HV (11kV) ○ HV (33kV) ○ HV (66kV) ○ HV (132kV)	--- --- --- ---	--- PME Earth --- Underground Earth	--- ○ Pole Mounted Transformer □ Ground Mounted Transformer

IMPORTANT NOTICES

- This information is given as a guide only and its accuracy cannot be guaranteed. Services or recent additions to the network may not be shown.
- Cables, overhead lines & substations owned by other electricity network owners or private companies may be present and may not be shown.
- You should always verify exact locations of cables using a cable locator and by careful use of hand tools in accordance with HSE guidance note HSG47.
- When working within 10m of any overhead electric line you should follow the requirements of HSE Guidance Note GS6.
- For further advice on working near our electricity cables or lines, call our General Enquiries number.
- Advice should be sought from the National Grid Electricity Distribution General Enquiries team for any work that is to take place in proximity to 132kV underground cables and 132kV overhead lines.

Report damage immediately – KEEP EVERYONE AWAY FROM THE AREA
0800 6783 105

Crown Copyright © All Rights Reserved. Ordnance Survey Licence numbers: 100022432
NGED Copyright: This copy has been made by or with the authority of National Grid Electricity Distribution (NGED) pursuant to Section 47 of the Copyright Designs and Patents Act 1988 unless that Act provides a relevant exception to copyright the copy must not be copied without the prior permission of the copyright owner.

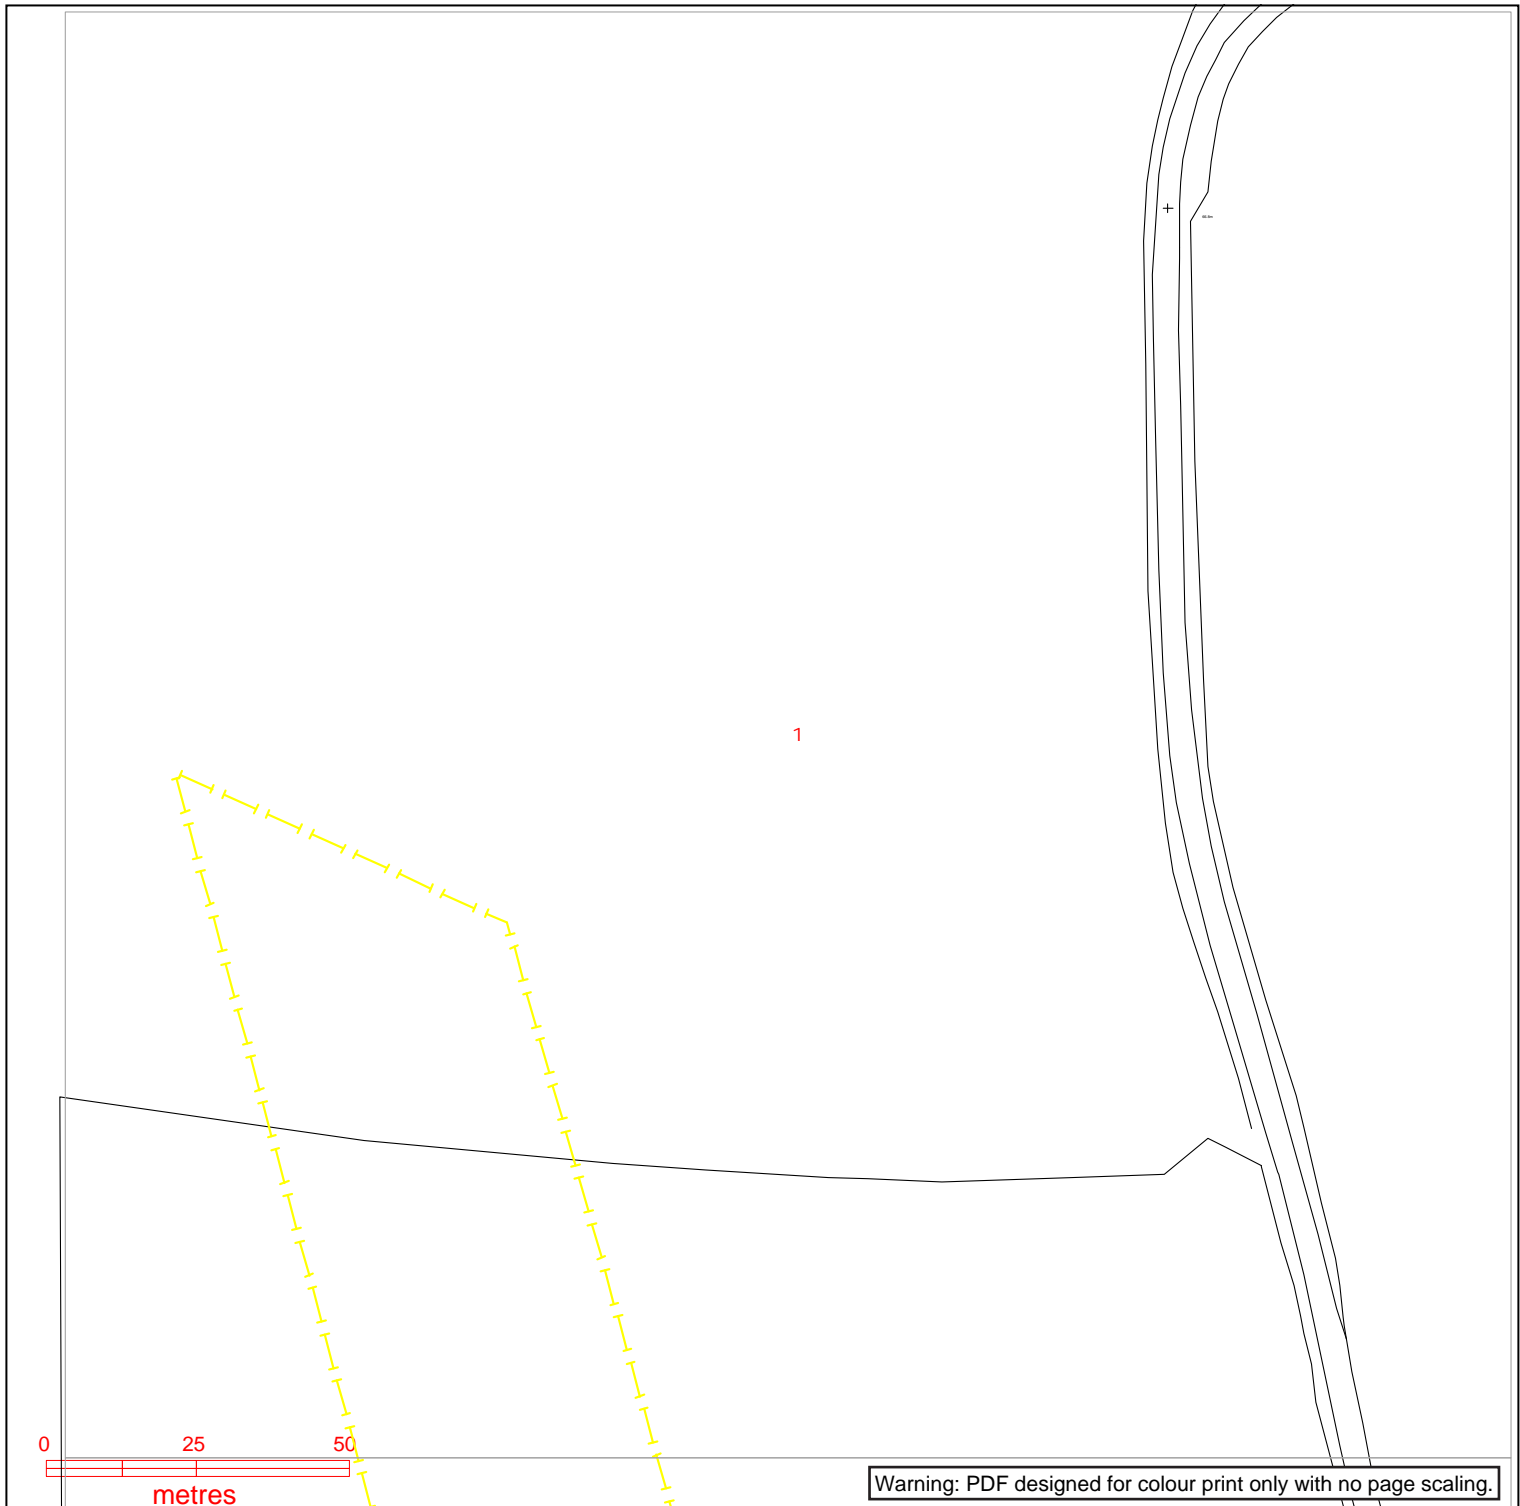

nationalgrid Electricity Distribution

Contact Us

Mapping Enquiries:
All areas 0121 623 9780

General Enquiries:
All areas 0800 096 3080

Date Requested: 08/05/2023
Job Reference: 29406944
Site Location: 476361 383022
Requested by:
Mr Ben Evans
Your Scheme/Reference:
LM 203570/DK - 8

Exact Scales:
1:1250 Area or Circle dig site
1:500 Line dig site


Link Box ●	Overhead Line ○—○ PL ○—○ Service ○—○ LV ○—○ HV (11kV) ○—○ HV (33kV) ○—○ HV (66kV) ○—○ HV (132kV)	Underground Cable -	National Grid Telecoms - - - - - PME Earth Underground Earth	Pilot Cables ○ □ Pole Mounted Transformer Ground Mounted Transformer
----------------------	--	---	--	---

IMPORTANT NOTICES

- This information is given as a guide only and its accuracy cannot be guaranteed. Services or recent additions to the network may not be shown.
- Cables, overhead lines & substations owned by other electricity network owners or private companies may be present and may not be shown.
- You should always verify exact locations of cables using a cable locator and by careful use of hand tools in accordance with HSE guidance note HSG47.
- When working within 10m of any overhead electric line you should follow the requirements of HSE Guidance Note GS6.
- For further advice on working near our electricity cables or lines, call our General Enquiries number.
- Advice should be sought from the National Grid Electricity Distribution General Enquiries team for any work that is to take place in proximity to 132kV underground cables and 132kV overhead lines.

Report damage immediately – KEEP EVERYONE AWAY FROM THE AREA
0800 6783 105

Crown Copyright © All Rights Reserved. Ordnance Survey Licence numbers: 100022432
NGED Copyright: This copy has been made by or with the authority of National Grid Electricity Distribution (NGED) pursuant to Section 47 of the Copyright Designs and Patents Act 1988 unless that Act provides a relevant exception to copyright the copy must not be copied without the prior permission of the copyright owner.

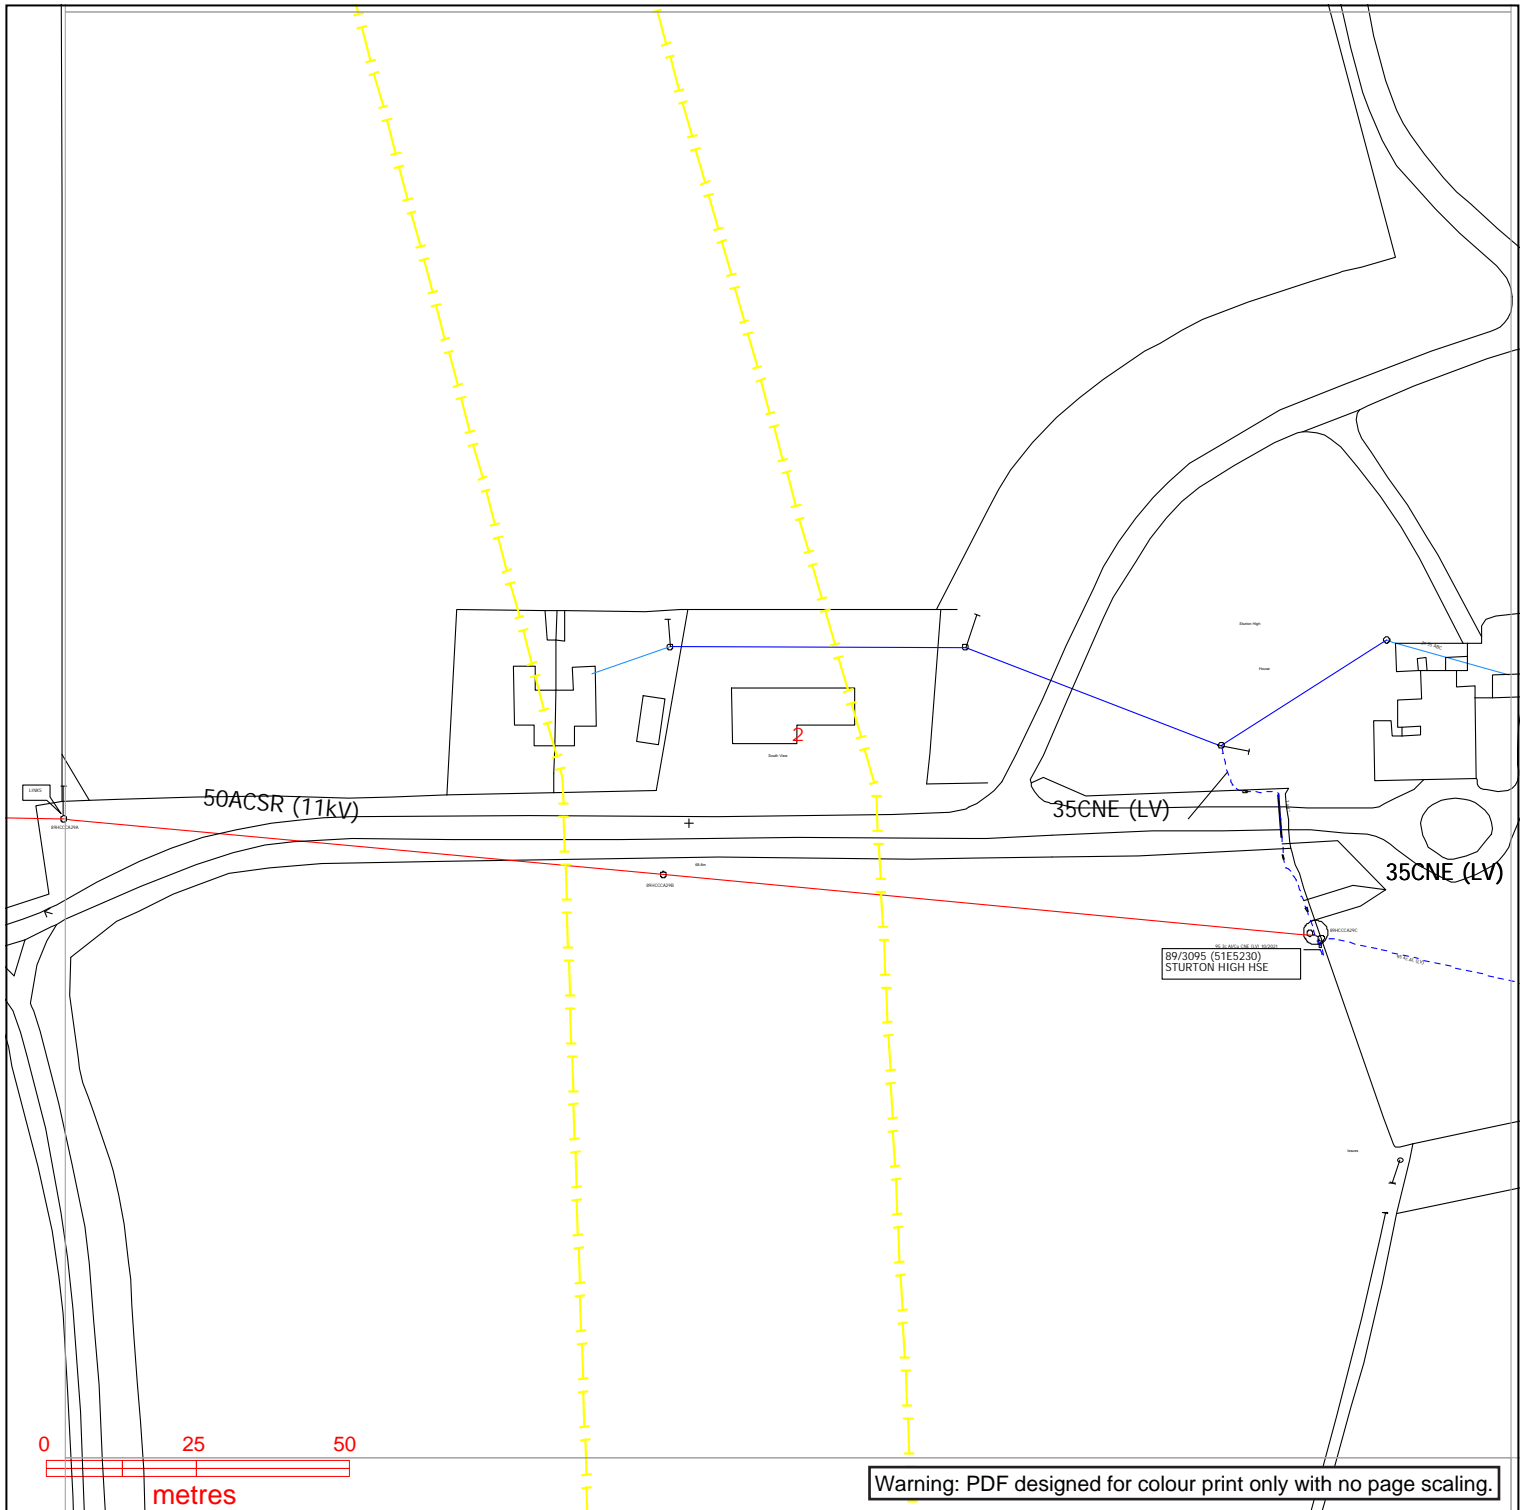

nationalgrid Electricity Distribution

Contact Us

Mapping Enquiries:
All areas 0121 623 9780

General Enquiries:
All areas 0800 096 3080

Date Requested: 08/05/2023
Job Reference: 29406944
Site Location: 476361 383022
Requested by:
Mr Ben Evans
Your Scheme/Reference:
LM 203570/DK - 8

Exact Scales:
1:1250 Area or Circle dig site
1:500 Line dig site


Link Box	Overhead Line	Underground Cable	National Grid Telecoms	Pilot Cables
●	<ul style="list-style-type: none"> ○ PL ○ Service ○ LV ○ HV (11kV) ○ HV (33kV) ○ HV (66kV) ○ HV (132kV) 	<ul style="list-style-type: none"> --- --- --- --- --- --- --- 	<ul style="list-style-type: none"> --- PME Earth ---E Underground Earth 	<ul style="list-style-type: none"> ○ Pole Mounted Transformer □ Ground Mounted Transformer
●	<ul style="list-style-type: none"> ○ Site Location ○ Line/Area 	<ul style="list-style-type: none"> --- --- --- --- --- --- --- 		

IMPORTANT NOTICES

- This information is given as a guide only and its accuracy cannot be guaranteed. Services or recent additions to the network may not be shown.
- Cables, overhead lines & substations owned by other electricity network owners or private companies may be present and may not be shown.
- You should always verify exact locations of cables using a cable locator and by careful use of hand tools in accordance with HSE guidance note HSG47.
- When working within 10m of any overhead electric line you should follow the requirements of HSE Guidance Note GS6.
- For further advice on working near our electricity cables or lines, call our General Enquiries number.
- Advice should be sought from the National Grid Electricity Distribution General Enquiries team for any work that is to take place in proximity to 132kV underground cables and 132kV overhead lines.

Report damage immediately – KEEP EVERYONE AWAY FROM THE AREA
0800 6783 105

Crown Copyright © All Rights Reserved. Ordnance Survey Licence numbers: 100022432
NGED Copyright: This copy has been made by or with the authority of National Grid Electricity Distribution (NGED) pursuant to Section 47 of the Copyright Designs and Patents Act 1988 unless that Act provides a relevant exception to copyright the copy must not be copied without the prior permission of the copyright owner.

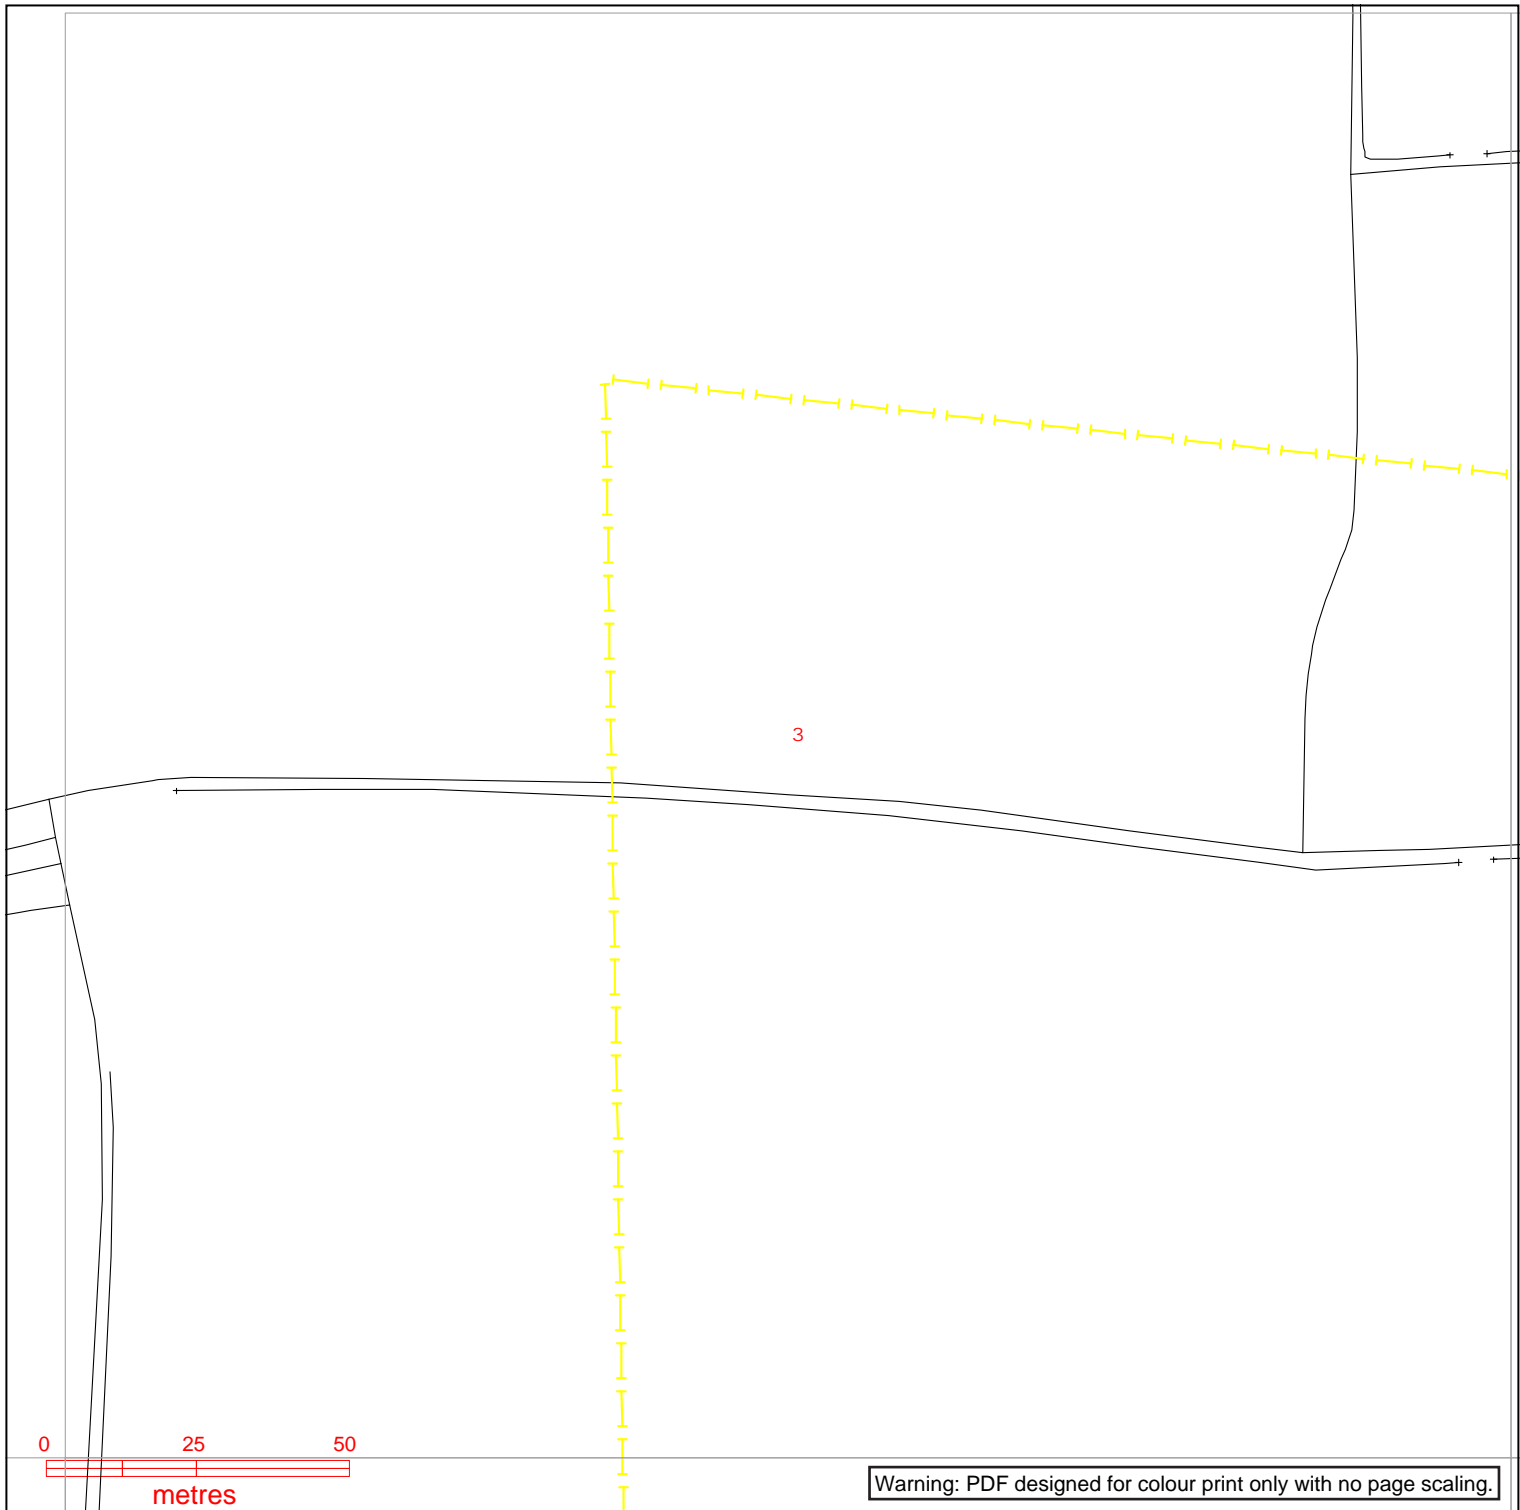

Warning: PDF designed for colour print only with no page scaling.

nationalgrid Electricity Distribution

Contact Us

Mapping Enquiries:
All areas 0121 623 9780

General Enquiries:
All areas 0800 096 3080

Date Requested: 08/05/2023
Job Reference: 29406944
Site Location: 476361 383022
Requested by:
Mr Ben Evans
Your Scheme/Reference:
LM 203570/DK - 8

Exact Scales:
1:1250 Area or Circle dig site
1:500 Line dig site


Link Box ●	Overhead Line ○—○ PL ○—○ Service ○—○ LV ○—○ HV (11kV) ○—○ HV (33kV) ○—○ HV (66kV) □—□ HV (132kV)	Underground Cable -	National Grid Telecoms - - - - - PME Earth -E- - - - - Underground Earth	Pilot Cables ○ Pole Mounted Transformer □ Ground Mounted Transformer
----------------------	--	---	---	---

IMPORTANT NOTICES

- This information is given as a guide only and its accuracy cannot be guaranteed. Services or recent additions to the network may not be shown.
- Cables, overhead lines & substations owned by other electricity network owners or private companies may be present and may not be shown.
- You should always verify exact locations of cables using a cable locator and by careful use of hand tools in accordance with HSE guidance note HSG47.
- When working within 10m of any overhead electric line you should follow the requirements of HSE Guidance Note GS6.
- For further advice on working near our electricity cables or lines, call our General Enquiries number.
- Advice should be sought from the National Grid Electricity Distribution General Enquiries team for any work that is to take place in proximity to 132kV underground cables and 132kV overhead lines.

Report damage immediately – KEEP EVERYONE AWAY FROM THE AREA
0800 6783 105

Crown Copyright © All Rights Reserved. Ordnance Survey Licence numbers: 100022432
NGED Copyright: This copy has been made by or with the authority of National Grid Electricity Distribution (NGED) pursuant to Section 47 of the Copyright Designs and Patents Act 1988 unless that Act provides a relevant exception to copyright the copy must not be copied without the prior permission of the copyright owner.

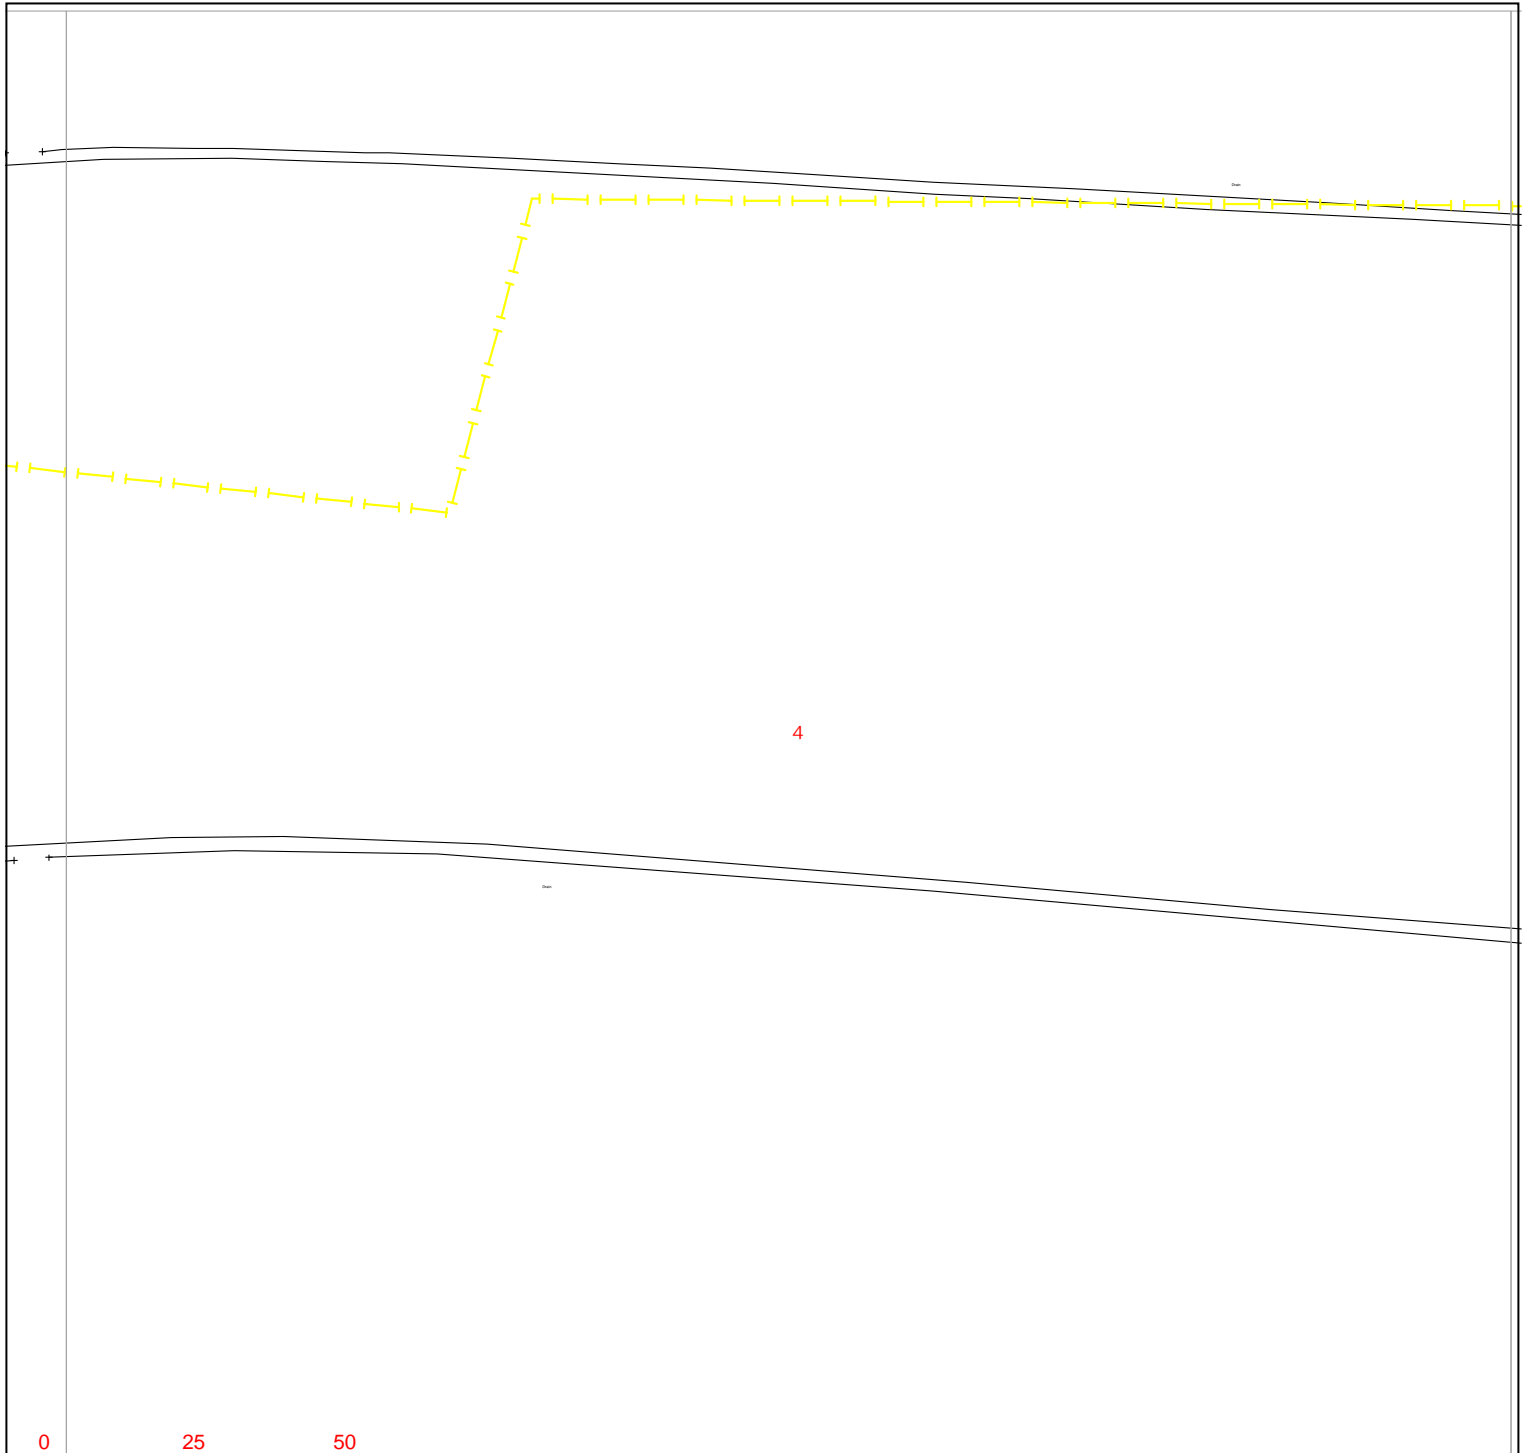

Warning: PDF designed for colour print only with no page scaling.



Contact Us
Mapping Enquiries:
 All areas 0121 623 9780
General Enquiries:
 All areas 0800 096 3080

Date Requested: 08/05/2023
 Job Reference: 29406944
 Site Location: 476361 383022
 Requested by:
 Mr Ben Evans
 Your Scheme/Reference:
 LM 203570/DK - 8

Exact Scales:
 1:1250 Area or Circle dig site
 1:500 Line dig site


Link Box	Overhead Line	Underground Cable	National Grid Telecoms	Pilot Cables
●				
Site Location 				

IMPORTANT NOTICES

- This information is given as a guide only and its accuracy cannot be guaranteed. Services or recent additions to the network may not be shown.
- Cables, overhead lines & substations owned by other electricity network owners or private companies may be present and may not be shown.
- You should always verify exact locations of cables using a cable locator and by careful use of hand tools in accordance with HSE guidance note HSG47.
- When working within 10m of any overhead electric line you should follow the requirements of HSE Guidance Note GS6.
- For further advice on working near our electricity cables or lines, call our General Enquiries number.
- Advice should be sought from the National Grid Electricity Distribution General Enquiries team for any work that is to take place in proximity to 132kV underground cables and 132kV overhead lines.

Report damage immediately – KEEP EVERYONE AWAY FROM THE AREA
0800 6783 105

Crown Copyright © All Rights Reserved. Ordnance Survey Licence numbers: 100022432
 NGED Copyright: This copy has been made by or with the authority of National Grid Electricity Distribution (NGED) pursuant to Section 47 of the Copyright Designs and Patents Act 1988 unless that Act provides a relevant exception to copyright the copy must not be copied without the prior permission of the copyright owner.

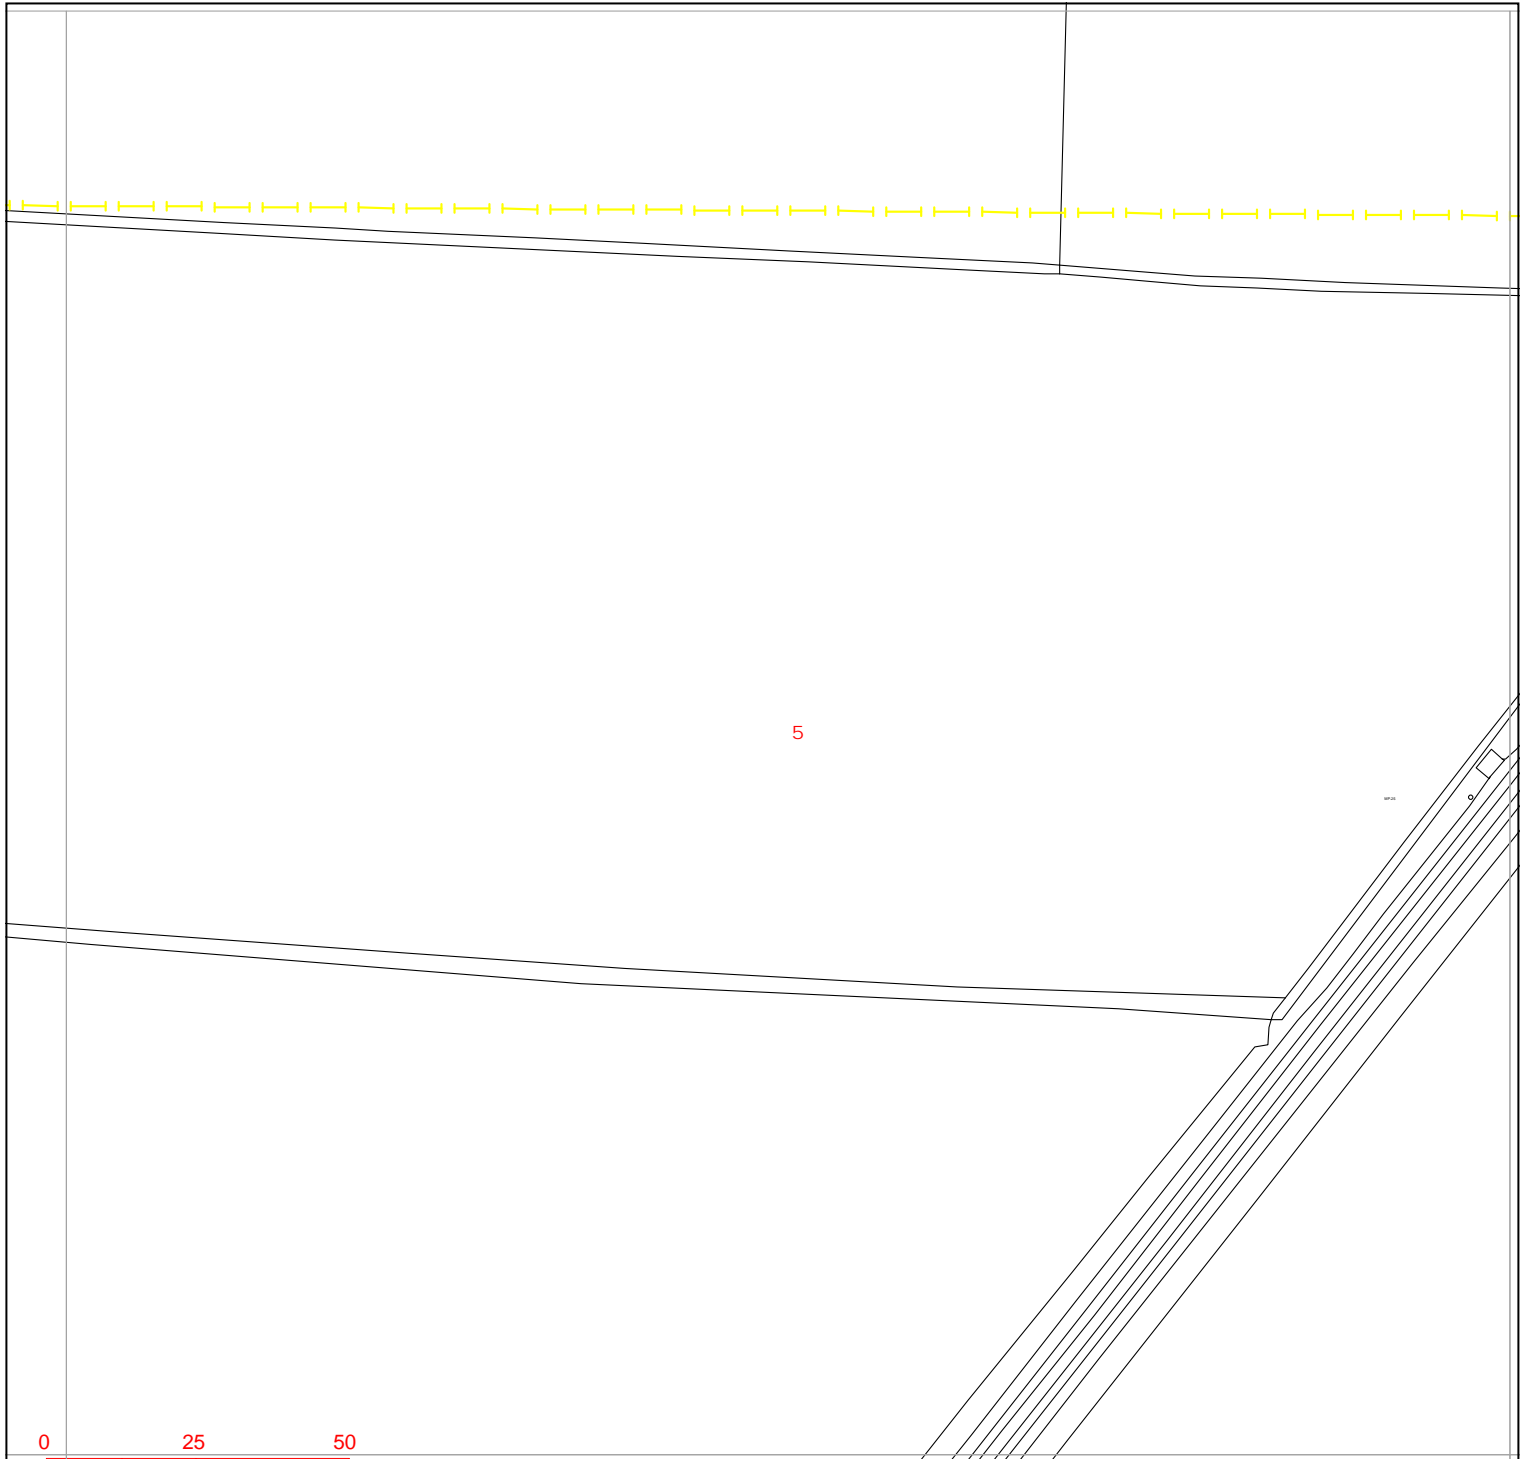

Warning: PDF designed for colour print only with no page scaling.



Contact Us
 Mapping Enquiries:
 All areas 0121 623 9780
 General Enquiries:
 All areas 0800 096 3080

Date Requested: 08/05/2023
 Job Reference: 29406944
 Site Location: 476361 383022
 Requested by:
 Mr Ben Evans
 Your Scheme/Reference:
 LM 203570/DK - 8

Exact Scales:
 1:1250 Area or Circle dig site
 1:500 Line dig site


<p>Link Box ●</p> <p>Site Location Line/Area</p>	<p>Overhead Line</p> <ul style="list-style-type: none"> PL Service LV HV (11kV) HV (33kV) HV (66kV) HV (132kV) 	<p>Underground Cable</p> <ul style="list-style-type: none"> PL Service LV HV (11kV) HV (33kV) HV (66kV) HV (132kV) 	<p>National Grid Telecoms</p> <ul style="list-style-type: none"> PME Earth Underground Earth 	<p>Pilot Cables</p> <ul style="list-style-type: none"> Pole Mounted Transformer Ground Mounted Transformer
--	---	---	---	---

IMPORTANT NOTICES

- This information is given as a guide only and its accuracy cannot be guaranteed. Services or recent additions to the network may not be shown.
- Cables, overhead lines & substations owned by other electricity network owners or private companies may be present and may not be shown.
- You should always verify exact locations of cables using a cable locator and by careful use of hand tools in accordance with HSE guidance note HSG47.
- When working within 10m of any overhead electric line you should follow the requirements of HSE Guidance Note GS6.
- For further advice on working near our electricity cables or lines, call our General Enquiries number.
- Advice should be sought from the National Grid Electricity Distribution General Enquiries team for any work that is to take place in proximity to 132kV underground cables and 132kV overhead lines.

Report damage immediately – KEEP EVERYONE AWAY FROM THE AREA
0800 6783 105

Crown Copyright © All Rights Reserved. Ordnance Survey Licence numbers: 100022432
 NGED Copyright: This copy has been made by or with the authority of National Grid Electricity Distribution (NGED) pursuant to Section 47 of the Copyright Designs and Patents Act 1988 unless that Act provides a relevant exception to copyright the copy must not be copied without the prior permission of the copyright owner.

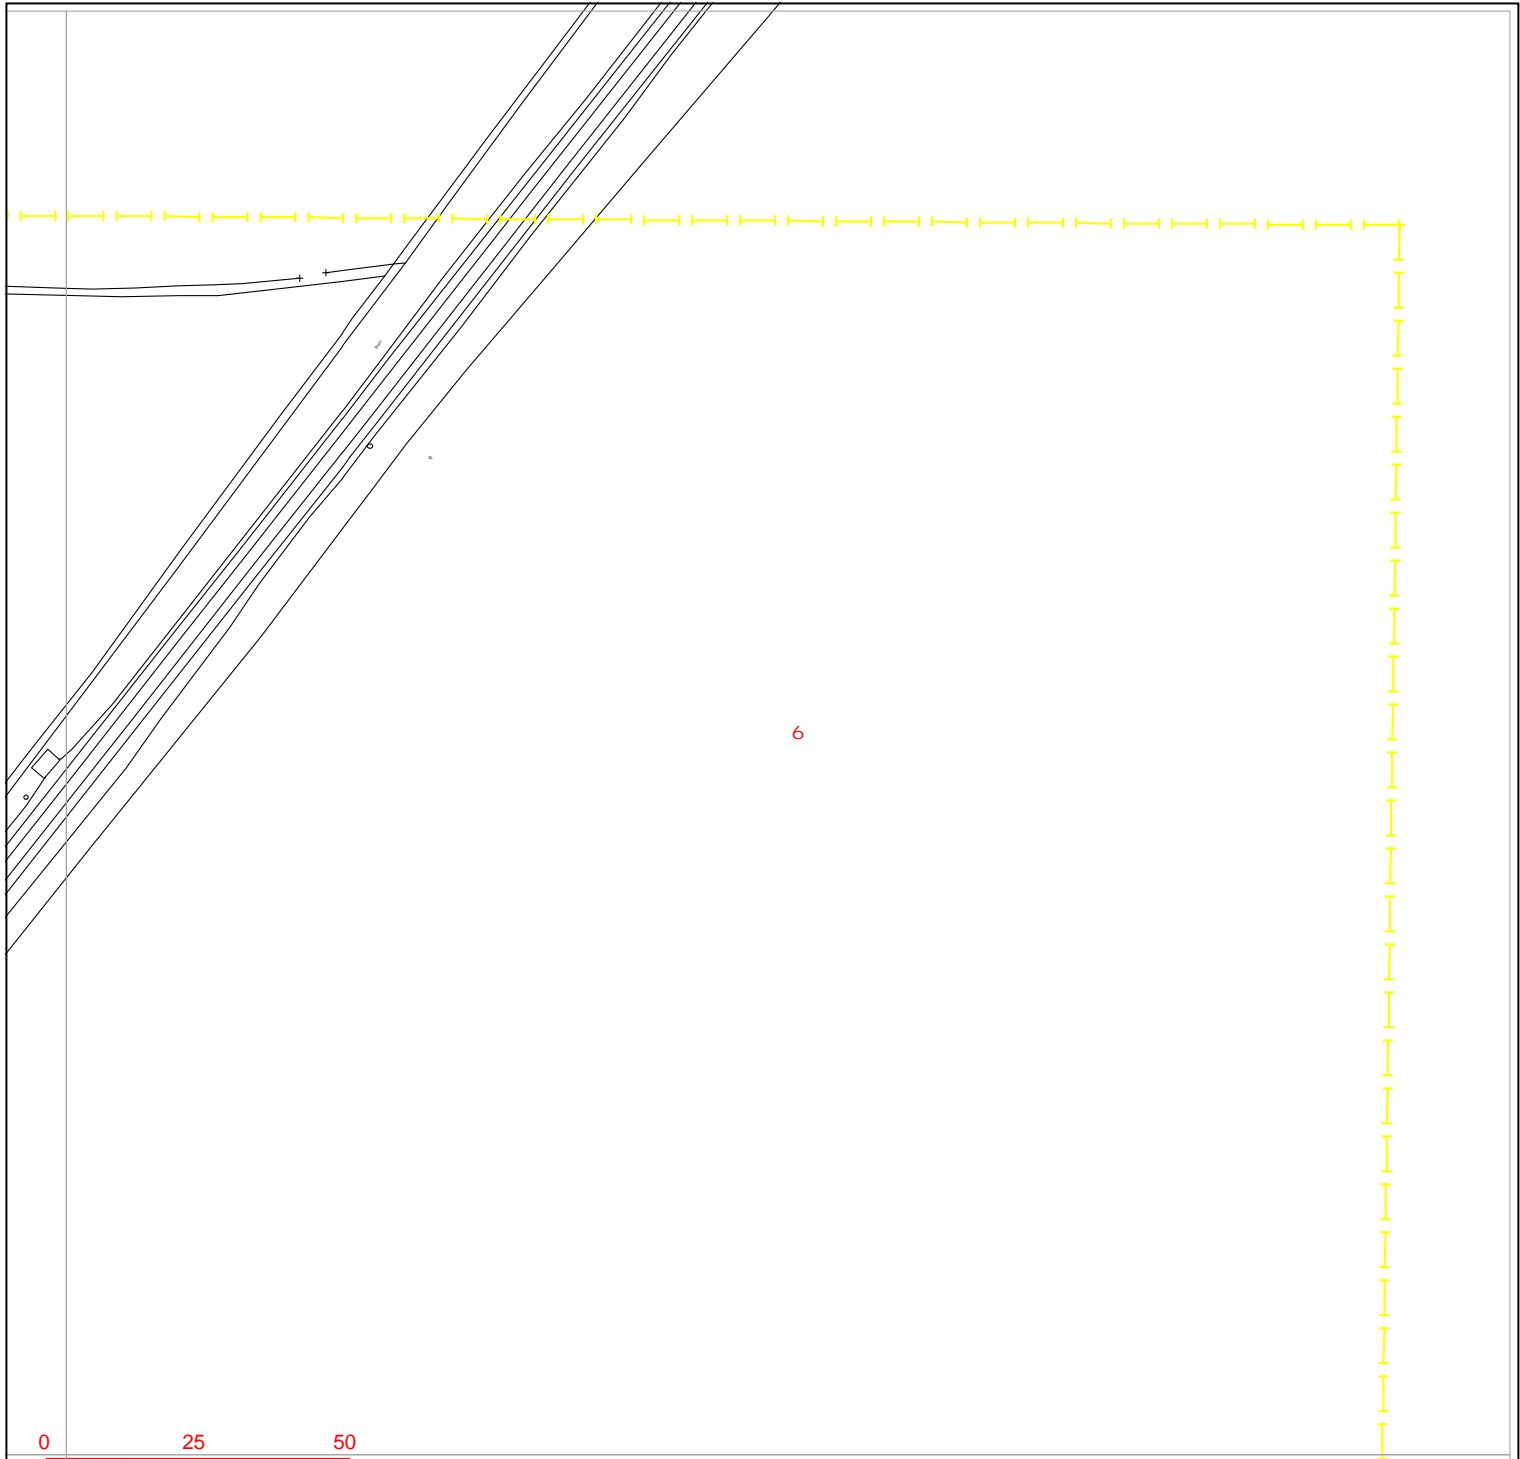

Warning: PDF designed for colour print only with no page scaling.



Contact Us
 Mapping Enquiries:
 All areas 0121 623 9780

General Enquiries:
 All areas 0800 096 3080

Date Requested: 08/05/2023
 Job Reference: 29406944
 Site Location: 476361 383022
 Requested by:
 Mr Ben Evans
 Your Scheme/Reference:
 LM 203570/DK - 8

Exact Scales:
 1:1250 Area or Circle dig site
 1:500 Line dig site


Link Box	Overhead Line	Underground Cable	National Grid Telecoms	Pilot Cables
●				
●	Site Location 			
— — —				

IMPORTANT NOTICES

- This information is given as a guide only and its accuracy cannot be guaranteed. Services or recent additions to the network may not be shown.
- Cables, overhead lines & substations owned by other electricity network owners or private companies may be present and may not be shown.
- You should always verify exact locations of cables using a cable locator and by careful use of hand tools in accordance with HSE guidance note HSG47.
- When working within 10m of any overhead electric line you should follow the requirements of HSE Guidance Note GS6.
- For further advice on working near our electricity cables or lines, call our General Enquiries number.
- Advice should be sought from the National Grid Electricity Distribution General Enquiries team for any work that is to take place in proximity to 132kV underground cables and 132kV overhead lines.

Report damage immediately – KEEP EVERYONE AWAY FROM THE AREA
0800 6783 105

Crown Copyright © All Rights Reserved. Ordnance Survey Licence numbers: 100022432
 NGED Copyright: This copy has been made by or with the authority of National Grid Electricity Distribution (NGED) pursuant to Section 47 of the Copyright Designs and Patents Act 1988 unless that Act provides a relevant exception to copyright the copy must not be copied without the prior permission of the copyright owner.

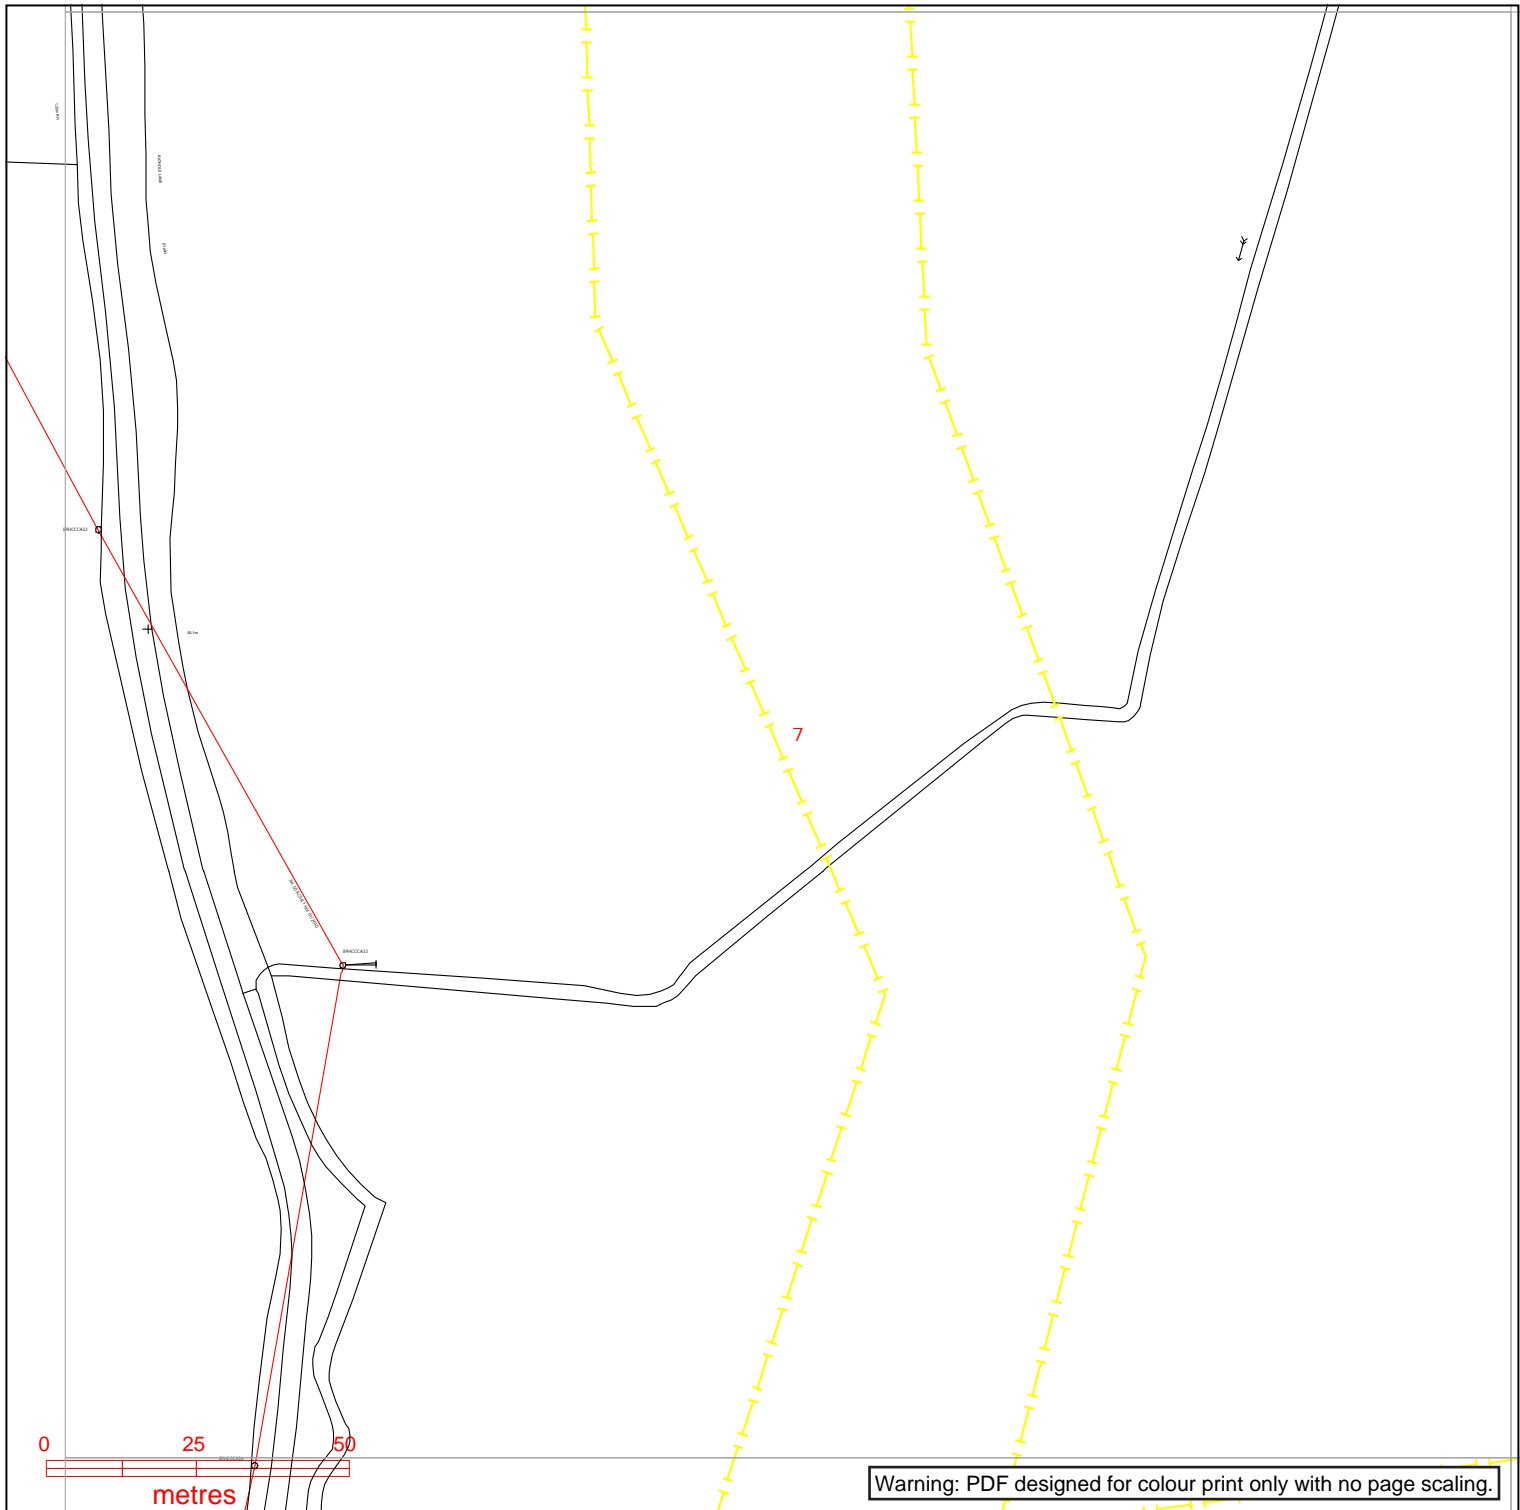

nationalgrid Electricity Distribution

Contact Us

Mapping Enquiries:
All areas 0121 623 9780

General Enquiries:
All areas 0800 096 3080

Date Requested: 08/05/2023
Job Reference: 29406944
Site Location: 476361 383022
Requested by:
Mr Ben Evans
Your Scheme/Reference:
LM 203570/DK - 8

Exact Scales:
1:1250 Area or Circle dig site
1:500 Line dig site


Link Box	Overhead Line	Underground Cable	National Grid Telecoms	Pilot Cables
●	<ul style="list-style-type: none"> ○ PL ○ Service ○ LV ○ HV (11kV) ○ HV (33kV) ○ HV (66kV) ○ HV (132kV) 	<ul style="list-style-type: none"> --- --- --- --- --- --- --- 	<ul style="list-style-type: none"> --- PME Earth ---E Underground Earth 	<ul style="list-style-type: none"> ○ Pole Mounted Transformer □ Ground Mounted Transformer
●	<ul style="list-style-type: none"> ○ Site Location ○ Line/Area 	<ul style="list-style-type: none"> --- --- --- --- --- --- --- 		

IMPORTANT NOTICES

- This information is given as a guide only and its accuracy cannot be guaranteed. Services or recent additions to the network may not be shown.
- Cables, overhead lines & substations owned by other electricity network owners or private companies may be present and may not be shown.
- You should always verify exact locations of cables using a cable locator and by careful use of hand tools in accordance with HSE guidance note HSG47.
- When working within 10m of any overhead electric line you should follow the requirements of HSE Guidance Note GS6.
- For further advice on working near our electricity cables or lines, call our General Enquiries number.
- Advice should be sought from the National Grid Electricity Distribution General Enquiries team for any work that is to take place in proximity to 132kV underground cables and 132kV overhead lines.

Report damage immediately – KEEP EVERYONE AWAY FROM THE AREA
0800 6783 105

Crown Copyright © All Rights Reserved. Ordnance Survey Licence numbers: 100022432
NGED Copyright: This copy has been made by or with the authority of National Grid Electricity Distribution (NGED) pursuant to Section 47 of the Copyright Designs and Patents Act 1988 unless that Act provides a relevant exception to copyright the copy must not be copied without the prior permission of the copyright owner.

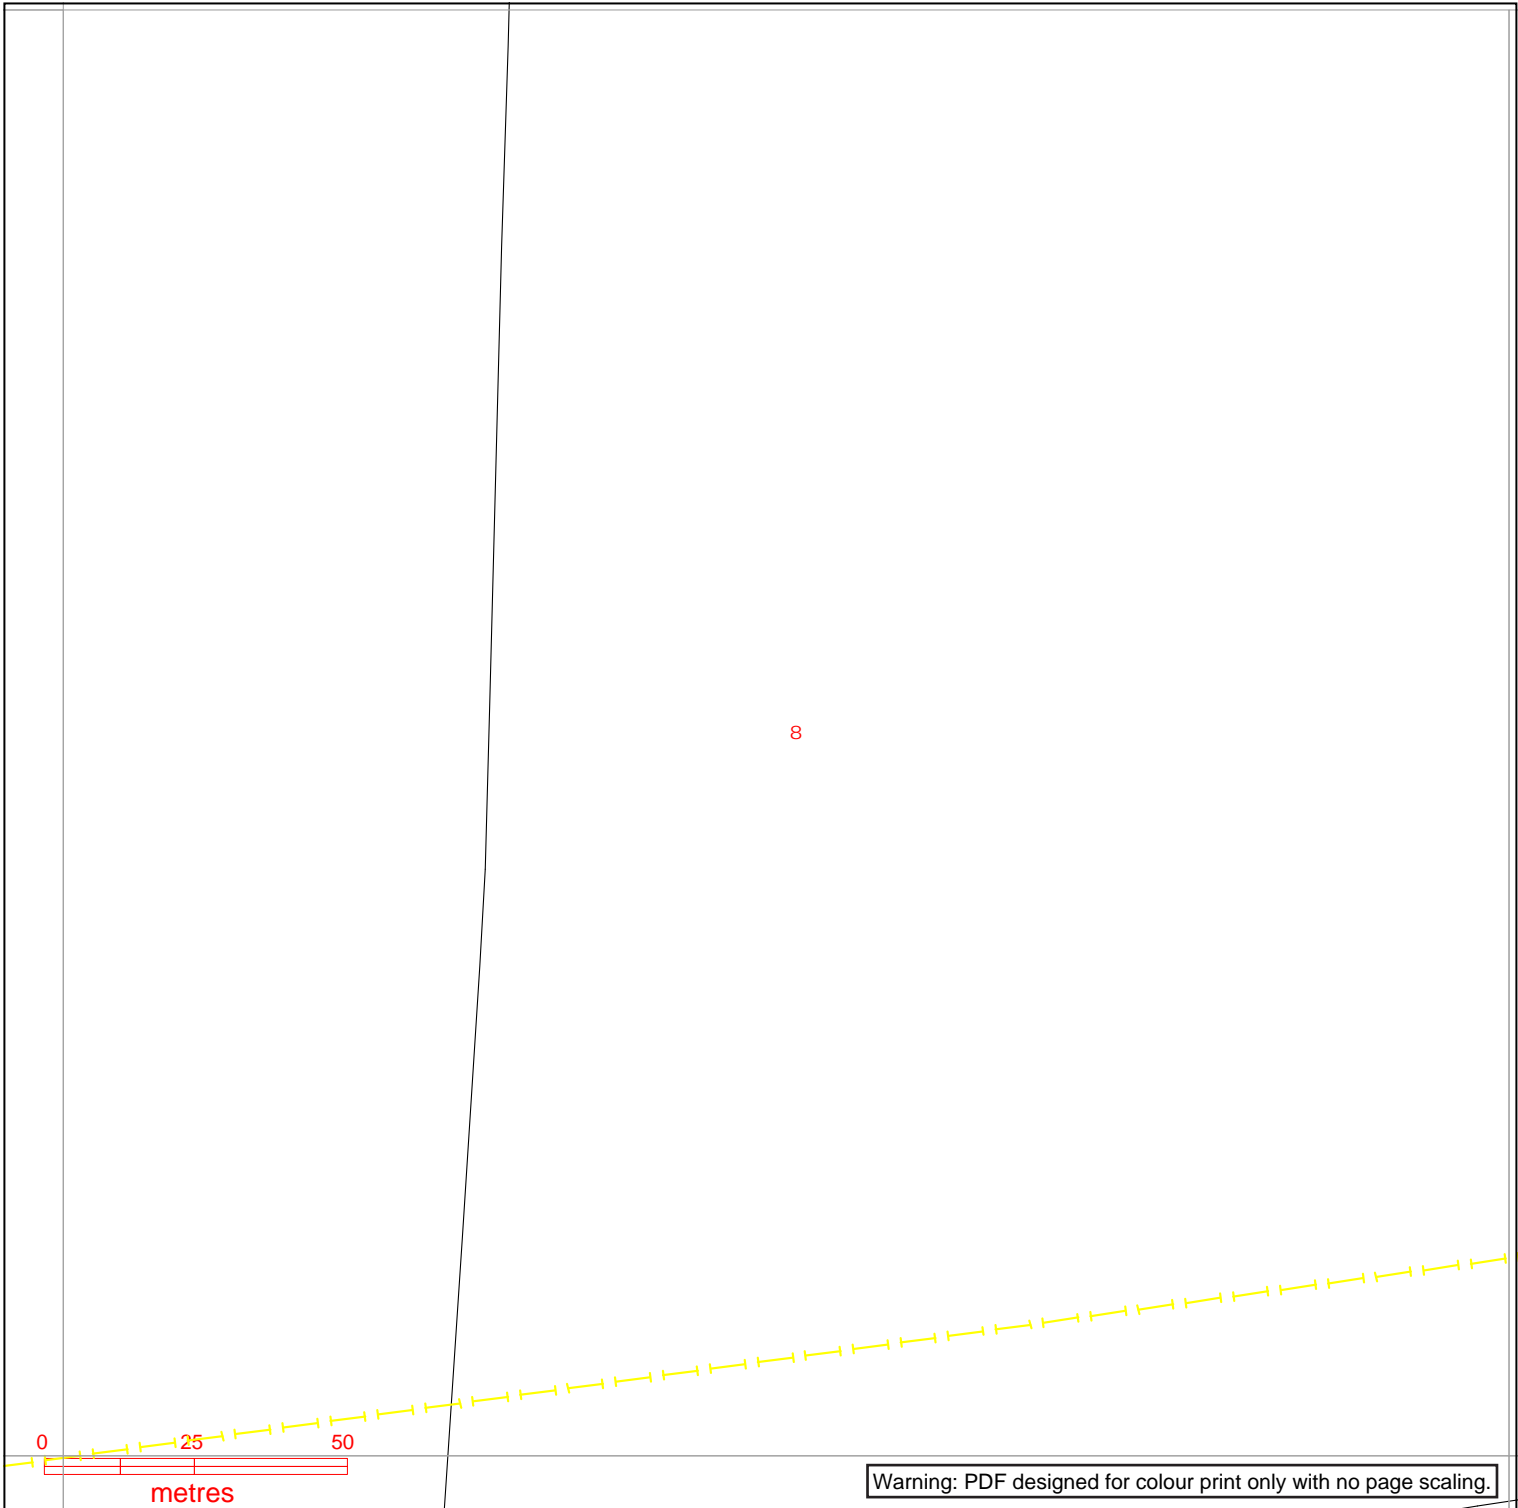

Warning: PDF designed for colour print only with no page scaling.

nationalgrid Electricity Distribution

Contact Us

Mapping Enquiries:
All areas 0121 623 9780

General Enquiries:
All areas 0800 096 3080

Date Requested: 08/05/2023
Job Reference: 29406944
Site Location: 476361 383022
Requested by:
Mr Ben Evans
Your Scheme/Reference:
LM 203570/DK - 8

Exact Scales:
1:1250 Area or Circle dig site
1:500 Line dig site


Link Box ●	Overhead Line ○—○ PL ○—○ Service ○—○ LV ○—○ HV (11kV) ○—○ HV (33kV) ○—○ HV (66kV) □—□ HV (132kV)	Underground Cable -	National Grid Telecoms - - - - - PME Earth Underground Earth	Pilot Cables ○ □ Pole Mounted Transformer Ground Mounted Transformer
----------------------	--	--	--	---

IMPORTANT NOTICES

- This information is given as a guide only and its accuracy cannot be guaranteed. Services or recent additions to the network may not be shown.
- Cables, overhead lines & substations owned by other electricity network owners or private companies may be present and may not be shown.
- You should always verify exact locations of cables using a cable locator and by careful use of hand tools in accordance with HSE guidance note HSG47.
- When working within 10m of any overhead electric line you should follow the requirements of HSE Guidance Note GS6.
- For further advice on working near our electricity cables or lines, call our General Enquiries number.
- Advice should be sought from the National Grid Electricity Distribution General Enquiries team for any work that is to take place in proximity to 132kV underground cables and 132kV overhead lines.

Report damage immediately – KEEP EVERYONE AWAY FROM THE AREA
0800 6783 105

Crown Copyright © All Rights Reserved. Ordnance Survey Licence numbers: 100022432
NGED Copyright: This copy has been made by or with the authority of National Grid Electricity Distribution (NGED) pursuant to Section 47 of the Copyright Designs and Patents Act 1988 unless that Act provides a relevant exception to copyright the copy must not be copied without the prior permission of the copyright owner.

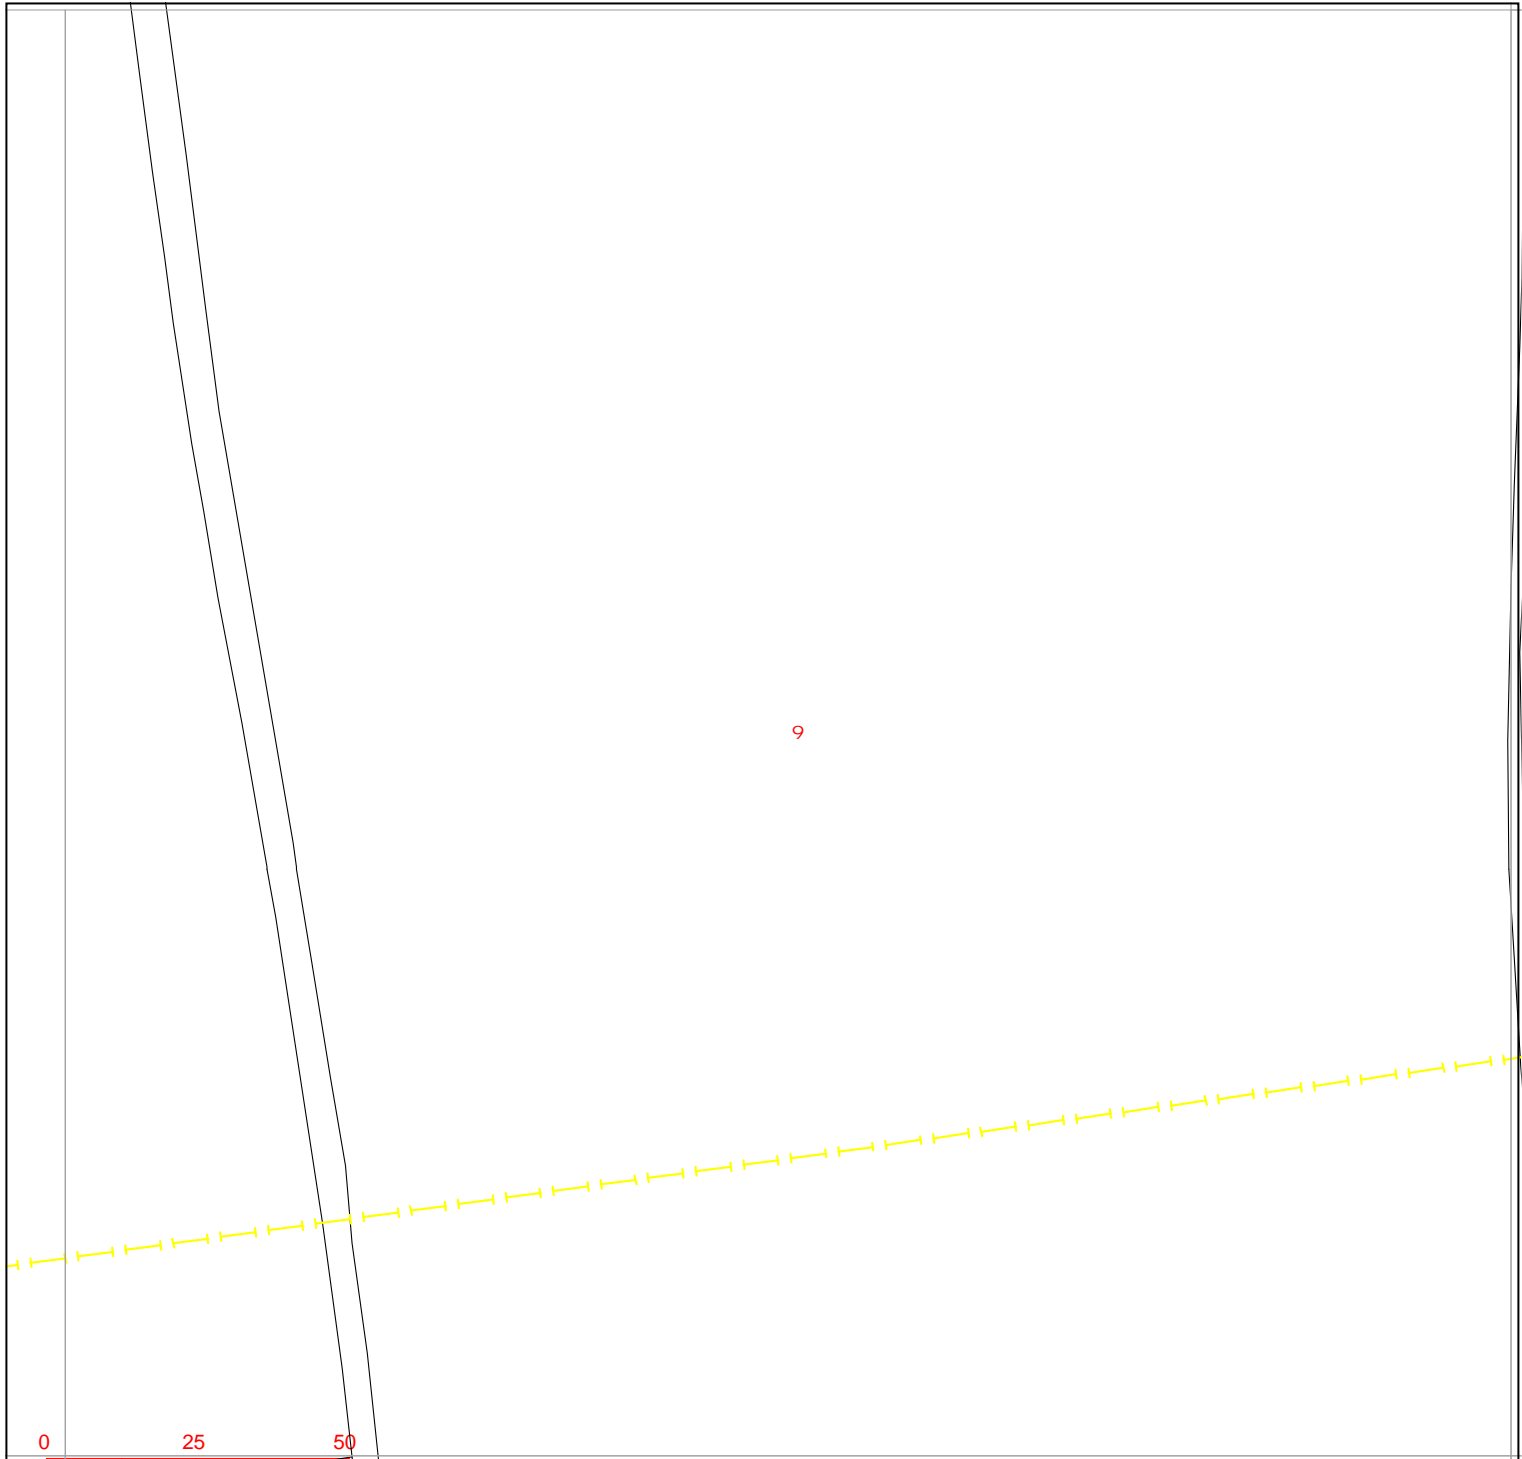

Warning: PDF designed for colour print only with no page scaling.



Contact Us

Mapping Enquiries:
All areas 0121 623 9780

General Enquiries:
All areas 0800 096 3080

Date Requested: 08/05/2023
Job Reference: 29406944
Site Location: 476361 383022
Requested by:
Mr Ben Evans
Your Scheme/Reference:
LM 203570/DK - 8

Exact Scales:
1:1250 Area or Circle dig site
1:500 Line dig site


Link Box	Overhead Line	Underground Cable	National Grid Telecoms	Pilot Cables
●				
○				

IMPORTANT NOTICES

- This information is given as a guide only and its accuracy cannot be guaranteed. Services or recent additions to the network may not be shown.
- Cables, overhead lines & substations owned by other electricity network owners or private companies may be present and may not be shown.
- You should always verify exact locations of cables using a cable locator and by careful use of hand tools in accordance with HSE guidance note HSG47.
- When working within 10m of any overhead electric line you should follow the requirements of HSE Guidance Note GS6.
- For further advice on working near our electricity cables or lines, call our General Enquiries number.
- Advice should be sought from the National Grid Electricity Distribution General Enquiries team for any work that is to take place in proximity to 132kV underground cables and 132kV overhead lines.

Report damage immediately – KEEP EVERYONE AWAY FROM THE AREA
0800 6783 105

Crown Copyright © All Rights Reserved. Ordnance Survey Licence numbers: 100022432
NGED Copyright: This copy has been made by or with the authority of National Grid Electricity Distribution (NGED) pursuant to Section 47 of the Copyright Designs and Patents Act 1988 unless that Act provides a relevant exception to copyright the copy must not be copied without the prior permission of the copyright owner.

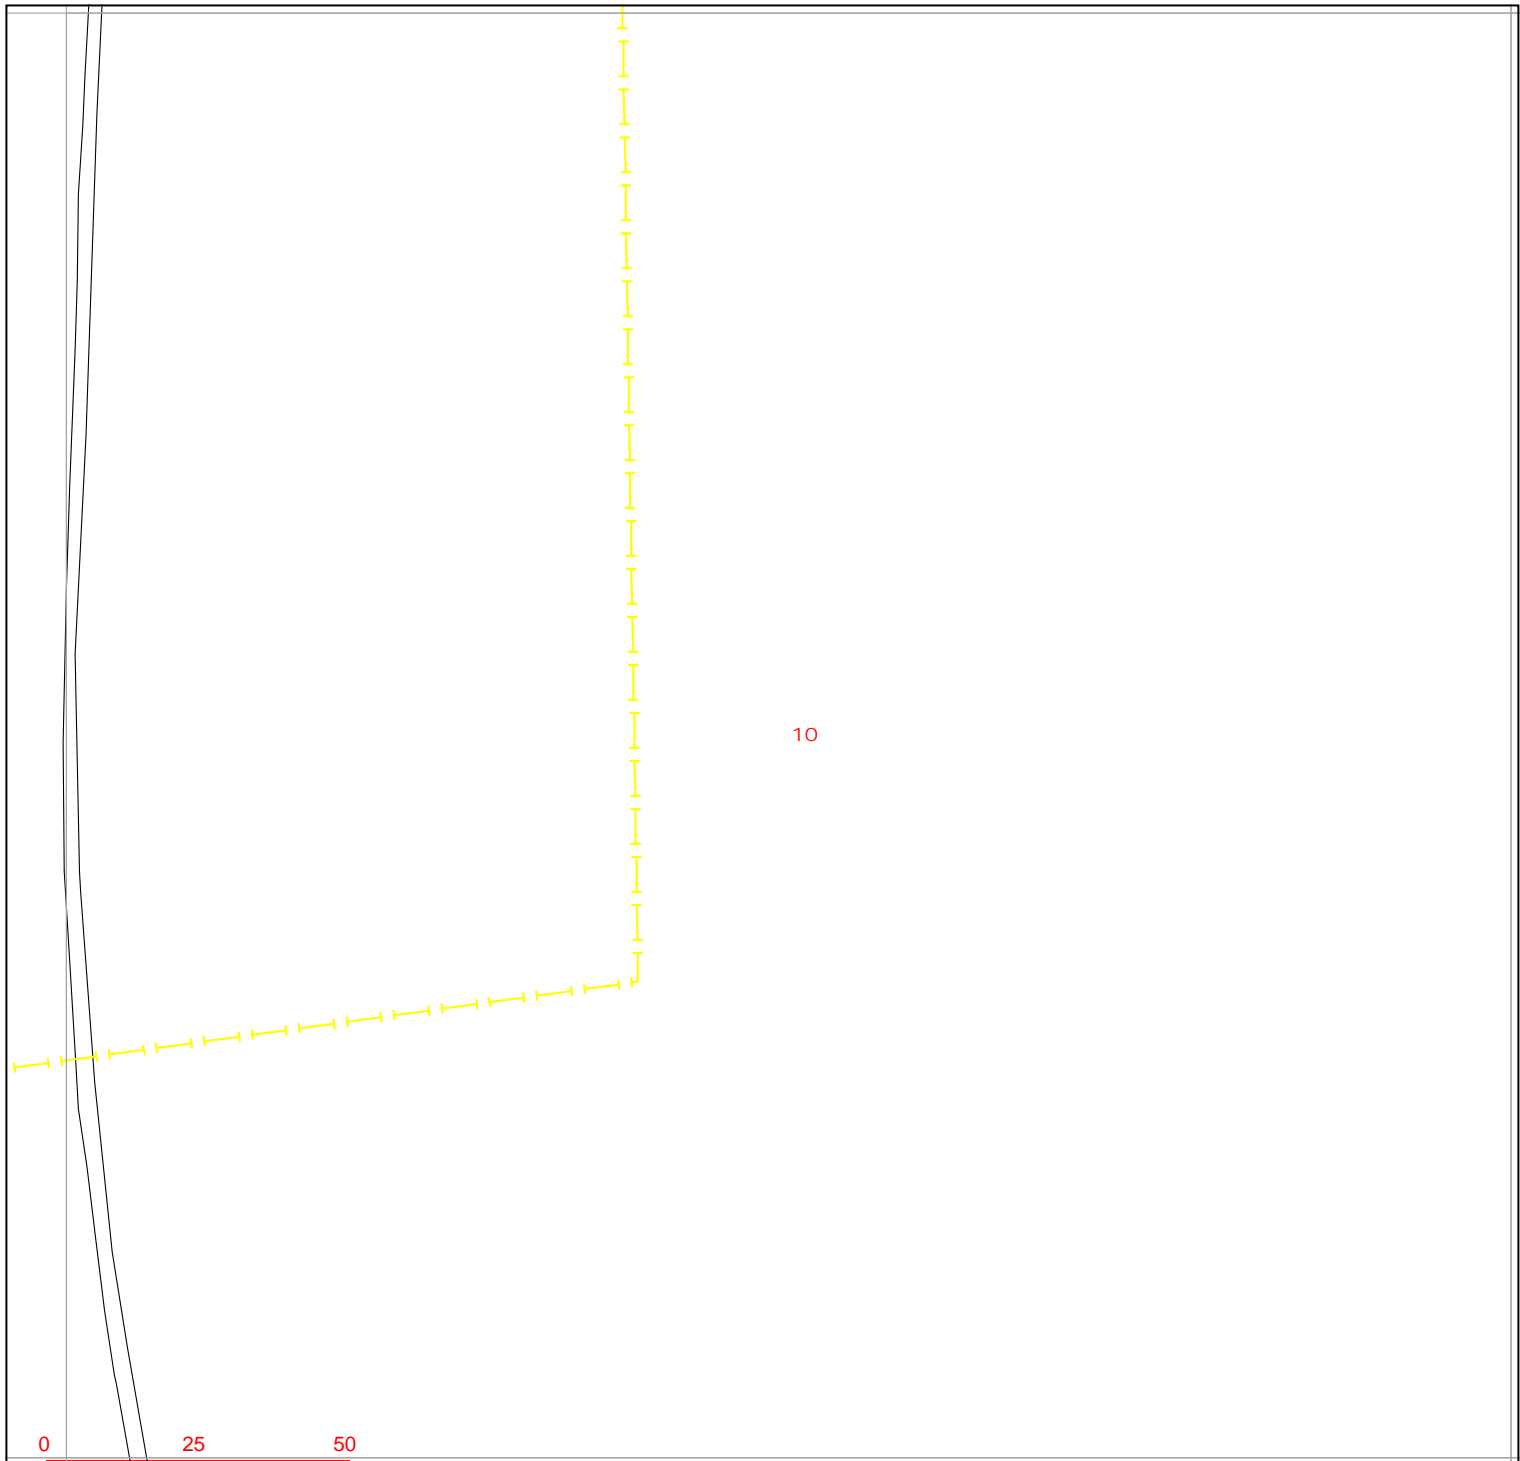

Warning: PDF designed for colour print only with no page scaling.




Contact Us
 All areas 0121 623 9780

Mapping Enquiries:

General Enquiries:
 All areas 0800 096 3080

Date Requested: 08/05/2023
 Job Reference: 29406944
 Site Location: 476361 383022
 Requested by:
 Mr Ben Evans
 Your Scheme/Reference:
 LM 203570/DK - 8

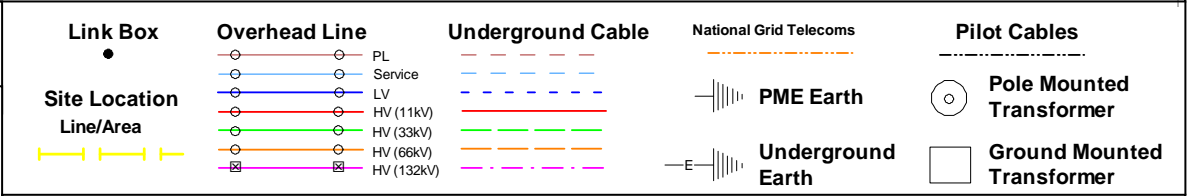


IMPORTANT NOTICES

- This information is given as a guide only and its accuracy cannot be guaranteed. Services or recent additions to the network may not be shown.
- Cables, overhead lines & substations owned by other electricity network owners or private companies may be present and may not be shown.
- You should always verify exact locations of cables using a cable locator and by careful use of hand tools in accordance with HSE guidance note HSG47.
- When working within 10m of any overhead electric line you should follow the requirements of HSE Guidance Note GS6.
- For further advice on working near our electricity cables or lines, call our General Enquiries number.
- Advice should be sought from the National Grid Electricity Distribution General Enquiries team for any work that is to take place in proximity to 132kV underground cables and 132kV overhead lines.

Report damage immediately – KEEP EVERYONE AWAY FROM THE AREA
0800 6783 105

Exact Scales:
 1:1250 Area or Circle dig site
 1:500 Line dig site

Crown Copyright © All Rights Reserved. Ordnance Survey Licence numbers: 100022432
 NGED Copyright: This copy has been made by or with the authority of National Grid Electricity Distribution (NGED) pursuant to Section 47 of the Copyright Designs and Patents Act 1988 unless that Act provides a relevant exception to copyright the copy must not be copied without the prior permission of the copyright owner.

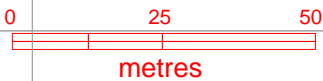

Warning: PDF designed for colour print only with no page scaling.




Contact Us

Mapping Enquiries:
All areas 0121 623 9780

General Enquiries:
All areas 0800 096 3080

Date Requested: 08/05/2023
Job Reference: 29406944
Site Location: 476361 383022
Requested by:
Mr Ben Evans
Your Scheme/Reference:
LM 203570/DK - 8

Exact Scales:
1:1250 Area or Circle dig site
1:500 Line dig site

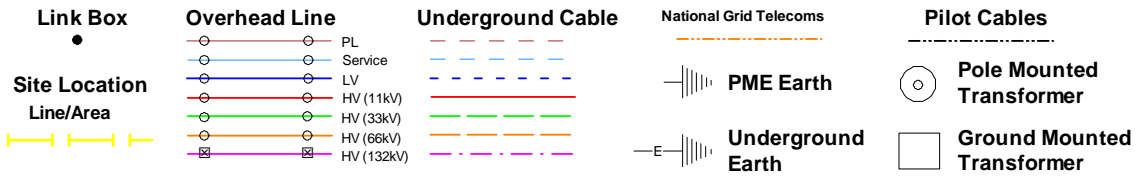


IMPORTANT NOTICES

- This information is given as a guide only and its accuracy cannot be guaranteed. Services or recent additions to the network may not be shown.
- Cables, overhead lines & substations owned by other electricity network owners or private companies may be present and may not be shown.
- You should always verify exact locations of cables using a cable locator and by careful use of hand tools in accordance with HSE guidance note HSG47.
- When working within 10m of any overhead electric line you should follow the requirements of HSE Guidance Note GS6.
- For further advice on working near our electricity cables or lines, call our General Enquiries number.
- Advice should be sought from the National Grid Electricity Distribution General Enquiries team for any work that is to take place in proximity to 132kV underground cables and 132kV overhead lines.

Report damage immediately – KEEP EVERYONE AWAY FROM THE AREA
0800 6783 105

Crown Copyright © All Rights Reserved. Ordnance Survey Licence numbers: 100022432
NGED Copyright: This copy has been made by or with the authority of National Grid Electricity Distribution (NGED) pursuant to Section 47 of the Copyright Designs and Patents Act 1988 unless that Act provides a relevant exception to copyright the copy must not be copied without the prior permission of the copyright owner.

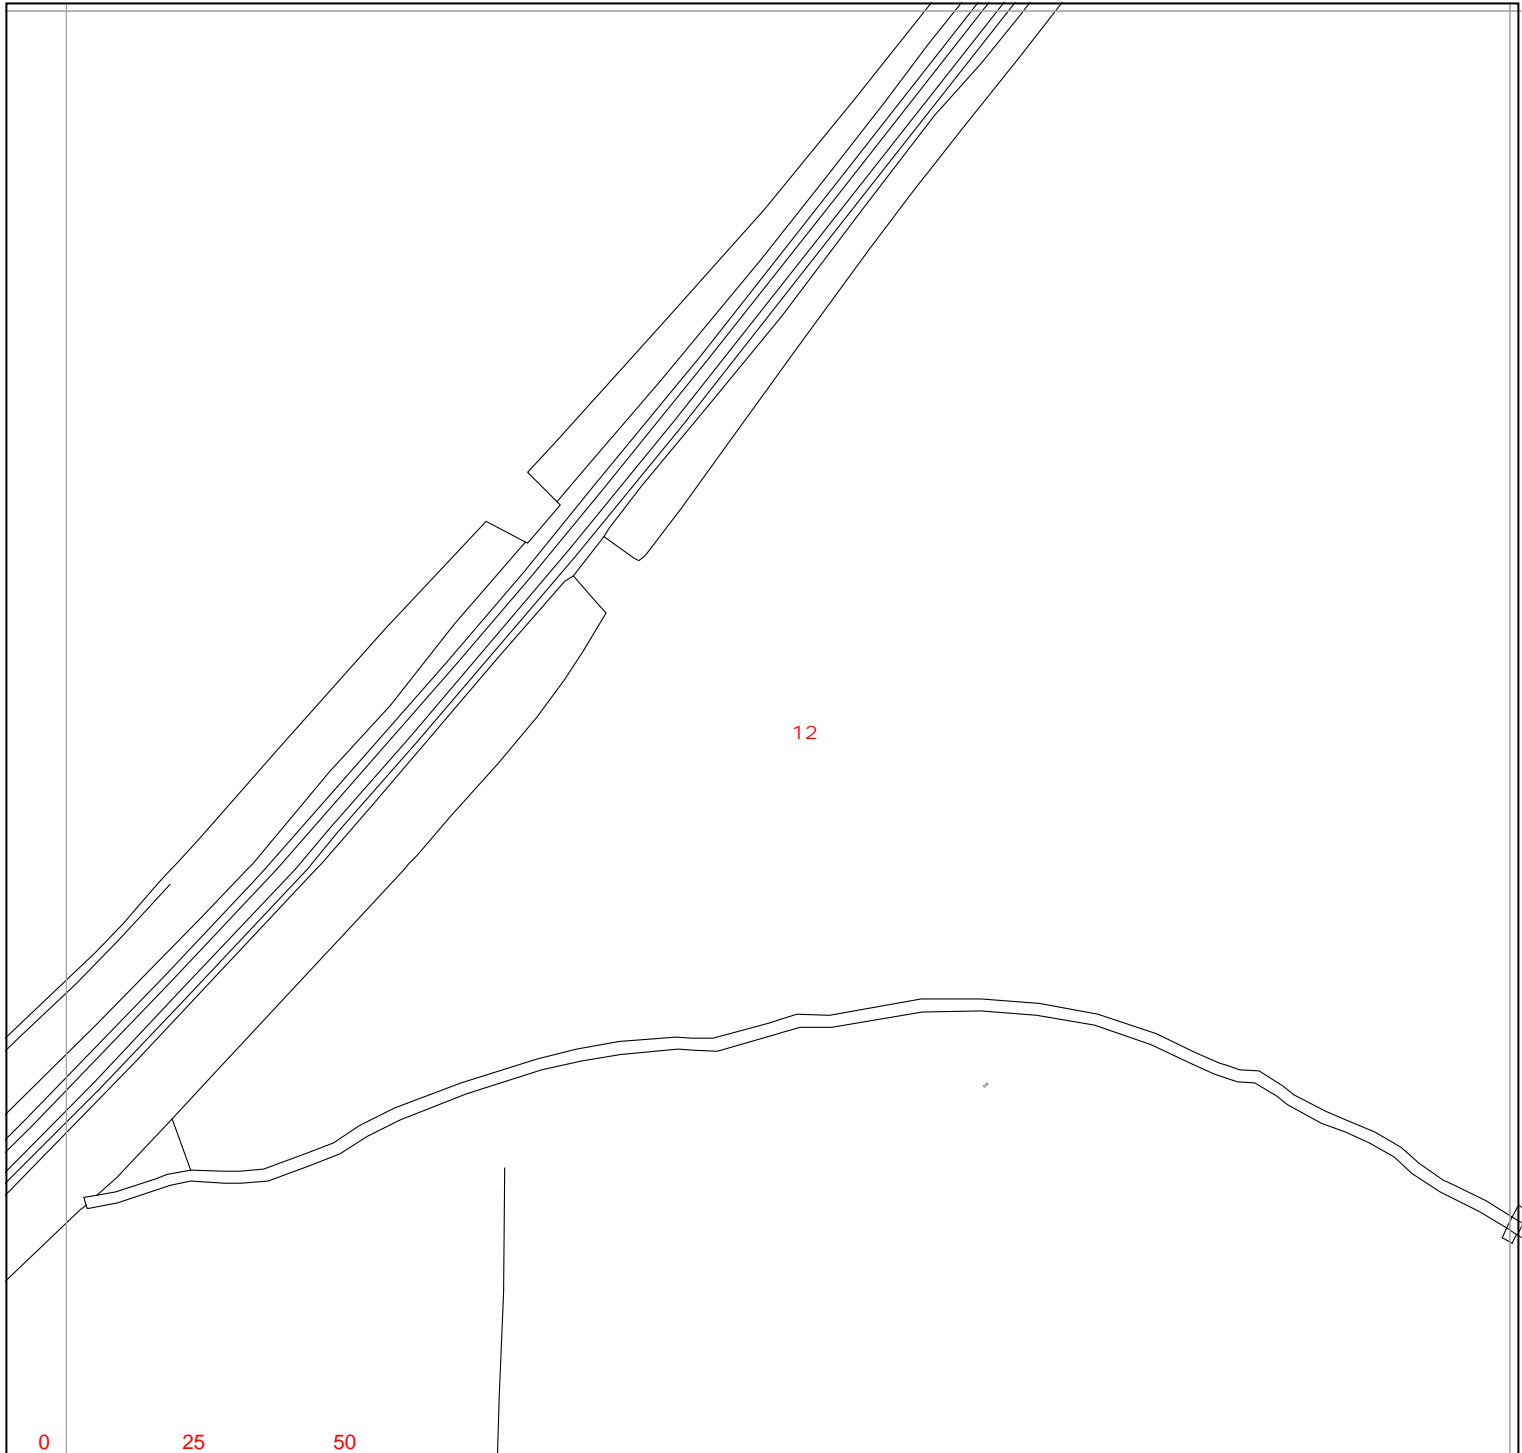

Warning: PDF designed for colour print only with no page scaling.



Contact Us
 Mapping Enquiries:
 All areas 0121 623 9780
 General Enquiries:
 All areas 0800 096 3080

Date Requested: 08/05/2023
 Job Reference: 29406944
 Site Location: 476361 383022
 Requested by:
 Mr Ben Evans
 Your Scheme/Reference:
 LM 203570/DK - 8

Exact Scales:
 1:1250 Area or Circle dig site
 1:500 Line dig site


Link Box ●	Overhead Line ○ ○ PL ○ ○ Service ○ ○ LV ○ ○ HV (11kV) ○ ○ HV (33kV) ○ ○ HV (66kV) ○ ○ HV (132kV)	Underground Cable -	National Grid Telecoms - - - - - PME Earth Underground Earth	Pilot Cables ○ Pole Mounted Transformer □ Ground Mounted Transformer
----------------------	--	---	--	---

IMPORTANT NOTICES

- This information is given as a guide only and its accuracy cannot be guaranteed. Services or recent additions to the network may not be shown.
- Cables, overhead lines & substations owned by other electricity network owners or private companies may be present and may not be shown.
- You should always verify exact locations of cables using a cable locator and by careful use of hand tools in accordance with HSE guidance note HSG47.
- When working within 10m of any overhead electric line you should follow the requirements of HSE Guidance Note GS6.
- For further advice on working near our electricity cables or lines, call our General Enquiries number.
- Advice should be sought from the National Grid Electricity Distribution General Enquiries team for any work that is to take place in proximity to 132kV underground cables and 132kV overhead lines.

Report damage immediately – KEEP EVERYONE AWAY FROM THE AREA
0800 6783 105

Crown Copyright © All Rights Reserved. Ordnance Survey Licence numbers: 100022432
 NGED Copyright: This copy has been made by or with the authority of National Grid Electricity Distribution (NGED) pursuant to Section 47 of the Copyright Designs and Patents Act 1988 unless that Act provides a relevant exception to copyright the copy must not be copied without the prior permission of the copyright owner.

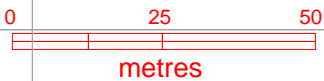


Warning: PDF designed for colour print only with no page scaling.



Contact Us
Mapping Enquiries:
 All areas 0121 623 9780
General Enquiries:
 All areas 0800 096 3080

Date Requested: 08/05/2023
 Job Reference: 29406944
 Site Location: 476361 383022
 Requested by:
 Mr Ben Evans
 Your Scheme/Reference:
 LM 203570/DK - 8

Exact Scales:
 1:1250 Area or Circle dig site
 1:500 Line dig site

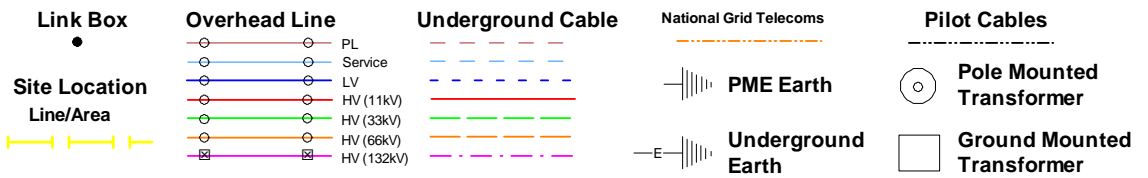


IMPORTANT NOTICES

- This information is given as a guide only and its accuracy cannot be guaranteed. Services or recent additions to the network may not be shown.
- Cables, overhead lines & substations owned by other electricity network owners or private companies may be present and may not be shown.
- You should always verify exact locations of cables using a cable locator and by careful use of hand tools in accordance with HSE guidance note HSG47.
- When working within 10m of any overhead electric line you should follow the requirements of HSE Guidance Note GS6.
- For further advice on working near our electricity cables or lines, call our General Enquiries number.
- Advice should be sought from the National Grid Electricity Distribution General Enquiries team for any work that is to take place in proximity to 132kV underground cables and 132kV overhead lines.

Report damage immediately – KEEP EVERYONE AWAY FROM THE AREA
0800 6783 105

Crown Copyright © All Rights Reserved. Ordnance Survey Licence numbers: 100022432
 NGED Copyright: This copy has been made by or with the authority of National Grid Electricity Distribution (NGED) pursuant to Section 47 of the Copyright Designs and Patents Act 1988 unless that Act provides a relevant exception to copyright the copy must not be copied without the prior permission of the copyright owner.

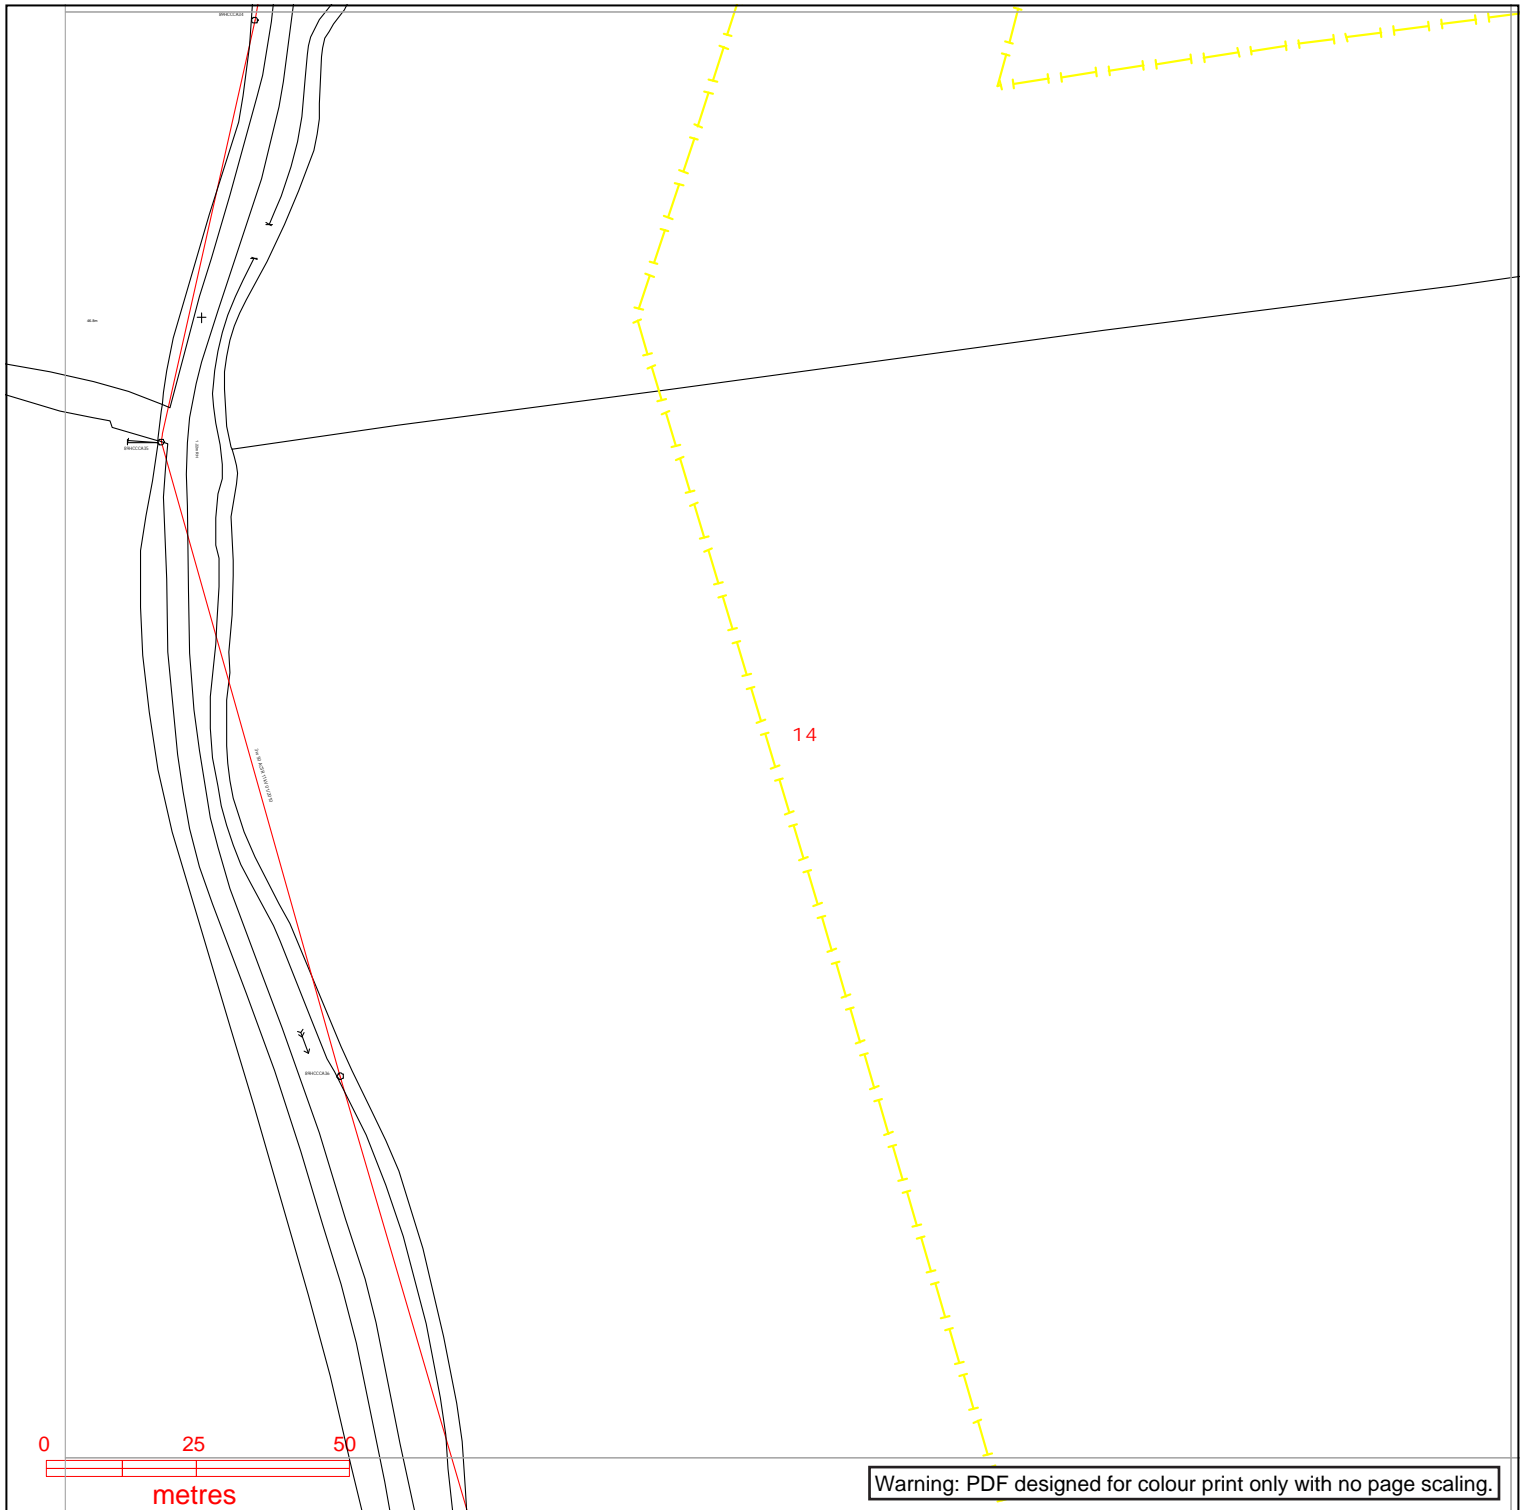

Warning: PDF designed for colour print only with no page scaling.

nationalgrid Electricity Distribution

Contact Us

Mapping Enquiries:
All areas 0121 623 9780

General Enquiries:
All areas 0800 096 3080

Date Requested: 08/05/2023
Job Reference: 29406944
Site Location: 476361 383022
Requested by:
Mr Ben Evans
Your Scheme/Reference:
LM 203570/DK - 8

Exact Scales:
1:1250 Area or Circle dig site
1:500 Line dig site


Link Box ●	Overhead Line ○ ○ PL ○ ○ Service ○ ○ LV ○ ○ HV (11kV) ○ ○ HV (33kV) ○ ○ HV (66kV) ○ ○ HV (132kV)	Underground Cable -	National Grid Telecoms - - - - - PME Earth Underground Earth	Pilot Cables - - - - - ○ Pole Mounted Transformer □ Ground Mounted Transformer
----------------------	--	---	--	--

IMPORTANT NOTICES

- This information is given as a guide only and its accuracy cannot be guaranteed. Services or recent additions to the network may not be shown.
- Cables, overhead lines & substations owned by other electricity network owners or private companies may be present and may not be shown.
- You should always verify exact locations of cables using a cable locator and by careful use of hand tools in accordance with HSE guidance note HSG47.
- When working within 10m of any overhead electric line you should follow the requirements of HSE Guidance Note GS6.
- For further advice on working near our electricity cables or lines, call our General Enquiries number.
- Advice should be sought from the National Grid Electricity Distribution General Enquiries team for any work that is to take place in proximity to 132kV underground cables and 132kV overhead lines.

Report damage immediately – KEEP EVERYONE AWAY FROM THE AREA
0800 6783 105

Crown Copyright © All Rights Reserved. Ordnance Survey Licence numbers: 100022432
NGED Copyright: This copy has been made by or with the authority of National Grid Electricity Distribution (NGED) pursuant to Section 47 of the Copyright Designs and Patents Act 1988 unless that Act provides a relevant exception to copyright the copy must not be copied without the prior permission of the copyright owner.

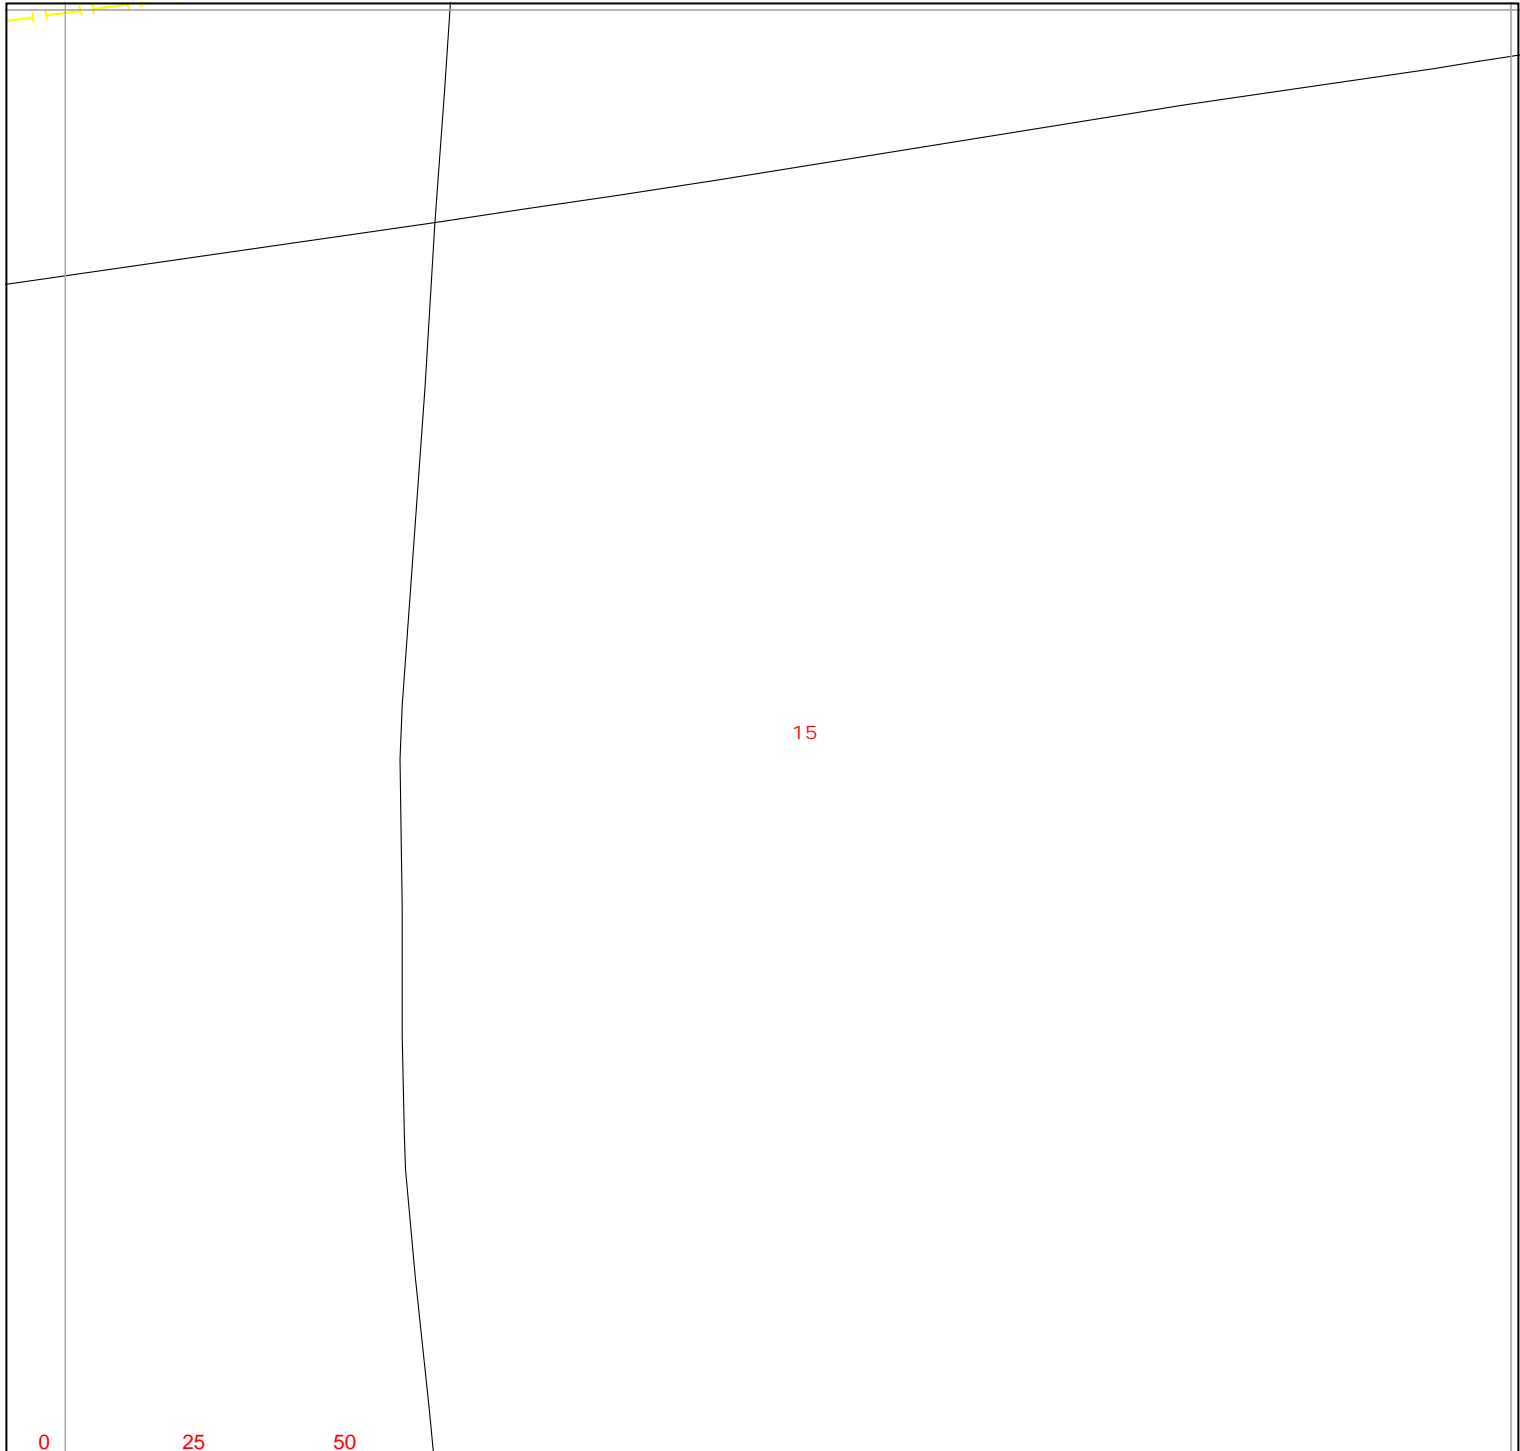

Warning: PDF designed for colour print only with no page scaling.



Contact Us

Mapping Enquiries:
All areas 0121 623 9780

General Enquiries:
All areas 0800 096 3080

Date Requested: 08/05/2023
Job Reference: 29406944
Site Location: 476361 383022
Requested by:
Mr Ben Evans
Your Scheme/Reference:
LM 203570/DK - 8

Exact Scales:
1:1250 Area or Circle dig site
1:500 Line dig site


Link Box ●	Overhead Line ○—○ PL ○—○ Service ○—○ LV ○—○ HV (11kV) ○—○ HV (33kV) ○—○ HV (66kV) ○—○ HV (132kV)	Underground Cable -	National Grid Telecoms - - - - - PME Earth Underground Earth	Pilot Cables ○ □ Pole Mounted Transformer Ground Mounted Transformer
----------------------	--	---	--	---

IMPORTANT NOTICES

- This information is given as a guide only and its accuracy cannot be guaranteed. Services or recent additions to the network may not be shown.
- Cables, overhead lines & substations owned by other electricity network owners or private companies may be present and may not be shown.
- You should always verify exact locations of cables using a cable locator and by careful use of hand tools in accordance with HSE guidance note HSG47.
- When working within 10m of any overhead electric line you should follow the requirements of HSE Guidance Note GS6.
- For further advice on working near our electricity cables or lines, call our General Enquiries number.
- Advice should be sought from the National Grid Electricity Distribution General Enquiries team for any work that is to take place in proximity to 132kV underground cables and 132kV overhead lines.

Report damage immediately – KEEP EVERYONE AWAY FROM THE AREA
0800 6783 105

Crown Copyright © All Rights Reserved. Ordnance Survey Licence numbers: 100022432
NGED Copyright: This copy has been made by or with the authority of National Grid Electricity Distribution (NGED) pursuant to Section 47 of the Copyright Designs and Patents Act 1988 unless that Act provides a relevant exception to copyright the copy must not be copied without the prior permission of the copyright owner.

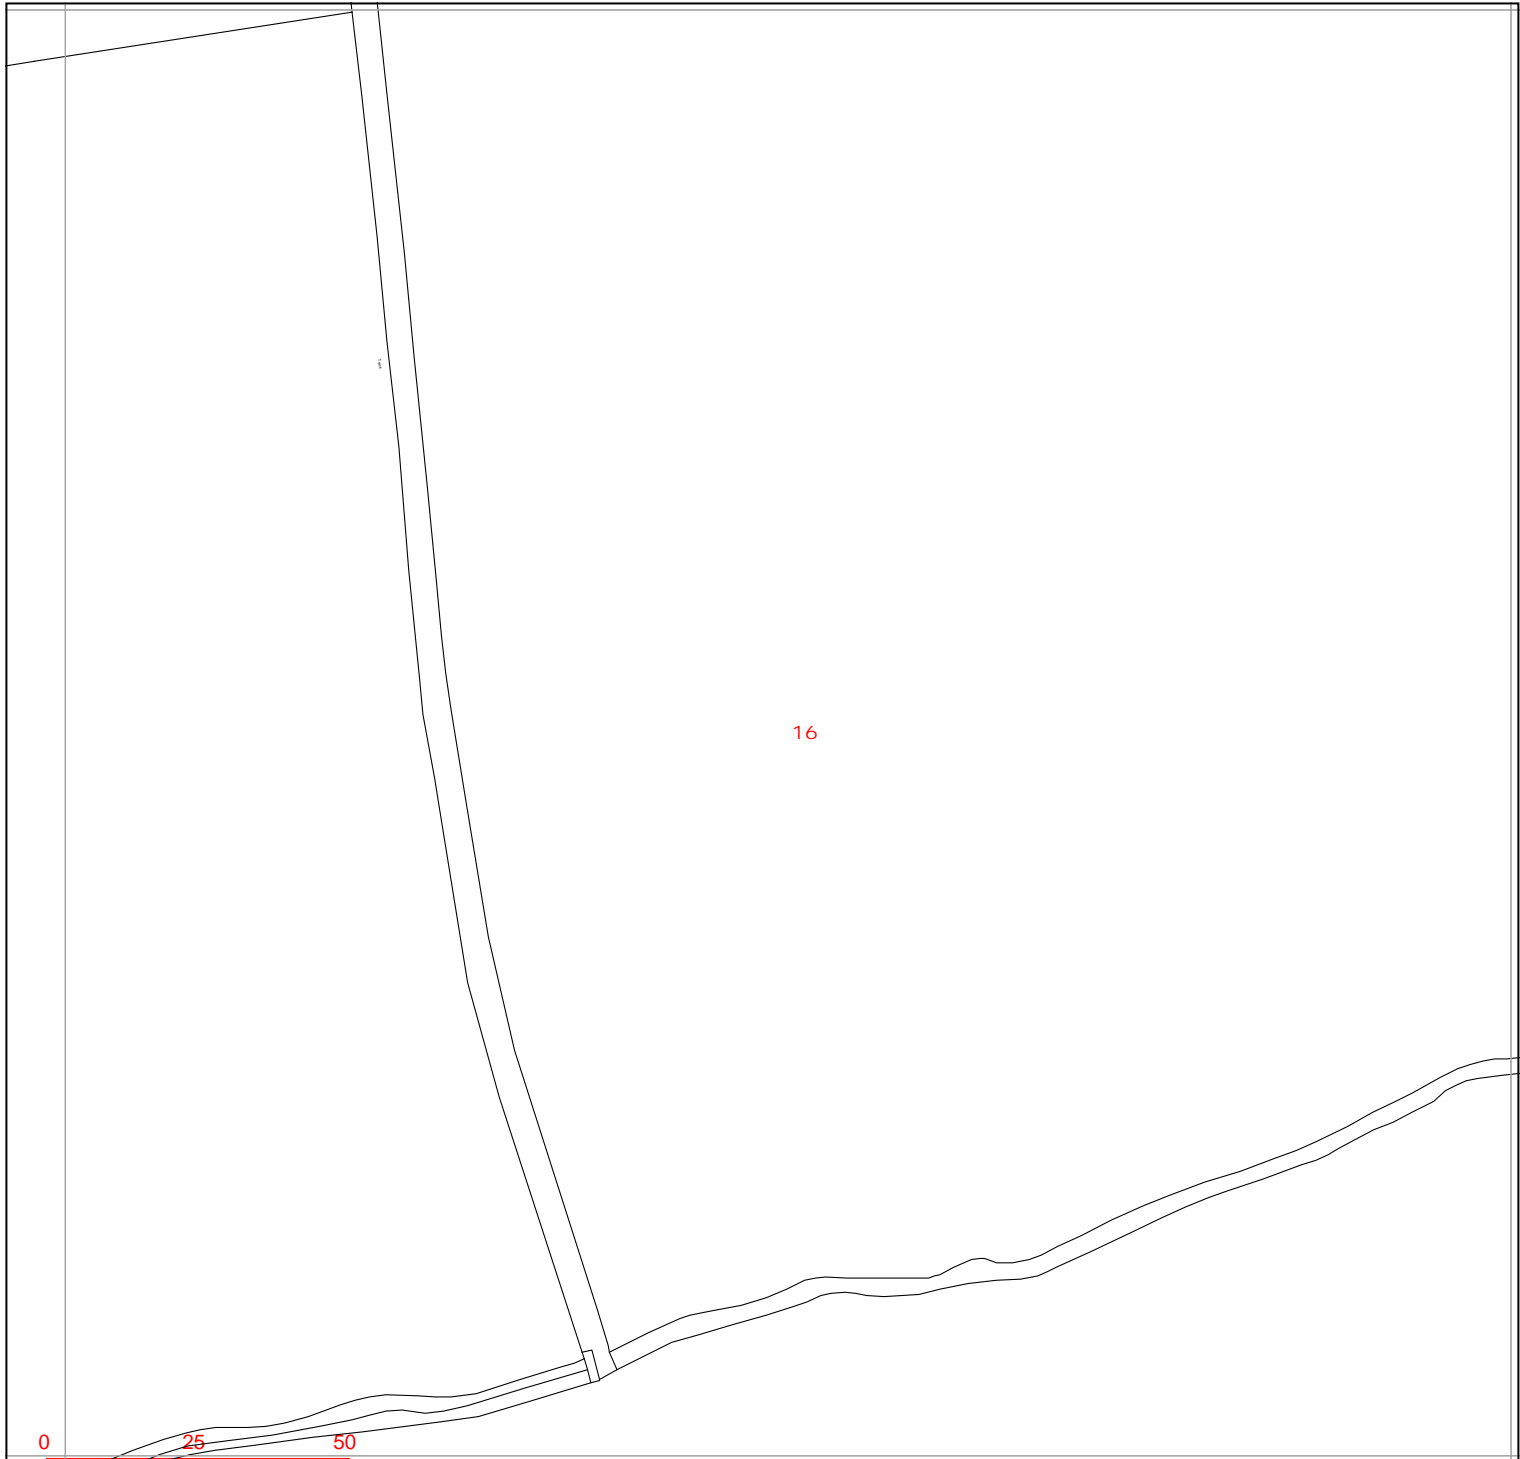

Warning: PDF designed for colour print only with no page scaling.



Link Box ●	Overhead Line ○—○ PL ○—○ Service ○—○ LV ○—○ HV (11kV) ○—○ HV (33kV) ○—○ HV (66kV) ○—○ HV (132kV)	Underground Cable -	National Grid Telecoms - - - - - PME Earth -E- - - - - Underground Earth	Pilot Cables - - - - - ○ Pole Mounted Transformer □ Ground Mounted Transformer
----------------------	--	---	---	--

Contact Us

Mapping Enquiries:
All areas 0121 623 9780

General Enquiries:
All areas 0800 096 3080

Date Requested: 08/05/2023
Job Reference: 29406944
Site Location: 476361 383022
Requested by:
Mr Ben Evans
Your Scheme/Reference:
LM 203570/DK - 8

IMPORTANT NOTICES

- This information is given as a guide only and its accuracy cannot be guaranteed. Services or recent additions to the network may not be shown.
- Cables, overhead lines & substations owned by other electricity network owners or private companies may be present and may not be shown.
- You should always verify exact locations of cables using a cable locator and by careful use of hand tools in accordance with HSE guidance note HSG47.
- When working within 10m of any overhead electric line you should follow the requirements of HSE Guidance Note GS6.
- For further advice on working near our electricity cables or lines, call our General Enquiries number.
- Advice should be sought from the National Grid Electricity Distribution General Enquiries team for any work that is to take place in proximity to 132kV underground cables and 132kV overhead lines.






Report damage immediately – KEEP EVERYONE AWAY FROM THE AREA
0800 6783 105

Exact Scales:
1:1250 Area or Circle dig site
1:500 Line dig site

Crown Copyright © All Rights Reserved. Ordnance Survey Licence numbers: 100022432
NGED Copyright: This copy has been made by or with the authority of National Grid Electricity Distribution (NGED) pursuant to Section 47 of the Copyright Designs and Patents Act 1988 unless that Act provides a relevant exception to copyright the copy must not be copied without the prior permission of the copyright owner.




Contact Us
 Mapping Enquiries:
 All areas 0121 623 9780
 General Enquiries:
 All areas 0800 096 3080
 Date Requested: 08/05/2023
 Job Reference: 29406944
 Site Location: 476361 383022
 Requested by:
 Mr Ben Evans
 Your Scheme/Reference:
 LM 203570/DK - 8
 Exact Scales:
 1:1250 Area or Circle dig site
 1:500 Line dig site

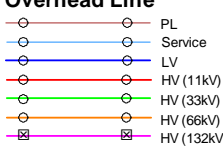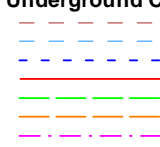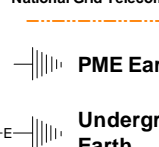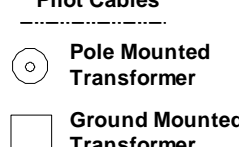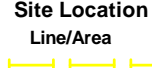
Link Box	Overhead Line	Underground Cable	National Grid Telecoms	Pilot Cables
●				
				

IMPORTANT NOTICES

- This information is given as a guide only and its accuracy cannot be guaranteed. Services or recent additions to the network may not be shown.
- Cables, overhead lines & substations owned by other electricity network owners or private companies may be present and may not be shown.
- You should always verify exact locations of cables using a cable locator and by careful use of hand tools in accordance with HSE guidance note HSG47.
- When working within 10m of any overhead electric line you should follow the requirements of HSE Guidance Note GS6.
- For further advice on working near our electricity cables or lines, call our General Enquiries number.
- Advice should be sought from the National Grid Electricity Distribution General Enquiries team for any work that is to take place in proximity to 132kV underground cables and 132kV overhead lines.

Report damage immediately – KEEP EVERYONE AWAY FROM THE AREA
0800 6783 105

Crown Copyright © All Rights Reserved. Ordnance Survey Licence numbers: 100022432
 NGED Copyright: This copy has been made by or with the authority of National Grid Electricity Distribution (NGED) pursuant to Section 47 of the Copyright Designs and Patents Act 1988 unless that Act provides a relevant exception to copyright the copy must not be copied without the prior permission of the copyright owner.

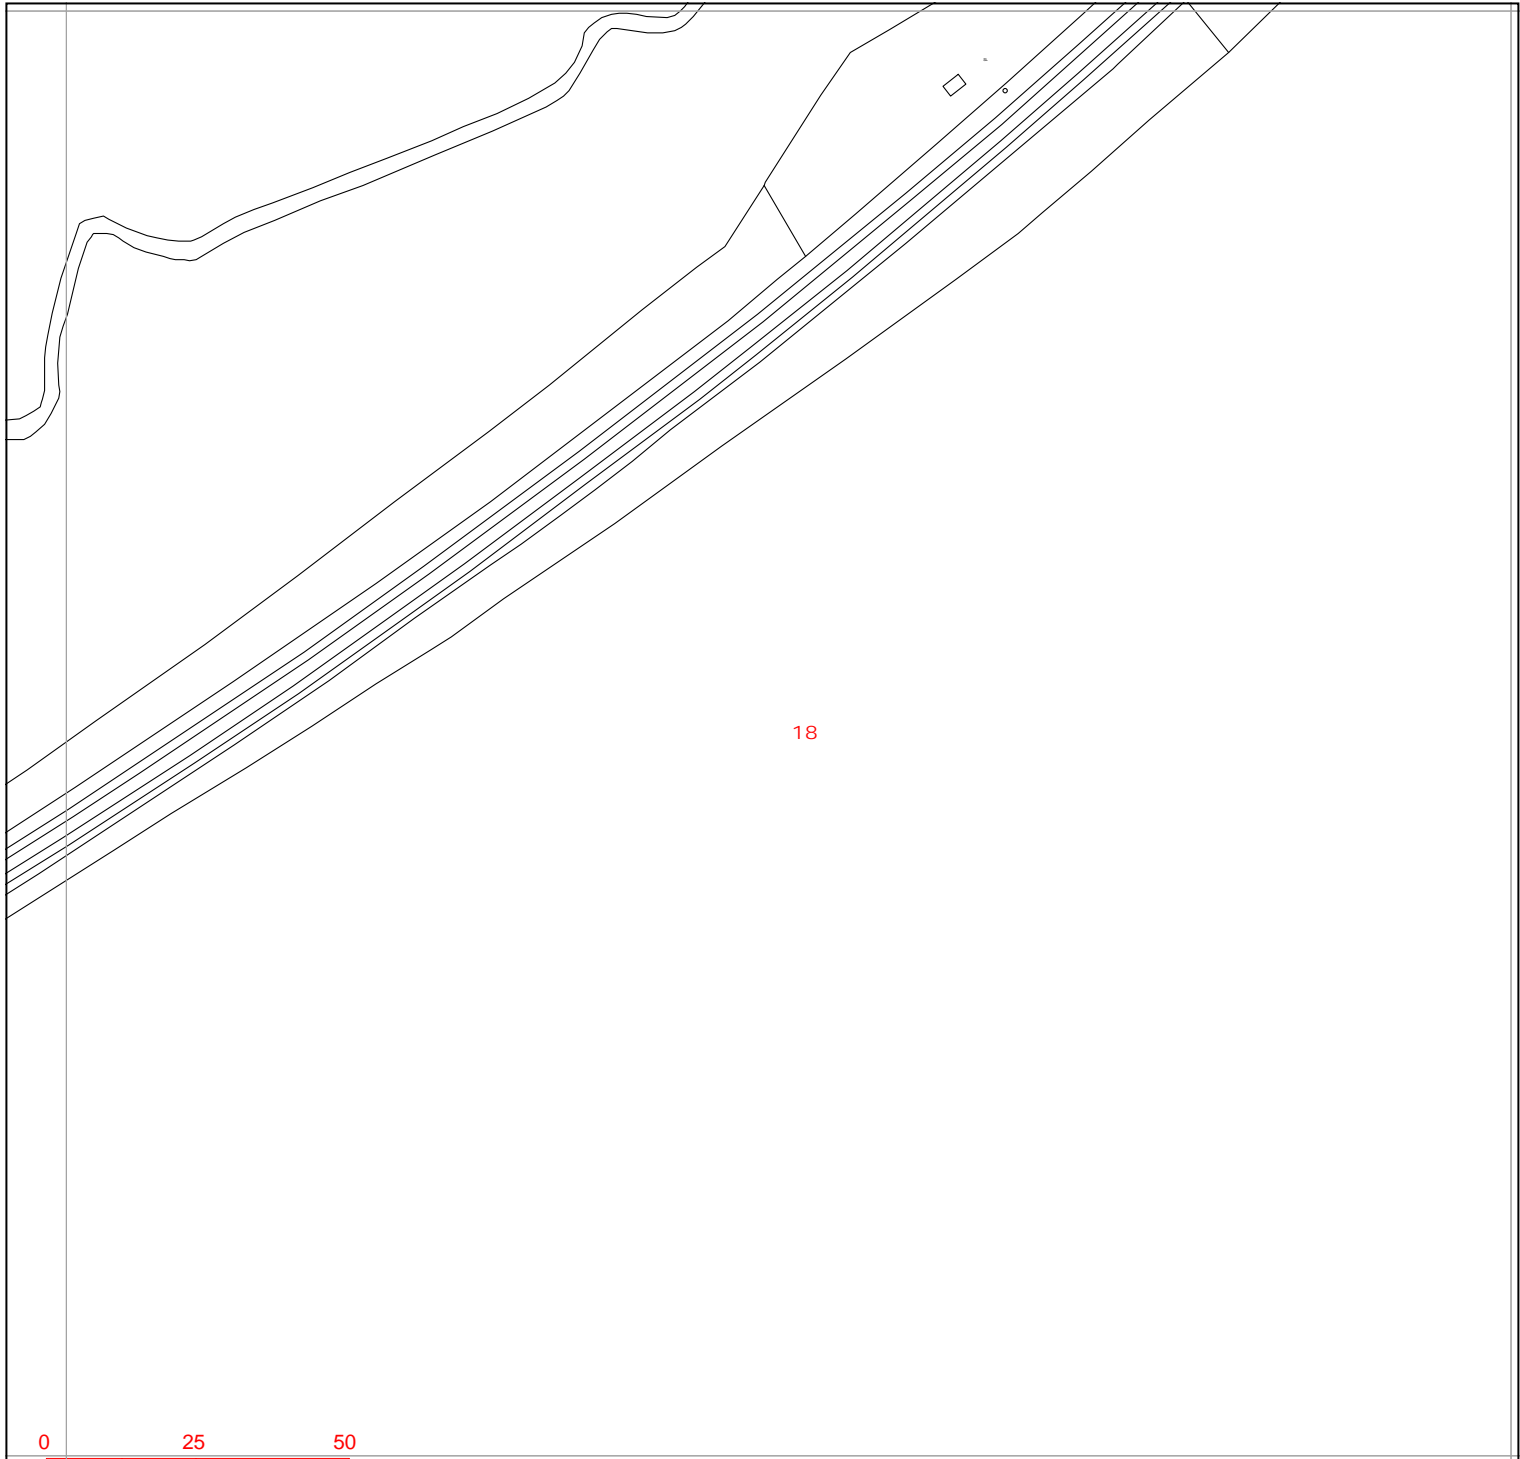

18



Warning: PDF designed for colour print only with no page scaling.

nationalgrid Electricity Distribution

Contact Us

Mapping Enquiries:
All areas 0121 623 9780

General Enquiries:
All areas 0800 096 3080

Date Requested: 08/05/2023
Job Reference: 29406944
Site Location: 476361 383022
Requested by:
Mr Ben Evans
Your Scheme/Reference:
LM 203570/DK - 8

Exact Scales:
1:1250 Area or Circle dig site
1:500 Line dig site


Link Box ●	Overhead Line ○—○ PL ○—○ Service ○—○ LV ○—○ HV (11kV) ○—○ HV (33kV) ○—○ HV (66kV) ○—○ HV (132kV)	Underground Cable -	National Grid Telecoms - - - - - PME Earth Underground Earth	Pilot Cables ○ Pole Mounted Transformer □ Ground Mounted Transformer
----------------------	--	--	--	---

IMPORTANT NOTICES

- This information is given as a guide only and its accuracy cannot be guaranteed. Services or recent additions to the network may not be shown.
- Cables, overhead lines & substations owned by other electricity network owners or private companies may be present and may not be shown.
- You should always verify exact locations of cables using a cable locator and by careful use of hand tools in accordance with HSE guidance note HSG47.
- When working within 10m of any overhead electric line you should follow the requirements of HSE Guidance Note GS6.
- For further advice on working near our electricity cables or lines, call our General Enquiries number.
- Advice should be sought from the National Grid Electricity Distribution General Enquiries team for any work that is to take place in proximity to 132kV underground cables and 132kV overhead lines.

Report damage immediately – KEEP EVERYONE AWAY FROM THE AREA
0800 6783 105

Crown Copyright © All Rights Reserved. Ordnance Survey Licence numbers: 100022432
NGED Copyright: This copy has been made by or with the authority of National Grid Electricity Distribution (NGED) pursuant to Section 47 of the Copyright Designs and Patents Act 1988 unless that Act provides a relevant exception to copyright the copy must not be copied without the prior permission of the copyright owner.

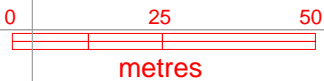

Warning: PDF designed for colour print only with no page scaling.




Contact Us

Mapping Enquiries:
All areas 0121 623 9780

General Enquiries:
All areas 0800 096 3080

Date Requested: 08/05/2023
Job Reference: 29406944
Site Location: 476361 383022
Requested by:
Mr Ben Evans
Your Scheme/Reference:
LM 203570/DK - 8

Exact Scales:
1:1250 Area or Circle dig site
1:500 Line dig site

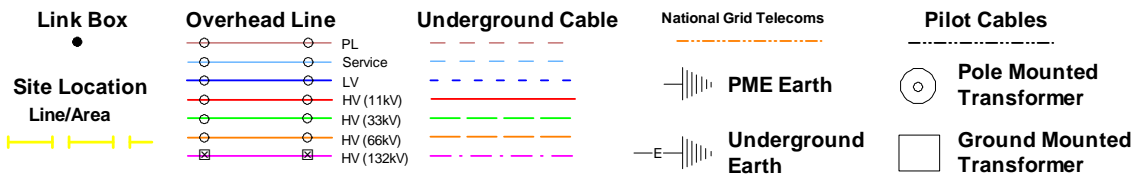

IMPORTANT NOTICES

- This information is given as a guide only and its accuracy cannot be guaranteed. Services or recent additions to the network may not be shown.
- Cables, overhead lines & substations owned by other electricity network owners or private companies may be present and may not be shown.
- You should always verify exact locations of cables using a cable locator and by careful use of hand tools in accordance with HSE guidance note HSG47.
- When working within 10m of any overhead electric line you should follow the requirements of HSE Guidance Note GS6.
- For further advice on working near our electricity cables or lines, call our General Enquiries number.
- Advice should be sought from the National Grid Electricity Distribution General Enquiries team for any work that is to take place in proximity to 132kV underground cables and 132kV overhead lines.

Report damage immediately – KEEP EVERYONE AWAY FROM THE AREA
0800 6783 105

Crown Copyright © All Rights Reserved. Ordnance Survey Licence numbers: 100022432
NGED Copyright: This copy has been made by or with the authority of National Grid Electricity Distribution (NGED) pursuant to Section 47 of the Copyright Designs and Patents Act 1988 unless that Act provides a relevant exception to copyright the copy must not be copied without the prior permission of the copyright owner.



Warning: PDF designed for colour print only with no page scaling.




Contact Us

Mapping Enquiries:
All areas 0121 623 9780

General Enquiries:
All areas 0800 096 3080

Date Requested: 08/05/2023
Job Reference: 29406944
Site Location: 476361 383022
Requested by:
Mr Ben Evans
Your Scheme/Reference:
LM 203570/DK - 8

Exact Scales:
1:1250 Area or Circle dig site
1:500 Line dig site

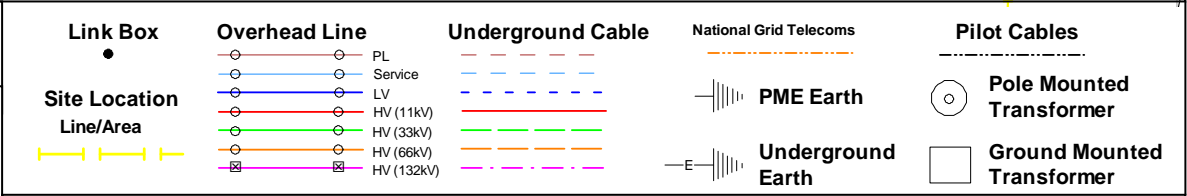


IMPORTANT NOTICES

- This information is given as a guide only and its accuracy cannot be guaranteed. Services or recent additions to the network may not be shown.
- Cables, overhead lines & substations owned by other electricity network owners or private companies may be present and may not be shown.
- You should always verify exact locations of cables using a cable locator and by careful use of hand tools in accordance with HSE guidance note HSG47.
- When working within 10m of any overhead electric line you should follow the requirements of HSE Guidance Note GS6.
- For further advice on working near our electricity cables or lines, call our General Enquiries number.
- Advice should be sought from the National Grid Electricity Distribution General Enquiries team for any work that is to take place in proximity to 132kV underground cables and 132kV overhead lines.

Report damage immediately – KEEP EVERYONE AWAY FROM THE AREA
0800 6783 105

Crown Copyright © All Rights Reserved. Ordnance Survey Licence numbers: 100022432
NGED Copyright: This copy has been made by or with the authority of National Grid Electricity Distribution (NGED) pursuant to Section 47 of the Copyright Designs and Patents Act 1988 unless that Act provides a relevant exception to copyright the copy must not be copied without the prior permission of the copyright owner.

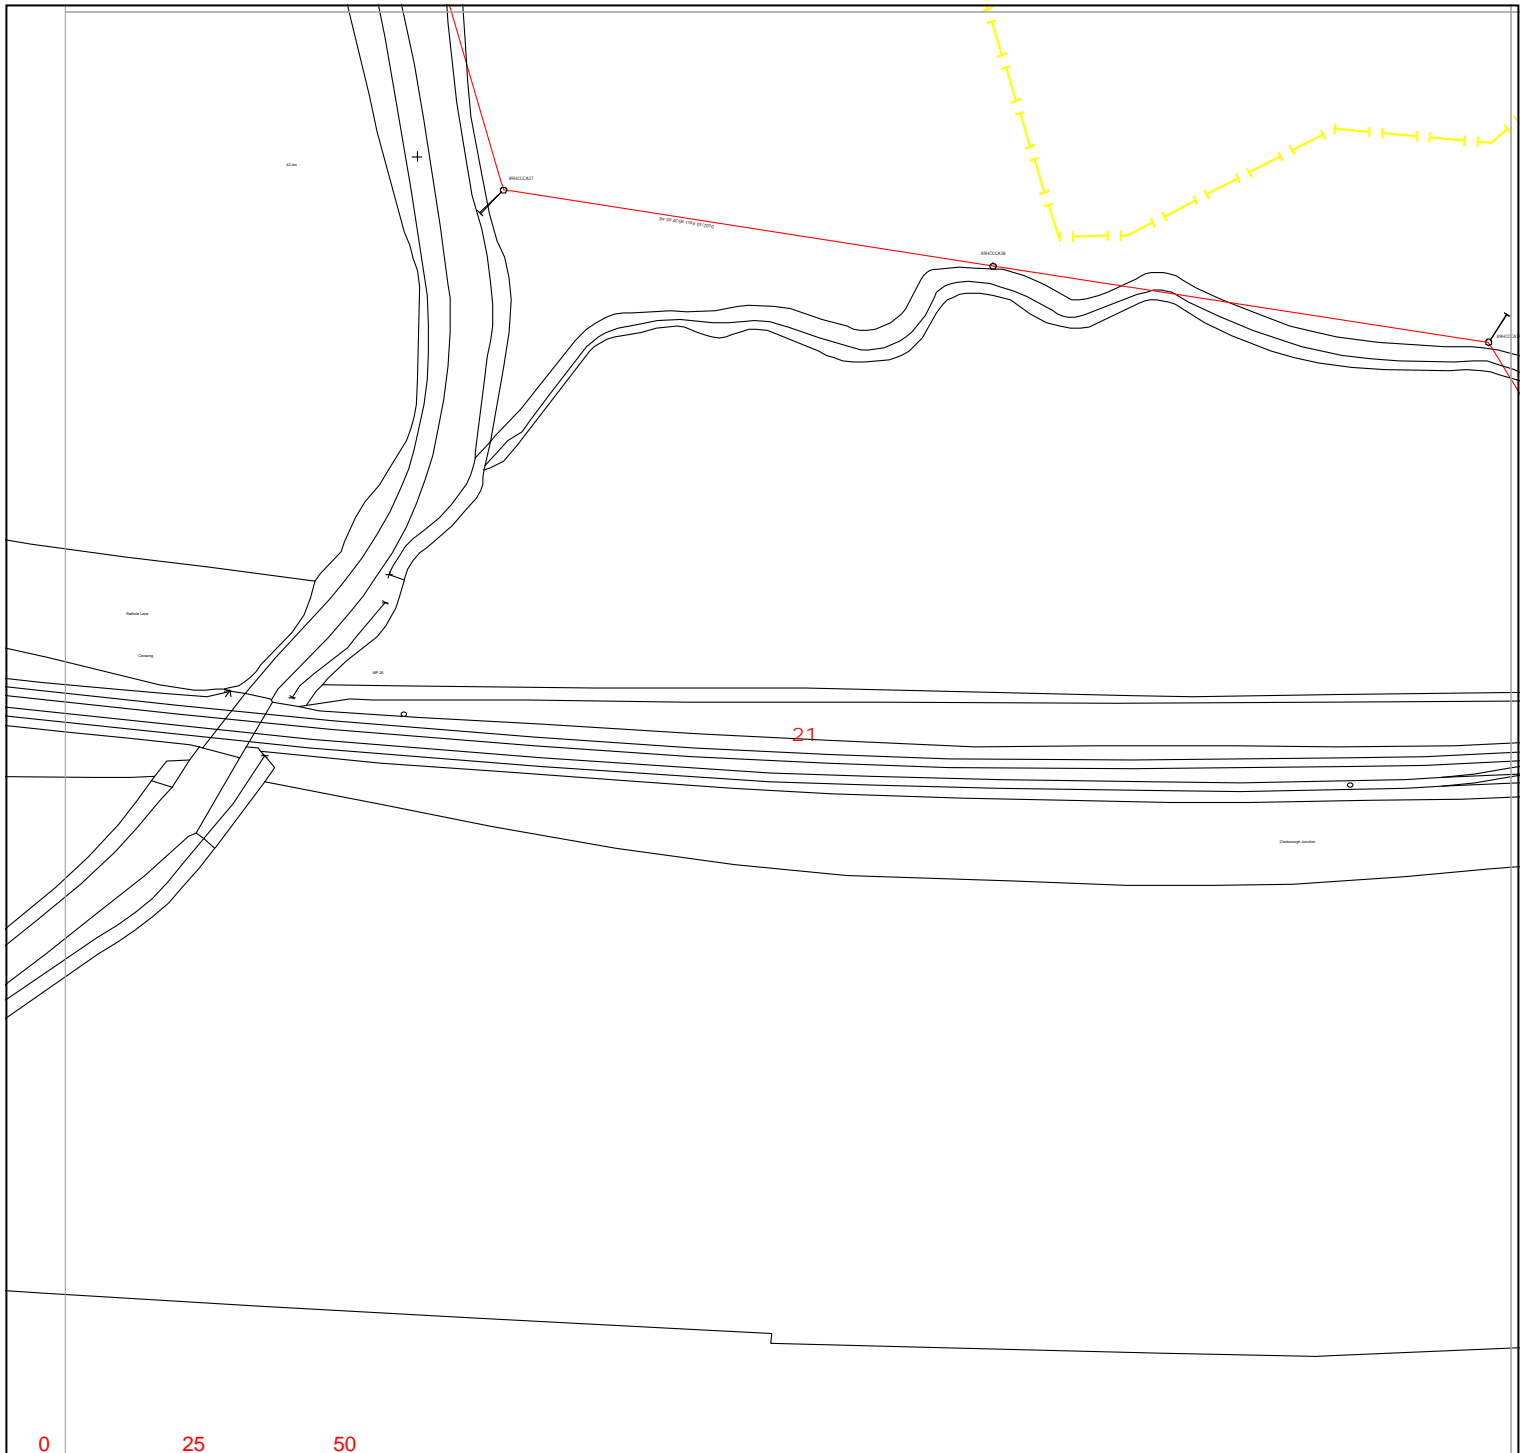

Warning: PDF designed for colour print only with no page scaling.

nationalgrid Electricity Distribution

Contact Us

Mapping Enquiries:
All areas 0121 623 9780

General Enquiries:
All areas 0800 096 3080

Date Requested: 08/05/2023
Job Reference: 29406944
Site Location: 476361 383022
Requested by:
Mr Ben Evans
Your Scheme/Reference:
LM 203570/DK - 8

Exact Scales:
1:1250 Area or Circle dig site
1:500 Line dig site


Link Box	Overhead Line	Underground Cable	National Grid Telecoms	Pilot Cables
●	○ PL ○ Service ○ LV ○ HV (11kV) ○ HV (33kV) ○ HV (66kV) ○ HV (132kV)	---	--- PME Earth ---E Underground Earth	○ Pole Mounted Transformer □ Ground Mounted Transformer

IMPORTANT NOTICES

- This information is given as a guide only and its accuracy cannot be guaranteed. Services or recent additions to the network may not be shown.
- Cables, overhead lines & substations owned by other electricity network owners or private companies may be present and may not be shown.
- You should always verify exact locations of cables using a cable locator and by careful use of hand tools in accordance with HSE guidance note HSG47.
- When working within 10m of any overhead electric line you should follow the requirements of HSE Guidance Note GS6.
- For further advice on working near our electricity cables or lines, call our General Enquiries number.
- Advice should be sought from the National Grid Electricity Distribution General Enquiries team for any work that is to take place in proximity to 132kV underground cables and 132kV overhead lines.

Report damage immediately – KEEP EVERYONE AWAY FROM THE AREA
0800 6783 105

Crown Copyright © All Rights Reserved. Ordnance Survey Licence numbers: 100022432
NGED Copyright: This copy has been made by or with the authority of National Grid Electricity Distribution (NGED) pursuant to Section 47 of the Copyright Designs and Patents Act 1988 unless that Act provides a relevant exception to copyright the copy must not be copied without the prior permission of the copyright owner.

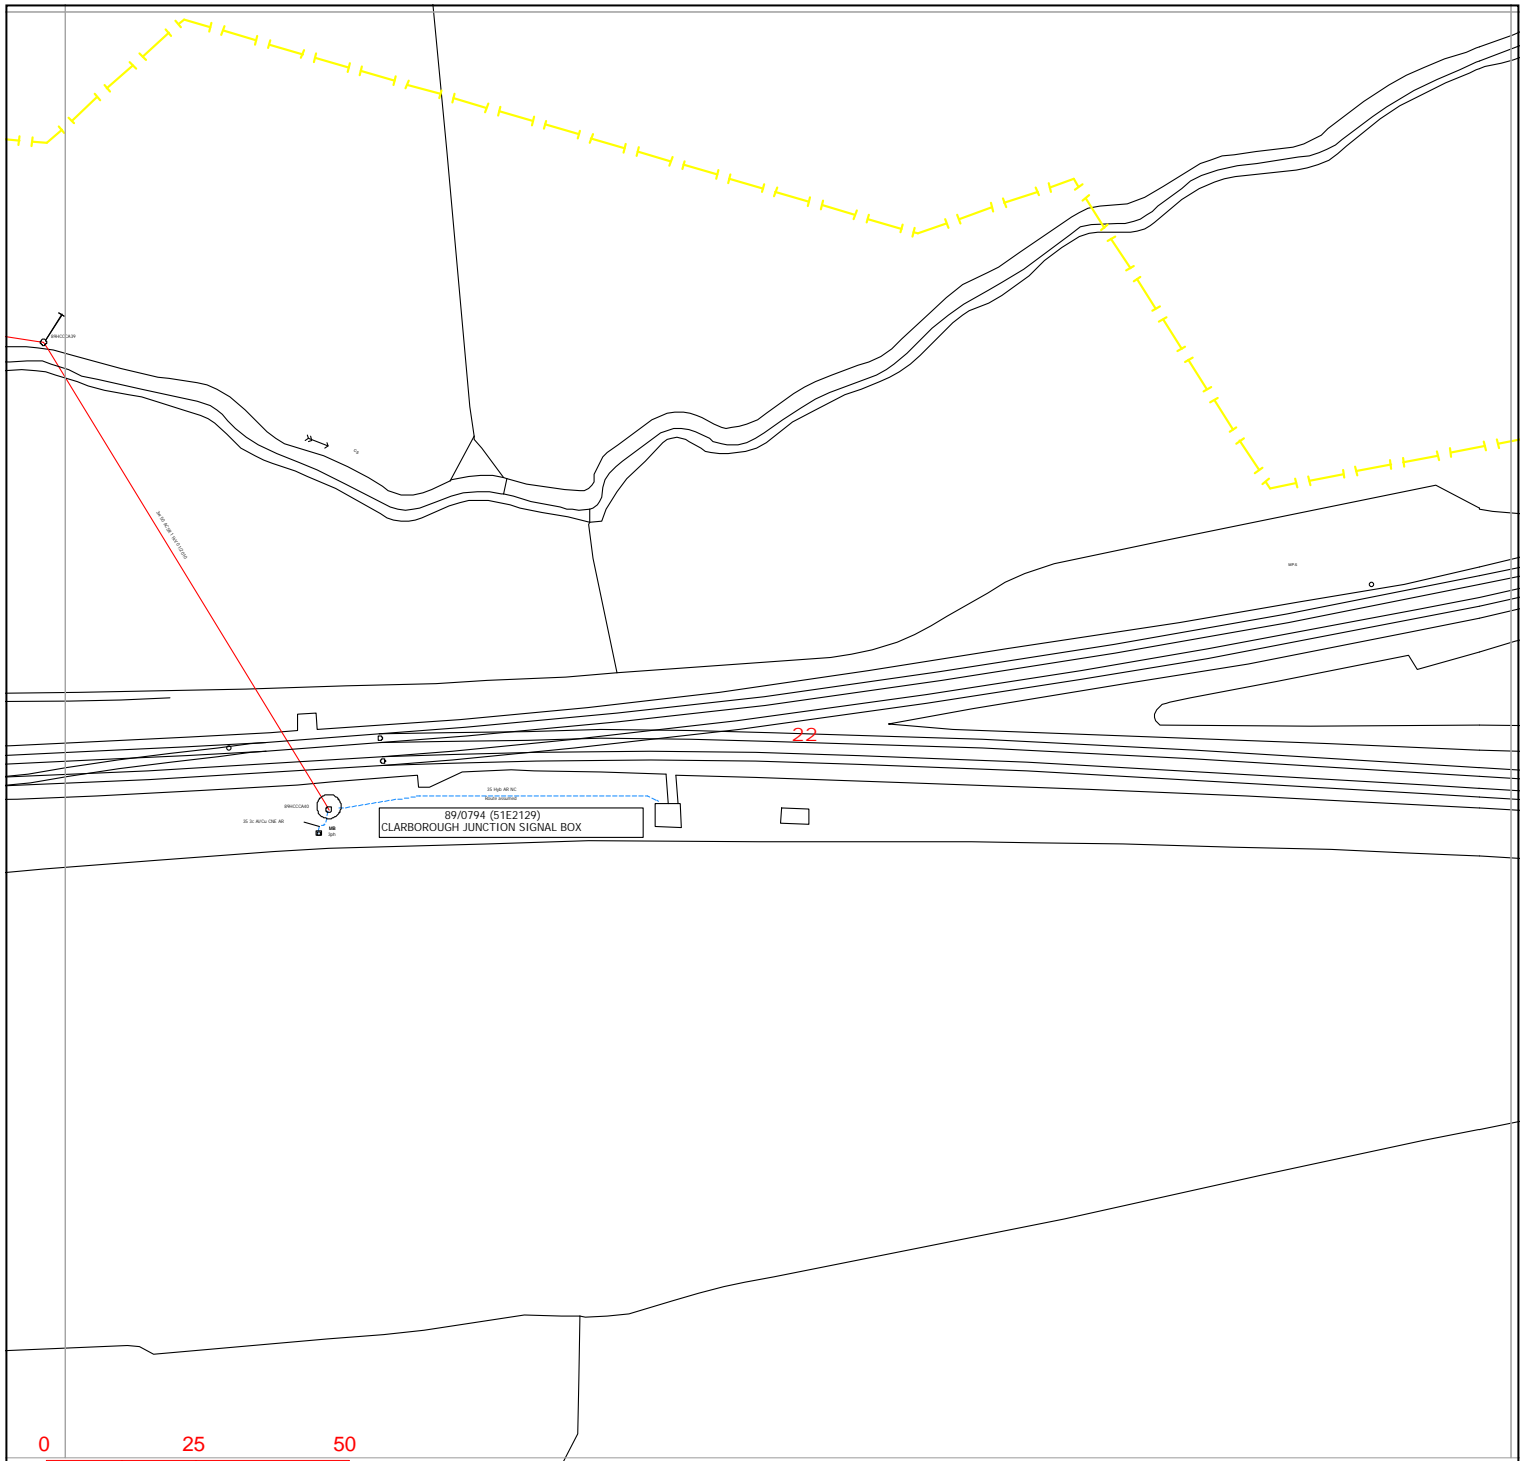

nationalgrid Electricity Distribution

Contact Us

Mapping Enquiries:
All areas 0121 623 9780

General Enquiries:
All areas 0800 096 3080

Date Requested: 08/05/2023
Job Reference: 29406944
Site Location: 476361 383022
Requested by:
Mr Ben Evans
Your Scheme/Reference:
LM 203570/DK - 8

Exact Scales:
1:1250 Area or Circle dig site
1:500 Line dig site


Link Box ●	Overhead Line ○ ○ PL ○ ○ Service ○ ○ LV ○ ○ HV (11kV) ○ ○ HV (33kV) ○ ○ HV (66kV) ○ ○ HV (132kV)	Underground Cable -	National Grid Telecoms - - - - - PME Earth Underground Earth	Pilot Cables - - - - - ○ Pole Mounted Transformer □ Ground Mounted Transformer
----------------------	--	---	--	--

IMPORTANT NOTICES

- This information is given as a guide only and its accuracy cannot be guaranteed. Services or recent additions to the network may not be shown.
- Cables, overhead lines & substations owned by other electricity network owners or private companies may be present and may not be shown.
- You should always verify exact locations of cables using a cable locator and by careful use of hand tools in accordance with HSE guidance note HSG47.
- When working within 10m of any overhead electric line you should follow the requirements of HSE Guidance Note GS6.
- For further advice on working near our electricity cables or lines, call our General Enquiries number.
- Advice should be sought from the National Grid Electricity Distribution General Enquiries team for any work that is to take place in proximity to 132kV underground cables and 132kV overhead lines.

Report damage immediately – KEEP EVERYONE AWAY FROM THE AREA
0800 6783 105

Crown Copyright © All Rights Reserved. Ordnance Survey Licence numbers: 100022432
NGED Copyright: This copy has been made by or with the authority of National Grid Electricity Distribution (NGED) pursuant to Section 47 of the Copyright Designs and Patents Act 1988 unless that Act provides a relevant exception to copyright the copy must not be copied without the prior permission of the copyright owner.

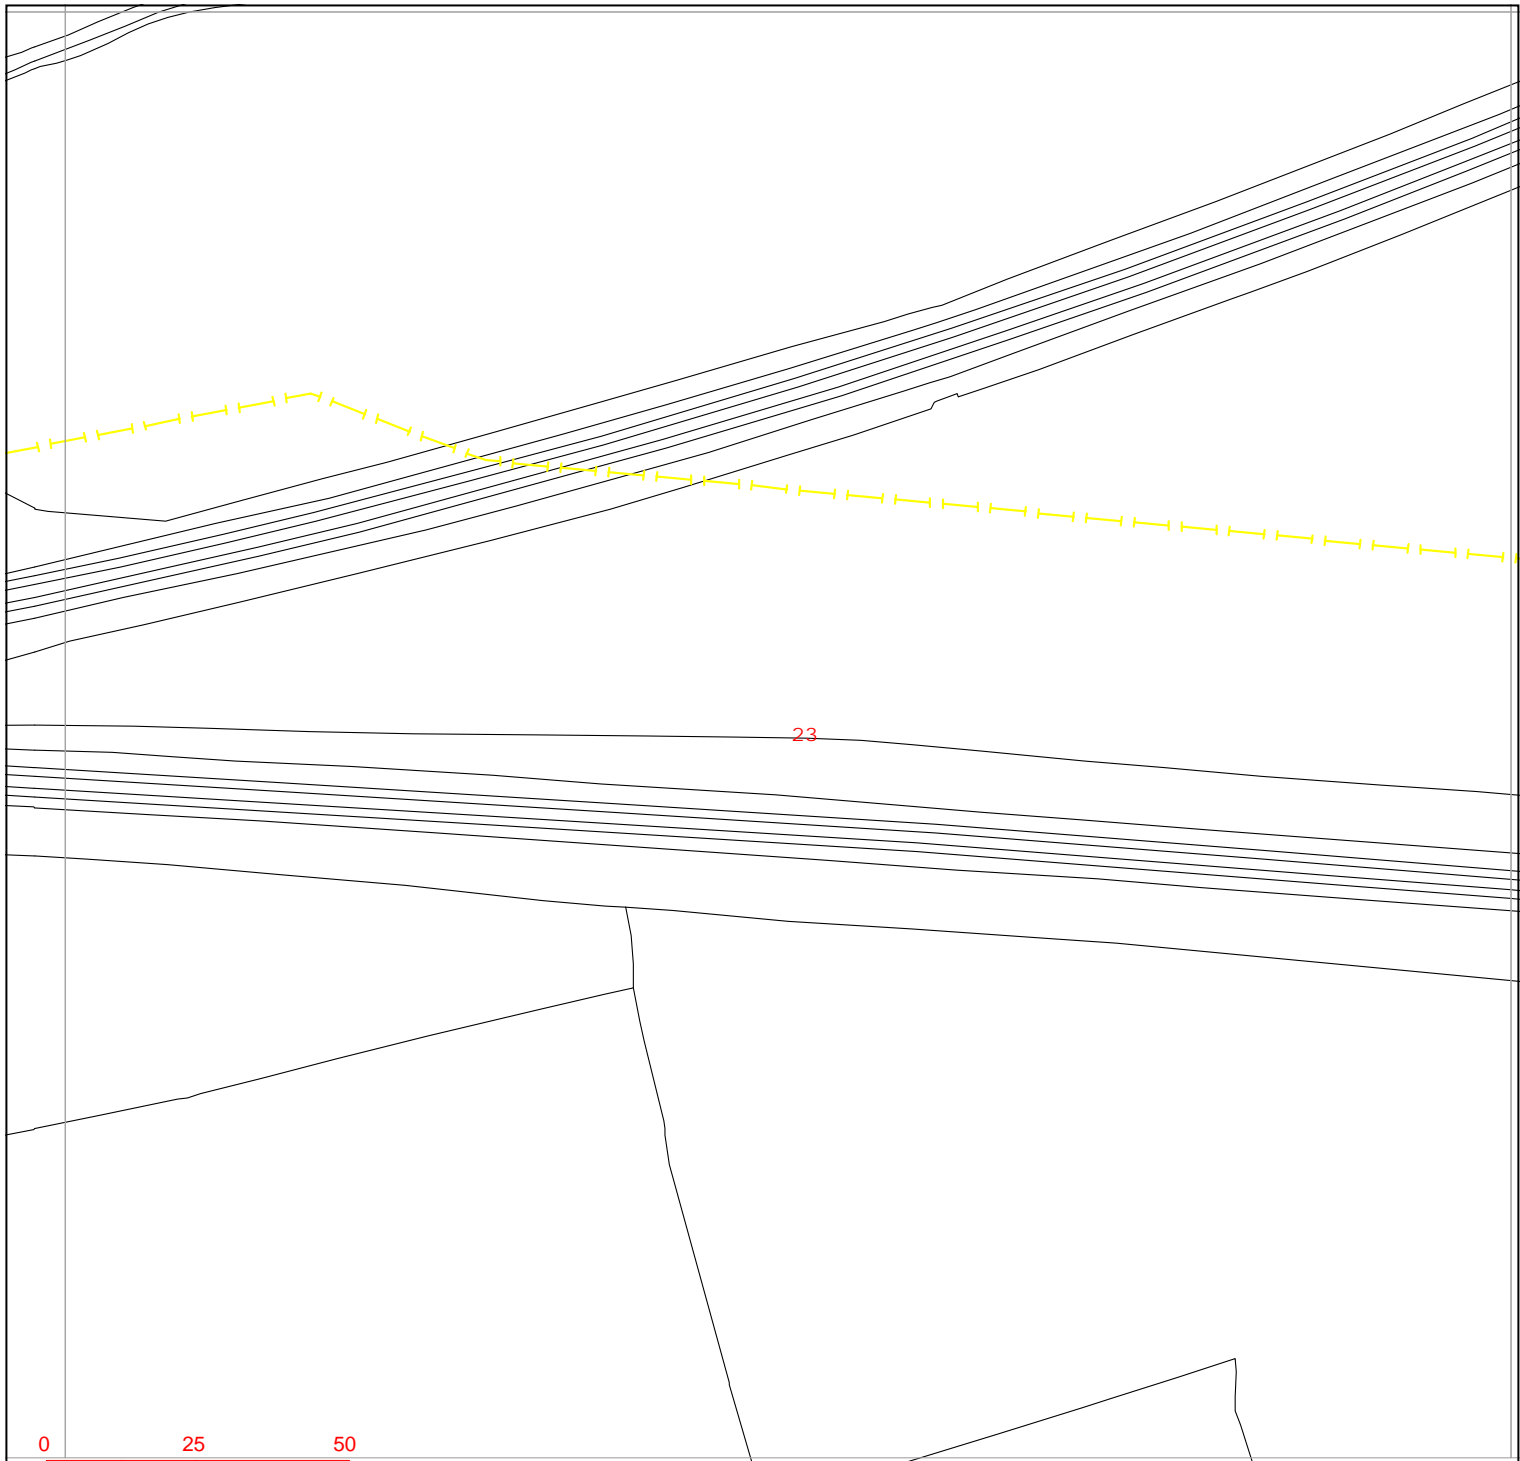

Warning: PDF designed for colour print only with no page scaling.



Contact Us
Mapping Enquiries:
 All areas 0121 623 9780
General Enquiries:
 All areas 0800 096 3080

Date Requested: 08/05/2023
 Job Reference: 29406944
 Site Location: 476361 383022
 Requested by:
 Mr Ben Evans
 Your Scheme/Reference:
 LM 203570/DK - 8

Link Box	Overhead Line	Underground Cable	National Grid Telecoms	Pilot Cables
●	PL Service LV HV (11kV) HV (33kV) HV (66kV) HV (132kV)		PME Earth Underground Earth	Pole Mounted Transformer Ground Mounted Transformer
Site Location Line/Area				


IMPORTANT NOTICES

- This information is given as a guide only and its accuracy cannot be guaranteed. Services or recent additions to the network may not be shown.
- Cables, overhead lines & substations owned by other electricity network owners or private companies may be present and may not be shown.
- You should always verify exact locations of cables using a cable locator and by careful use of hand tools in accordance with HSE guidance note HSG47.
- When working within 10m of any overhead electric line you should follow the requirements of HSE Guidance Note GS6.
- For further advice on working near our electricity cables or lines, call our General Enquiries number.
- Advice should be sought from the National Grid Electricity Distribution General Enquiries team for any work that is to take place in proximity to 132kV underground cables and 132kV overhead lines.

Report damage immediately – KEEP EVERYONE AWAY FROM THE AREA
0800 6783 105

Exact Scales:
 1:1250 Area or Circle dig site
 1:500 Line dig site

Crown Copyright © All Rights Reserved. Ordnance Survey Licence numbers: 100022432
 NGED Copyright: This copy has been made by or with the authority of National Grid Electricity Distribution (NGED) pursuant to Section 47 of the Copyright Designs and Patents Act 1988 unless that Act provides a relevant exception to copyright the copy must not be copied without the prior permission of the copyright owner.

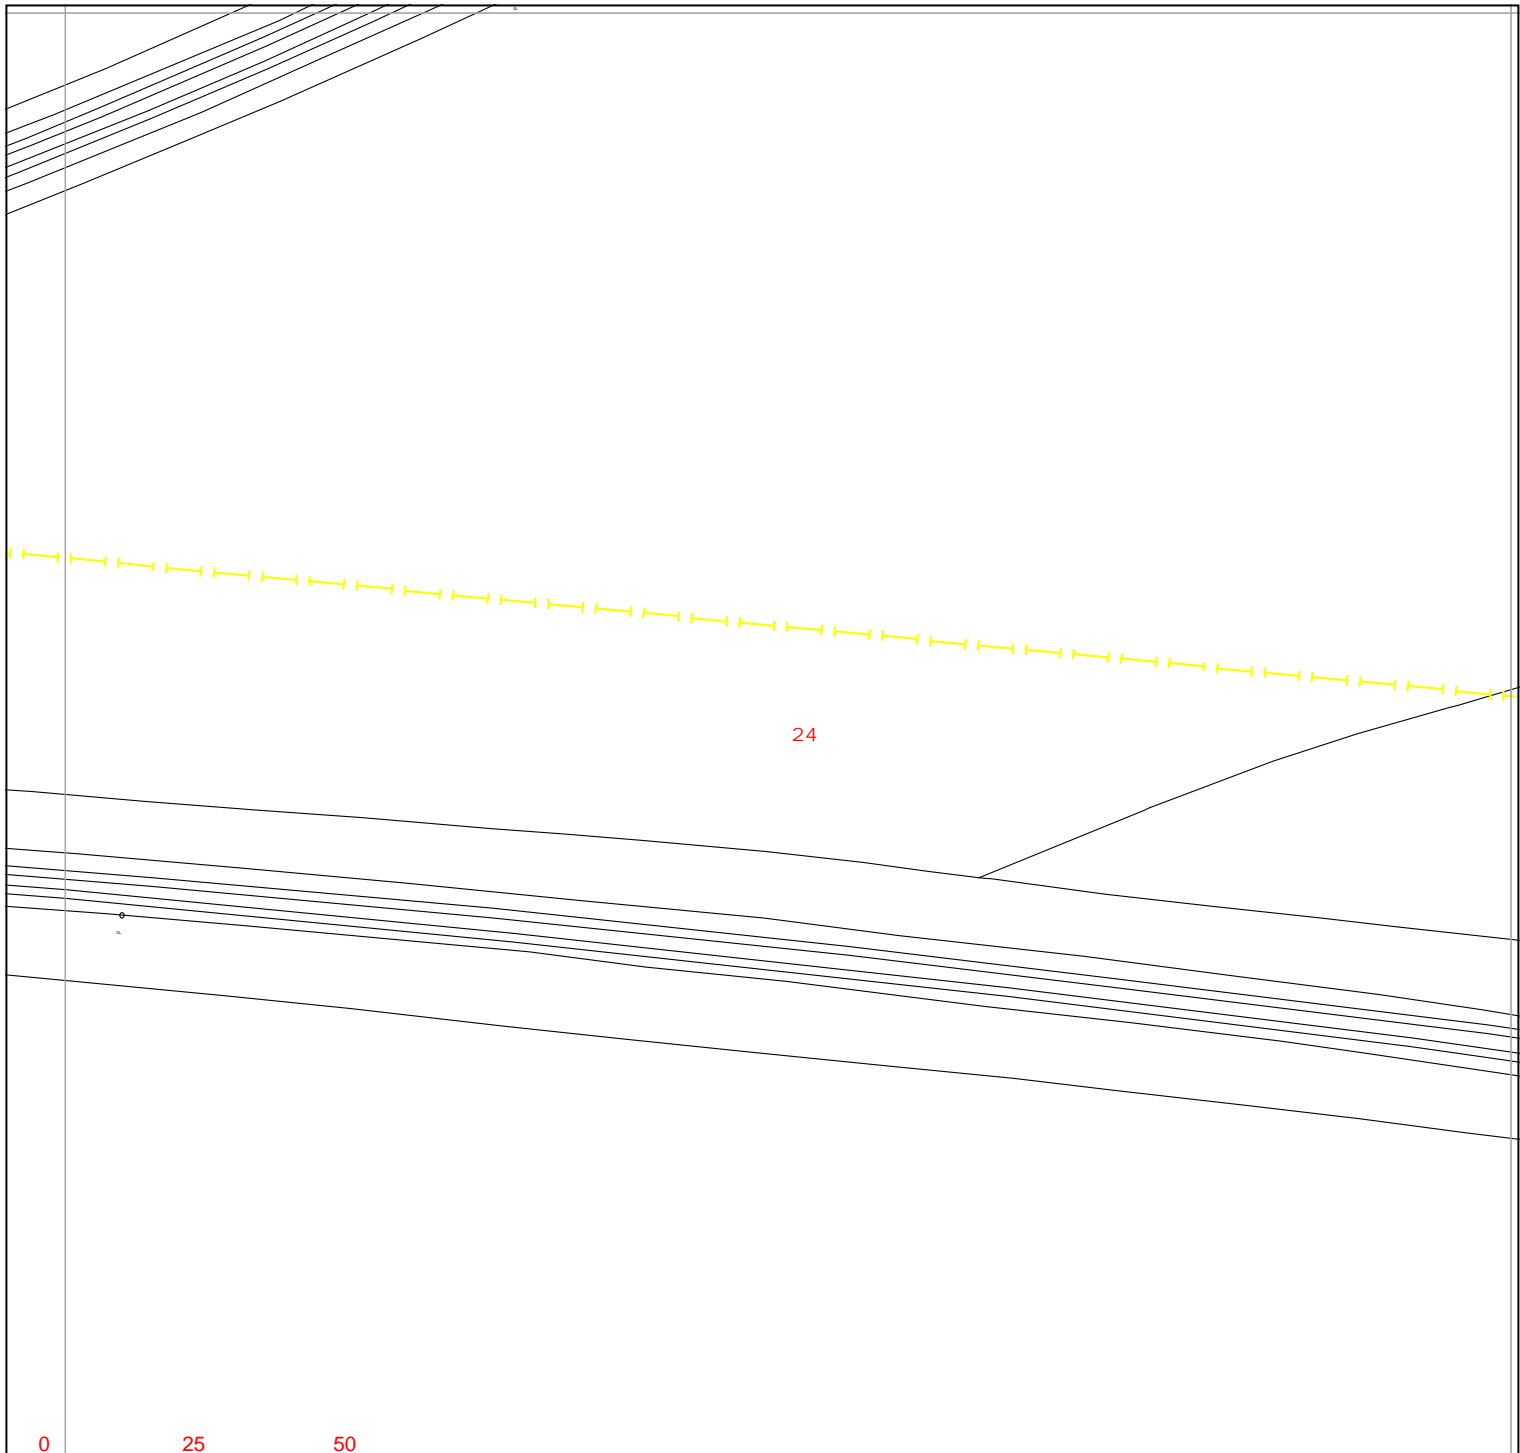

Warning: PDF designed for colour print only with no page scaling.



Contact Us
Mapping Enquiries:
 All areas 0121 623 9780
General Enquiries:
 All areas 0800 096 3080

Date Requested: 08/05/2023
 Job Reference: 29406944
 Site Location: 476361 383022
 Requested by:
 Mr Ben Evans
 Your Scheme/Reference:
 LM 203570/DK - 8

Link Box	Overhead Line	Underground Cable	National Grid Telecoms	Pilot Cables
●				
●	Site Location Line/Area			


IMPORTANT NOTICES

- This information is given as a guide only and its accuracy cannot be guaranteed. Services or recent additions to the network may not be shown.
- Cables, overhead lines & substations owned by other electricity network owners or private companies may be present and may not be shown.
- You should always verify exact locations of cables using a cable locator and by careful use of hand tools in accordance with HSE guidance note HSG47.
- When working within 10m of any overhead electric line you should follow the requirements of HSE Guidance Note GS6.
- For further advice on working near our electricity cables or lines, call our General Enquiries number.
- Advice should be sought from the National Grid Electricity Distribution General Enquiries team for any work that is to take place in proximity to 132kV underground cables and 132kV overhead lines.

Report damage immediately – KEEP EVERYONE AWAY FROM THE AREA
0800 6783 105

Exact Scales:
 1:1250 Area or Circle dig site
 1:500 Line dig site

Crown Copyright © All Rights Reserved. Ordnance Survey Licence numbers: 100022432
 NGED Copyright: This copy has been made by or with the authority of National Grid Electricity Distribution (NGED) pursuant to Section 47 of the Copyright Designs and Patents Act 1988 unless that Act provides a relevant exception to copyright the copy must not be copied without the prior permission of the copyright owner.

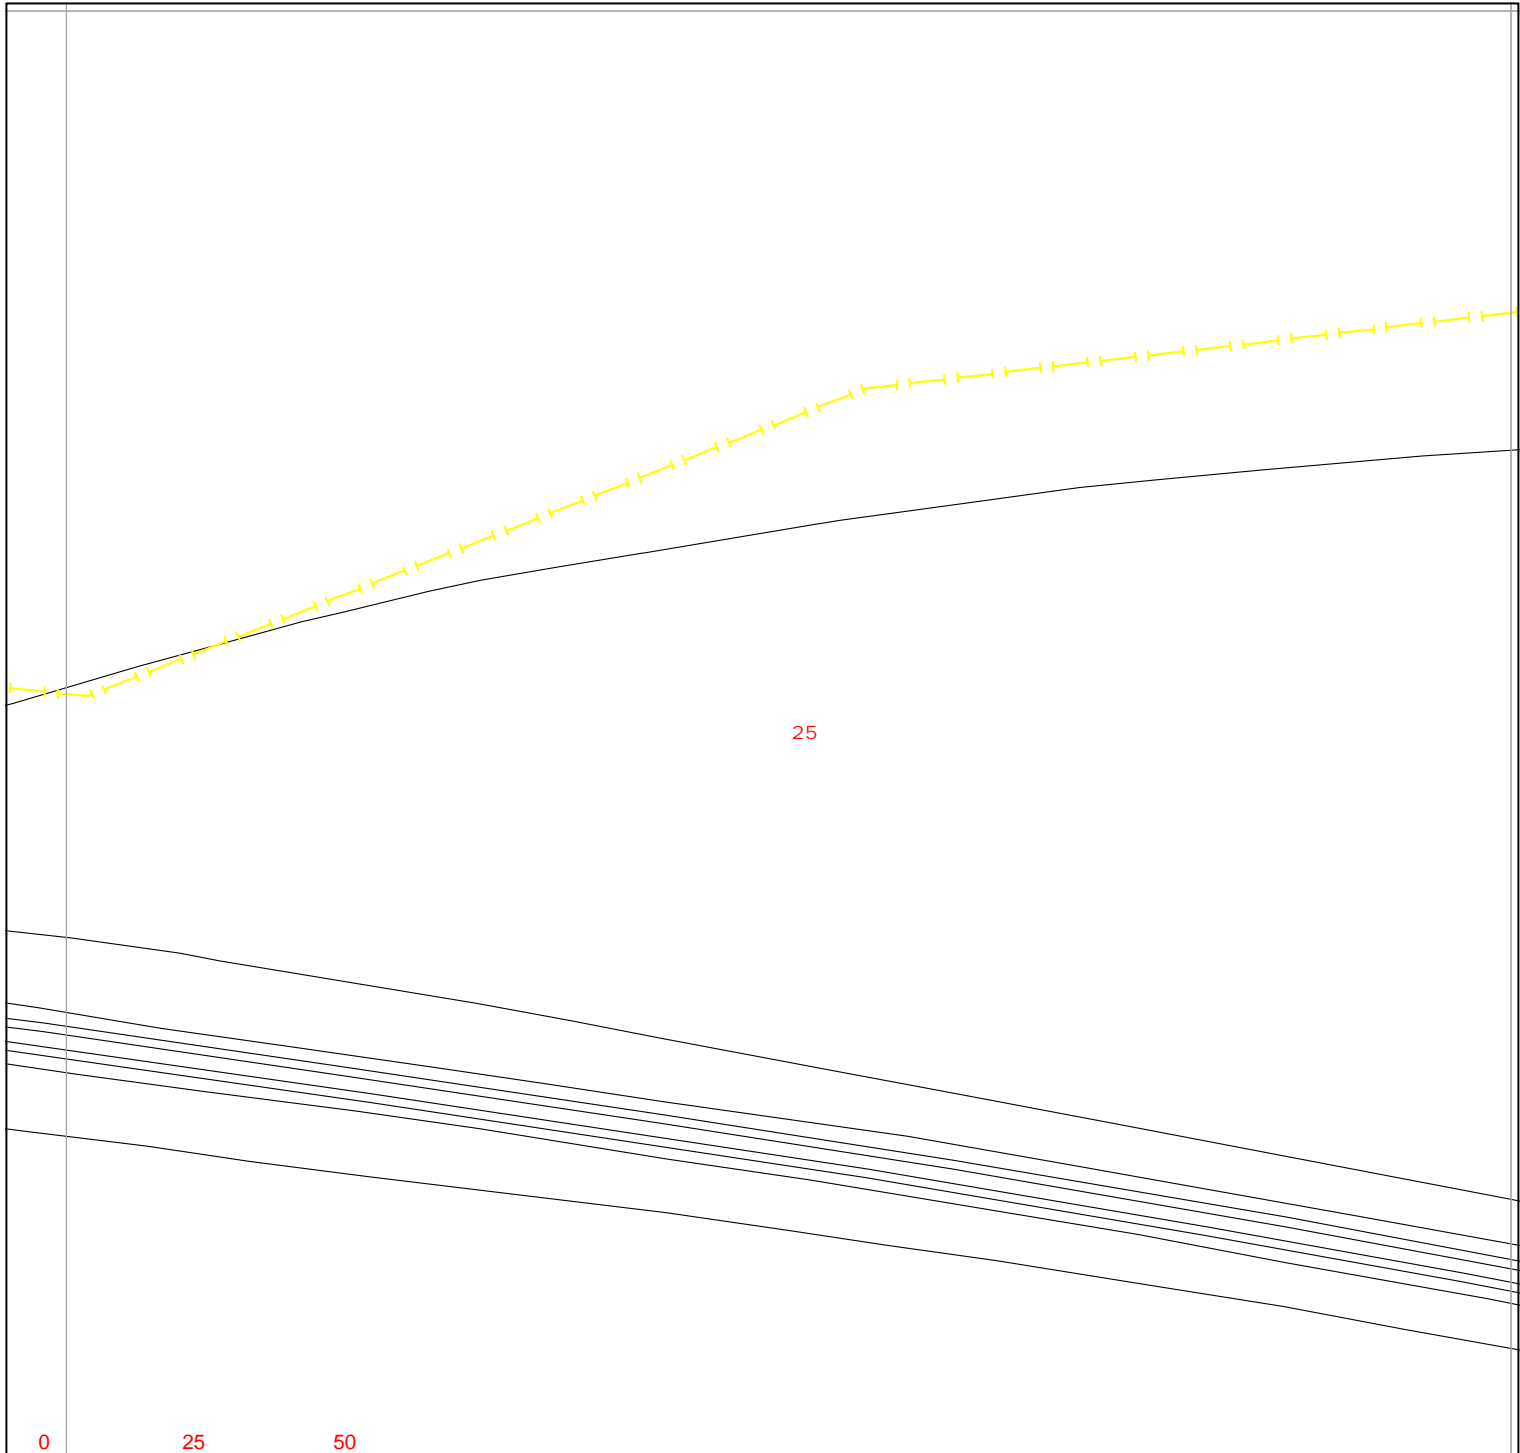

25



Warning: PDF designed for colour print only with no page scaling.

nationalgrid Electricity Distribution

Contact Us

Mapping Enquiries:
All areas 0121 623 9780

General Enquiries:
All areas 0800 096 3080

Date Requested: 08/05/2023
Job Reference: 29406944
Site Location: 476361 383022
Requested by:
Mr Ben Evans
Your Scheme/Reference:
LM 203570/DK - 8

Exact Scales:
1:1250 Area or Circle dig site
1:500 Line dig site


Link Box	Overhead Line	Underground Cable	National Grid Telecoms	Pilot Cables
●				

IMPORTANT NOTICES

- This information is given as a guide only and its accuracy cannot be guaranteed. Services or recent additions to the network may not be shown.
- Cables, overhead lines & substations owned by other electricity network owners or private companies may be present and may not be shown.
- You should always verify exact locations of cables using a cable locator and by careful use of hand tools in accordance with HSE guidance note HSG47.
- When working within 10m of any overhead electric line you should follow the requirements of HSE Guidance Note GS6.
- For further advice on working near our electricity cables or lines, call our General Enquiries number.
- Advice should be sought from the National Grid Electricity Distribution General Enquiries team for any work that is to take place in proximity to 132kV underground cables and 132kV overhead lines.

Report damage immediately – KEEP EVERYONE AWAY FROM THE AREA
0800 6783 105

Crown Copyright © All Rights Reserved. Ordnance Survey Licence numbers: 100022432
NGED Copyright: This copy has been made by or with the authority of National Grid Electricity Distribution (NGED) pursuant to Section 47 of the Copyright Designs and Patents Act 1988 unless that Act provides a relevant exception to copyright the copy must not be copied without the prior permission of the copyright owner.

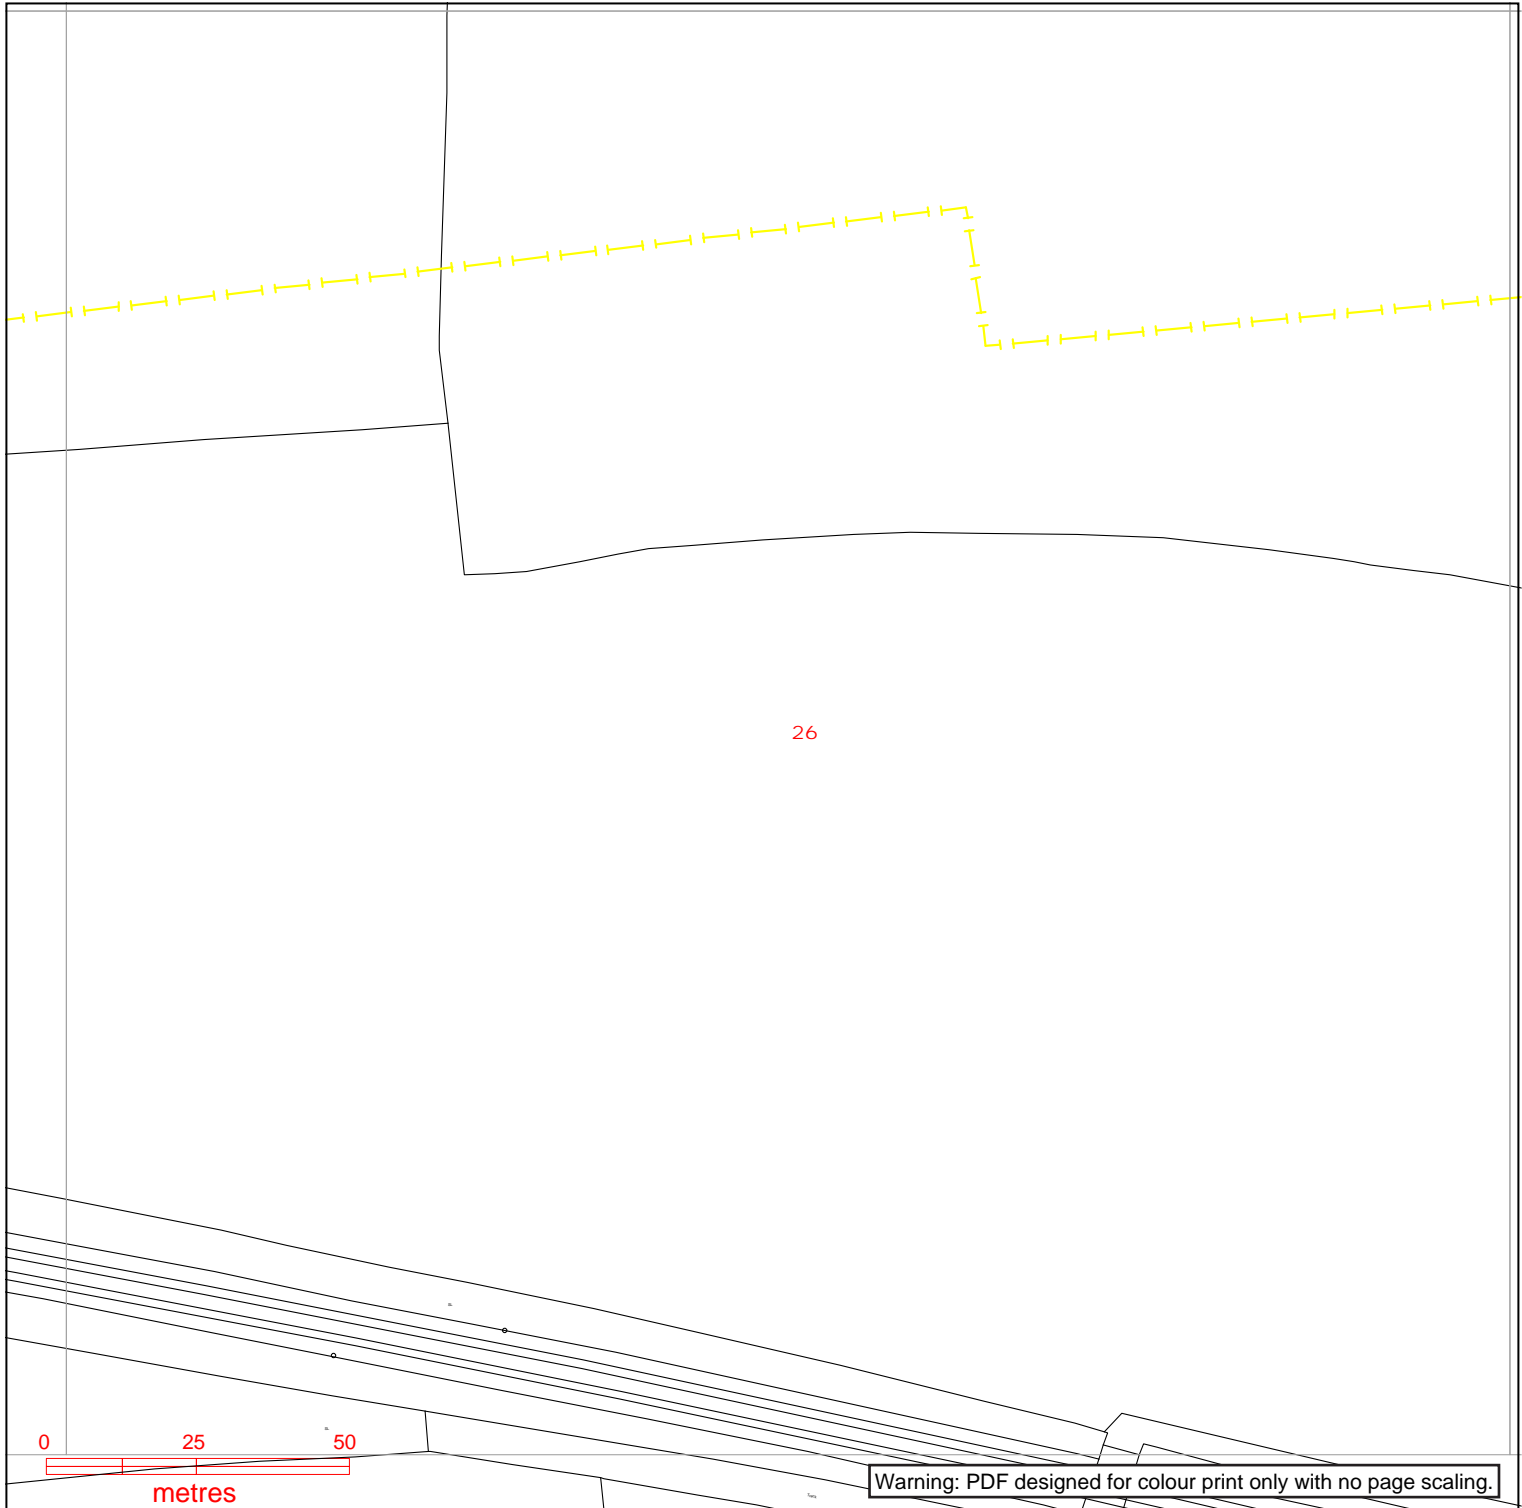


26



Warning: PDF designed for colour print only with no page scaling.

	<table border="0"> <tr> <td data-bbox="363 1545 558 1630"> Link Box ● </td> <td data-bbox="558 1545 798 1630"> Overhead Line </td> <td data-bbox="798 1545 1037 1630"> Underground Cable </td> <td data-bbox="1037 1545 1276 1630"> National Grid Telecoms </td> <td data-bbox="1276 1545 1562 1630"> Pilot Cables </td> </tr> </table>					Link Box ●	Overhead Line 	Underground Cable 	National Grid Telecoms 	Pilot Cables
Link Box ●	Overhead Line 	Underground Cable 	National Grid Telecoms 	Pilot Cables 						
<p>Contact Us</p> <p>Mapping Enquiries: All areas 0121 623 9780</p> <p>General Enquiries: All areas 0800 096 3080</p>	<p>Site Location Line/Area</p> <p>IMPORTANT NOTICES</p> <ul style="list-style-type: none"> This information is given as a guide only and its accuracy cannot be guaranteed. Services or recent additions to the network may not be shown. Cables, overhead lines & substations owned by other electricity network owners or private companies may be present and may not be shown. You should always verify exact locations of cables using a cable locator and by careful use of hand tools in accordance with HSE guidance note HSG47. When working within 10m of any overhead electric line you should follow the requirements of HSE Guidance Note GS6. For further advice on working near our electricity cables or lines, call our General Enquiries number. Advice should be sought from the National Grid Electricity Distribution General Enquiries team for any work that is to take place in proximity to 132kV underground cables and 132kV overhead lines. 									
<p>Report damage immediately – KEEP EVERYONE AWAY FROM THE AREA 0800 6783 105</p>										
<p>Exact Scales: 1:1250 Area or Circle dig site 1:500 Line dig site</p>		<p>Crown Copyright © All Rights Reserved. Ordnance Survey Licence numbers: 100022432 NGED Copyright: This copy has been made by or with the authority of National Grid Electricity Distribution (NGED) pursuant to Section 47 of the Copyright Designs and Patents Act 1988 unless that Act provides a relevant exception to copyright the copy must not be copied without the prior permission of the copyright owner.</p>								

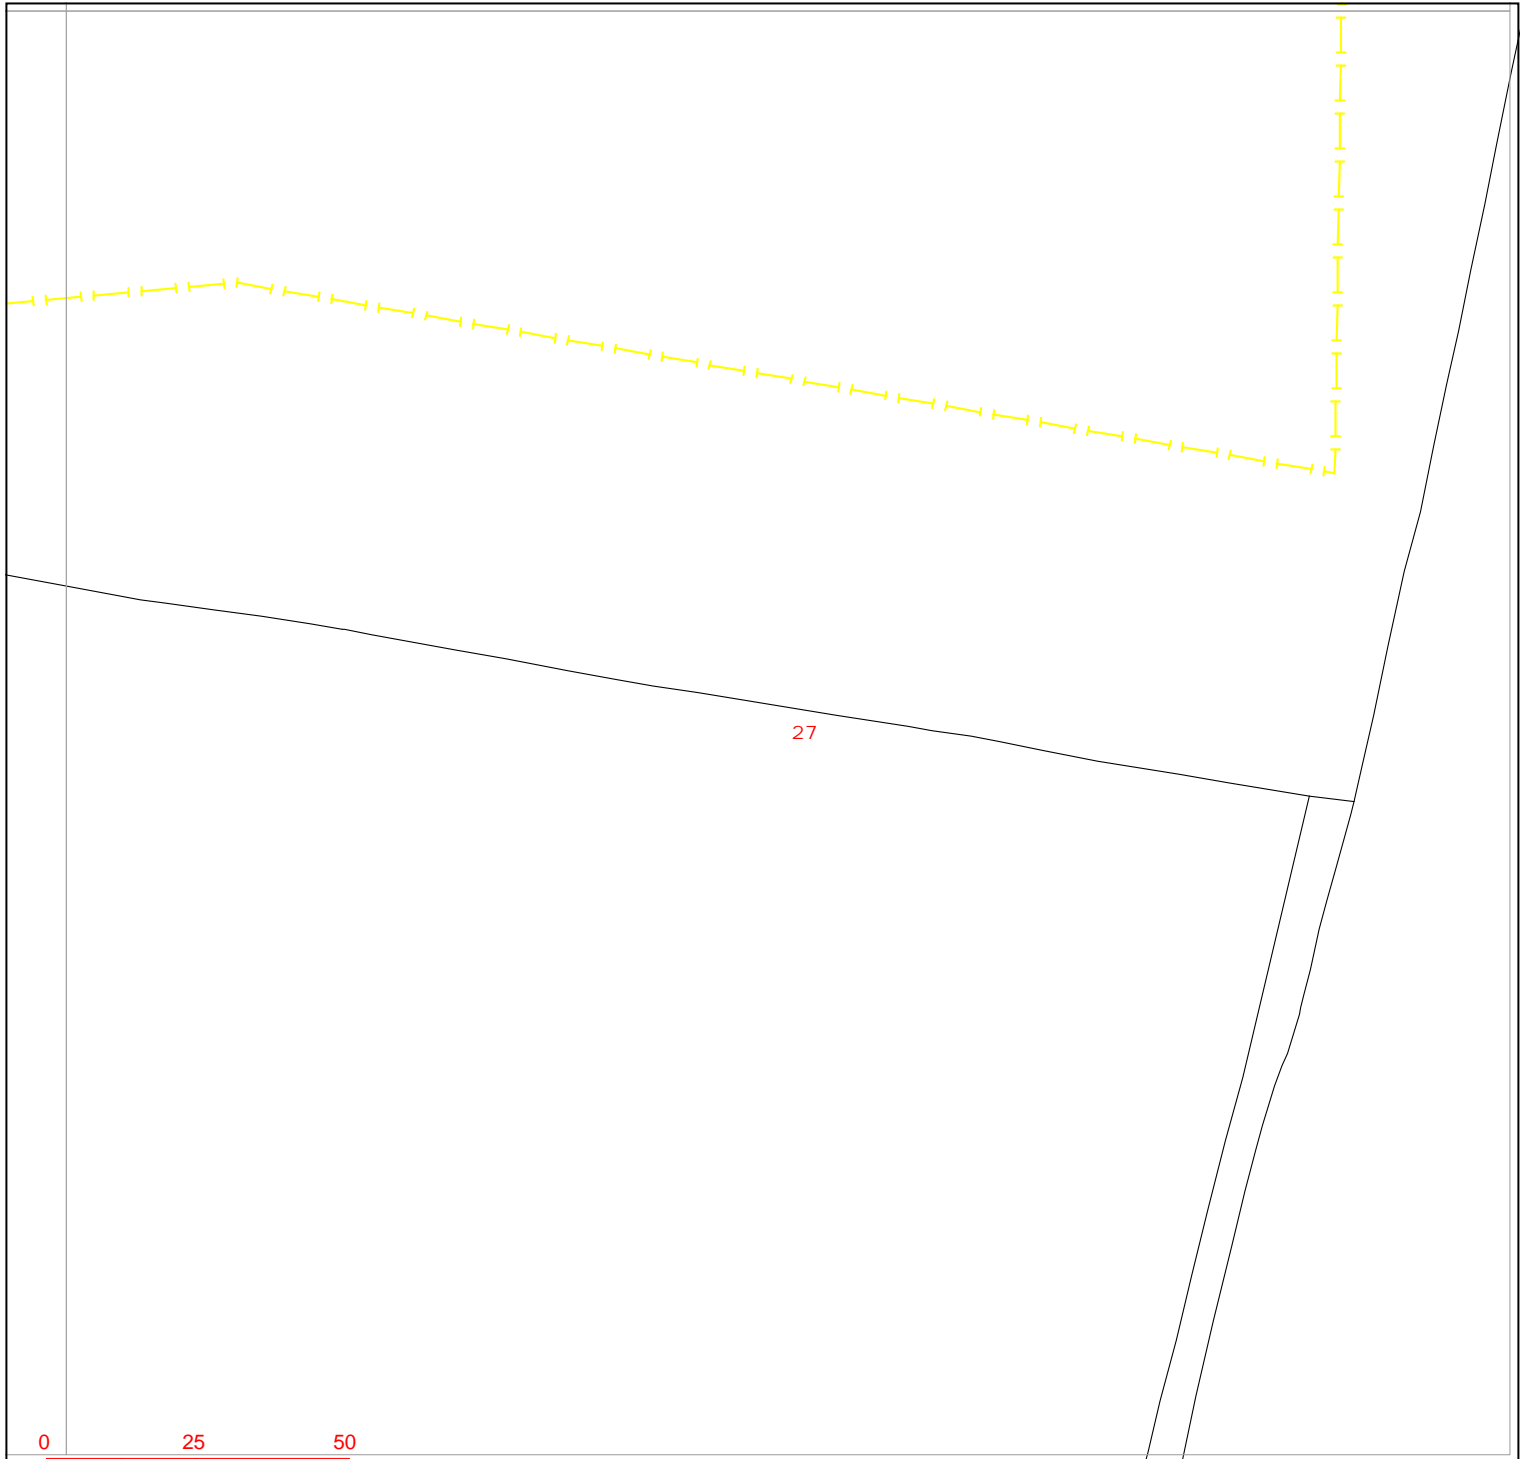

Warning: PDF designed for colour print only with no page scaling.

nationalgrid Electricity Distribution

Contact Us

Mapping Enquiries:
All areas 0121 623 9780

General Enquiries:
All areas 0800 096 3080

Date Requested: 08/05/2023
Job Reference: 29406944
Site Location: 476361 383022
Requested by:
Mr Ben Evans
Your Scheme/Reference:
LM 203570/DK - 8

Exact Scales:
1:1250 Area or Circle dig site
1:500 Line dig site


Link Box ●	Overhead Line ○—○ PL ○—○ Service ○—○ LV ○—○ HV (11kV) ○—○ HV (33kV) ○—○ HV (66kV) ○—○ HV (132kV)	Underground Cable -	National Grid Telecoms - - - - - PME Earth -E- - - - - Underground Earth	Pilot Cables - - - - - ○ Pole Mounted Transformer □ Ground Mounted Transformer
----------------------	--	---	---	--

IMPORTANT NOTICES

- This information is given as a guide only and its accuracy cannot be guaranteed. Services or recent additions to the network may not be shown.
- Cables, overhead lines & substations owned by other electricity network owners or private companies may be present and may not be shown.
- You should always verify exact locations of cables using a cable locator and by careful use of hand tools in accordance with HSE guidance note HSG47.
- When working within 10m of any overhead electric line you should follow the requirements of HSE Guidance Note GS6.
- For further advice on working near our electricity cables or lines, call our General Enquiries number.
- Advice should be sought from the National Grid Electricity Distribution General Enquiries team for any work that is to take place in proximity to 132kV underground cables and 132kV overhead lines.

Report damage immediately – KEEP EVERYONE AWAY FROM THE AREA
0800 6783 105

Crown Copyright © All Rights Reserved. Ordnance Survey Licence numbers: 100022432
NGED Copyright: This copy has been made by or with the authority of National Grid Electricity Distribution (NGED) pursuant to Section 47 of the Copyright Designs and Patents Act 1988 unless that Act provides a relevant exception to copyright the copy must not be copied without the prior permission of the copyright owner.

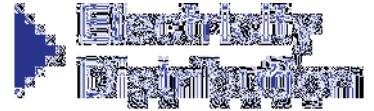

Our Ref: 29406946 Your Ref: LM 203570/DK - 9

Monday, 08 May 2023

Ben Evans
The Hub, 500 Park Avenue, Aztec West
Almondsbury
Bristol
BS32 4RZ

**National Grid Electricity
Distribution**
Mapping Centre
Toll End Road
Tipton
West Midlands
United Kingdom
DY4 0HH
www.nationalgrid.co.uk

Dear Ben Evans

Thank you for your enquiry dated Monday, 08 May 2023

I now enclose a copy of our plan showing existing National Grid Electricity Distribution (NGED) Electricity / National Grid Telecoms (NGT) apparatus in the vicinity of your proposed works. This information is given as a general guide only and its accuracy cannot be guaranteed. Please note that all NGED equipment on site should be assumed to be LIVE until NGED prove otherwise and provide you with confirmation to this effect in writing. Recent additions to our network, or service connections between the main cable and a building or street lamp may not be shown.

Map Response
T 0121 623 9780
NGED.MapResponse
@nationalgrid.co.uk

Damage to underground cables and contact with overhead lines can cause severe injury or may prove fatal. If you are excavating on site in the vicinity of either NGED Electrical apparatus or NGT Telecoms apparatus you must comply with the requirements of the following:-

Health & Safety Executive guidance HS(G)47, Avoiding Danger from underground services.

Work taking place in the vicinity of our plant is also regulated under the:-

Electricity at Work Regulations 1989, Health and Safety Act 1974, CDM Regulations 2015.
Safe working procedures should be defined and practiced

Please ensure that the use of mechanical excavators in the vicinity of our plant is kept to a minimum. NGT Telecoms ducts contain fibre cables, which are expensive to repair. Therefore, extreme care must be taken whilst working in the vicinity of these ducts, hand digging methods being used to determine their precise position.

If there are overhead lines crossing your site and your proposal involves building works which may infringe the clearance to our overhead system then you should call the relevant general enquiries number (see page 2 of this letter) for advice. Where overhead lines cross your site you must comply with the requirements of Health & Safety Executive guidance as laid down in GS6, Avoidance of Danger from Overhead Electric Lines.

National Grid Electricity
Distribution
South West - 02366894
South Wales - 02366985
East Midlands - 02366923
West Midlands - 03600574

Where diversions to NGED apparatus are needed to allow change to occur on site, the cost of these alterations may be charged to the persons responsible for the works.

If you require advice in connection with your proposals please contact the relevant general enquiries number (see page 2 of this letter)

Registered in
England and Wales


Following consultation the local NGED team will where necessary prepare detailed proposals and provide a quotation for any necessary alterations and/or development of our equipment on the site.

Registered Office:
Avonbank
Feeder Road
Bristol
BS2 0TB

This information is given as a guide only and its accuracy cannot be guaranteed. This plan is based on data from our Geographic Information System, which is updated every 24 hours to reflect changes to our network. The information contained in this plan reflects the most recent network GIS data, however changes to the network (including network additions and new service

Safety Documents:

<https://www.nationalgrid.co.uk/customers-and-community/health-safety/public-safety-advice>

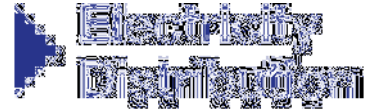

connections) may not be shown. You are advised to obtain an up to date plan on the date of commencing on-site works.

Yours sincerely
NGED Map Response Team

Contact Us

Emergency or Power Supply issues

In an emergency call 105, 24 hours a day.

Mapping Enquiries

If you have an enquiry relating to this letter or the attached map plan, please contact us using the following information:

Telephone 0121 623 9780
Email NGED.MapResponse@nationalgrid.co.uk

General Enquiries


If you have a general enquiry, please call us on the following telephone number:

All areas 0800 096 3080

LSBUD

If you have an enquiry relating to the use of the LSBUD website please contact LSBUD using the following information:

Telephone 0345 437 7365
Email enquiries@LSBUD.co.uk
Website www.LSBUD.co.uk

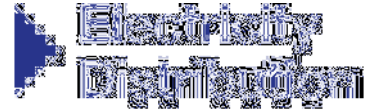


Steps to help keep you safe

- **If you are working within 10 metres of our 33kV, 66kV, 132kV underground electricity cables or within 10 meters of an overhead electricity line you should call the relevant General Enquiries for free safety advice.**

Safety Documents – please download our informative safety documents to help ensure that you, your staff and the public are kept safe whilst working in the vicinity of electricity.

<https://www.nationalgrid.co.uk/customers-and-community/health-safety/public-safety-advice>

- **Make sure you have up to date plans** - remember that recent additions to our network or service connections between the main cable and a building or street lamp may not be shown.
- **Look for signs of service cables** - an electricity meter box or nearby streetlamp may give you an indication that service cables are present in your area of work.
- **Non NGED Network** - electricity cables, lines and equipment owned by others may also be present in addition to NGED network. They are unlikely to be shown on our plans.
- **Use a cable locator** - trace electricity cables and mark the position of them using paint or other waterproof marking on the ground.
- **Hand dig trial holes** - to confirm the position of cables in close proximity to your area of your work and use spades and shovels rather than picks, pins or forks.
- **Have an emergency plan** - so that everyone working on site understands what to do in the event of an underground electricity cable being damaged or contact being made with an overhead electricity line.
- **If you are working within 10 meters** of an overhead electricity line then it may be necessary for you to erect warning signs and markers, or height restriction goal posts. Ensure that you comply with the requirements of Health & Safety Executive guidance laid down in GS6, Avoidance of Danger from Overhead Electric Lines.
- **If you are erecting a structure** that could allow anyone standing on it, or its access device (ladder, scaffold, MEWP), to come within 3m of any overhead electric line then **you must inform us**. This is your duty and a legal requirement under the Electricity Safety, Quality & Continuity Regulations 2002.
- **If you cannot work safely** around the underground electricity cable or overhead electricity line, then you may need to get it moved to allow your works to go ahead. Call the general enquiry numbers above for guidance.
- **It is possible that cables or pipes may be embedded in concrete** - electricity cables embedded in concrete **MUST** be made 'dead' by Western Power Distribution or the cable owner before the concrete is broken out. Alternatively, another safe way of working should be agreed.
- **Cables are sometimes covered by tiles or a marker tape** - these can be concrete, polythene or earthenware and are a useful early warning of the presence of cables; you should avoid disturbing any tiles or tape to expose the cable. Not all cables have these warning indicators.

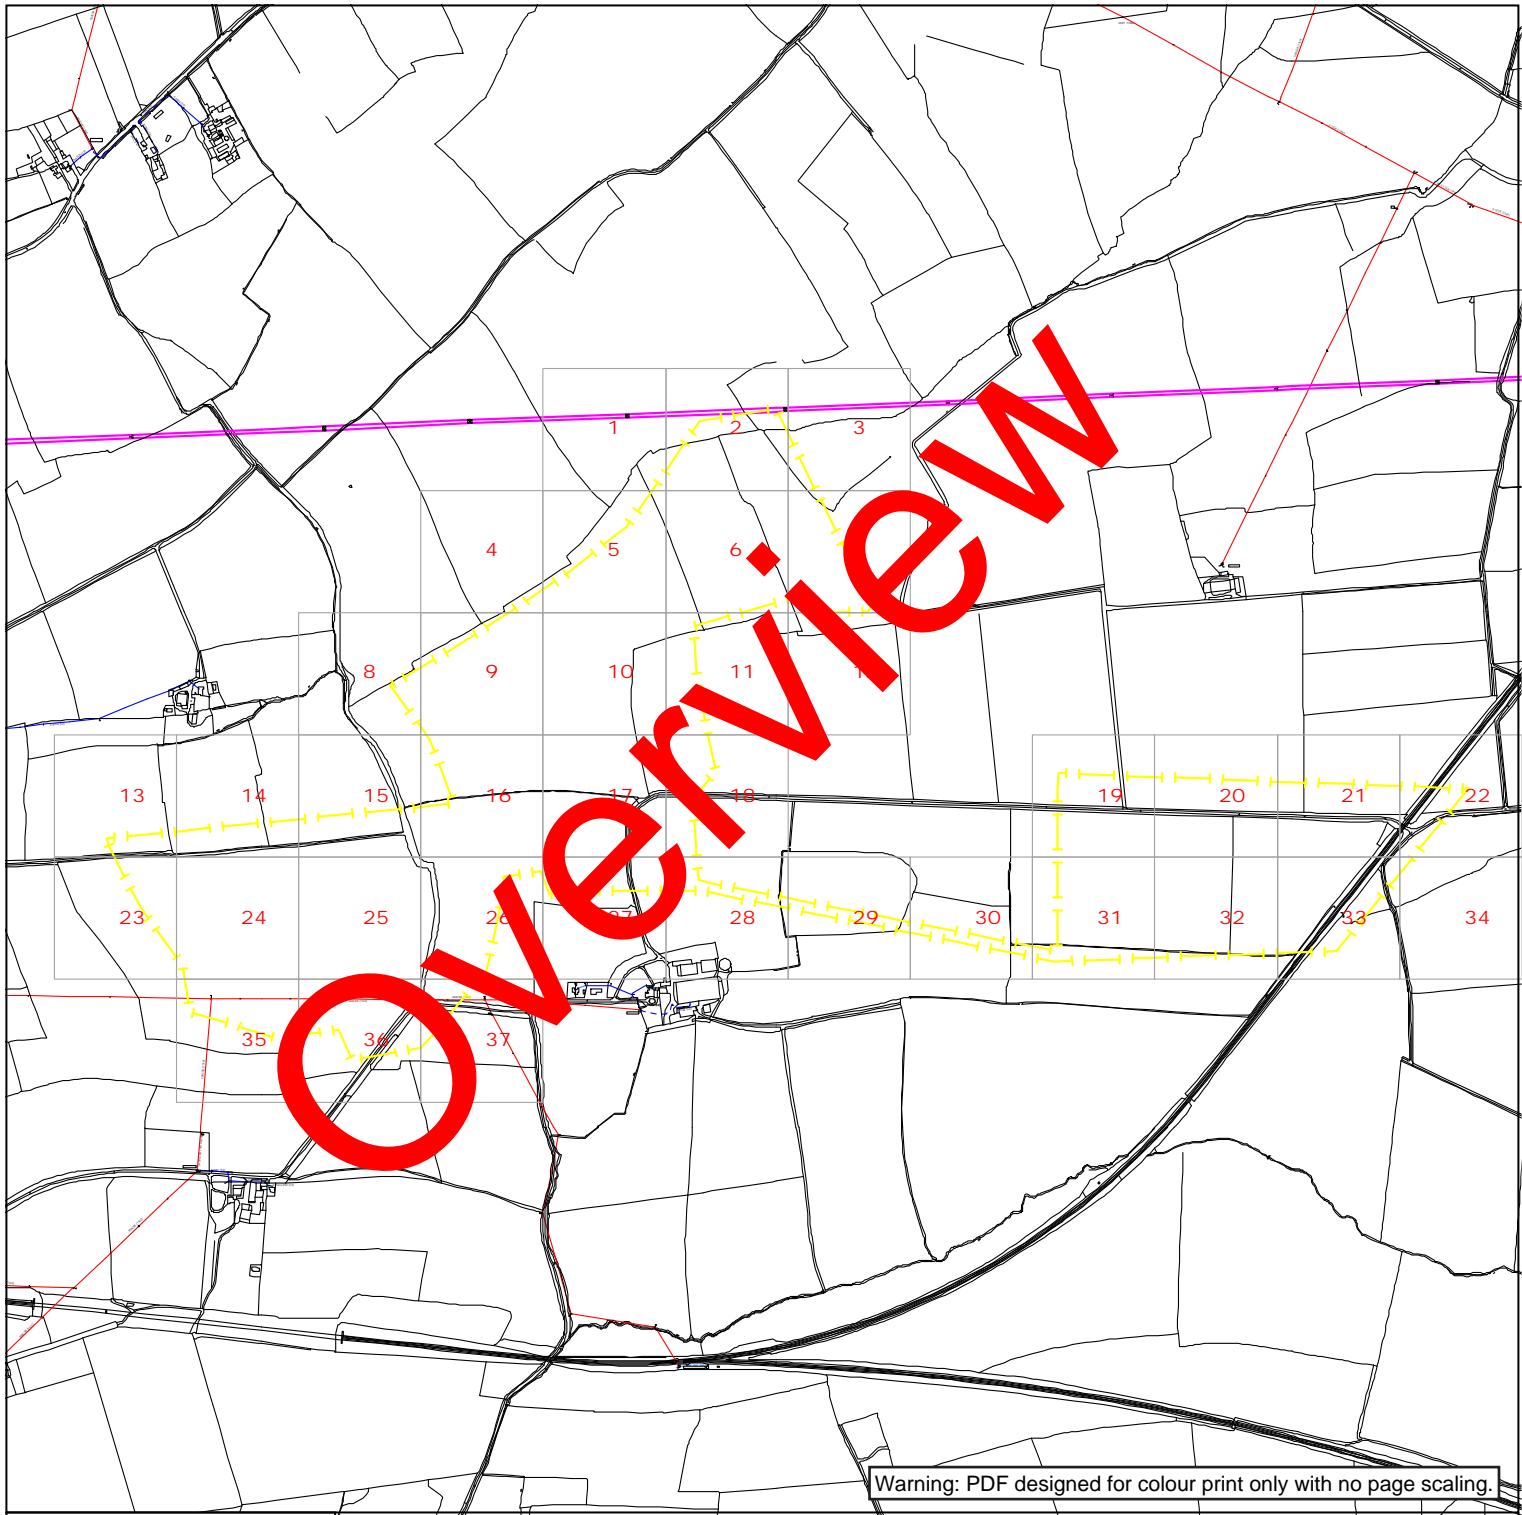

Warning: PDF designed for colour print only with no page scaling.



Contact Us

Mapping Enquiries:
All areas 0121 623 9780

General Enquiries:
All areas 0800 096 3080

Date Requested: 08/05/2023
Job Reference: 29406946
Site Location: 476022 383761
Requested by:
Mr Ben Evans
Your Scheme/Reference:
LM 203570/DK - 9


Link Box	Overhead Line	Underground Cable	National Grid Telecoms	Pilot Cables
●	○ PL ○ Service ○ LV ○ HV (11kV) ○ HV (33kV) ○ HV (66kV) ○ HV (132kV)	---	--- PME Earth --- Underground Earth	○ Pole Mounted Transformer □ Ground Mounted Transformer
Site Location Line/Area	--- (various colors)	---		

IMPORTANT NOTICES

- This information is given as a guide only and its accuracy cannot be guaranteed. Services or recent additions to the network may not be shown.
- Cables, overhead lines & substations owned by other electricity network owners or private companies may be present and may not be shown.
- You should always verify exact locations of cables using a cable locator and by careful use of hand tools in accordance with HSE guidance note HSG47.
- When working within 10m of any overhead electric line you should follow the requirements of HSE Guidance Note GS6.
- For further advice on working near our electricity cables or lines, call our General Enquiries number.
- Advice should be sought from the National Grid Electricity Distribution General Enquiries team for any work that is to take place in proximity to 132kV underground cables and 132kV overhead lines.

Report damage immediately – KEEP EVERYONE AWAY FROM THE AREA
0800 6783 105

Crown Copyright © All Rights Reserved. Ordnance Survey Licence numbers: 100022432
NGED Copyright: This copy has been made by or with the authority of National Grid Electricity Distribution (NGED) pursuant to Section 47 of the Copyright Designs and Patents Act 1988 unless that Act provides a relevant exception to copyright the copy must not be copied without the prior permission of the copyright owner.

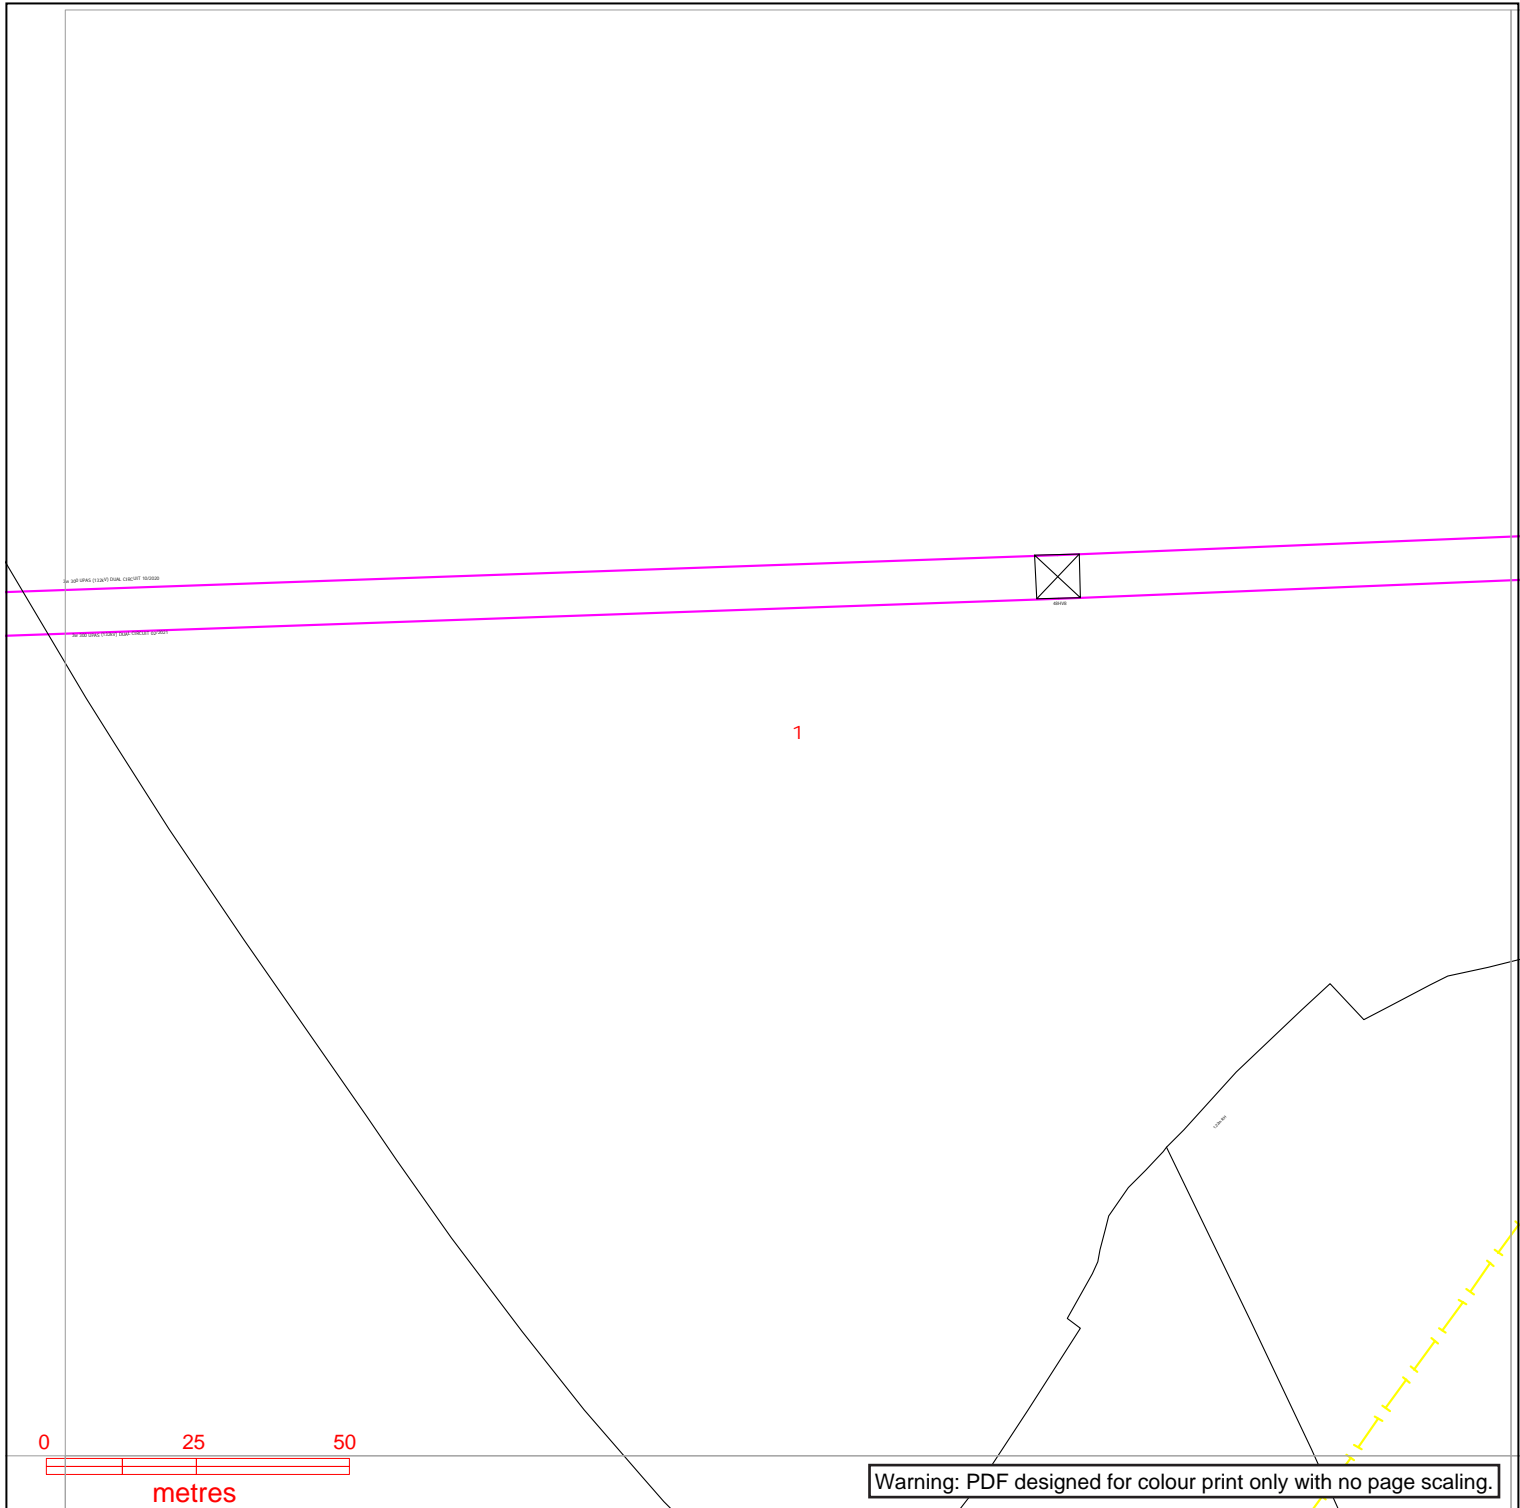

Warning: PDF designed for colour print only with no page scaling.

nationalgrid Electricity Distribution

Contact Us

Mapping Enquiries:
All areas 0121 623 9780

General Enquiries:
All areas 0800 096 3080

Date Requested: 08/05/2023
Job Reference: 29406946
Site Location: 476022 383761
Requested by:
Mr Ben Evans
Your Scheme/Reference:
LM 203570/DK - 9

Exact Scales:
1:1250 Area or Circle dig site
1:500 Line dig site


Link Box	Overhead Line	Underground Cable	National Grid Telecoms	Pilot Cables
●	○ PL ○ Service ○ LV ○ HV (11kV) ○ HV (33kV) ○ HV (66kV) ○ HV (132kV)	---	--- PME Earth ---E Underground Earth	○ Pole Mounted Transformer □ Ground Mounted Transformer

IMPORTANT NOTICES

- This information is given as a guide only and its accuracy cannot be guaranteed. Services or recent additions to the network may not be shown.
- Cables, overhead lines & substations owned by other electricity network owners or private companies may be present and may not be shown.
- You should always verify exact locations of cables using a cable locator and by careful use of hand tools in accordance with HSE guidance note HSG47.
- When working within 10m of any overhead electric line you should follow the requirements of HSE Guidance Note GS6.
- For further advice on working near our electricity cables or lines, call our General Enquiries number.
- Advice should be sought from the National Grid Electricity Distribution General Enquiries team for any work that is to take place in proximity to 132kV underground cables and 132kV overhead lines.

Report damage immediately – KEEP EVERYONE AWAY FROM THE AREA
0800 6783 105

Crown Copyright © All Rights Reserved. Ordnance Survey Licence numbers: 100022432
NGED Copyright: This copy has been made by or with the authority of National Grid Electricity Distribution (NGED) pursuant to Section 47 of the Copyright Designs and Patents Act 1988 unless that Act provides a relevant exception to copyright the copy must not be copied without the prior permission of the copyright owner.

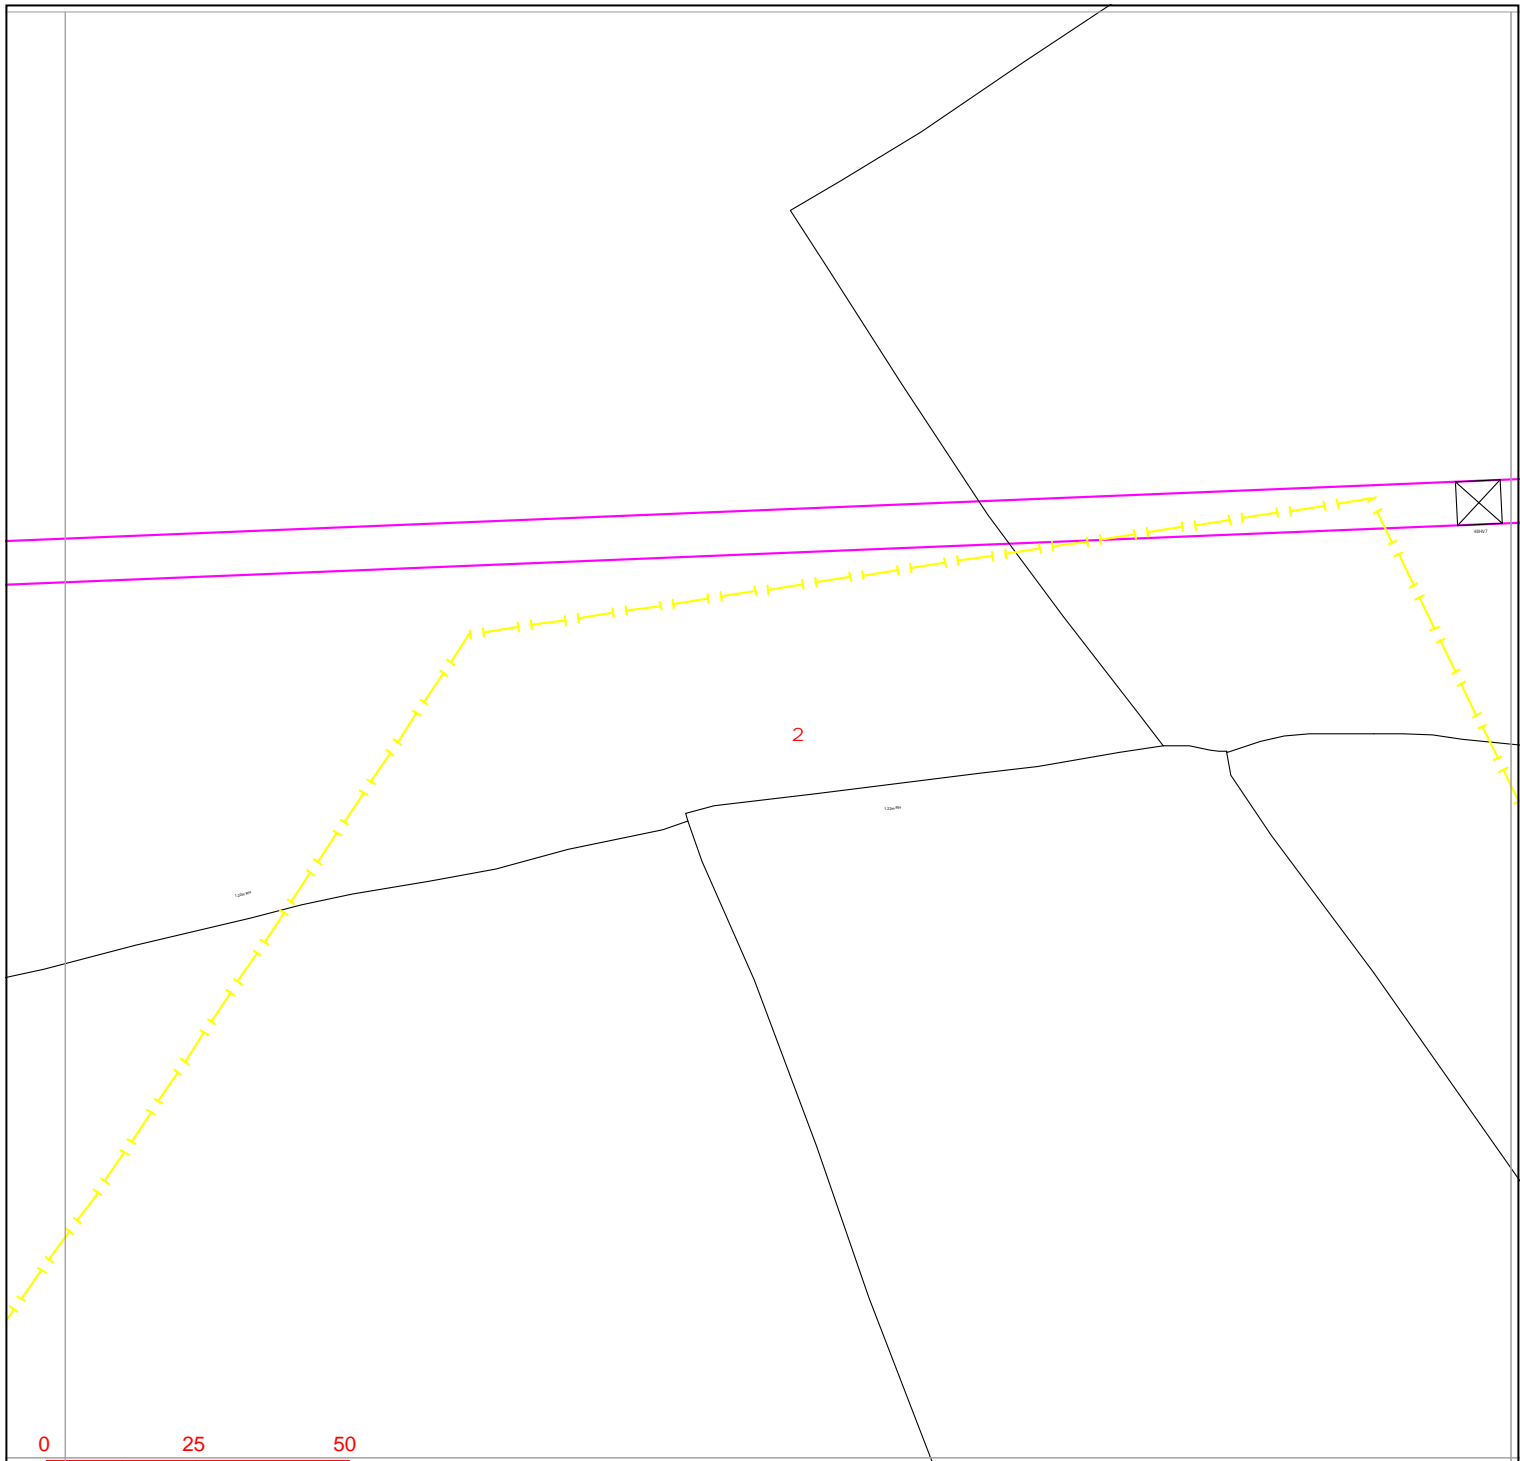

Warning: PDF designed for colour print only with no page scaling.

nationalgrid Electricity Distribution

Contact Us

Mapping Enquiries:
All areas 0121 623 9780

General Enquiries:
All areas 0800 096 3080

Date Requested: 08/05/2023
Job Reference: 29406946
Site Location: 476022 383761
Requested by:
Mr Ben Evans
Your Scheme/Reference:
LM 203570/DK - 9

Exact Scales:
1:1250 Area or Circle dig site
1:500 Line dig site


Link Box	Overhead Line	Underground Cable	National Grid Telecoms	Pilot Cables
●	○ PL ○ Service ○ LV ○ HV (11kV) ○ HV (33kV) ○ HV (66kV) ○ HV (132kV)	---	---E	○ Pole Mounted Transformer □ Ground Mounted Transformer
Site Location Line/Area	---	---	---E PME Earth ---E Underground Earth	
--- --- ---	---	---		

IMPORTANT NOTICES

- This information is given as a guide only and its accuracy cannot be guaranteed. Services or recent additions to the network may not be shown.
- Cables, overhead lines & substations owned by other electricity network owners or private companies may be present and may not be shown.
- You should always verify exact locations of cables using a cable locator and by careful use of hand tools in accordance with HSE guidance note HSG47.
- When working within 10m of any overhead electric line you should follow the requirements of HSE Guidance Note GS6.
- For further advice on working near our electricity cables or lines, call our General Enquiries number.
- Advice should be sought from the National Grid Electricity Distribution General Enquiries team for any work that is to take place in proximity to 132kV underground cables and 132kV overhead lines.

Report damage immediately – KEEP EVERYONE AWAY FROM THE AREA
0800 6783 105

Crown Copyright © All Rights Reserved. Ordnance Survey Licence numbers: 100022432
NGED Copyright: This copy has been made by or with the authority of National Grid Electricity Distribution (NGED) pursuant to Section 47 of the Copyright Designs and Patents Act 1988 unless that Act provides a relevant exception to copyright the copy must not be copied without the prior permission of the copyright owner.

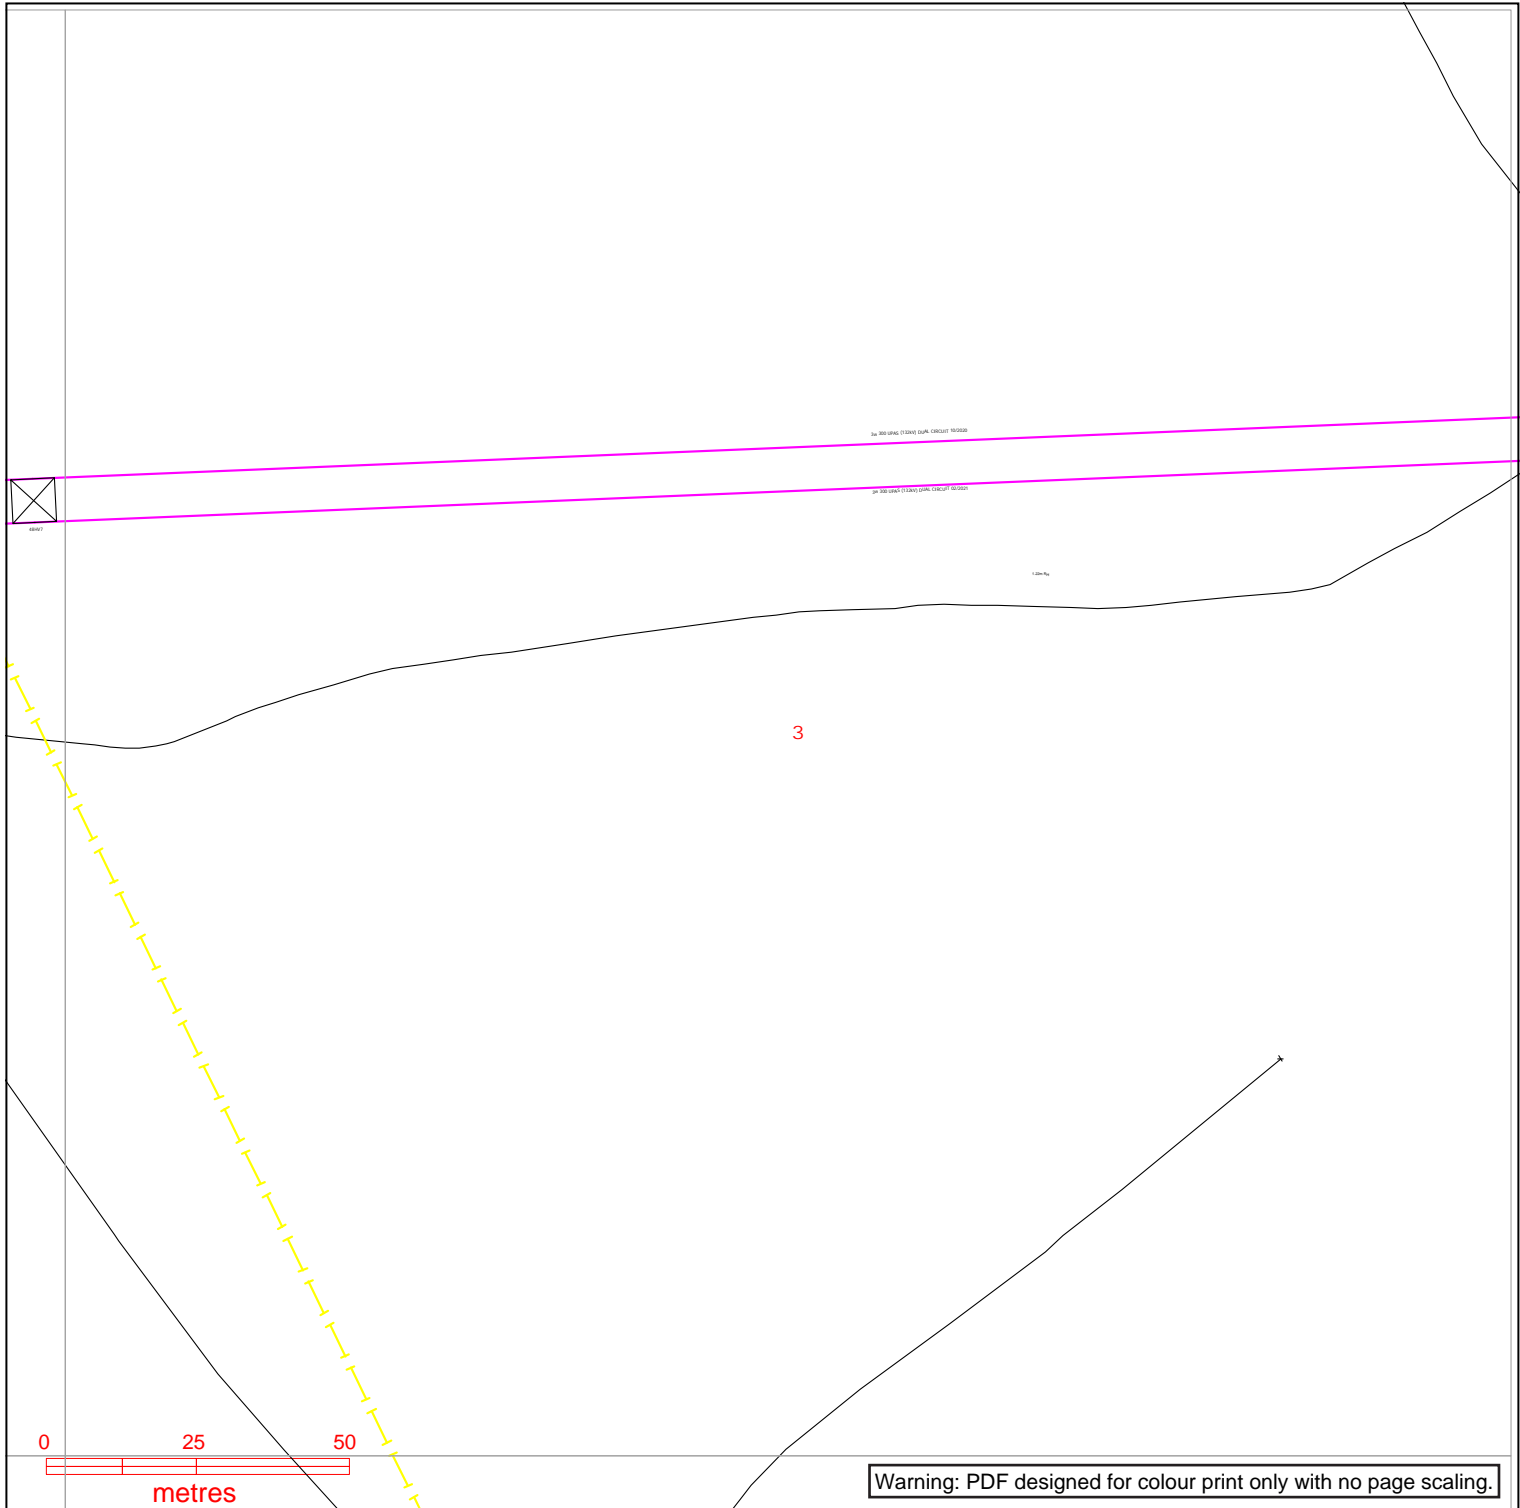

nationalgrid Electricity Distribution

Contact Us

Mapping Enquiries:
All areas 0121 623 9780

General Enquiries:
All areas 0800 096 3080

Date Requested: 08/05/2023
Job Reference: 29406946
Site Location: 476022 383761
Requested by:
Mr Ben Evans
Your Scheme/Reference:
LM 203570/DK - 9

Exact Scales:
1:1250 Area or Circle dig site
1:500 Line dig site


Link Box	Overhead Line	Underground Cable	National Grid Telecoms	Pilot Cables
●	○ PL ○ Service ○ LV ○ HV (11kV) ○ HV (33kV) ○ HV (66kV) ○ HV (132kV)	--- --- ---	--- --- ---	○ Pole Mounted Transformer □ Ground Mounted Transformer
■	■	■	■ PME Earth ■ Underground Earth	

IMPORTANT NOTICES

- This information is given as a guide only and its accuracy cannot be guaranteed. Services or recent additions to the network may not be shown.
- Cables, overhead lines & substations owned by other electricity network owners or private companies may be present and may not be shown.
- You should always verify exact locations of cables using a cable locator and by careful use of hand tools in accordance with HSE guidance note HSG47.
- When working within 10m of any overhead electric line you should follow the requirements of HSE Guidance Note GS6.
- For further advice on working near our electricity cables or lines, call our General Enquiries number.
- Advice should be sought from the National Grid Electricity Distribution General Enquiries team for any work that is to take place in proximity to 132kV underground cables and 132kV overhead lines.

Report damage immediately – KEEP EVERYONE AWAY FROM THE AREA
0800 6783 105

Crown Copyright © All Rights Reserved. Ordnance Survey Licence numbers: 100022432
NGED Copyright: This copy has been made by or with the authority of National Grid Electricity Distribution (NGED) pursuant to Section 47 of the Copyright Designs and Patents Act 1988 unless that Act provides a relevant exception to copyright the copy must not be copied without the prior permission of the copyright owner.

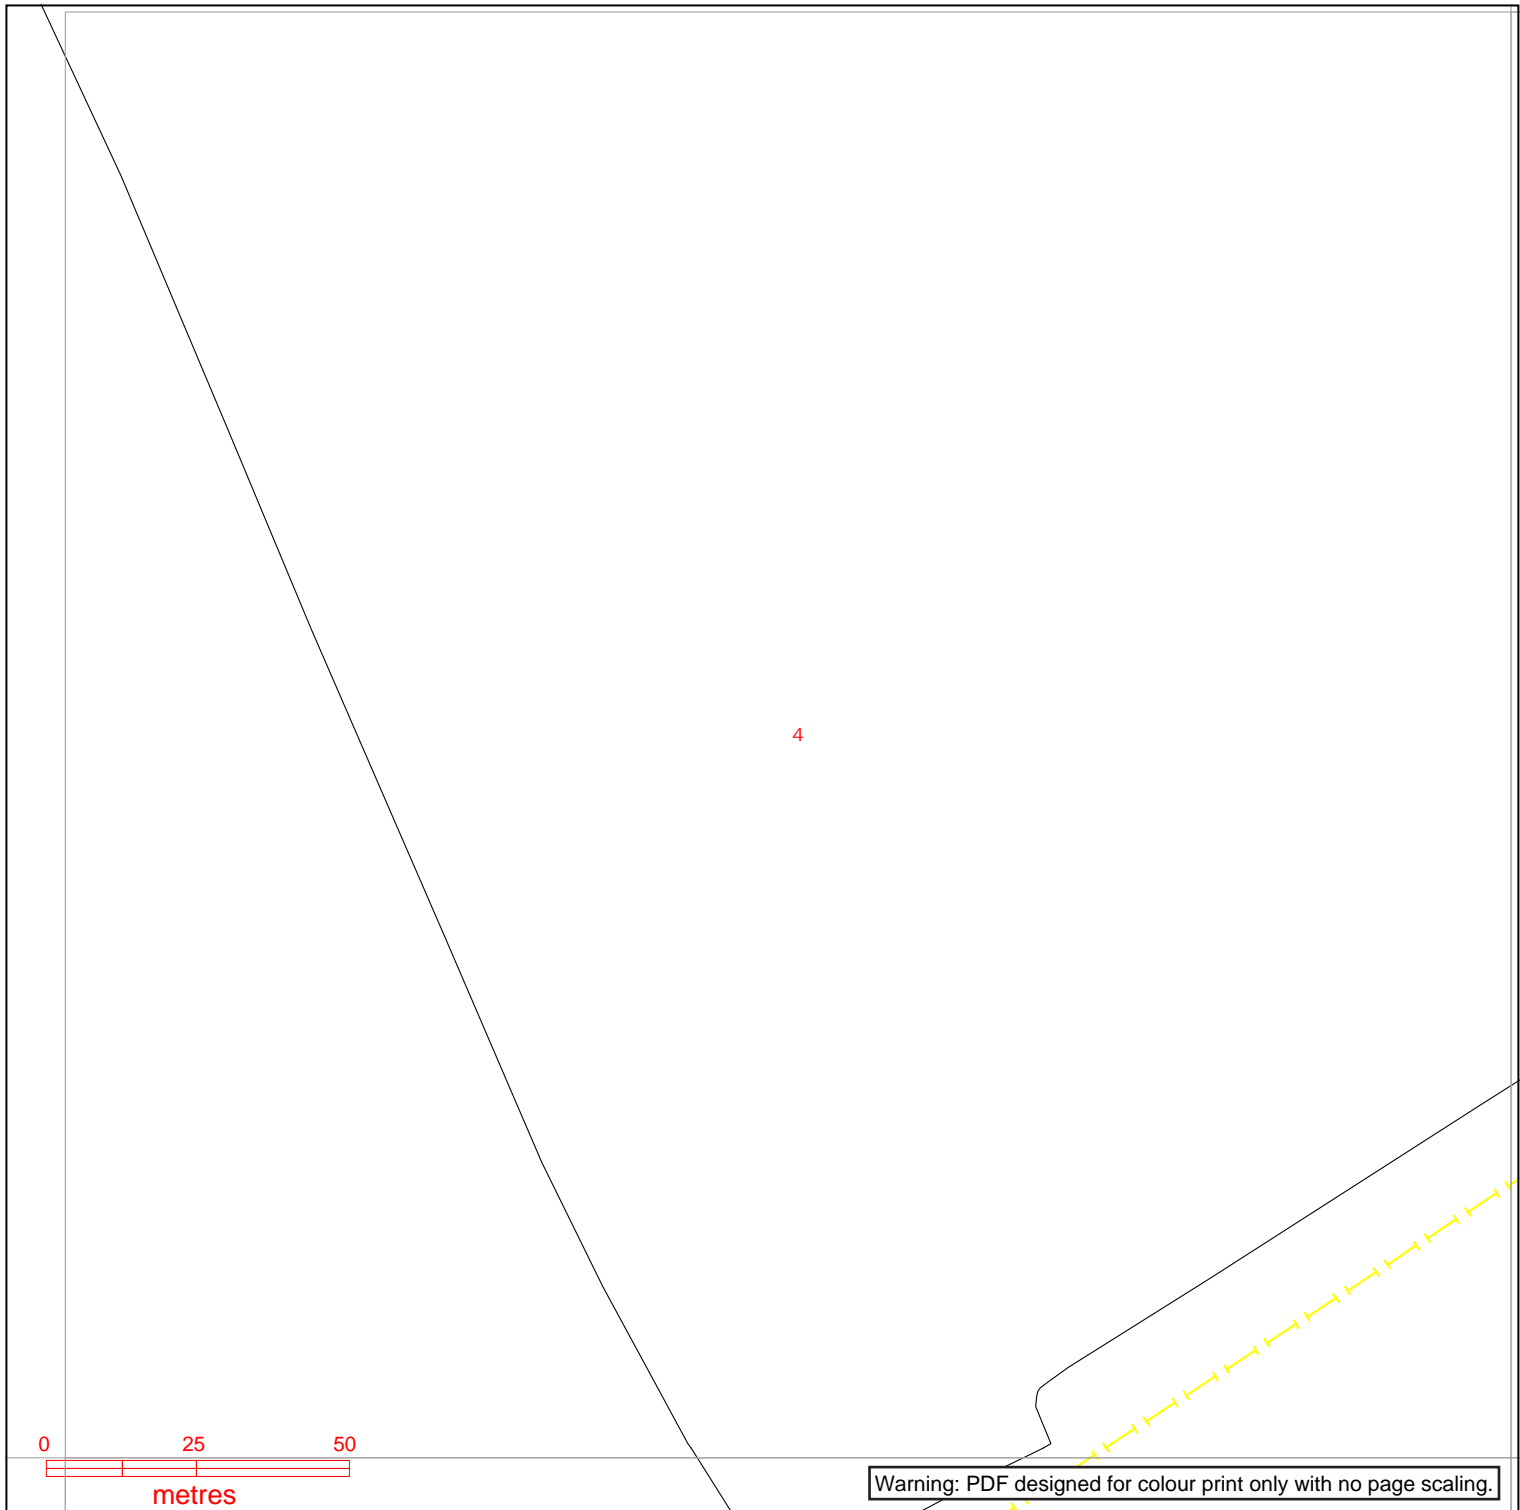

Warning: PDF designed for colour print only with no page scaling.

nationalgrid Electricity Distribution

Contact Us

Mapping Enquiries:
All areas 0121 623 9780

General Enquiries:
All areas 0800 096 3080

Date Requested: 08/05/2023
Job Reference: 29406946
Site Location: 476022 383761
Requested by:
Mr Ben Evans
Your Scheme/Reference:
LM 203570/DK - 9

Exact Scales:
1:1250 Area or Circle dig site
1:500 Line dig site


Link Box ●	Overhead Line ○—○ PL ○—○ Service ○—○ LV ○—○ HV (11kV) ○—○ HV (33kV) ○—○ HV (66kV) ○—○ HV (132kV)	Underground Cable -	National Grid Telecoms - - - - - PME Earth -E- - - - - Underground Earth	Pilot Cables - - - - - ○ Pole Mounted Transformer □ Ground Mounted Transformer
----------------------	--	--	---	--

IMPORTANT NOTICES

- This information is given as a guide only and its accuracy cannot be guaranteed. Services or recent additions to the network may not be shown.
- Cables, overhead lines & substations owned by other electricity network owners or private companies may be present and may not be shown.
- You should always verify exact locations of cables using a cable locator and by careful use of hand tools in accordance with HSE guidance note HSG47.
- When working within 10m of any overhead electric line you should follow the requirements of HSE Guidance Note GS6.
- For further advice on working near our electricity cables or lines, call our General Enquiries number.
- Advice should be sought from the National Grid Electricity Distribution General Enquiries team for any work that is to take place in proximity to 132kV underground cables and 132kV overhead lines.

Report damage immediately – KEEP EVERYONE AWAY FROM THE AREA
0800 6783 105

Crown Copyright © All Rights Reserved. Ordnance Survey Licence numbers: 100022432
NGED Copyright: This copy has been made by or with the authority of National Grid Electricity Distribution (NGED) pursuant to Section 47 of the Copyright Designs and Patents Act 1988 unless that Act provides a relevant exception to copyright the copy must not be copied without the prior permission of the copyright owner.

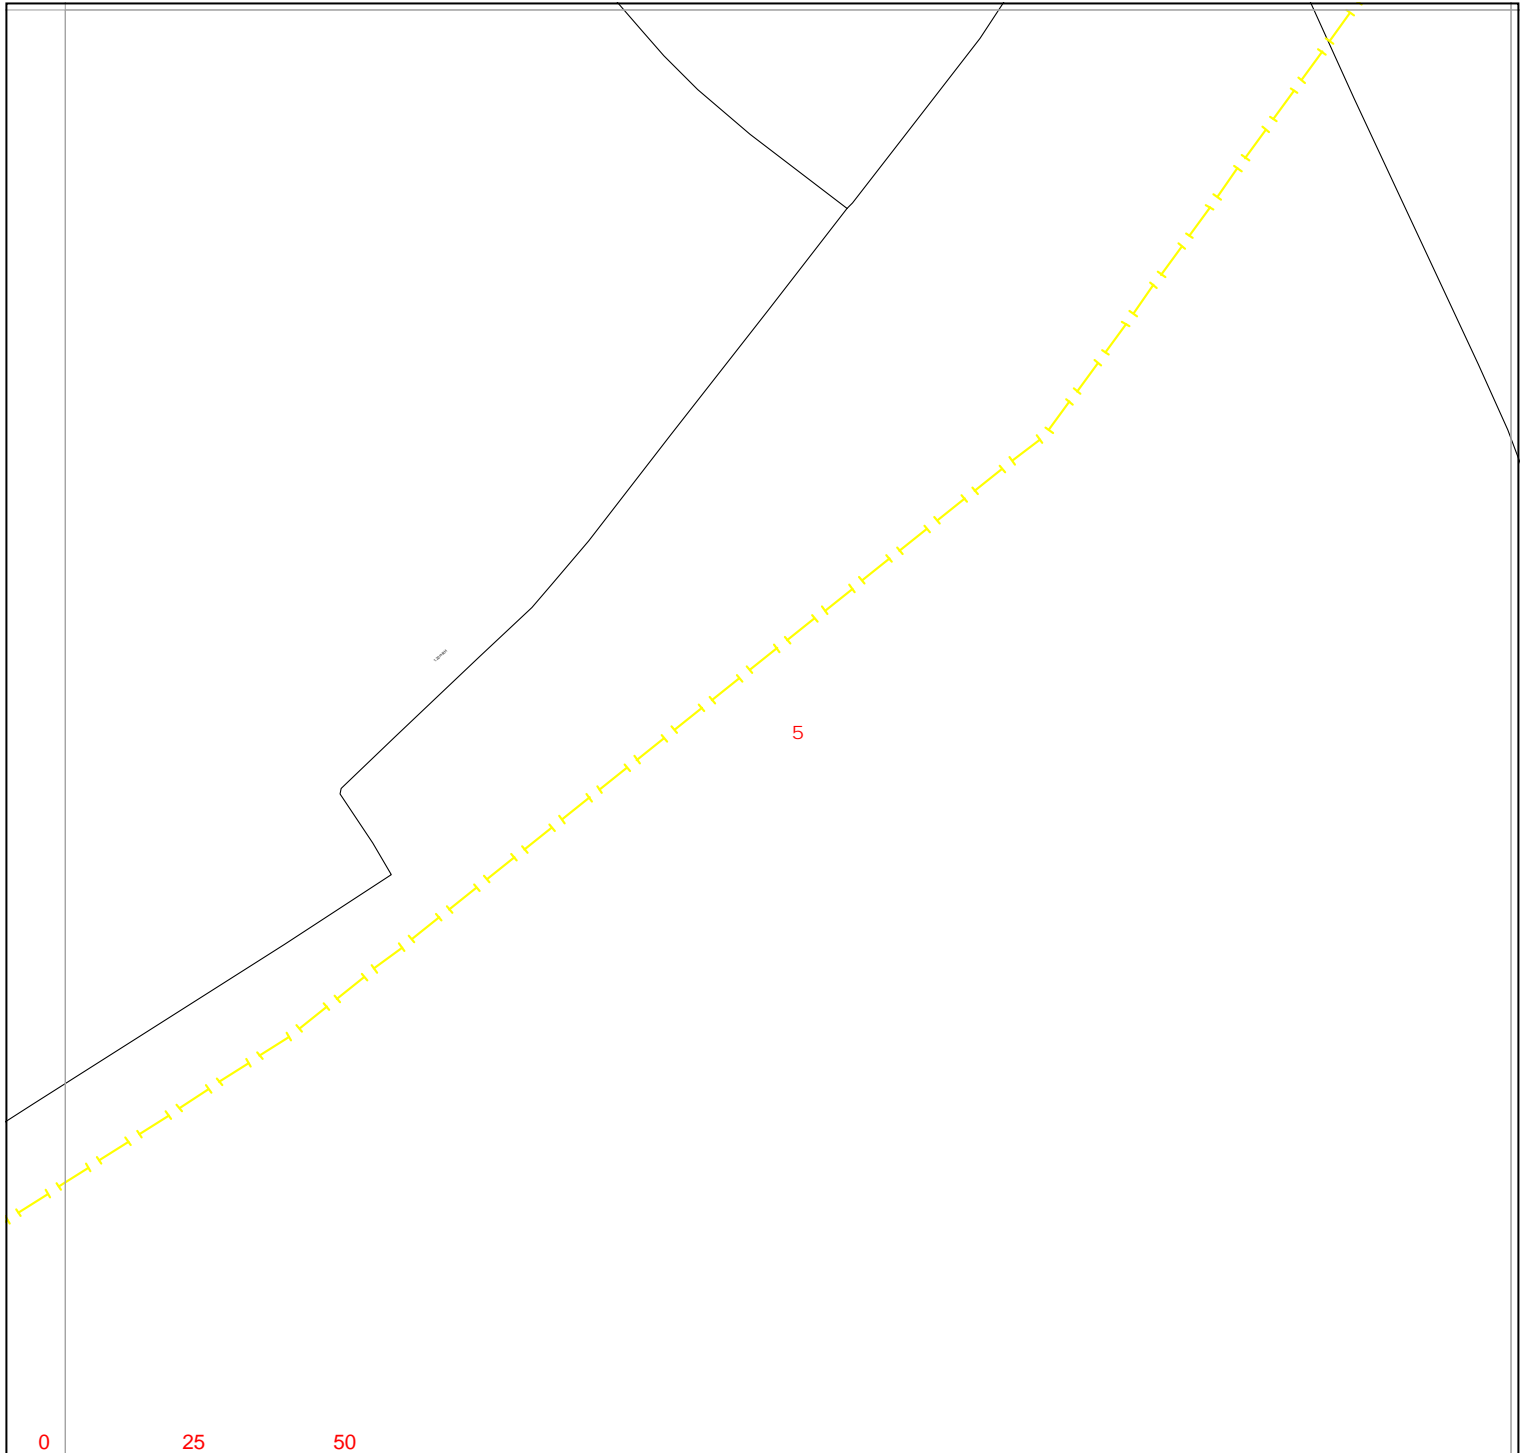

Warning: PDF designed for colour print only with no page scaling.



Contact Us

Mapping Enquiries:
All areas 0121 623 9780

General Enquiries:
All areas 0800 096 3080

Date Requested: 08/05/2023
Job Reference: 29406946
Site Location: 476022 383761
Requested by:
Mr Ben Evans
Your Scheme/Reference:
LM 203570/DK - 9

Exact Scales:
1:1250 Area or Circle dig site
1:500 Line dig site


Link Box ●	Overhead Line ○—○ PL ○—○ Service ○—○ LV ○—○ HV (11kV) ○—○ HV (33kV) ○—○ HV (66kV) ○—○ HV (132kV)	Underground Cable -	National Grid Telecoms - - - - - PME Earth Underground Earth	Pilot Cables ○ □ Pole Mounted Transformer Ground Mounted Transformer
----------------------	--	---	--	---

IMPORTANT NOTICES

- This information is given as a guide only and its accuracy cannot be guaranteed. Services or recent additions to the network may not be shown.
- Cables, overhead lines & substations owned by other electricity network owners or private companies may be present and may not be shown.
- You should always verify exact locations of cables using a cable locator and by careful use of hand tools in accordance with HSE guidance note HSG47.
- When working within 10m of any overhead electric line you should follow the requirements of HSE Guidance Note GS6.
- For further advice on working near our electricity cables or lines, call our General Enquiries number.
- Advice should be sought from the National Grid Electricity Distribution General Enquiries team for any work that is to take place in proximity to 132kV underground cables and 132kV overhead lines.

Report damage immediately – KEEP EVERYONE AWAY FROM THE AREA
0800 6783 105

Crown Copyright © All Rights Reserved. Ordnance Survey Licence numbers: 100022432
NGED Copyright: This copy has been made by or with the authority of National Grid Electricity Distribution (NGED) pursuant to Section 47 of the Copyright Designs and Patents Act 1988 unless that Act provides a relevant exception to copyright the copy must not be copied without the prior permission of the copyright owner.

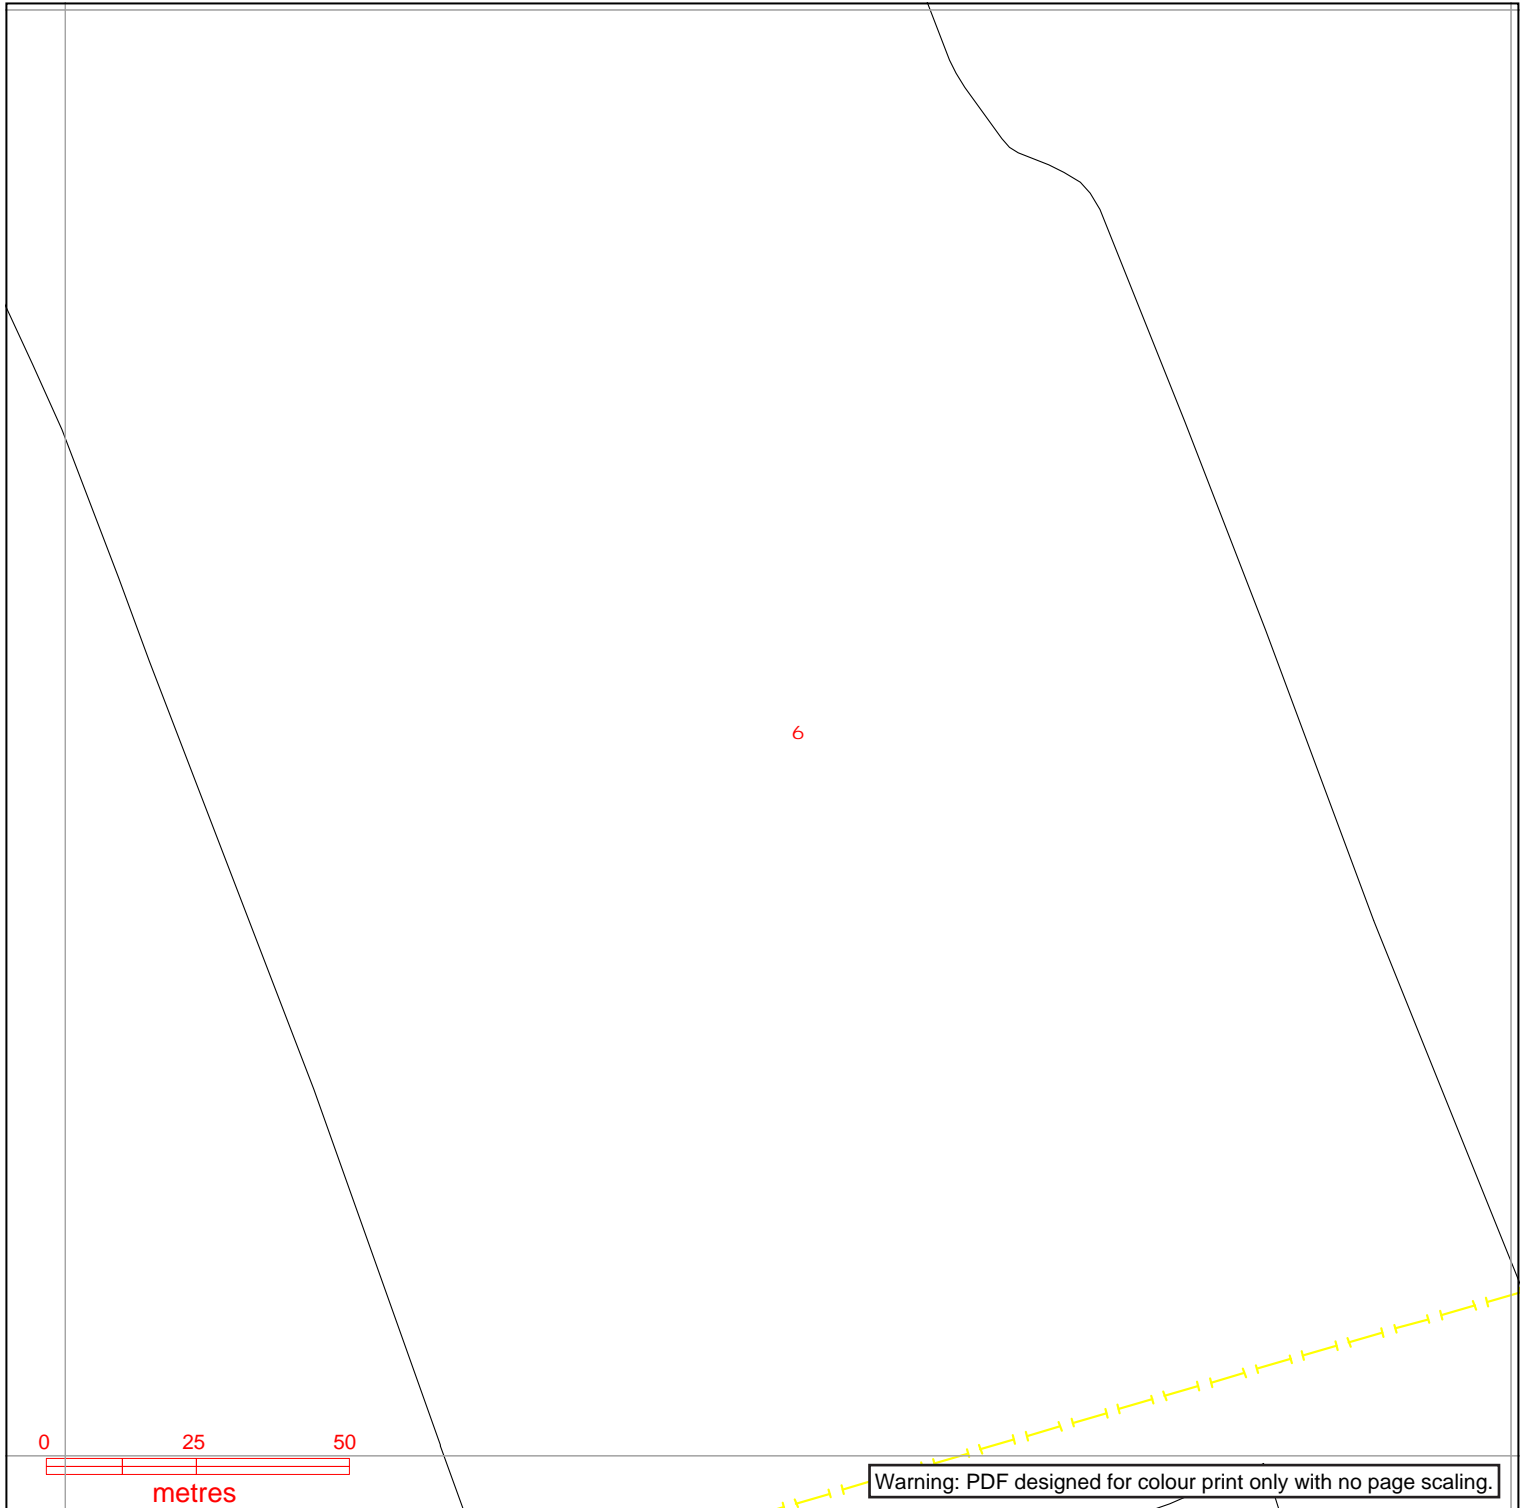

Warning: PDF designed for colour print only with no page scaling.

nationalgrid Electricity Distribution

Contact Us

Mapping Enquiries:
All areas 0121 623 9780

General Enquiries:
All areas 0800 096 3080

Date Requested: 08/05/2023
Job Reference: 29406946
Site Location: 476022 383761
Requested by:
Mr Ben Evans
Your Scheme/Reference:
LM 203570/DK - 9

Exact Scales:
1:1250 Area or Circle dig site
1:500 Line dig site


<p>Link Box</p> <p>●</p> <p>Site Location</p> <p>Line/Area</p> <p>— — — — — </p>	<p>Overhead Line</p> <p>○—○ PL ○—○ Service ○—○ LV ○—○ HV (11kV) ○—○ HV (33kV) ○—○ HV (66kV) ○—○ HV (132kV)</p>	<p>Underground Cable</p> <p>--- --- --- --- --- </p> <p>--- --- --- --- --- </p> <p>--- --- --- --- --- </p> <p>--- --- --- --- --- </p>	<p>National Grid Telecoms</p> <p>--- --- --- --- --- </p> <p>—E PME Earth</p> <p>—E Underground Earth</p>	<p>Pilot Cables</p> <p>○</p> <p>□</p> <p>Pole Mounted Transformer</p> <p>Ground Mounted Transformer</p>
--	---	---	--	--

IMPORTANT NOTICES

- This information is given as a guide only and its accuracy cannot be guaranteed. Services or recent additions to the network may not be shown.
- Cables, overhead lines & substations owned by other electricity network owners or private companies may be present and may not be shown.
- You should always verify exact locations of cables using a cable locator and by careful use of hand tools in accordance with HSE guidance note HSG47.
- When working within 10m of any overhead electric line you should follow the requirements of HSE Guidance Note GS6.
- For further advice on working near our electricity cables or lines, call our General Enquiries number.
- Advice should be sought from the National Grid Electricity Distribution General Enquiries team for any work that is to take place in proximity to 132kV underground cables and 132kV overhead lines.

Report damage immediately – KEEP EVERYONE AWAY FROM THE AREA
0800 6783 105

Crown Copyright © All Rights Reserved. Ordnance Survey Licence numbers: 100022432
NGED Copyright: This copy has been made by or with the authority of National Grid Electricity Distribution (NGED) pursuant to Section 47 of the Copyright Designs and Patents Act 1988 unless that Act provides a relevant exception to copyright the copy must not be copied without the prior permission of the copyright owner.

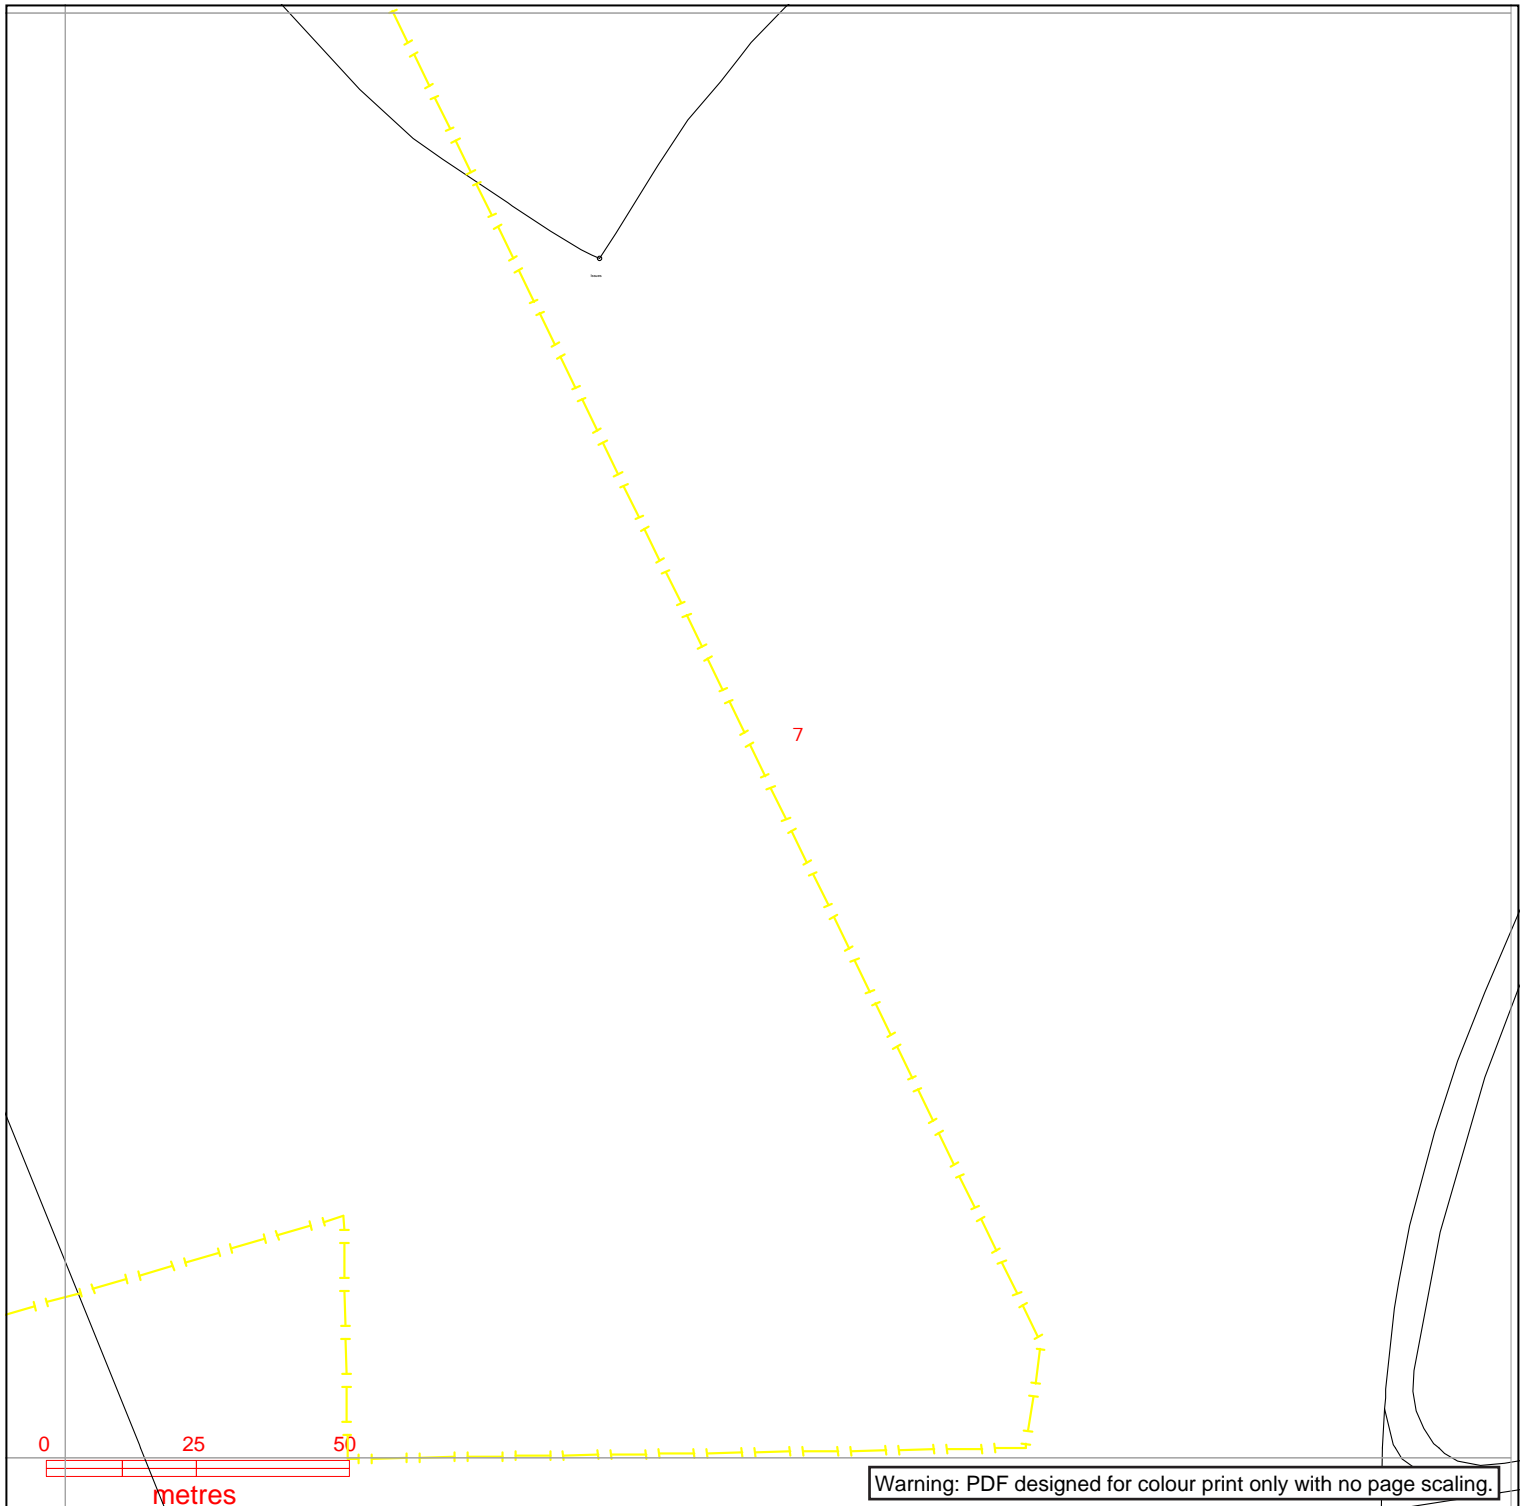

Contact Us

Mapping Enquiries:
All areas 0121 623 9780

General Enquiries:
All areas 0800 096 3080

Date Requested: 08/05/2023
Job Reference: 29406946
Site Location: 476022 383761
Requested by:
Mr Ben Evans
Your Scheme/Reference:
LM 203570/DK - 9

Exact Scales:
1:1250 Area or Circle dig site
1:500 Line dig site


Link Box ●	Overhead Line ○—○ PL ○—○ Service ○—○ LV ○—○ HV (11kV) ○—○ HV (33kV) ○—○ HV (66kV) ○—○ HV (132kV)	Underground Cable -	National Grid Telecoms - - - - - PME Earth Underground Earth	Pilot Cables ○ Pole Mounted Transformer □ Ground Mounted Transformer
----------------------	--	---	--	---

IMPORTANT NOTICES

- This information is given as a guide only and its accuracy cannot be guaranteed. Services or recent additions to the network may not be shown.
- Cables, overhead lines & substations owned by other electricity network owners or private companies may be present and may not be shown.
- You should always verify exact locations of cables using a cable locator and by careful use of hand tools in accordance with HSE guidance note HSG47.
- When working within 10m of any overhead electric line you should follow the requirements of HSE Guidance Note GS6.
- For further advice on working near our electricity cables or lines, call our General Enquiries number.
- Advice should be sought from the National Grid Electricity Distribution General Enquiries team for any work that is to take place in proximity to 132kV underground cables and 132kV overhead lines.

Report damage immediately – KEEP EVERYONE AWAY FROM THE AREA
0800 6783 105

Crown Copyright © All Rights Reserved. Ordnance Survey Licence numbers: 100022432
NGED Copyright: This copy has been made by or with the authority of National Grid Electricity Distribution (NGED) pursuant to Section 47 of the Copyright Designs and Patents Act 1988 unless that Act provides a relevant exception to copyright the copy must not be copied without the prior permission of the copyright owner.

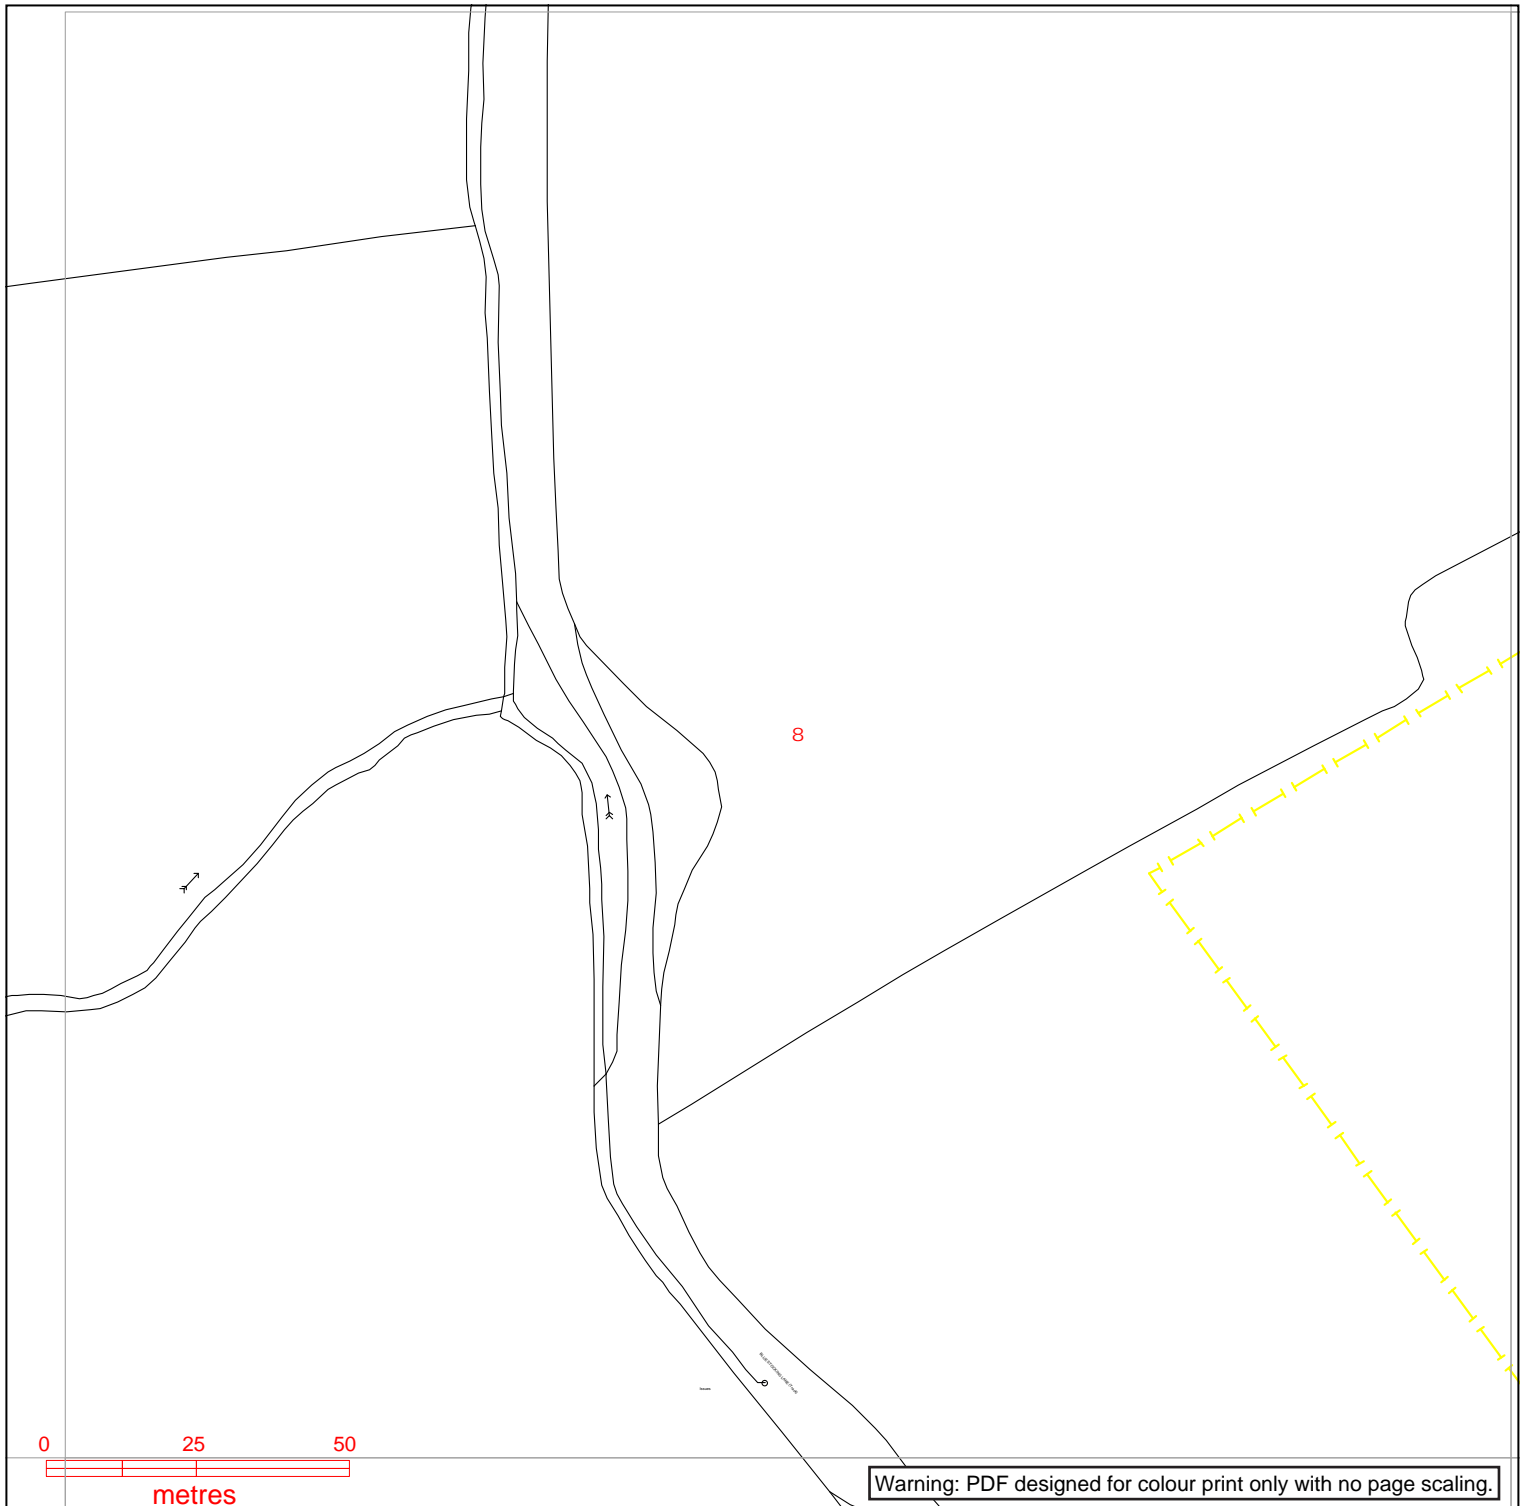

nationalgrid Electricity Distribution

Contact Us

Mapping Enquiries:
All areas 0121 623 9780

General Enquiries:
All areas 0800 096 3080

Date Requested: 08/05/2023
Job Reference: 29406946
Site Location: 476022 383761
Requested by:
Mr Ben Evans
Your Scheme/Reference:
LM 203570/DK - 9

Exact Scales:
1:1250 Area or Circle dig site
1:500 Line dig site


Link Box ●	Overhead Line ○ ○ PL ○ ○ Service ○ ○ LV ○ ○ HV (11kV) ○ ○ HV (33kV) ○ ○ HV (66kV) ○ ○ HV (132kV)	Underground Cable -	National Grid Telecoms - - - - - PME Earth -E- - - - - Underground Earth	Pilot Cables - - - - - ○ Pole Mounted Transformer □ Ground Mounted Transformer
----------------------	--	---	---	--

IMPORTANT NOTICES

- This information is given as a guide only and its accuracy cannot be guaranteed. Services or recent additions to the network may not be shown.
- Cables, overhead lines & substations owned by other electricity network owners or private companies may be present and may not be shown.
- You should always verify exact locations of cables using a cable locator and by careful use of hand tools in accordance with HSE guidance note HSG47.
- When working within 10m of any overhead electric line you should follow the requirements of HSE Guidance Note GS6.
- For further advice on working near our electricity cables or lines, call our General Enquiries number.
- Advice should be sought from the National Grid Electricity Distribution General Enquiries team for any work that is to take place in proximity to 132kV underground cables and 132kV overhead lines.

Report damage immediately – KEEP EVERYONE AWAY FROM THE AREA
0800 6783 105

Crown Copyright © All Rights Reserved. Ordnance Survey Licence numbers: 100022432
NGED Copyright: This copy has been made by or with the authority of National Grid Electricity Distribution (NGED) pursuant to Section 47 of the Copyright Designs and Patents Act 1988 unless that Act provides a relevant exception to copyright the copy must not be copied without the prior permission of the copyright owner.

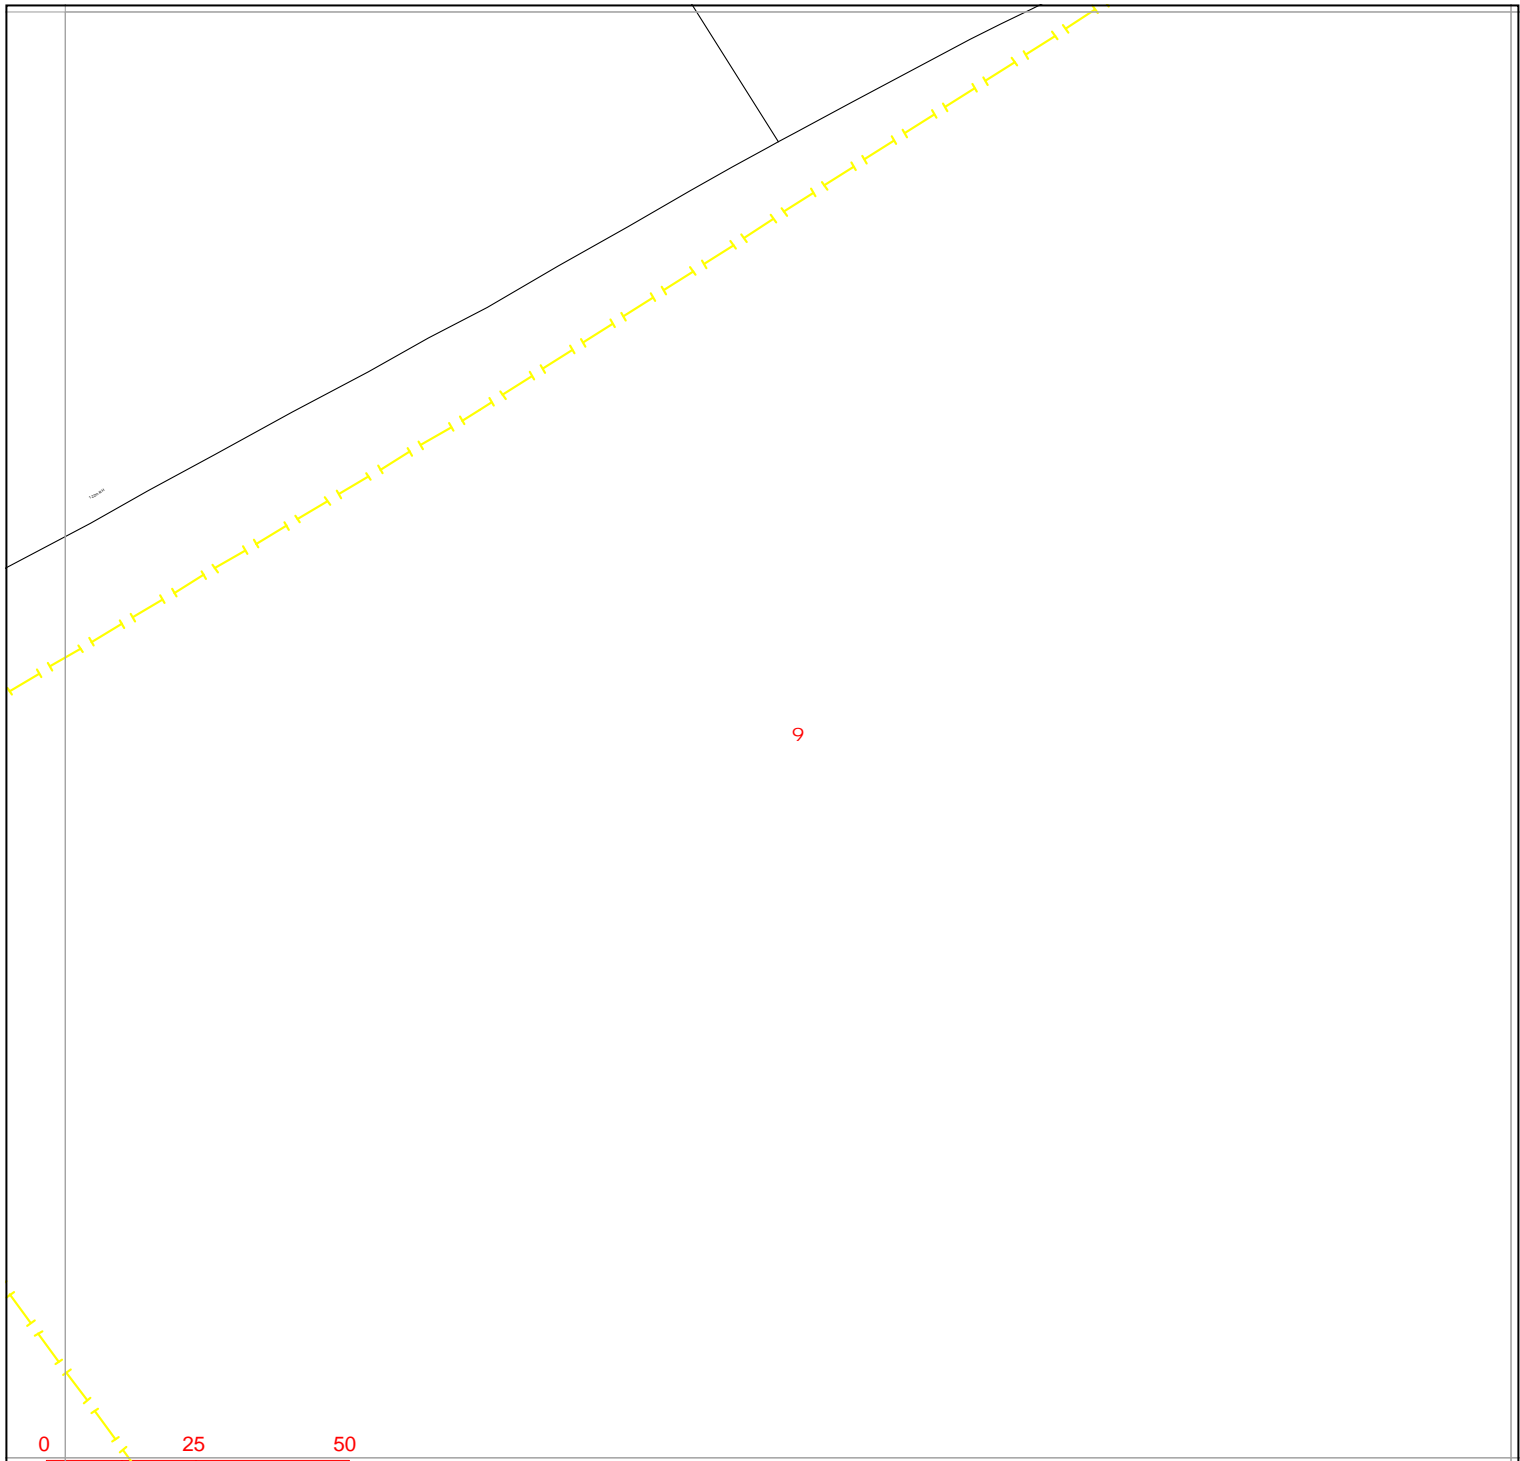

Warning: PDF designed for colour print only with no page scaling.

nationalgrid Electricity Distribution

Contact Us

Mapping Enquiries:
All areas 0121 623 9780

General Enquiries:
All areas 0800 096 3080

Date Requested: 08/05/2023
Job Reference: 29406946
Site Location: 476022 383761
Requested by:
Mr Ben Evans
Your Scheme/Reference:
LM 203570/DK - 9

Exact Scales:
1:1250 Area or Circle dig site
1:500 Line dig site


Link Box ●	Overhead Line ○—○ PL ○—○ Service ○—○ LV ○—○ HV (11kV) ○—○ HV (33kV) ○—○ HV (66kV) ○—○ HV (132kV)	Underground Cable -	National Grid Telecoms - - - - - PME Earth Underground Earth	Pilot Cables ○ □ Pole Mounted Transformer Ground Mounted Transformer
----------------------	--	---	--	---

IMPORTANT NOTICES

- This information is given as a guide only and its accuracy cannot be guaranteed. Services or recent additions to the network may not be shown.
- Cables, overhead lines & substations owned by other electricity network owners or private companies may be present and may not be shown.
- You should always verify exact locations of cables using a cable locator and by careful use of hand tools in accordance with HSE guidance note HSG47.
- When working within 10m of any overhead electric line you should follow the requirements of HSE Guidance Note GS6.
- For further advice on working near our electricity cables or lines, call our General Enquiries number.
- Advice should be sought from the National Grid Electricity Distribution General Enquiries team for any work that is to take place in proximity to 132kV underground cables and 132kV overhead lines.

Report damage immediately – KEEP EVERYONE AWAY FROM THE AREA
0800 6783 105

Crown Copyright © All Rights Reserved. Ordnance Survey Licence numbers: 100022432
NGED Copyright: This copy has been made by or with the authority of National Grid Electricity Distribution (NGED) pursuant to Section 47 of the Copyright Designs and Patents Act 1988 unless that Act provides a relevant exception to copyright the copy must not be copied without the prior permission of the copyright owner.

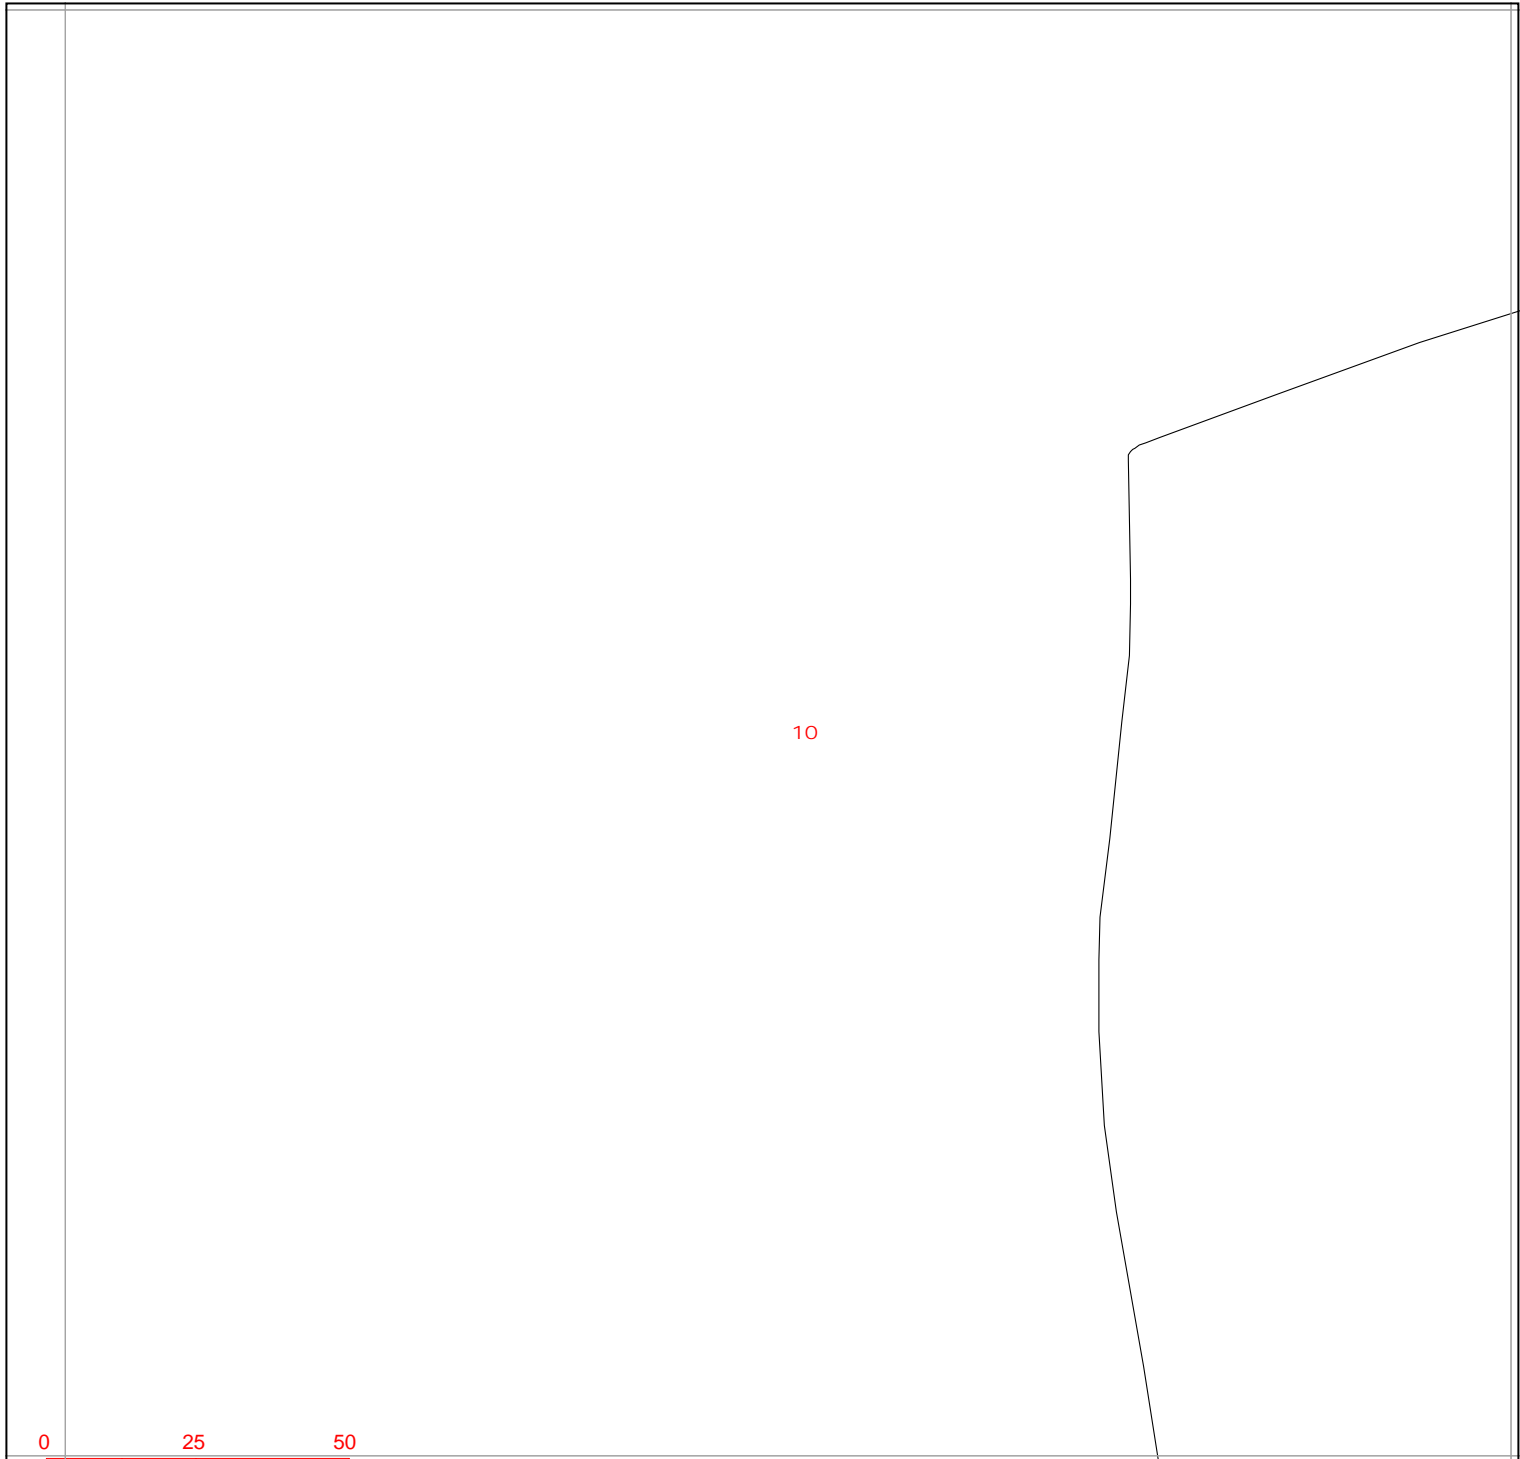

Warning: PDF designed for colour print only with no page scaling.



Contact Us
Mapping Enquiries:
 All areas 0121 623 9780
General Enquiries:
 All areas 0800 096 3080

Date Requested: 08/05/2023
 Job Reference: 29406946
 Site Location: 476022 383761
 Requested by:
 Mr Ben Evans
 Your Scheme/Reference:
 LM 203570/DK - 9

Exact Scales:
 1:1250 Area or Circle dig site
 1:500 Line dig site


<p>Link Box ●</p> <p>Site Location Line/Area — — — </p>	<p>Overhead Line</p> <ul style="list-style-type: none"> ○—○ PL ○—○ Service ○—○ LV ○—○ HV (11kV) ○—○ HV (33kV) ○—○ HV (66kV) ○—○ HV (132kV) 	<p>Underground Cable</p> <ul style="list-style-type: none"> — — — — — — — — — — — — — — — — — — — — — — — — — 	<p>National Grid Telecoms</p> <ul style="list-style-type: none"> — — — — — — — — — — 	<p>Pilot Cables</p> <ul style="list-style-type: none"> ○ Pole Mounted Transformer □ Ground Mounted Transformer
---	--	---	---	---

IMPORTANT NOTICES

- This information is given as a guide only and its accuracy cannot be guaranteed. Services or recent additions to the network may not be shown.
- Cables, overhead lines & substations owned by other electricity network owners or private companies may be present and may not be shown.
- You should always verify exact locations of cables using a cable locator and by careful use of hand tools in accordance with HSE guidance note HSG47.
- When working within 10m of any overhead electric line you should follow the requirements of HSE Guidance Note GS6.
- For further advice on working near our electricity cables or lines, call our General Enquiries number.
- Advice should be sought from the National Grid Electricity Distribution General Enquiries team for any work that is to take place in proximity to 132kV underground cables and 132kV overhead lines.

Report damage immediately – KEEP EVERYONE AWAY FROM THE AREA
0800 6783 105

Crown Copyright © All Rights Reserved. Ordnance Survey Licence numbers: 100022432
 NGED Copyright: This copy has been made by or with the authority of National Grid Electricity Distribution (NGED) pursuant to Section 47 of the Copyright Designs and Patents Act 1988 unless that Act provides a relevant exception to copyright the copy must not be copied without the prior permission of the copyright owner.

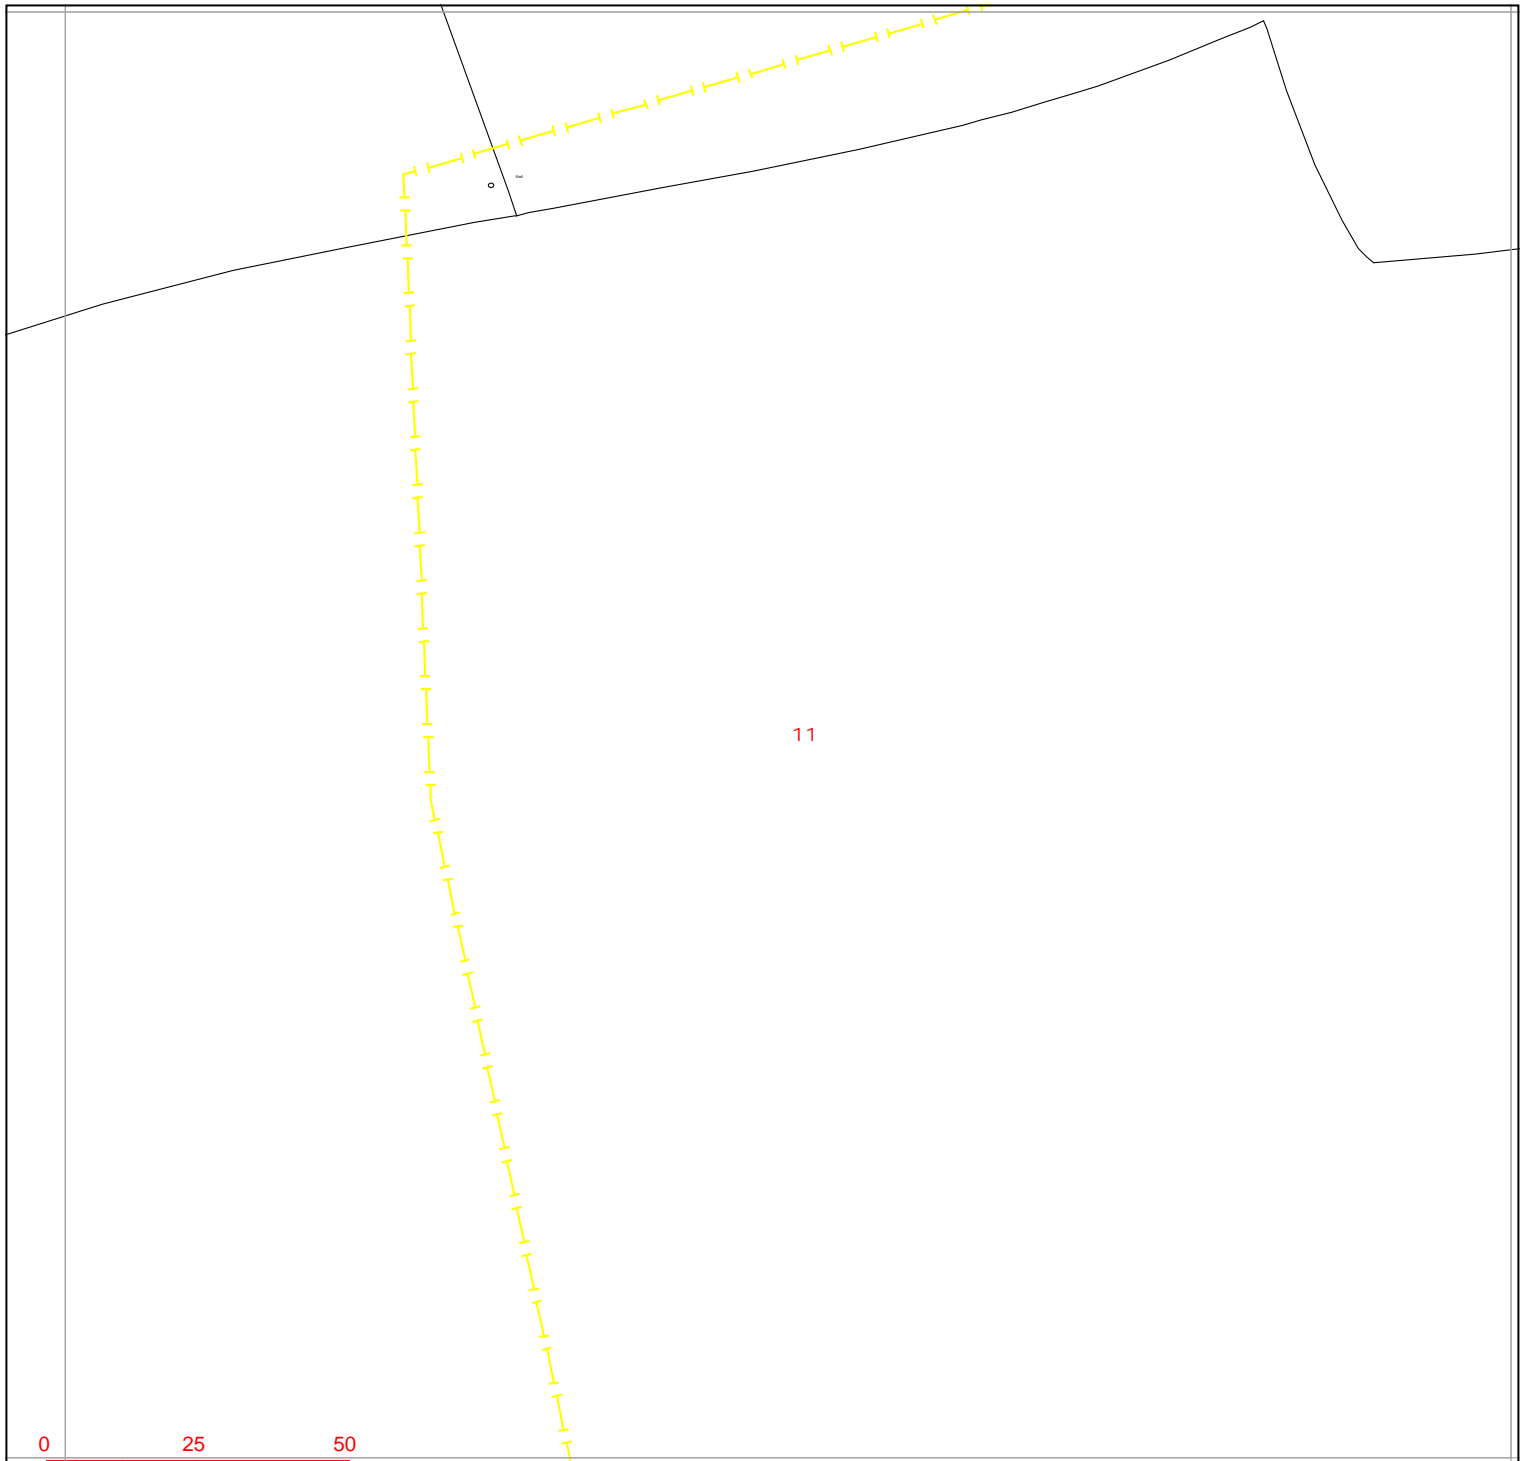

Warning: PDF designed for colour print only with no page scaling.

nationalgrid Electricity Distribution

Contact Us

Mapping Enquiries:
All areas 0121 623 9780

General Enquiries:
All areas 0800 096 3080

Date Requested: 08/05/2023
Job Reference: 29406946
Site Location: 476022 383761
Requested by:
Mr Ben Evans
Your Scheme/Reference:
LM 203570/DK - 9

Exact Scales:
1:1250 Area or Circle dig site
1:500 Line dig site

Link Box ●	Overhead Line ○ ○ PL ○ ○ Service ○ ○ LV ○ ○ HV (11kV) ○ ○ HV (33kV) ○ ○ HV (66kV) □ □ HV (132kV)	Underground Cable -	National Grid Telecoms - - - - - PME Earth Underground Earth	Pilot Cables ○ Pole Mounted Transformer □ Ground Mounted Transformer
----------------------	--	---	--	---


IMPORTANT NOTICES

- This information is given as a guide only and its accuracy cannot be guaranteed. Services or recent additions to the network may not be shown.
- Cables, overhead lines & substations owned by other electricity network owners or private companies may be present and may not be shown.
- You should always verify exact locations of cables using a cable locator and by careful use of hand tools in accordance with HSE guidance note HSG47.
- When working within 10m of any overhead electric line you should follow the requirements of HSE Guidance Note GS6.
- For further advice on working near our electricity cables or lines, call our General Enquiries number.
- Advice should be sought from the National Grid Electricity Distribution General Enquiries team for any work that is to take place in proximity to 132kV underground cables and 132kV overhead lines.

Report damage immediately – KEEP EVERYONE AWAY FROM THE AREA
0800 6783 105

Crown Copyright © All Rights Reserved. Ordnance Survey Licence numbers: 100022432
NGED Copyright: This copy has been made by or with the authority of National Grid Electricity Distribution (NGED) pursuant to Section 47 of the Copyright Designs and Patents Act 1988 unless that Act provides a relevant exception to copyright the copy must not be copied without the prior permission of the copyright owner.

12

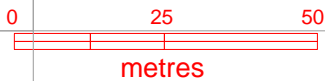

Warning: PDF designed for colour print only with no page scaling.




Contact Us

Mapping Enquiries:
All areas 0121 623 9780

General Enquiries:
All areas 0800 096 3080

Date Requested: 08/05/2023
Job Reference: 29406946
Site Location: 476022 383761
Requested by:
Mr Ben Evans
Your Scheme/Reference:
LM 203570/DK - 9

Exact Scales:
1:1250 Area or Circle dig site
1:500 Line dig site

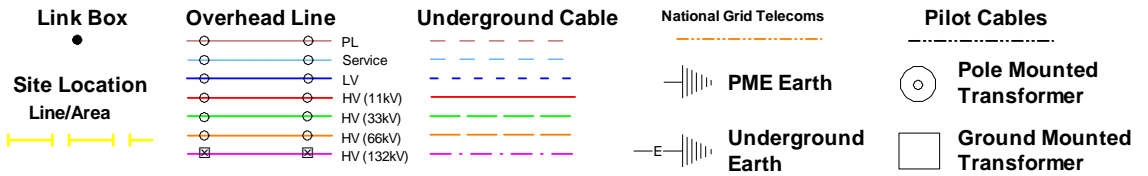


IMPORTANT NOTICES

- This information is given as a guide only and its accuracy cannot be guaranteed. Services or recent additions to the network may not be shown.
- Cables, overhead lines & substations owned by other electricity network owners or private companies may be present and may not be shown.
- You should always verify exact locations of cables using a cable locator and by careful use of hand tools in accordance with HSE guidance note HSG47.
- When working within 10m of any overhead electric line you should follow the requirements of HSE Guidance Note GS6.
- For further advice on working near our electricity cables or lines, call our General Enquiries number.
- Advice should be sought from the National Grid Electricity Distribution General Enquiries team for any work that is to take place in proximity to 132kV underground cables and 132kV overhead lines.

Report damage immediately – KEEP EVERYONE AWAY FROM THE AREA
0800 6783 105

Crown Copyright © All Rights Reserved. Ordnance Survey Licence numbers: 100022432
NGED Copyright: This copy has been made by or with the authority of National Grid Electricity Distribution (NGED) pursuant to Section 47 of the Copyright Designs and Patents Act 1988 unless that Act provides a relevant exception to copyright the copy must not be copied without the prior permission of the copyright owner.

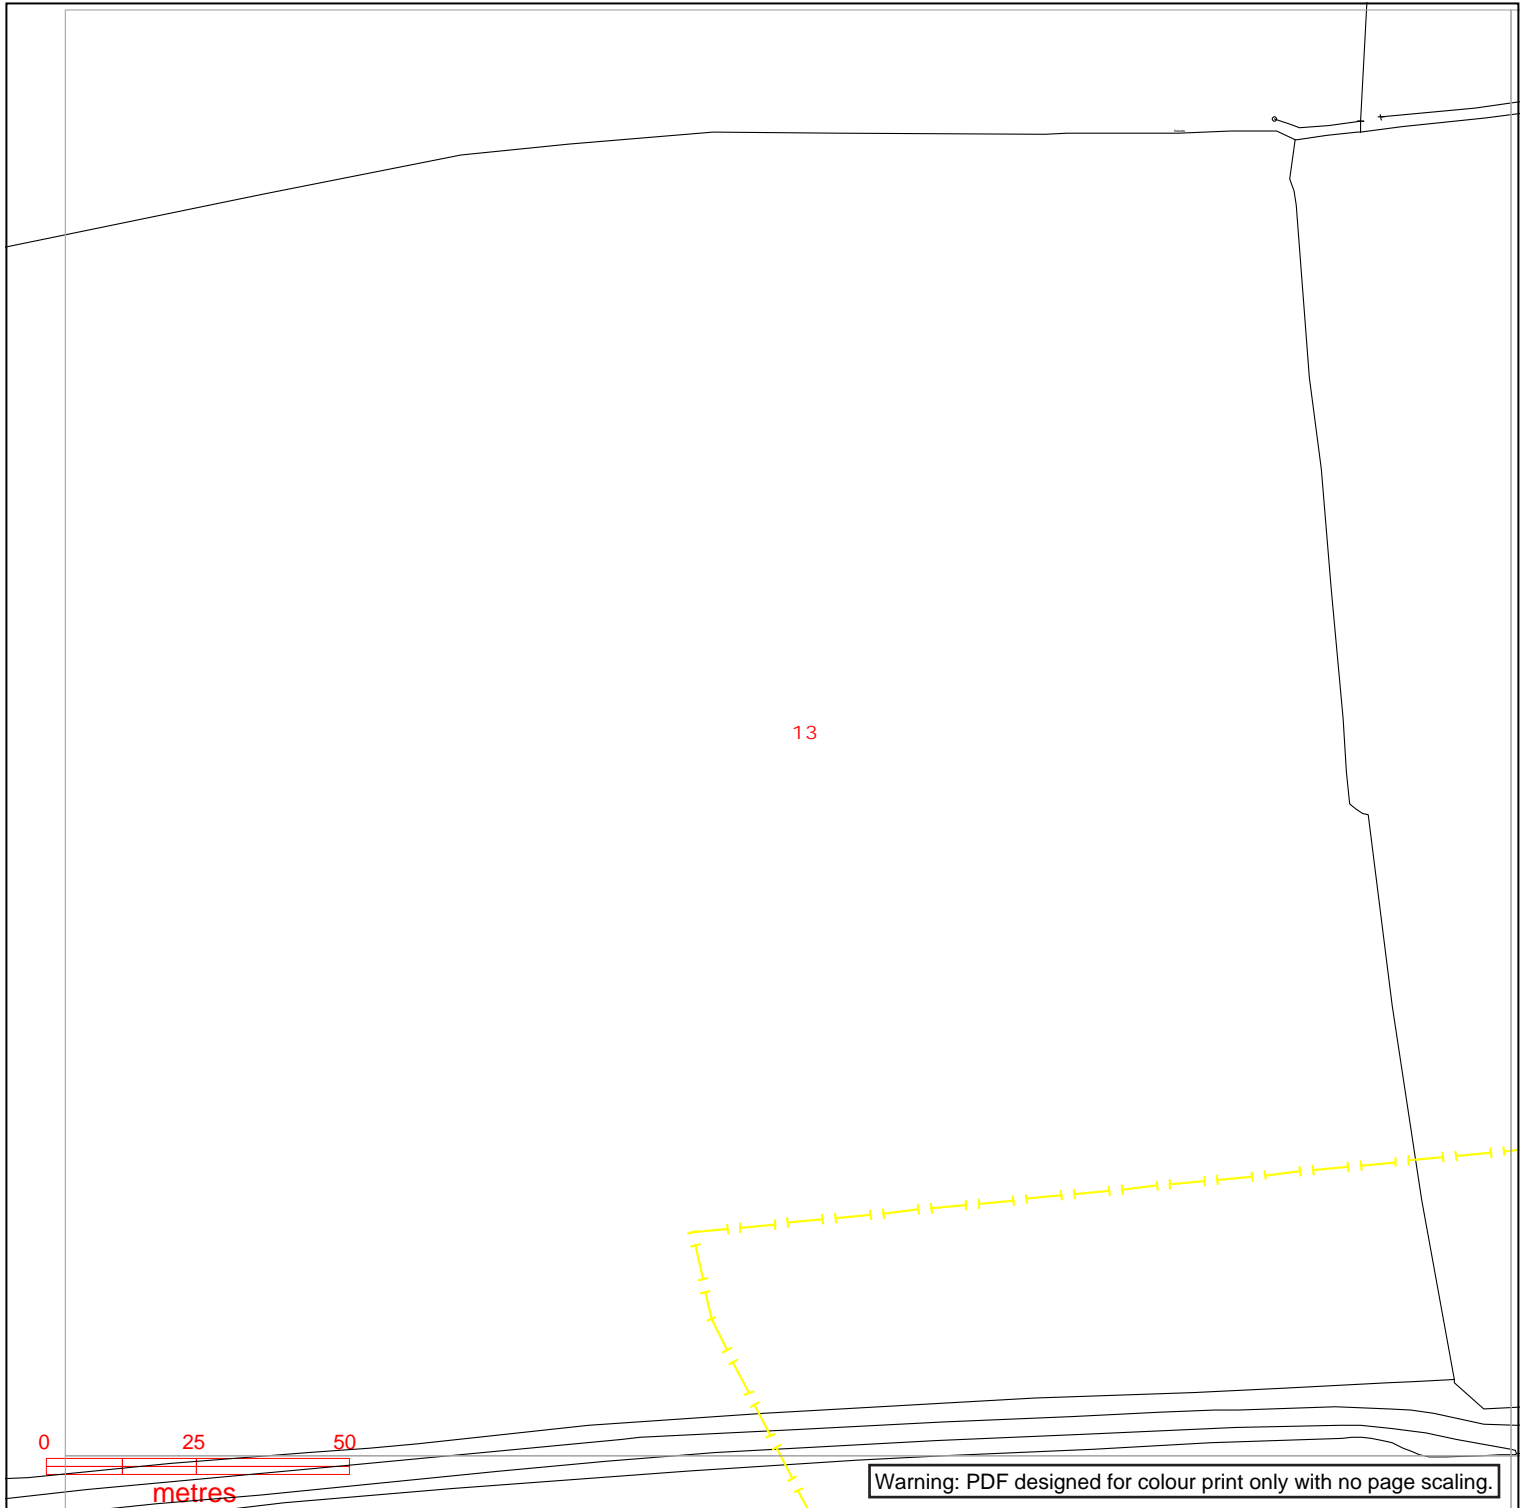

Warning: PDF designed for colour print only with no page scaling.

nationalgrid Electricity Distribution

Contact Us

Mapping Enquiries:
All areas 0121 623 9780

General Enquiries:
All areas 0800 096 3080

Date Requested: 08/05/2023
Job Reference: 29406946
Site Location: 476022 383761
Requested by:
Mr Ben Evans
Your Scheme/Reference:
LM 203570/DK - 9

Exact Scales:
1:1250 Area or Circle dig site
1:500 Line dig site


Link Box	Overhead Line	Underground Cable	National Grid Telecoms	Pilot Cables
●	<ul style="list-style-type: none"> ○ PL ○ Service ○ LV ○ HV (11kV) ○ HV (33kV) ○ HV (66kV) ○ HV (132kV) 	<ul style="list-style-type: none"> --- --- --- --- --- --- --- 	<ul style="list-style-type: none"> --- PME Earth ---E Underground Earth 	<ul style="list-style-type: none"> ○ Pole Mounted Transformer □ Ground Mounted Transformer
Site Location Line/Area	<ul style="list-style-type: none"> --- --- --- --- --- --- --- 	<ul style="list-style-type: none"> --- --- --- --- --- --- --- 		

IMPORTANT NOTICES

- This information is given as a guide only and its accuracy cannot be guaranteed. Services or recent additions to the network may not be shown.
- Cables, overhead lines & substations owned by other electricity network owners or private companies may be present and may not be shown.
- You should always verify exact locations of cables using a cable locator and by careful use of hand tools in accordance with HSE guidance note HSG47.
- When working within 10m of any overhead electric line you should follow the requirements of HSE Guidance Note GS6.
- For further advice on working near our electricity cables or lines, call our General Enquiries number.
- Advice should be sought from the National Grid Electricity Distribution General Enquiries team for any work that is to take place in proximity to 132kV underground cables and 132kV overhead lines.

Report damage immediately – KEEP EVERYONE AWAY FROM THE AREA
0800 6783 105

Crown Copyright © All Rights Reserved. Ordnance Survey Licence numbers: 100022432
NGED Copyright: This copy has been made by or with the authority of National Grid Electricity Distribution (NGED) pursuant to Section 47 of the Copyright Designs and Patents Act 1988 unless that Act provides a relevant exception to copyright the copy must not be copied without the prior permission of the copyright owner.

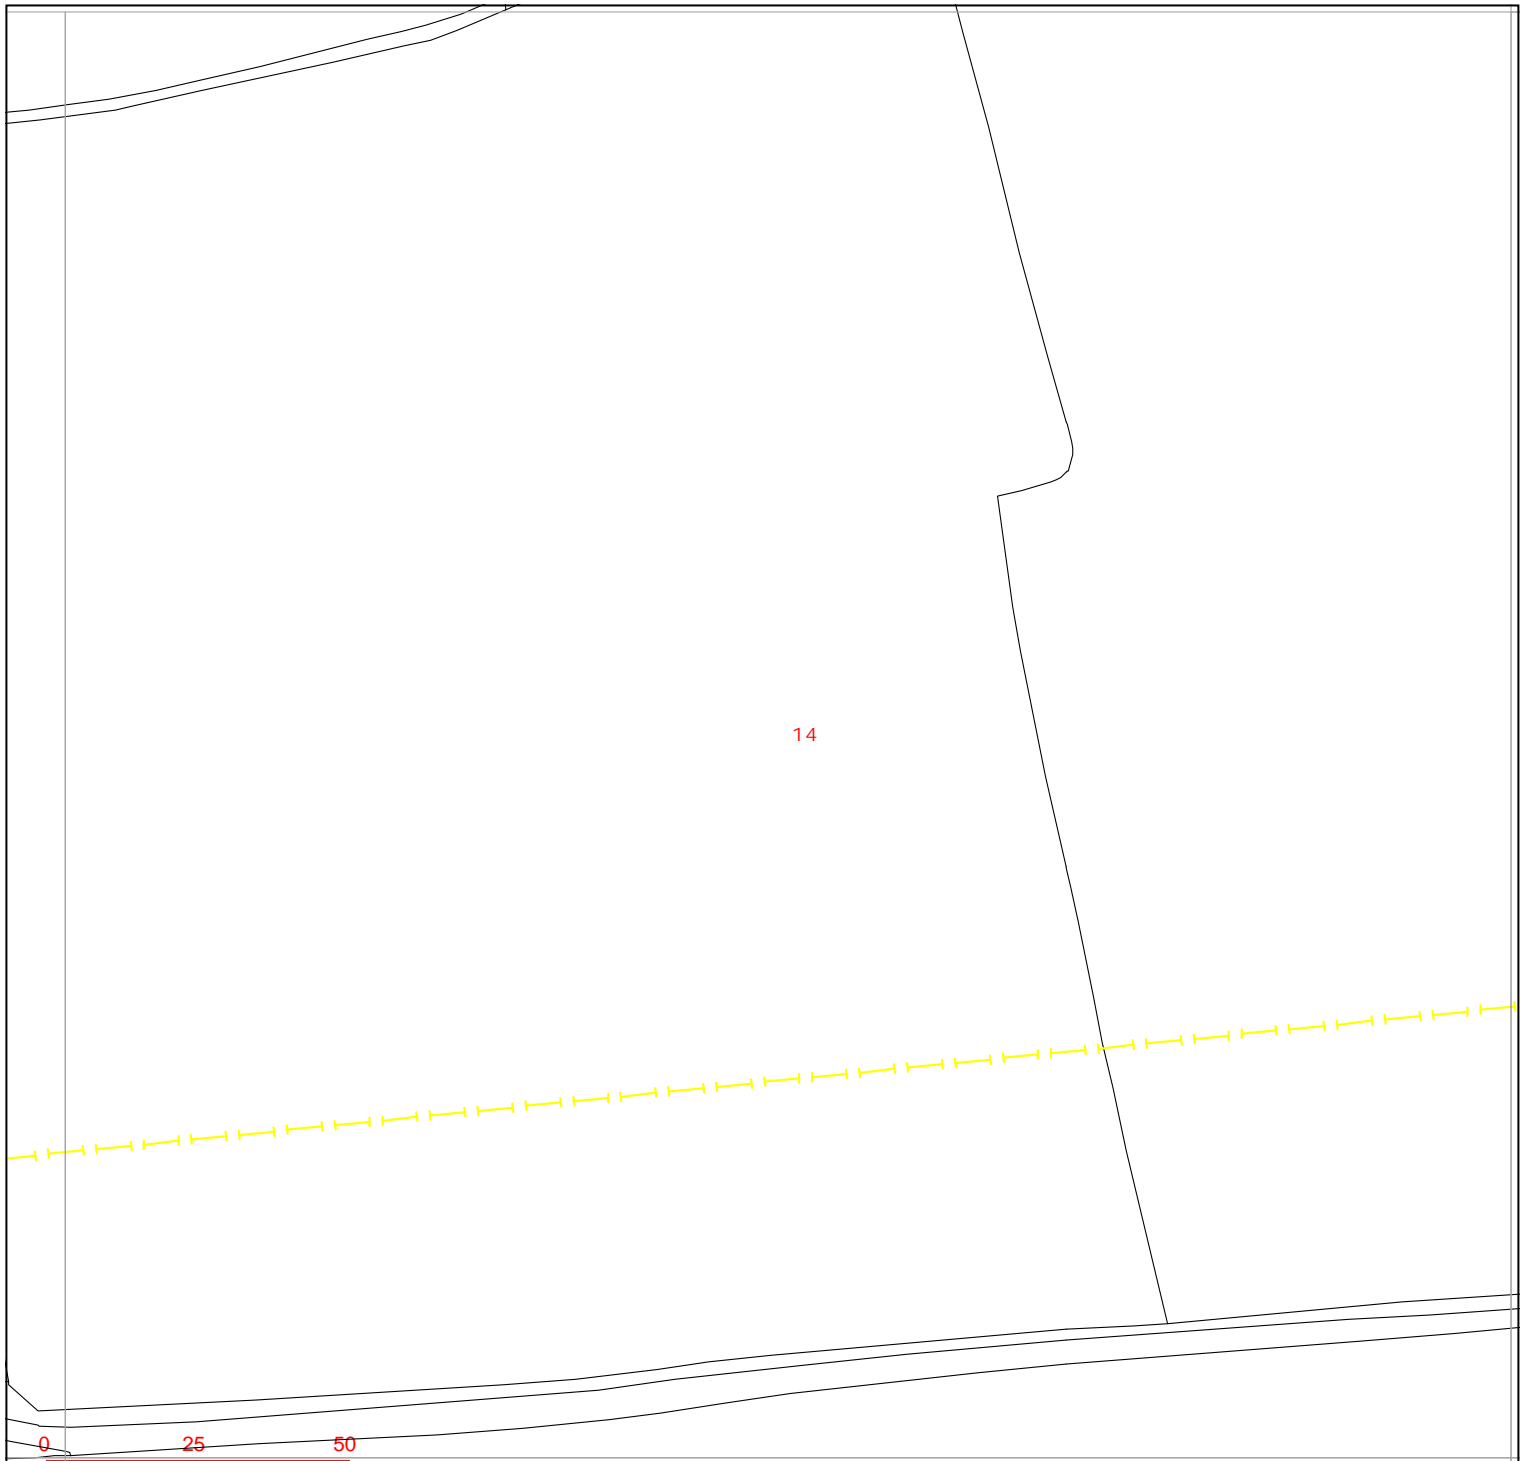

Warning: PDF designed for colour print only with no page scaling.

nationalgrid Electricity Distribution

Contact Us

Mapping Enquiries:
All areas 0121 623 9780

General Enquiries:
All areas 0800 096 3080

Date Requested: 08/05/2023
Job Reference: 29406946
Site Location: 476022 383761
Requested by:
Mr Ben Evans
Your Scheme/Reference:
LM 203570/DK - 9

Exact Scales:
1:1250 Area or Circle dig site
1:500 Line dig site

Link Box ●	Overhead Line ○—○ PL ○—○ Service ○—○ LV ○—○ HV (11kV) ○—○ HV (33kV) ○—○ HV (66kV) □—□ HV (132kV)	Underground Cable -	National Grid Telecoms - - - - - PME Earth -E- - - - - Underground Earth	Pilot Cables - - - - - ○ Pole Mounted Transformer □ Ground Mounted Transformer
----------------------	--	---	---	--

IMPORTANT NOTICES

- This information is given as a guide only and its accuracy cannot be guaranteed. Services or recent additions to the network may not be shown.
- Cables, overhead lines & substations owned by other electricity network owners or private companies may be present and may not be shown.
- You should always verify exact locations of cables using a cable locator and by careful use of hand tools in accordance with HSE guidance note HSG47.
- When working within 10m of any overhead electric line you should follow the requirements of HSE Guidance Note GS6.
- For further advice on working near our electricity cables or lines, call our General Enquiries number.
- Advice should be sought from the National Grid Electricity Distribution General Enquiries team for any work that is to take place in proximity to 132kV underground cables and 132kV overhead lines.

Report damage immediately – KEEP EVERYONE AWAY FROM THE AREA
0800 6783 105

Crown Copyright © All Rights Reserved. Ordnance Survey Licence numbers: 100022432
NGED Copyright: This copy has been made by or with the authority of National Grid Electricity Distribution (NGED) pursuant to Section 47 of the Copyright Designs and Patents Act 1988 unless that Act provides a relevant exception to copyright the copy must not be copied without the prior permission of the copyright owner.



Warning: PDF designed for colour print only with no page scaling.

nationalgrid Electricity Distribution

Contact Us

Mapping Enquiries:
All areas 0121 623 9780

General Enquiries:
All areas 0800 096 3080

Date Requested: 08/05/2023
Job Reference: 29406946
Site Location: 476022 383761
Requested by:
Mr Ben Evans
Your Scheme/Reference:
LM 203570/DK - 9

Exact Scales:
1:1250 Area or Circle dig site
1:500 Line dig site


Link Box ●	Overhead Line ○—○ PL ○—○ Service ○—○ LV ○—○ HV (11kV) ○—○ HV (33kV) ○—○ HV (66kV) ○—○ HV (132kV)	Underground Cable -	National Grid Telecoms - - - - - PME Earth -E- - - - - Underground Earth	Pilot Cables ○ Pole Mounted Transformer □ Ground Mounted Transformer
----------------------	--	---	---	---

IMPORTANT NOTICES

- This information is given as a guide only and its accuracy cannot be guaranteed. Services or recent additions to the network may not be shown.
- Cables, overhead lines & substations owned by other electricity network owners or private companies may be present and may not be shown.
- You should always verify exact locations of cables using a cable locator and by careful use of hand tools in accordance with HSE guidance note HSG47.
- When working within 10m of any overhead electric line you should follow the requirements of HSE Guidance Note GS6.
- For further advice on working near our electricity cables or lines, call our General Enquiries number.
- Advice should be sought from the National Grid Electricity Distribution General Enquiries team for any work that is to take place in proximity to 132kV underground cables and 132kV overhead lines.

Report damage immediately – KEEP EVERYONE AWAY FROM THE AREA
0800 6783 105

Crown Copyright © All Rights Reserved. Ordnance Survey Licence numbers: 100022432
NGED Copyright: This copy has been made by or with the authority of National Grid Electricity Distribution (NGED) pursuant to Section 47 of the Copyright Designs and Patents Act 1988 unless that Act provides a relevant exception to copyright the copy must not be copied without the prior permission of the copyright owner.

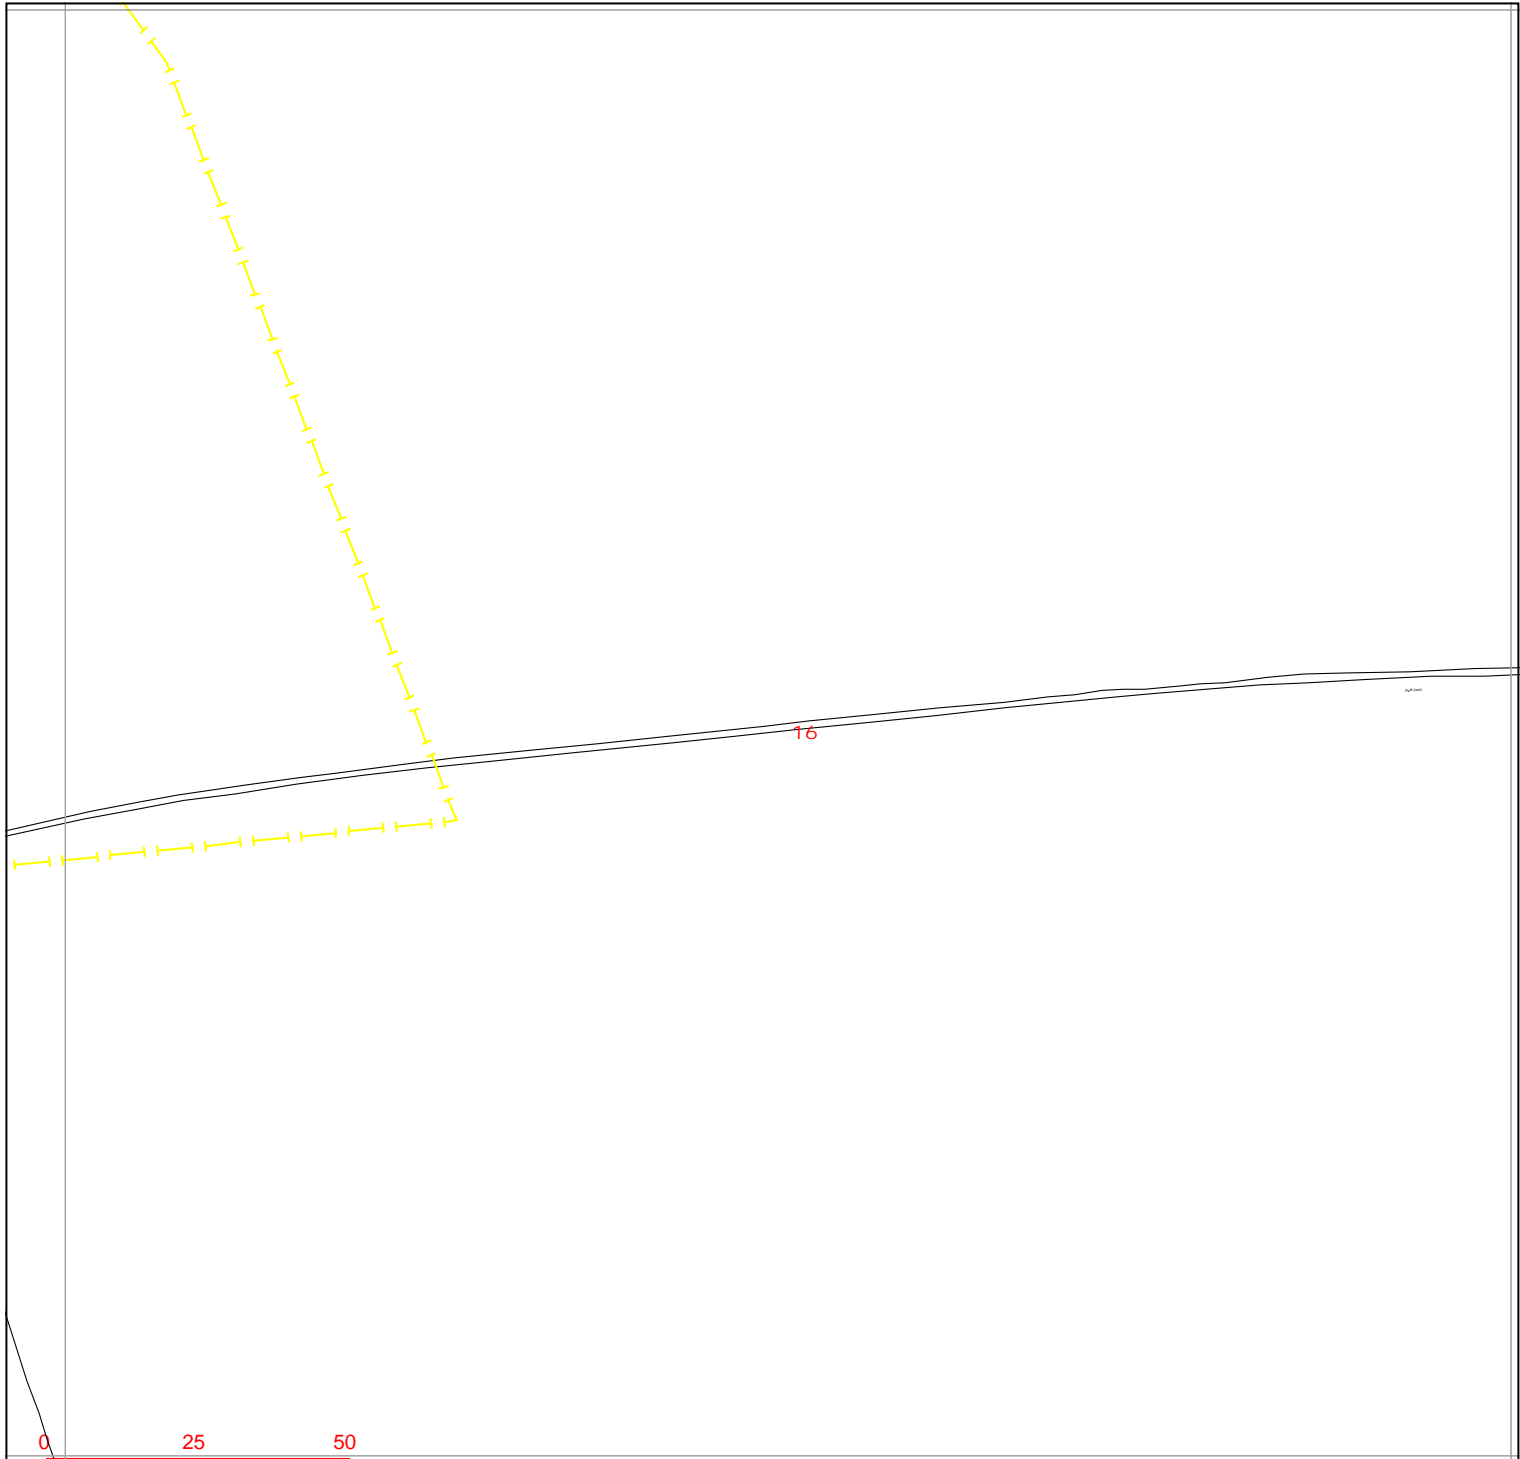

Warning: PDF designed for colour print only with no page scaling.



Contact Us

Mapping Enquiries:
All areas 0121 623 9780

General Enquiries:
All areas 0800 096 3080

Date Requested: 08/05/2023
Job Reference: 29406946
Site Location: 476022 383761
Requested by:
Mr Ben Evans
Your Scheme/Reference:
LM 203570/DK - 9

Link Box	Overhead Line	Underground Cable	National Grid Telecoms	Pilot Cables
●	○ PL ○ Service ○ LV ○ HV (11kV) ○ HV (33kV) ○ HV (66kV) □ HV (132kV)	---	--- PME Earth --- Underground Earth	○ Pole Mounted Transformer □ Ground Mounted Transformer
Site Location Line/Area	--- (various colors)	---		

IMPORTANT NOTICES

- This information is given as a guide only and its accuracy cannot be guaranteed. Services or recent additions to the network may not be shown.
- Cables, overhead lines & substations owned by other electricity network owners or private companies may be present and may not be shown.
- You should always verify exact locations of cables using a cable locator and by careful use of hand tools in accordance with HSE guidance note HSG47.
- When working within 10m of any overhead electric line you should follow the requirements of HSE Guidance Note GS6.
- For further advice on working near our electricity cables or lines, call our General Enquiries number.
- Advice should be sought from the National Grid Electricity Distribution General Enquiries team for any work that is to take place in proximity to 132kV underground cables and 132kV overhead lines.

Report damage immediately – KEEP EVERYONE AWAY FROM THE AREA
0800 6783 105

Exact Scales:
1:1250 Area or Circle dig site
1:500 Line dig site

Crown Copyright © All Rights Reserved. Ordnance Survey Licence numbers: 100022432
NGED Copyright: This copy has been made by or with the authority of National Grid Electricity Distribution (NGED) pursuant to Section 47 of the Copyright Designs and Patents Act 1988 unless that Act provides a relevant exception to copyright the copy must not be copied without the prior permission of the copyright owner.




Contact Us

Mapping Enquiries:
All areas 0121 623 9780

General Enquiries:
All areas 0800 096 3080

Date Requested: 08/05/2023
Job Reference: 29406946
Site Location: 476022 383761
Requested by:
Mr Ben Evans
Your Scheme/Reference:
LM 203570/DK - 9

Exact Scales:
1:1250 Area or Circle dig site
1:500 Line dig site

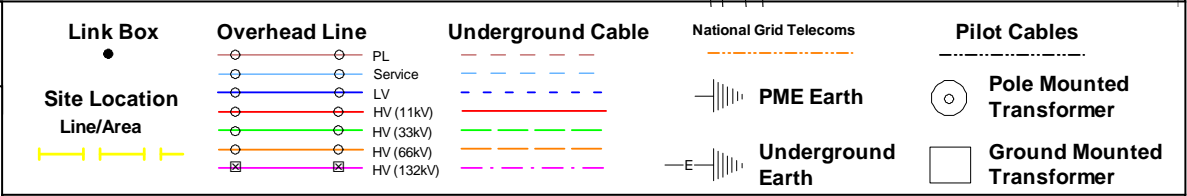


IMPORTANT NOTICES

- This information is given as a guide only and its accuracy cannot be guaranteed. Services or recent additions to the network may not be shown.
- Cables, overhead lines & substations owned by other electricity network owners or private companies may be present and may not be shown.
- You should always verify exact locations of cables using a cable locator and by careful use of hand tools in accordance with HSE guidance note HSG47.
- When working within 10m of any overhead electric line you should follow the requirements of HSE Guidance Note GS6.
- For further advice on working near our electricity cables or lines, call our General Enquiries number.
- Advice should be sought from the National Grid Electricity Distribution General Enquiries team for any work that is to take place in proximity to 132kV underground cables and 132kV overhead lines.

Report damage immediately – KEEP EVERYONE AWAY FROM THE AREA
0800 6783 105

Crown Copyright © All Rights Reserved. Ordnance Survey Licence numbers: 100022432
NGED Copyright: This copy has been made by or with the authority of National Grid Electricity Distribution (NGED) pursuant to Section 47 of the Copyright Designs and Patents Act 1988 unless that Act provides a relevant exception to copyright the copy must not be copied without the prior permission of the copyright owner.

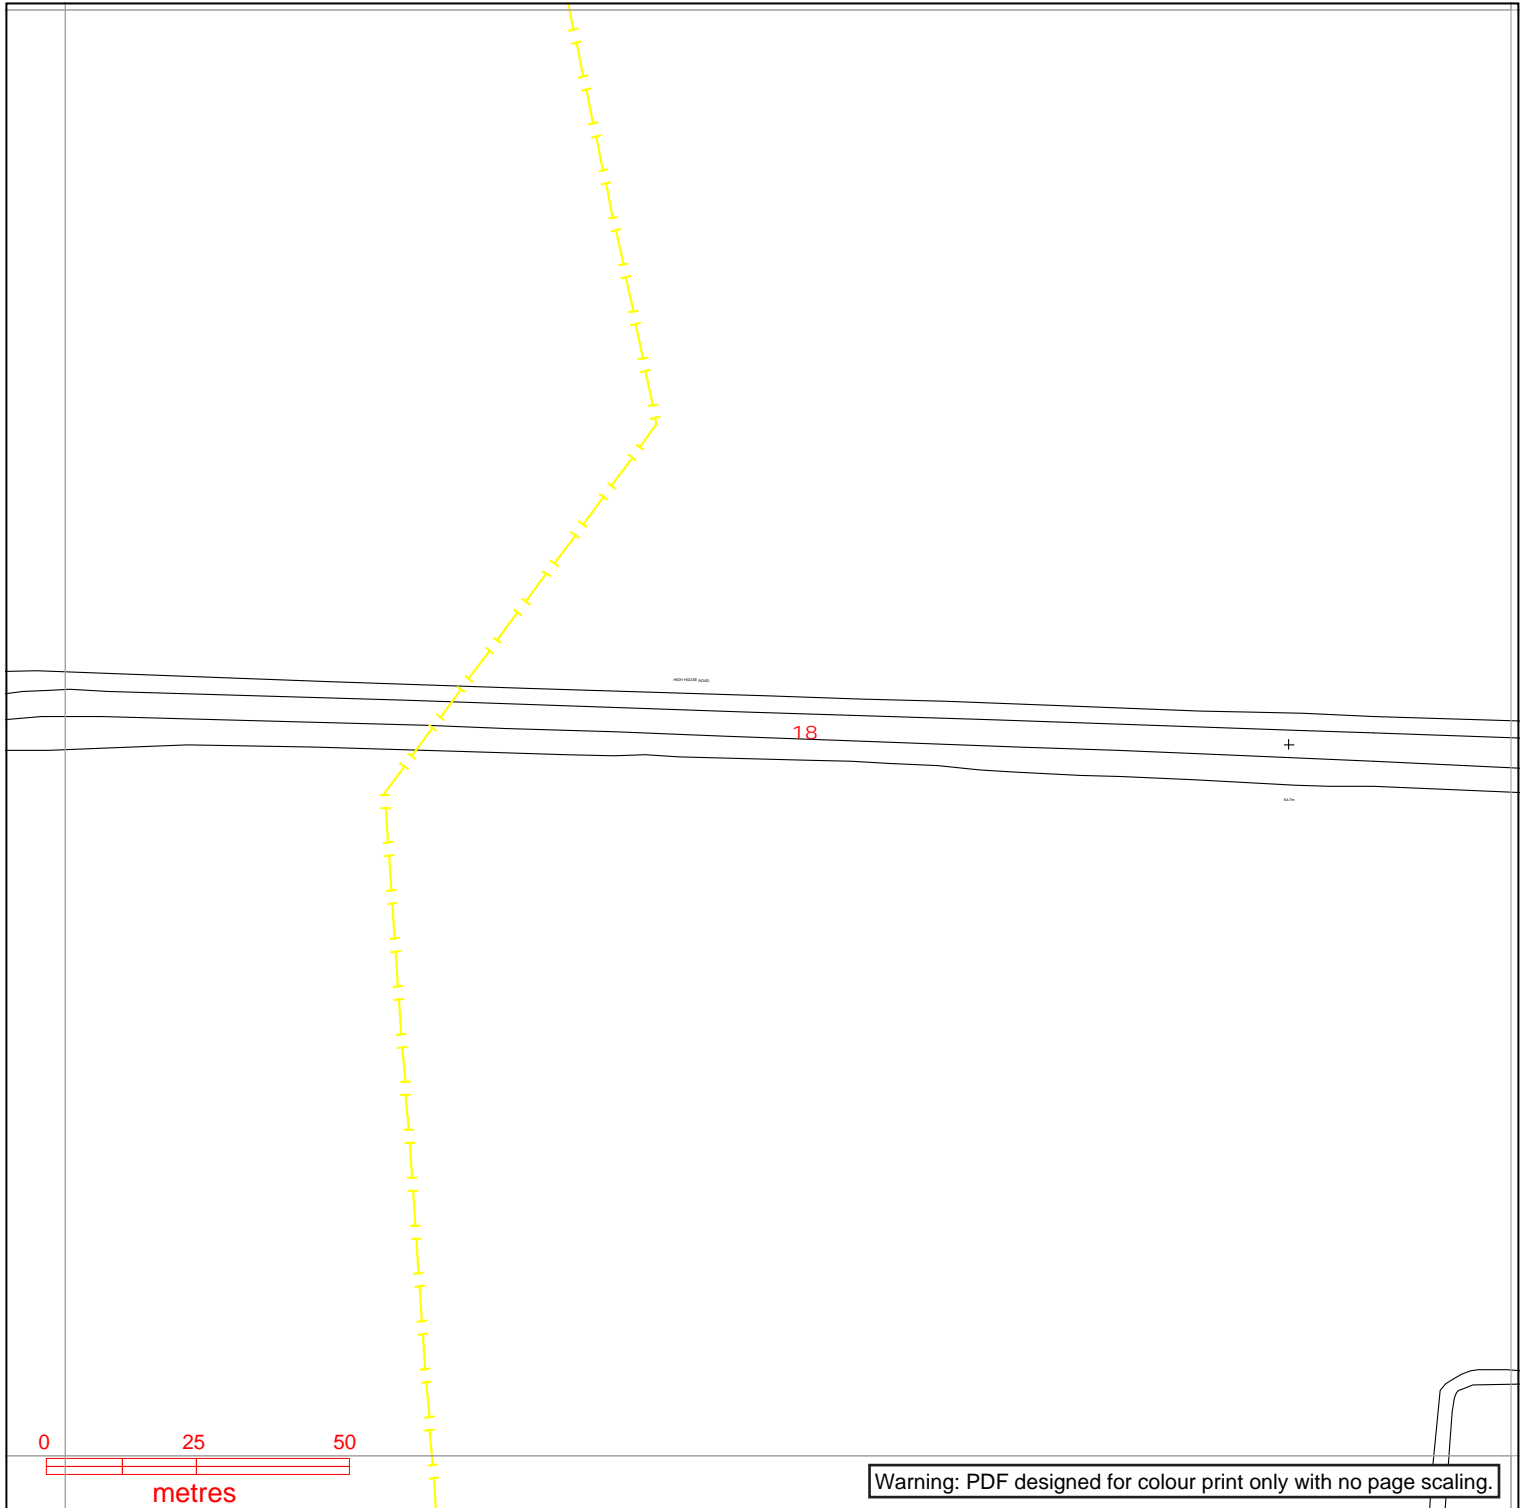

nationalgrid Electricity Distribution


Contact Us

Mapping Enquiries:
All areas 0121 623 9780

General Enquiries:
All areas 0800 096 3080

Date Requested: 08/05/2023
Job Reference: 29406946
Site Location: 476022 383761
Requested by:
Mr Ben Evans
Your Scheme/Reference:
LM 203570/DK - 9

Exact Scales:
1:1250 Area or Circle dig site
1:500 Line dig site

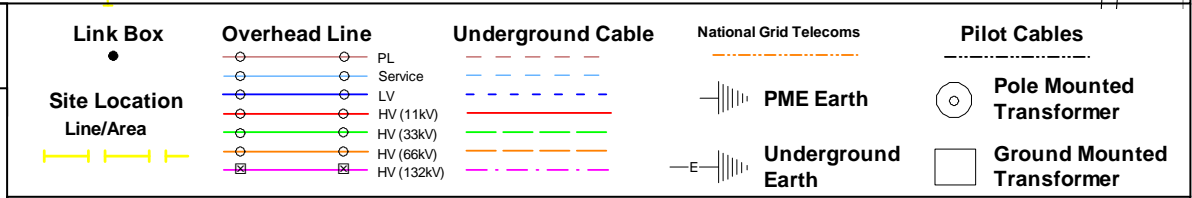


IMPORTANT NOTICES

- This information is given as a guide only and its accuracy cannot be guaranteed. Services or recent additions to the network may not be shown.
- Cables, overhead lines & substations owned by other electricity network owners or private companies may be present and may not be shown.
- You should always verify exact locations of cables using a cable locator and by careful use of hand tools in accordance with HSE guidance note HSG47.
- When working within 10m of any overhead electric line you should follow the requirements of HSE Guidance Note GS6.
- For further advice on working near our electricity cables or lines, call our General Enquiries number.
- Advice should be sought from the National Grid Electricity Distribution General Enquiries team for any work that is to take place in proximity to 132kV underground cables and 132kV overhead lines.

Report damage immediately – KEEP EVERYONE AWAY FROM THE AREA
0800 6783 105

Crown Copyright © All Rights Reserved. Ordnance Survey Licence numbers: 100022432
NGED Copyright: This copy has been made by or with the authority of National Grid Electricity Distribution (NGED) pursuant to Section 47 of the Copyright Designs and Patents Act 1988 unless that Act provides a relevant exception to copyright the copy must not be copied without the prior permission of the copyright owner.

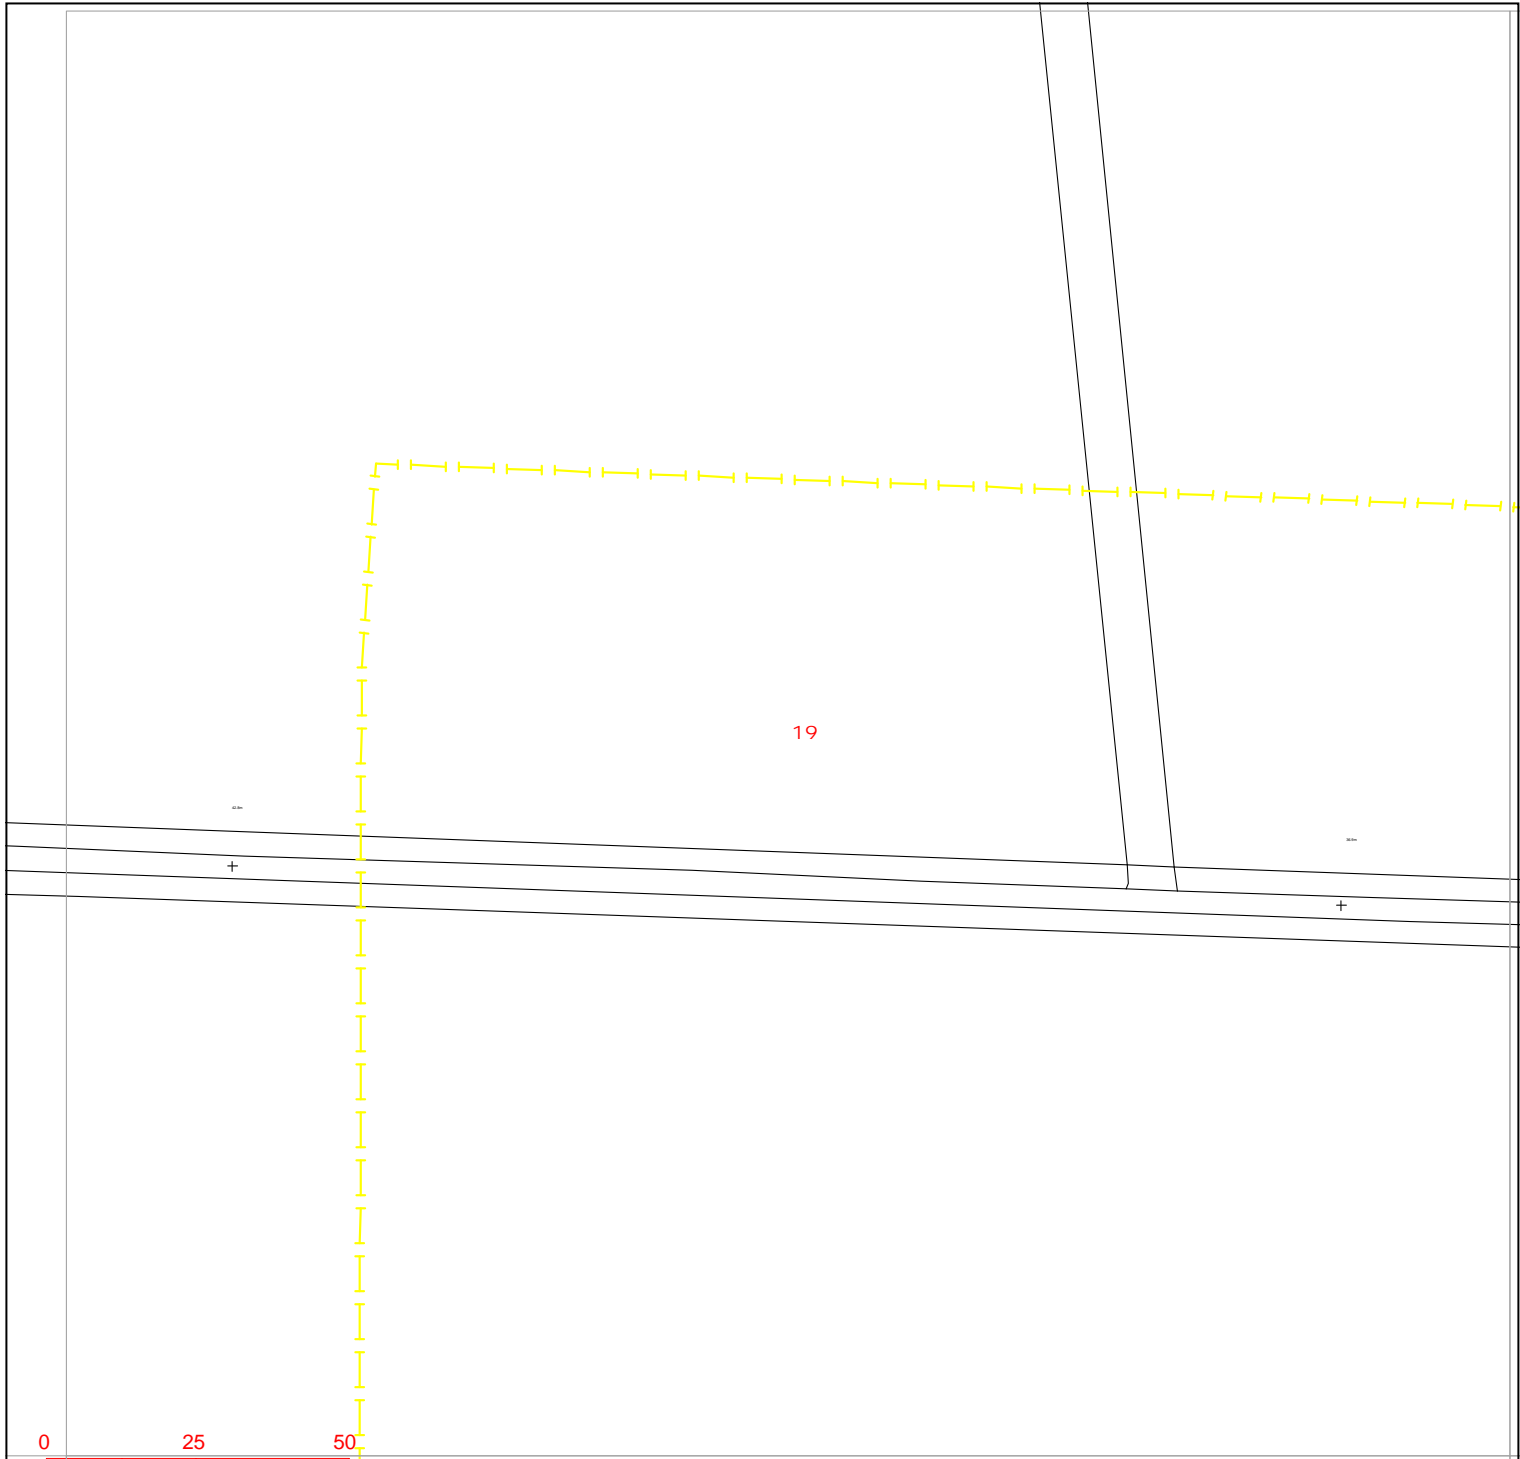

Warning: PDF designed for colour print only with no page scaling.

nationalgrid Electricity Distribution

Contact Us

Mapping Enquiries:
All areas 0121 623 9780

General Enquiries:
All areas 0800 096 3080

Date Requested: 08/05/2023
Job Reference: 29406946
Site Location: 476022 383761
Requested by:
Mr Ben Evans
Your Scheme/Reference:
LM 203570/DK - 9

Exact Scales:
1:1250 Area or Circle dig site
1:500 Line dig site


Link Box	Overhead Line	Underground Cable	National Grid Telecoms	Pilot Cables
●				
●				
—				

IMPORTANT NOTICES

- This information is given as a guide only and its accuracy cannot be guaranteed. Services or recent additions to the network may not be shown.
- Cables, overhead lines & substations owned by other electricity network owners or private companies may be present and may not be shown.
- You should always verify exact locations of cables using a cable locator and by careful use of hand tools in accordance with HSE guidance note HSG47.
- When working within 10m of any overhead electric line you should follow the requirements of HSE Guidance Note GS6.
- For further advice on working near our electricity cables or lines, call our General Enquiries number.
- Advice should be sought from the National Grid Electricity Distribution General Enquiries team for any work that is to take place in proximity to 132kV underground cables and 132kV overhead lines.

Report damage immediately – KEEP EVERYONE AWAY FROM THE AREA
0800 6783 105

Crown Copyright © All Rights Reserved. Ordnance Survey Licence numbers: 100022432
NGED Copyright: This copy has been made by or with the authority of National Grid Electricity Distribution (NGED) pursuant to Section 47 of the Copyright Designs and Patents Act 1988 unless that Act provides a relevant exception to copyright the copy must not be copied without the prior permission of the copyright owner.

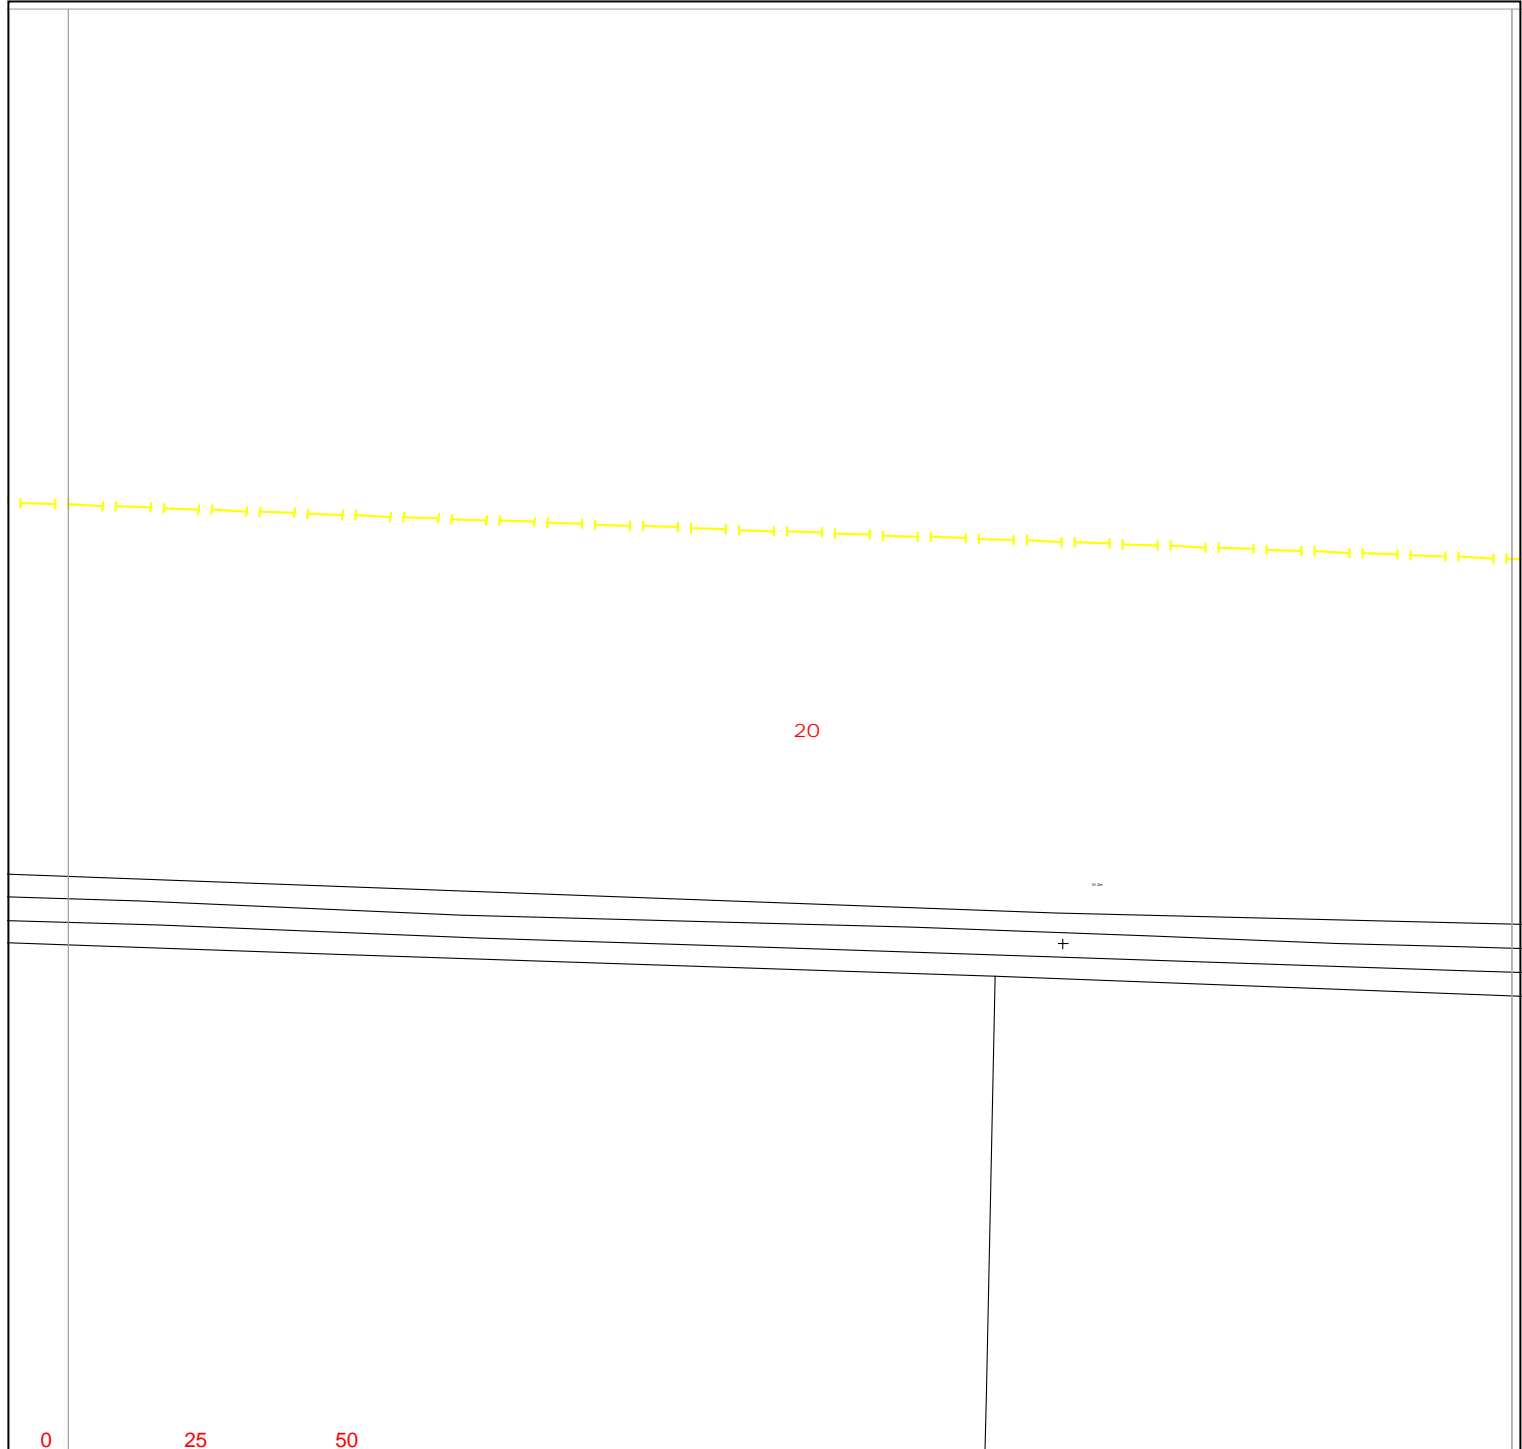

Warning: PDF designed for colour print only with no page scaling.

nationalgrid Electricity Distribution


Contact Us

Mapping Enquiries:
All areas 0121 623 9780

General Enquiries:
All areas 0800 096 3080

Date Requested: 08/05/2023
Job Reference: 29406946
Site Location: 476022 383761
Requested by:
Mr Ben Evans
Your Scheme/Reference:
LM 203570/DK - 9

Exact Scales:
1:1250 Area or Circle dig site
1:500 Line dig site

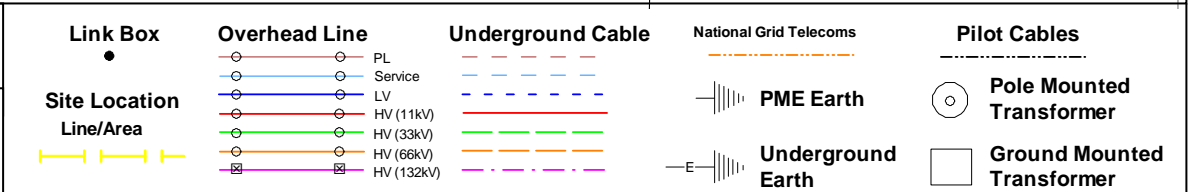


IMPORTANT NOTICES

- This information is given as a guide only and its accuracy cannot be guaranteed. Services or recent additions to the network may not be shown.
- Cables, overhead lines & substations owned by other electricity network owners or private companies may be present and may not be shown.
- You should always verify exact locations of cables using a cable locator and by careful use of hand tools in accordance with HSE guidance note HSG47.
- When working within 10m of any overhead electric line you should follow the requirements of HSE Guidance Note GS6.
- For further advice on working near our electricity cables or lines, call our General Enquiries number.
- Advice should be sought from the National Grid Electricity Distribution General Enquiries team for any work that is to take place in proximity to 132kV underground cables and 132kV overhead lines.

Report damage immediately – KEEP EVERYONE AWAY FROM THE AREA
0800 6783 105

Crown Copyright © All Rights Reserved. Ordnance Survey Licence numbers: 100022432
 NGED Copyright: This copy has been made by or with the authority of National Grid Electricity Distribution (NGED) pursuant to Section 47 of the Copyright Designs and Patents Act 1988 unless that Act provides a relevant exception to copyright the copy must not be copied without the prior permission of the copyright owner.

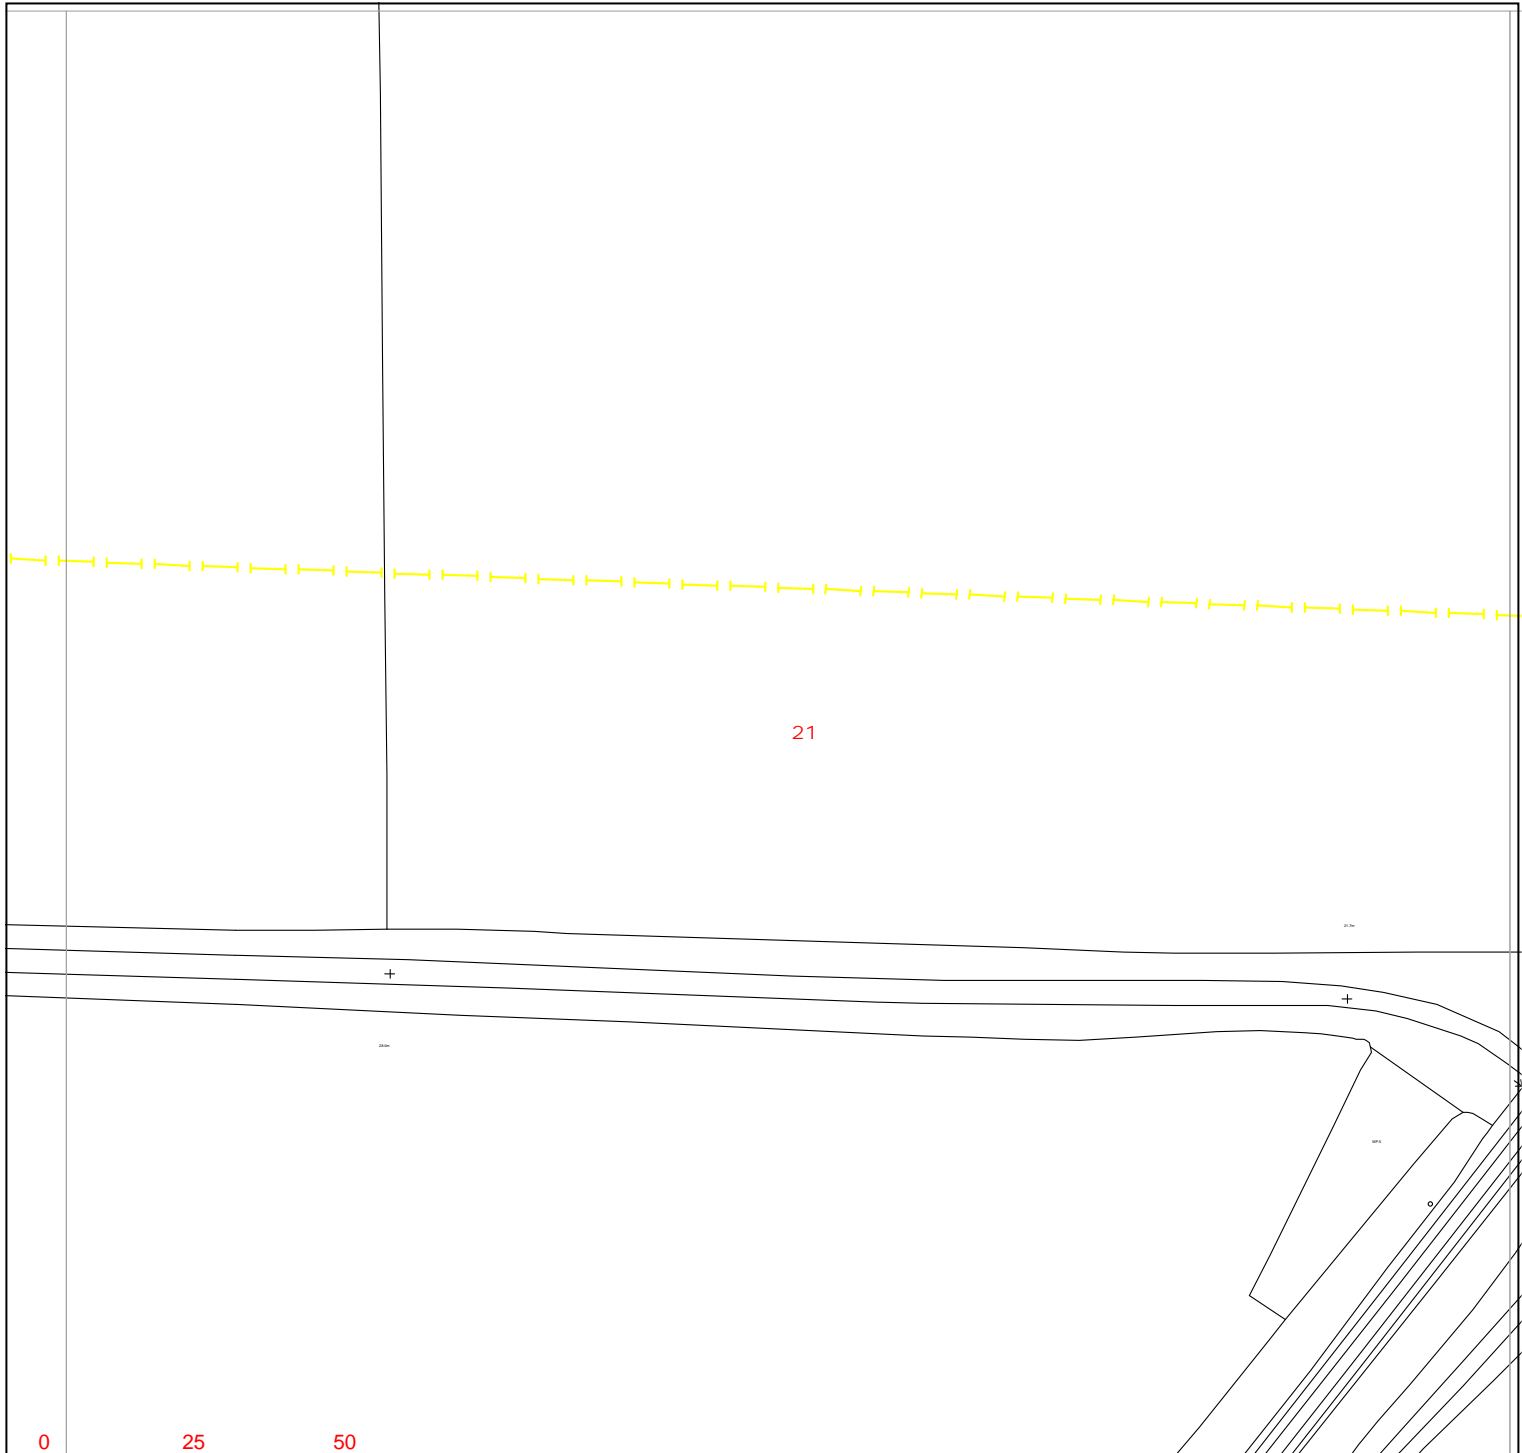

Warning: PDF designed for colour print only with no page scaling.



Contact Us
Mapping Enquiries:
 All areas 0121 623 9780
General Enquiries:
 All areas 0800 096 3080

Date Requested: 08/05/2023
 Job Reference: 29406946
 Site Location: 476022 383761
 Requested by:
 Mr Ben Evans
 Your Scheme/Reference:
 LM 203570/DK - 9

Exact Scales:
 1:1250 Area or Circle dig site
 1:500 Line dig site


Link Box ●	Overhead Line ○—○ PL ○—○ Service ○—○ LV ○—○ HV (11kV) ○—○ HV (33kV) ○—○ HV (66kV) ○—○ HV (132kV)	Underground Cable -	National Grid Telecoms - - - - - PME Earth -E- - - - - Underground Earth	Pilot Cables ○ Pole Mounted Transformer □ Ground Mounted Transformer
----------------------	--	---	---	---

IMPORTANT NOTICES

- This information is given as a guide only and its accuracy cannot be guaranteed. Services or recent additions to the network may not be shown.
- Cables, overhead lines & substations owned by other electricity network owners or private companies may be present and may not be shown.
- You should always verify exact locations of cables using a cable locator and by careful use of hand tools in accordance with HSE guidance note HSG47.
- When working within 10m of any overhead electric line you should follow the requirements of HSE Guidance Note GS6.
- For further advice on working near our electricity cables or lines, call our General Enquiries number.
- Advice should be sought from the National Grid Electricity Distribution General Enquiries team for any work that is to take place in proximity to 132kV underground cables and 132kV overhead lines.

Report damage immediately – KEEP EVERYONE AWAY FROM THE AREA
0800 6783 105

Crown Copyright © All Rights Reserved. Ordnance Survey Licence numbers: 100022432
 NGED Copyright: This copy has been made by or with the authority of National Grid Electricity Distribution (NGED) pursuant to Section 47 of the Copyright Designs and Patents Act 1988 unless that Act provides a relevant exception to copyright the copy must not be copied without the prior permission of the copyright owner.

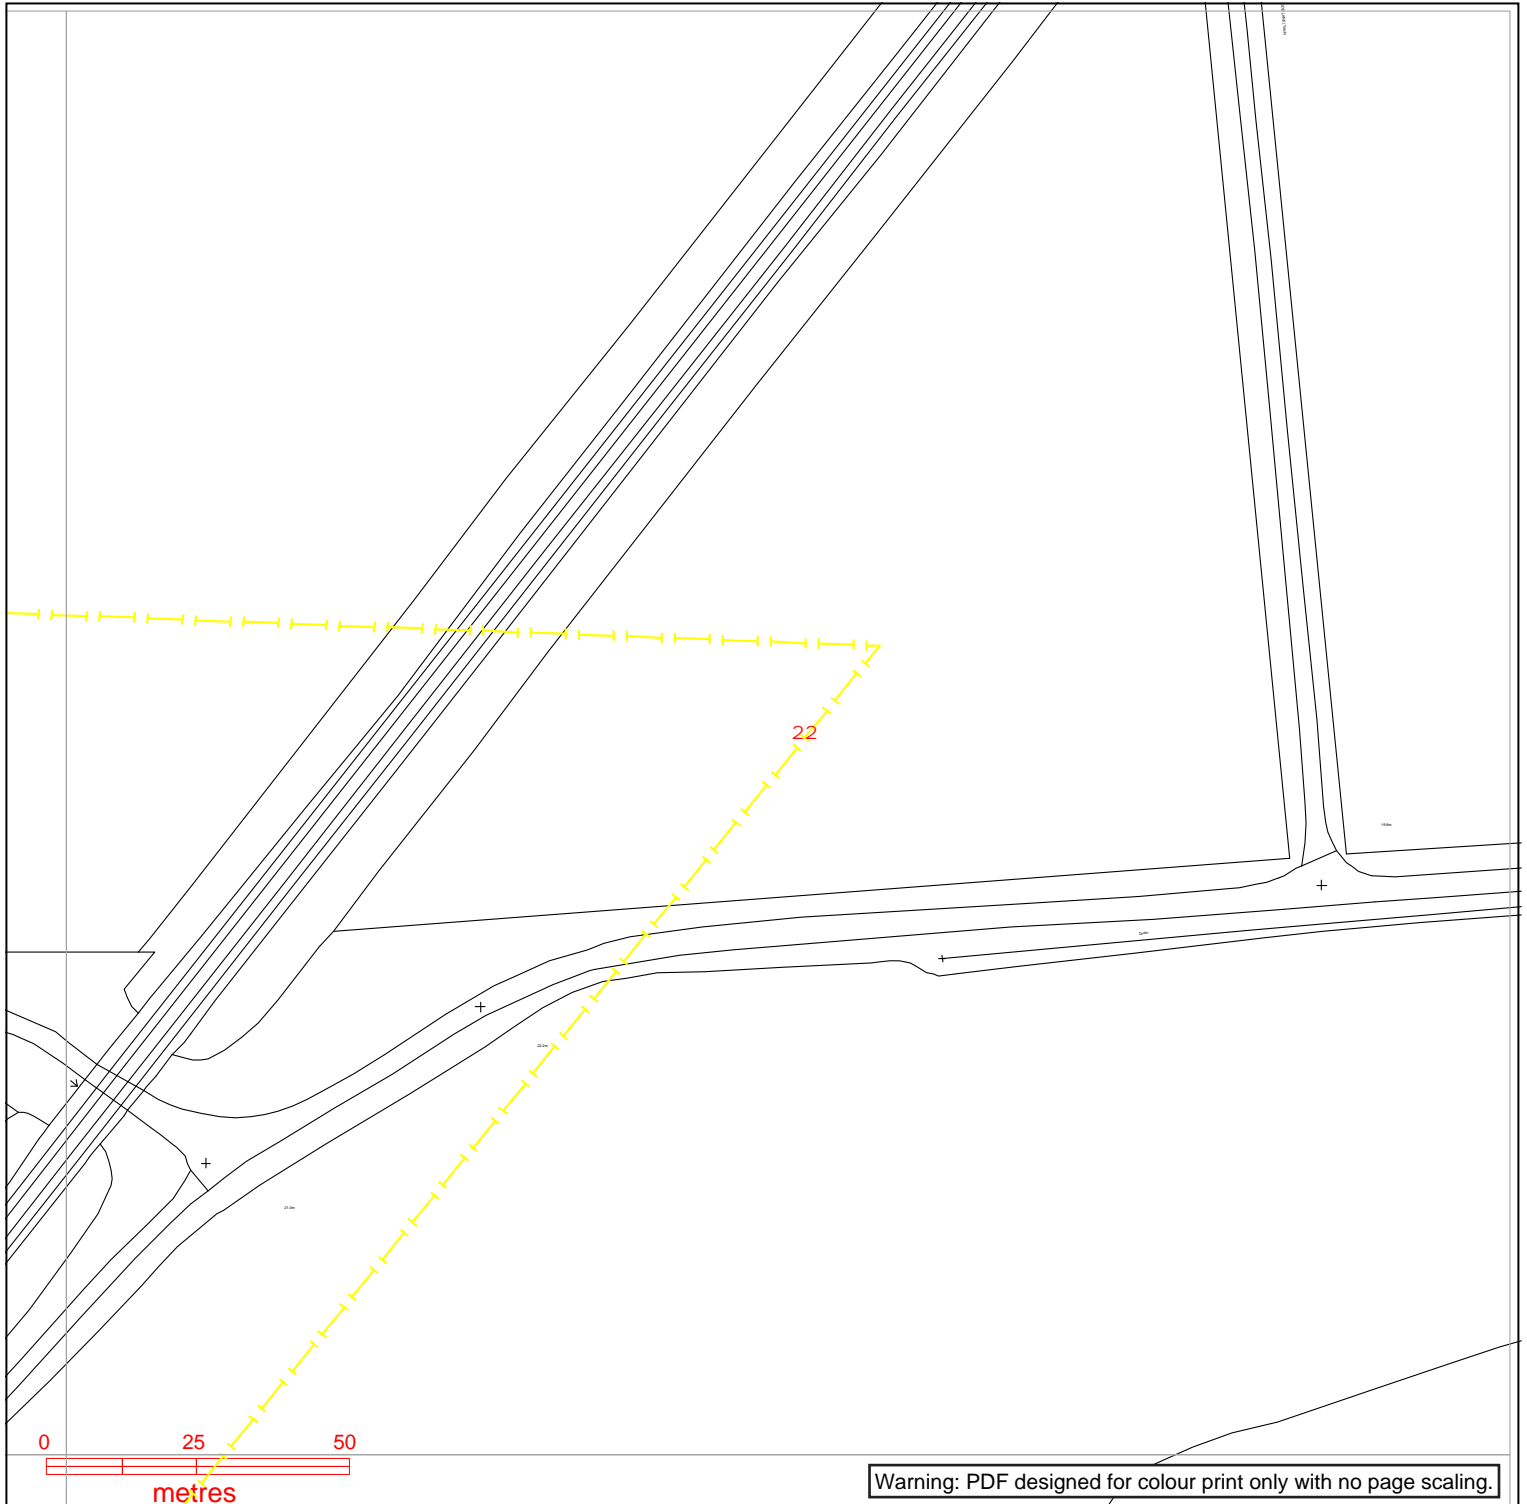

Warning: PDF designed for colour print only with no page scaling.

nationalgrid Electricity Distribution

Contact Us

Mapping Enquiries:
All areas 0121 623 9780

General Enquiries:
All areas 0800 096 3080

Date Requested: 08/05/2023
Job Reference: 29406946
Site Location: 476022 383761
Requested by:
Mr Ben Evans
Your Scheme/Reference:
LM 203570/DK - 9

Exact Scales:
1:1250 Area or Circle dig site
1:500 Line dig site


Link Box	Overhead Line	Underground Cable	National Grid Telecoms	Pilot Cables
●	<ul style="list-style-type: none"> ○ PL ○ Service ○ LV ○ HV (11kV) ○ HV (33kV) ○ HV (66kV) ○ HV (132kV) 	<ul style="list-style-type: none"> --- --- --- --- --- --- --- 	<ul style="list-style-type: none"> --- PME Earth ---E Underground Earth 	<ul style="list-style-type: none"> ○ Pole Mounted Transformer □ Ground Mounted Transformer
Site Location Line/Area	<ul style="list-style-type: none"> --- (Yellow dashed line) 			

IMPORTANT NOTICES

- This information is given as a guide only and its accuracy cannot be guaranteed. Services or recent additions to the network may not be shown.
- Cables, overhead lines & substations owned by other electricity network owners or private companies may be present and may not be shown.
- You should always verify exact locations of cables using a cable locator and by careful use of hand tools in accordance with HSE guidance note HSG47.
- When working within 10m of any overhead electric line you should follow the requirements of HSE Guidance Note GS6.
- For further advice on working near our electricity cables or lines, call our General Enquiries number.
- Advice should be sought from the National Grid Electricity Distribution General Enquiries team for any work that is to take place in proximity to 132kV underground cables and 132kV overhead lines.

Report damage immediately – KEEP EVERYONE AWAY FROM THE AREA
0800 6783 105

Crown Copyright © All Rights Reserved. Ordnance Survey Licence numbers: 100022432
NGED Copyright: This copy has been made by or with the authority of National Grid Electricity Distribution (NGED) pursuant to Section 47 of the Copyright Designs and Patents Act 1988 unless that Act provides a relevant exception to copyright the copy must not be copied without the prior permission of the copyright owner.

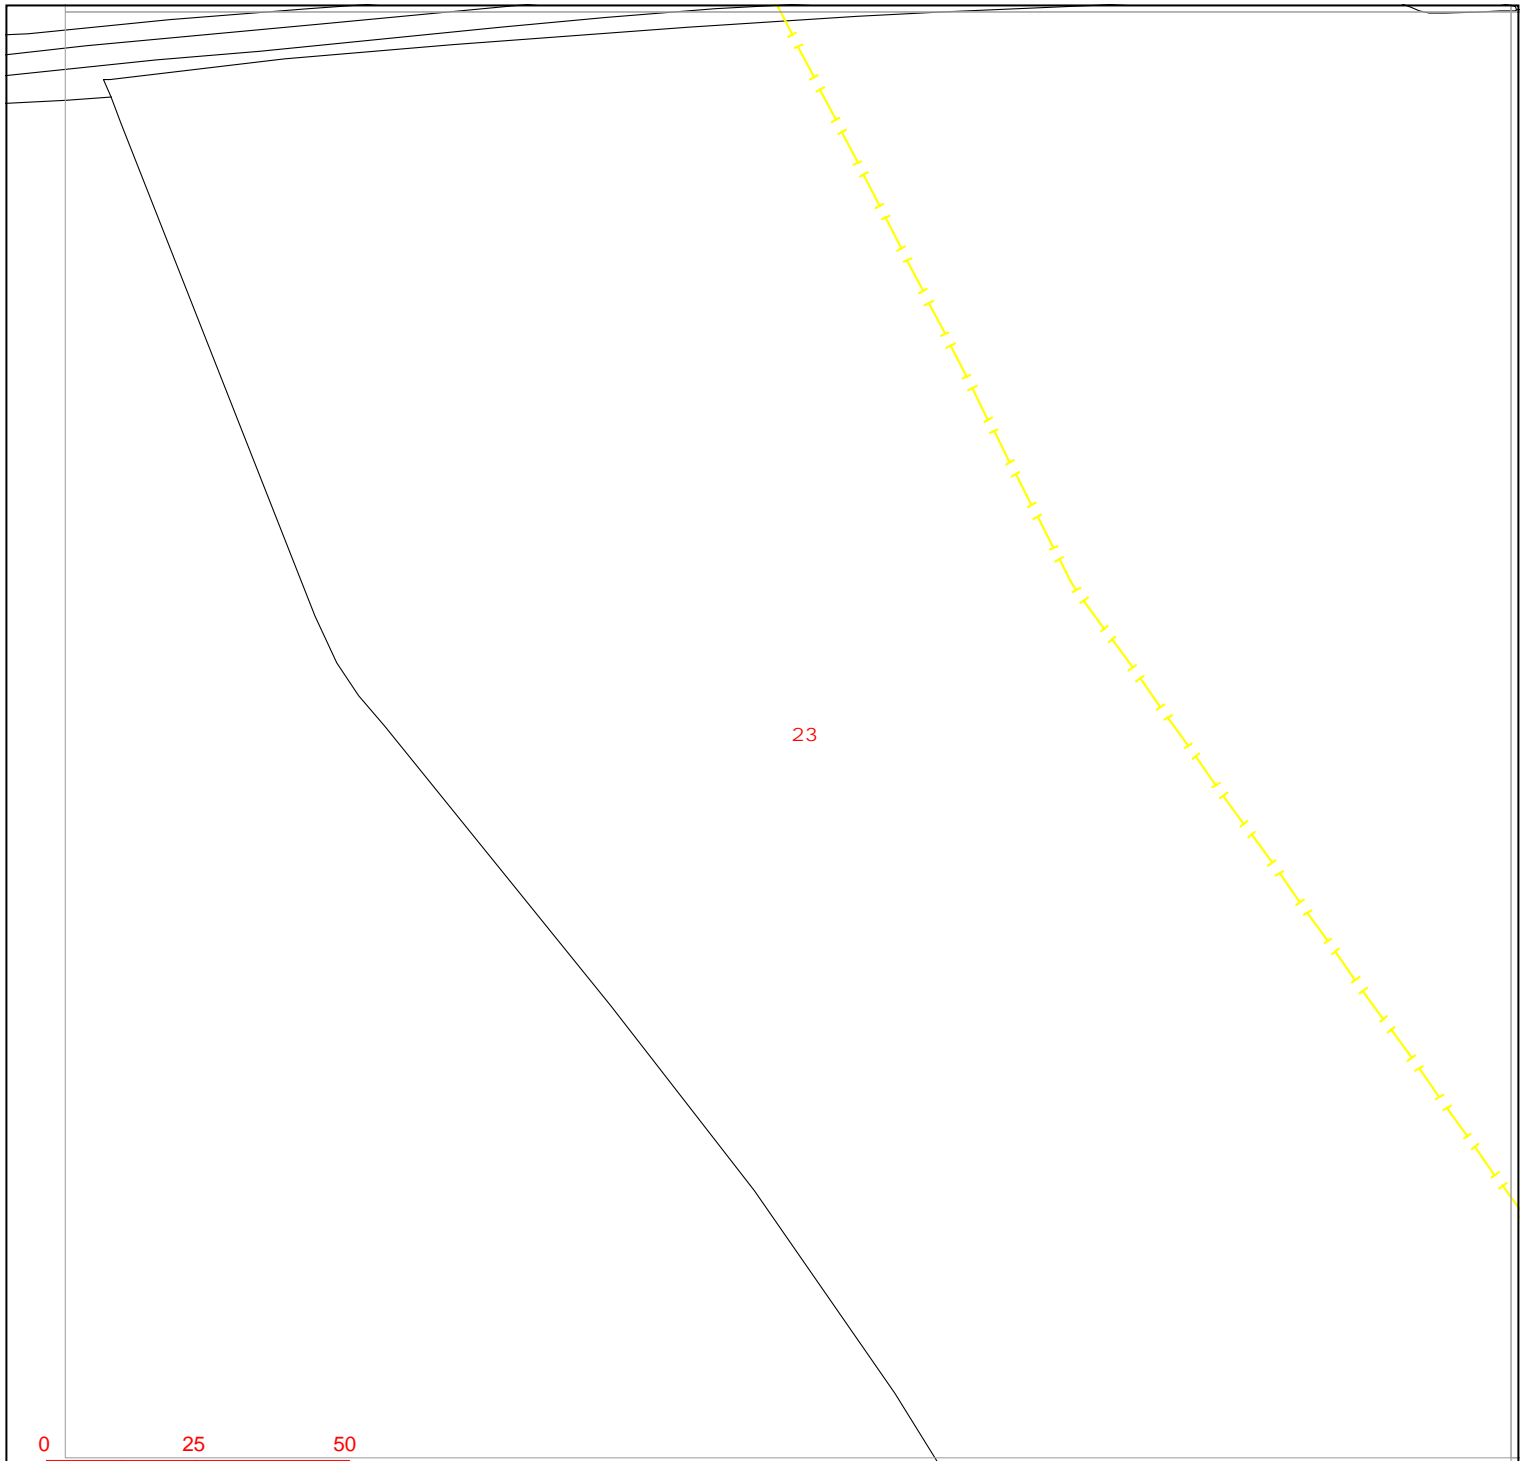

Warning: PDF designed for colour print only with no page scaling.

nationalgrid Electricity Distribution

Contact Us

Mapping Enquiries:
All areas 0121 623 9780

General Enquiries:
All areas 0800 096 3080

Date Requested: 08/05/2023
Job Reference: 29406946
Site Location: 476022 383761
Requested by:
Mr Ben Evans
Your Scheme/Reference:
LM 203570/DK - 9

Exact Scales:
1:1250 Area or Circle dig site
1:500 Line dig site


Link Box ●	Overhead Line ○—○ PL ○—○ Service ○—○ LV ○—○ HV (11kV) ○—○ HV (33kV) ○—○ HV (66kV) ○—○ HV (132kV)	Underground Cable -	National Grid Telecoms - - - - - PME Earth -E- - - - - Underground Earth	Pilot Cables ○ Pole Mounted Transformer □ Ground Mounted Transformer
----------------------	--	---	---	---

IMPORTANT NOTICES

- This information is given as a guide only and its accuracy cannot be guaranteed. Services or recent additions to the network may not be shown.
- Cables, overhead lines & substations owned by other electricity network owners or private companies may be present and may not be shown.
- You should always verify exact locations of cables using a cable locator and by careful use of hand tools in accordance with HSE guidance note HSG47.
- When working within 10m of any overhead electric line you should follow the requirements of HSE Guidance Note GS6.
- For further advice on working near our electricity cables or lines, call our General Enquiries number.
- Advice should be sought from the National Grid Electricity Distribution General Enquiries team for any work that is to take place in proximity to 132kV underground cables and 132kV overhead lines.

Report damage immediately – KEEP EVERYONE AWAY FROM THE AREA
0800 6783 105

Crown Copyright © All Rights Reserved. Ordnance Survey Licence numbers: 100022432
NGED Copyright: This copy has been made by or with the authority of National Grid Electricity Distribution (NGED) pursuant to Section 47 of the Copyright Designs and Patents Act 1988 unless that Act provides a relevant exception to copyright the copy must not be copied without the prior permission of the copyright owner.

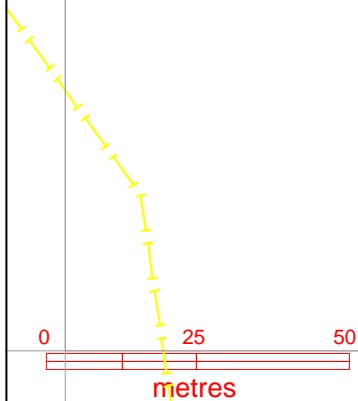

Warning: PDF designed for colour print only with no page scaling.

nationalgrid Electricity Distribution

Contact Us

Mapping Enquiries:
All areas 0121 623 9780

General Enquiries:
All areas 0800 096 3080

Date Requested: 08/05/2023
Job Reference: 29406946
Site Location: 476022 383761
Requested by:
Mr Ben Evans
Your Scheme/Reference:
LM 203570/DK - 9

Exact Scales:
1:1250 Area or Circle dig site
1:500 Line dig site


Link Box ●	Overhead Line ○—○ PL ○—○ Service ○—○ LV ○—○ HV (11kV) ○—○ HV (33kV) ○—○ HV (66kV) ○—○ HV (132kV)	Underground Cable -	National Grid Telecoms - - - - - PME Earth -E- - - - - Underground Earth	Pilot Cables ○ Pole Mounted Transformer □ Ground Mounted Transformer
----------------------	--	---	---	---

IMPORTANT NOTICES

- This information is given as a guide only and its accuracy cannot be guaranteed. Services or recent additions to the network may not be shown.
- Cables, overhead lines & substations owned by other electricity network owners or private companies may be present and may not be shown.
- You should always verify exact locations of cables using a cable locator and by careful use of hand tools in accordance with HSE guidance note HSG47.
- When working within 10m of any overhead electric line you should follow the requirements of HSE Guidance Note GS6.
- For further advice on working near our electricity cables or lines, call our General Enquiries number.
- Advice should be sought from the National Grid Electricity Distribution General Enquiries team for any work that is to take place in proximity to 132kV underground cables and 132kV overhead lines.

Report damage immediately – KEEP EVERYONE AWAY FROM THE AREA
0800 6783 105

Crown Copyright © All Rights Reserved. Ordnance Survey Licence numbers: 100022432
NGED Copyright: This copy has been made by or with the authority of National Grid Electricity Distribution (NGED) pursuant to Section 47 of the Copyright Designs and Patents Act 1988 unless that Act provides a relevant exception to copyright the copy must not be copied without the prior permission of the copyright owner.

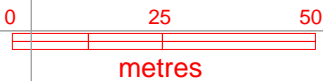


Warning: PDF designed for colour print only with no page scaling.



Contact Us
Mapping Enquiries:
 All areas 0121 623 9780
General Enquiries:
 All areas 0800 096 3080

Date Requested: 08/05/2023
 Job Reference: 29406946
 Site Location: 476022 383761
 Requested by:
 Mr Ben Evans
 Your Scheme/Reference:
 LM 203570/DK - 9

Exact Scales:
 1:1250 Area or Circle dig site
 1:500 Line dig site

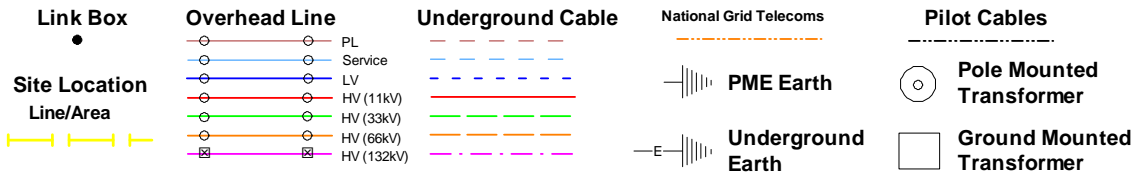

IMPORTANT NOTICES

- This information is given as a guide only and its accuracy cannot be guaranteed. Services or recent additions to the network may not be shown.
- Cables, overhead lines & substations owned by other electricity network owners or private companies may be present and may not be shown.
- You should always verify exact locations of cables using a cable locator and by careful use of hand tools in accordance with HSE guidance note HSG47.
- When working within 10m of any overhead electric line you should follow the requirements of HSE Guidance Note GS6.
- For further advice on working near our electricity cables or lines, call our General Enquiries number.
- Advice should be sought from the National Grid Electricity Distribution General Enquiries team for any work that is to take place in proximity to 132kV underground cables and 132kV overhead lines.

Report damage immediately – KEEP EVERYONE AWAY FROM THE AREA
0800 6783 105

Crown Copyright © All Rights Reserved. Ordnance Survey Licence numbers: 100022432
 NGED Copyright: This copy has been made by or with the authority of National Grid Electricity Distribution (NGED) pursuant to Section 47 of the Copyright Designs and Patents Act 1988 unless that Act provides a relevant exception to copyright the copy must not be copied without the prior permission of the copyright owner.



Warning: PDF designed for colour print only with no page scaling.

nationalgrid Electricity Distribution

Contact Us

Mapping Enquiries:
All areas 0121 623 9780

General Enquiries:
All areas 0800 096 3080

Date Requested: 08/05/2023
Job Reference: 29406946
Site Location: 476022 383761
Requested by:
Mr Ben Evans
Your Scheme/Reference:
LM 203570/DK - 9

Exact Scales:
1:1250 Area or Circle dig site
1:500 Line dig site


Link Box	Overhead Line	Underground Cable	National Grid Telecoms	Pilot Cables
●	<ul style="list-style-type: none"> ○ PL ○ Service ○ LV ○ HV (11kV) ○ HV (33kV) ○ HV (66kV) ○ HV (132kV) 	<ul style="list-style-type: none"> --- (Red) --- (Green) --- (Blue) --- (Purple) 	<ul style="list-style-type: none"> --- (Dashed) National Grid Telecoms ⚡ PME Earth ⚡ Underground Earth 	<ul style="list-style-type: none"> ○ Pole Mounted Transformer □ Ground Mounted Transformer

IMPORTANT NOTICES

- This information is given as a guide only and its accuracy cannot be guaranteed. Services or recent additions to the network may not be shown.
- Cables, overhead lines & substations owned by other electricity network owners or private companies may be present and may not be shown.
- You should always verify exact locations of cables using a cable locator and by careful use of hand tools in accordance with HSE guidance note HSG47.
- When working within 10m of any overhead electric line you should follow the requirements of HSE Guidance Note GS6.
- For further advice on working near our electricity cables or lines, call our General Enquiries number.
- Advice should be sought from the National Grid Electricity Distribution General Enquiries team for any work that is to take place in proximity to 132kV underground cables and 132kV overhead lines.

Report damage immediately – KEEP EVERYONE AWAY FROM THE AREA
0800 6783 105

Crown Copyright © All Rights Reserved. Ordnance Survey Licence numbers: 100022432
NGED Copyright: This copy has been made by or with the authority of National Grid Electricity Distribution (NGED) pursuant to Section 47 of the Copyright Designs and Patents Act 1988 unless that Act provides a relevant exception to copyright the copy must not be copied without the prior permission of the copyright owner.

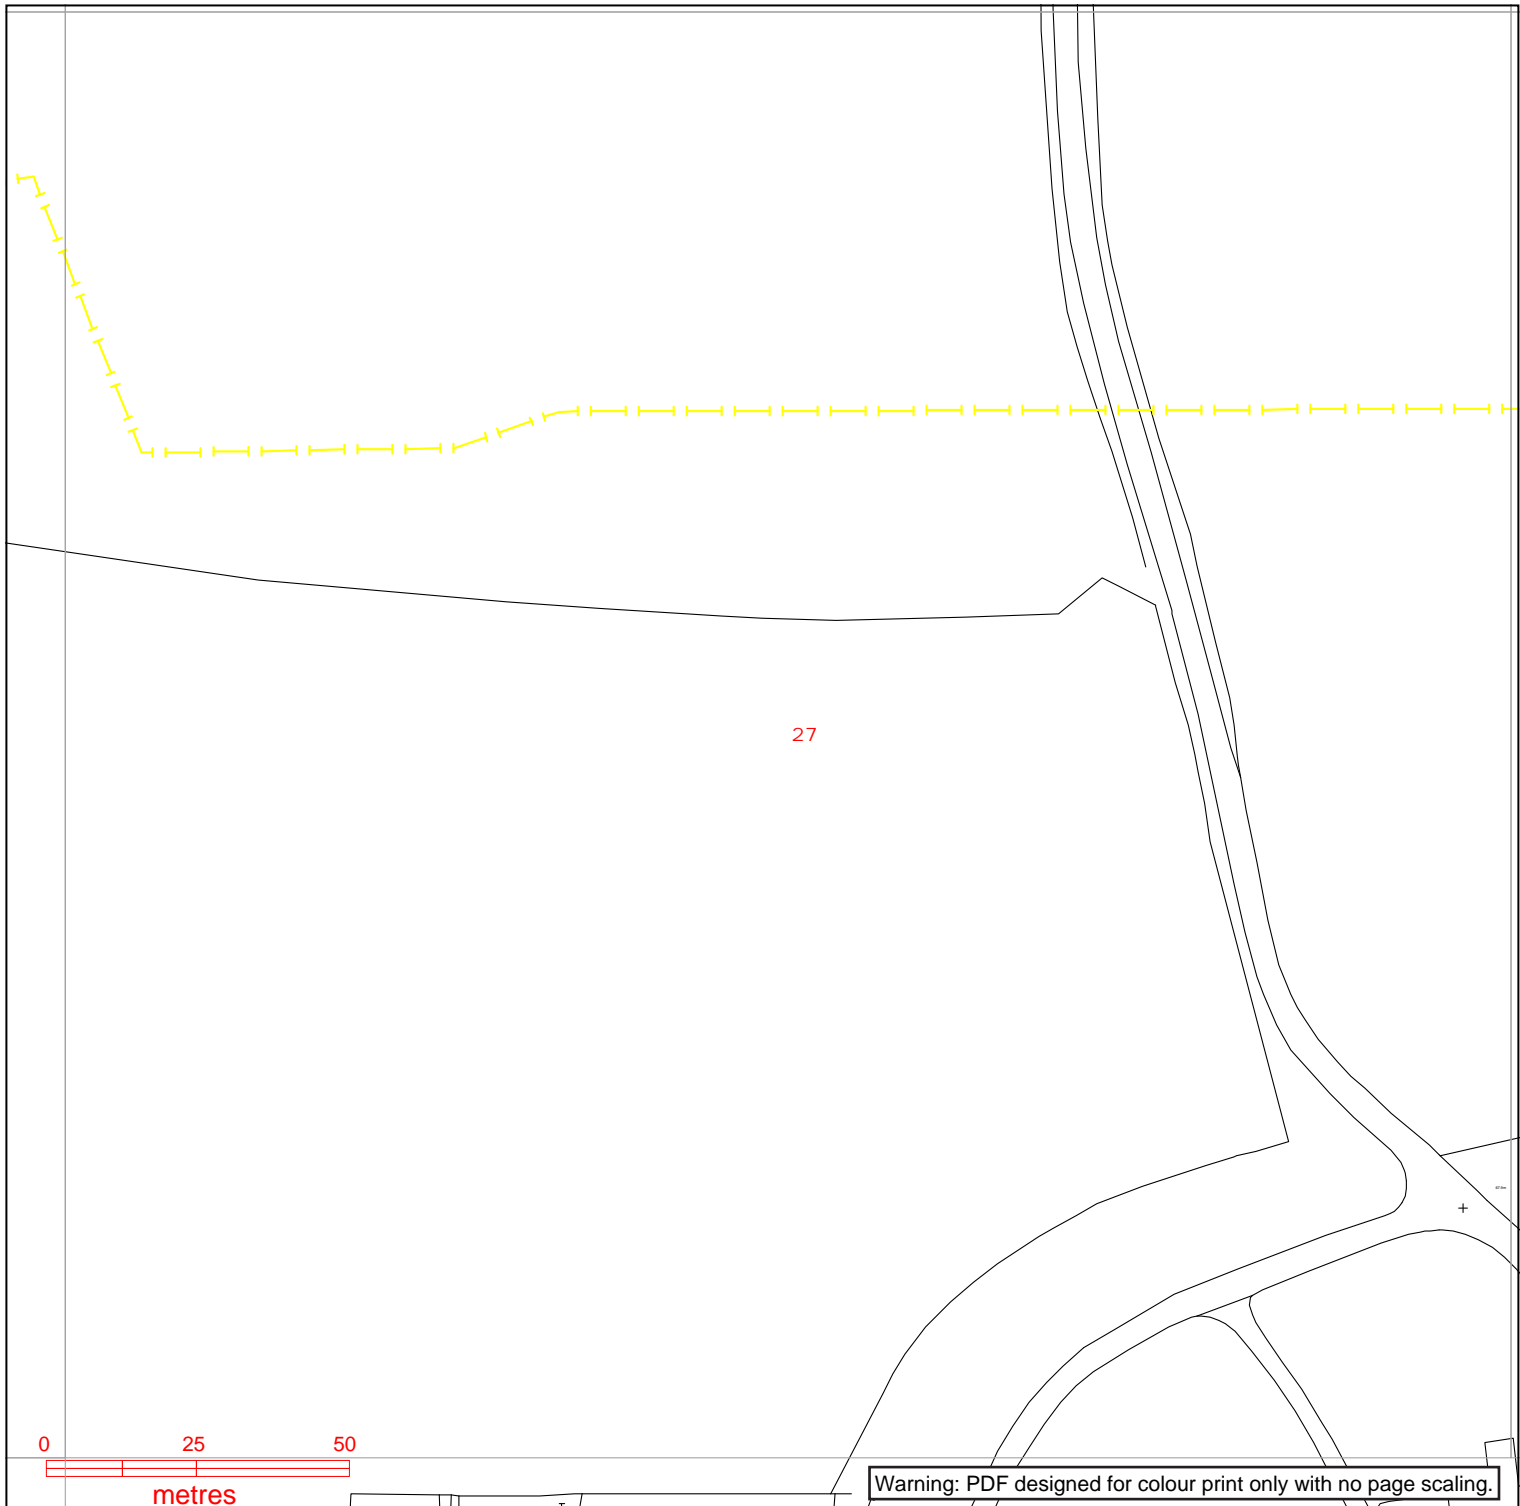

27



Warning: PDF designed for colour print only with no page scaling.



Contact Us
Mapping Enquiries:
 All areas 0121 623 9780
General Enquiries:
 All areas 0800 096 3080

Date Requested: 08/05/2023
 Job Reference: 29406946
 Site Location: 476022 383761
 Requested by:
 Mr Ben Evans
 Your Scheme/Reference:
 LM 203570/DK - 9

Link Box	Overhead Line	Underground Cable	National Grid Telecoms	Pilot Cables
●	○ PL ○ Service ○ LV ○ HV (11kV) ○ HV (33kV) ○ HV (66kV) ○ HV (132kV)	---	--- PME Earth ---E Underground Earth	○ Pole Mounted Transformer □ Ground Mounted Transformer
Site Location Line/Area	--- --- --- --- --- --- ---	---		
--- --- ---				


IMPORTANT NOTICES

- This information is given as a guide only and its accuracy cannot be guaranteed. Services or recent additions to the network may not be shown.
- Cables, overhead lines & substations owned by other electricity network owners or private companies may be present and may not be shown.
- You should always verify exact locations of cables using a cable locator and by careful use of hand tools in accordance with HSE guidance note HSG47.
- When working within 10m of any overhead electric line you should follow the requirements of HSE Guidance Note GS6.
- For further advice on working near our electricity cables or lines, call our General Enquiries number.
- Advice should be sought from the National Grid Electricity Distribution General Enquiries team for any work that is to take place in proximity to 132kV underground cables and 132kV overhead lines.

Report damage immediately – KEEP EVERYONE AWAY FROM THE AREA
0800 6783 105

Exact Scales:
 1:1250 Area or Circle dig site
 1:500 Line dig site

Crown Copyright © All Rights Reserved. Ordnance Survey Licence numbers: 100022432
 NGED Copyright: This copy has been made by or with the authority of National Grid Electricity Distribution (NGED) pursuant to Section 47 of the Copyright Designs and Patents Act 1988 unless that Act provides a relevant exception to copyright the copy must not be copied without the prior permission of the copyright owner.

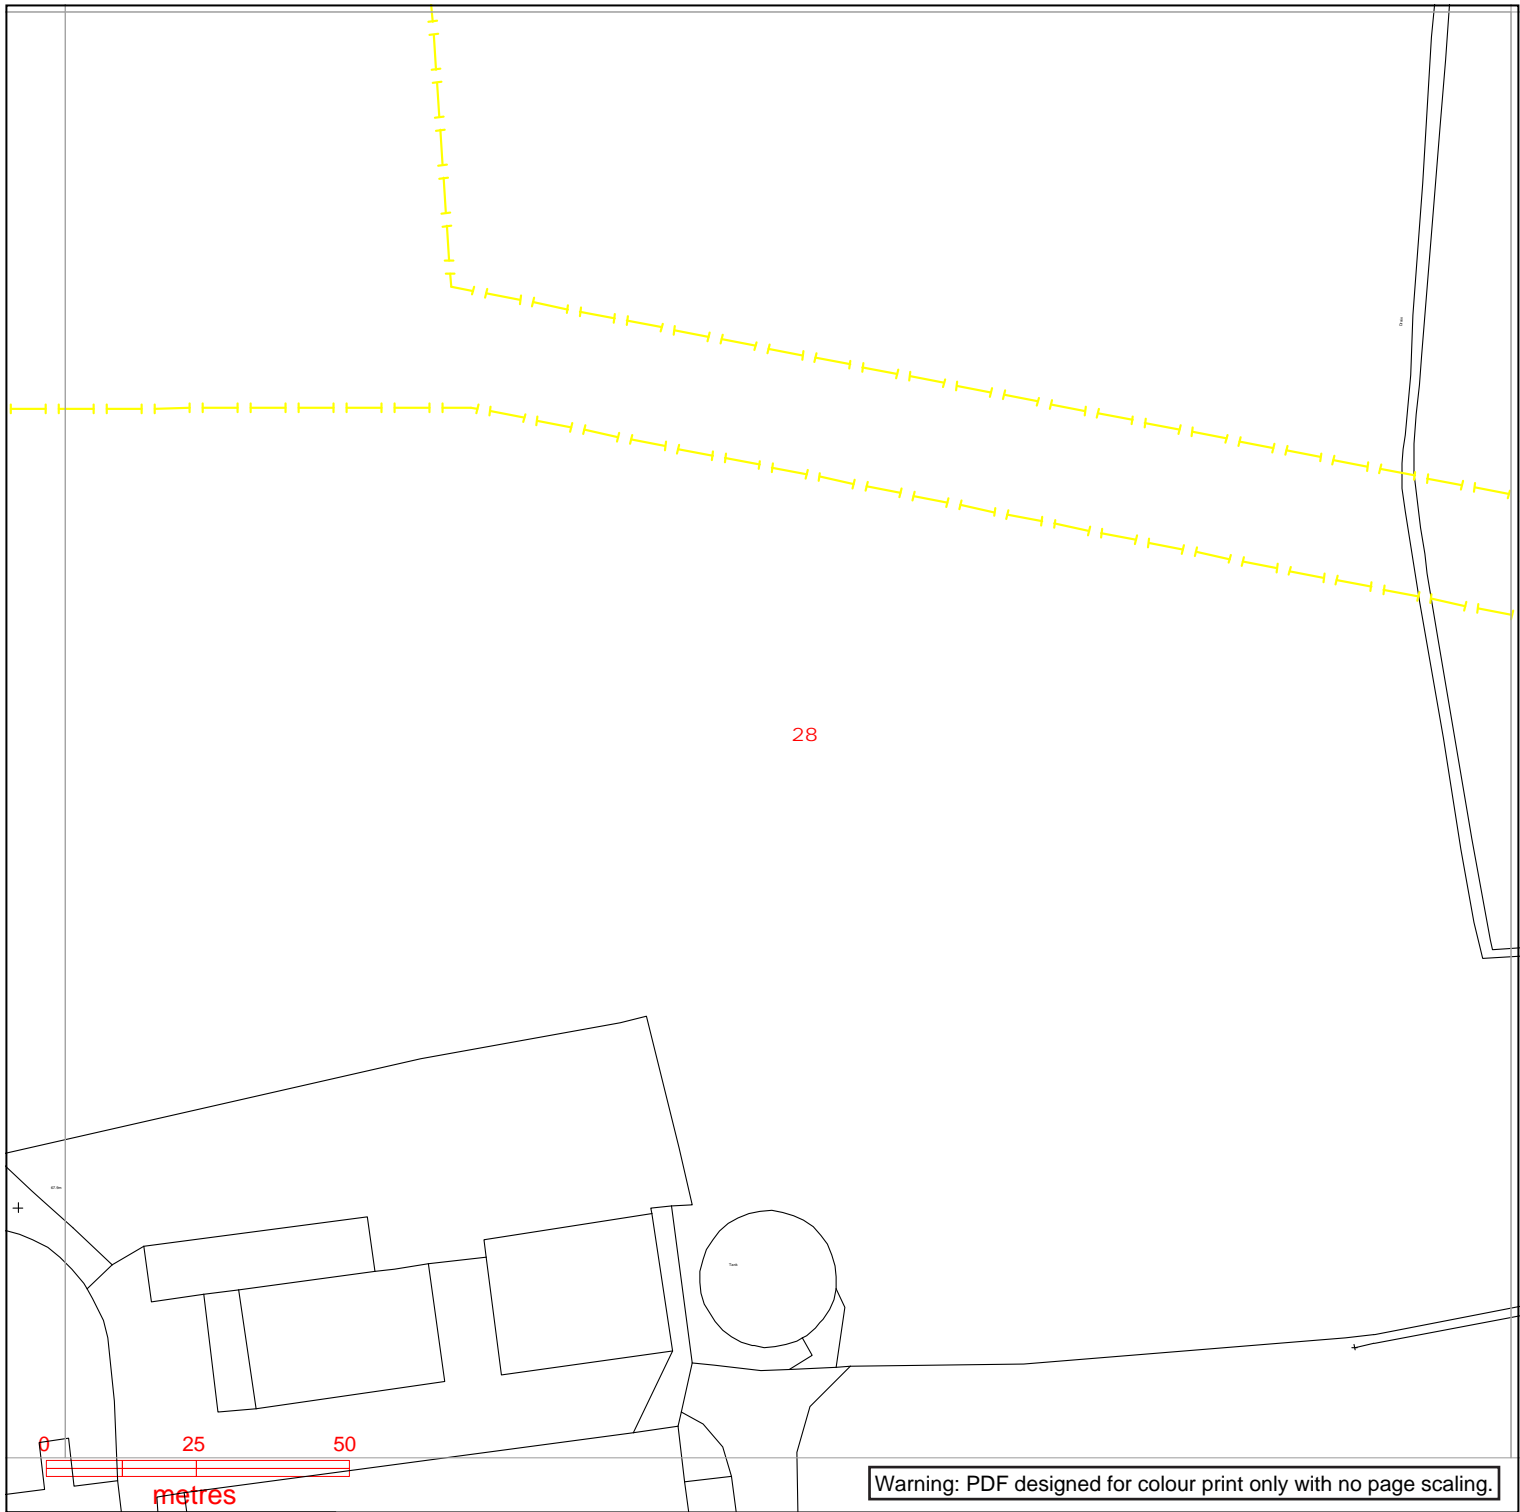

Warning: PDF designed for colour print only with no page scaling.

nationalgrid Electricity Distribution

Contact Us

Mapping Enquiries:
All areas 0121 623 9780

General Enquiries:
All areas 0800 096 3080

Date Requested: 08/05/2023
Job Reference: 29406946
Site Location: 476022 383761
Requested by:
Mr Ben Evans
Your Scheme/Reference:
LM 203570/DK - 9

Exact Scales:
1:1250 Area or Circle dig site
1:500 Line dig site


Link Box ●	Overhead Line ○—○ PL ○—○ Service ○—○ LV ○—○ HV (11kV) ○—○ HV (33kV) ○—○ HV (66kV) ○—○ HV (132kV)	Underground Cable -	National Grid Telecoms - - - - - PME Earth Underground Earth	Pilot Cables ○ Pole Mounted Transformer □ Ground Mounted Transformer
----------------------	--	---	--	---

IMPORTANT NOTICES

- This information is given as a guide only and its accuracy cannot be guaranteed. Services or recent additions to the network may not be shown.
- Cables, overhead lines & substations owned by other electricity network owners or private companies may be present and may not be shown.
- You should always verify exact locations of cables using a cable locator and by careful use of hand tools in accordance with HSE guidance note HSG47.
- When working within 10m of any overhead electric line you should follow the requirements of HSE Guidance Note GS6.
- For further advice on working near our electricity cables or lines, call our General Enquiries number.
- Advice should be sought from the National Grid Electricity Distribution General Enquiries team for any work that is to take place in proximity to 132kV underground cables and 132kV overhead lines.

Report damage immediately – KEEP EVERYONE AWAY FROM THE AREA
0800 6783 105

Crown Copyright © All Rights Reserved. Ordnance Survey Licence numbers: 100022432
NGED Copyright: This copy has been made by or with the authority of National Grid Electricity Distribution (NGED) pursuant to Section 47 of the Copyright Designs and Patents Act 1988 unless that Act provides a relevant exception to copyright the copy must not be copied without the prior permission of the copyright owner.

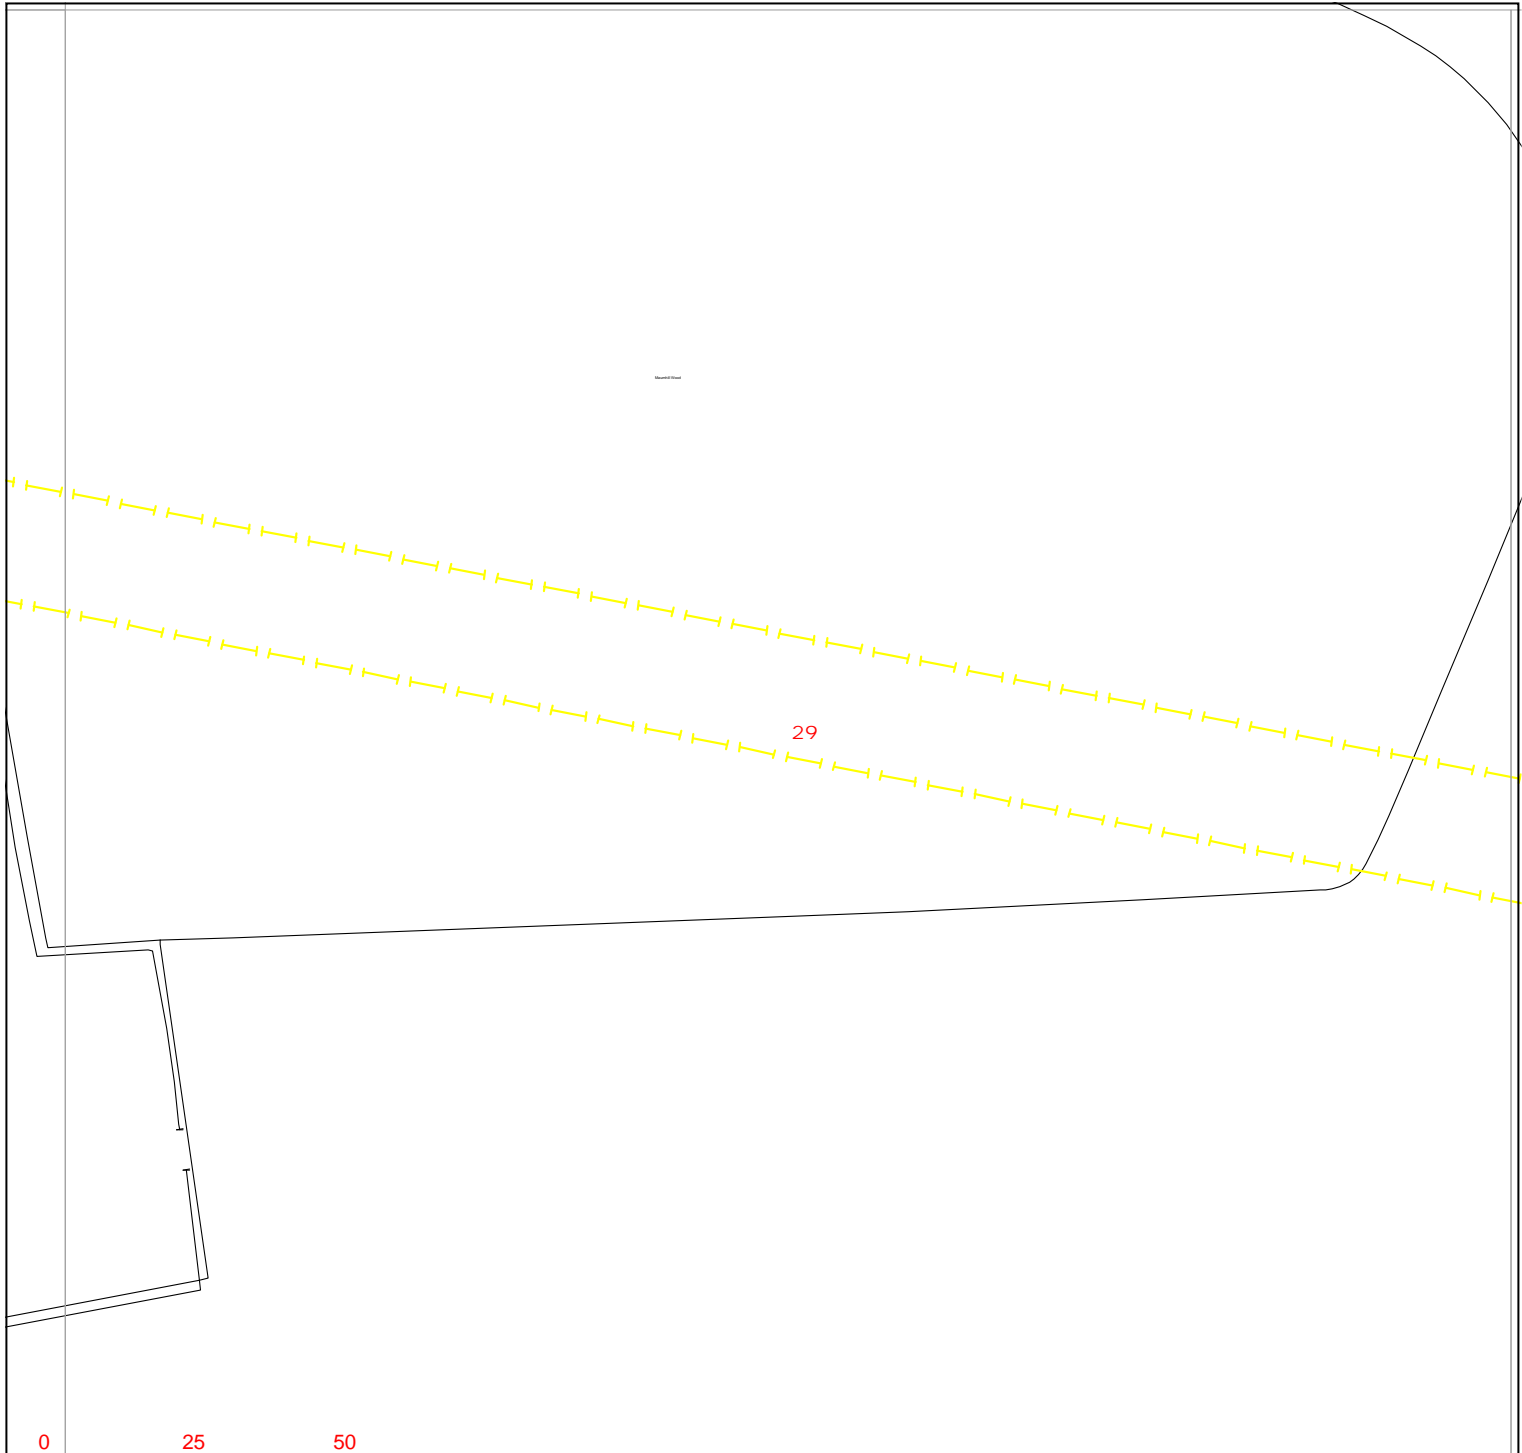

Warning: PDF designed for colour print only with no page scaling.



Link Box ●	Overhead Line —○—○— PL —○—○— Service —○—○— LV —○—○— HV (11kV) —○—○— HV (33kV) —○—○— HV (66kV) —□—□— HV (132kV)	Underground Cable -	National Grid Telecoms - - - - - PME Earth Underground Earth	Pilot Cables - - - - - ○ Pole Mounted Transformer □ Ground Mounted Transformer
----------------------	--	---	--	--

Contact Us

Mapping Enquiries:
All areas 0121 623 9780

General Enquiries:
All areas 0800 096 3080

IMPORTANT NOTICES

- This information is given as a guide only and its accuracy cannot be guaranteed. Services or recent additions to the network may not be shown.
- Cables, overhead lines & substations owned by other electricity network owners or private companies may be present and may not be shown.
- You should always verify exact locations of cables using a cable locator and by careful use of hand tools in accordance with HSE guidance note HSG47.
- When working within 10m of any overhead electric line you should follow the requirements of HSE Guidance Note GS6.
- For further advice on working near our electricity cables or lines, call our General Enquiries number.
- Advice should be sought from the National Grid Electricity Distribution General Enquiries team for any work that is to take place in proximity to 132kV underground cables and 132kV overhead lines.

Report damage immediately – KEEP EVERYONE AWAY FROM THE AREA
0800 6783 105

Date Requested: 08/05/2023
Job Reference: 29406946
Site Location: 476022 383761
Requested by:
Mr Ben Evans
Your Scheme/Reference:
LM 203570/DK - 9

Exact Scales:
1:1250 Area or Circle dig site
1:500 Line dig site

Crown Copyright © All Rights Reserved. Ordnance Survey Licence numbers: 100022432
NGED Copyright: This copy has been made by or with the authority of National Grid Electricity Distribution (NGED) pursuant to Section 47 of the Copyright Designs and Patents Act 1988 unless that Act provides a relevant exception to copyright the copy must not be copied without the prior permission of the copyright owner.



Warning: PDF designed for colour print only with no page scaling.

nationalgrid Electricity Distribution

Contact Us

Mapping Enquiries:
All areas 0121 623 9780

General Enquiries:
All areas 0800 096 3080

Date Requested: 08/05/2023
Job Reference: 29406946
Site Location: 476022 383761
Requested by:
Mr Ben Evans
Your Scheme/Reference:
LM 203570/DK - 9

Exact Scales:
1:1250 Area or Circle dig site
1:500 Line dig site


Link Box ●	Overhead Line ○—○ PL ○—○ Service ○—○ LV ○—○ HV (11kV) ○—○ HV (33kV) ○—○ HV (66kV) ○—○ HV (132kV)	Underground Cable -	National Grid Telecoms - - - - - PME Earth -E- - - - - Underground Earth	Pilot Cables - - - - - ○ Pole Mounted Transformer □ Ground Mounted Transformer
----------------------	--	---	---	--

IMPORTANT NOTICES

- This information is given as a guide only and its accuracy cannot be guaranteed. Services or recent additions to the network may not be shown.
- Cables, overhead lines & substations owned by other electricity network owners or private companies may be present and may not be shown.
- You should always verify exact locations of cables using a cable locator and by careful use of hand tools in accordance with HSE guidance note HSG47.
- When working within 10m of any overhead electric line you should follow the requirements of HSE Guidance Note GS6.
- For further advice on working near our electricity cables or lines, call our General Enquiries number.
- Advice should be sought from the National Grid Electricity Distribution General Enquiries team for any work that is to take place in proximity to 132kV underground cables and 132kV overhead lines.

Report damage immediately – KEEP EVERYONE AWAY FROM THE AREA
0800 6783 105

Crown Copyright © All Rights Reserved. Ordnance Survey Licence numbers: 100022432
NGED Copyright: This copy has been made by or with the authority of National Grid Electricity Distribution (NGED) pursuant to Section 47 of the Copyright Designs and Patents Act 1988 unless that Act provides a relevant exception to copyright the copy must not be copied without the prior permission of the copyright owner.

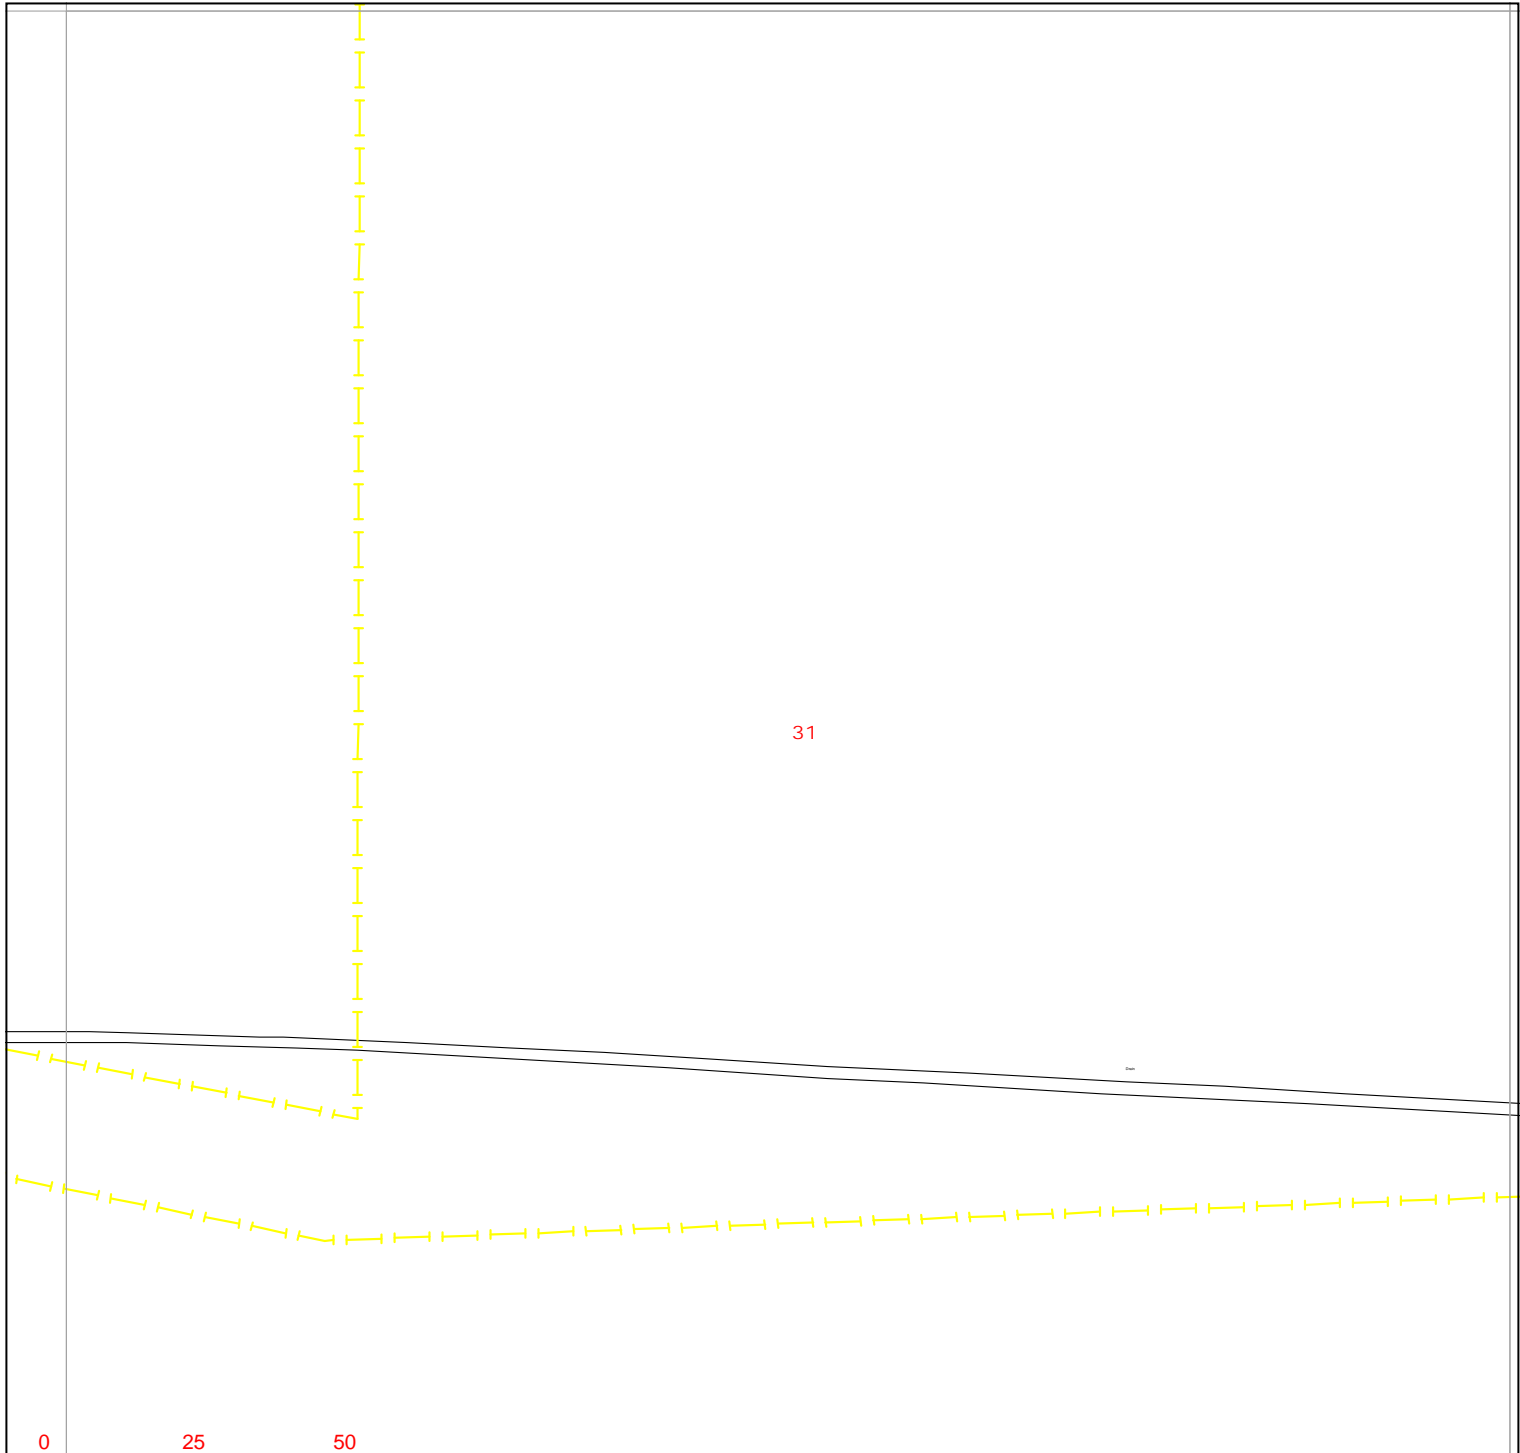

Warning: PDF designed for colour print only with no page scaling.



Contact Us
Mapping Enquiries:
 All areas 0121 623 9780
General Enquiries:
 All areas 0800 096 3080

Date Requested: 08/05/2023
 Job Reference: 29406946
 Site Location: 476022 383761
 Requested by:
 Mr Ben Evans
 Your Scheme/Reference:
 LM 203570/DK - 9

Exact Scales:
 1:1250 Area or Circle dig site
 1:500 Line dig site

Link Box	Overhead Line	Underground Cable	National Grid Telecoms	Pilot Cables
●				
●	Site Location Line/Area			


IMPORTANT NOTICES

- This information is given as a guide only and its accuracy cannot be guaranteed. Services or recent additions to the network may not be shown.
- Cables, overhead lines & substations owned by other electricity network owners or private companies may be present and may not be shown.
- You should always verify exact locations of cables using a cable locator and by careful use of hand tools in accordance with HSE guidance note HSG47.
- When working within 10m of any overhead electric line you should follow the requirements of HSE Guidance Note GS6.
- For further advice on working near our electricity cables or lines, call our General Enquiries number.
- Advice should be sought from the National Grid Electricity Distribution General Enquiries team for any work that is to take place in proximity to 132kV underground cables and 132kV overhead lines.

Report damage immediately – KEEP EVERYONE AWAY FROM THE AREA
0800 6783 105

Crown Copyright © All Rights Reserved. Ordnance Survey Licence numbers: 100022432
 NGED Copyright: This copy has been made by or with the authority of National Grid Electricity Distribution (NGED) pursuant to Section 47 of the Copyright Designs and Patents Act 1988 unless that Act provides a relevant exception to copyright the copy must not be copied without the prior permission of the copyright owner.

32

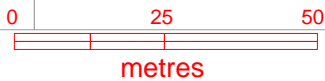

Warning: PDF designed for colour print only with no page scaling.




Contact Us

Mapping Enquiries:
All areas 0121 623 9780

General Enquiries:
All areas 0800 096 3080

Date Requested: 08/05/2023
Job Reference: 29406946
Site Location: 476022 383761
Requested by:
Mr Ben Evans
Your Scheme/Reference:
LM 203570/DK - 9

Exact Scales:
1:1250 Area or Circle dig site
1:500 Line dig site

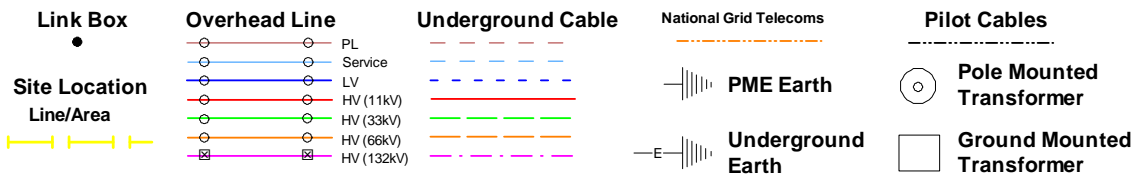


IMPORTANT NOTICES

- This information is given as a guide only and its accuracy cannot be guaranteed. Services or recent additions to the network may not be shown.
- Cables, overhead lines & substations owned by other electricity network owners or private companies may be present and may not be shown.
- You should always verify exact locations of cables using a cable locator and by careful use of hand tools in accordance with HSE guidance note HSG47.
- When working within 10m of any overhead electric line you should follow the requirements of HSE Guidance Note GS6.
- For further advice on working near our electricity cables or lines, call our General Enquiries number.
- Advice should be sought from the National Grid Electricity Distribution General Enquiries team for any work that is to take place in proximity to 132kV underground cables and 132kV overhead lines.

Report damage immediately – KEEP EVERYONE AWAY FROM THE AREA
0800 6783 105

Crown Copyright © All Rights Reserved. Ordnance Survey Licence numbers: 100022432
NGED Copyright: This copy has been made by or with the authority of National Grid Electricity Distribution (NGED) pursuant to Section 47 of the Copyright Designs and Patents Act 1988 unless that Act provides a relevant exception to copyright the copy must not be copied without the prior permission of the copyright owner.

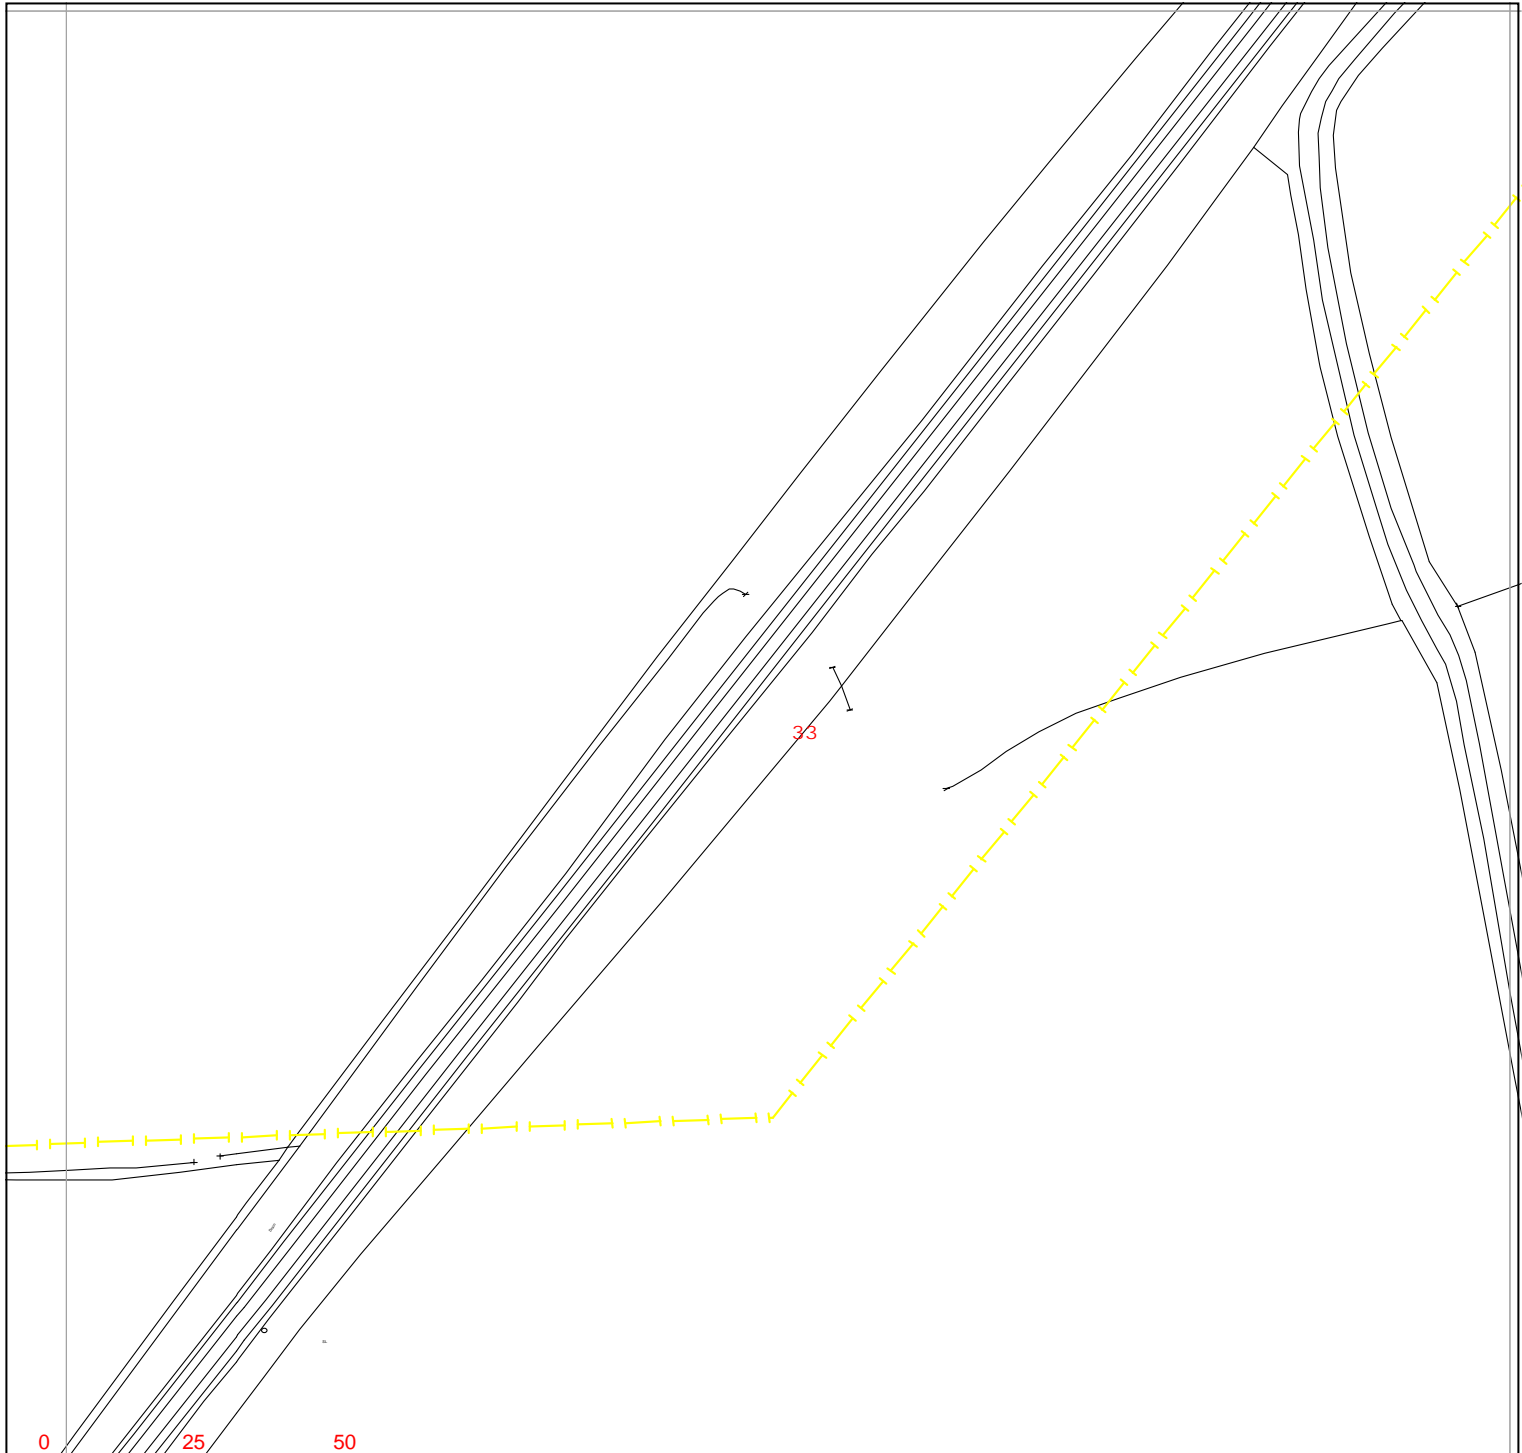

Warning: PDF designed for colour print only with no page scaling.



Contact Us

Mapping Enquiries:
All areas 0121 623 9780

General Enquiries:
All areas 0800 096 3080

Date Requested: 08/05/2023
Job Reference: 29406946
Site Location: 476022 383761
Requested by:
Mr Ben Evans
Your Scheme/Reference:
LM 203570/DK - 9

Exact Scales:
1:1250 Area or Circle dig site
1:500 Line dig site

Link Box	Overhead Line	Underground Cable	National Grid Telecoms	Pilot Cables
●	<ul style="list-style-type: none"> ○ PL ○ Service ○ LV ○ HV (11kV) ○ HV (33kV) ○ HV (66kV) ○ HV (132kV) 	<ul style="list-style-type: none"> --- --- --- --- --- --- --- 	<ul style="list-style-type: none"> --- PME Earth ---E Underground Earth 	<ul style="list-style-type: none"> ○ Pole Mounted Transformer □ Ground Mounted Transformer
Site Location Line/Area	<ul style="list-style-type: none"> --- --- --- --- --- --- --- 			

IMPORTANT NOTICES

- This information is given as a guide only and its accuracy cannot be guaranteed. Services or recent additions to the network may not be shown.
- Cables, overhead lines & substations owned by other electricity network owners or private companies may be present and may not be shown.
- You should always verify exact locations of cables using a cable locator and by careful use of hand tools in accordance with HSE guidance note HSG47.
- When working within 10m of any overhead electric line you should follow the requirements of HSE Guidance Note GS6.
- For further advice on working near our electricity cables or lines, call our General Enquiries number.
- Advice should be sought from the National Grid Electricity Distribution General Enquiries team for any work that is to take place in proximity to 132kV underground cables and 132kV overhead lines.

Report damage immediately – KEEP EVERYONE AWAY FROM THE AREA
0800 6783 105

Crown Copyright © All Rights Reserved. Ordnance Survey Licence numbers: 100022432
NGED Copyright: This copy has been made by or with the authority of National Grid Electricity Distribution (NGED) pursuant to Section 47 of the Copyright Designs and Patents Act 1988 unless that Act provides a relevant exception to copyright the copy must not be copied without the prior permission of the copyright owner.



Warning: PDF designed for colour print only with no page scaling.

nationalgrid Electricity Distribution

Contact Us

Mapping Enquiries:
All areas 0121 623 9780

General Enquiries:
All areas 0800 096 3080

Date Requested: 08/05/2023
Job Reference: 29406946
Site Location: 476022 383761
Requested by:
Mr Ben Evans
Your Scheme/Reference:
LM 203570/DK - 9

Exact Scales:
1:1250 Area or Circle dig site
1:500 Line dig site


Link Box ●	Overhead Line ○—○ PL ○—○ Service ○—○ LV ○—○ HV (11kV) ○—○ HV (33kV) ○—○ HV (66kV) □—□ HV (132kV)	Underground Cable -	National Grid Telecoms - - - - - PME Earth -E- - - - - Underground Earth	Pilot Cables ○ Pole Mounted Transformer □ Ground Mounted Transformer
----------------------	--	---	---	---

IMPORTANT NOTICES

- This information is given as a guide only and its accuracy cannot be guaranteed. Services or recent additions to the network may not be shown.
- Cables, overhead lines & substations owned by other electricity network owners or private companies may be present and may not be shown.
- You should always verify exact locations of cables using a cable locator and by careful use of hand tools in accordance with HSE guidance note HSG47.
- When working within 10m of any overhead electric line you should follow the requirements of HSE Guidance Note GS6.
- For further advice on working near our electricity cables or lines, call our General Enquiries number.
- Advice should be sought from the National Grid Electricity Distribution General Enquiries team for any work that is to take place in proximity to 132kV underground cables and 132kV overhead lines.

Report damage immediately – KEEP EVERYONE AWAY FROM THE AREA
0800 6783 105

Crown Copyright © All Rights Reserved. Ordnance Survey Licence numbers: 100022432
NGED Copyright: This copy has been made by or with the authority of National Grid Electricity Distribution (NGED) pursuant to Section 47 of the Copyright Designs and Patents Act 1988 unless that Act provides a relevant exception to copyright the copy must not be copied without the prior permission of the copyright owner.

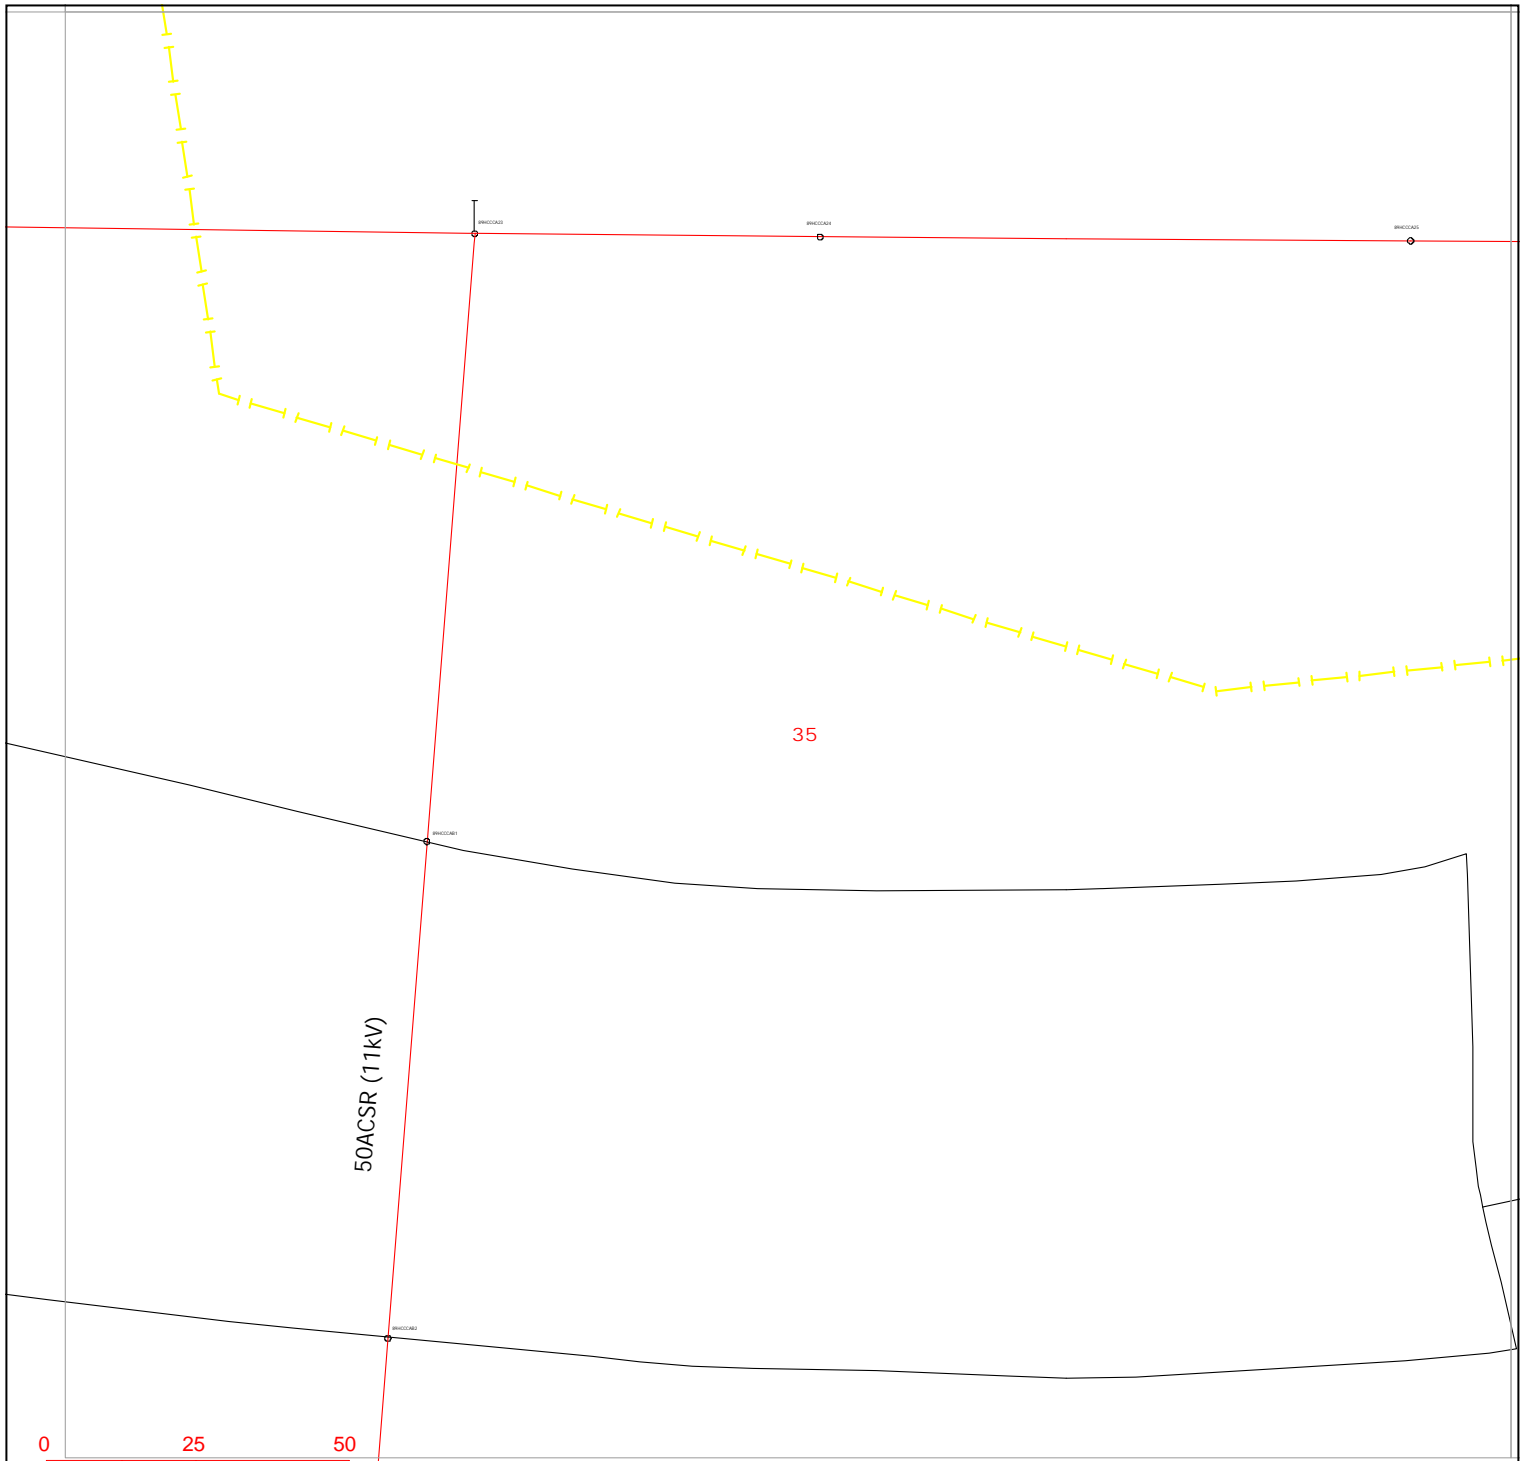

Warning: PDF designed for colour print only with no page scaling.

nationalgrid Electricity Distribution

Contact Us

Mapping Enquiries:
All areas 0121 623 9780

General Enquiries:
All areas 0800 096 3080

Date Requested: 08/05/2023
Job Reference: 29406946
Site Location: 476022 383761
Requested by:
Mr Ben Evans
Your Scheme/Reference:
LM 203570/DK - 9

Exact Scales:
1:1250 Area or Circle dig site
1:500 Line dig site


Link Box	Overhead Line	Underground Cable	National Grid Telecoms	Pilot Cables
●	<ul style="list-style-type: none"> ○ PL ○ Service ○ LV ○ HV (11kV) ○ HV (33kV) ○ HV (66kV) ○ HV (132kV) 	<ul style="list-style-type: none"> --- --- --- --- --- --- --- 	<ul style="list-style-type: none"> —E— PME Earth —E— Underground Earth 	<ul style="list-style-type: none"> ○ Pole Mounted Transformer □ Ground Mounted Transformer
Site Location Line/Area	<ul style="list-style-type: none"> — — — — — — — 			

IMPORTANT NOTICES

- This information is given as a guide only and its accuracy cannot be guaranteed. Services or recent additions to the network may not be shown.
- Cables, overhead lines & substations owned by other electricity network owners or private companies may be present and may not be shown.
- You should always verify exact locations of cables using a cable locator and by careful use of hand tools in accordance with HSE guidance note HSG47.
- When working within 10m of any overhead electric line you should follow the requirements of HSE Guidance Note GS6.
- For further advice on working near our electricity cables or lines, call our General Enquiries number.
- Advice should be sought from the National Grid Electricity Distribution General Enquiries team for any work that is to take place in proximity to 132kV underground cables and 132kV overhead lines.

Report damage immediately – KEEP EVERYONE AWAY FROM THE AREA
0800 6783 105

Crown Copyright © All Rights Reserved. Ordnance Survey Licence numbers: 100022432
NGED Copyright: This copy has been made by or with the authority of National Grid Electricity Distribution (NGED) pursuant to Section 47 of the Copyright Designs and Patents Act 1988 unless that Act provides a relevant exception to copyright the copy must not be copied without the prior permission of the copyright owner.

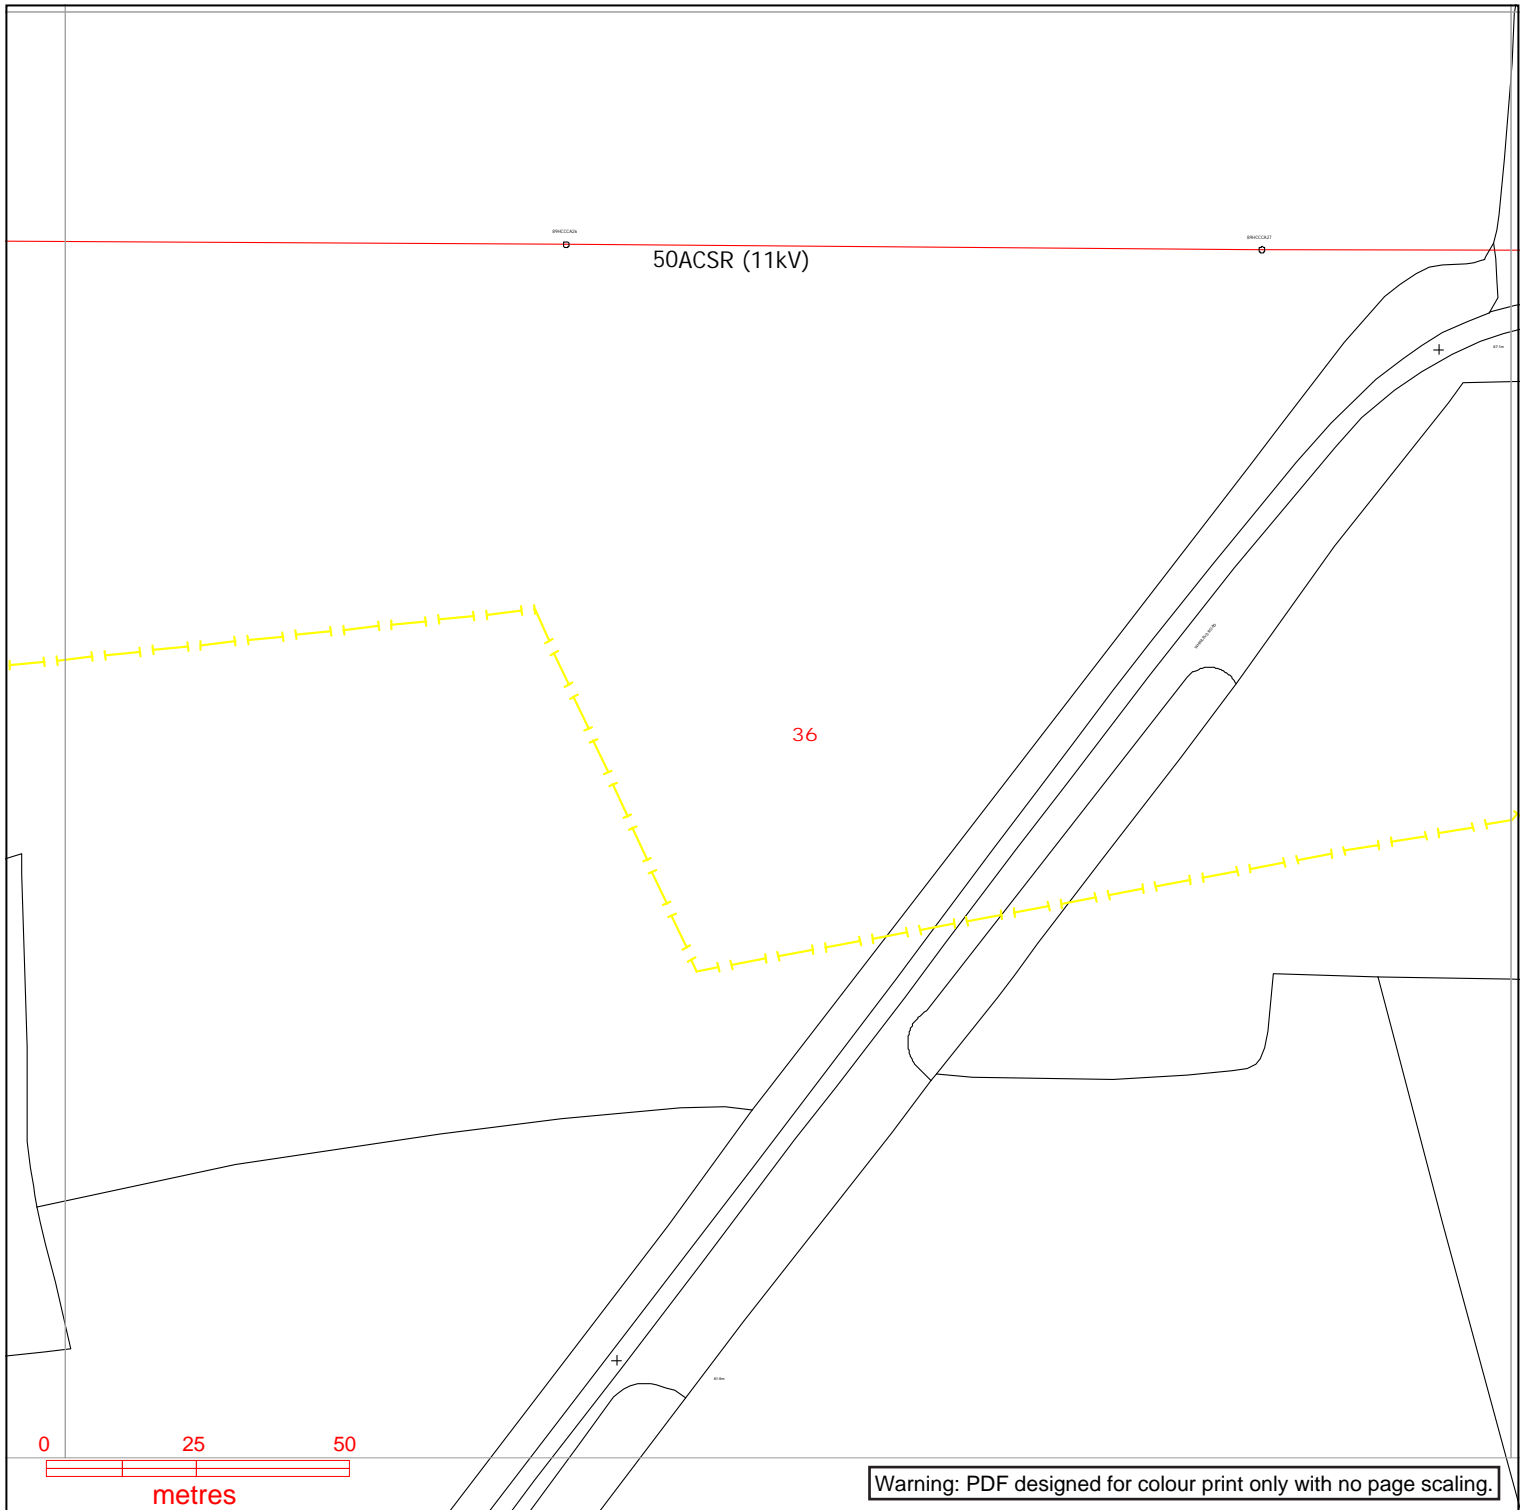

nationalgrid Electricity Distribution

Contact Us

Mapping Enquiries:
All areas 0121 623 9780

General Enquiries:
All areas 0800 096 3080

Date Requested: 08/05/2023
Job Reference: 29406946
Site Location: 476022 383761
Requested by:
Mr Ben Evans
Your Scheme/Reference:
LM 203570/DK - 9

Exact Scales:
1:1250 Area or Circle dig site
1:500 Line dig site


Link Box	Overhead Line	Underground Cable	National Grid Telecoms	Pilot Cables
●	<ul style="list-style-type: none"> ○ PL ○ Service ○ LV ○ HV (11kV) ○ HV (33kV) ○ HV (66kV) ○ HV (132kV) 	<ul style="list-style-type: none"> --- --- --- --- --- --- --- 	<ul style="list-style-type: none"> --- PME Earth ---E Underground Earth 	<ul style="list-style-type: none"> ○ Pole Mounted Transformer □ Ground Mounted Transformer
Site Location Line/Area	<ul style="list-style-type: none"> --- (Yellow dashed line) 			

IMPORTANT NOTICES

- This information is given as a guide only and its accuracy cannot be guaranteed. Services or recent additions to the network may not be shown.
- Cables, overhead lines & substations owned by other electricity network owners or private companies may be present and may not be shown.
- You should always verify exact locations of cables using a cable locator and by careful use of hand tools in accordance with HSE guidance note HSG47.
- When working within 10m of any overhead electric line you should follow the requirements of HSE Guidance Note GS6.
- For further advice on working near our electricity cables or lines, call our General Enquiries number.
- Advice should be sought from the National Grid Electricity Distribution General Enquiries team for any work that is to take place in proximity to 132kV underground cables and 132kV overhead lines.

Report damage immediately – KEEP EVERYONE AWAY FROM THE AREA
0800 6783 105

Crown Copyright © All Rights Reserved. Ordnance Survey Licence numbers: 100022432
NGED Copyright: This copy has been made by or with the authority of National Grid Electricity Distribution (NGED) pursuant to Section 47 of the Copyright Designs and Patents Act 1988 unless that Act provides a relevant exception to copyright the copy must not be copied without the prior permission of the copyright owner.

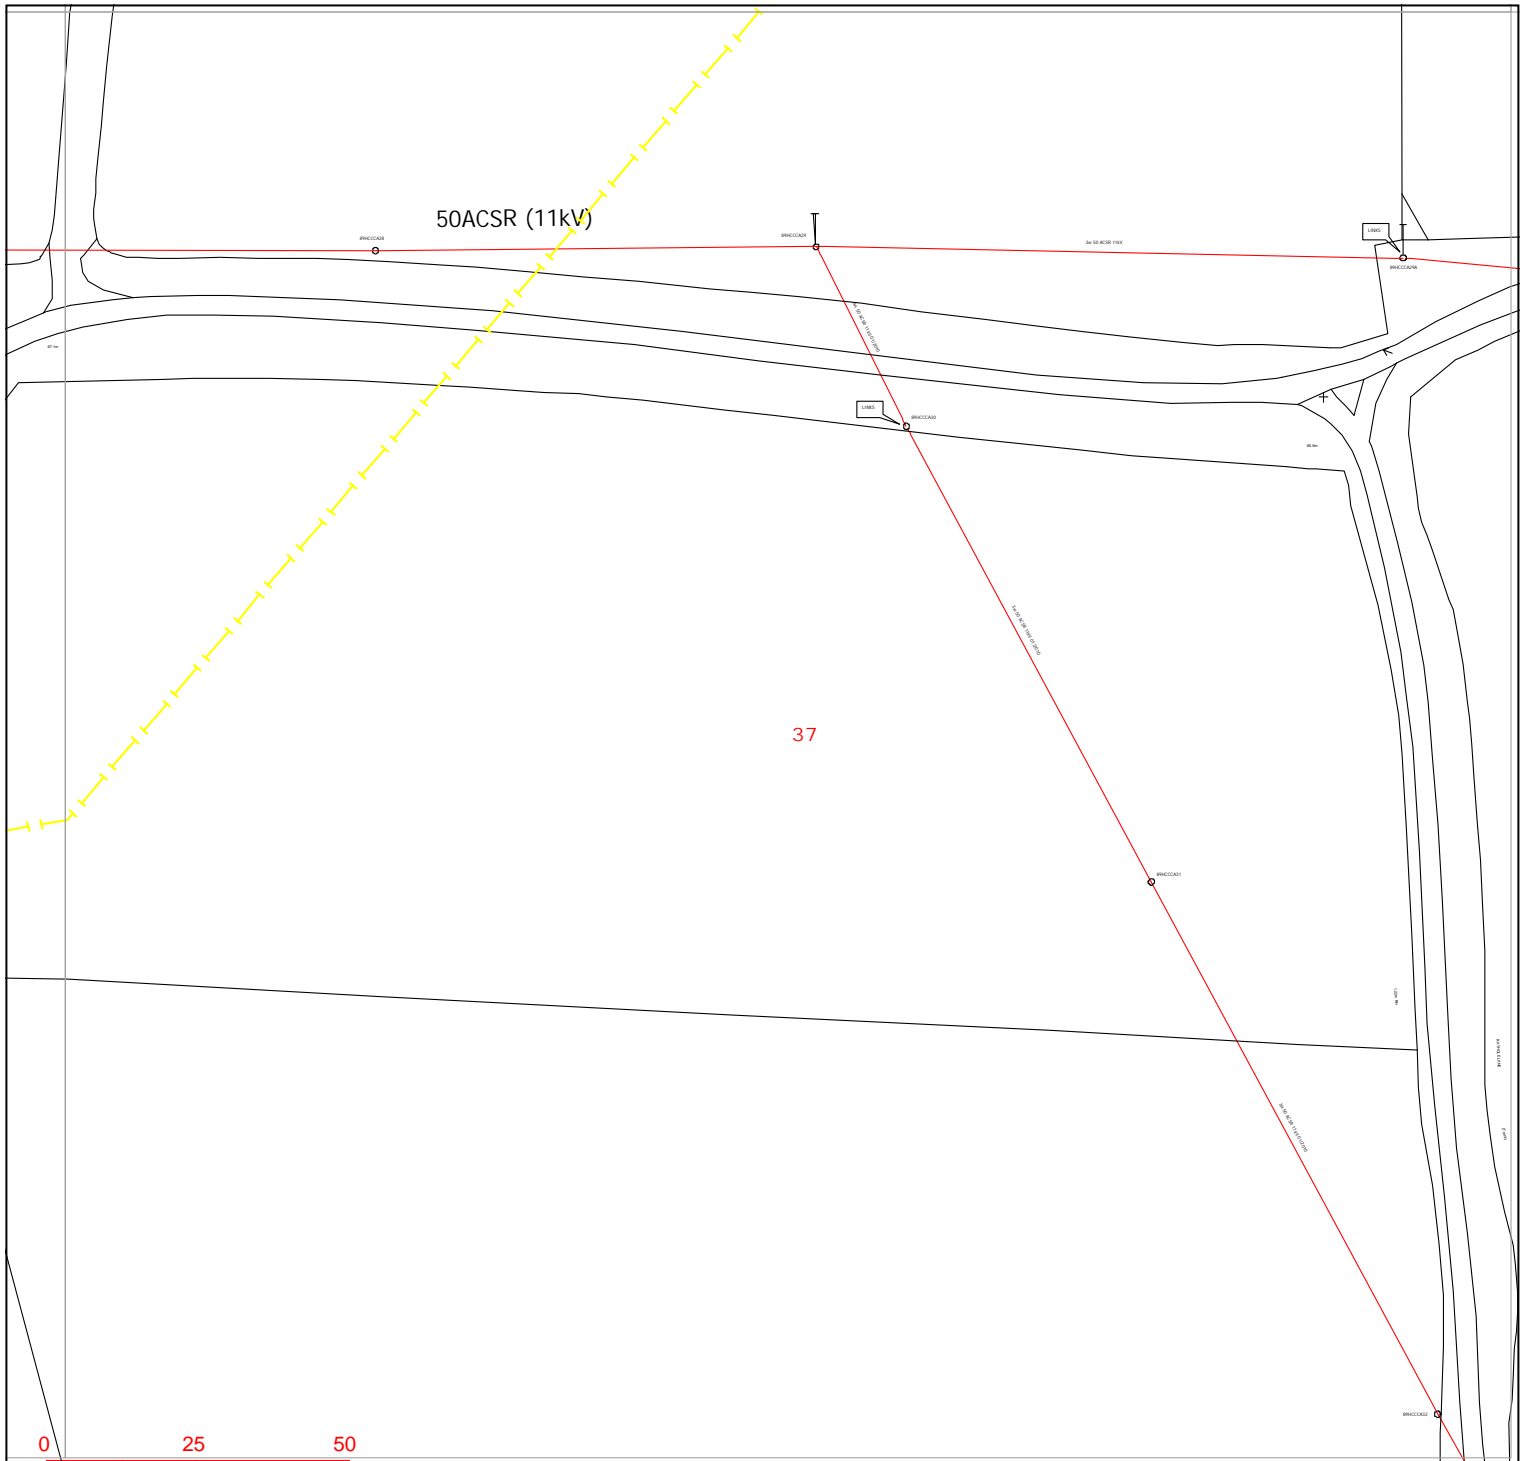

Warning: PDF designed for colour print only with no page scaling.

nationalgrid Electricity Distribution

Contact Us

Mapping Enquiries:
All areas 0121 623 9780

General Enquiries:
All areas 0800 096 3080

Date Requested: 08/05/2023
Job Reference: 29406946
Site Location: 476022 383761
Requested by:
Mr Ben Evans
Your Scheme/Reference:
LM 203570/DK - 9

Exact Scales:
1:1250 Area or Circle dig site
1:500 Line dig site


Link Box	Overhead Line	Underground Cable	National Grid Telecoms	Pilot Cables
●	○ PL ○ Service ○ LV ○ HV (11kV) ○ HV (33kV) ○ HV (66kV) ○ HV (132kV)	---	--- PME Earth ---E Underground Earth	○ Pole Mounted Transformer □ Ground Mounted Transformer

IMPORTANT NOTICES

- This information is given as a guide only and its accuracy cannot be guaranteed. Services or recent additions to the network may not be shown.
- Cables, overhead lines & substations owned by other electricity network owners or private companies may be present and may not be shown.
- You should always verify exact locations of cables using a cable locator and by careful use of hand tools in accordance with HSE guidance note HSG47.
- When working within 10m of any overhead electric line you should follow the requirements of HSE Guidance Note GS6.
- For further advice on working near our electricity cables or lines, call our General Enquiries number.
- Advice should be sought from the National Grid Electricity Distribution General Enquiries team for any work that is to take place in proximity to 132kV underground cables and 132kV overhead lines.

Report damage immediately – KEEP EVERYONE AWAY FROM THE AREA
0800 6783 105

Crown Copyright © All Rights Reserved. Ordnance Survey Licence numbers: 100022432
NGED Copyright: This copy has been made by or with the authority of National Grid Electricity Distribution (NGED) pursuant to Section 47 of the Copyright Designs and Patents Act 1988 unless that Act provides a relevant exception to copyright the copy must not be copied without the prior permission of the copyright owner.

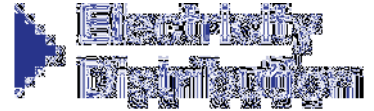

Our Ref: 29406948 Your Ref: LM 203570/DK - 10

Monday, 08 May 2023

Ben Evans
The Hub, 500 Park Avenue, Aztec West
Almondsbury
Bristol
BS32 4RZ

**National Grid Electricity
Distribution**
Mapping Centre
Toll End Road
Tipton
West Midlands
United Kingdom
DY4 0HH
www.nationalgrid.co.uk

Dear Ben Evans

Thank you for your enquiry dated Monday, 08 May 2023

I now enclose a copy of our plan showing existing National Grid Electricity Distribution (NGED) Electricity / National Grid Telecoms (NGT) apparatus in the vicinity of your proposed works. This information is given as a general guide only and its accuracy cannot be guaranteed. Please note that all NGED equipment on site should be assumed to be LIVE until NGED prove otherwise and provide you with confirmation to this effect in writing. Recent additions to our network, or service connections between the main cable and a building or street lamp may not be shown.

Map Response
T 0121 623 9780
NGED.MapResponse
@nationalgrid.co.uk

Damage to underground cables and contact with overhead lines can cause severe injury or may prove fatal. If you are excavating on site in the vicinity of either NGED Electrical apparatus or NGT Telecoms apparatus you must comply with the requirements of the following:-

Health & Safety Executive guidance HS(G)47, Avoiding Danger from underground services.

Work taking place in the vicinity of our plant is also regulated under the:-

Electricity at Work Regulations 1989, Health and Safety Act 1974, CDM Regulations 2015.
Safe working procedures should be defined and practiced

Please ensure that the use of mechanical excavators in the vicinity of our plant is kept to a minimum. NGT Telecoms ducts contain fibre cables, which are expensive to repair. Therefore, extreme care must be taken whilst working in the vicinity of these ducts, hand digging methods being used to determine their precise position.

If there are overhead lines crossing your site and your proposal involves building works which may infringe the clearance to our overhead system then you should call the relevant general enquiries number (see page 2 of this letter) for advice. Where overhead lines cross your site you must comply with the requirements of Health & Safety Executive guidance as laid down in GS6, Avoidance of Danger from Overhead Electric Lines.

National Grid Electricity
Distribution
South West - 02366894
South Wales - 02366985
East Midlands - 02366923
West Midlands - 03600574

Where diversions to NGED apparatus are needed to allow change to occur on site, the cost of these alterations may be charged to the persons responsible for the works.

If you require advice in connection with your proposals please contact the relevant general enquiries number (see page 2 of this letter)

Registered in
England and Wales


Following consultation the local NGED team will where necessary prepare detailed proposals and provide a quotation for any necessary alterations and/or development of our equipment on the site.

Registered Office:
Avonbank
Feeder Road
Bristol
BS2 0TB

This information is given as a guide only and its accuracy cannot be guaranteed. This plan is based on data from our Geographic Information System, which is updated every 24 hours to reflect changes to our network. The information contained in this plan reflects the most recent network GIS data, however changes to the network (including network additions and new service

Safety Documents:

<https://www.nationalgrid.co.uk/customers-and-community/health-safety/public-safety-advice>

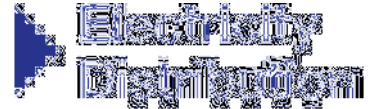

connections) may not be shown. You are advised to obtain an up to date plan on the date of commencing on-site works.

Yours sincerely
NGED Map Response Team

Contact Us

Emergency or Power Supply issues

In an emergency call 105, 24 hours a day.

Mapping Enquiries

If you have an enquiry relating to this letter or the attached map plan, please contact us using the following information:

Telephone 0121 623 9780
Email NGED.MapResponse@nationalgrid.co.uk

General Enquiries


If you have a general enquiry, please call us on the following telephone number:

All areas 0800 096 3080

LSBUD

If you have an enquiry relating to the use of the LSBUD website please contact LSBUD using the following information:

Telephone 0345 437 7365
Email enquiries@LSBUD.co.uk
Website www.LSBUD.co.uk

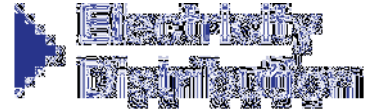


Steps to help keep you safe

- **If you are working within 10 metres of our 33kV, 66kV, 132kV underground electricity cables or within 10 meters of an overhead electricity line you should call the relevant General Enquiries for free safety advice.**

Safety Documents – please download our informative safety documents to help ensure that you, your staff and the public are kept safe whilst working in the vicinity of electricity.

<https://www.nationalgrid.co.uk/customers-and-community/health-safety/public-safety-advice>

- **Make sure you have up to date plans** - remember that recent additions to our network or service connections between the main cable and a building or street lamp may not be shown.
- **Look for signs of service cables** - an electricity meter box or nearby streetlamp may give you an indication that service cables are present in your area of work.
- **Non NGED Network** - electricity cables, lines and equipment owned by others may also be present in addition to NGED network. They are unlikely to be shown on our plans.
- **Use a cable locator** - trace electricity cables and mark the position of them using paint or other waterproof marking on the ground.
- **Hand dig trial holes** - to confirm the position of cables in close proximity to your area of your work and use spades and shovels rather than picks, pins or forks.
- **Have an emergency plan** - so that everyone working on site understands what to do in the event of an underground electricity cable being damaged or contact being made with an overhead electricity line.
- **If you are working within 10 meters** of an overhead electricity line then it may be necessary for you to erect warning signs and markers, or height restriction goal posts. Ensure that you comply with the requirements of Health & Safety Executive guidance laid down in GS6, Avoidance of Danger from Overhead Electric Lines.
- **If you are erecting a structure** that could allow anyone standing on it, or its access device (ladder, scaffold, MEWP), to come within 3m of any overhead electric line then **you must inform us**. This is your duty and a legal requirement under the Electricity Safety, Quality & Continuity Regulations 2002.
- **If you cannot work safely** around the underground electricity cable or overhead electricity line, then you may need to get it moved to allow your works to go ahead. Call the general enquiry numbers above for guidance.
- **It is possible that cables or pipes may be embedded in concrete** - electricity cables embedded in concrete **MUST** be made 'dead' by Western Power Distribution or the cable owner before the concrete is broken out. Alternatively, another safe way of working should be agreed.
- **Cables are sometimes covered by tiles or a marker tape** - these can be concrete, polythene or earthenware and are a useful early warning of the presence of cables; you should avoid disturbing any tiles or tape to expose the cable. Not all cables have these warning indicators.

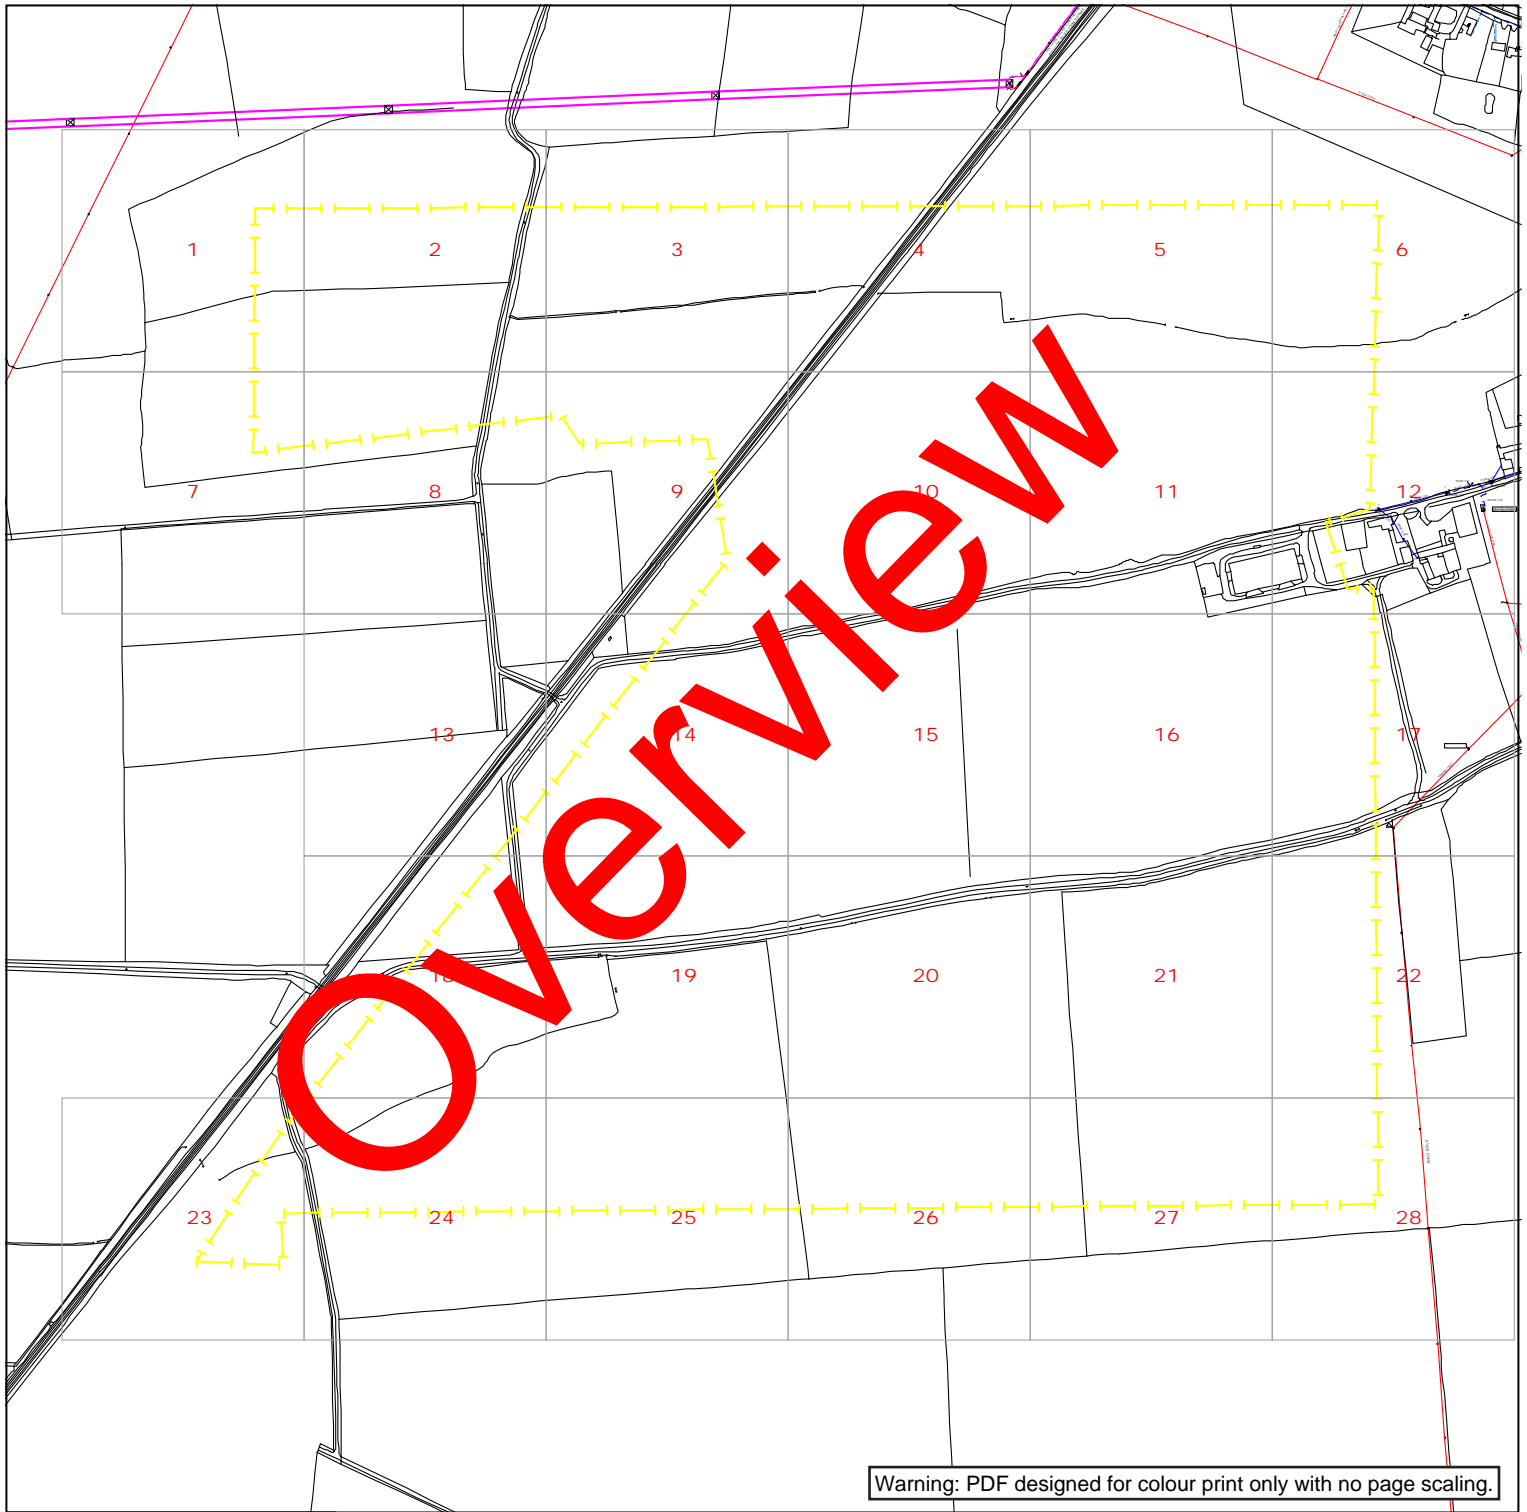

Warning: PDF designed for colour print only with no page scaling.

nationalgrid Electricity Distribution

Contact Us

Mapping Enquiries:
All areas 0121 623 9780

General Enquiries:
All areas 0800 096 3080

Date Requested: 08/05/2023
Job Reference: 29406948
Site Location: 477674 383832
Requested by:
Mr Ben Evans
Your Scheme/Reference:
LM 203570/DK - 10


Link Box	Overhead Line	Underground Cable	National Grid Telecoms	Pilot Cables
●	○ PL ○ Service ○ LV ○ HV (11kV) ○ HV (33kV) ○ HV (66kV) ○ HV (132kV)	---	--- PME Earth ---E Underground Earth	○ Pole Mounted Transformer □ Ground Mounted Transformer
Site Location Line/Area	--- (various colors)	---		

IMPORTANT NOTICES

- This information is given as a guide only and its accuracy cannot be guaranteed. Services or recent additions to the network may not be shown.
- Cables, overhead lines & substations owned by other electricity network owners or private companies may be present and may not be shown.
- You should always verify exact locations of cables using a cable locator and by careful use of hand tools in accordance with HSE guidance note HSG47.
- When working within 10m of any overhead electric line you should follow the requirements of HSE Guidance Note GS6.
- For further advice on working near our electricity cables or lines, call our General Enquiries number.
- Advice should be sought from the National Grid Electricity Distribution General Enquiries team for any work that is to take place in proximity to 132kV underground cables and 132kV overhead lines.

Report damage immediately – KEEP EVERYONE AWAY FROM THE AREA
0800 6783 105

Crown Copyright © All Rights Reserved. Ordnance Survey Licence numbers: 100022432
NGED Copyright: This copy has been made by or with the authority of National Grid Electricity Distribution (NGED) pursuant to Section 47 of the Copyright Designs and Patents Act 1988 unless that Act provides a relevant exception to copyright the copy must not be copied without the prior permission of the copyright owner.

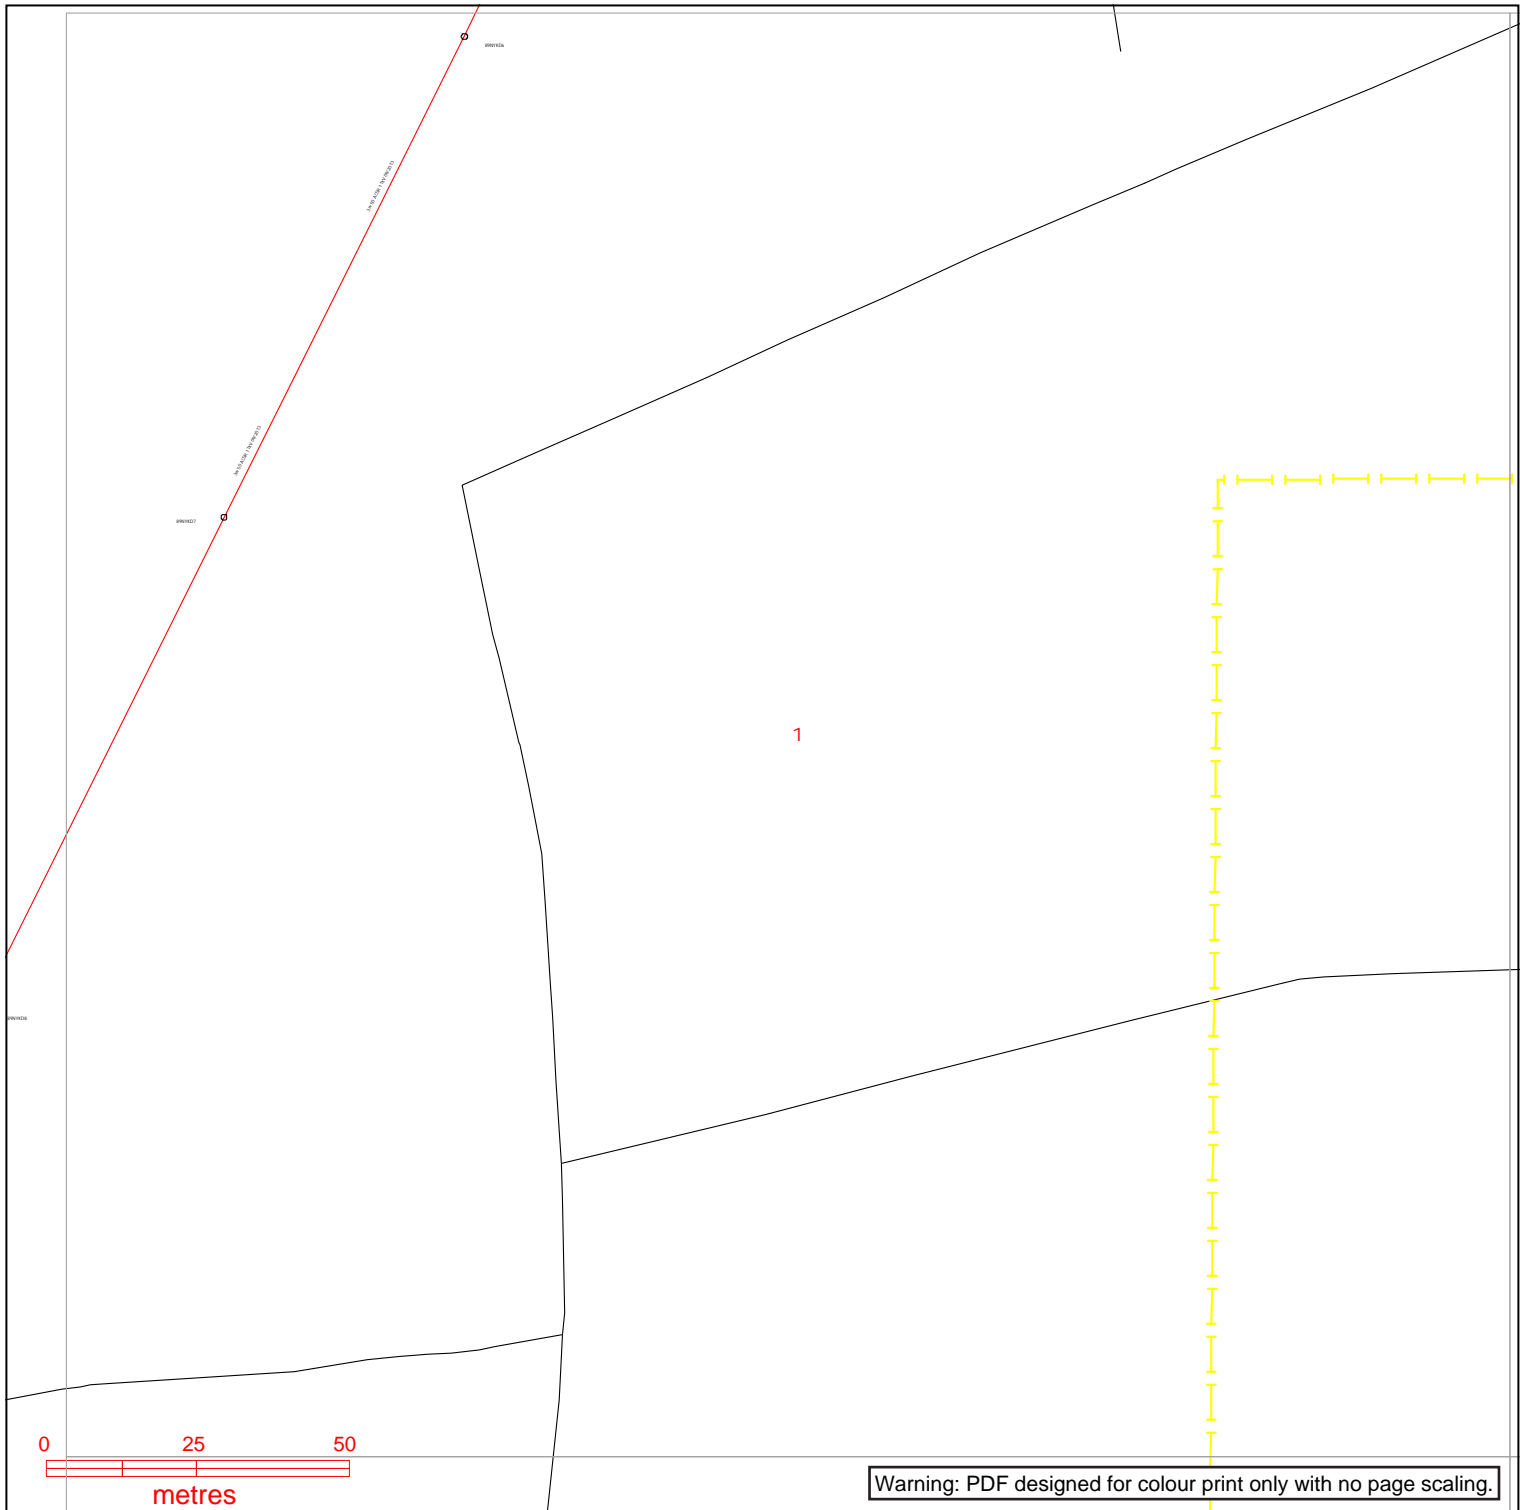

Warning: PDF designed for colour print only with no page scaling.

nationalgrid Electricity Distribution

Contact Us

Mapping Enquiries:
All areas 0121 623 9780

General Enquiries:
All areas 0800 096 3080

Date Requested: 08/05/2023
Job Reference: 29406948
Site Location: 477674 383832
Requested by:
Mr Ben Evans
Your Scheme/Reference:
LM 203570/DK - 10

Exact Scales:
1:1250 Area or Circle dig site
1:500 Line dig site


Link Box	Overhead Line	Underground Cable	National Grid Telecoms	Pilot Cables
●	○ PL ○ Service ○ LV ○ HV (11kV) ○ HV (33kV) ○ HV (66kV) ○ HV (132kV)	---	--- PME Earth ---E Underground Earth	○ Pole Mounted Transformer □ Ground Mounted Transformer
Site Location Line/Area	--- --- --- --- --- --- ---	---		---

IMPORTANT NOTICES

- This information is given as a guide only and its accuracy cannot be guaranteed. Services or recent additions to the network may not be shown.
- Cables, overhead lines & substations owned by other electricity network owners or private companies may be present and may not be shown.
- You should always verify exact locations of cables using a cable locator and by careful use of hand tools in accordance with HSE guidance note HSG47.
- When working within 10m of any overhead electric line you should follow the requirements of HSE Guidance Note GS6.
- For further advice on working near our electricity cables or lines, call our General Enquiries number.
- Advice should be sought from the National Grid Electricity Distribution General Enquiries team for any work that is to take place in proximity to 132kV underground cables and 132kV overhead lines.

Report damage immediately – KEEP EVERYONE AWAY FROM THE AREA
0800 6783 105

Crown Copyright © All Rights Reserved. Ordnance Survey Licence numbers: 100022432
NGED Copyright: This copy has been made by or with the authority of National Grid Electricity Distribution (NGED) pursuant to Section 47 of the Copyright Designs and Patents Act 1988 unless that Act provides a relevant exception to copyright the copy must not be copied without the prior permission of the copyright owner.

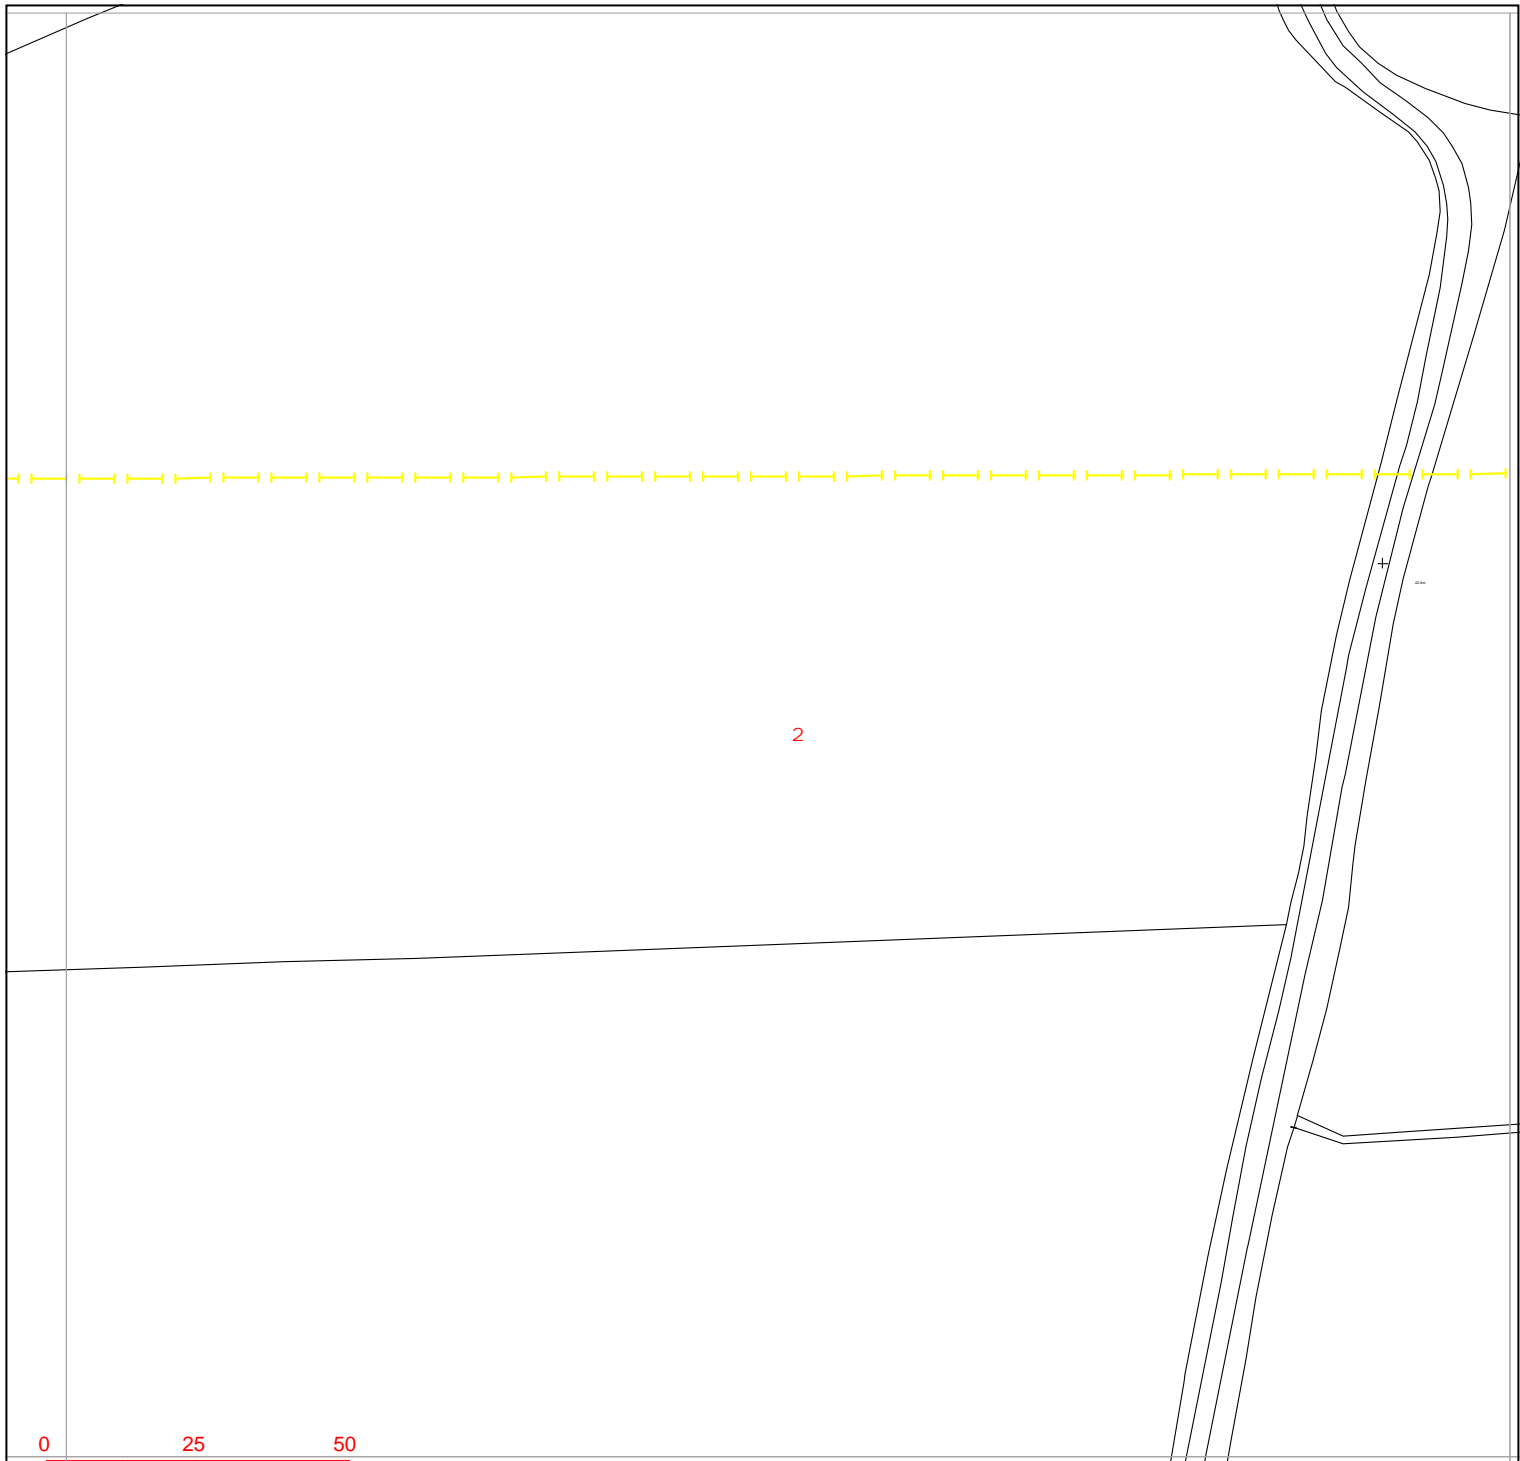

Warning: PDF designed for colour print only with no page scaling.



Contact Us
Mapping Enquiries:
 All areas 0121 623 9780
General Enquiries:
 All areas 0800 096 3080

Date Requested: 08/05/2023
 Job Reference: 29406948
 Site Location: 477674 383832
 Requested by:
 Mr Ben Evans
 Your Scheme/Reference:
 LM 203570/DK - 10

Exact Scales:
 1:1250 Area or Circle dig site
 1:500 Line dig site


<p>Link Box ●</p> <p>Site Location ○</p> <p>Line/Area —</p>	<p>Overhead Line</p> <ul style="list-style-type: none"> ○—○ PL ○—○ Service ○—○ LV ○—○ HV (11kV) ○—○ HV (33kV) ○—○ HV (66kV) ○—○ HV (132kV) 	<p>Underground Cable</p> <ul style="list-style-type: none"> --- PL --- Service --- LV --- HV (11kV) --- HV (33kV) --- HV (66kV) --- HV (132kV) 	<p>National Grid Telecoms</p> <ul style="list-style-type: none"> —E— PME Earth —E— Underground Earth 	<p>Pilot Cables</p> <ul style="list-style-type: none"> ○ Pole Mounted Transformer □ Ground Mounted Transformer
--	--	--	---	---

IMPORTANT NOTICES

- This information is given as a guide only and its accuracy cannot be guaranteed. Services or recent additions to the network may not be shown.
- Cables, overhead lines & substations owned by other electricity network owners or private companies may be present and may not be shown.
- You should always verify exact locations of cables using a cable locator and by careful use of hand tools in accordance with HSE guidance note HSG47.
- When working within 10m of any overhead electric line you should follow the requirements of HSE Guidance Note GS6.
- For further advice on working near our electricity cables or lines, call our General Enquiries number.
- Advice should be sought from the National Grid Electricity Distribution General Enquiries team for any work that is to take place in proximity to 132kV underground cables and 132kV overhead lines.

Report damage immediately – KEEP EVERYONE AWAY FROM THE AREA
0800 6783 105

Crown Copyright © All Rights Reserved. Ordnance Survey Licence numbers: 100022432
 NGED Copyright: This copy has been made by or with the authority of National Grid Electricity Distribution (NGED) pursuant to Section 47 of the Copyright Designs and Patents Act 1988 unless that Act provides a relevant exception to copyright the copy must not be copied without the prior permission of the copyright owner.

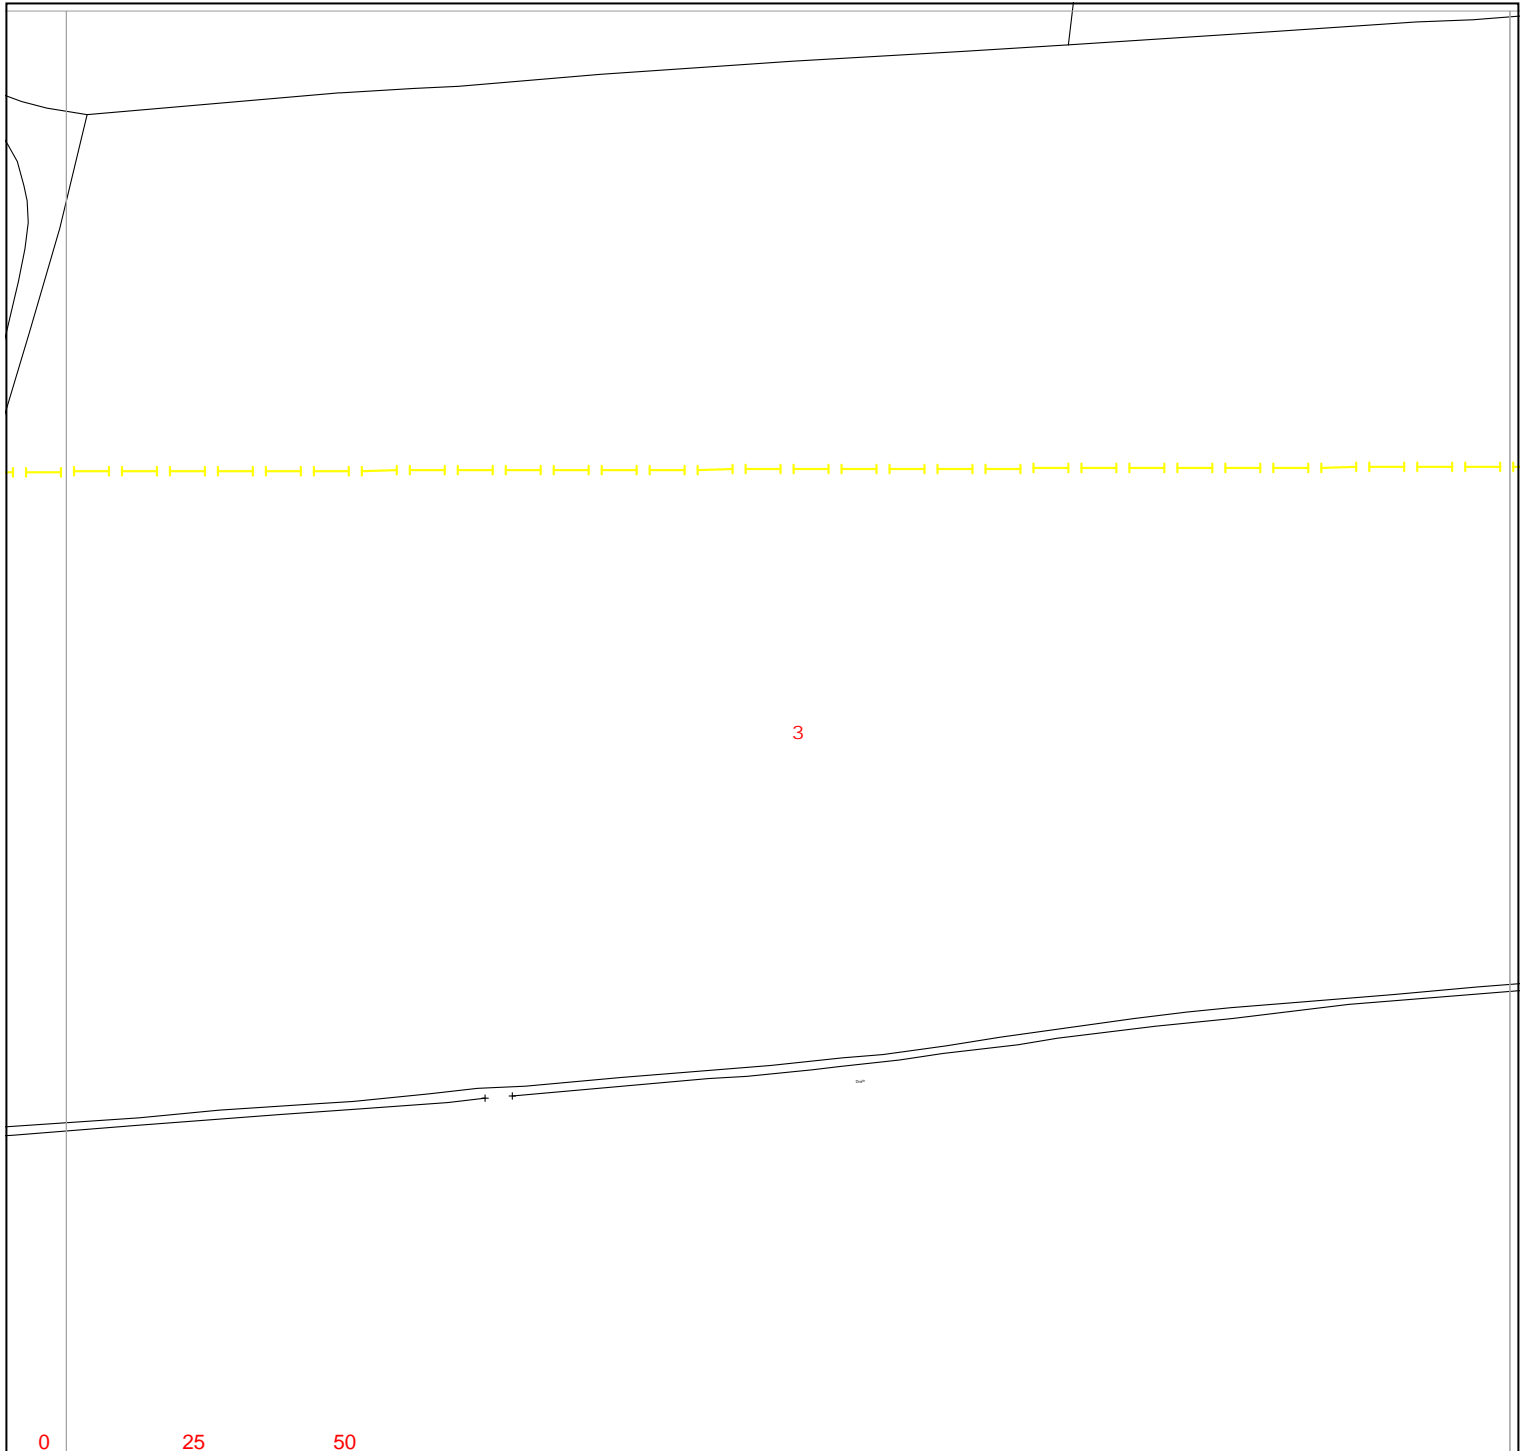

Warning: PDF designed for colour print only with no page scaling.



Link Box ●	Overhead Line ○—○ PL ○—○ Service ○—○ LV ○—○ HV (11kV) ○—○ HV (33kV) ○—○ HV (66kV) □—□ HV (132kV)	Underground Cable -	National Grid Telecoms - - - - - PME Earth Underground Earth	Pilot Cables ○ □ Pole Mounted Transformer Ground Mounted Transformer
----------------------	--	---	--	---

Contact Us

Mapping Enquiries:
All areas 0121 623 9780

General Enquiries:
All areas 0800 096 3080

Date Requested: 08/05/2023
 Job Reference: 29406948
 Site Location: 477674 383832
 Requested by:
 Mr Ben Evans
 Your Scheme/Reference:
 LM 203570/DK - 10


IMPORTANT NOTICES

- This information is given as a guide only and its accuracy cannot be guaranteed. Services or recent additions to the network may not be shown.
- Cables, overhead lines & substations owned by other electricity network owners or private companies may be present and may not be shown.
- You should always verify exact locations of cables using a cable locator and by careful use of hand tools in accordance with HSE guidance note HSG47.
- When working within 10m of any overhead electric line you should follow the requirements of HSE Guidance Note GS6.
- For further advice on working near our electricity cables or lines, call our General Enquiries number.
- Advice should be sought from the National Grid Electricity Distribution General Enquiries team for any work that is to take place in proximity to 132kV underground cables and 132kV overhead lines.

Report damage immediately – KEEP EVERYONE AWAY FROM THE AREA
0800 6783 105

Exact Scales:
 1:1250 Area or Circle dig site
 1:500 Line dig site

Crown Copyright © All Rights Reserved. Ordnance Survey Licence numbers: 100022432
 NGED Copyright: This copy has been made by or with the authority of National Grid Electricity Distribution (NGED) pursuant to Section 47 of the Copyright Designs and Patents Act 1988 unless that Act provides a relevant exception to copyright the copy must not be copied without the prior permission of the copyright owner.

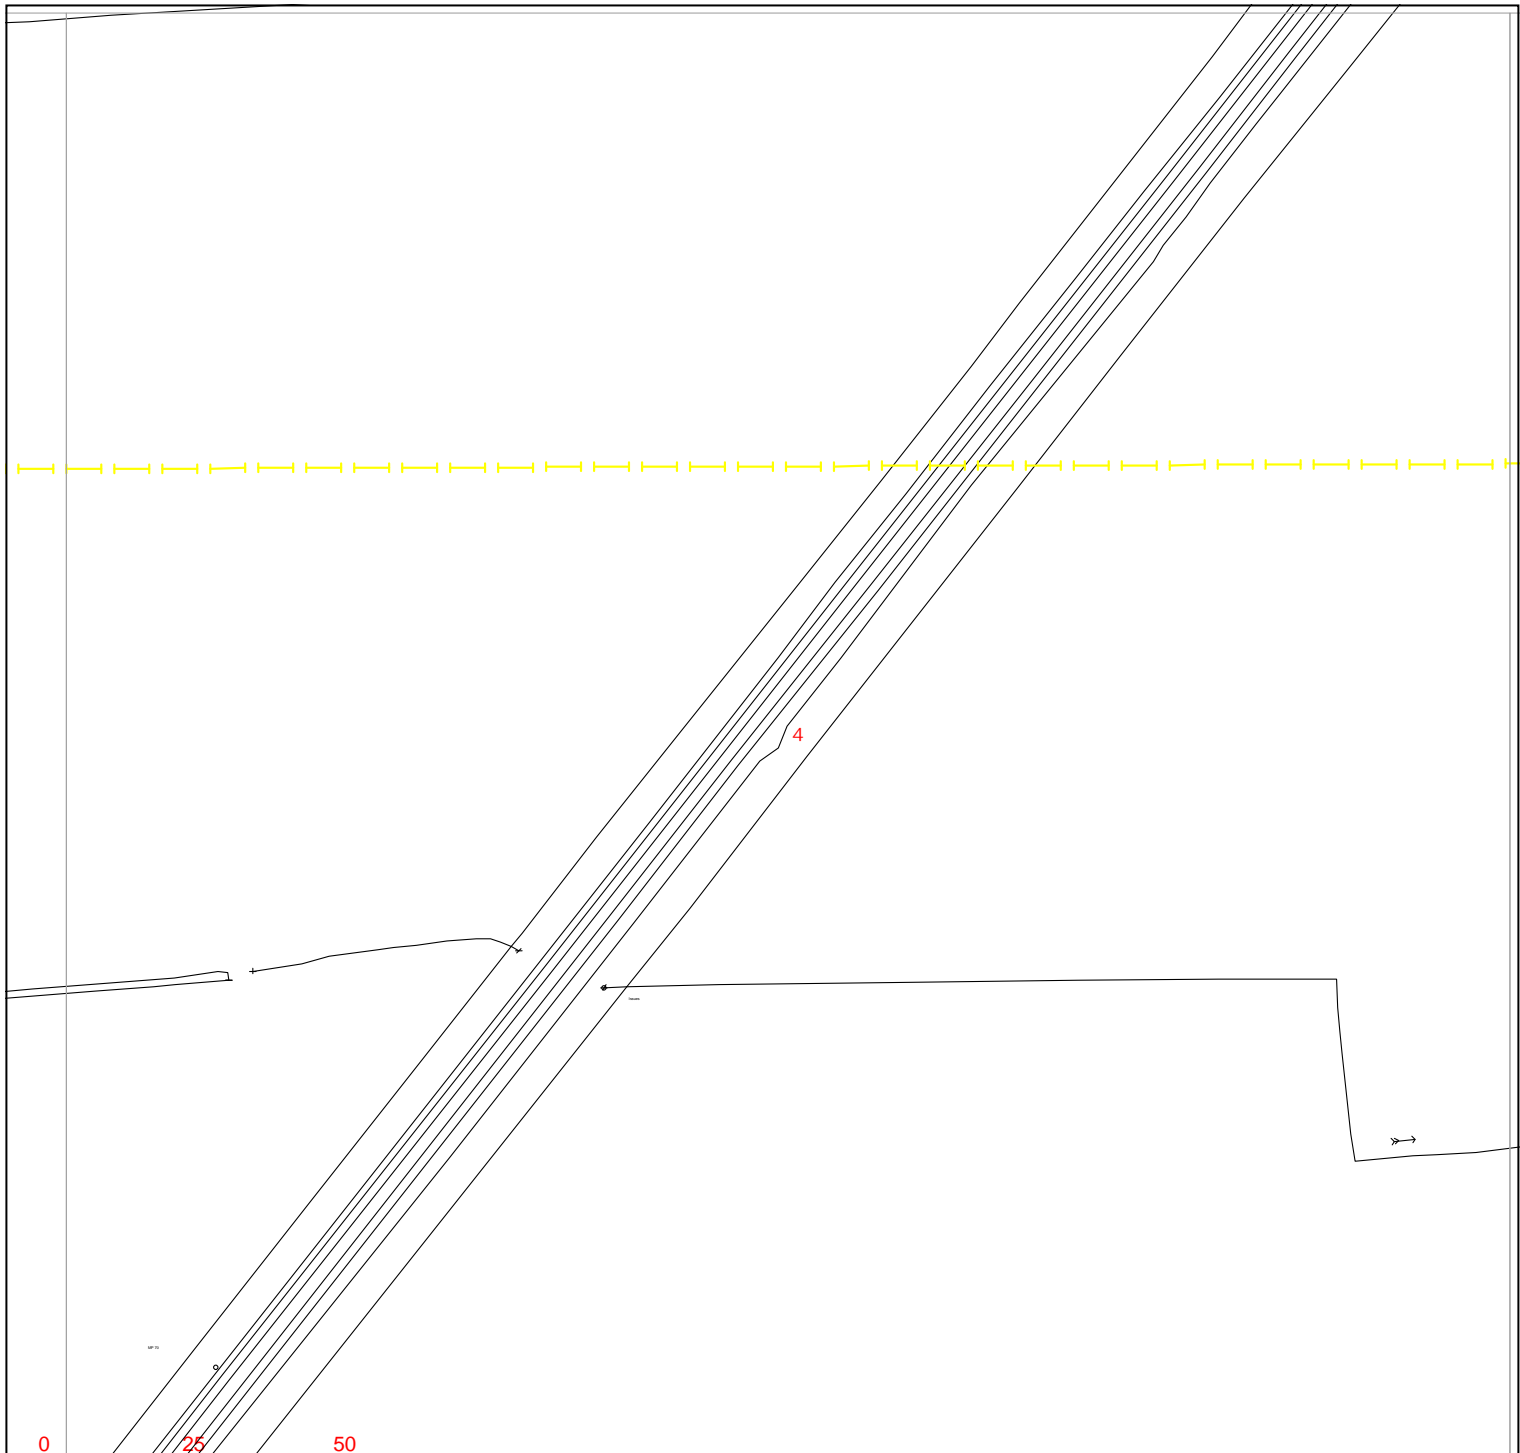

nationalgrid Electricity Distribution

Contact Us

Mapping Enquiries:
All areas 0121 623 9780

General Enquiries:
All areas 0800 096 3080

Date Requested: 08/05/2023
Job Reference: 29406948
Site Location: 477674 383832
Requested by:
Mr Ben Evans
Your Scheme/Reference:
LM 203570/DK - 10

Exact Scales:
1:1250 Area or Circle dig site
1:500 Line dig site


Link Box ●	Overhead Line ○—○ PL ○—○ Service ○—○ LV ○—○ HV (11kV) ○—○ HV (33kV) ○—○ HV (66kV) ○—○ HV (132kV)	Underground Cable -	National Grid Telecoms - - - - - PME Earth Underground Earth	Pilot Cables ○ □ Pole Mounted Transformer Ground Mounted Transformer
----------------------	--	---	--	---

IMPORTANT NOTICES

- This information is given as a guide only and its accuracy cannot be guaranteed. Services or recent additions to the network may not be shown.
- Cables, overhead lines & substations owned by other electricity network owners or private companies may be present and may not be shown.
- You should always verify exact locations of cables using a cable locator and by careful use of hand tools in accordance with HSE guidance note HSG47.
- When working within 10m of any overhead electric line you should follow the requirements of HSE Guidance Note GS6.
- For further advice on working near our electricity cables or lines, call our General Enquiries number.
- Advice should be sought from the National Grid Electricity Distribution General Enquiries team for any work that is to take place in proximity to 132kV underground cables and 132kV overhead lines.

Report damage immediately – KEEP EVERYONE AWAY FROM THE AREA
0800 6783 105

Crown Copyright © All Rights Reserved. Ordnance Survey Licence numbers: 100022432
NGED Copyright: This copy has been made by or with the authority of National Grid Electricity Distribution (NGED) pursuant to Section 47 of the Copyright Designs and Patents Act 1988 unless that Act provides a relevant exception to copyright the copy must not be copied without the prior permission of the copyright owner.

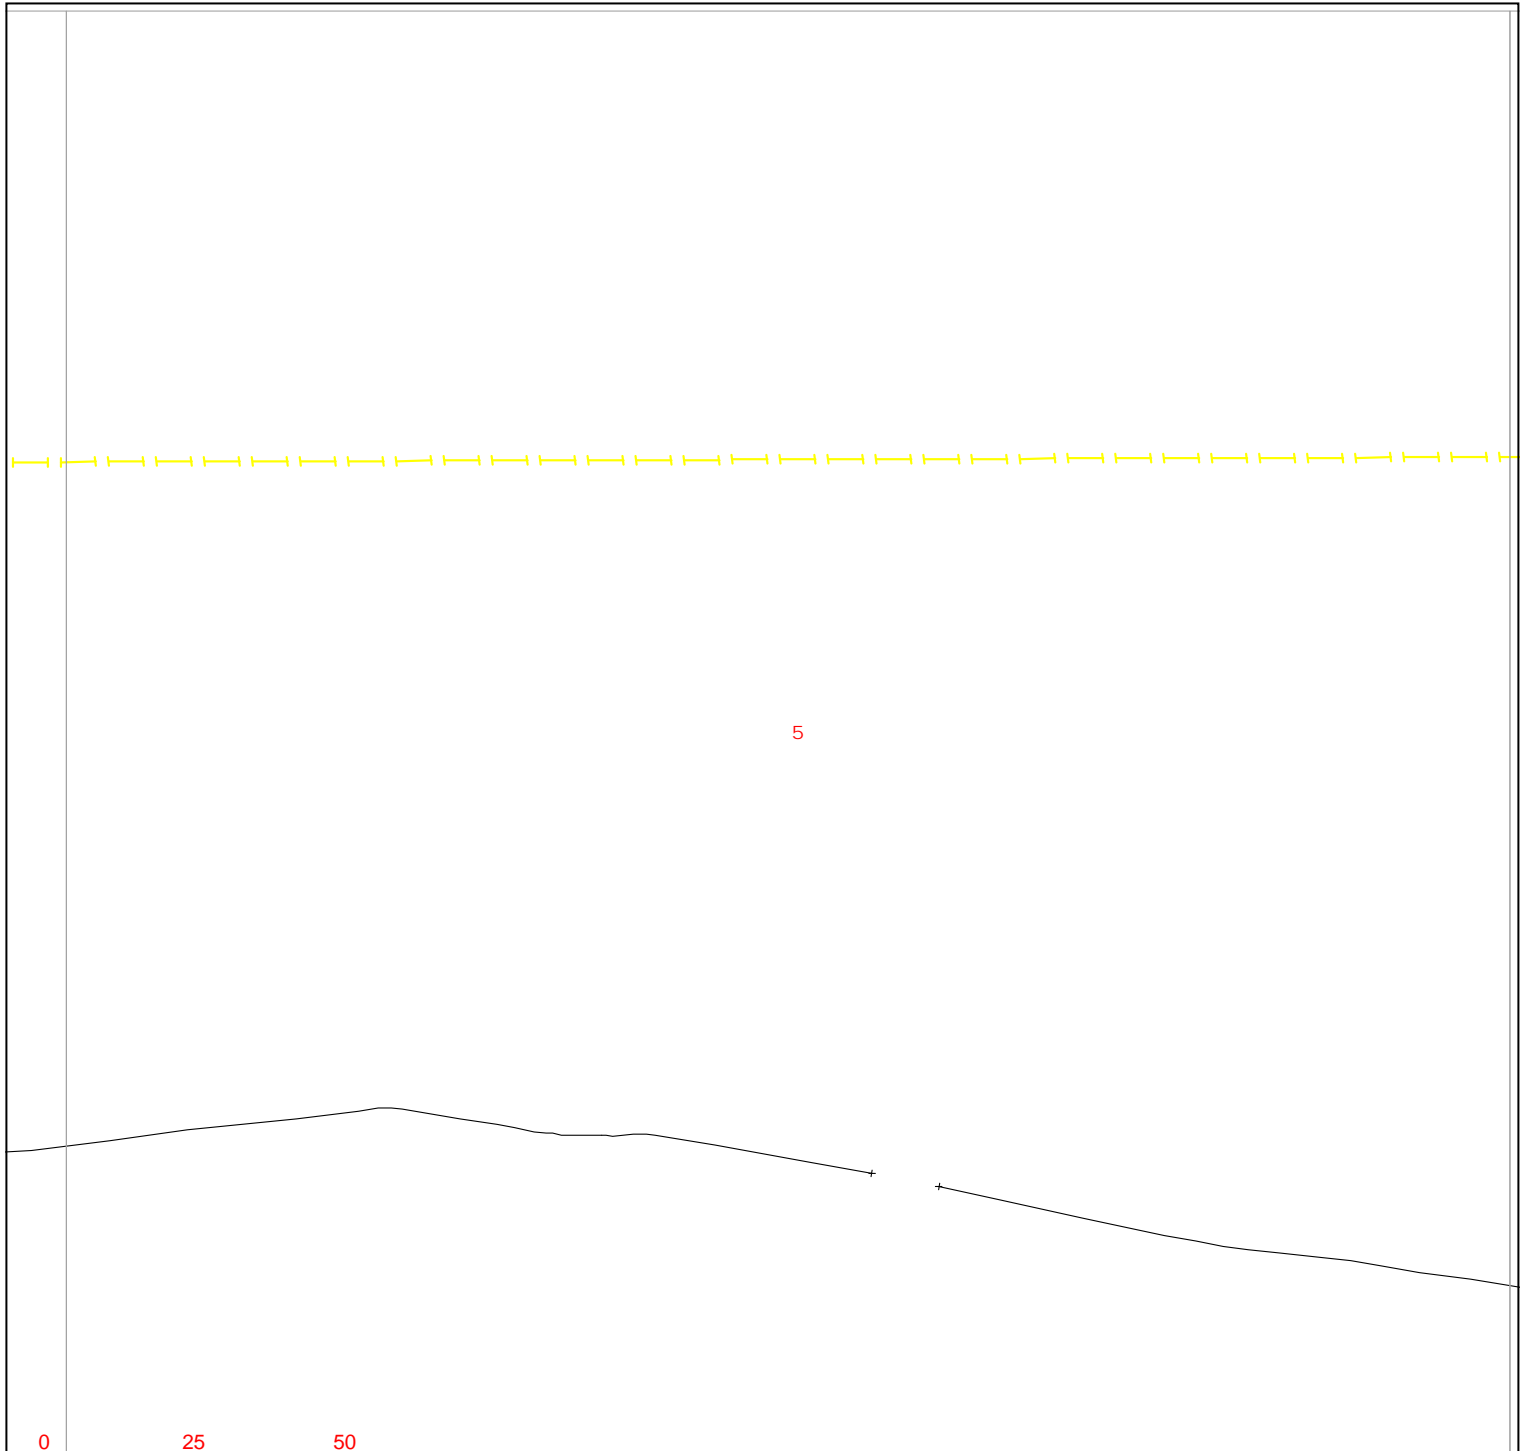

5



Warning: PDF designed for colour print only with no page scaling.



Contact Us
 Mapping Enquiries:
 All areas 0121 623 9780
 General Enquiries:
 All areas 0800 096 3080

Date Requested: 08/05/2023
 Job Reference: 29406948
 Site Location: 477674 383832
 Requested by:
 Mr Ben Evans
 Your Scheme/Reference:
 LM 203570/DK - 10

Exact Scales:
 1:1250 Area or Circle dig site
 1:500 Line dig site


Link Box	Overhead Line	Underground Cable	National Grid Telecoms	Pilot Cables
●				
●				
—				

IMPORTANT NOTICES

- This information is given as a guide only and its accuracy cannot be guaranteed. Services or recent additions to the network may not be shown.
- Cables, overhead lines & substations owned by other electricity network owners or private companies may be present and may not be shown.
- You should always verify exact locations of cables using a cable locator and by careful use of hand tools in accordance with HSE guidance note HSG47.
- When working within 10m of any overhead electric line you should follow the requirements of HSE Guidance Note GS6.
- For further advice on working near our electricity cables or lines, call our General Enquiries number.
- Advice should be sought from the National Grid Electricity Distribution General Enquiries team for any work that is to take place in proximity to 132kV underground cables and 132kV overhead lines.

Report damage immediately – KEEP EVERYONE AWAY FROM THE AREA
0800 6783 105

Crown Copyright © All Rights Reserved. Ordnance Survey Licence numbers: 100022432
 NGED Copyright: This copy has been made by or with the authority of National Grid Electricity Distribution (NGED) pursuant to Section 47 of the Copyright Designs and Patents Act 1988 unless that Act provides a relevant exception to copyright the copy must not be copied without the prior permission of the copyright owner.

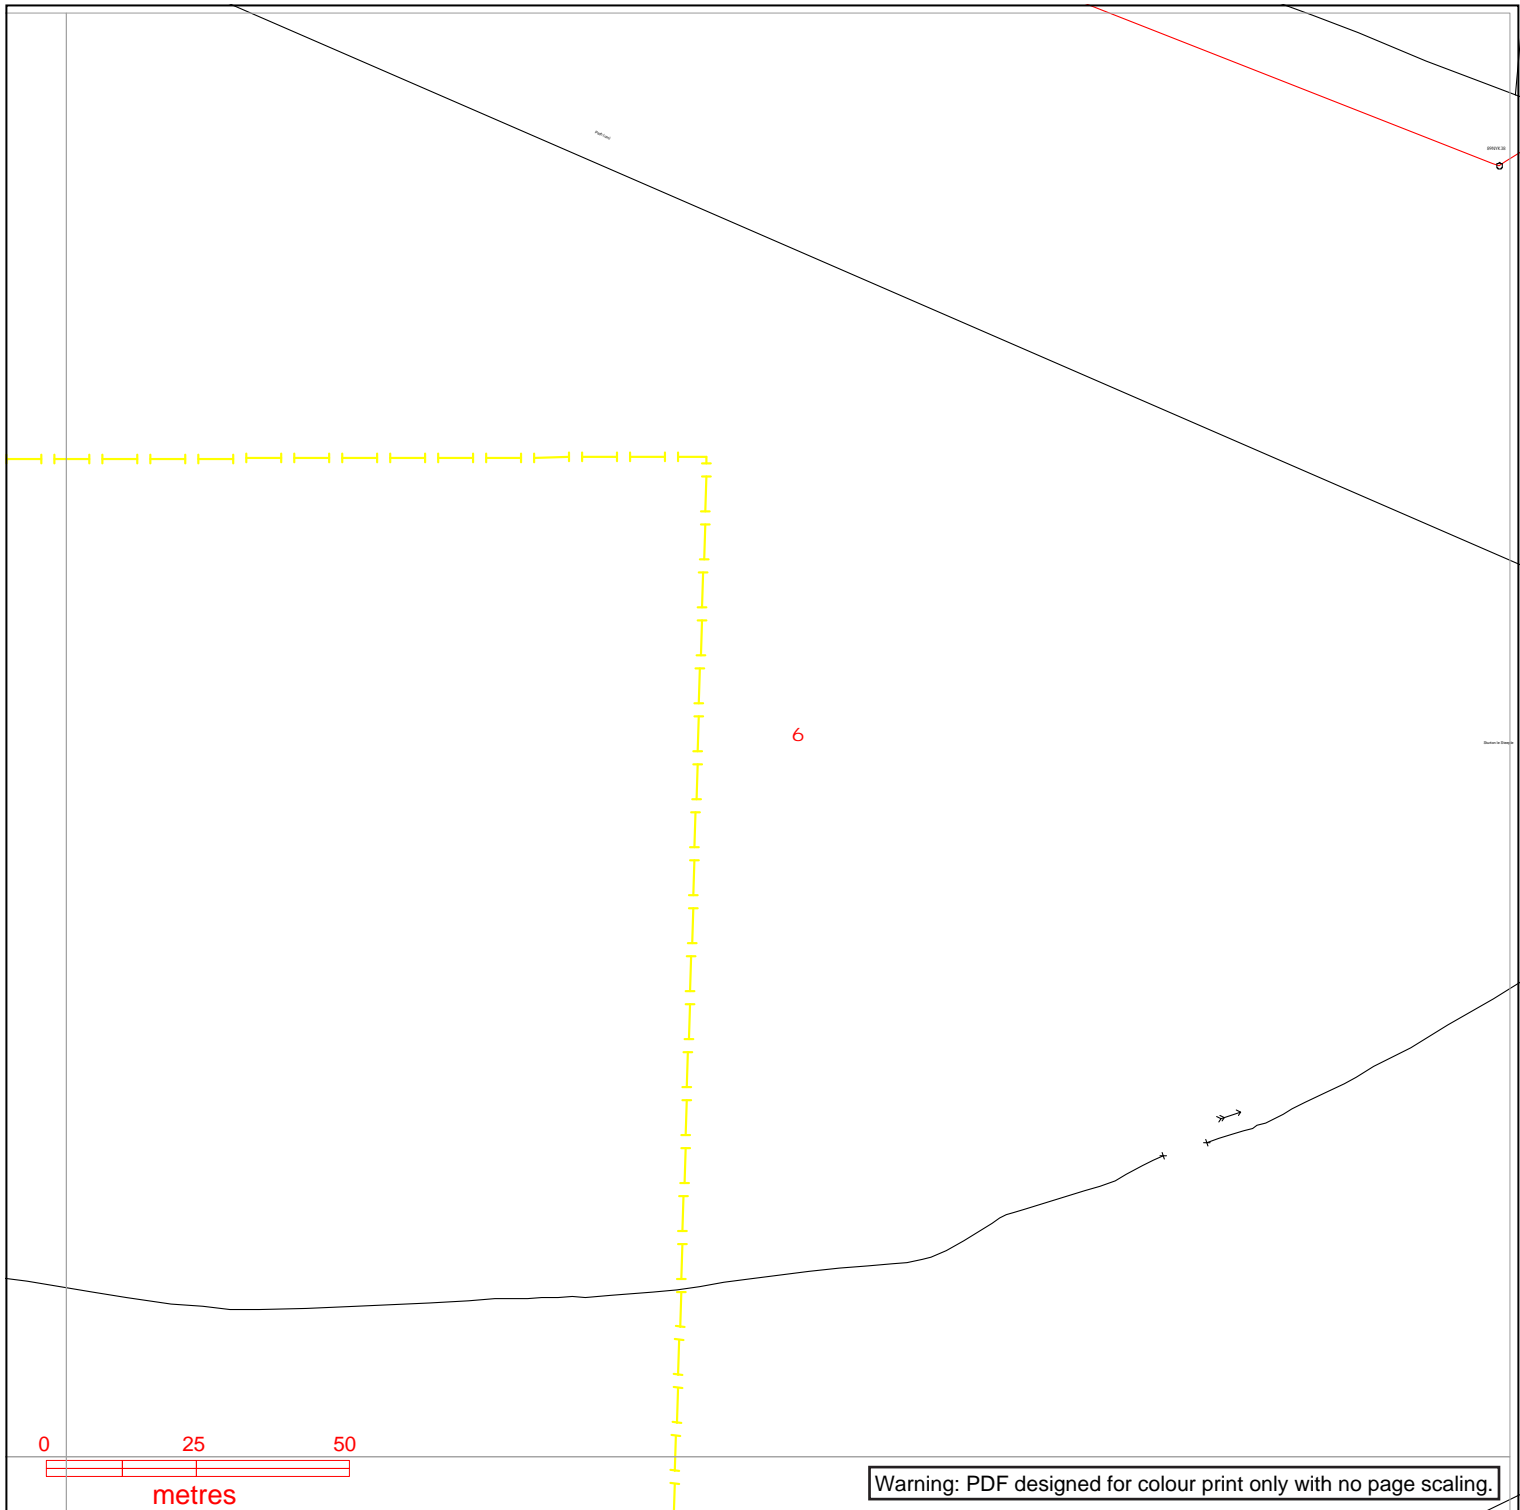

nationalgrid Electricity Distribution

Contact Us

Mapping Enquiries:
All areas 0121 623 9780

General Enquiries:
All areas 0800 096 3080

Date Requested: 08/05/2023
Job Reference: 29406948
Site Location: 477674 383832
Requested by:
Mr Ben Evans
Your Scheme/Reference:
LM 203570/DK - 10

Exact Scales:
1:1250 Area or Circle dig site
1:500 Line dig site


Link Box	Overhead Line	Underground Cable	National Grid Telecoms	Pilot Cables
●	<ul style="list-style-type: none"> ○ PL ○ Service ○ LV ○ HV (11kV) ○ HV (33kV) ○ HV (66kV) ○ HV (132kV) 	<ul style="list-style-type: none"> --- --- --- --- --- --- --- 	<ul style="list-style-type: none"> --- PME Earth ---E Underground Earth 	<ul style="list-style-type: none"> ○ Pole Mounted Transformer □ Ground Mounted Transformer
Site Location Line/Area	<ul style="list-style-type: none"> --- Site Location --- Line/Area 			

IMPORTANT NOTICES

- This information is given as a guide only and its accuracy cannot be guaranteed. Services or recent additions to the network may not be shown.
- Cables, overhead lines & substations owned by other electricity network owners or private companies may be present and may not be shown.
- You should always verify exact locations of cables using a cable locator and by careful use of hand tools in accordance with HSE guidance note HSG47.
- When working within 10m of any overhead electric line you should follow the requirements of HSE Guidance Note GS6.
- For further advice on working near our electricity cables or lines, call our General Enquiries number.
- Advice should be sought from the National Grid Electricity Distribution General Enquiries team for any work that is to take place in proximity to 132kV underground cables and 132kV overhead lines.

Report damage immediately – KEEP EVERYONE AWAY FROM THE AREA
0800 6783 105

Crown Copyright © All Rights Reserved. Ordnance Survey Licence numbers: 100022432
NGED Copyright: This copy has been made by or with the authority of National Grid Electricity Distribution (NGED) pursuant to Section 47 of the Copyright Designs and Patents Act 1988 unless that Act provides a relevant exception to copyright the copy must not be copied without the prior permission of the copyright owner.

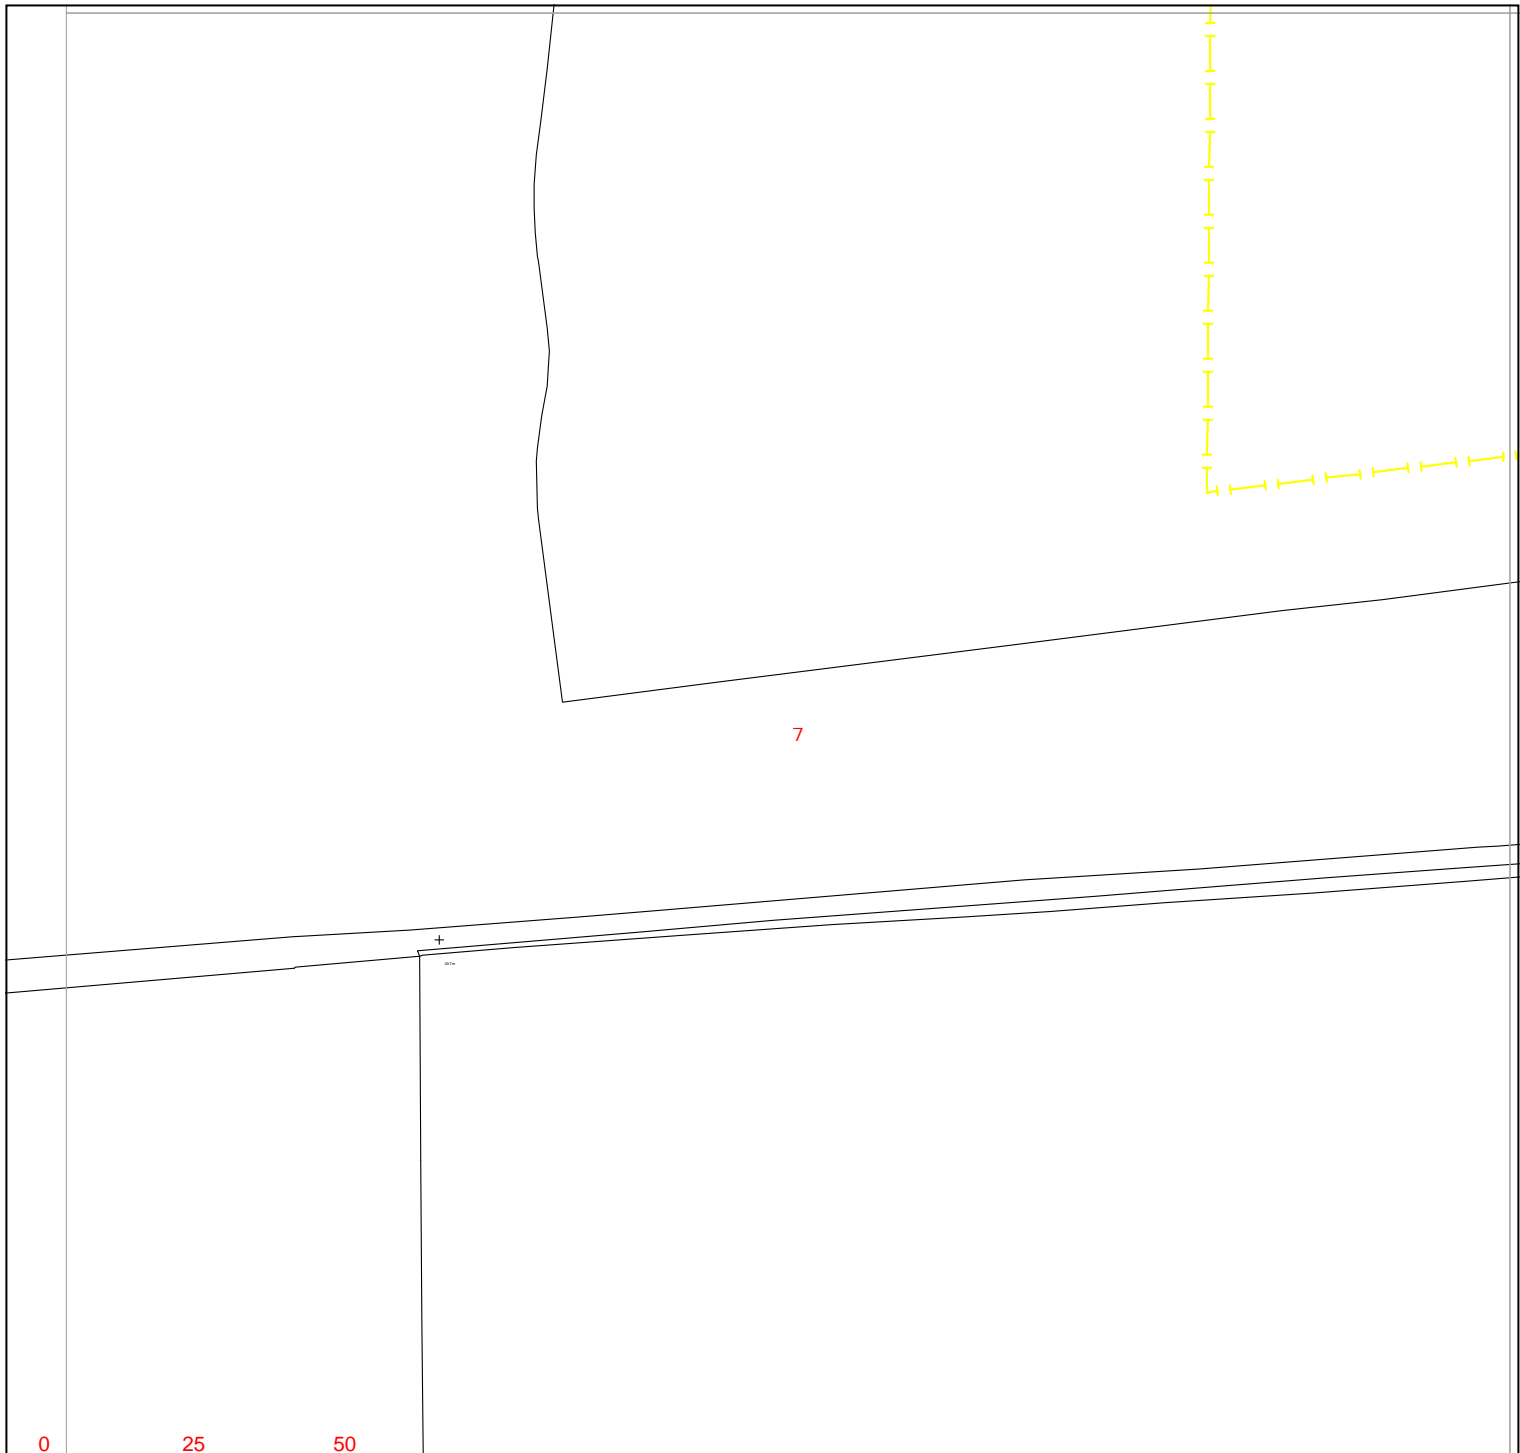

Warning: PDF designed for colour print only with no page scaling.




Contact Us

Mapping Enquiries:
All areas 0121 623 9780

General Enquiries:
All areas 0800 096 3080

Date Requested: 08/05/2023
Job Reference: 29406948
Site Location: 477674 383832
Requested by:
Mr Ben Evans
Your Scheme/Reference:
LM 203570/DK - 10

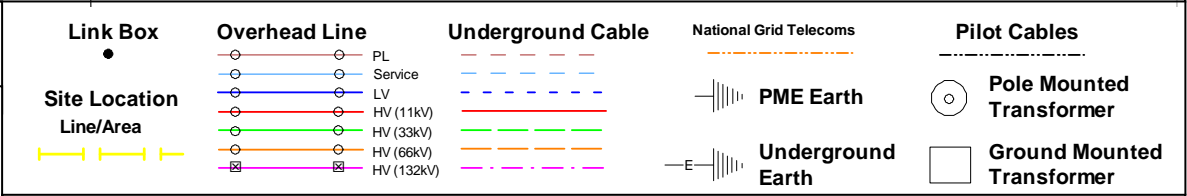


IMPORTANT NOTICES

- This information is given as a guide only and its accuracy cannot be guaranteed. Services or recent additions to the network may not be shown.
- Cables, overhead lines & substations owned by other electricity network owners or private companies may be present and may not be shown.
- You should always verify exact locations of cables using a cable locator and by careful use of hand tools in accordance with HSE guidance note HSG47.
- When working within 10m of any overhead electric line you should follow the requirements of HSE Guidance Note GS6.
- For further advice on working near our electricity cables or lines, call our General Enquiries number.
- Advice should be sought from the National Grid Electricity Distribution General Enquiries team for any work that is to take place in proximity to 132kV underground cables and 132kV overhead lines.

Report damage immediately – KEEP EVERYONE AWAY FROM THE AREA
0800 6783 105

Exact Scales:
1:1250 Area or Circle dig site
1:500 Line dig site

Crown Copyright © All Rights Reserved. Ordnance Survey Licence numbers: 100022432
NGED Copyright: This copy has been made by or with the authority of National Grid Electricity Distribution (NGED) pursuant to Section 47 of the Copyright Designs and Patents Act 1988 unless that Act provides a relevant exception to copyright the copy must not be copied without the prior permission of the copyright owner.

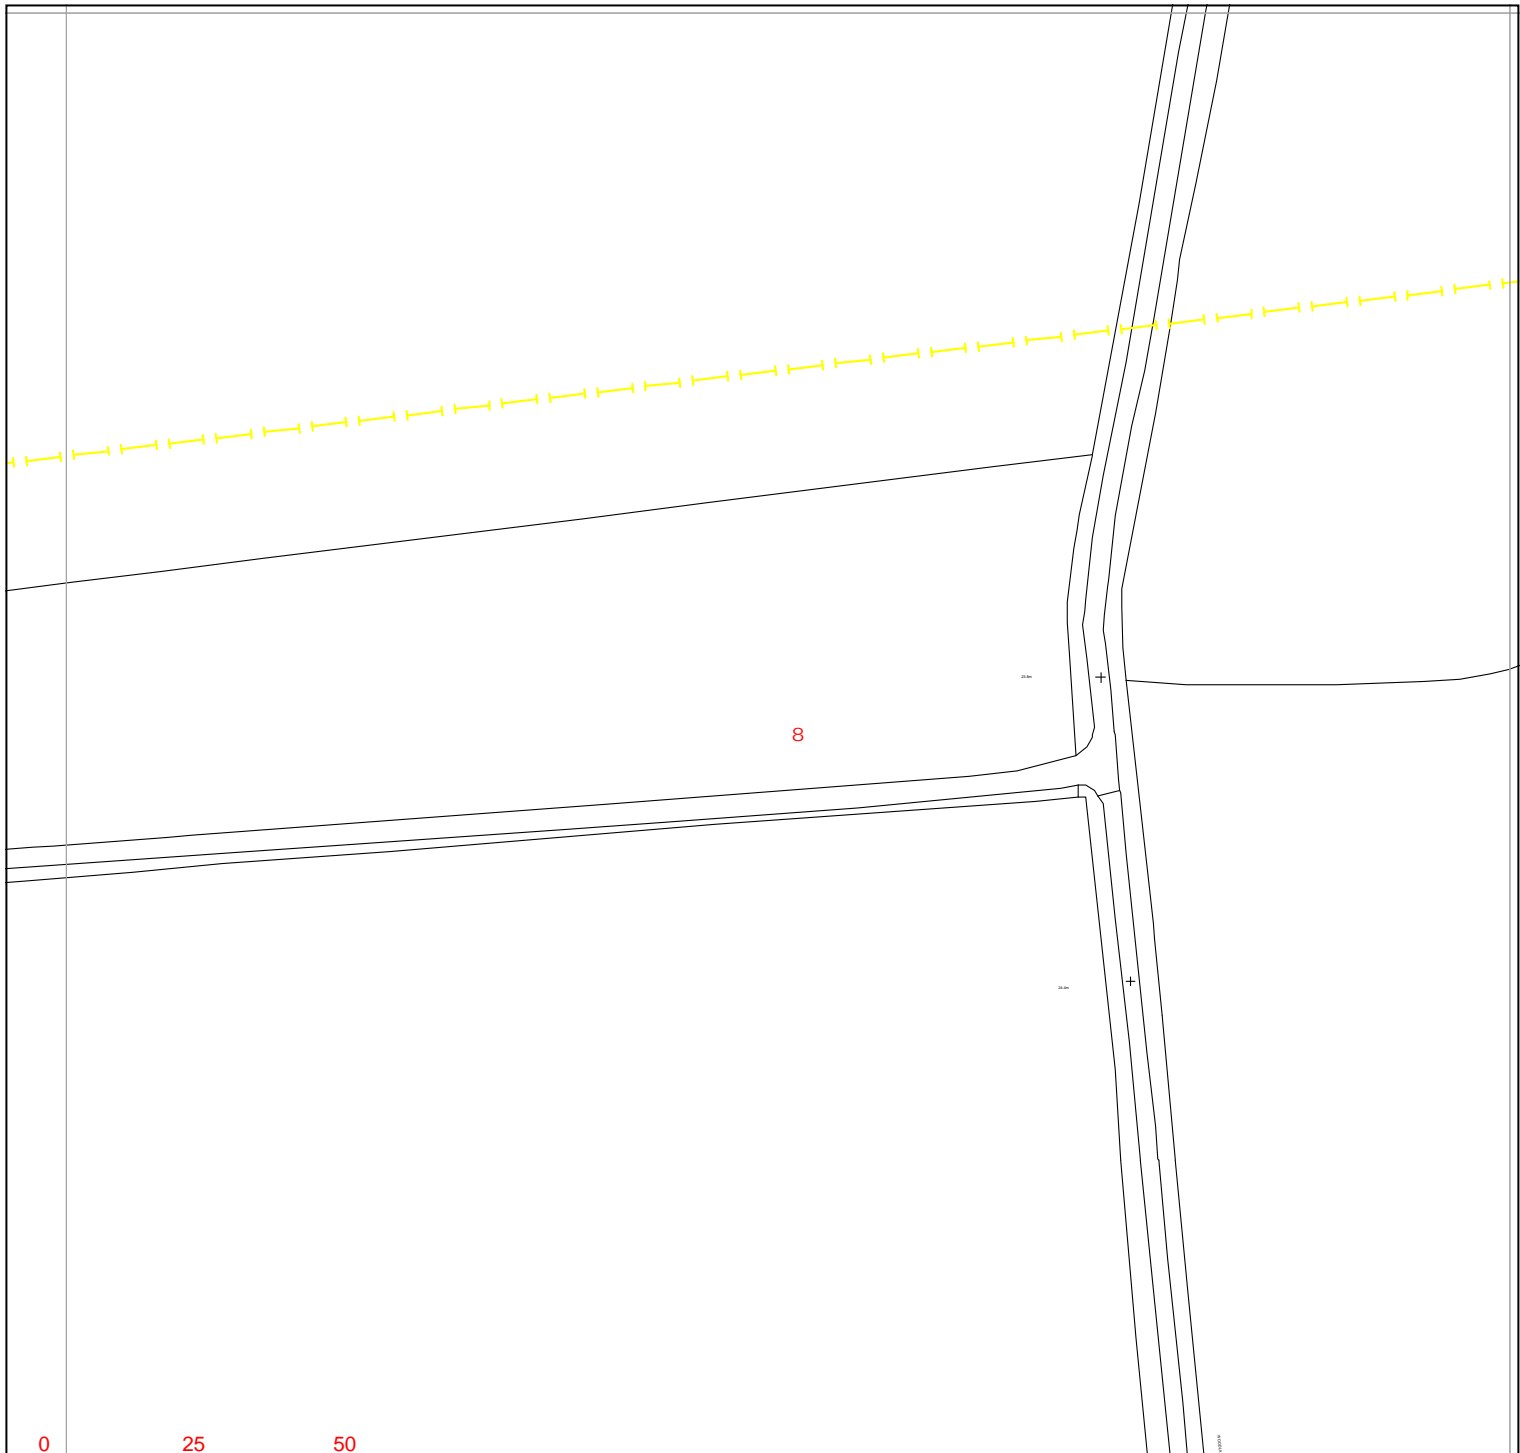

Warning: PDF designed for colour print only with no page scaling.



Contact Us

Mapping Enquiries:
All areas 0121 623 9780

General Enquiries:
All areas 0800 096 3080

Date Requested: 08/05/2023
Job Reference: 29406948
Site Location: 477674 383832
Requested by:
Mr Ben Evans
Your Scheme/Reference:
LM 203570/DK - 10

Exact Scales:
1:1250 Area or Circle dig site
1:500 Line dig site


Link Box	Overhead Line	Underground Cable	National Grid Telecoms	Pilot Cables
●				

IMPORTANT NOTICES

- This information is given as a guide only and its accuracy cannot be guaranteed. Services or recent additions to the network may not be shown.
- Cables, overhead lines & substations owned by other electricity network owners or private companies may be present and may not be shown.
- You should always verify exact locations of cables using a cable locator and by careful use of hand tools in accordance with HSE guidance note HSG47.
- When working within 10m of any overhead electric line you should follow the requirements of HSE Guidance Note GS6.
- For further advice on working near our electricity cables or lines, call our General Enquiries number.
- Advice should be sought from the National Grid Electricity Distribution General Enquiries team for any work that is to take place in proximity to 132kV underground cables and 132kV overhead lines.

Report damage immediately – KEEP EVERYONE AWAY FROM THE AREA
0800 6783 105

Crown Copyright © All Rights Reserved. Ordnance Survey Licence numbers: 100022432
NGED Copyright: This copy has been made by or with the authority of National Grid Electricity Distribution (NGED) pursuant to Section 47 of the Copyright Designs and Patents Act 1988 unless that Act provides a relevant exception to copyright the copy must not be copied without the prior permission of the copyright owner.

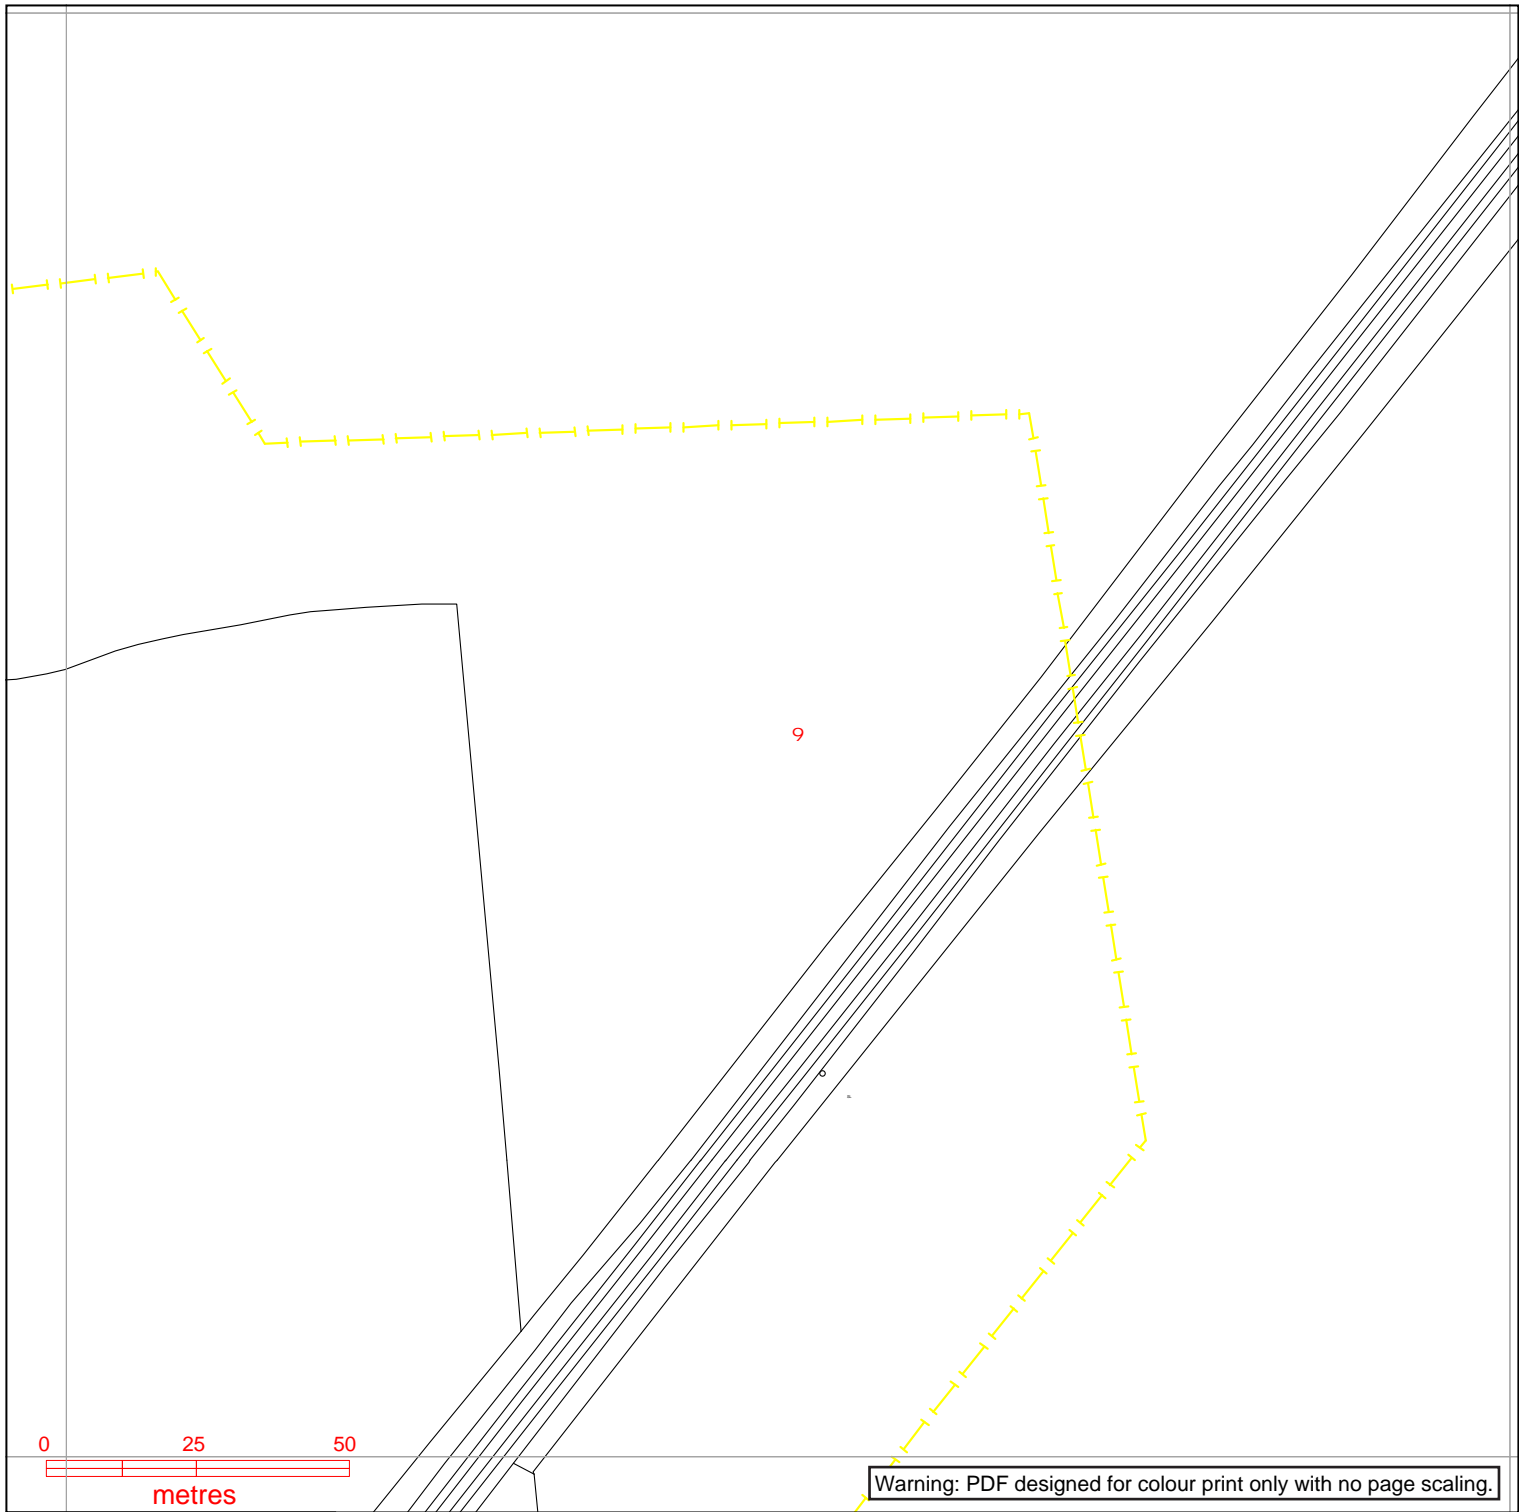

Warning: PDF designed for colour print only with no page scaling.

nationalgrid Electricity Distribution

Contact Us

Mapping Enquiries:
All areas 0121 623 9780

General Enquiries:
All areas 0800 096 3080

Date Requested: 08/05/2023
Job Reference: 29406948
Site Location: 477674 383832
Requested by:
Mr Ben Evans
Your Scheme/Reference:
LM 203570/DK - 10

Exact Scales:
1:1250 Area or Circle dig site
1:500 Line dig site

Link Box ●	Overhead Line ○ ○ PL ○ ○ Service ○ ○ LV ○ ○ HV (11kV) ○ ○ HV (33kV) ○ ○ HV (66kV) ⊠ ⊠ HV (132kV)	Underground Cable -	National Grid Telecoms - - - - - PME Earth Underground Earth	Pilot Cables ○ Pole Mounted Transformer □ Ground Mounted Transformer
----------------------	--	---	--	---


IMPORTANT NOTICES

- This information is given as a guide only and its accuracy cannot be guaranteed. Services or recent additions to the network may not be shown.
- Cables, overhead lines & substations owned by other electricity network owners or private companies may be present and may not be shown.
- You should always verify exact locations of cables using a cable locator and by careful use of hand tools in accordance with HSE guidance note HSG47.
- When working within 10m of any overhead electric line you should follow the requirements of HSE Guidance Note GS6.
- For further advice on working near our electricity cables or lines, call our General Enquiries number.
- Advice should be sought from the National Grid Electricity Distribution General Enquiries team for any work that is to take place in proximity to 132kV underground cables and 132kV overhead lines.

Report damage immediately – KEEP EVERYONE AWAY FROM THE AREA
0800 6783 105

Crown Copyright © All Rights Reserved. Ordnance Survey Licence numbers: 100022432
NGED Copyright: This copy has been made by or with the authority of National Grid Electricity Distribution (NGED) pursuant to Section 47 of the Copyright Designs and Patents Act 1988 unless that Act provides a relevant exception to copyright the copy must not be copied without the prior permission of the copyright owner.

10

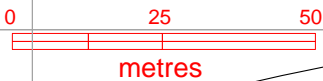

Warning: PDF designed for colour print only with no page scaling.



Contact Us

Mapping Enquiries:

All areas 0121 623 9780

General Enquiries:

All areas 0800 096 3080

Date Requested: 08/05/2023

Job Reference: 29406948

Site Location: 477674 383832

Requested by:

Mr Ben Evans


Your Scheme/Reference:

LM 203570/DK - 10

Exact Scales:

1:1250 Area or Circle dig site

1:500 Line dig site

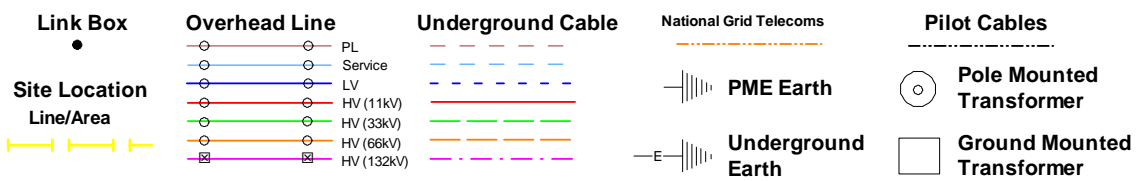


IMPORTANT NOTICES

- This information is given as a guide only and its accuracy cannot be guaranteed. Services or recent additions to the network may not be shown.
- Cables, overhead lines & substations owned by other electricity network owners or private companies may be present and may not be shown.
- You should always verify exact locations of cables using a cable locator and by careful use of hand tools in accordance with HSE guidance note HSG47.
- When working within 10m of any overhead electric line you should follow the requirements of HSE Guidance Note GS6.
- For further advice on working near our electricity cables or lines, call our General Enquiries number.
- Advice should be sought from the National Grid Electricity Distribution General Enquiries team for any work that is to take place in proximity to 132kV underground cables and 132kV overhead lines.

**Report damage immediately – KEEP EVERYONE AWAY FROM THE AREA
0800 6783 105**

Crown Copyright © All Rights Reserved. Ordnance Survey Licence numbers: 100022432
NGED Copyright: This copy has been made by or with the authority of National Grid Electricity Distribution (NGED) pursuant to Section 47 of the Copyright Designs and Patents Act 1988 unless that Act provides a relevant exception to copyright the copy must not be copied without the prior permission of the copyright owner.

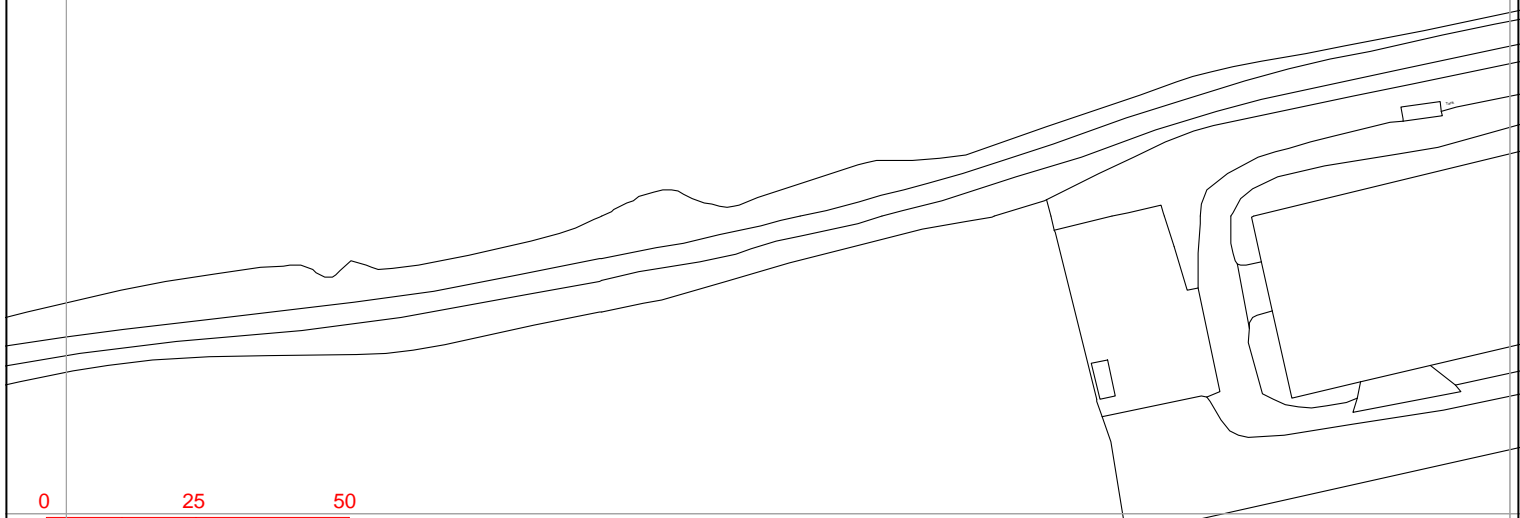

Contact Us

Mapping Enquiries:
All areas 0121 623 9780

General Enquiries:
All areas 0800 096 3080

Date Requested: 08/05/2023
Job Reference: 29406948
Site Location: 477674 383832
Requested by:
Mr Ben Evans
Your Scheme/Reference:
LM 203570/DK - 10

Exact Scales:
1:1250 Area or Circle dig site
1:500 Line dig site


Link Box ●	Overhead Line ○—○ PL ○—○ Service ○—○ LV ○—○ HV (11kV) ○—○ HV (33kV) ○—○ HV (66kV) ○—○ HV (132kV)	Underground Cable -	National Grid Telecoms - - - - - PME Earth -E- - - - - Underground Earth	Pilot Cables - - - - - ○ Pole Mounted Transformer □ Ground Mounted Transformer
----------------------	--	---	---	--

IMPORTANT NOTICES

- This information is given as a guide only and its accuracy cannot be guaranteed. Services or recent additions to the network may not be shown.
- Cables, overhead lines & substations owned by other electricity network owners or private companies may be present and may not be shown.
- You should always verify exact locations of cables using a cable locator and by careful use of hand tools in accordance with HSE guidance note HSG47.
- When working within 10m of any overhead electric line you should follow the requirements of HSE Guidance Note GS6.
- For further advice on working near our electricity cables or lines, call our General Enquiries number.
- Advice should be sought from the National Grid Electricity Distribution General Enquiries team for any work that is to take place in proximity to 132kV underground cables and 132kV overhead lines.

Report damage immediately – KEEP EVERYONE AWAY FROM THE AREA
0800 6783 105

Crown Copyright © All Rights Reserved. Ordnance Survey Licence numbers: 100022432
NGED Copyright: This copy has been made by or with the authority of National Grid Electricity Distribution (NGED) pursuant to Section 47 of the Copyright Designs and Patents Act 1988 unless that Act provides a relevant exception to copyright the copy must not be copied without the prior permission of the copyright owner.

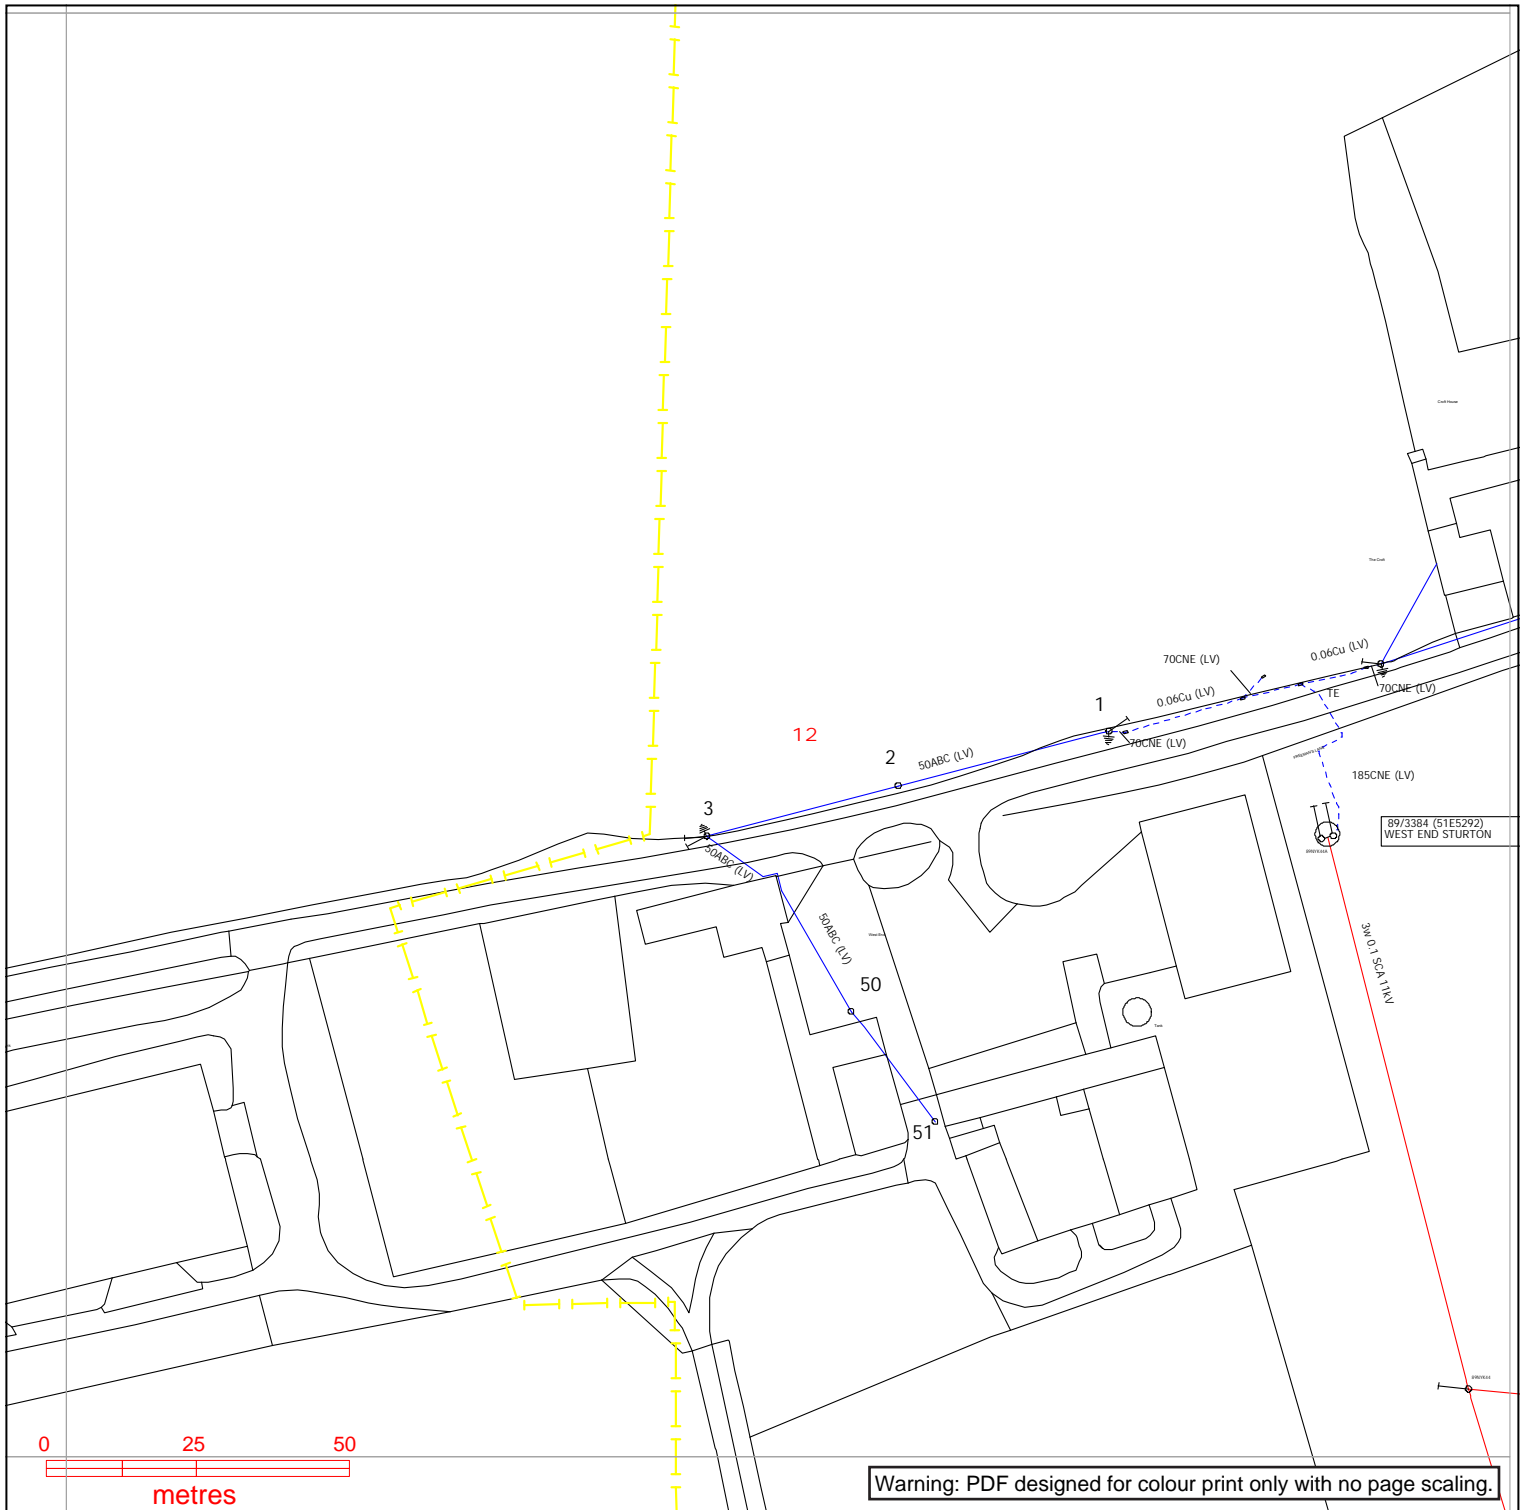

Contact Us

Mapping Enquiries:
All areas 0121 623 9780

General Enquiries:
All areas 0800 096 3080

Date Requested: 08/05/2023
Job Reference: 29406948
Site Location: 477674 383832
Requested by:
Mr Ben Evans
Your Scheme/Reference:
LM 203570/DK - 10


Link Box	Overhead Line	Underground Cable	National Grid Telecoms	Pilot Cables
●	○ PL ○ Service ○ LV ○ HV (11kV) ○ HV (33kV) ○ HV (66kV) ○ HV (132kV)	--- --- --- ---	--- PME Earth --- Underground Earth	○ Pole Mounted Transformer □ Ground Mounted Transformer

IMPORTANT NOTICES

- This information is given as a guide only and its accuracy cannot be guaranteed. Services or recent additions to the network may not be shown.
- Cables, overhead lines & substations owned by other electricity network owners or private companies may be present and may not be shown.
- You should always verify exact locations of cables using a cable locator and by careful use of hand tools in accordance with HSE guidance note HSG47.
- When working within 10m of any overhead electric line you should follow the requirements of HSE Guidance Note GS6.
- For further advice on working near our electricity cables or lines, call our General Enquiries number.
- Advice should be sought from the National Grid Electricity Distribution General Enquiries team for any work that is to take place in proximity to 132kV underground cables and 132kV overhead lines.

**Report damage immediately – KEEP EVERYONE AWAY FROM THE AREA
0800 6783 105**

Crown Copyright © All Rights Reserved. Ordnance Survey Licence numbers: 100022432
NGED Copyright: This copy has been made by or with the authority of National Grid Electricity Distribution (NGED) pursuant to Section 47 of the Copyright Designs and Patents Act 1988 unless that Act provides a relevant exception to copyright the copy must not be copied without the prior permission of the copyright owner.

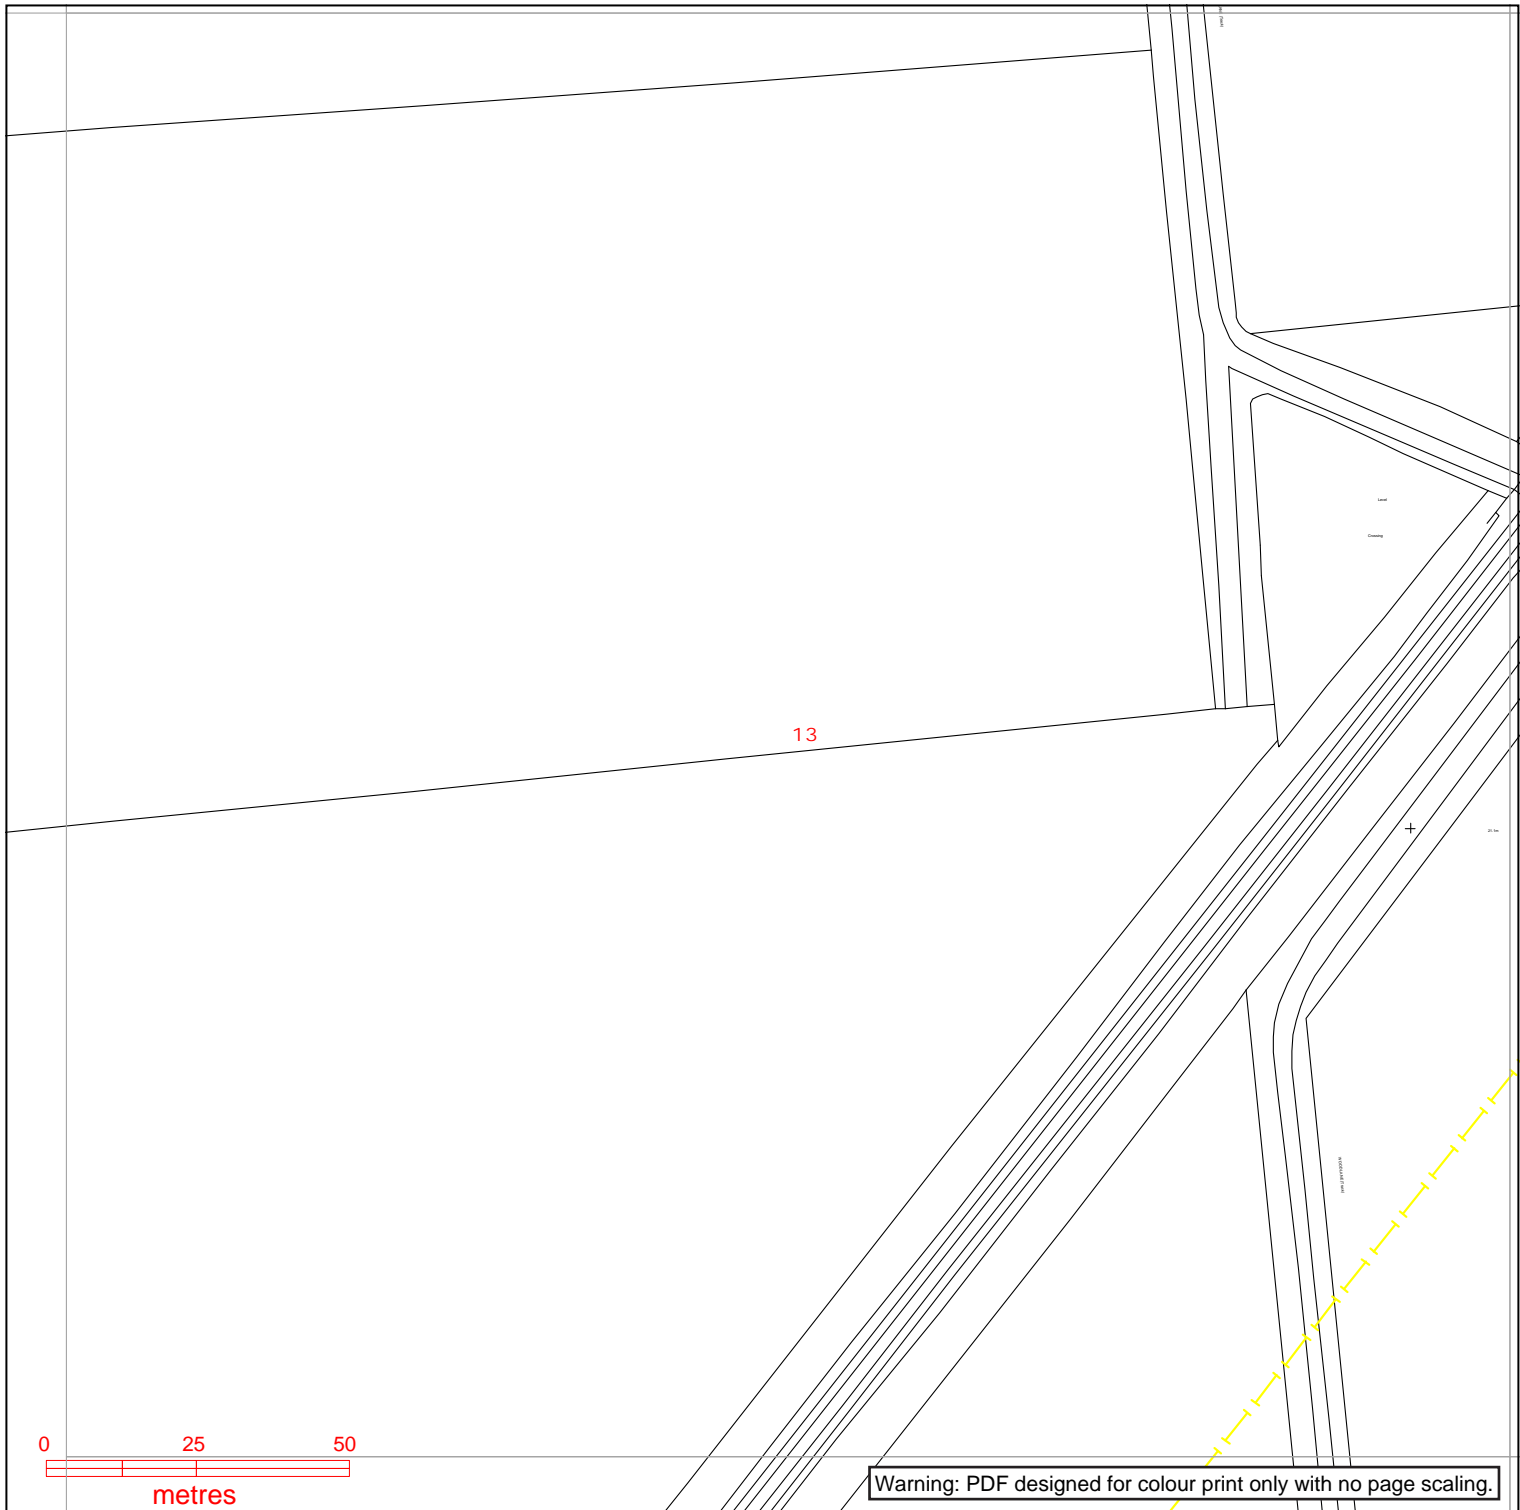

Contact Us

Mapping Enquiries:
All areas 0121 623 9780

General Enquiries:
All areas 0800 096 3080

Date Requested: 08/05/2023
Job Reference: 29406948
Site Location: 477674 383832
Requested by:
Mr Ben Evans
Your Scheme/Reference:
LM 203570/DK - 10

Exact Scales:
1:1250 Area or Circle dig site
1:500 Line dig site


Link Box	Overhead Line	Underground Cable	National Grid Telecoms	Pilot Cables
●	<ul style="list-style-type: none"> ○ PL ○ Service ○ LV ○ HV (11kV) ○ HV (33kV) ○ HV (66kV) ○ HV (132kV) 	<ul style="list-style-type: none"> --- --- --- --- --- --- --- 	<ul style="list-style-type: none"> --- PME Earth ---E Underground Earth 	<ul style="list-style-type: none"> ○ Pole Mounted Transformer □ Ground Mounted Transformer
Site Location Line/Area	<ul style="list-style-type: none"> --- Site Location --- Line/Area 			

IMPORTANT NOTICES

- This information is given as a guide only and its accuracy cannot be guaranteed. Services or recent additions to the network may not be shown.
- Cables, overhead lines & substations owned by other electricity network owners or private companies may be present and may not be shown.
- You should always verify exact locations of cables using a cable locator and by careful use of hand tools in accordance with HSE guidance note HSG47.
- When working within 10m of any overhead electric line you should follow the requirements of HSE Guidance Note GS6.
- For further advice on working near our electricity cables or lines, call our General Enquiries number.
- Advice should be sought from the National Grid Electricity Distribution General Enquiries team for any work that is to take place in proximity to 132kV underground cables and 132kV overhead lines.

Report damage immediately – KEEP EVERYONE AWAY FROM THE AREA
0800 6783 105

Crown Copyright © All Rights Reserved. Ordnance Survey Licence numbers: 100022432
NGED Copyright: This copy has been made by or with the authority of National Grid Electricity Distribution (NGED) pursuant to Section 47 of the Copyright Designs and Patents Act 1988 unless that Act provides a relevant exception to copyright the copy must not be copied without the prior permission of the copyright owner.

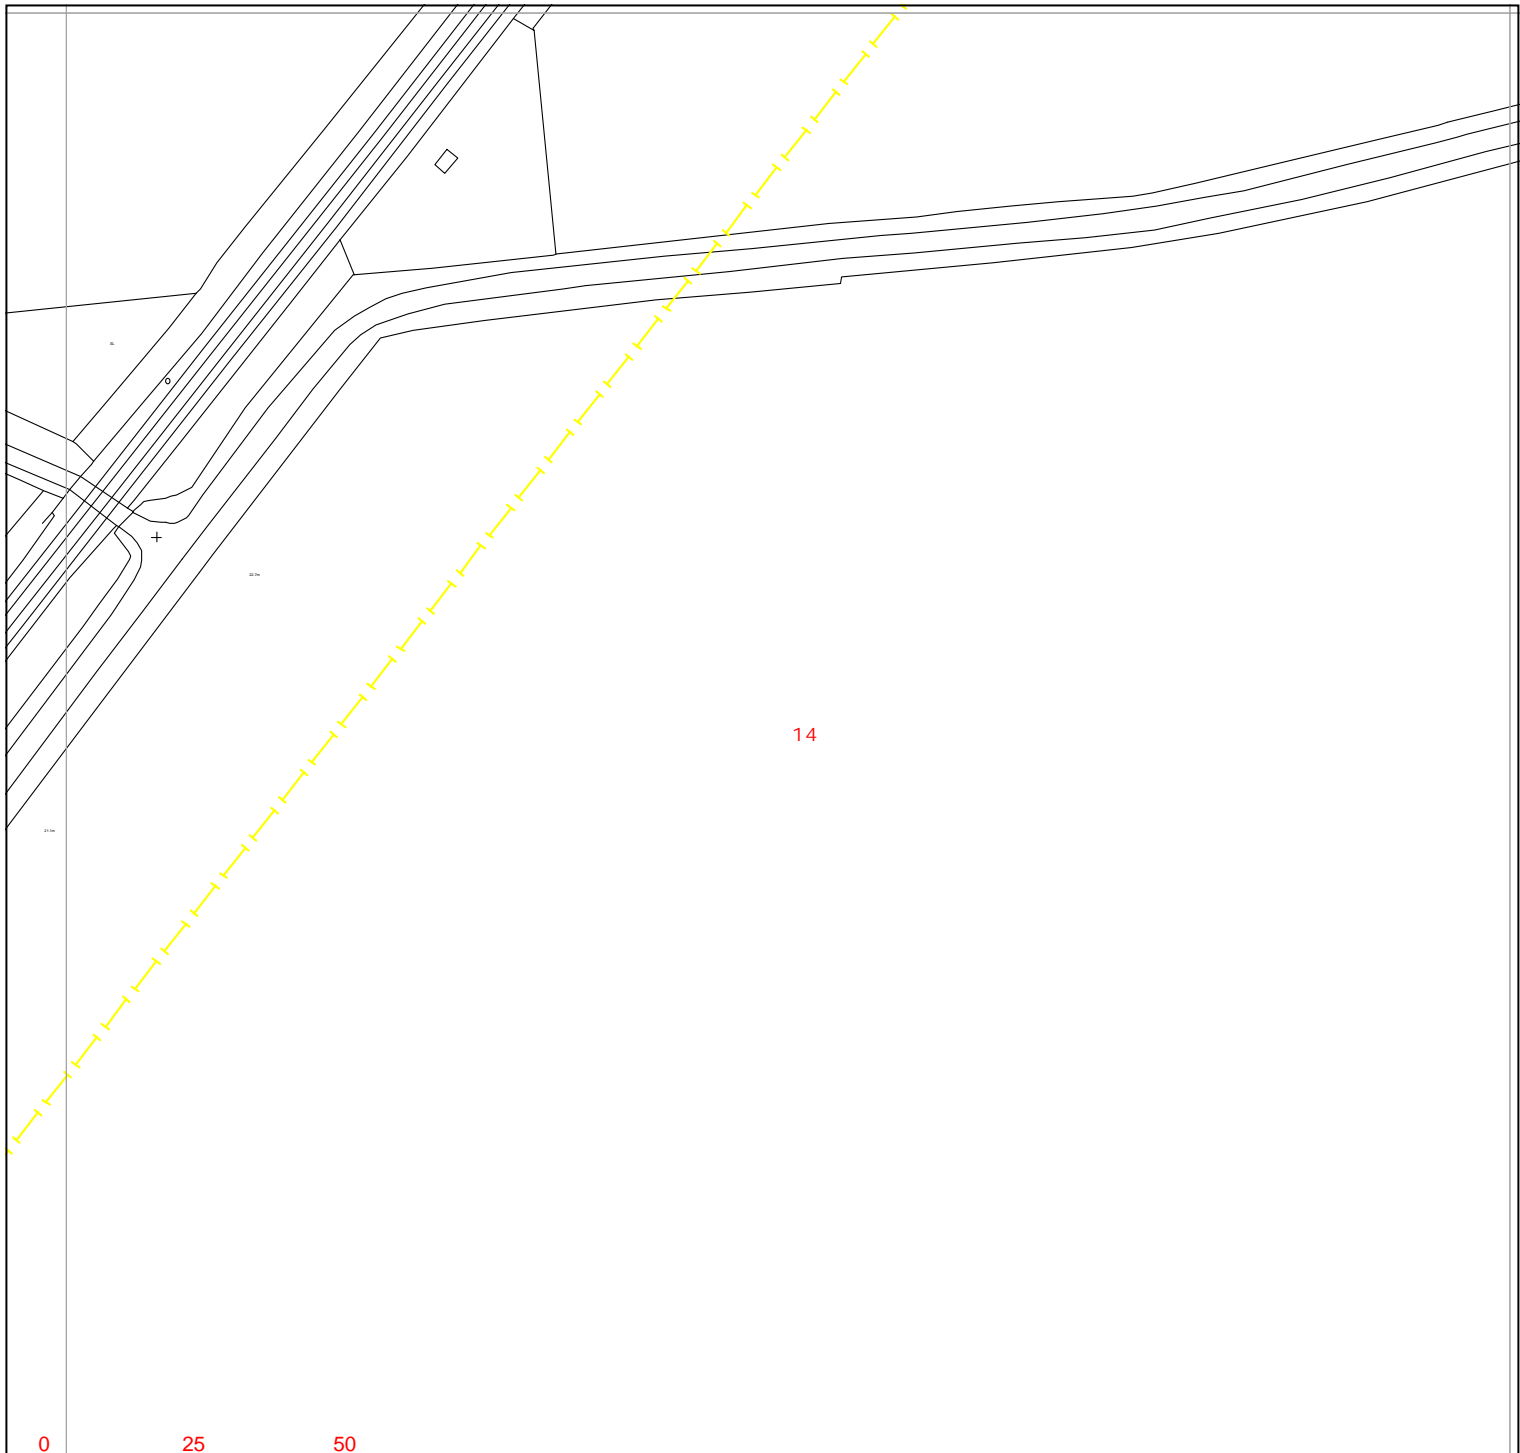

Warning: PDF designed for colour print only with no page scaling.

nationalgrid Electricity Distribution

Contact Us

Mapping Enquiries:
All areas 0121 623 9780

General Enquiries:
All areas 0800 096 3080

Date Requested: 08/05/2023
Job Reference: 29406948
Site Location: 477674 383832
Requested by:
Mr Ben Evans
Your Scheme/Reference:
LM 203570/DK - 10

Exact Scales:
1:1250 Area or Circle dig site
1:500 Line dig site


Link Box ●	Overhead Line ○—○ PL ○—○ Service ○—○ LV ○—○ HV (11kV) ○—○ HV (33kV) ○—○ HV (66kV) ○—○ HV (132kV)	Underground Cable -	National Grid Telecoms - - - - - PME Earth -E- - - - - Underground Earth	Pilot Cables ○ Pole Mounted Transformer □ Ground Mounted Transformer
----------------------	--	--	---	---

IMPORTANT NOTICES

- This information is given as a guide only and its accuracy cannot be guaranteed. Services or recent additions to the network may not be shown.
- Cables, overhead lines & substations owned by other electricity network owners or private companies may be present and may not be shown.
- You should always verify exact locations of cables using a cable locator and by careful use of hand tools in accordance with HSE guidance note HSG47.
- When working within 10m of any overhead electric line you should follow the requirements of HSE Guidance Note GS6.
- For further advice on working near our electricity cables or lines, call our General Enquiries number.
- Advice should be sought from the National Grid Electricity Distribution General Enquiries team for any work that is to take place in proximity to 132kV underground cables and 132kV overhead lines.

Report damage immediately – KEEP EVERYONE AWAY FROM THE AREA
0800 6783 105

Crown Copyright © All Rights Reserved. Ordnance Survey Licence numbers: 100022432
NGED Copyright: This copy has been made by or with the authority of National Grid Electricity Distribution (NGED) pursuant to Section 47 of the Copyright Designs and Patents Act 1988 unless that Act provides a relevant exception to copyright the copy must not be copied without the prior permission of the copyright owner.

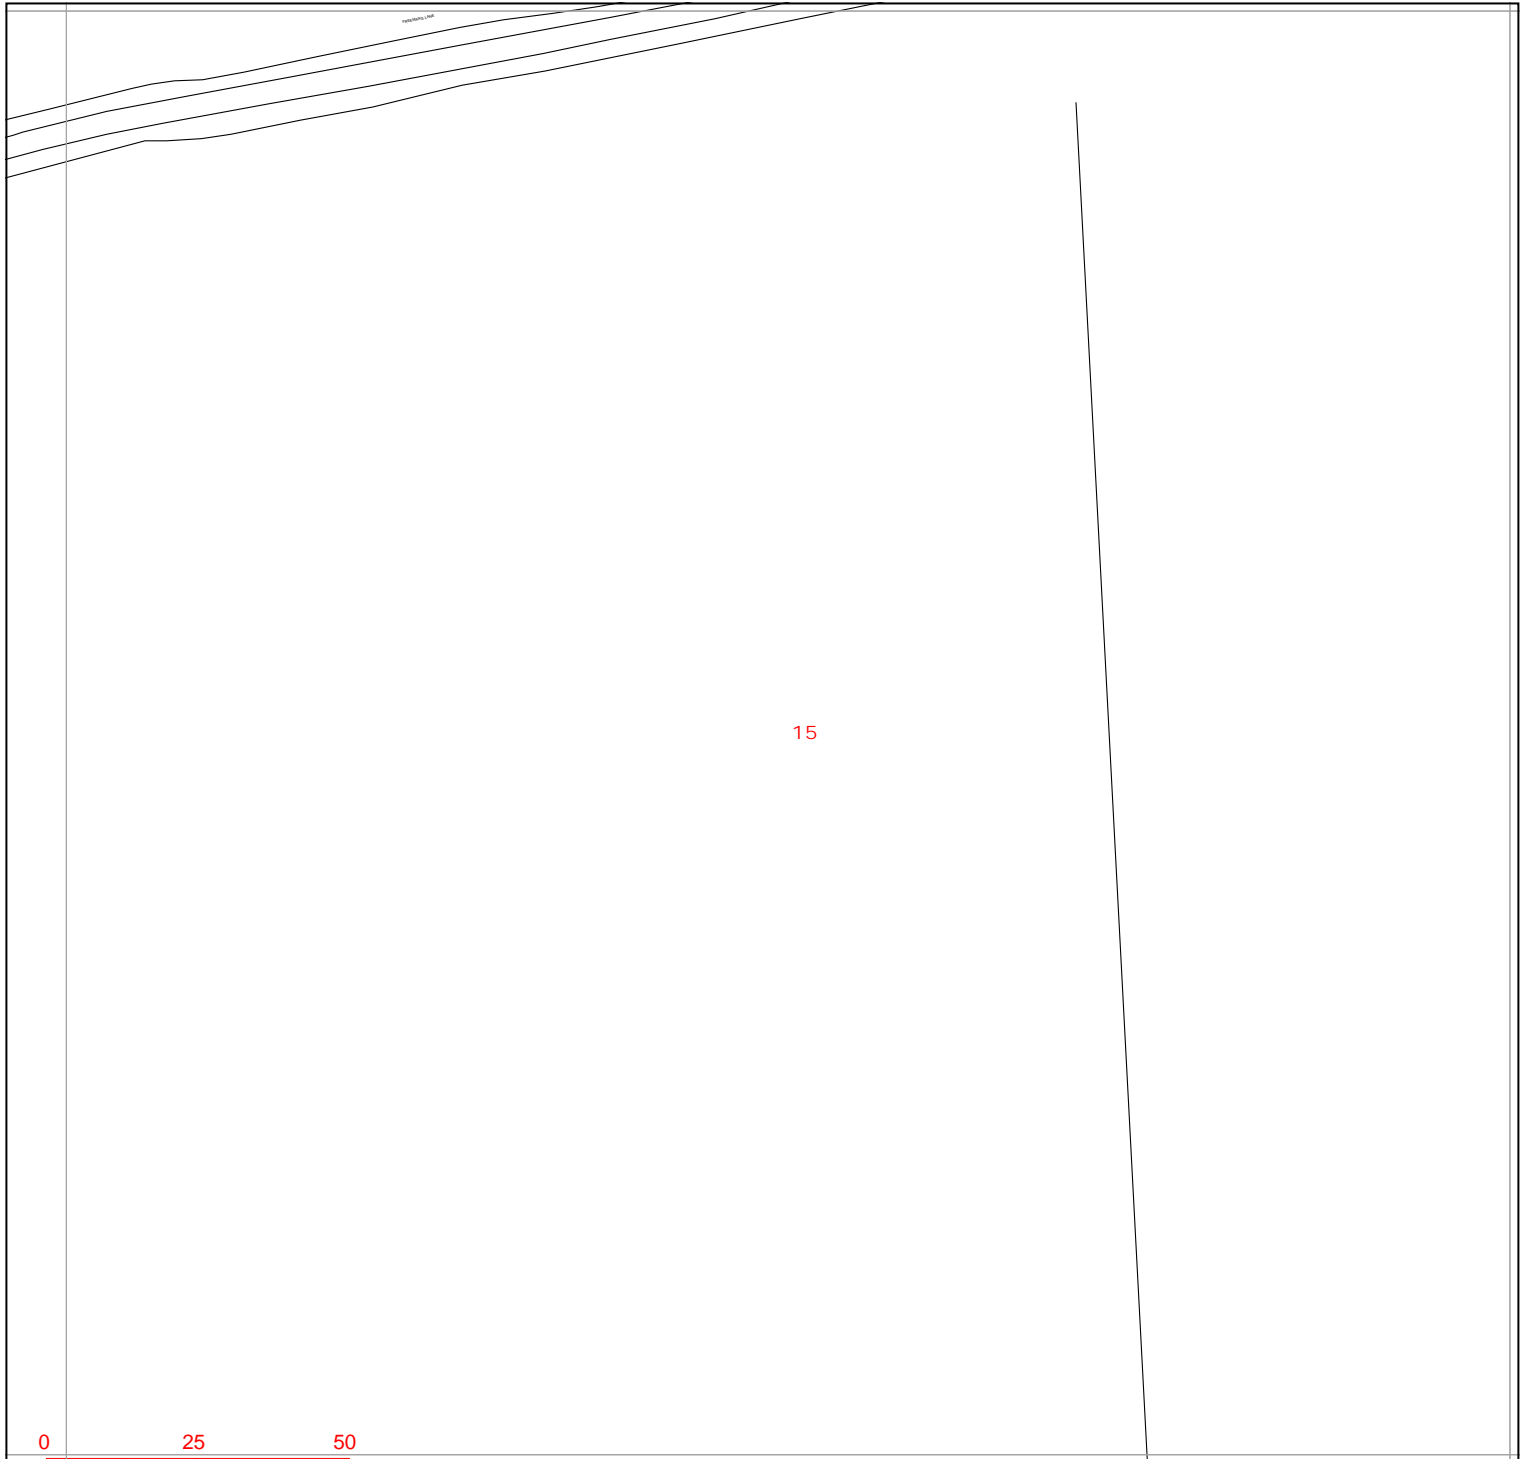


Warning: PDF designed for colour print only with no page scaling.



Contact Us
Mapping Enquiries:
 All areas 0121 623 9780
General Enquiries:
 All areas 0800 096 3080

Date Requested: 08/05/2023
 Job Reference: 29406948
 Site Location: 477674 383832
 Requested by:
 Mr Ben Evans
 Your Scheme/Reference:
 LM 203570/DK - 10

Exact Scales:
 1:1250 Area or Circle dig site
 1:500 Line dig site

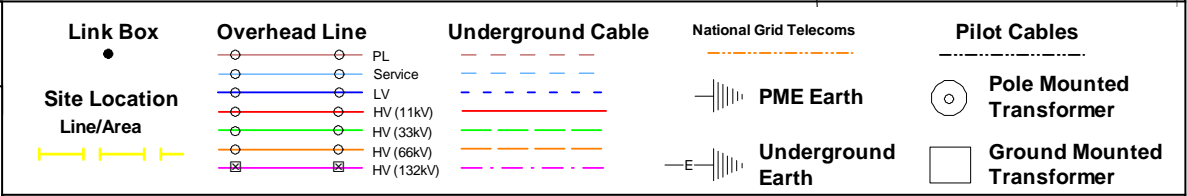


IMPORTANT NOTICES

- This information is given as a guide only and its accuracy cannot be guaranteed. Services or recent additions to the network may not be shown.
- Cables, overhead lines & substations owned by other electricity network owners or private companies may be present and may not be shown.
- You should always verify exact locations of cables using a cable locator and by careful use of hand tools in accordance with HSE guidance note HSG47.
- When working within 10m of any overhead electric line you should follow the requirements of HSE Guidance Note GS6.
- For further advice on working near our electricity cables or lines, call our General Enquiries number.
- Advice should be sought from the National Grid Electricity Distribution General Enquiries team for any work that is to take place in proximity to 132kV underground cables and 132kV overhead lines.

Report damage immediately – KEEP EVERYONE AWAY FROM THE AREA
0800 6783 105

Crown Copyright © All Rights Reserved. Ordnance Survey Licence numbers: 100022432
 NGED Copyright: This copy has been made by or with the authority of National Grid Electricity Distribution (NGED) pursuant to Section 47 of the Copyright Designs and Patents Act 1988 unless that Act provides a relevant exception to copyright the copy must not be copied without the prior permission of the copyright owner.

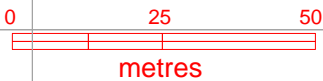

Warning: PDF designed for colour print only with no page scaling.

nationalgrid Electricity Distribution

Contact Us

Mapping Enquiries:
All areas 0121 623 9780

General Enquiries:
All areas 0800 096 3080

Date Requested: 08/05/2023
Job Reference: 29406948
Site Location: 477674 383832
Requested by:
Mr Ben Evans
Your Scheme/Reference:
LM 203570/DK - 10

Exact Scales:
1:1250 Area or Circle dig site
1:500 Line dig site


Link Box	Overhead Line	Underground Cable	National Grid Telecoms	Pilot Cables
●	<ul style="list-style-type: none"> ○ PL ○ Service ○ LV ○ HV (11kV) ○ HV (33kV) ○ HV (66kV) ○ HV (132kV) 	<ul style="list-style-type: none"> --- --- --- --- --- --- --- 	<ul style="list-style-type: none"> —E— PME Earth —E— Underground Earth 	<ul style="list-style-type: none"> ○ Pole Mounted Transformer □ Ground Mounted Transformer

IMPORTANT NOTICES

- This information is given as a guide only and its accuracy cannot be guaranteed. Services or recent additions to the network may not be shown.
- Cables, overhead lines & substations owned by other electricity network owners or private companies may be present and may not be shown.
- You should always verify exact locations of cables using a cable locator and by careful use of hand tools in accordance with HSE guidance note HSG47.
- When working within 10m of any overhead electric line you should follow the requirements of HSE Guidance Note GS6.
- For further advice on working near our electricity cables or lines, call our General Enquiries number.
- Advice should be sought from the National Grid Electricity Distribution General Enquiries team for any work that is to take place in proximity to 132kV underground cables and 132kV overhead lines.

Report damage immediately – KEEP EVERYONE AWAY FROM THE AREA
0800 6783 105

Crown Copyright © All Rights Reserved. Ordnance Survey Licence numbers: 100022432
NGED Copyright: This copy has been made by or with the authority of National Grid Electricity Distribution (NGED) pursuant to Section 47 of the Copyright Designs and Patents Act 1988 unless that Act provides a relevant exception to copyright the copy must not be copied without the prior permission of the copyright owner.

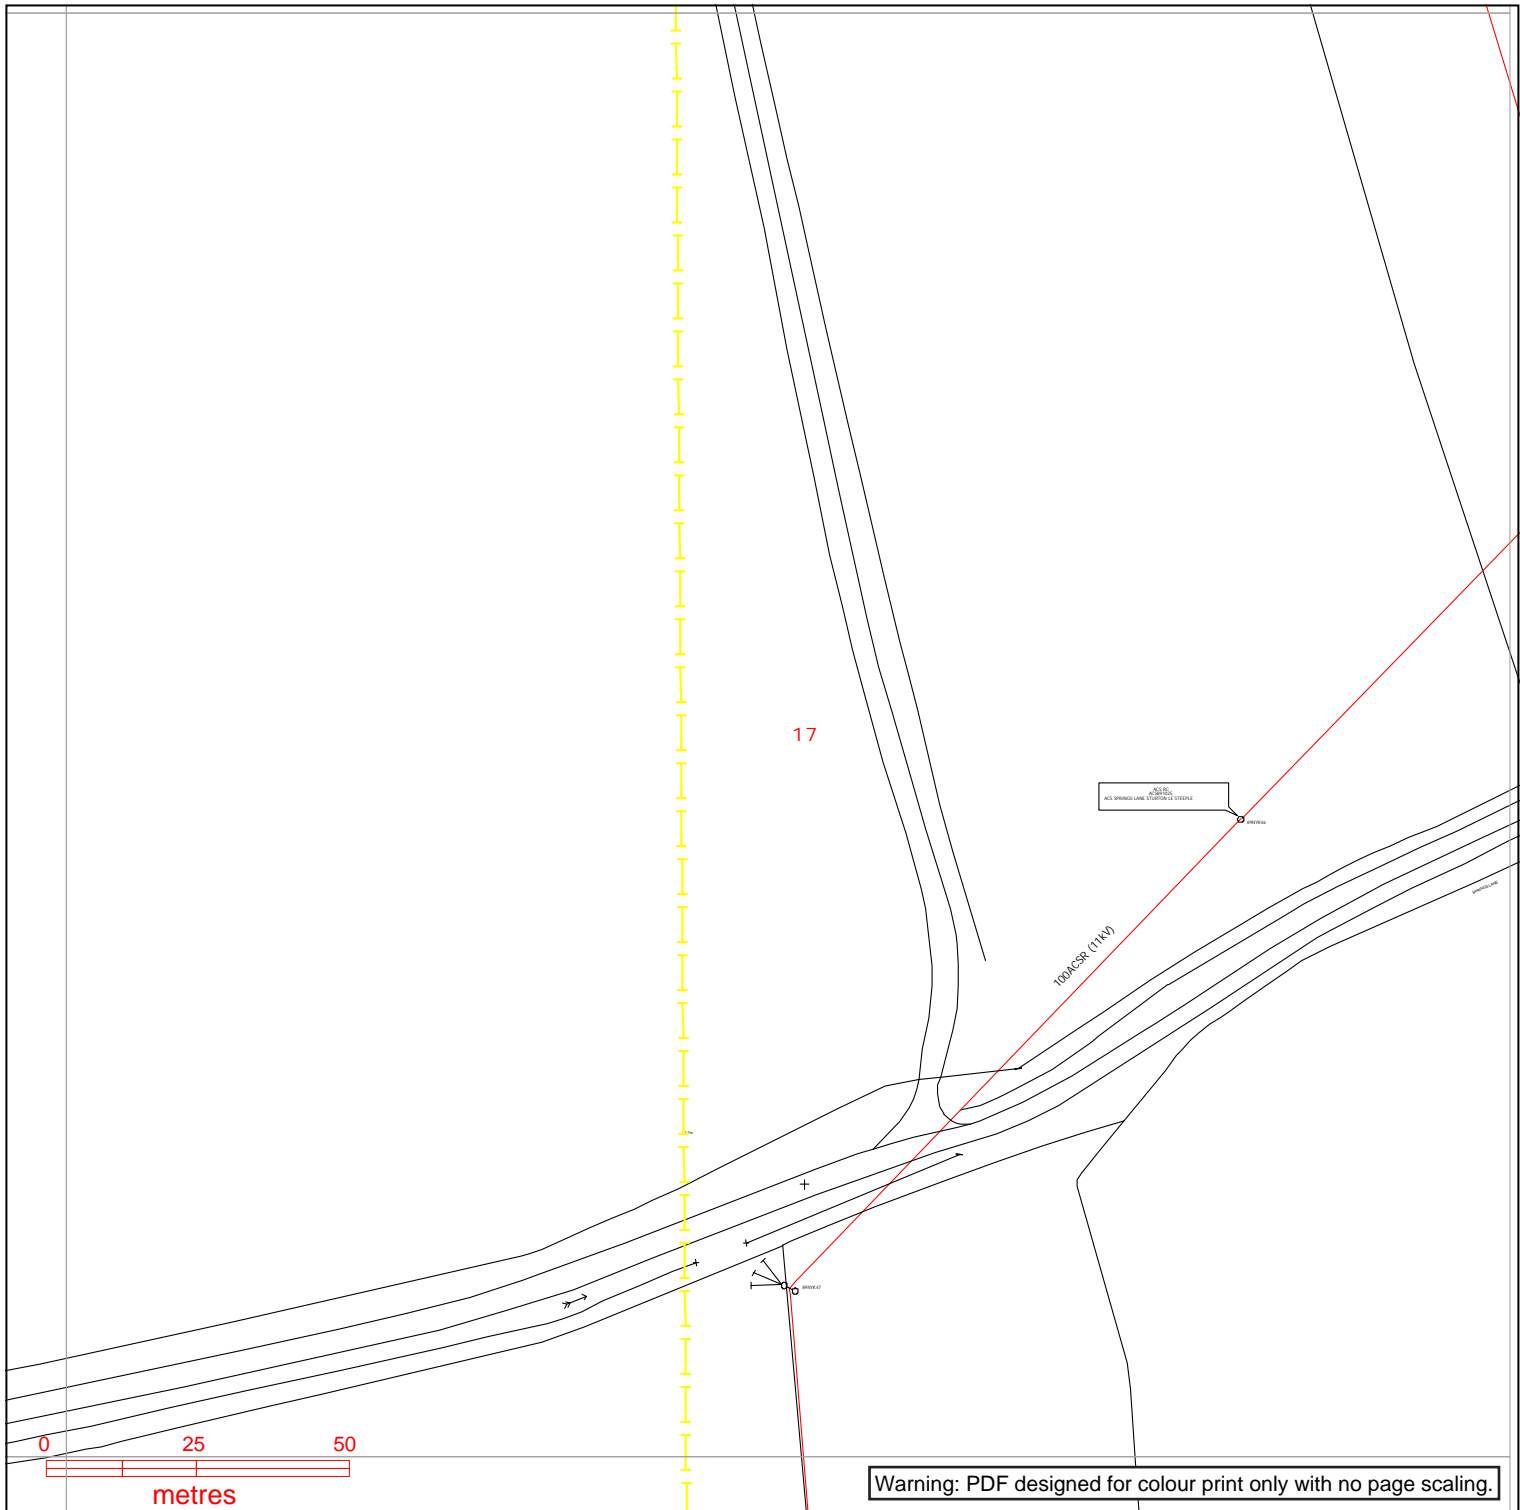

nationalgrid Electricity Distribution

Contact Us

Mapping Enquiries:
All areas 0121 623 9780

General Enquiries:
All areas 0800 096 3080

Date Requested: 08/05/2023
Job Reference: 29406948
Site Location: 477674 383832
Requested by:
Mr Ben Evans
Your Scheme/Reference:
LM 203570/DK - 10

Exact Scales:
1:1250 Area or Circle dig site
1:500 Line dig site


Link Box	Overhead Line	Underground Cable	National Grid Telecoms	Pilot Cables
●	○ PL ○ Service ○ LV ○ HV (11kV) ○ HV (33kV) ○ HV (66kV) ○ HV (132kV)	---	—E— PME Earth —E— Underground Earth	○ Pole Mounted Transformer □ Ground Mounted Transformer
Site Location Line/Area	—	---		

IMPORTANT NOTICES

- This information is given as a guide only and its accuracy cannot be guaranteed. Services or recent additions to the network may not be shown.
- Cables, overhead lines & substations owned by other electricity network owners or private companies may be present and may not be shown.
- You should always verify exact locations of cables using a cable locator and by careful use of hand tools in accordance with HSE guidance note HSG47.
- When working within 10m of any overhead electric line you should follow the requirements of HSE Guidance Note GS6.
- For further advice on working near our electricity cables or lines, call our General Enquiries number.
- Advice should be sought from the National Grid Electricity Distribution General Enquiries team for any work that is to take place in proximity to 132kV underground cables and 132kV overhead lines.

Report damage immediately – KEEP EVERYONE AWAY FROM THE AREA
0800 6783 105

Crown Copyright © All Rights Reserved. Ordnance Survey Licence numbers: 100022432
NGED Copyright: This copy has been made by or with the authority of National Grid Electricity Distribution (NGED) pursuant to Section 47 of the Copyright Designs and Patents Act 1988 unless that Act provides a relevant exception to copyright the copy must not be copied without the prior permission of the copyright owner.

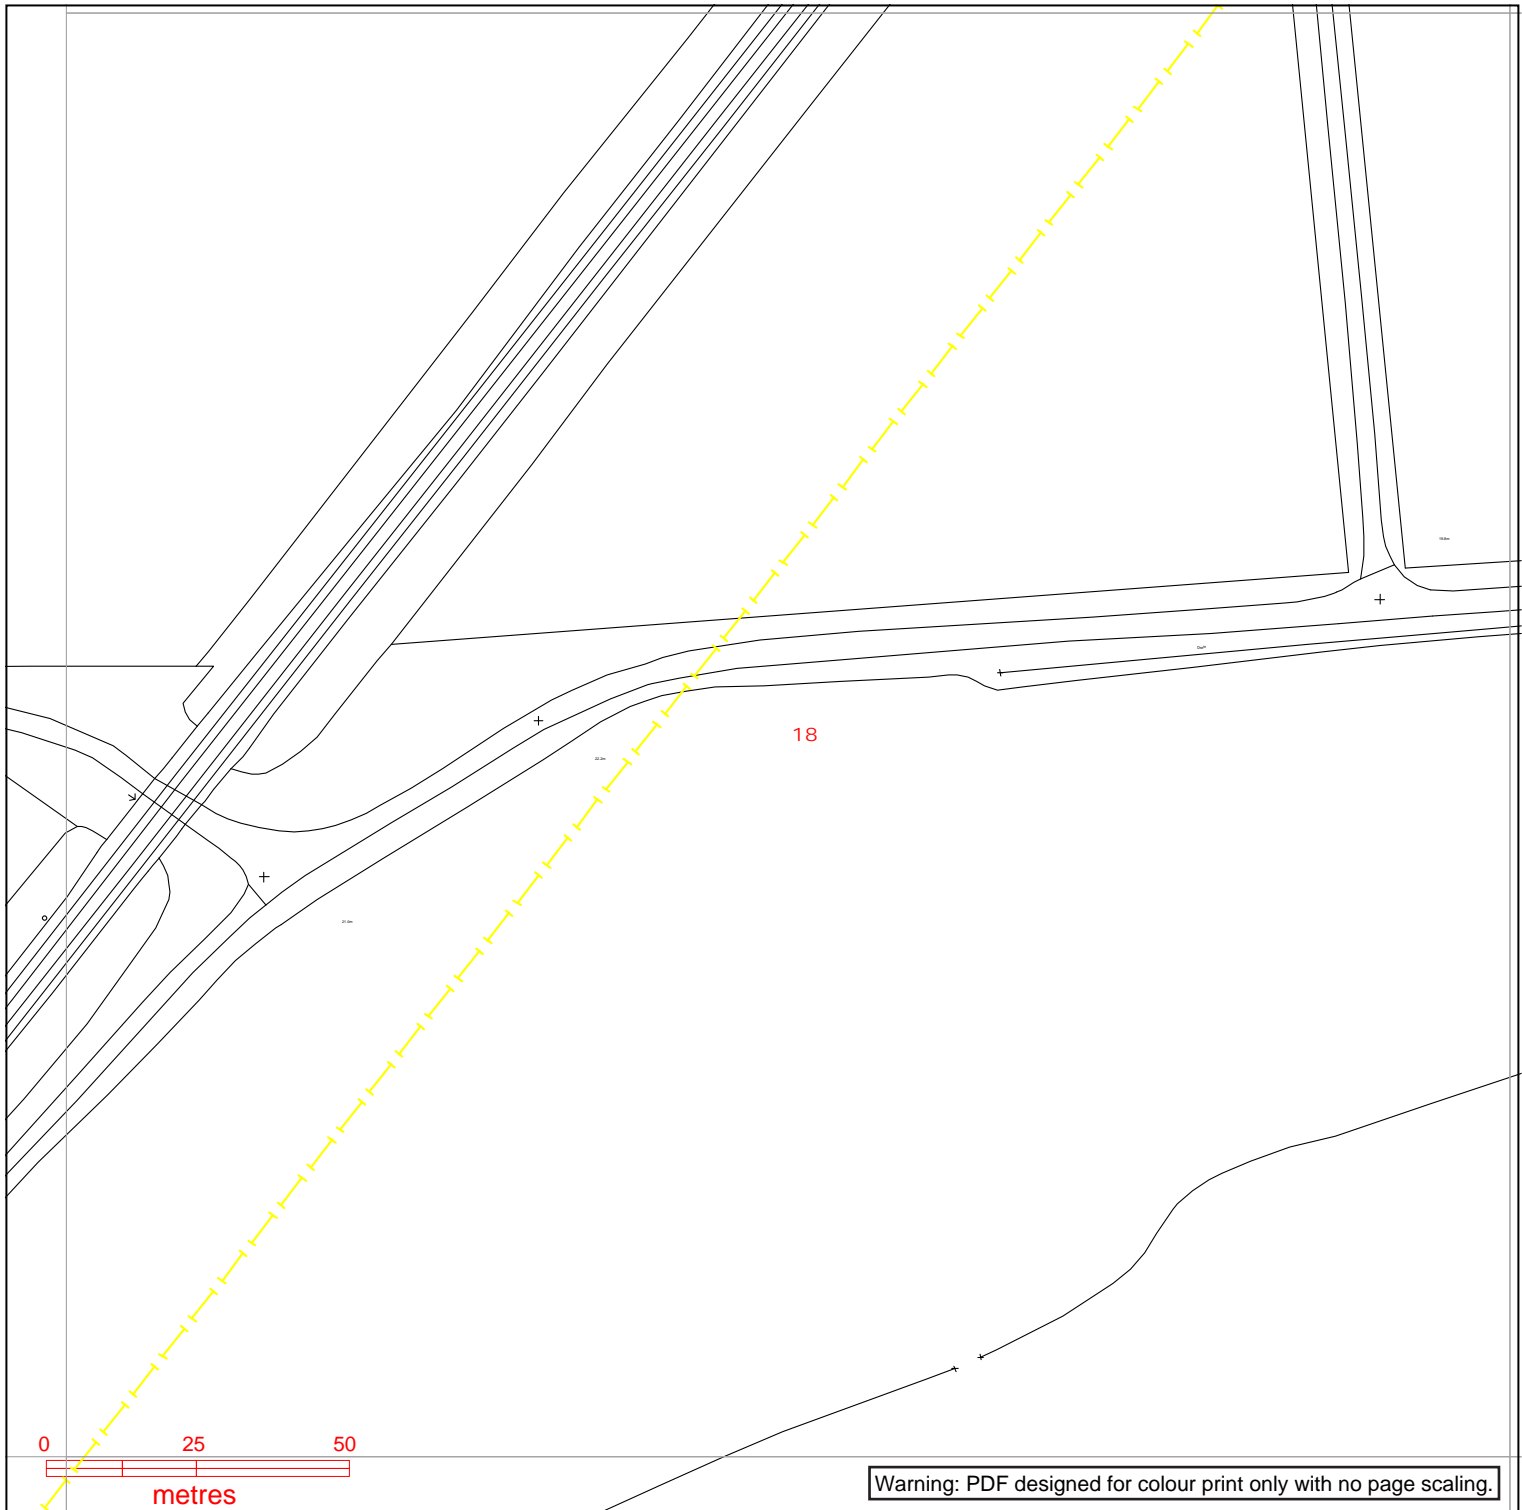

nationalgrid Electricity Distribution

Contact Us

Mapping Enquiries:
All areas 0121 623 9780

General Enquiries:
All areas 0800 096 3080

Date Requested: 08/05/2023
Job Reference: 29406948
Site Location: 477674 383832
Requested by:
Mr Ben Evans
Your Scheme/Reference:
LM 203570/DK - 10

Exact Scales:
1:1250 Area or Circle dig site
1:500 Line dig site

Link Box ●	Overhead Line ○ ○ PL ○ ○ Service ○ ○ LV ○ ○ HV (11kV) ○ ○ HV (33kV) ○ ○ HV (66kV) ○ ○ HV (132kV)	Underground Cable -	National Grid Telecoms - - - - - PME Earth - E - Underground Earth	Pilot Cables ○ Pole Mounted Transformer □ Ground Mounted Transformer
----------------------	--	---	---	---

IMPORTANT NOTICES

- This information is given as a guide only and its accuracy cannot be guaranteed. Services or recent additions to the network may not be shown.
- Cables, overhead lines & substations owned by other electricity network owners or private companies may be present and may not be shown.
- You should always verify exact locations of cables using a cable locator and by careful use of hand tools in accordance with HSE guidance note HSG47.
- When working within 10m of any overhead electric line you should follow the requirements of HSE Guidance Note GS6.
- For further advice on working near our electricity cables or lines, call our General Enquiries number.
- Advice should be sought from the National Grid Electricity Distribution General Enquiries team for any work that is to take place in proximity to 132kV underground cables and 132kV overhead lines.

Report damage immediately – KEEP EVERYONE AWAY FROM THE AREA
0800 6783 105

Crown Copyright © All Rights Reserved. Ordnance Survey Licence numbers: 100022432
NGED Copyright: This copy has been made by or with the authority of National Grid Electricity Distribution (NGED) pursuant to Section 47 of the Copyright Designs and Patents Act 1988 unless that Act provides a relevant exception to copyright the copy must not be copied without the prior permission of the copyright owner.




Warning: PDF designed for colour print only with no page scaling.



Contact Us
Mapping Enquiries:
 All areas 0121 623 9780
General Enquiries:
 All areas 0800 096 3080

Date Requested: 08/05/2023
 Job Reference: 29406948
 Site Location: 477674 383832
 Requested by:
 Mr Ben Evans
 Your Scheme/Reference:
 LM 203570/DK - 10

Exact Scales:
 1:1250 Area or Circle dig site
 1:500 Line dig site

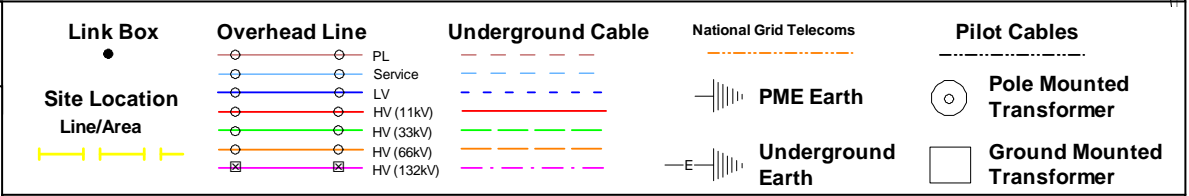


IMPORTANT NOTICES

- This information is given as a guide only and its accuracy cannot be guaranteed. Services or recent additions to the network may not be shown.
- Cables, overhead lines & substations owned by other electricity network owners or private companies may be present and may not be shown.
- You should always verify exact locations of cables using a cable locator and by careful use of hand tools in accordance with HSE guidance note HSG47.
- When working within 10m of any overhead electric line you should follow the requirements of HSE Guidance Note GS6.
- For further advice on working near our electricity cables or lines, call our General Enquiries number.
- Advice should be sought from the National Grid Electricity Distribution General Enquiries team for any work that is to take place in proximity to 132kV underground cables and 132kV overhead lines.

Report damage immediately – KEEP EVERYONE AWAY FROM THE AREA
0800 6783 105

Crown Copyright © All Rights Reserved. Ordnance Survey Licence numbers: 100022432
 NGED Copyright: This copy has been made by or with the authority of National Grid Electricity Distribution (NGED) pursuant to Section 47 of the Copyright Designs and Patents Act 1988 unless that Act provides a relevant exception to copyright the copy must not be copied without the prior permission of the copyright owner.

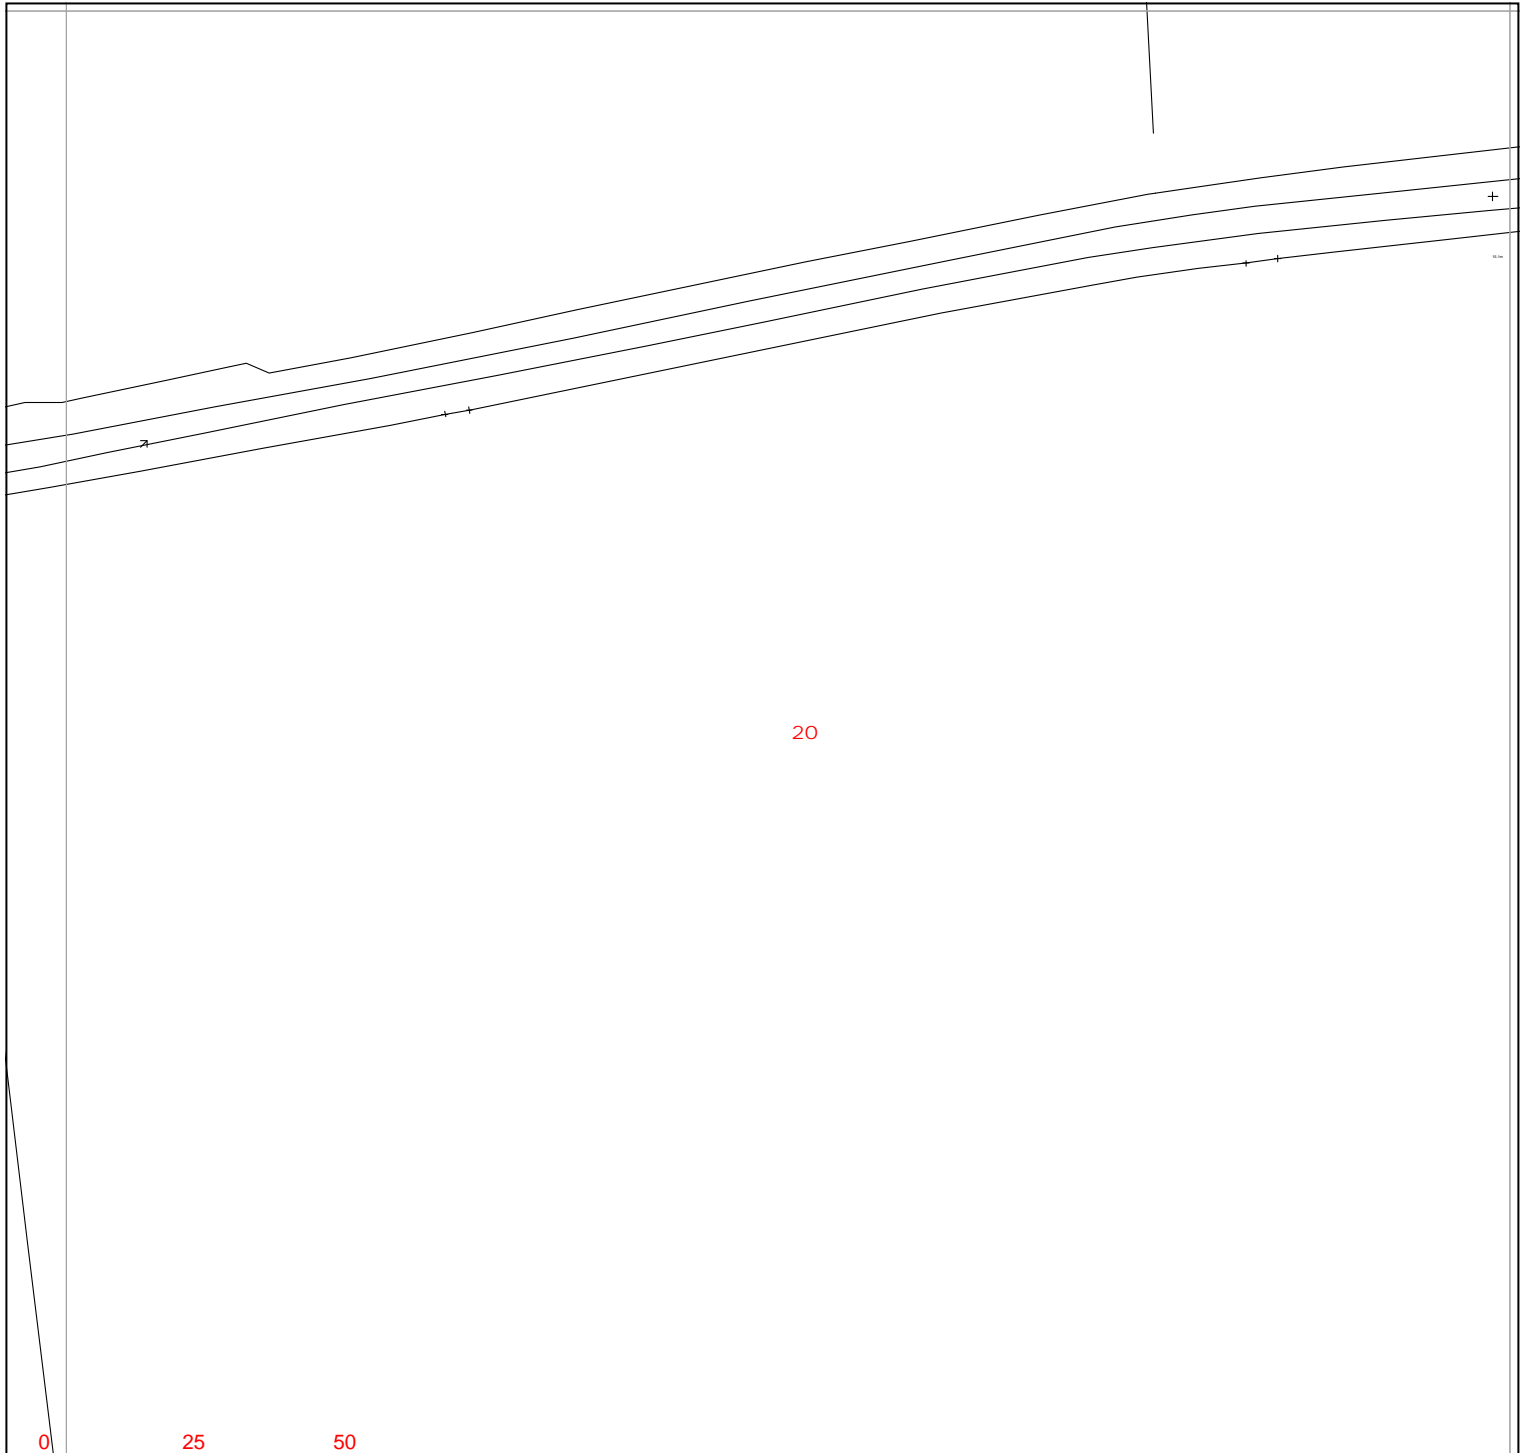

Warning: PDF designed for colour print only with no page scaling.




Contact Us
 Mapping Enquiries:
 All areas 0121 623 9780

General Enquiries:
 All areas 0800 096 3080

Date Requested: 08/05/2023
 Job Reference: 29406948
 Site Location: 477674 383832
 Requested by:
 Mr Ben Evans
 Your Scheme/Reference:
 LM 203570/DK - 10

Exact Scales:
 1:1250 Area or Circle dig site
 1:500 Line dig site

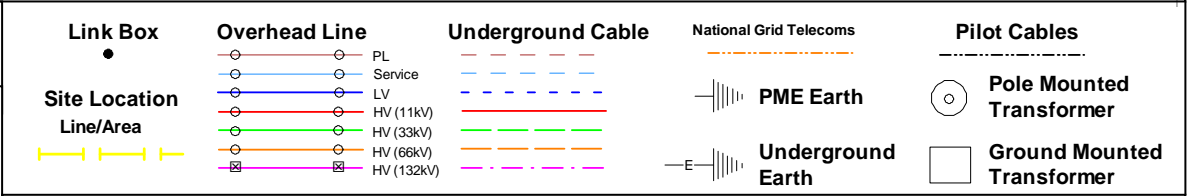


IMPORTANT NOTICES


- This information is given as a guide only and its accuracy cannot be guaranteed. Services or recent additions to the network may not be shown.
- Cables, overhead lines & substations owned by other electricity network owners or private companies may be present and may not be shown.
- You should always verify exact locations of cables using a cable locator and by careful use of hand tools in accordance with HSE guidance note HSG47.
- When working within 10m of any overhead electric line you should follow the requirements of HSE Guidance Note GS6.
- For further advice on working near our electricity cables or lines, call our General Enquiries number.
- Advice should be sought from the National Grid Electricity Distribution General Enquiries team for any work that is to take place in proximity to 132kV underground cables and 132kV overhead lines.

Report damage immediately – KEEP EVERYONE AWAY FROM THE AREA
0800 6783 105

Crown Copyright © All Rights Reserved. Ordnance Survey Licence numbers: 100022432
 NGED Copyright: This copy has been made by or with the authority of National Grid Electricity Distribution (NGED) pursuant to Section 47 of the Copyright Designs and Patents Act 1988 unless that Act provides a relevant exception to copyright the copy must not be copied without the prior permission of the copyright owner.

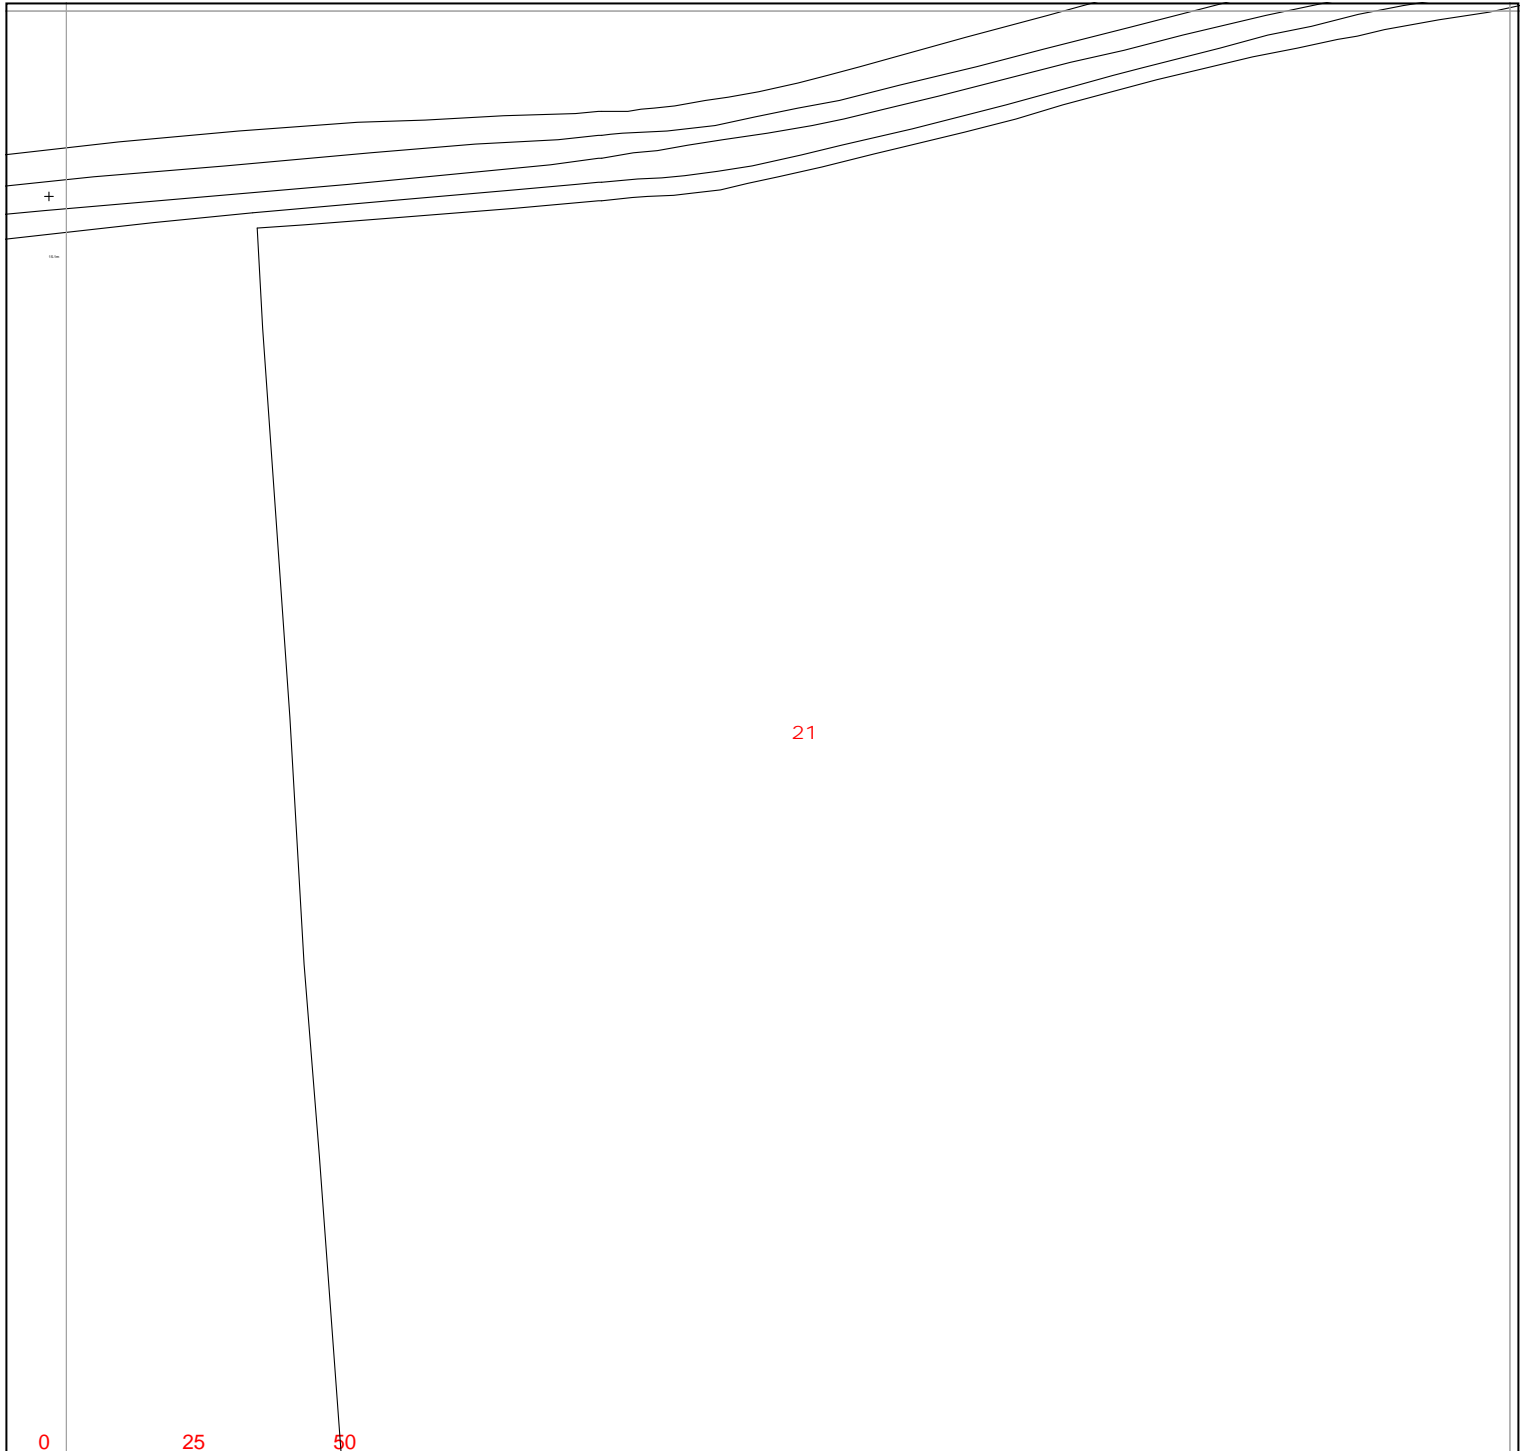

21

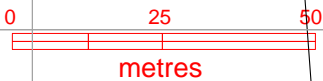

Warning: PDF designed for colour print only with no page scaling.

nationalgrid Electricity Distribution

Contact Us

Mapping Enquiries:
All areas 0121 623 9780

General Enquiries:
All areas 0800 096 3080

Date Requested: 08/05/2023
Job Reference: 29406948
Site Location: 477674 383832
Requested by:
Mr Ben Evans
Your Scheme/Reference:
LM 203570/DK - 10

Exact Scales:
1:1250 Area or Circle dig site
1:500 Line dig site


Link Box ●	Overhead Line ○—○ PL ○—○ Service ○—○ LV ○—○ HV (11kV) ○—○ HV (33kV) ○—○ HV (66kV) ○—○ HV (132kV)	Underground Cable -	National Grid Telecoms - - - - - PME Earth Underground Earth	Pilot Cables ○ □ Pole Mounted Transformer Ground Mounted Transformer
----------------------	--	---	--	---

IMPORTANT NOTICES

- This information is given as a guide only and its accuracy cannot be guaranteed. Services or recent additions to the network may not be shown.
- Cables, overhead lines & substations owned by other electricity network owners or private companies may be present and may not be shown.
- You should always verify exact locations of cables using a cable locator and by careful use of hand tools in accordance with HSE guidance note HSG47.
- When working within 10m of any overhead electric line you should follow the requirements of HSE Guidance Note GS6.
- For further advice on working near our electricity cables or lines, call our General Enquiries number.
- Advice should be sought from the National Grid Electricity Distribution General Enquiries team for any work that is to take place in proximity to 132kV underground cables and 132kV overhead lines.

Report damage immediately – KEEP EVERYONE AWAY FROM THE AREA
0800 6783 105

Crown Copyright © All Rights Reserved. Ordnance Survey Licence numbers: 100022432
NGED Copyright: This copy has been made by or with the authority of National Grid Electricity Distribution (NGED) pursuant to Section 47 of the Copyright Designs and Patents Act 1988 unless that Act provides a relevant exception to copyright the copy must not be copied without the prior permission of the copyright owner.

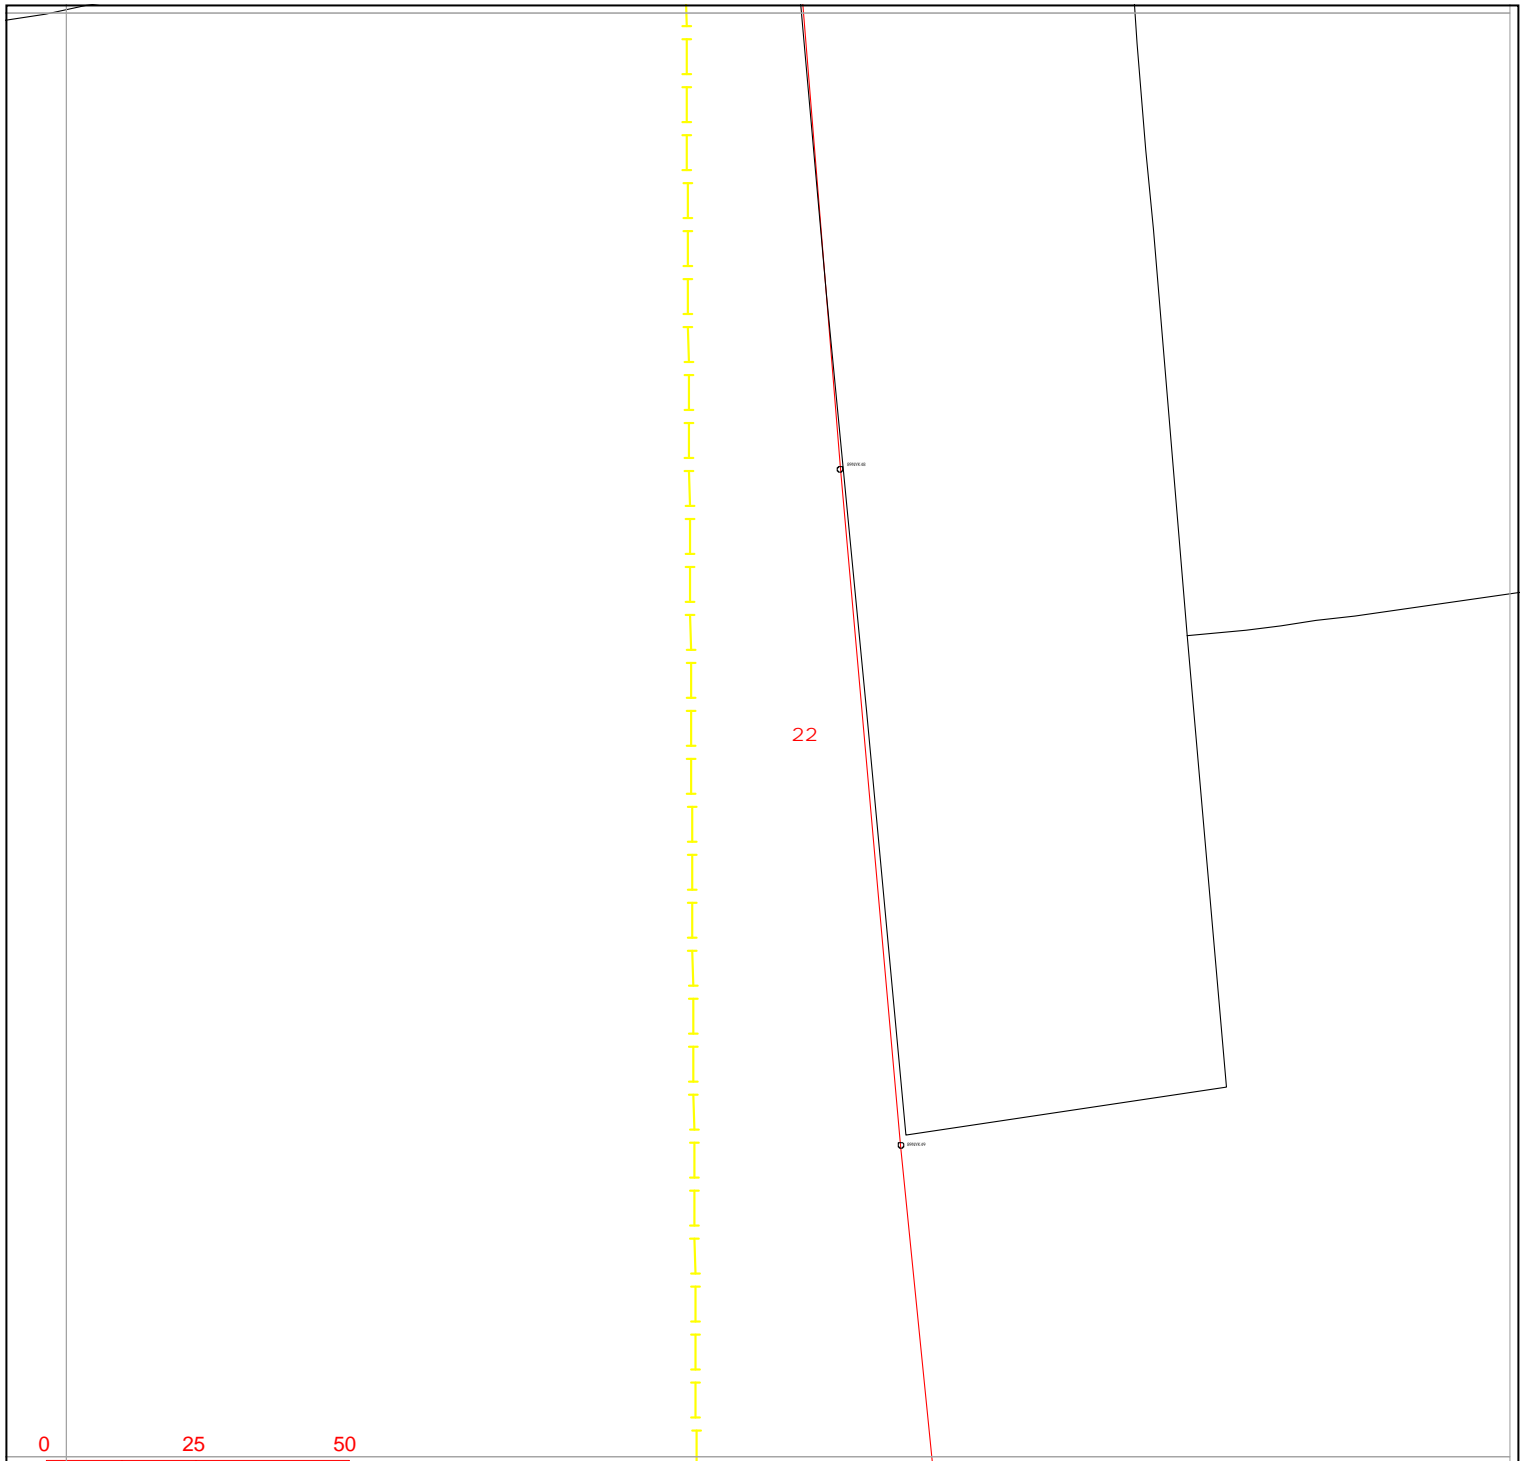

Warning: PDF designed for colour print only with no page scaling.

nationalgrid Electricity Distribution

Contact Us

Mapping Enquiries:
All areas 0121 623 9780

General Enquiries:
All areas 0800 096 3080

Date Requested: 08/05/2023
Job Reference: 29406948
Site Location: 477674 383832
Requested by:
Mr Ben Evans
Your Scheme/Reference:
LM 203570/DK - 10

Exact Scales:
1:1250 Area or Circle dig site
1:500 Line dig site


Link Box ●	Overhead Line ○—○ PL ○—○ Service ○—○ LV ○—○ HV (11kV) ○—○ HV (33kV) ○—○ HV (66kV) ○—○ HV (132kV)	Underground Cable -	National Grid Telecoms - - - - - PME Earth -E- - - - - Underground Earth	Pilot Cables ○ Pole Mounted Transformer □ Ground Mounted Transformer
----------------------	--	---	---	---

IMPORTANT NOTICES

- This information is given as a guide only and its accuracy cannot be guaranteed. Services or recent additions to the network may not be shown.
- Cables, overhead lines & substations owned by other electricity network owners or private companies may be present and may not be shown.
- You should always verify exact locations of cables using a cable locator and by careful use of hand tools in accordance with HSE guidance note HSG47.
- When working within 10m of any overhead electric line you should follow the requirements of HSE Guidance Note GS6.
- For further advice on working near our electricity cables or lines, call our General Enquiries number.
- Advice should be sought from the National Grid Electricity Distribution General Enquiries team for any work that is to take place in proximity to 132kV underground cables and 132kV overhead lines.

Report damage immediately – KEEP EVERYONE AWAY FROM THE AREA
0800 6783 105

Crown Copyright © All Rights Reserved. Ordnance Survey Licence numbers: 100022432
NGED Copyright: This copy has been made by or with the authority of National Grid Electricity Distribution (NGED) pursuant to Section 47 of the Copyright Designs and Patents Act 1988 unless that Act provides a relevant exception to copyright the copy must not be copied without the prior permission of the copyright owner.

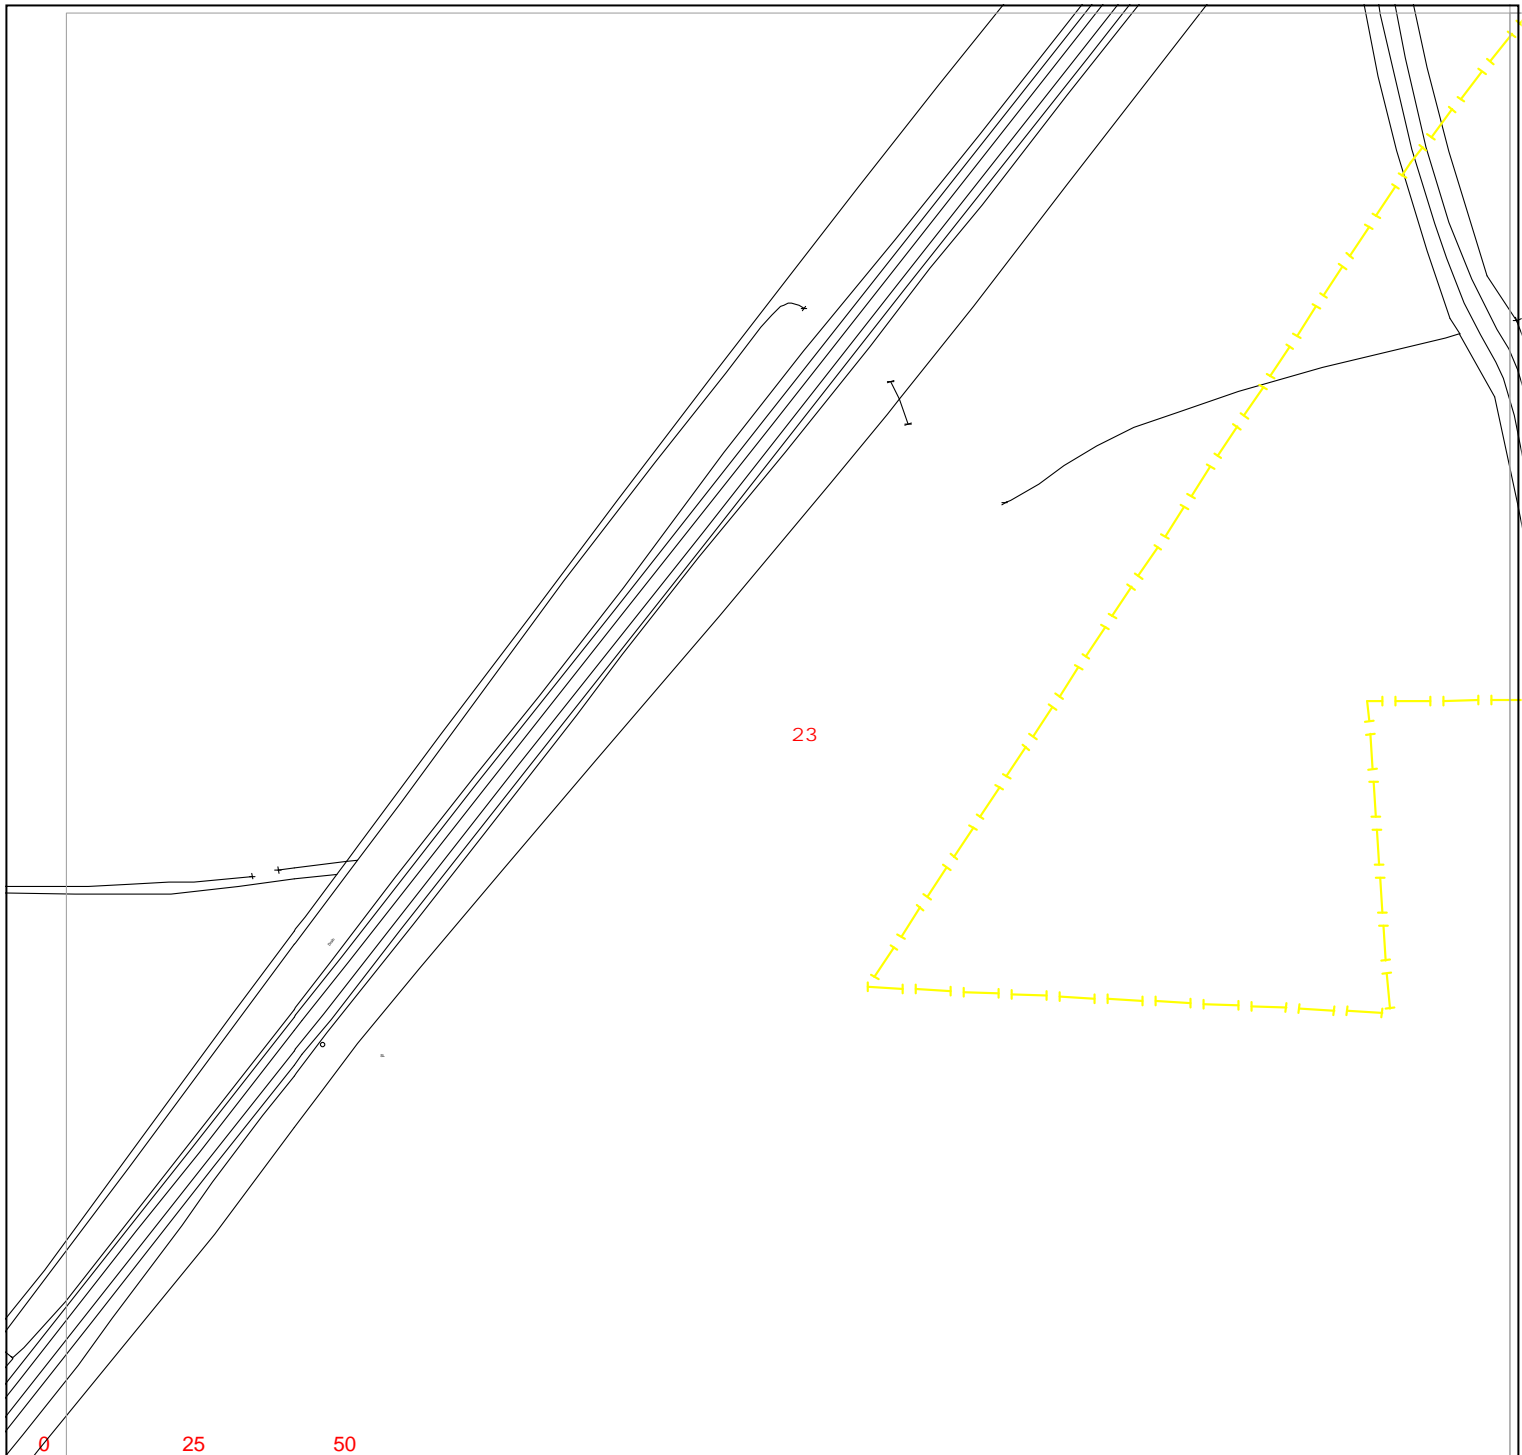

Warning: PDF designed for colour print only with no page scaling.

nationalgrid Electricity Distribution

Contact Us

Mapping Enquiries:
All areas 0121 623 9780

General Enquiries:
All areas 0800 096 3080

Date Requested: 08/05/2023
Job Reference: 29406948
Site Location: 477674 383832
Requested by:
Mr Ben Evans
Your Scheme/Reference:
LM 203570/DK - 10

Exact Scales:
1:1250 Area or Circle dig site
1:500 Line dig site


Link Box	Overhead Line	Underground Cable	National Grid Telecoms	Pilot Cables
●	<ul style="list-style-type: none"> ○ PL ○ Service ○ LV ○ HV (11kV) ○ HV (33kV) ○ HV (66kV) ○ HV (132kV) 	<ul style="list-style-type: none"> --- --- --- --- --- --- --- 	<ul style="list-style-type: none"> --- PME Earth ---E Underground Earth 	<ul style="list-style-type: none"> ○ Pole Mounted Transformer □ Ground Mounted Transformer
<ul style="list-style-type: none"> --- Site Location --- Line/Area 				

IMPORTANT NOTICES

- This information is given as a guide only and its accuracy cannot be guaranteed. Services or recent additions to the network may not be shown.
- Cables, overhead lines & substations owned by other electricity network owners or private companies may be present and may not be shown.
- You should always verify exact locations of cables using a cable locator and by careful use of hand tools in accordance with HSE guidance note HSG47.
- When working within 10m of any overhead electric line you should follow the requirements of HSE Guidance Note GS6.
- For further advice on working near our electricity cables or lines, call our General Enquiries number.
- Advice should be sought from the National Grid Electricity Distribution General Enquiries team for any work that is to take place in proximity to 132kV underground cables and 132kV overhead lines.

Report damage immediately – KEEP EVERYONE AWAY FROM THE AREA
0800 6783 105

Crown Copyright © All Rights Reserved. Ordnance Survey Licence numbers: 100022432
NGED Copyright: This copy has been made by or with the authority of National Grid Electricity Distribution (NGED) pursuant to Section 47 of the Copyright Designs and Patents Act 1988 unless that Act provides a relevant exception to copyright the copy must not be copied without the prior permission of the copyright owner.

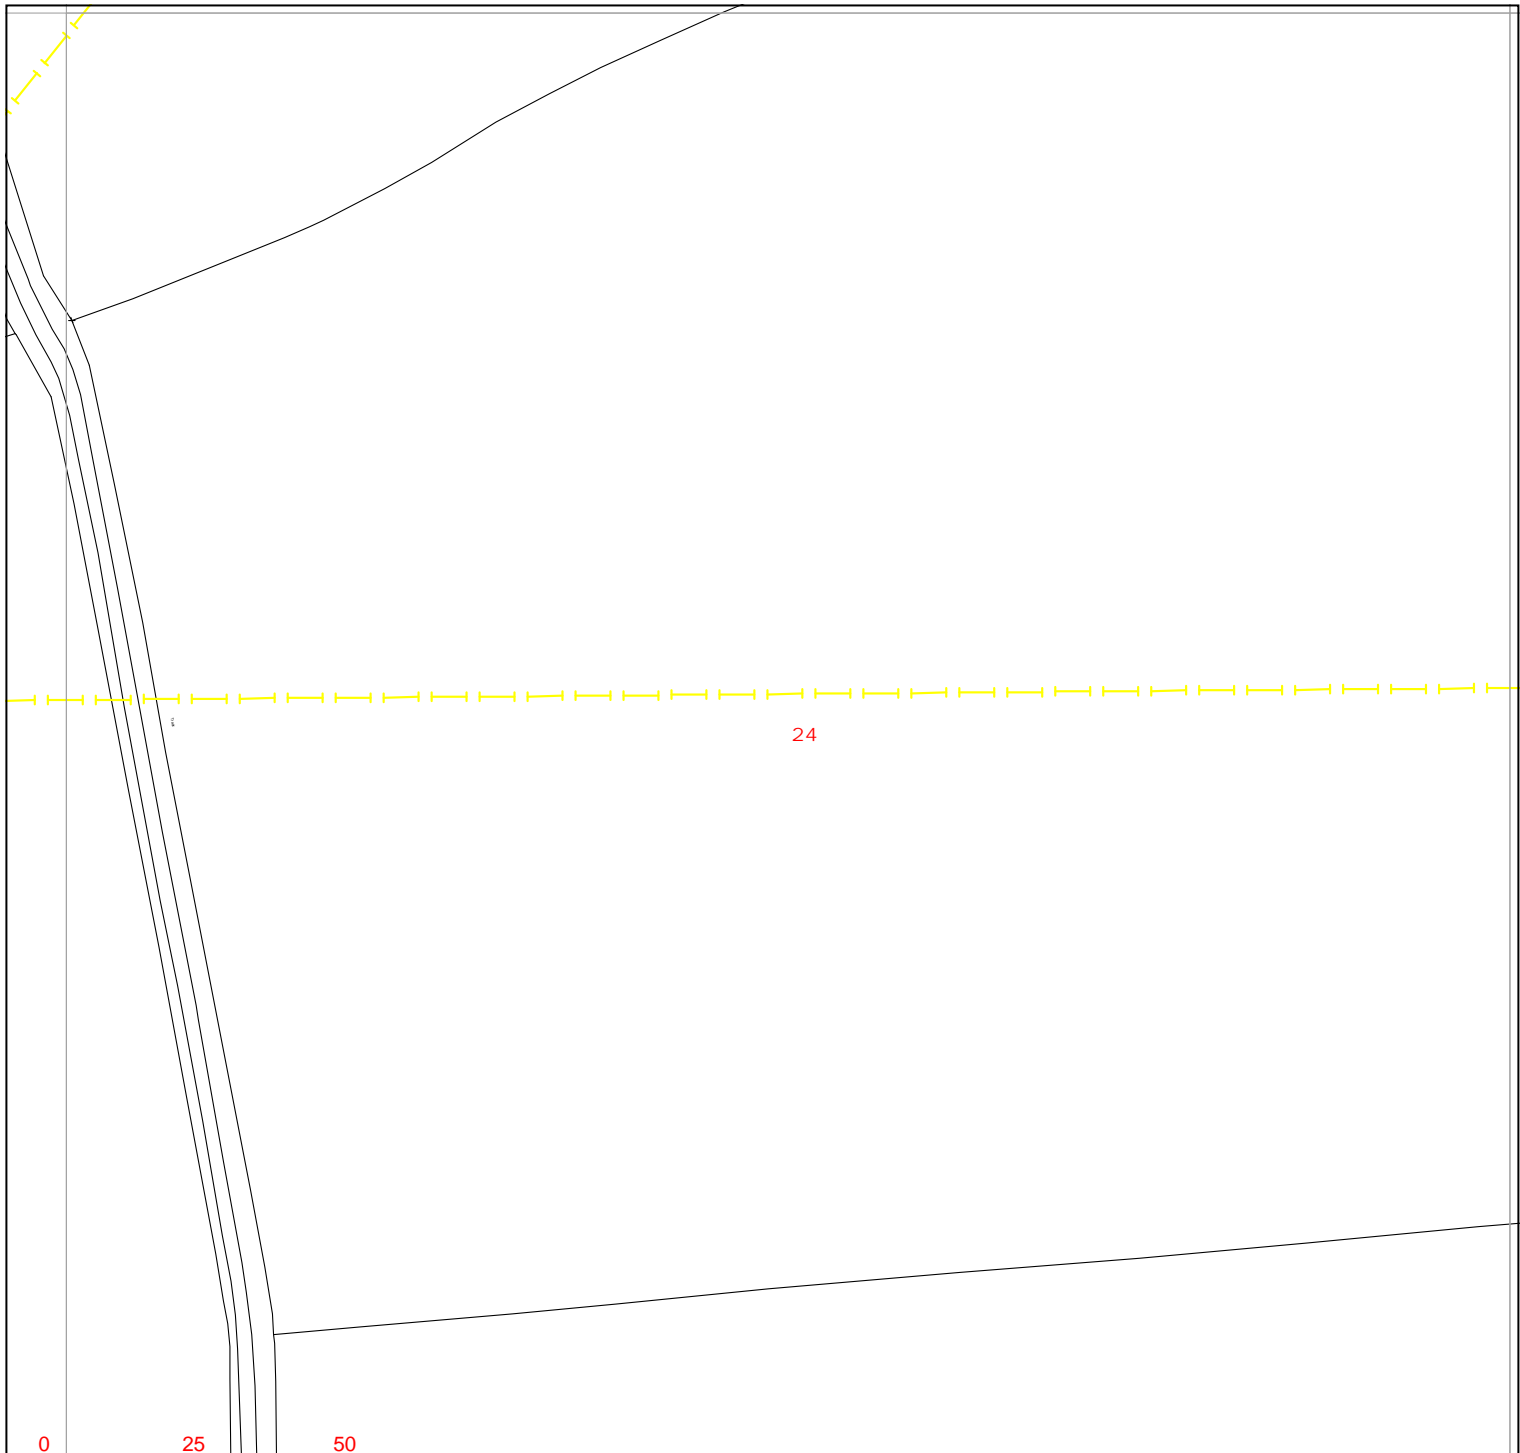

Warning: PDF designed for colour print only with no page scaling.

nationalgrid Electricity Distribution

Contact Us

Mapping Enquiries:
All areas 0121 623 9780

General Enquiries:
All areas 0800 096 3080

Date Requested: 08/05/2023
Job Reference: 29406948
Site Location: 477674 383832
Requested by:
Mr Ben Evans
Your Scheme/Reference:
LM 203570/DK - 10

Exact Scales:
1:1250 Area or Circle dig site
1:500 Line dig site


Link Box ●	Overhead Line ○—○ PL ○—○ Service ○—○ LV ○—○ HV (11kV) ○—○ HV (33kV) ○—○ HV (66kV) ○—○ HV (132kV)	Underground Cable -	National Grid Telecoms - - - - - PME Earth -E- - - - - Underground Earth	Pilot Cables ○ Pole Mounted Transformer □ Ground Mounted Transformer
----------------------	--	---	---	---

IMPORTANT NOTICES

- This information is given as a guide only and its accuracy cannot be guaranteed. Services or recent additions to the network may not be shown.
- Cables, overhead lines & substations owned by other electricity network owners or private companies may be present and may not be shown.
- You should always verify exact locations of cables using a cable locator and by careful use of hand tools in accordance with HSE guidance note HSG47.
- When working within 10m of any overhead electric line you should follow the requirements of HSE Guidance Note GS6.
- For further advice on working near our electricity cables or lines, call our General Enquiries number.
- Advice should be sought from the National Grid Electricity Distribution General Enquiries team for any work that is to take place in proximity to 132kV underground cables and 132kV overhead lines.

Report damage immediately – KEEP EVERYONE AWAY FROM THE AREA
0800 6783 105

Crown Copyright © All Rights Reserved. Ordnance Survey Licence numbers: 100022432
NGED Copyright: This copy has been made by or with the authority of National Grid Electricity Distribution (NGED) pursuant to Section 47 of the Copyright Designs and Patents Act 1988 unless that Act provides a relevant exception to copyright the copy must not be copied without the prior permission of the copyright owner.

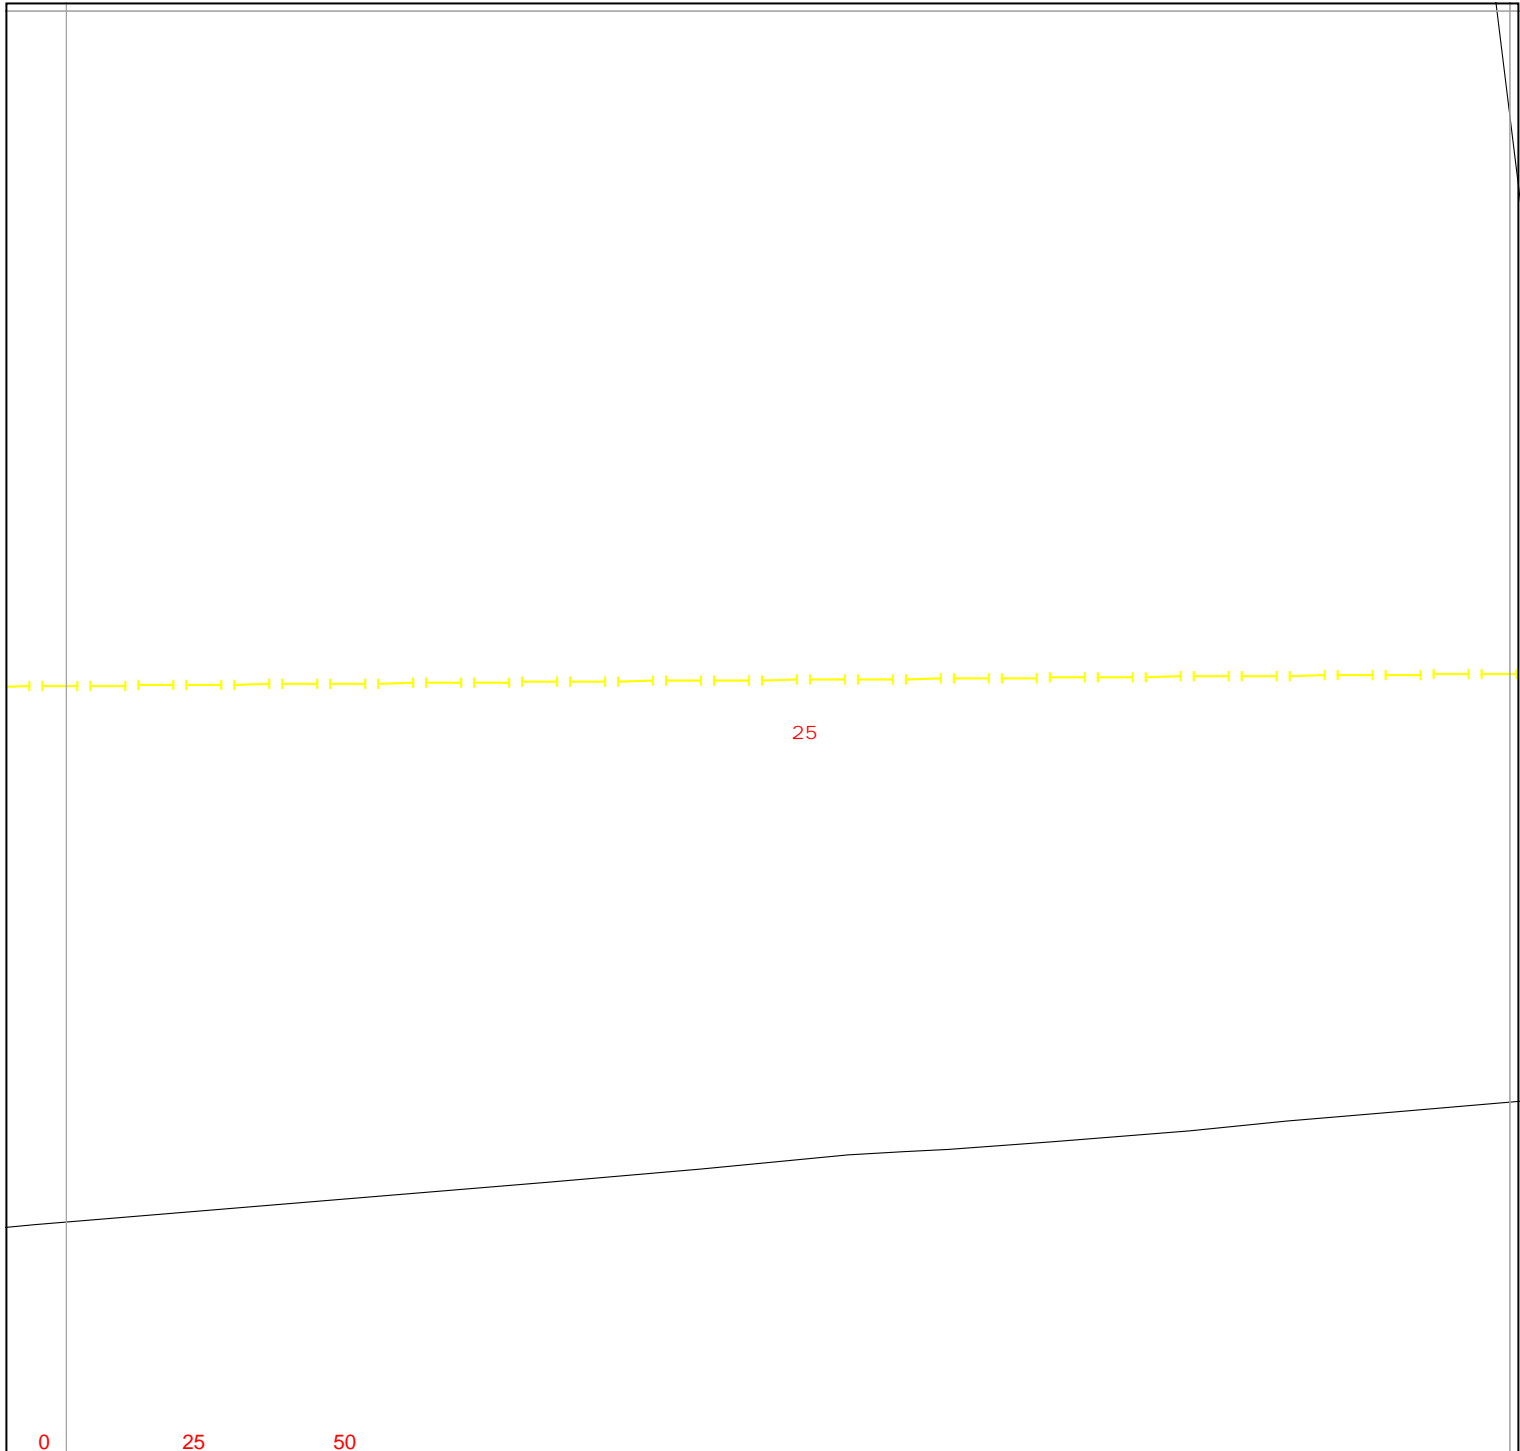

Warning: PDF designed for colour print only with no page scaling.

nationalgrid Electricity Distribution

Contact Us

Mapping Enquiries:
All areas 0121 623 9780

General Enquiries:
All areas 0800 096 3080

Date Requested: 08/05/2023
Job Reference: 29406948
Site Location: 477674 383832
Requested by:
Mr Ben Evans
Your Scheme/Reference:
LM 203570/DK - 10

Exact Scales:
1:1250 Area or Circle dig site
1:500 Line dig site


Link Box	Overhead Line	Underground Cable	National Grid Telecoms	Pilot Cables
●				
●	<p>Site Location</p> <p>Line/Area</p>			

IMPORTANT NOTICES

- This information is given as a guide only and its accuracy cannot be guaranteed. Services or recent additions to the network may not be shown.
- Cables, overhead lines & substations owned by other electricity network owners or private companies may be present and may not be shown.
- You should always verify exact locations of cables using a cable locator and by careful use of hand tools in accordance with HSE guidance note HSG47.
- When working within 10m of any overhead electric line you should follow the requirements of HSE Guidance Note GS6.
- For further advice on working near our electricity cables or lines, call our General Enquiries number.
- Advice should be sought from the National Grid Electricity Distribution General Enquiries team for any work that is to take place in proximity to 132kV underground cables and 132kV overhead lines.

Report damage immediately – KEEP EVERYONE AWAY FROM THE AREA
0800 6783 105

Crown Copyright © All Rights Reserved. Ordnance Survey Licence numbers: 100022432
NGED Copyright: This copy has been made by or with the authority of National Grid Electricity Distribution (NGED) pursuant to Section 47 of the Copyright Designs and Patents Act 1988 unless that Act provides a relevant exception to copyright the copy must not be copied without the prior permission of the copyright owner.

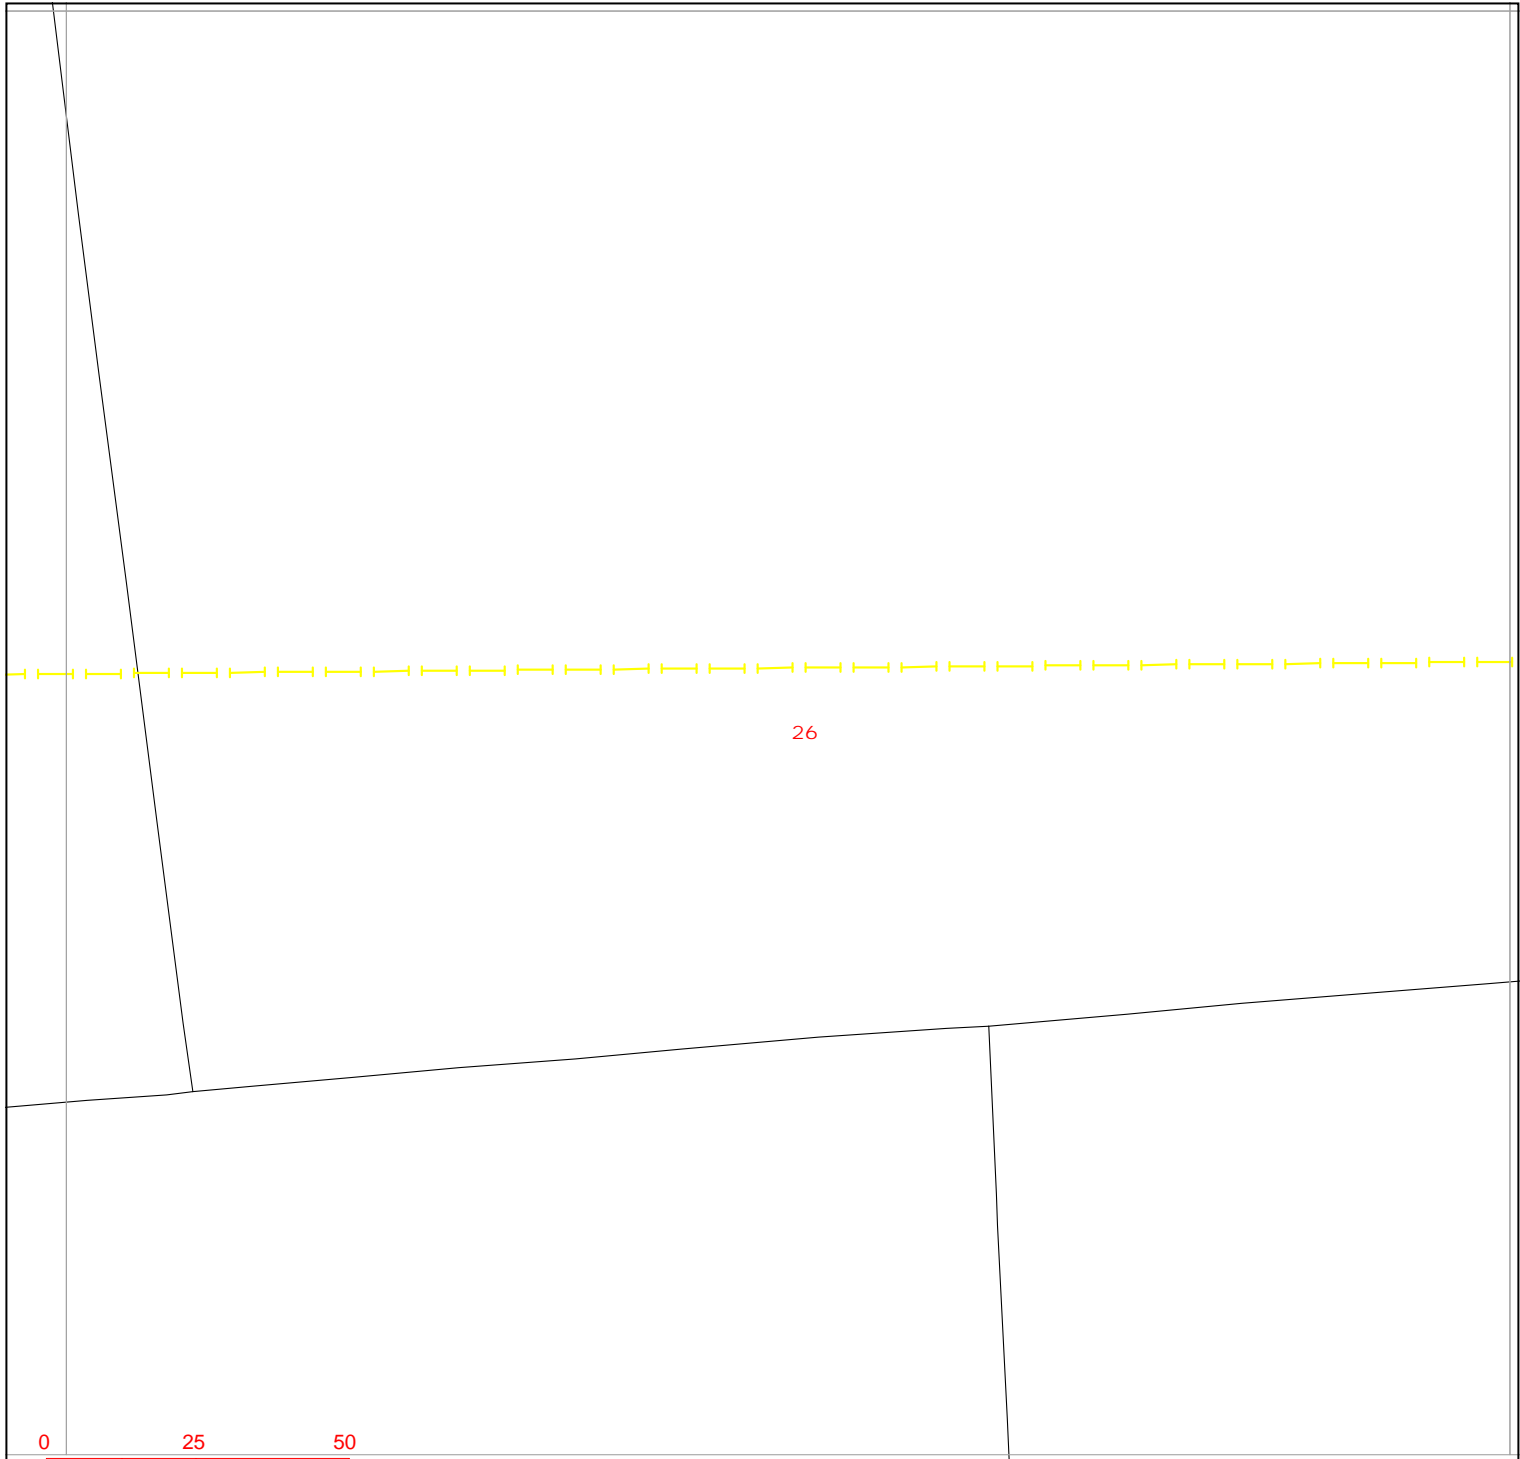

Warning: PDF designed for colour print only with no page scaling.



Contact Us
 Mapping Enquiries:
 All areas 0121 623 9780
 General Enquiries:
 All areas 0800 096 3080

Date Requested: 08/05/2023
 Job Reference: 29406948
 Site Location: 477674 383832
 Requested by:
 Mr Ben Evans
 Your Scheme/Reference:
 LM 203570/DK - 10

Exact Scales:
 1:1250 Area or Circle dig site
 1:500 Line dig site


Link Box ●	Overhead Line ○—○ PL ○—○ Service ○—○ LV ○—○ HV (11kV) ○—○ HV (33kV) ○—○ HV (66kV) ○—○ HV (132kV)	Underground Cable -	National Grid Telecoms - - - - - PME Earth -E- - - - - Underground Earth	Pilot Cables - - - - - ○ Pole Mounted Transformer □ Ground Mounted Transformer
----------------------	--	---	---	--

IMPORTANT NOTICES

- This information is given as a guide only and its accuracy cannot be guaranteed. Services or recent additions to the network may not be shown.
- Cables, overhead lines & substations owned by other electricity network owners or private companies may be present and may not be shown.
- You should always verify exact locations of cables using a cable locator and by careful use of hand tools in accordance with HSE guidance note HSG47.
- When working within 10m of any overhead electric line you should follow the requirements of HSE Guidance Note GS6.
- For further advice on working near our electricity cables or lines, call our General Enquiries number.
- Advice should be sought from the National Grid Electricity Distribution General Enquiries team for any work that is to take place in proximity to 132kV underground cables and 132kV overhead lines.

Report damage immediately – KEEP EVERYONE AWAY FROM THE AREA
0800 6783 105

Crown Copyright © All Rights Reserved. Ordnance Survey Licence numbers: 100022432
 NGED Copyright: This copy has been made by or with the authority of National Grid Electricity Distribution (NGED) pursuant to Section 47 of the Copyright Designs and Patents Act 1988 unless that Act provides a relevant exception to copyright the copy must not be copied without the prior permission of the copyright owner.

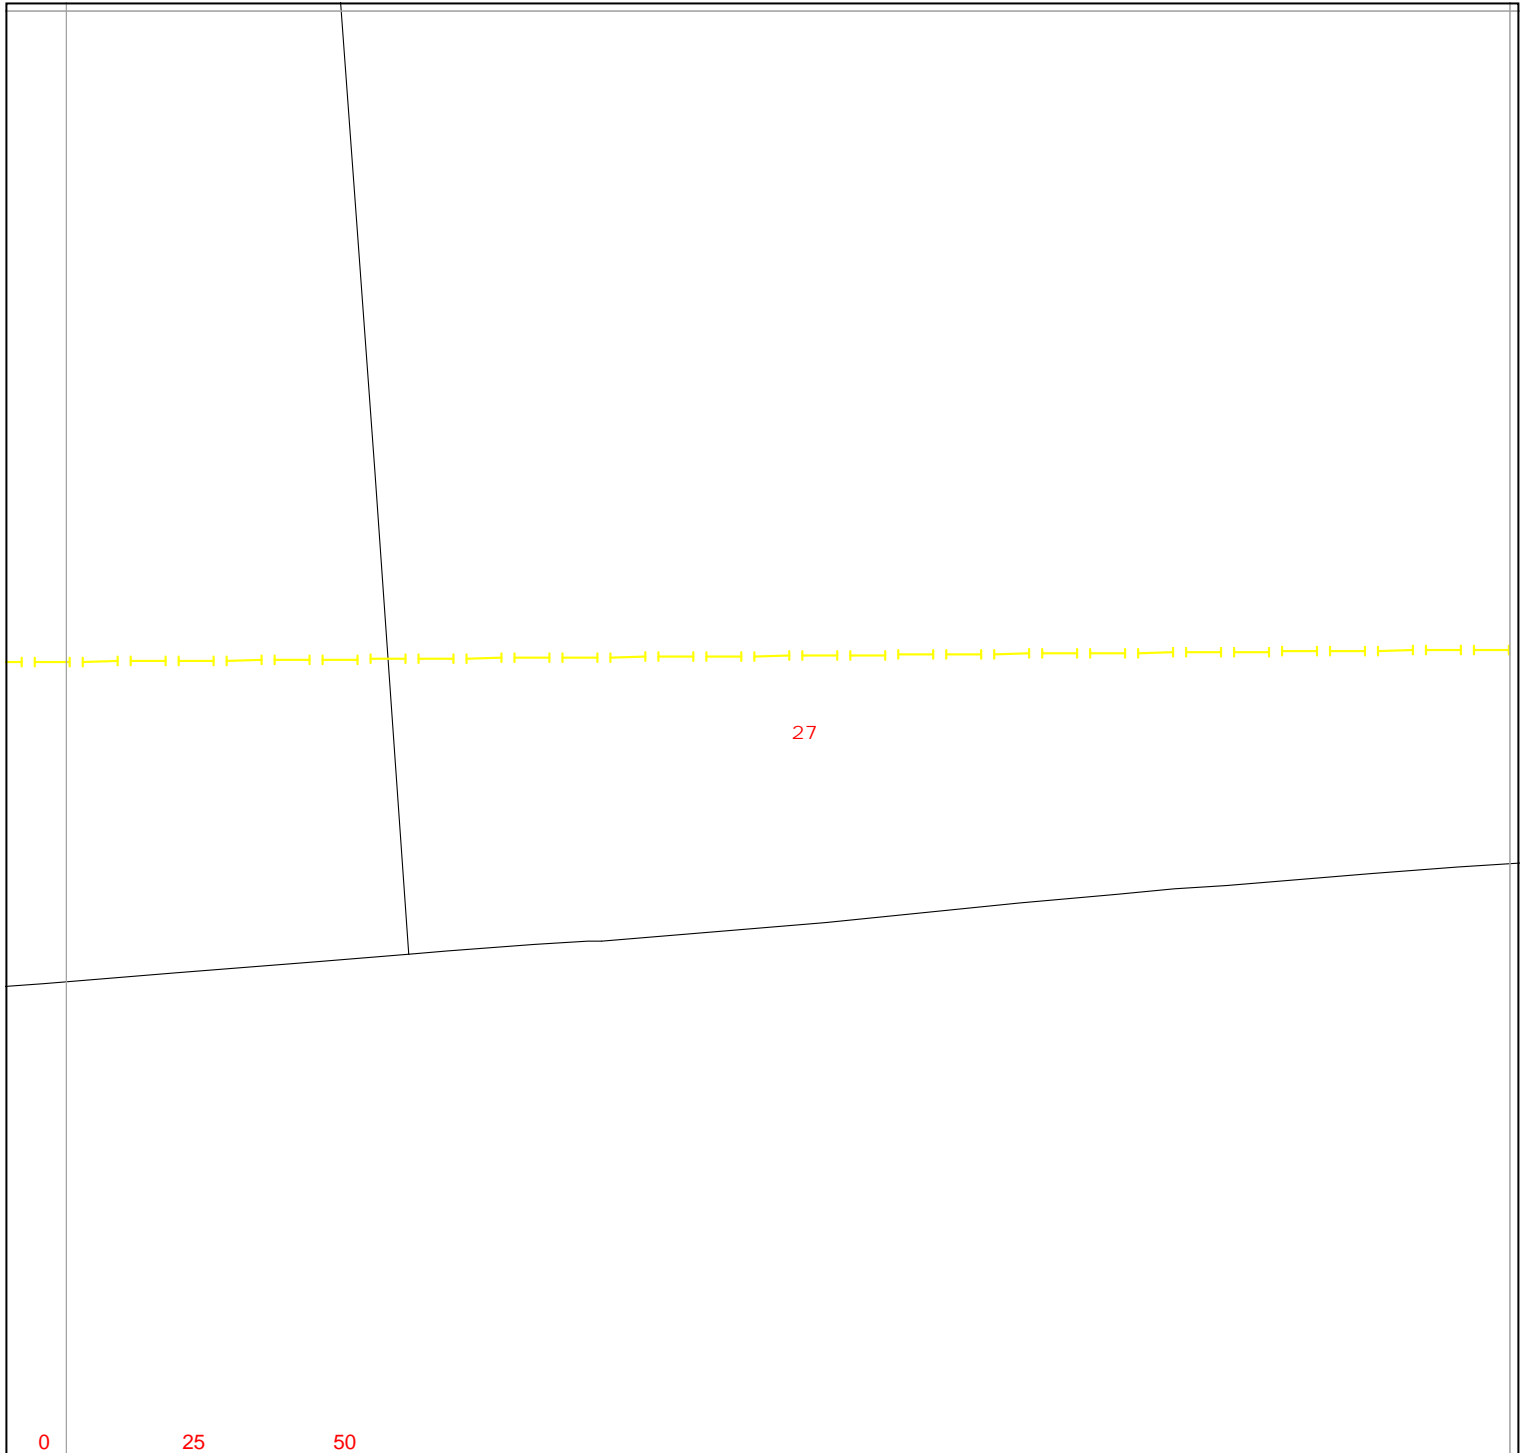

Warning: PDF designed for colour print only with no page scaling.

nationalgrid Electricity Distribution

Contact Us

Mapping Enquiries:
All areas 0121 623 9780

General Enquiries:
All areas 0800 096 3080

Date Requested: 08/05/2023
Job Reference: 29406948
Site Location: 477674 383832
Requested by:
Mr Ben Evans
Your Scheme/Reference:
LM 203570/DK - 10

Exact Scales:
1:1250 Area or Circle dig site
1:500 Line dig site


Link Box ●	Overhead Line ○ ○ PL ○ ○ Service ○ ○ LV ○ ○ HV (11kV) ○ ○ HV (33kV) ○ ○ HV (66kV) ○ ○ HV (132kV)	Underground Cable -	National Grid Telecoms - - - - - PME Earth - E - - - - - Underground Earth	Pilot Cables ○ Pole Mounted Transformer □ Ground Mounted Transformer
----------------------	--	---	---	---

IMPORTANT NOTICES

- This information is given as a guide only and its accuracy cannot be guaranteed. Services or recent additions to the network may not be shown.
- Cables, overhead lines & substations owned by other electricity network owners or private companies may be present and may not be shown.
- You should always verify exact locations of cables using a cable locator and by careful use of hand tools in accordance with HSE guidance note HSG47.
- When working within 10m of any overhead electric line you should follow the requirements of HSE Guidance Note GS6.
- For further advice on working near our electricity cables or lines, call our General Enquiries number.
- Advice should be sought from the National Grid Electricity Distribution General Enquiries team for any work that is to take place in proximity to 132kV underground cables and 132kV overhead lines.

Report damage immediately – KEEP EVERYONE AWAY FROM THE AREA
0800 6783 105

Crown Copyright © All Rights Reserved. Ordnance Survey Licence numbers: 100022432
NGED Copyright: This copy has been made by or with the authority of National Grid Electricity Distribution (NGED) pursuant to Section 47 of the Copyright Designs and Patents Act 1988 unless that Act provides a relevant exception to copyright the copy must not be copied without the prior permission of the copyright owner.

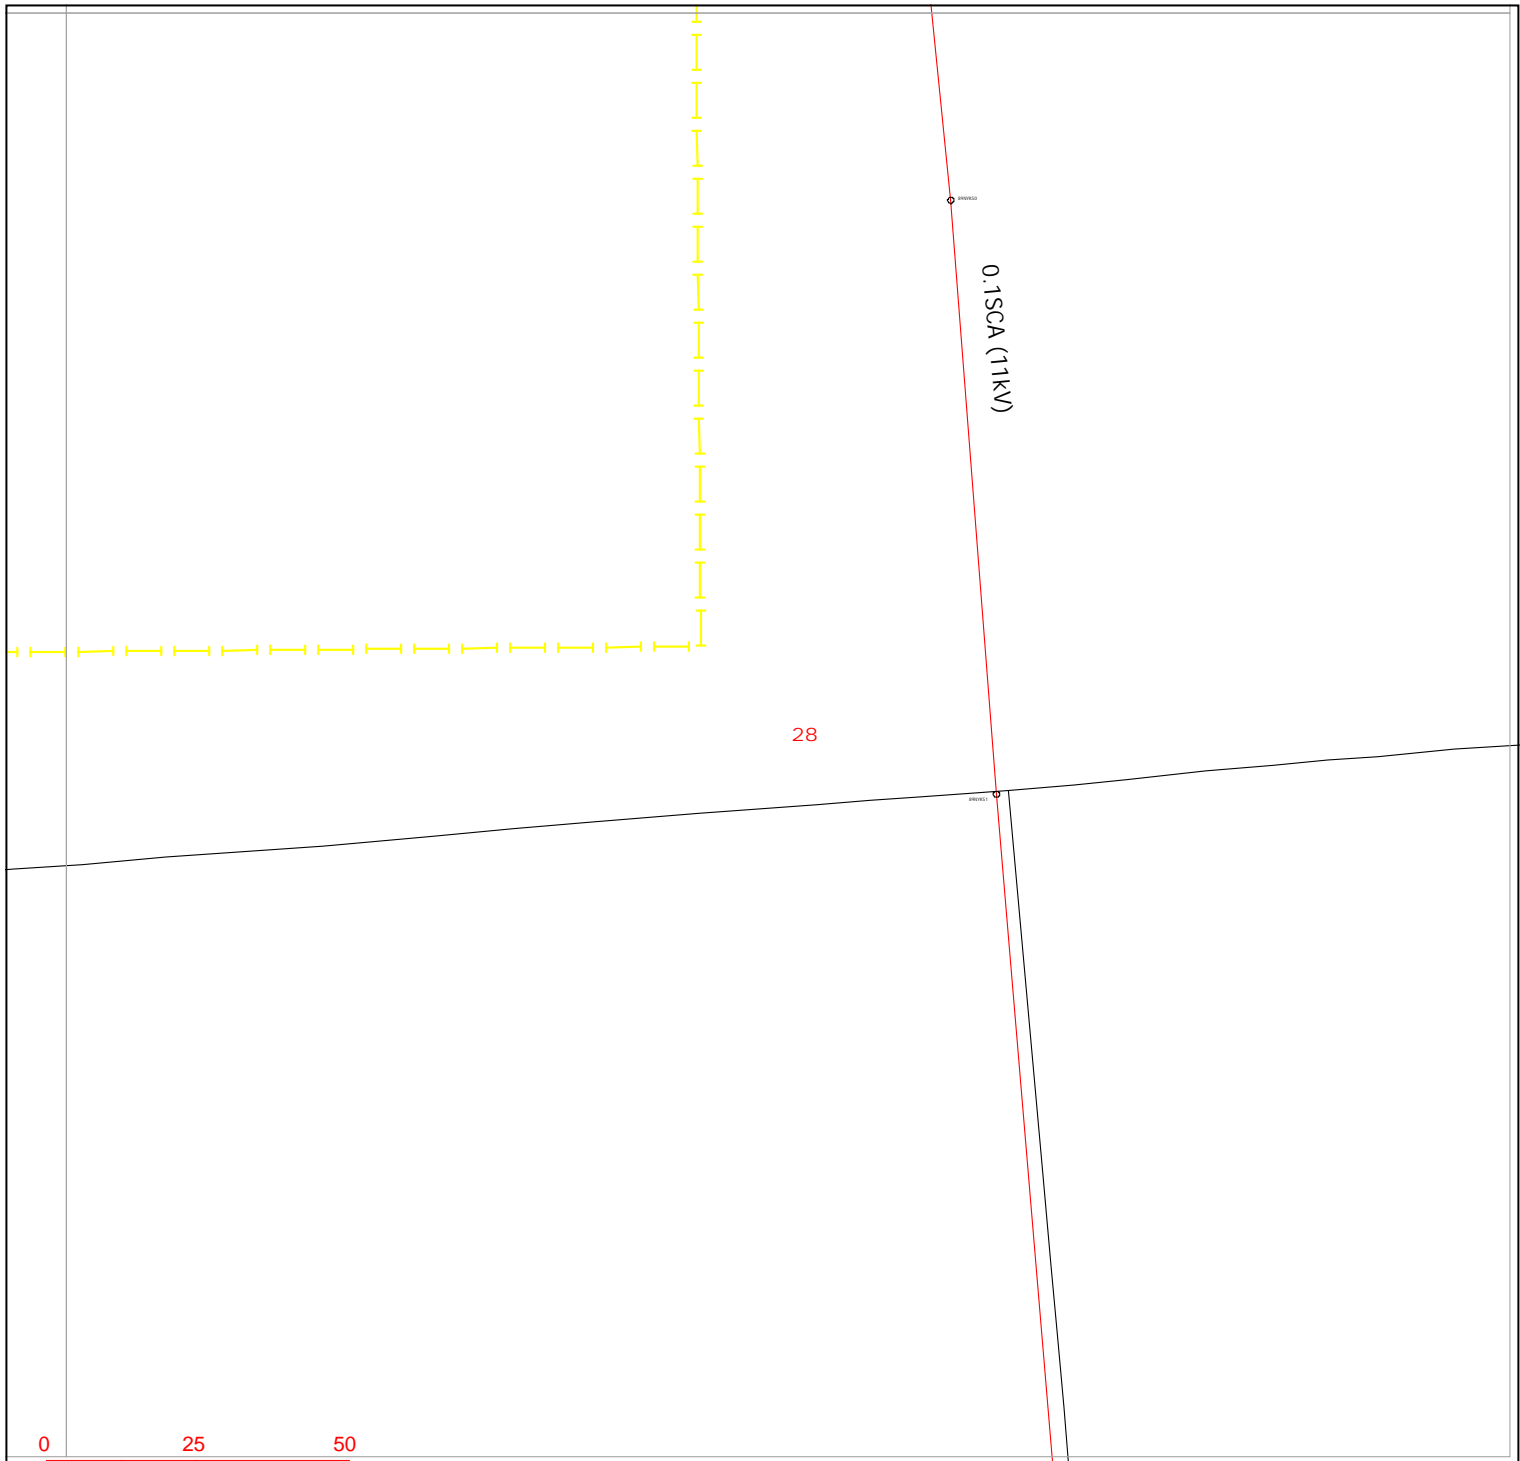

Warning: PDF designed for colour print only with no page scaling.

nationalgrid Electricity Distribution

Contact Us

Mapping Enquiries:
All areas 0121 623 9780

General Enquiries:
All areas 0800 096 3080

Date Requested: 08/05/2023
Job Reference: 29406948
Site Location: 477674 383832
Requested by:
Mr Ben Evans
Your Scheme/Reference:
LM 203570/DK - 10

Exact Scales:
1:1250 Area or Circle dig site
1:500 Line dig site


Link Box	Overhead Line	Underground Cable	National Grid Telecoms	Pilot Cables
●				
Site Location Line/Area 				

IMPORTANT NOTICES

- This information is given as a guide only and its accuracy cannot be guaranteed. Services or recent additions to the network may not be shown.
- Cables, overhead lines & substations owned by other electricity network owners or private companies may be present and may not be shown.
- You should always verify exact locations of cables using a cable locator and by careful use of hand tools in accordance with HSE guidance note HSG47.
- When working within 10m of any overhead electric line you should follow the requirements of HSE Guidance Note GS6.
- For further advice on working near our electricity cables or lines, call our General Enquiries number.
- Advice should be sought from the National Grid Electricity Distribution General Enquiries team for any work that is to take place in proximity to 132kV underground cables and 132kV overhead lines.

Report damage immediately – KEEP EVERYONE AWAY FROM THE AREA
0800 6783 105

Crown Copyright © All Rights Reserved. Ordnance Survey Licence numbers: 100022432
NGED Copyright: This copy has been made by or with the authority of National Grid Electricity Distribution (NGED) pursuant to Section 47 of the Copyright Designs and Patents Act 1988 unless that Act provides a relevant exception to copyright the copy must not be copied without the prior permission of the copyright owner.

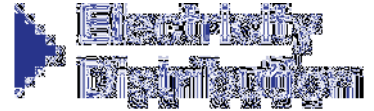

Our Ref: 29406949 Your Ref: LM 203570/DK - 11

Monday, 08 May 2023

Ben Evans
The Hub, 500 Park Avenue, Aztec West
Almondsbury
Bristol
BS32 4RZ

**National Grid Electricity
Distribution**
Mapping Centre
Toll End Road
Tipton
West Midlands
United Kingdom
DY4 0HH
www.nationalgrid.co.uk

Dear Ben Evans

Thank you for your enquiry dated Monday, 08 May 2023

I now enclose a copy of our plan showing existing National Grid Electricity Distribution (NGED) Electricity / National Grid Telecoms (NGT) apparatus in the vicinity of your proposed works. This information is given as a general guide only and its accuracy cannot be guaranteed. Please note that all NGED equipment on site should be assumed to be LIVE until NGED prove otherwise and provide you with confirmation to this effect in writing. Recent additions to our network, or service connections between the main cable and a building or street lamp may not be shown.

Map Response
T 0121 623 9780
NGED.MapResponse
@nationalgrid.co.uk

Damage to underground cables and contact with overhead lines can cause severe injury or may prove fatal. If you are excavating on site in the vicinity of either NGED Electrical apparatus or NGT Telecoms apparatus you must comply with the requirements of the following:-

Health & Safety Executive guidance HS(G)47, Avoiding Danger from underground services.

Work taking place in the vicinity of our plant is also regulated under the:-

Electricity at Work Regulations 1989, Health and Safety Act 1974, CDM Regulations 2015.
Safe working procedures should be defined and practiced

Please ensure that the use of mechanical excavators in the vicinity of our plant is kept to a minimum. NGT Telecoms ducts contain fibre cables, which are expensive to repair. Therefore, extreme care must be taken whilst working in the vicinity of these ducts, hand digging methods being used to determine their precise position.

If there are overhead lines crossing your site and your proposal involves building works which may infringe the clearance to our overhead system then you should call the relevant general enquiries number (see page 2 of this letter) for advice. Where overhead lines cross your site you must comply with the requirements of Health & Safety Executive guidance as laid down in GS6, Avoidance of Danger from Overhead Electric Lines.

National Grid Electricity
Distribution
South West - 02366894
South Wales - 02366985
East Midlands - 02366923
West Midlands - 03600574

Where diversions to NGED apparatus are needed to allow change to occur on site, the cost of these alterations may be charged to the persons responsible for the works.

If you require advice in connection with your proposals please contact the relevant general enquiries number (see page 2 of this letter)

Registered in
England and Wales


Following consultation the local NGED team will where necessary prepare detailed proposals and provide a quotation for any necessary alterations and/or development of our equipment on the site.

Registered Office:
Avonbank
Feeder Road
Bristol
BS2 0TB

This information is given as a guide only and its accuracy cannot be guaranteed. This plan is based on data from our Geographic Information System, which is updated every 24 hours to reflect changes to our network. The information contained in this plan reflects the most recent network GIS data, however changes to the network (including network additions and new service

Safety Documents:

<https://www.nationalgrid.co.uk/customers-and-community/health-safety/public-safety-advice>

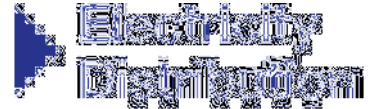

connections) may not be shown. You are advised to obtain an up to date plan on the date of commencing on-site works.

Yours sincerely
NGED Map Response Team

Contact Us

Emergency or Power Supply issues

In an emergency call 105, 24 hours a day.

Mapping Enquiries

If you have an enquiry relating to this letter or the attached map plan, please contact us using the following information:

Telephone 0121 623 9780
Email NGED.MapResponse@nationalgrid.co.uk

General Enquiries


If you have a general enquiry, please call us on the following telephone number:

All areas 0800 096 3080

LSBUD

If you have an enquiry relating to the use of the LSBUD website please contact LSBUD using the following information:

Telephone 0345 437 7365
Email enquiries@LSBUD.co.uk
Website www.LSBUD.co.uk

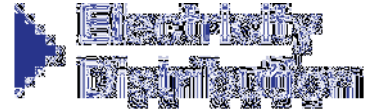


Steps to help keep you safe

- **If you are working within 10 metres of our 33kV, 66kV, 132kV underground electricity cables or within 10 meters of an overhead electricity line you should call the relevant General Enquiries for free safety advice.**

Safety Documents – please download our informative safety documents to help ensure that you, your staff and the public are kept safe whilst working in the vicinity of electricity.

<https://www.nationalgrid.co.uk/customers-and-community/health-safety/public-safety-advice>

- **Make sure you have up to date plans** - remember that recent additions to our network or service connections between the main cable and a building or street lamp may not be shown.
- **Look for signs of service cables** - an electricity meter box or nearby streetlamp may give you an indication that service cables are present in your area of work.
- **Non NGED Network** - electricity cables, lines and equipment owned by others may also be present in addition to NGED network. They are unlikely to be shown on our plans.
- **Use a cable locator** - trace electricity cables and mark the position of them using paint or other waterproof marking on the ground.
- **Hand dig trial holes** - to confirm the position of cables in close proximity to your area of your work and use spades and shovels rather than picks, pins or forks.
- **Have an emergency plan** - so that everyone working on site understands what to do in the event of an underground electricity cable being damaged or contact being made with an overhead electricity line.
- **If you are working within 10 meters** of an overhead electricity line then it may be necessary for you to erect warning signs and markers, or height restriction goal posts. Ensure that you comply with the requirements of Health & Safety Executive guidance laid down in GS6, Avoidance of Danger from Overhead Electric Lines.
- **If you are erecting a structure** that could allow anyone standing on it, or its access device (ladder, scaffold, MEWP), to come within 3m of any overhead electric line then **you must inform us**. This is your duty and a legal requirement under the Electricity Safety, Quality & Continuity Regulations 2002.
- **If you cannot work safely** around the underground electricity cable or overhead electricity line, then you may need to get it moved to allow your works to go ahead. Call the general enquiry numbers above for guidance.
- **It is possible that cables or pipes may be embedded in concrete** - electricity cables embedded in concrete **MUST** be made 'dead' by Western Power Distribution or the cable owner before the concrete is broken out. Alternatively, another safe way of working should be agreed.
- **Cables are sometimes covered by tiles or a marker tape** - these can be concrete, polythene or earthenware and are a useful early warning of the presence of cables; you should avoid disturbing any tiles or tape to expose the cable. Not all cables have these warning indicators.

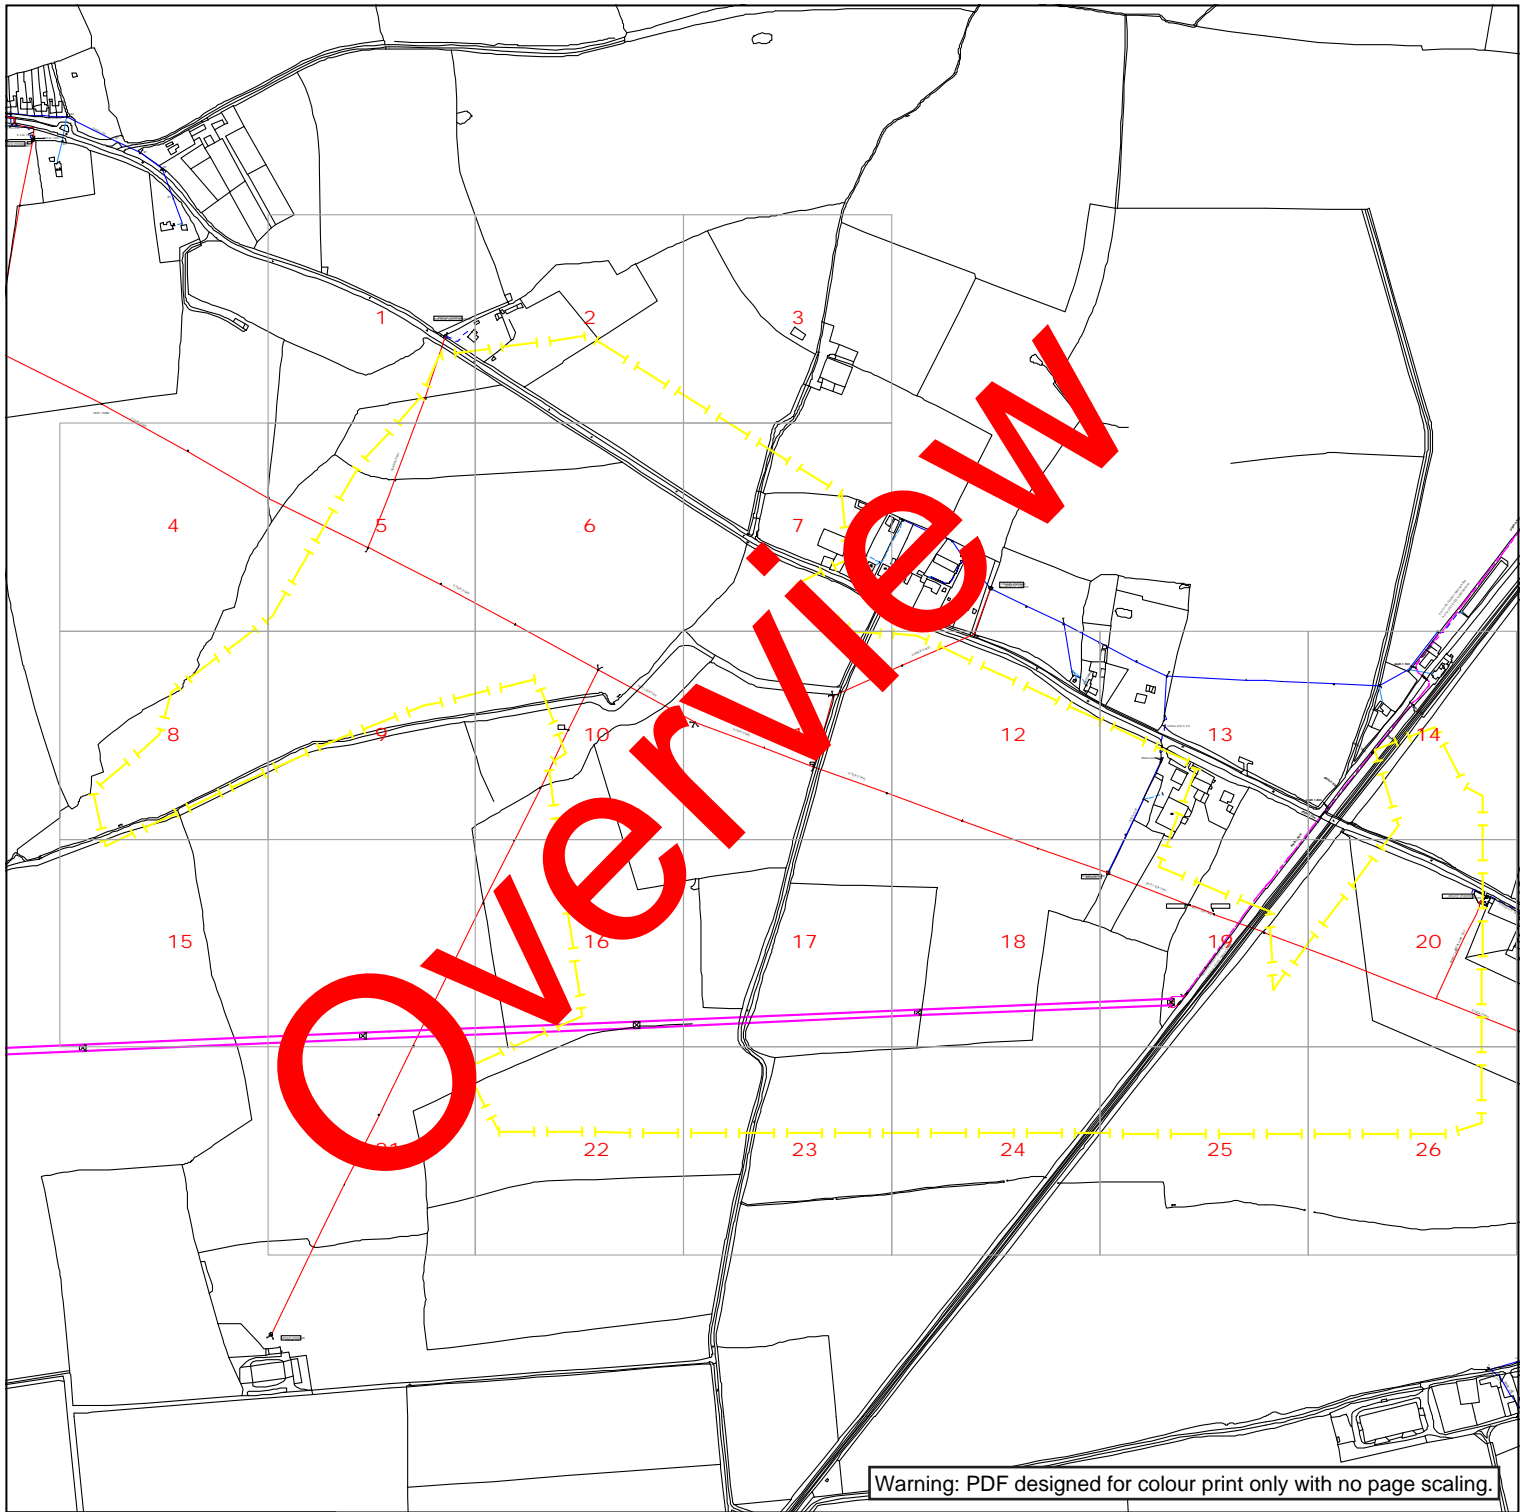

Warning: PDF designed for colour print only with no page scaling.

nationalgrid Electricity Distribution

Contact Us

Mapping Enquiries:
All areas 0121 623 9780

General Enquiries:
All areas 0800 096 3080

Date Requested: 08/05/2023
Job Reference: 29406949
Site Location: 477455 384776
Requested by:
Mr Ben Evans
Your Scheme/Reference:
LM 203570/DK - 11


Link Box	Overhead Line	Underground Cable	National Grid Telecoms	Pilot Cables
●	○ PL ○ Service ○ LV ○ HV (11kV) ○ HV (33kV) ○ HV (66kV) ○ HV (132kV)	--- --- --- ---	--- --- ---	○ Pole Mounted Transformer □ Ground Mounted Transformer
Site Location Line/Area	--- --- --- ---	--- --- --- ---	⊥ PME Earth ⊥ Underground Earth	
--- ---	---	---		

IMPORTANT NOTICES

- This information is given as a guide only and its accuracy cannot be guaranteed. Services or recent additions to the network may not be shown.
- Cables, overhead lines & substations owned by other electricity network owners or private companies may be present and may not be shown.
- You should always verify exact locations of cables using a cable locator and by careful use of hand tools in accordance with HSE guidance note HSG47.
- When working within 10m of any overhead electric line you should follow the requirements of HSE Guidance Note GS6.
- For further advice on working near our electricity cables or lines, call our General Enquiries number.
- Advice should be sought from the National Grid Electricity Distribution General Enquiries team for any work that is to take place in proximity to 132kV underground cables and 132kV overhead lines.

Report damage immediately – KEEP EVERYONE AWAY FROM THE AREA
0800 6783 105

Crown Copyright © All Rights Reserved. Ordnance Survey Licence numbers: 100022432
NGED Copyright: This copy has been made by or with the authority of National Grid Electricity Distribution (NGED) pursuant to Section 47 of the Copyright Designs and Patents Act 1988 unless that Act provides a relevant exception to copyright the copy must not be copied without the prior permission of the copyright owner.

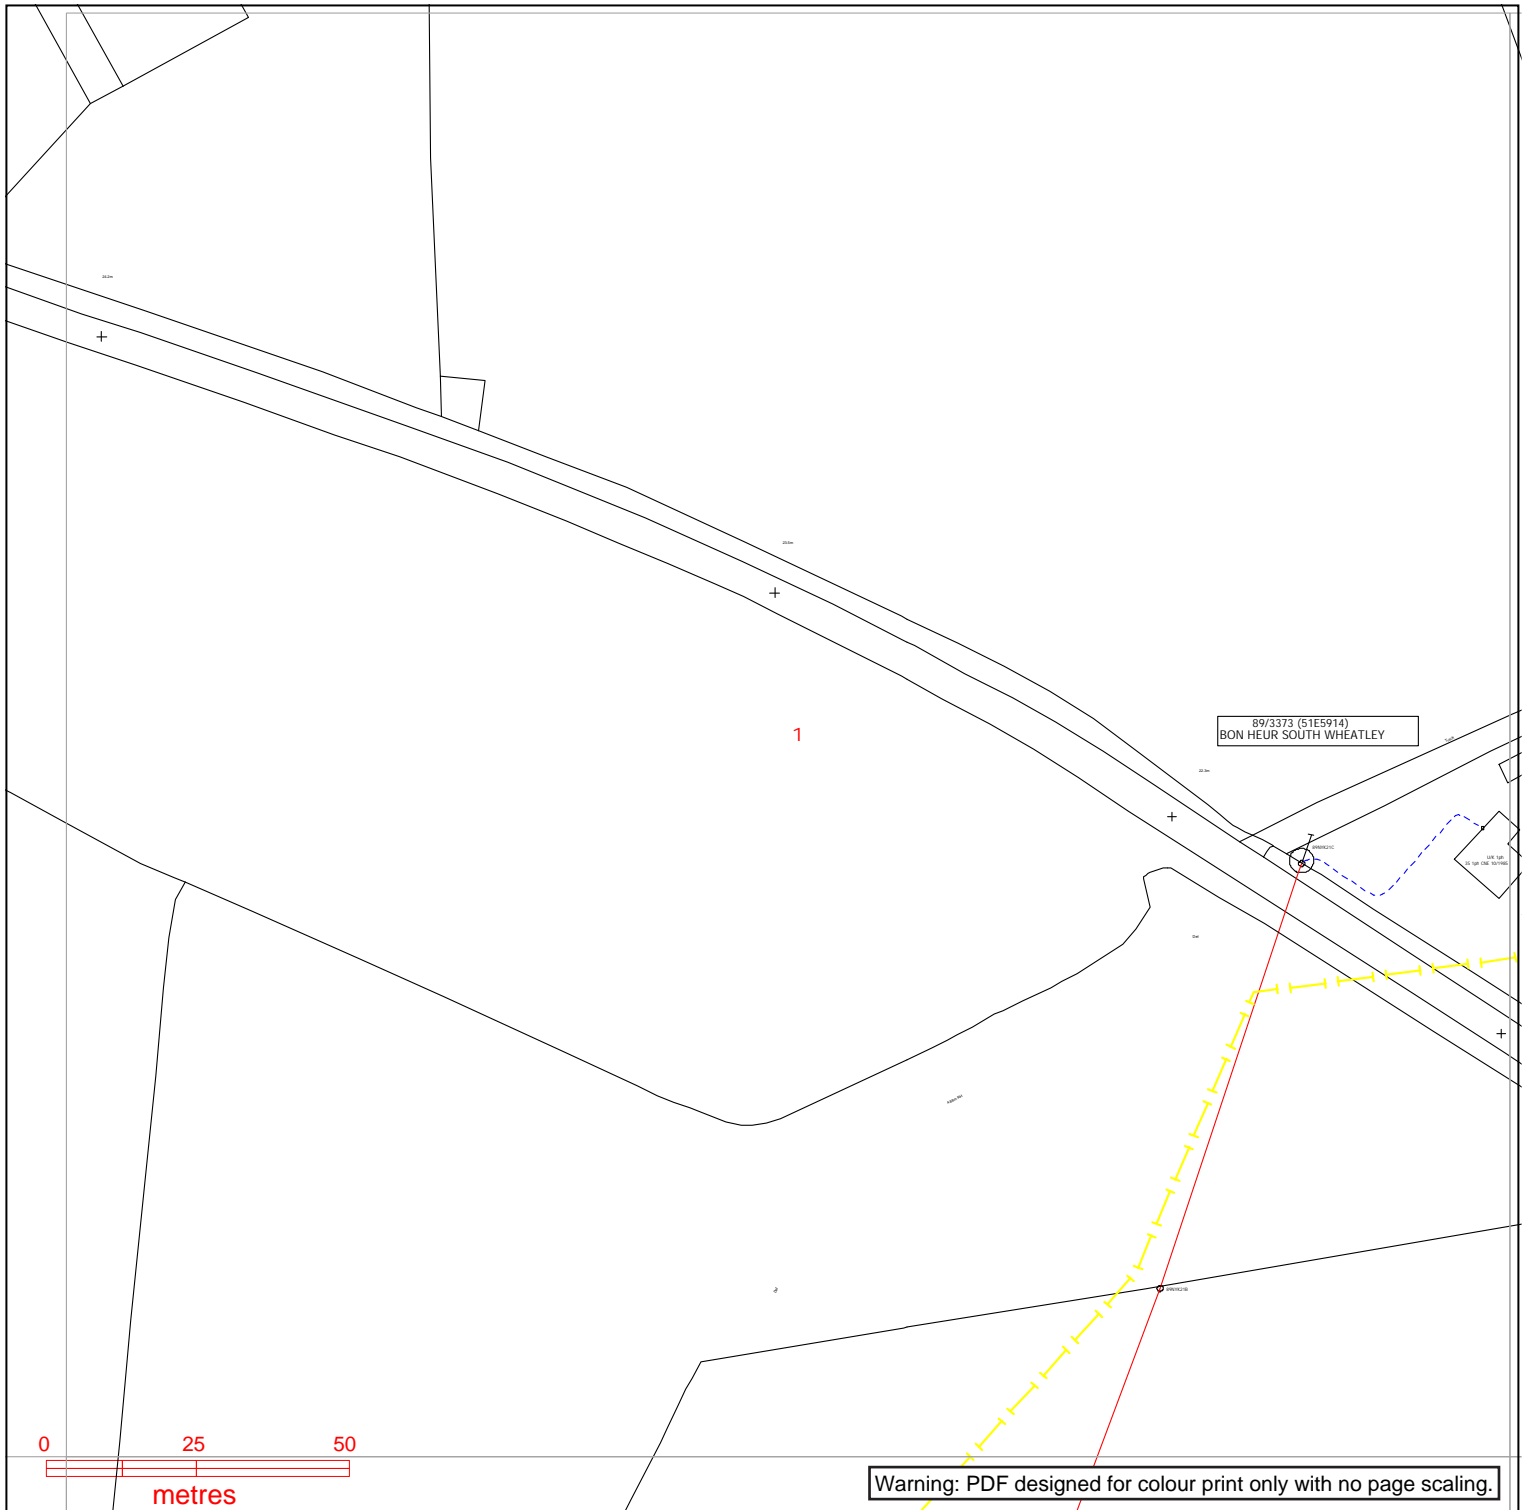

nationalgrid Electricity Distribution

Contact Us

Mapping Enquiries:
All areas 0121 623 9780

General Enquiries:
All areas 0800 096 3080

Date Requested: 08/05/2023
Job Reference: 29406949
Site Location: 477455 384776
Requested by:
Mr Ben Evans
Your Scheme/Reference:
LM 203570/DK - 11

Exact Scales:
1:1250 Area or Circle dig site
1:500 Line dig site


Link Box	Overhead Line	Underground Cable	National Grid Telecoms	Pilot Cables
●	○ PL ○ Service ○ LV ○ HV (11kV) ○ HV (33kV) ○ HV (66kV) ○ HV (132kV)	--- --- --- ---	--- --- --- ---	○ Pole Mounted Transformer □ Ground Mounted Transformer
■			⎓ PME Earth ⎓ Underground Earth	

IMPORTANT NOTICES

- This information is given as a guide only and its accuracy cannot be guaranteed. Services or recent additions to the network may not be shown.
- Cables, overhead lines & substations owned by other electricity network owners or private companies may be present and may not be shown.
- You should always verify exact locations of cables using a cable locator and by careful use of hand tools in accordance with HSE guidance note HSG47.
- When working within 10m of any overhead electric line you should follow the requirements of HSE Guidance Note GS6.
- For further advice on working near our electricity cables or lines, call our General Enquiries number.
- Advice should be sought from the National Grid Electricity Distribution General Enquiries team for any work that is to take place in proximity to 132kV underground cables and 132kV overhead lines.

Report damage immediately – KEEP EVERYONE AWAY FROM THE AREA
0800 6783 105

Crown Copyright © All Rights Reserved. Ordnance Survey Licence numbers: 100022432
NGED Copyright: This copy has been made by or with the authority of National Grid Electricity Distribution (NGED) pursuant to Section 47 of the Copyright Designs and Patents Act 1988 unless that Act provides a relevant exception to copyright the copy must not be copied without the prior permission of the copyright owner.

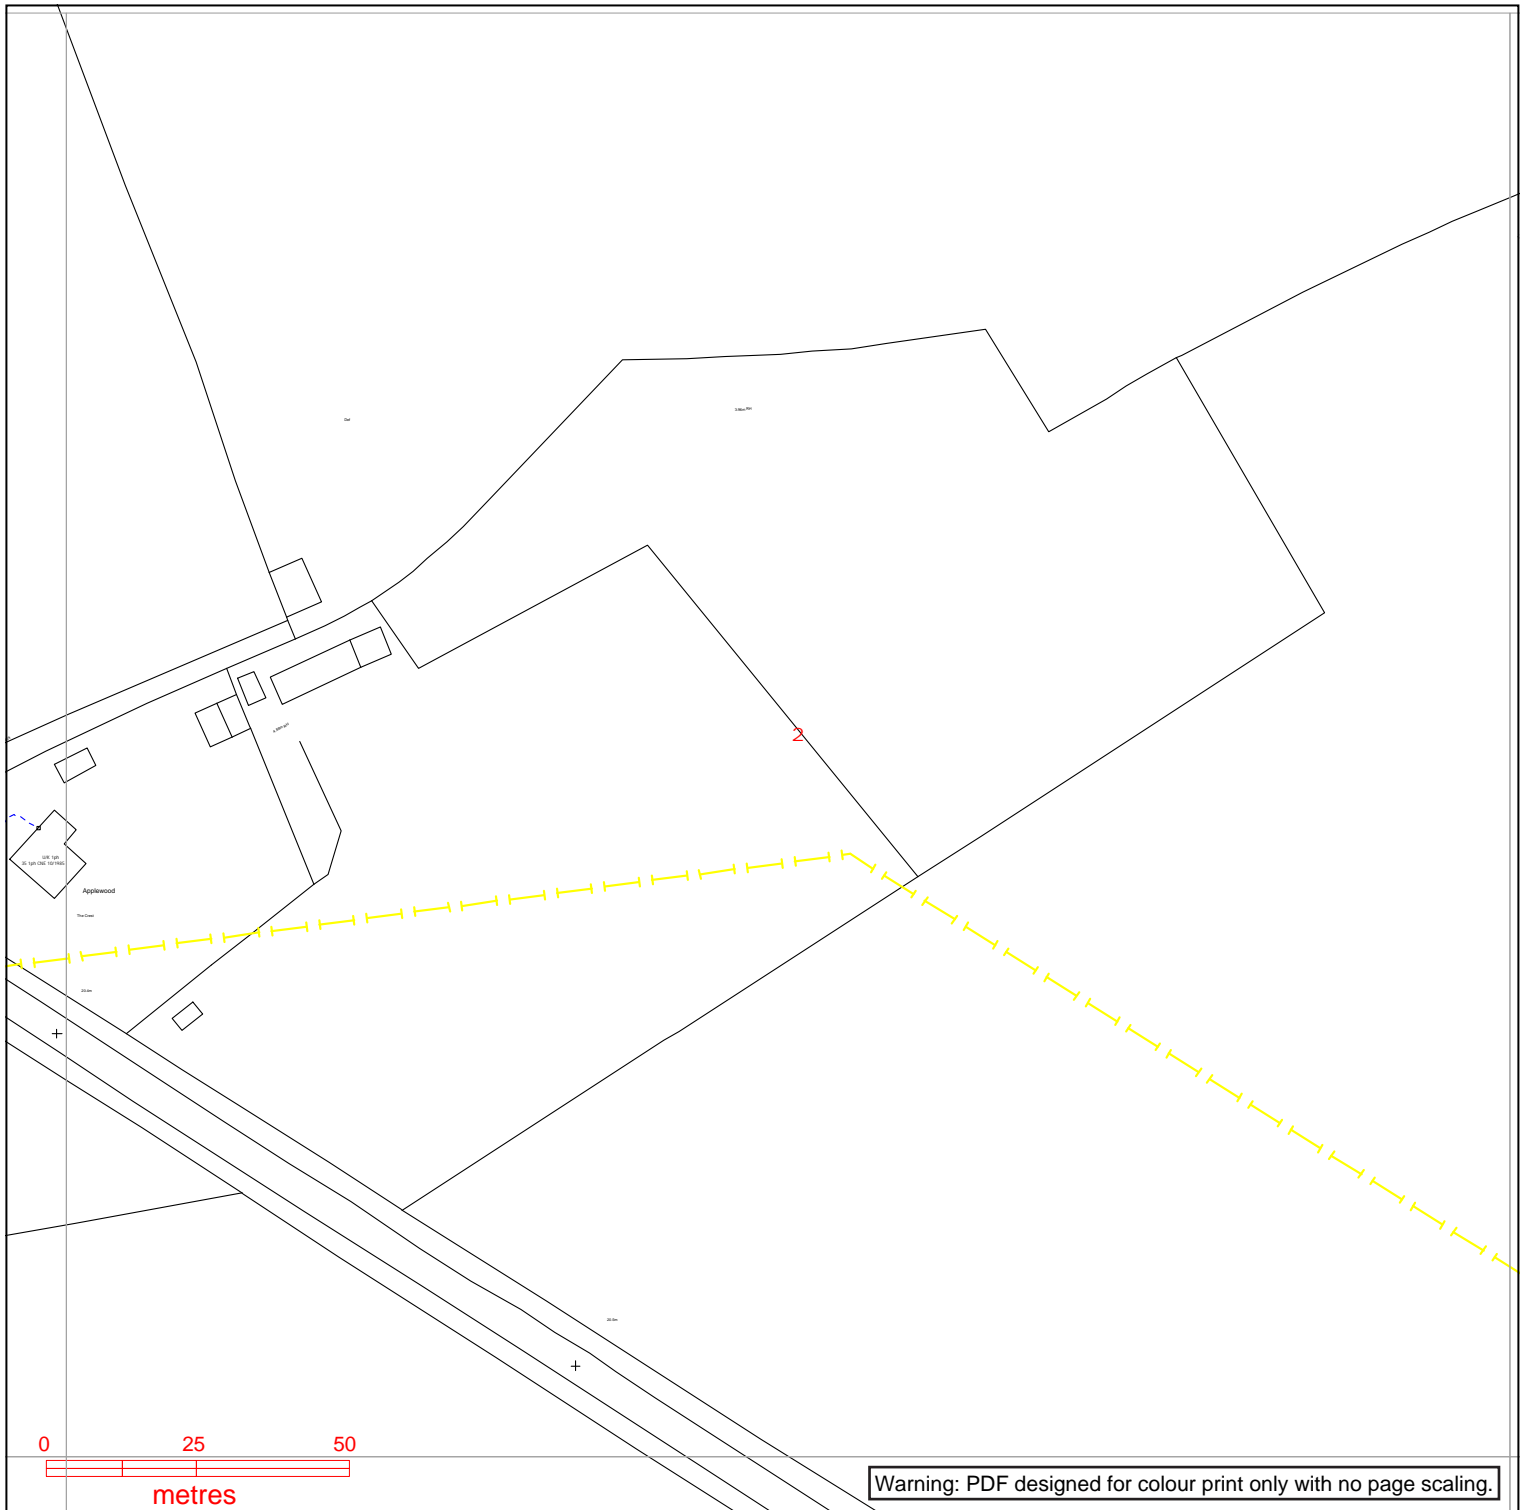

Contact Us

Mapping Enquiries:
All areas 0121 623 9780

General Enquiries:
All areas 0800 096 3080

Date Requested: 08/05/2023
Job Reference: 29406949
Site Location: 477455 384776
Requested by:
Mr Ben Evans
Your Scheme/Reference:
LM 203570/DK - 11

Exact Scales:
1:1250 Area or Circle dig site
1:500 Line dig site


Link Box	Overhead Line	Underground Cable	National Grid Telecoms	Pilot Cables
●	<ul style="list-style-type: none"> ○ PL ○ Service ○ LV ○ HV (11kV) ○ HV (33kV) ○ HV (66kV) ○ HV (132kV) 	<ul style="list-style-type: none"> --- --- --- --- --- --- --- 	<ul style="list-style-type: none"> --- PME Earth ---E Underground Earth 	<ul style="list-style-type: none"> ○ Pole Mounted Transformer □ Ground Mounted Transformer
Site Location Line/Area	<ul style="list-style-type: none"> --- (Yellow dashed line) 			

IMPORTANT NOTICES

- This information is given as a guide only and its accuracy cannot be guaranteed. Services or recent additions to the network may not be shown.
- Cables, overhead lines & substations owned by other electricity network owners or private companies may be present and may not be shown.
- You should always verify exact locations of cables using a cable locator and by careful use of hand tools in accordance with HSE guidance note HSG47.
- When working within 10m of any overhead electric line you should follow the requirements of HSE Guidance Note GS6.
- For further advice on working near our electricity cables or lines, call our General Enquiries number.
- Advice should be sought from the National Grid Electricity Distribution General Enquiries team for any work that is to take place in proximity to 132kV underground cables and 132kV overhead lines.

Report damage immediately – KEEP EVERYONE AWAY FROM THE AREA
0800 6783 105

Crown Copyright © All Rights Reserved. Ordnance Survey Licence numbers: 100022432
NGED Copyright: This copy has been made by or with the authority of National Grid Electricity Distribution (NGED) pursuant to Section 47 of the Copyright Designs and Patents Act 1988 unless that Act provides a relevant exception to copyright the copy must not be copied without the prior permission of the copyright owner.

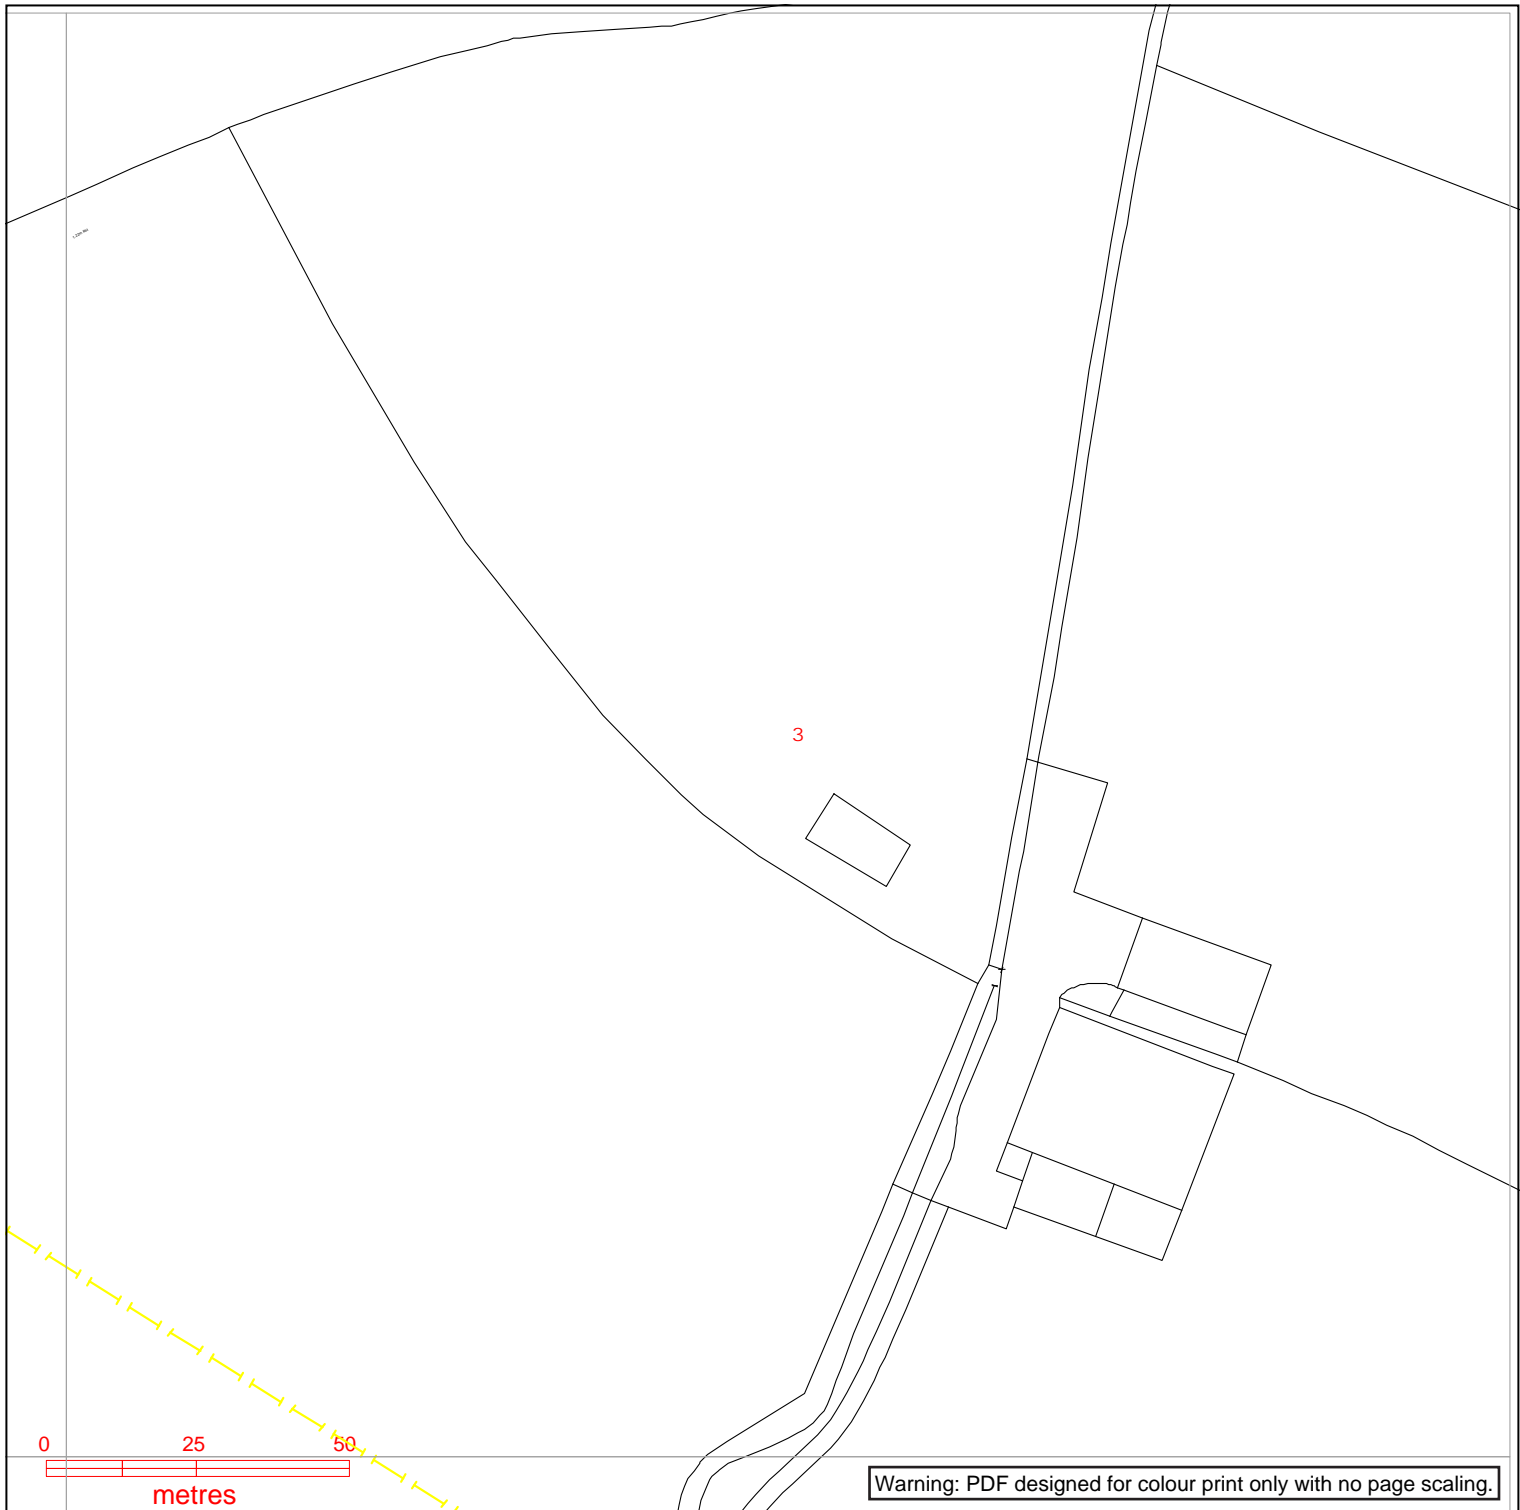

nationalgrid Electricity Distribution

Contact Us

Mapping Enquiries:
All areas 0121 623 9780

General Enquiries:
All areas 0800 096 3080

Date Requested: 08/05/2023
Job Reference: 29406949
Site Location: 477455 384776
Requested by:
Mr Ben Evans
Your Scheme/Reference:
LM 203570/DK - 11

Exact Scales:
1:1250 Area or Circle dig site
1:500 Line dig site


Link Box ●	Overhead Line ○—○ PL ○—○ Service ○—○ LV ○—○ HV (11kV) ○—○ HV (33kV) ○—○ HV (66kV) □—□ HV (132kV)	Underground Cable -	National Grid Telecoms - - - - - PME Earth -E- - - - - Underground Earth	Pilot Cables ○ Pole Mounted Transformer □ Ground Mounted Transformer
----------------------	--	---	---	---

IMPORTANT NOTICES

- This information is given as a guide only and its accuracy cannot be guaranteed. Services or recent additions to the network may not be shown.
- Cables, overhead lines & substations owned by other electricity network owners or private companies may be present and may not be shown.
- You should always verify exact locations of cables using a cable locator and by careful use of hand tools in accordance with HSE guidance note HSG47.
- When working within 10m of any overhead electric line you should follow the requirements of HSE Guidance Note GS6.
- For further advice on working near our electricity cables or lines, call our General Enquiries number.
- Advice should be sought from the National Grid Electricity Distribution General Enquiries team for any work that is to take place in proximity to 132kV underground cables and 132kV overhead lines.

Report damage immediately – KEEP EVERYONE AWAY FROM THE AREA
0800 6783 105

Crown Copyright © All Rights Reserved. Ordnance Survey Licence numbers: 100022432
NGED Copyright: This copy has been made by or with the authority of National Grid Electricity Distribution (NGED) pursuant to Section 47 of the Copyright Designs and Patents Act 1988 unless that Act provides a relevant exception to copyright the copy must not be copied without the prior permission of the copyright owner.

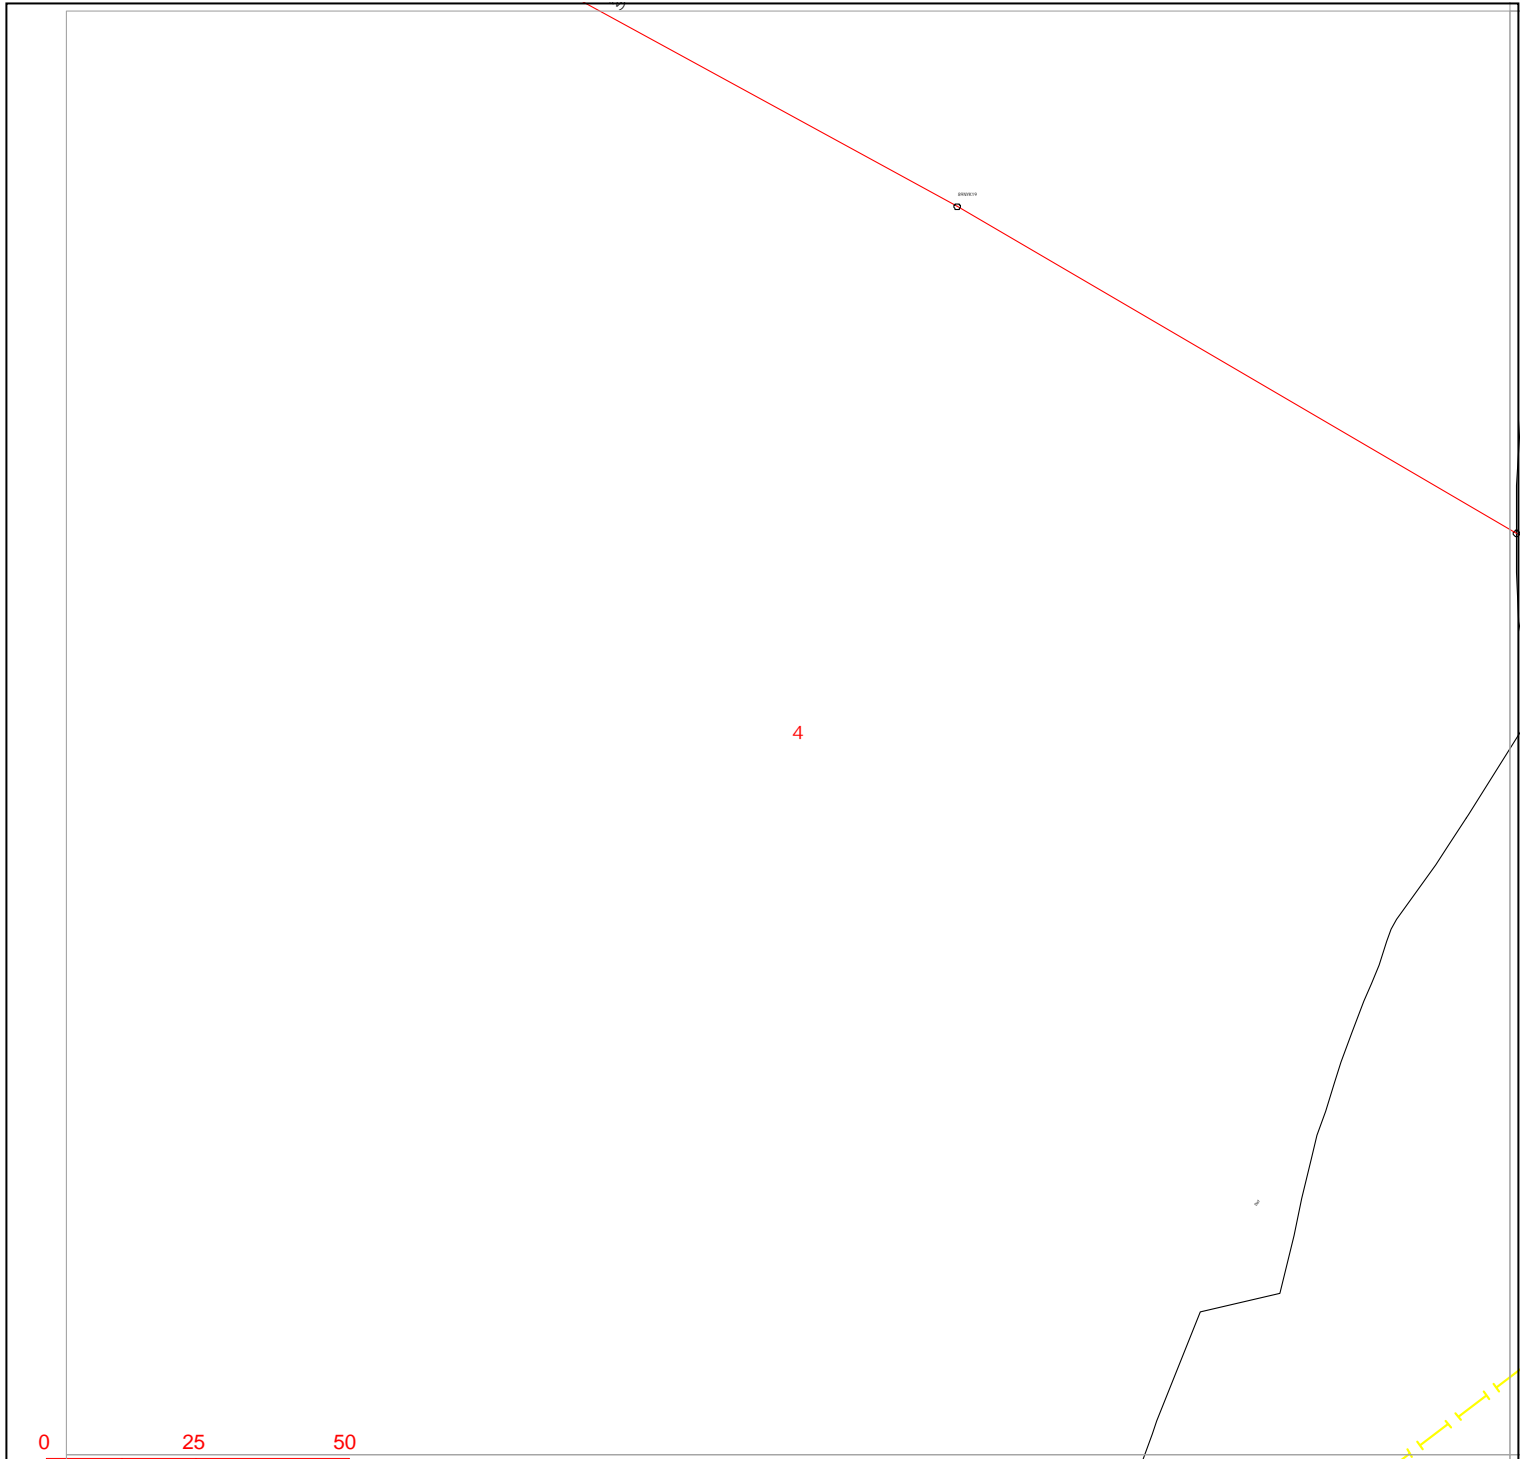

nationalgrid Electricity Distribution

Contact Us

Mapping Enquiries:
All areas 0121 623 9780

General Enquiries:
All areas 0800 096 3080

Date Requested: 08/05/2023
Job Reference: 29406949
Site Location: 477455 384776
Requested by:
Mr Ben Evans
Your Scheme/Reference:
LM 203570/DK - 11

Exact Scales:
1:1250 Area or Circle dig site
1:500 Line dig site


Link Box	Overhead Line	Underground Cable	National Grid Telecoms	Pilot Cables
●	<ul style="list-style-type: none"> ○ PL ○ Service ○ LV ○ HV (11kV) ○ HV (33kV) ○ HV (66kV) ○ HV (132kV) 	<ul style="list-style-type: none"> --- --- --- --- --- --- --- 	<ul style="list-style-type: none"> —E— PME Earth —E— Underground Earth 	<ul style="list-style-type: none"> ○ Pole Mounted Transformer □ Ground Mounted Transformer
Site Location Line/Area	<ul style="list-style-type: none"> — — — — — — — 			

IMPORTANT NOTICES

- This information is given as a guide only and its accuracy cannot be guaranteed. Services or recent additions to the network may not be shown.
- Cables, overhead lines & substations owned by other electricity network owners or private companies may be present and may not be shown.
- You should always verify exact locations of cables using a cable locator and by careful use of hand tools in accordance with HSE guidance note HSG47.
- When working within 10m of any overhead electric line you should follow the requirements of HSE Guidance Note GS6.
- For further advice on working near our electricity cables or lines, call our General Enquiries number.
- Advice should be sought from the National Grid Electricity Distribution General Enquiries team for any work that is to take place in proximity to 132kV underground cables and 132kV overhead lines.

Report damage immediately – KEEP EVERYONE AWAY FROM THE AREA
0800 6783 105

Crown Copyright © All Rights Reserved. Ordnance Survey Licence numbers: 100022432
NGED Copyright: This copy has been made by or with the authority of National Grid Electricity Distribution (NGED) pursuant to Section 47 of the Copyright Designs and Patents Act 1988 unless that Act provides a relevant exception to copyright the copy must not be copied without the prior permission of the copyright owner.

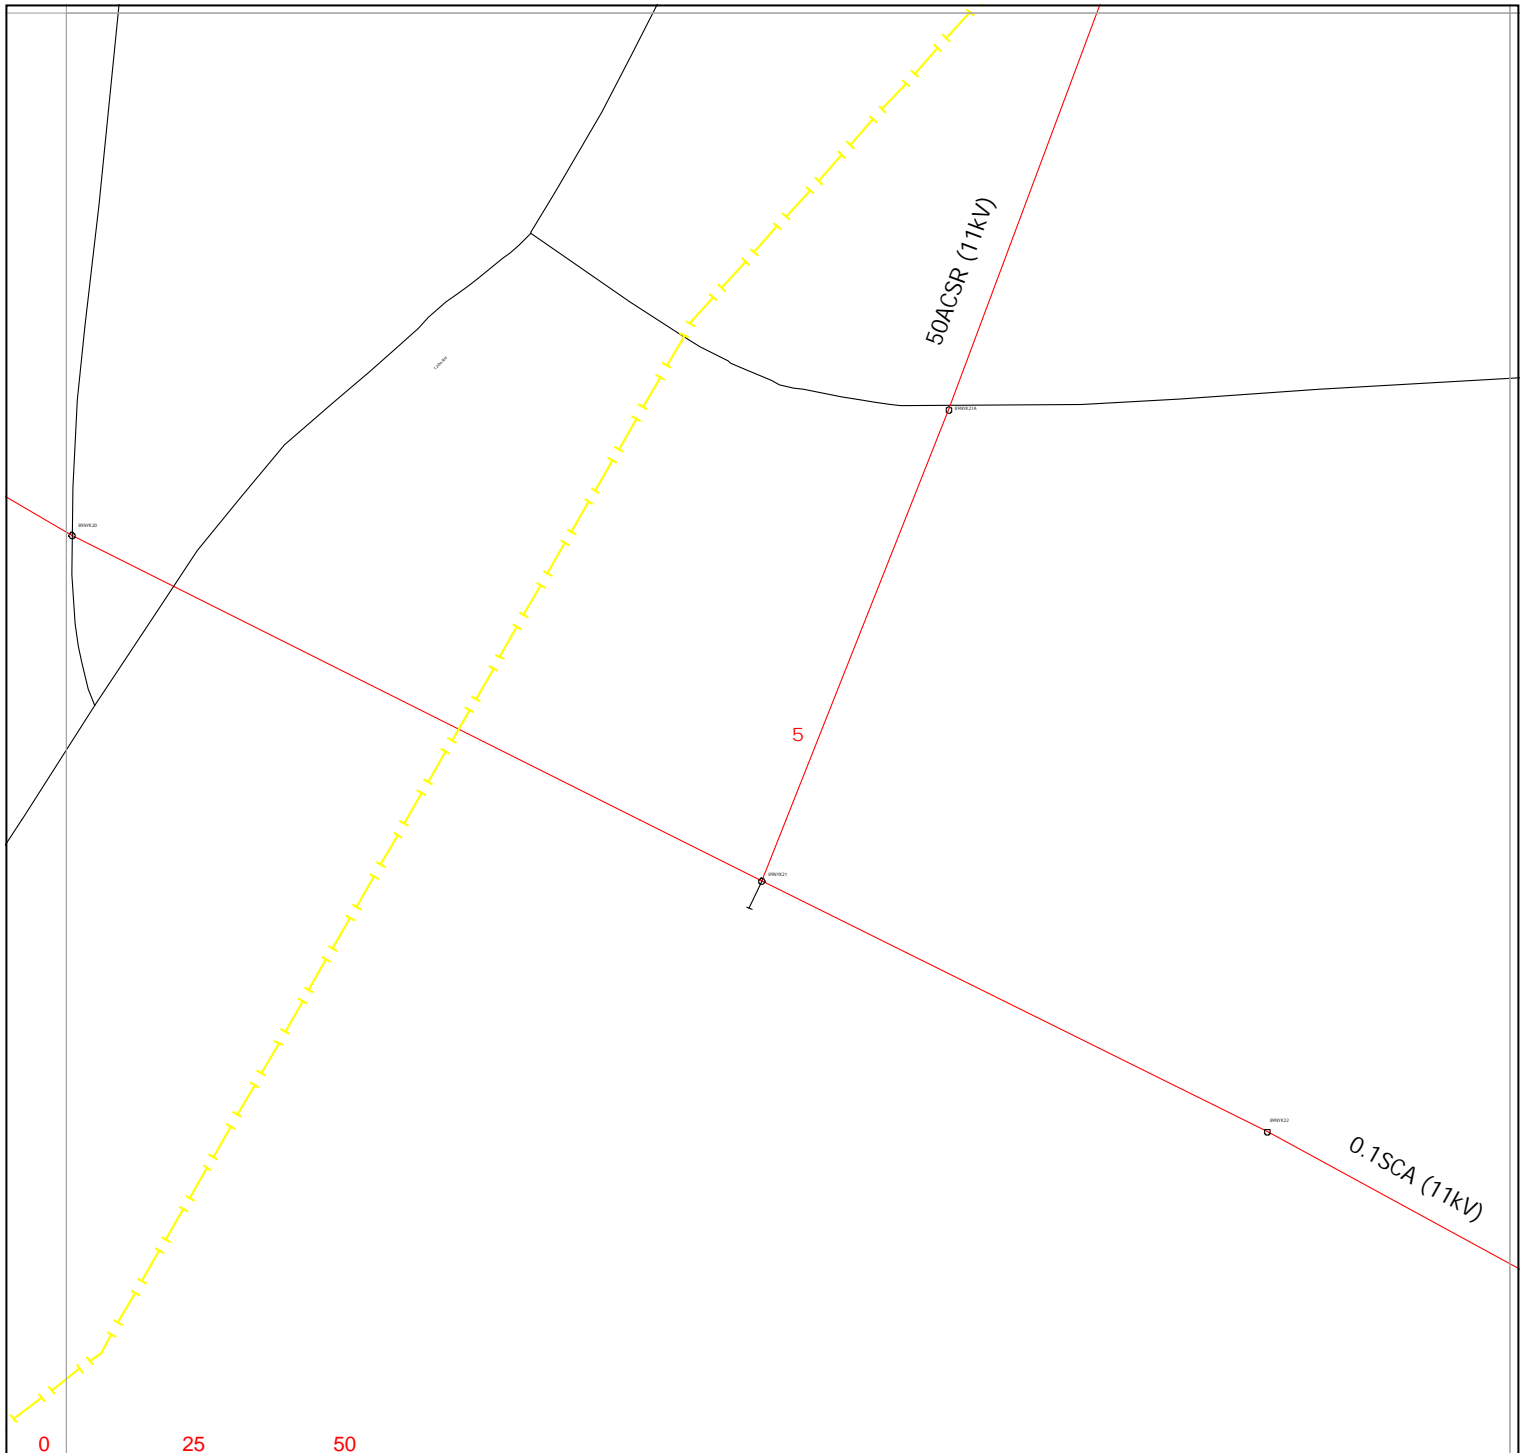

Warning: PDF designed for colour print only with no page scaling.



Contact Us

Mapping Enquiries:
All areas 0121 623 9780

General Enquiries:
All areas 0800 096 3080

Date Requested: 08/05/2023
Job Reference: 29406949
Site Location: 477455 384776
Requested by:
Mr Ben Evans
Your Scheme/Reference:
LM 203570/DK - 11

Exact Scales:
1:1250 Area or Circle dig site
1:500 Line dig site


Link Box	Overhead Line	Underground Cable	National Grid Telecoms	Pilot Cables
●	<ul style="list-style-type: none"> ○ PL ○ Service ○ LV ○ HV (11kV) ○ HV (33kV) ○ HV (66kV) ○ HV (132kV) 	<ul style="list-style-type: none"> --- --- --- --- --- --- --- 	<ul style="list-style-type: none"> —E— PME Earth —E— Underground Earth 	<ul style="list-style-type: none"> ○ Pole Mounted Transformer □ Ground Mounted Transformer
Site Location Line/Area	<ul style="list-style-type: none"> — — — — — — — 			

IMPORTANT NOTICES

- This information is given as a guide only and its accuracy cannot be guaranteed. Services or recent additions to the network may not be shown.
- Cables, overhead lines & substations owned by other electricity network owners or private companies may be present and may not be shown.
- You should always verify exact locations of cables using a cable locator and by careful use of hand tools in accordance with HSE guidance note HSG47.
- When working within 10m of any overhead electric line you should follow the requirements of HSE Guidance Note GS6.
- For further advice on working near our electricity cables or lines, call our General Enquiries number.
- Advice should be sought from the National Grid Electricity Distribution General Enquiries team for any work that is to take place in proximity to 132kV underground cables and 132kV overhead lines.

Report damage immediately – KEEP EVERYONE AWAY FROM THE AREA
0800 6783 105

Crown Copyright © All Rights Reserved. Ordnance Survey Licence numbers: 100022432
NGED Copyright: This copy has been made by or with the authority of National Grid Electricity Distribution (NGED) pursuant to Section 47 of the Copyright Designs and Patents Act 1988 unless that Act provides a relevant exception to copyright the copy must not be copied without the prior permission of the copyright owner.

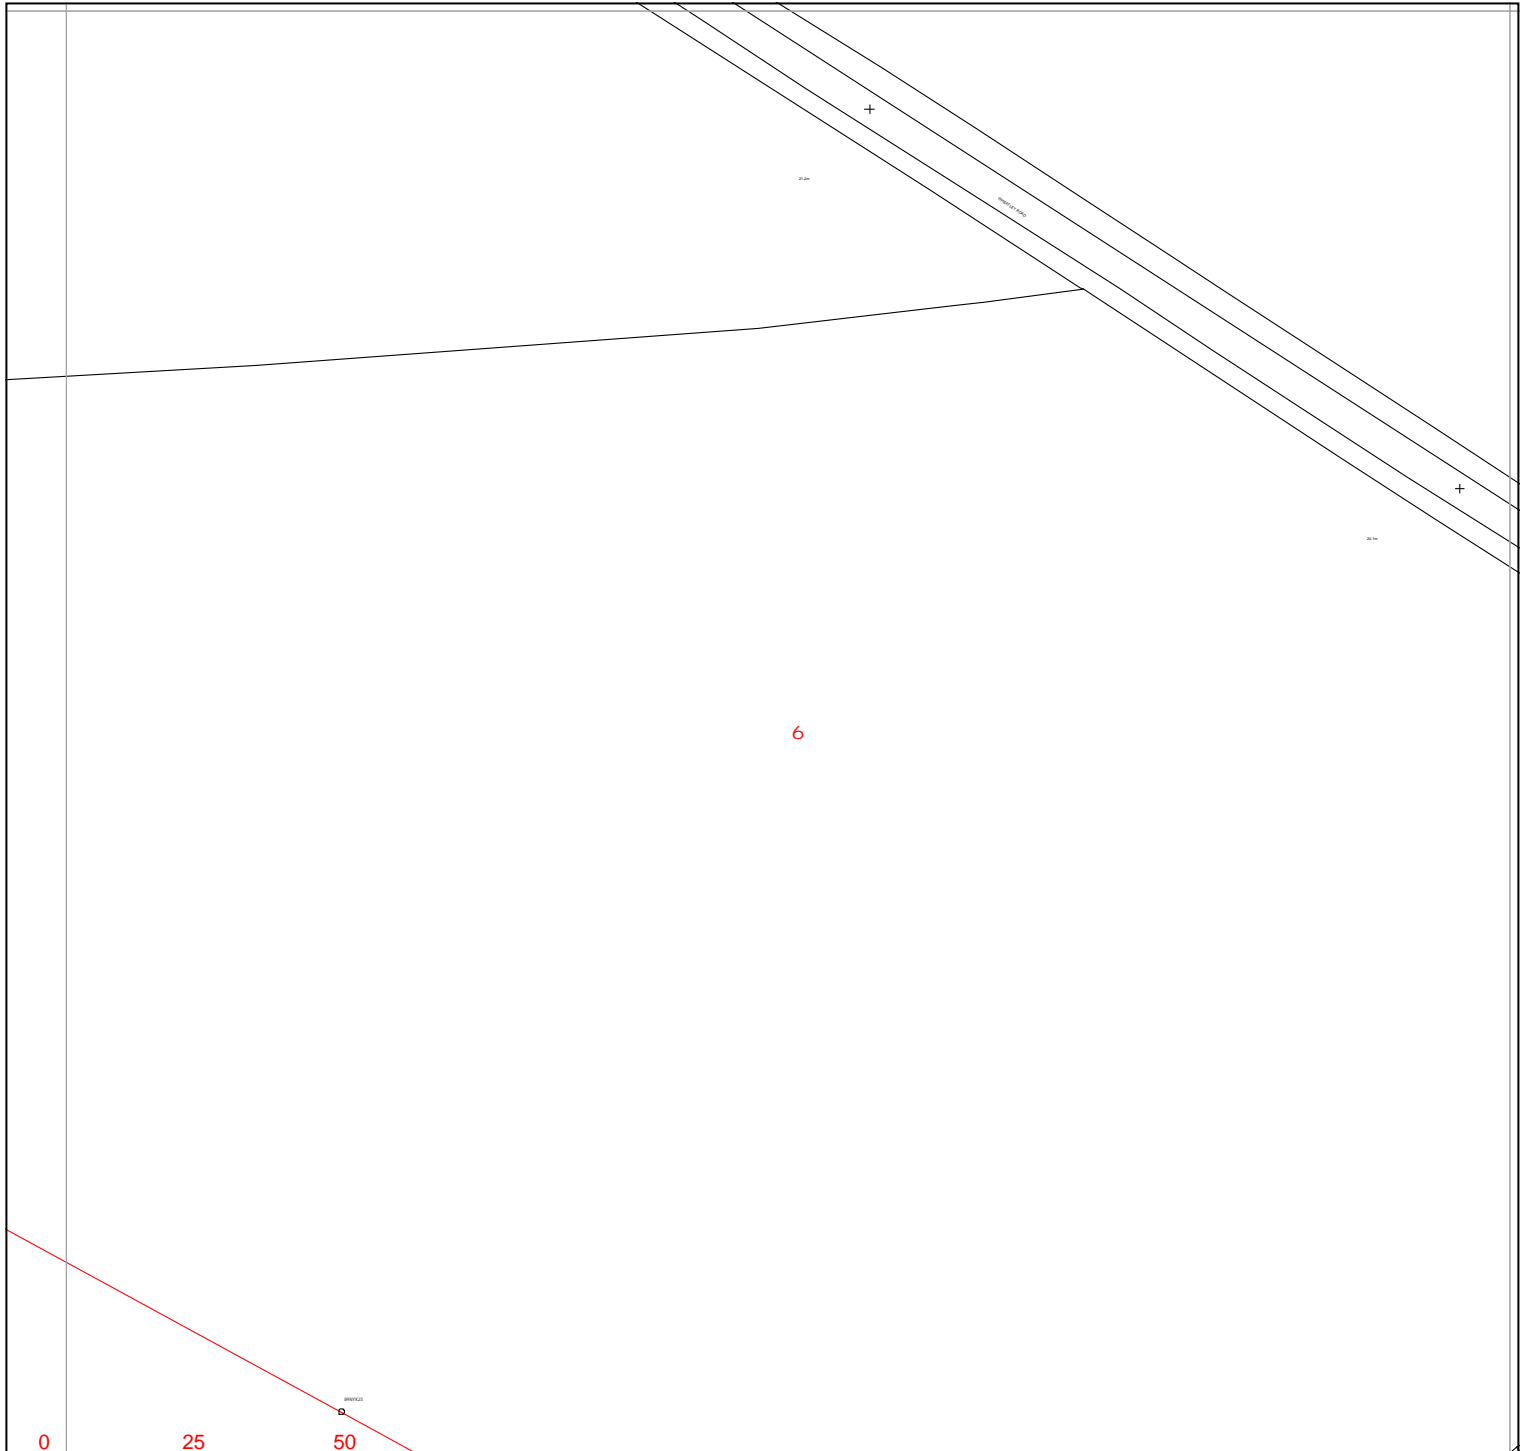

Warning: PDF designed for colour print only with no page scaling.

nationalgrid Electricity Distribution

Contact Us

Mapping Enquiries:
All areas 0121 623 9780

General Enquiries:
All areas 0800 096 3080

Date Requested: 08/05/2023
Job Reference: 29406949
Site Location: 477455 384776
Requested by:
Mr Ben Evans
Your Scheme/Reference:
LM 203570/DK - 11

Exact Scales:
1:1250 Area or Circle dig site
1:500 Line dig site


Link Box	Overhead Line	Underground Cable	National Grid Telecoms	Pilot Cables
●	<ul style="list-style-type: none"> ○ PL ○ Service ○ LV ○ HV (11kV) ○ HV (33kV) ○ HV (66kV) ○ HV (132kV) 	<ul style="list-style-type: none"> --- --- --- --- --- --- --- 	<ul style="list-style-type: none"> —E— PME Earth —E— Underground Earth 	<ul style="list-style-type: none"> ○ Pole Mounted Transformer □ Ground Mounted Transformer
<ul style="list-style-type: none"> — Site Location — Line/Area 				

IMPORTANT NOTICES

- This information is given as a guide only and its accuracy cannot be guaranteed. Services or recent additions to the network may not be shown.
- Cables, overhead lines & substations owned by other electricity network owners or private companies may be present and may not be shown.
- You should always verify exact locations of cables using a cable locator and by careful use of hand tools in accordance with HSE guidance note HSG47.
- When working within 10m of any overhead electric line you should follow the requirements of HSE Guidance Note GS6.
- For further advice on working near our electricity cables or lines, call our General Enquiries number.
- Advice should be sought from the National Grid Electricity Distribution General Enquiries team for any work that is to take place in proximity to 132kV underground cables and 132kV overhead lines.

Report damage immediately – KEEP EVERYONE AWAY FROM THE AREA
0800 6783 105

Crown Copyright © All Rights Reserved. Ordnance Survey Licence numbers: 100022432
NGED Copyright: This copy has been made by or with the authority of National Grid Electricity Distribution (NGED) pursuant to Section 47 of the Copyright Designs and Patents Act 1988 unless that Act provides a relevant exception to copyright the copy must not be copied without the prior permission of the copyright owner.

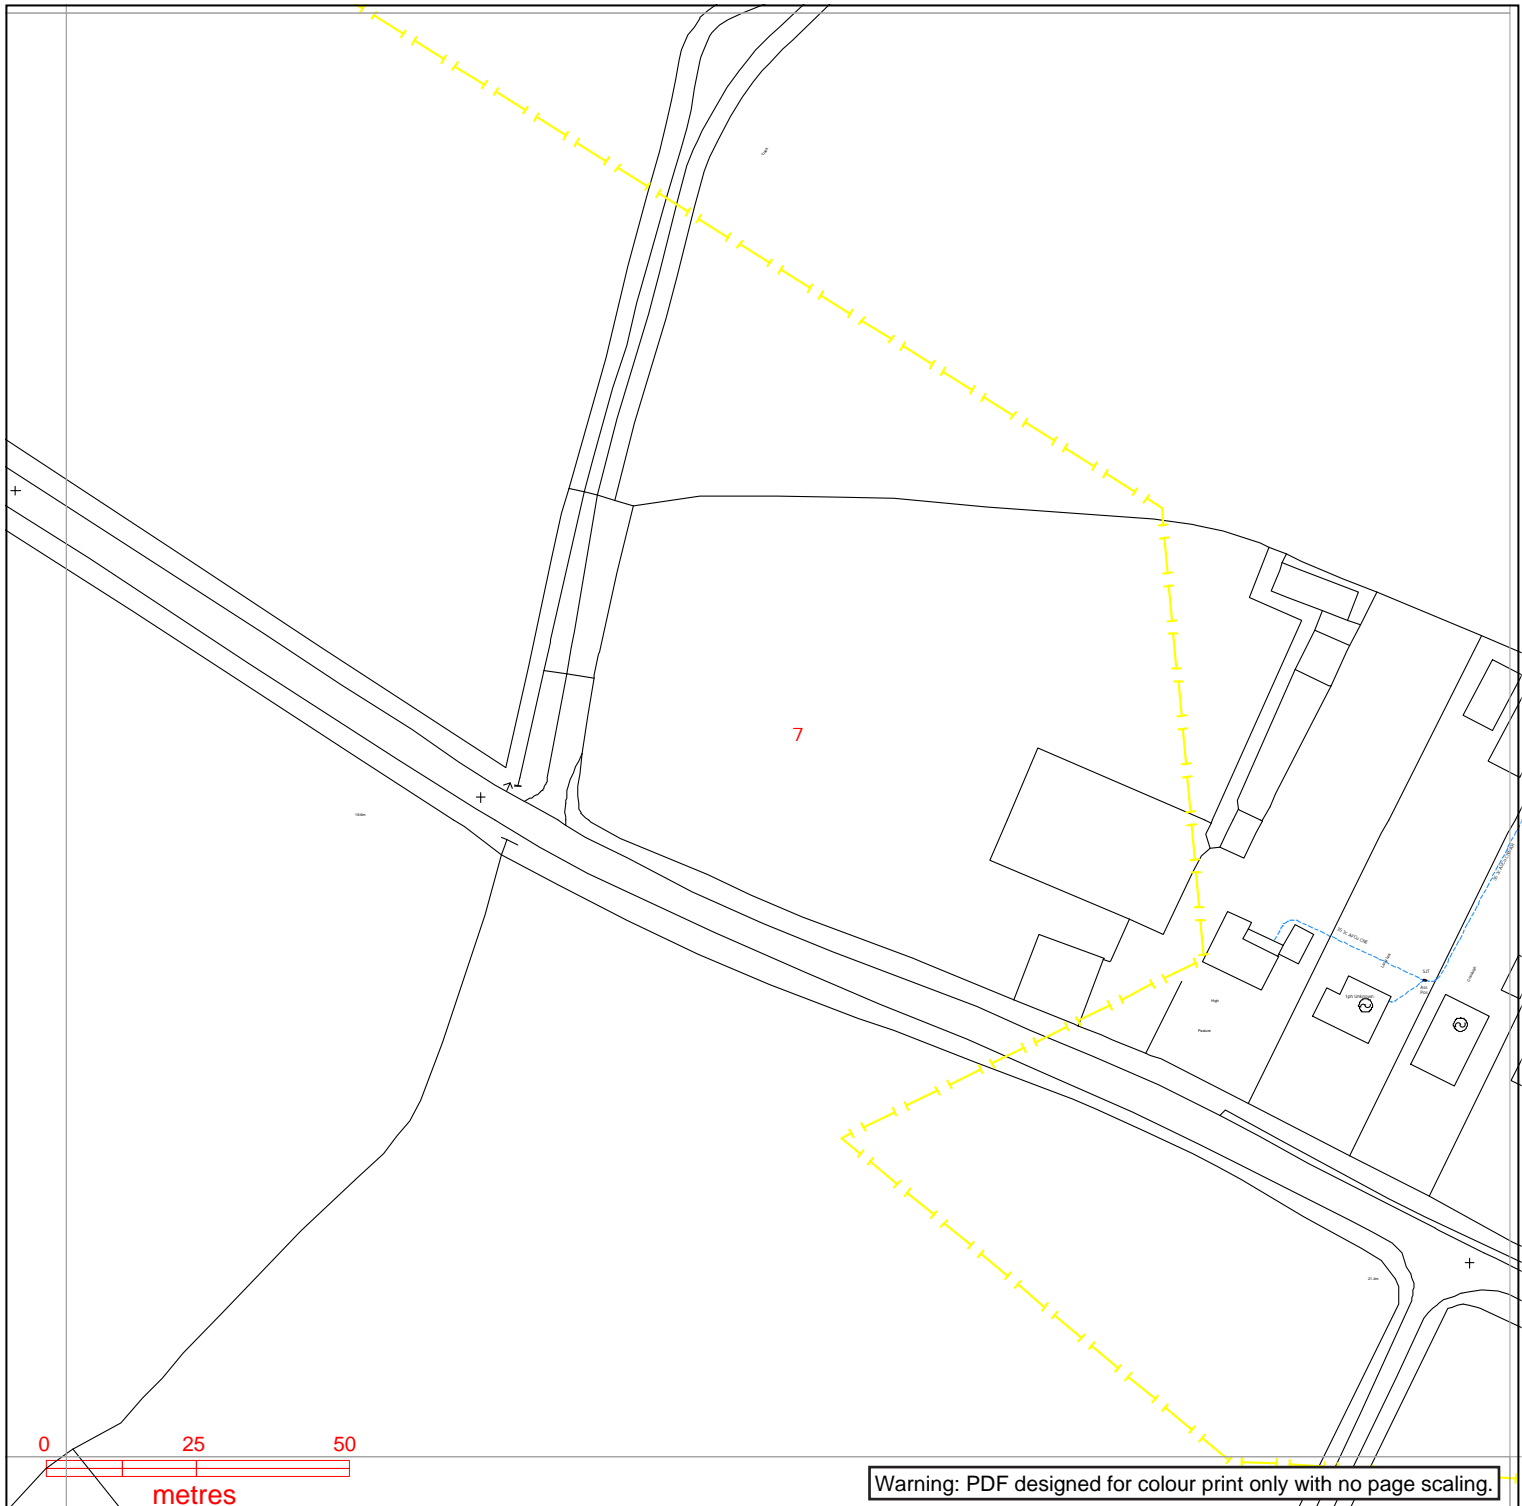

Contact Us

Mapping Enquiries:
All areas 0121 623 9780

General Enquiries:
All areas 0800 096 3080

Date Requested: 08/05/2023
Job Reference: 29406949
Site Location: 477455 384776
Requested by:
Mr Ben Evans
Your Scheme/Reference:
LM 203570/DK - 11

Exact Scales:
1:1250 Area or Circle dig site
1:500 Line dig site


Link Box	Overhead Line	Underground Cable	National Grid Telecoms	Pilot Cables
●	<ul style="list-style-type: none"> ○ PL ○ Service ○ LV ○ HV (11kV) ○ HV (33kV) ○ HV (66kV) ○ HV (132kV) 	<ul style="list-style-type: none"> --- --- --- --- --- --- --- 	<ul style="list-style-type: none"> --- PME Earth ---E Underground Earth 	<ul style="list-style-type: none"> ○ Pole Mounted Transformer □ Ground Mounted Transformer

IMPORTANT NOTICES

- This information is given as a guide only and its accuracy cannot be guaranteed. Services or recent additions to the network may not be shown.
- Cables, overhead lines & substations owned by other electricity network owners or private companies may be present and may not be shown.
- You should always verify exact locations of cables using a cable locator and by careful use of hand tools in accordance with HSE guidance note HSG47.
- When working within 10m of any overhead electric line you should follow the requirements of HSE Guidance Note GS6.
- For further advice on working near our electricity cables or lines, call our General Enquiries number.
- Advice should be sought from the National Grid Electricity Distribution General Enquiries team for any work that is to take place in proximity to 132kV underground cables and 132kV overhead lines.

Report damage immediately – KEEP EVERYONE AWAY FROM THE AREA
0800 6783 105

Crown Copyright © All Rights Reserved. Ordnance Survey Licence numbers: 100022432
NGED Copyright: This copy has been made by or with the authority of National Grid Electricity Distribution (NGED) pursuant to Section 47 of the Copyright Designs and Patents Act 1988 unless that Act provides a relevant exception to copyright the copy must not be copied without the prior permission of the copyright owner.

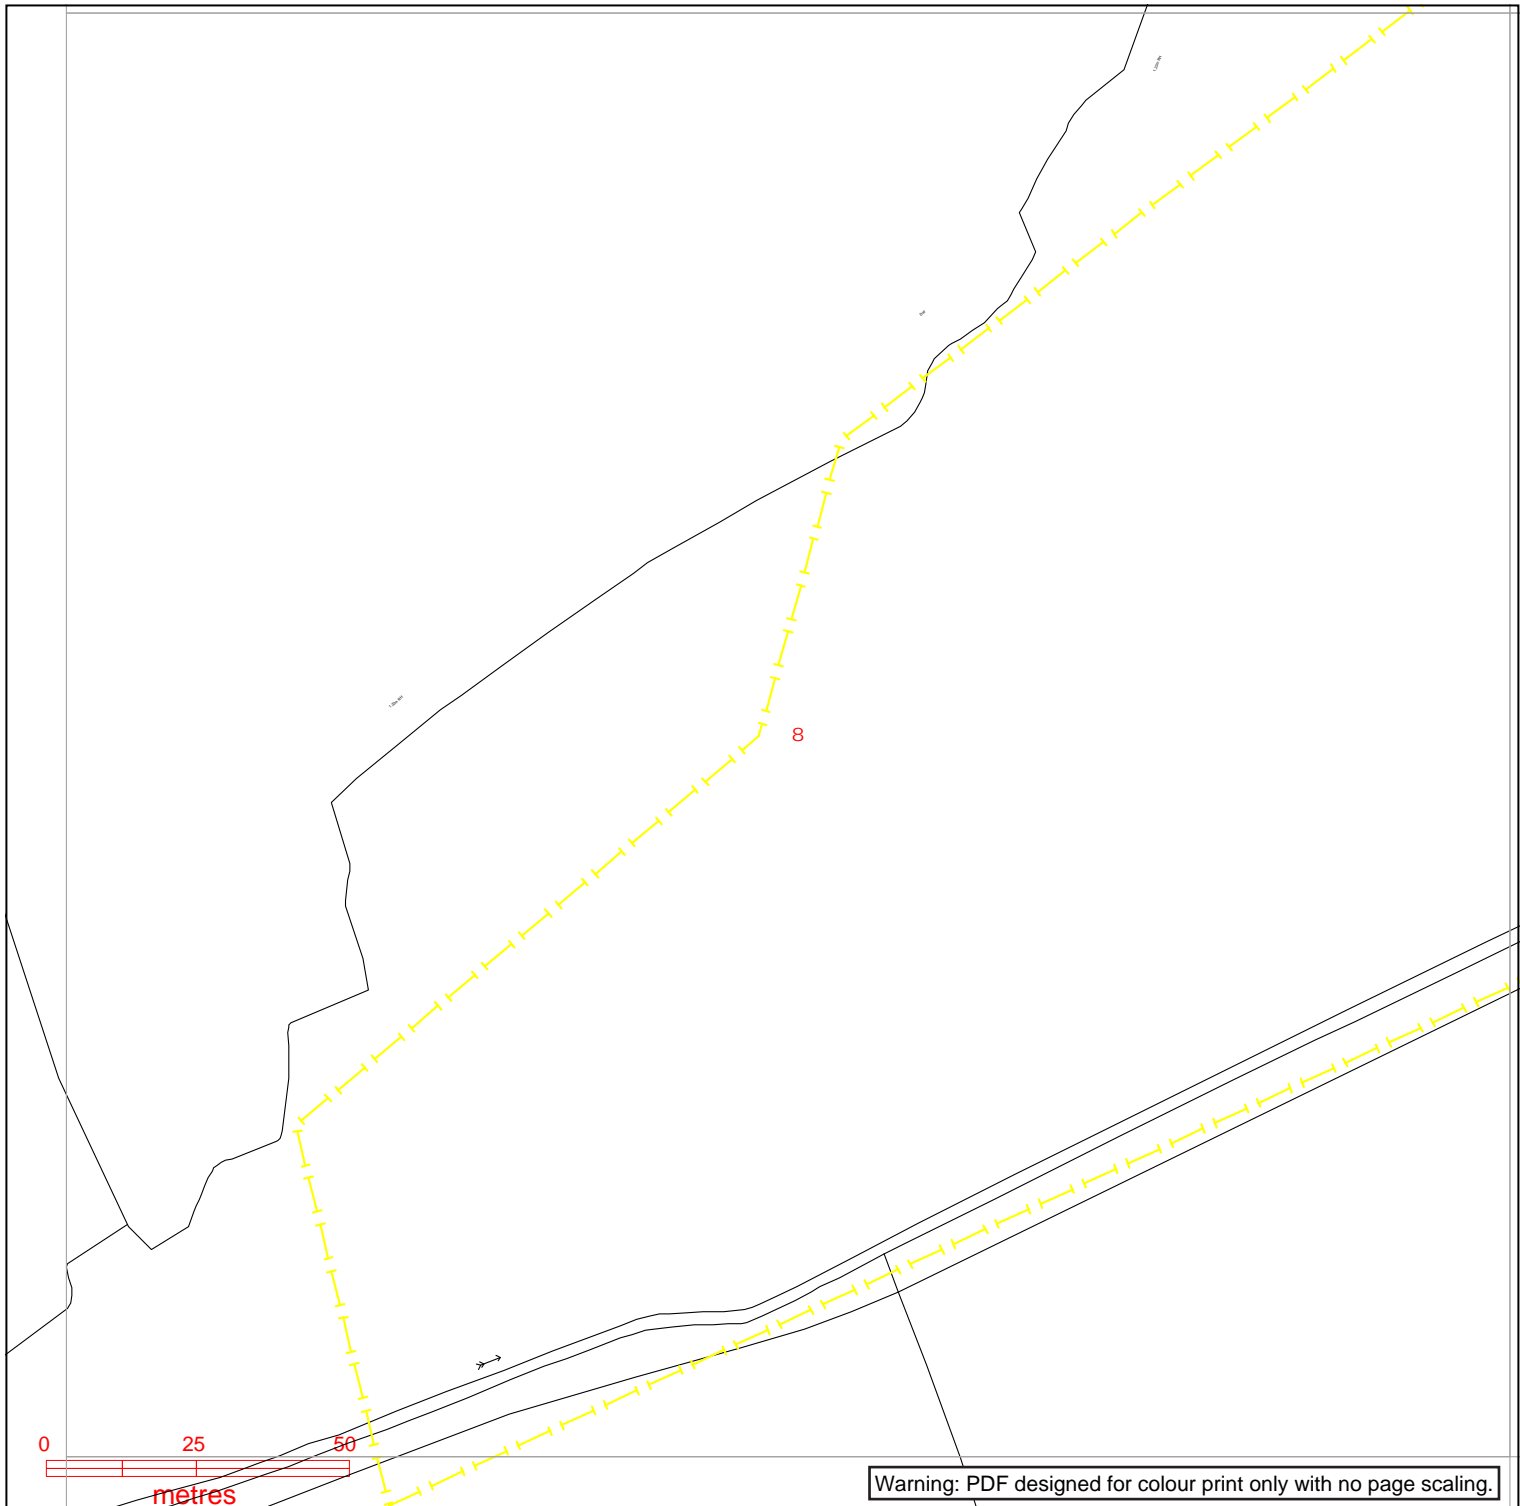

nationalgrid Electricity Distribution

Contact Us

Mapping Enquiries:
All areas 0121 623 9780

General Enquiries:
All areas 0800 096 3080

Date Requested: 08/05/2023
Job Reference: 29406949
Site Location: 477455 384776
Requested by:
Mr Ben Evans
Your Scheme/Reference:
LM 203570/DK - 11

Exact Scales:
1:1250 Area or Circle dig site
1:500 Line dig site


Link Box ●	Overhead Line ○—○ PL ○—○ Service ○—○ LV ○—○ HV (11kV) ○—○ HV (33kV) ○—○ HV (66kV) ○—○ HV (132kV)	Underground Cable -	National Grid Telecoms - - - - - PME Earth Underground Earth	Pilot Cables ○ Pole Mounted Transformer □ Ground Mounted Transformer
----------------------	--	---	--	---

IMPORTANT NOTICES

- This information is given as a guide only and its accuracy cannot be guaranteed. Services or recent additions to the network may not be shown.
- Cables, overhead lines & substations owned by other electricity network owners or private companies may be present and may not be shown.
- You should always verify exact locations of cables using a cable locator and by careful use of hand tools in accordance with HSE guidance note HSG47.
- When working within 10m of any overhead electric line you should follow the requirements of HSE Guidance Note GS6.
- For further advice on working near our electricity cables or lines, call our General Enquiries number.
- Advice should be sought from the National Grid Electricity Distribution General Enquiries team for any work that is to take place in proximity to 132kV underground cables and 132kV overhead lines.

Report damage immediately – KEEP EVERYONE AWAY FROM THE AREA
0800 6783 105

Crown Copyright © All Rights Reserved. Ordnance Survey Licence numbers: 100022432
NGED Copyright: This copy has been made by or with the authority of National Grid Electricity Distribution (NGED) pursuant to Section 47 of the Copyright Designs and Patents Act 1988 unless that Act provides a relevant exception to copyright the copy must not be copied without the prior permission of the copyright owner.

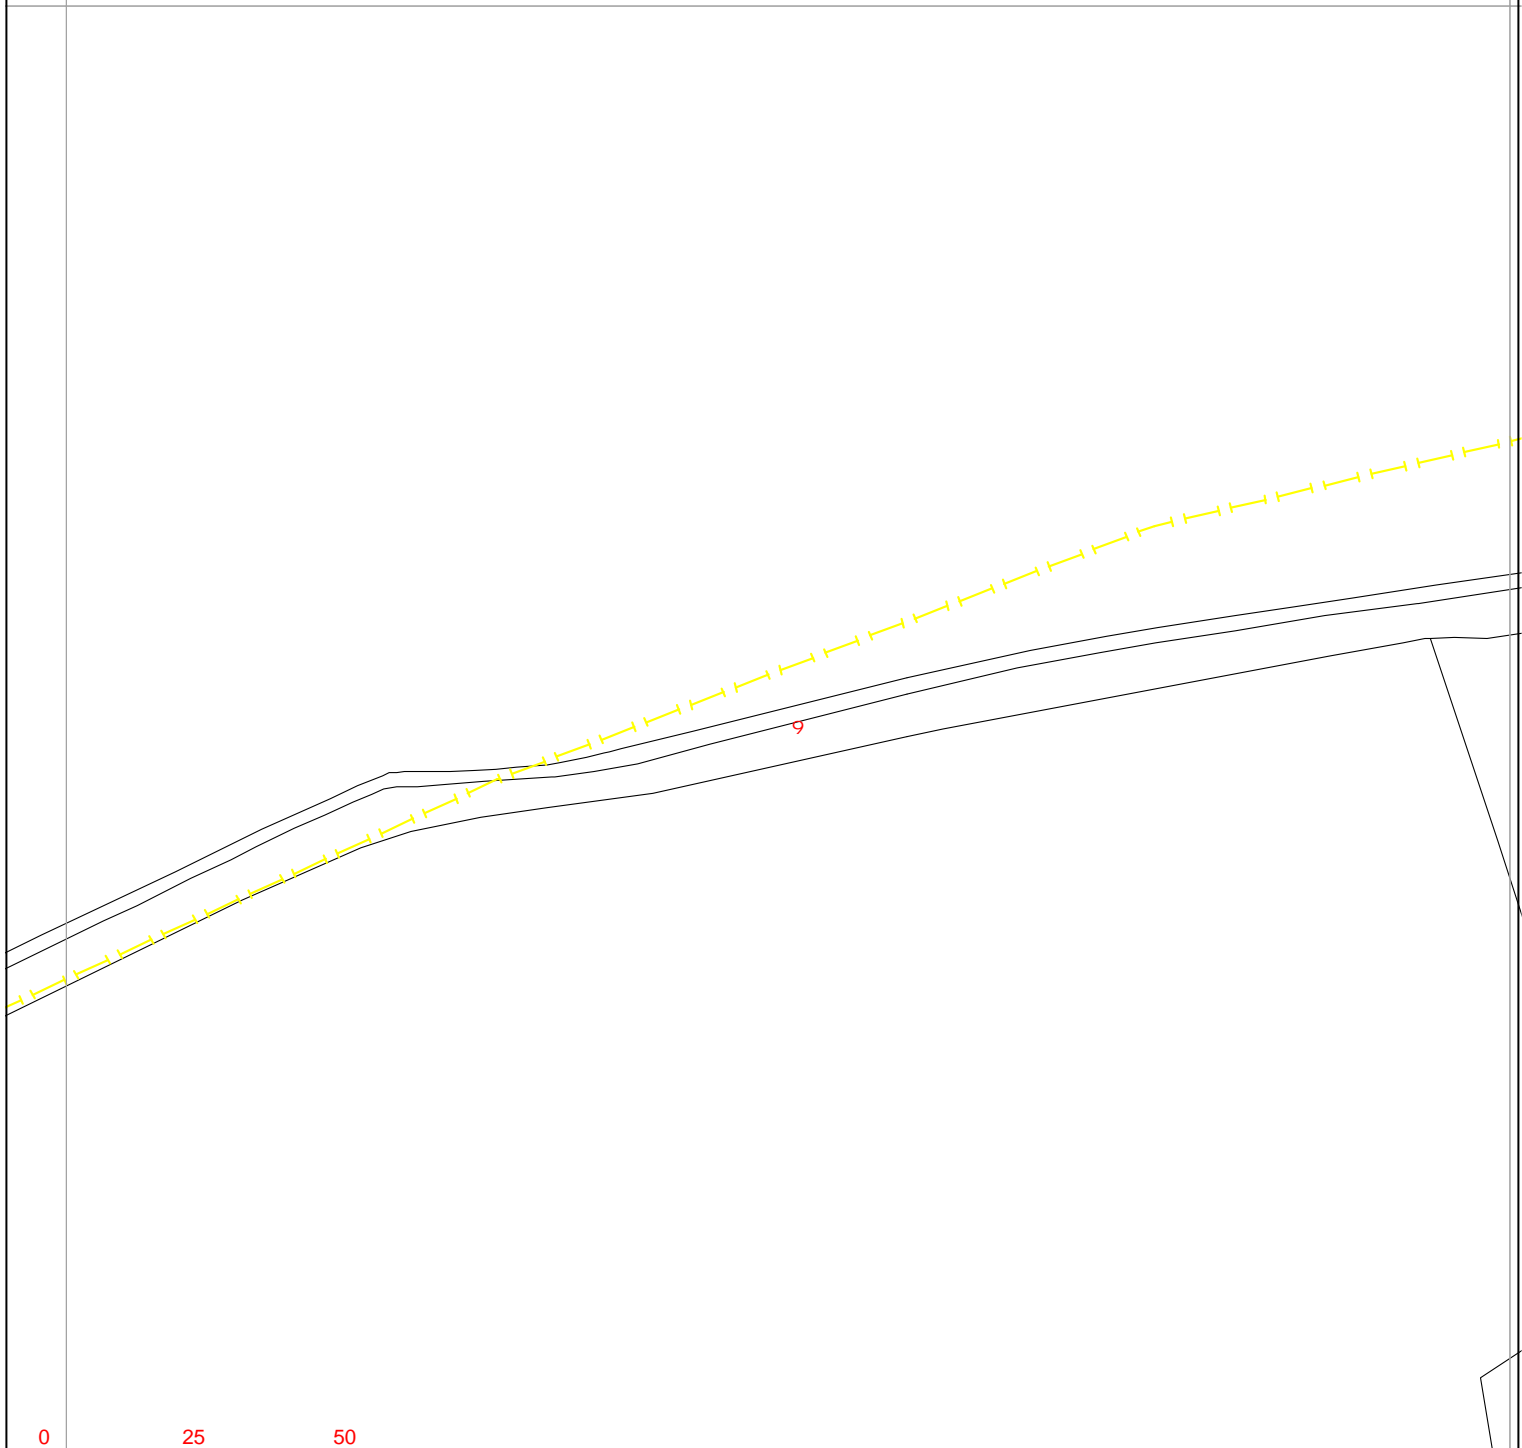

Warning: PDF designed for colour print only with no page scaling.

nationalgrid Electricity Distribution

Contact Us

Mapping Enquiries:
All areas 0121 623 9780

General Enquiries:
All areas 0800 096 3080

Date Requested: 08/05/2023
Job Reference: 29406949
Site Location: 477455 384776
Requested by:
Mr Ben Evans
Your Scheme/Reference:
LM 203570/DK - 11

Exact Scales:
1:1250 Area or Circle dig site
1:500 Line dig site


Link Box	Overhead Line	Underground Cable	National Grid Telecoms	Pilot Cables
●				
Site Location 				

IMPORTANT NOTICES

- This information is given as a guide only and its accuracy cannot be guaranteed. Services or recent additions to the network may not be shown.
- Cables, overhead lines & substations owned by other electricity network owners or private companies may be present and may not be shown.
- You should always verify exact locations of cables using a cable locator and by careful use of hand tools in accordance with HSE guidance note HSG47.
- When working within 10m of any overhead electric line you should follow the requirements of HSE Guidance Note GS6.
- For further advice on working near our electricity cables or lines, call our General Enquiries number.
- Advice should be sought from the National Grid Electricity Distribution General Enquiries team for any work that is to take place in proximity to 132kV underground cables and 132kV overhead lines.

Report damage immediately – KEEP EVERYONE AWAY FROM THE AREA
0800 6783 105

Crown Copyright © All Rights Reserved. Ordnance Survey Licence numbers: 100022432
NGED Copyright: This copy has been made by or with the authority of National Grid Electricity Distribution (NGED) pursuant to Section 47 of the Copyright Designs and Patents Act 1988 unless that Act provides a relevant exception to copyright the copy must not be copied without the prior permission of the copyright owner.

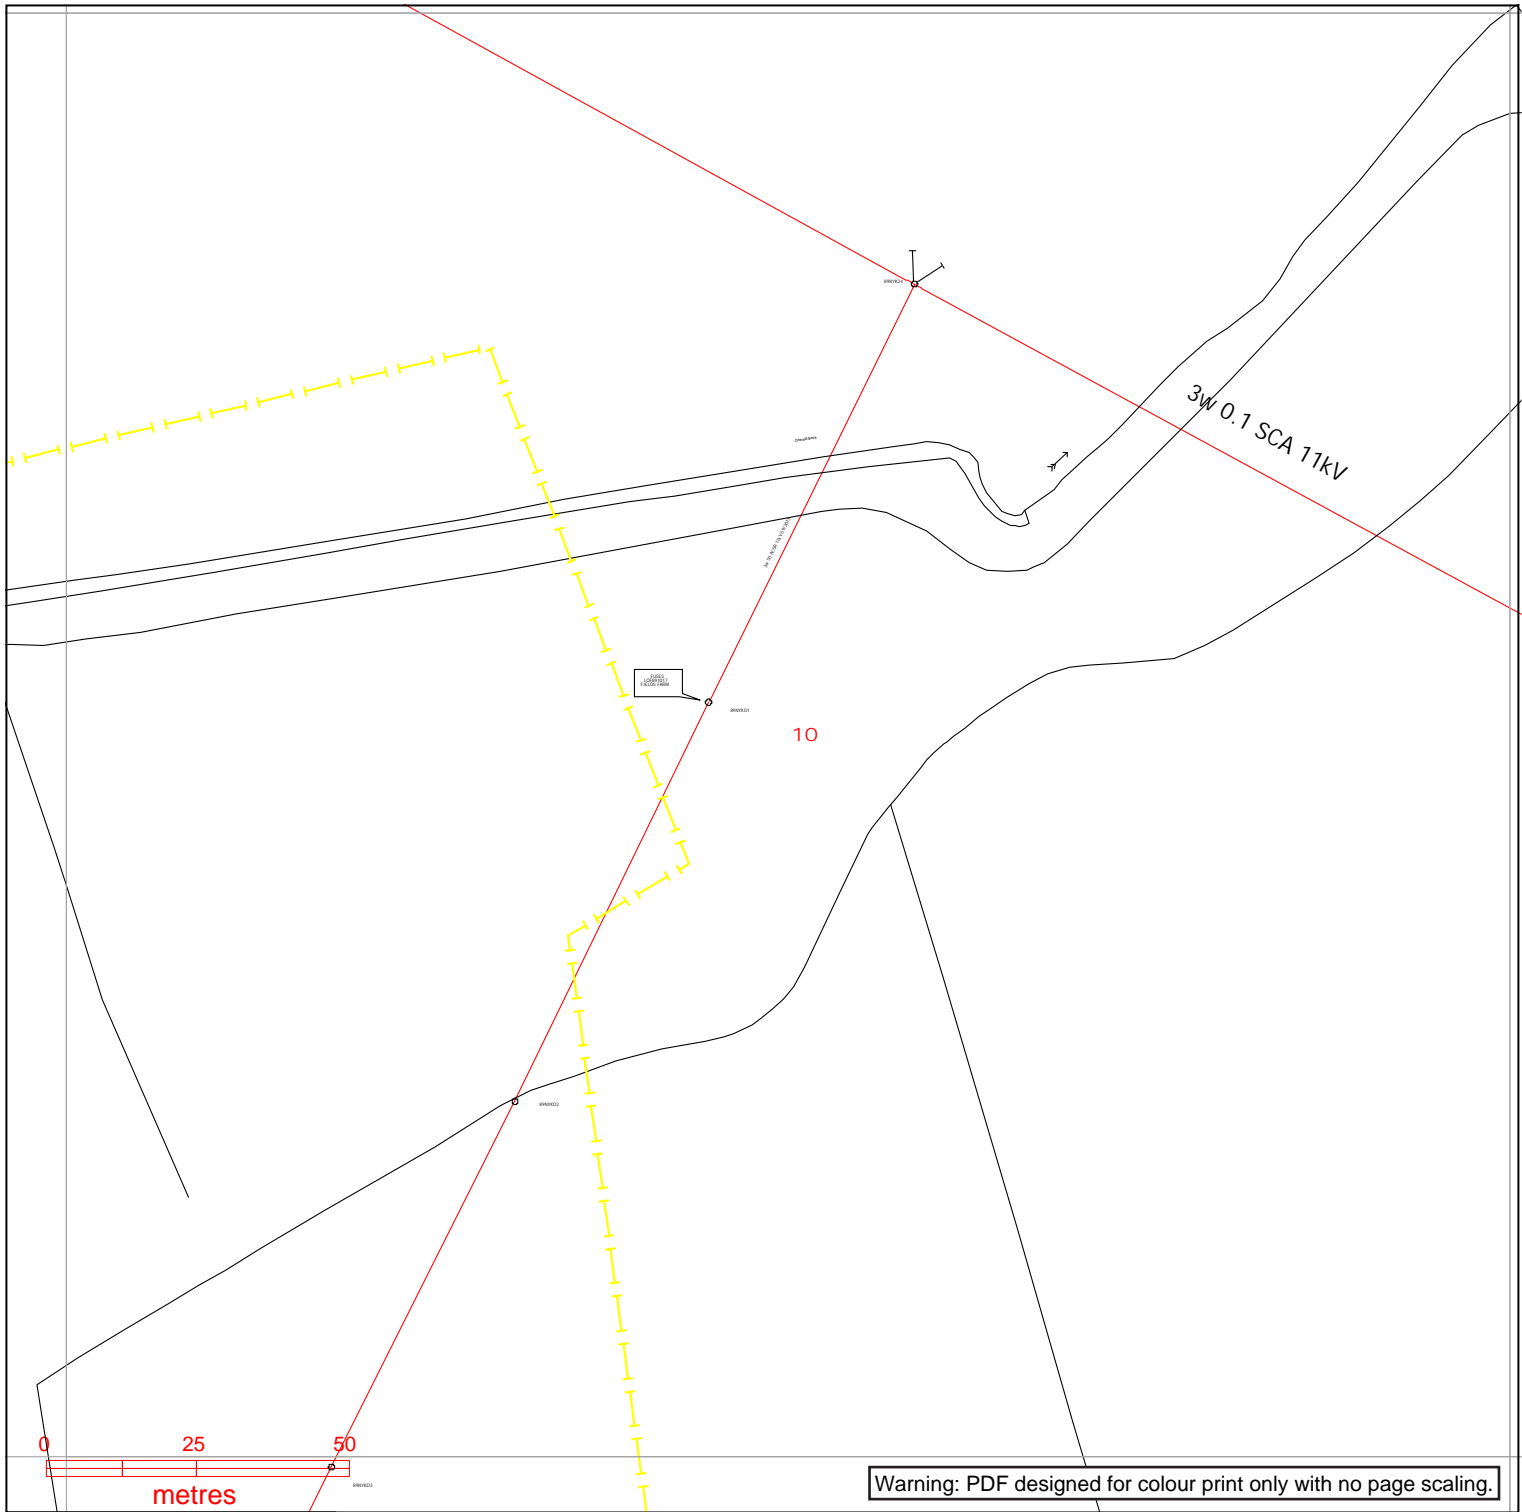

Warning: PDF designed for colour print only with no page scaling.

nationalgrid Electricity Distribution

Contact Us

Mapping Enquiries:
All areas 0121 623 9780

General Enquiries:
All areas 0800 096 3080

Date Requested: 08/05/2023
Job Reference: 29406949
Site Location: 477455 384776
Requested by:
Mr Ben Evans
Your Scheme/Reference:
LM 203570/DK - 11

Exact Scales:
1:1250 Area or Circle dig site
1:500 Line dig site


Link Box	Overhead Line	Underground Cable	National Grid Telecoms	Pilot Cables
●	○ PL ○ Service ○ LV ○ HV (11kV) ○ HV (33kV) ○ HV (66kV) ○ HV (132kV)	--- --- ---	--- --- ---	○ Pole Mounted Transformer □ Ground Mounted Transformer
■	■	■	■ PME Earth ■ Underground Earth	

IMPORTANT NOTICES

- This information is given as a guide only and its accuracy cannot be guaranteed. Services or recent additions to the network may not be shown.
- Cables, overhead lines & substations owned by other electricity network owners or private companies may be present and may not be shown.
- You should always verify exact locations of cables using a cable locator and by careful use of hand tools in accordance with HSE guidance note HSG47.
- When working within 10m of any overhead electric line you should follow the requirements of HSE Guidance Note GS6.
- For further advice on working near our electricity cables or lines, call our General Enquiries number.
- Advice should be sought from the National Grid Electricity Distribution General Enquiries team for any work that is to take place in proximity to 132kV underground cables and 132kV overhead lines.

Report damage immediately – KEEP EVERYONE AWAY FROM THE AREA
0800 6783 105

Crown Copyright © All Rights Reserved. Ordnance Survey Licence numbers: 100022432
NGED Copyright: This copy has been made by or with the authority of National Grid Electricity Distribution (NGED) pursuant to Section 47 of the Copyright Designs and Patents Act 1988 unless that Act provides a relevant exception to copyright the copy must not be copied without the prior permission of the copyright owner.

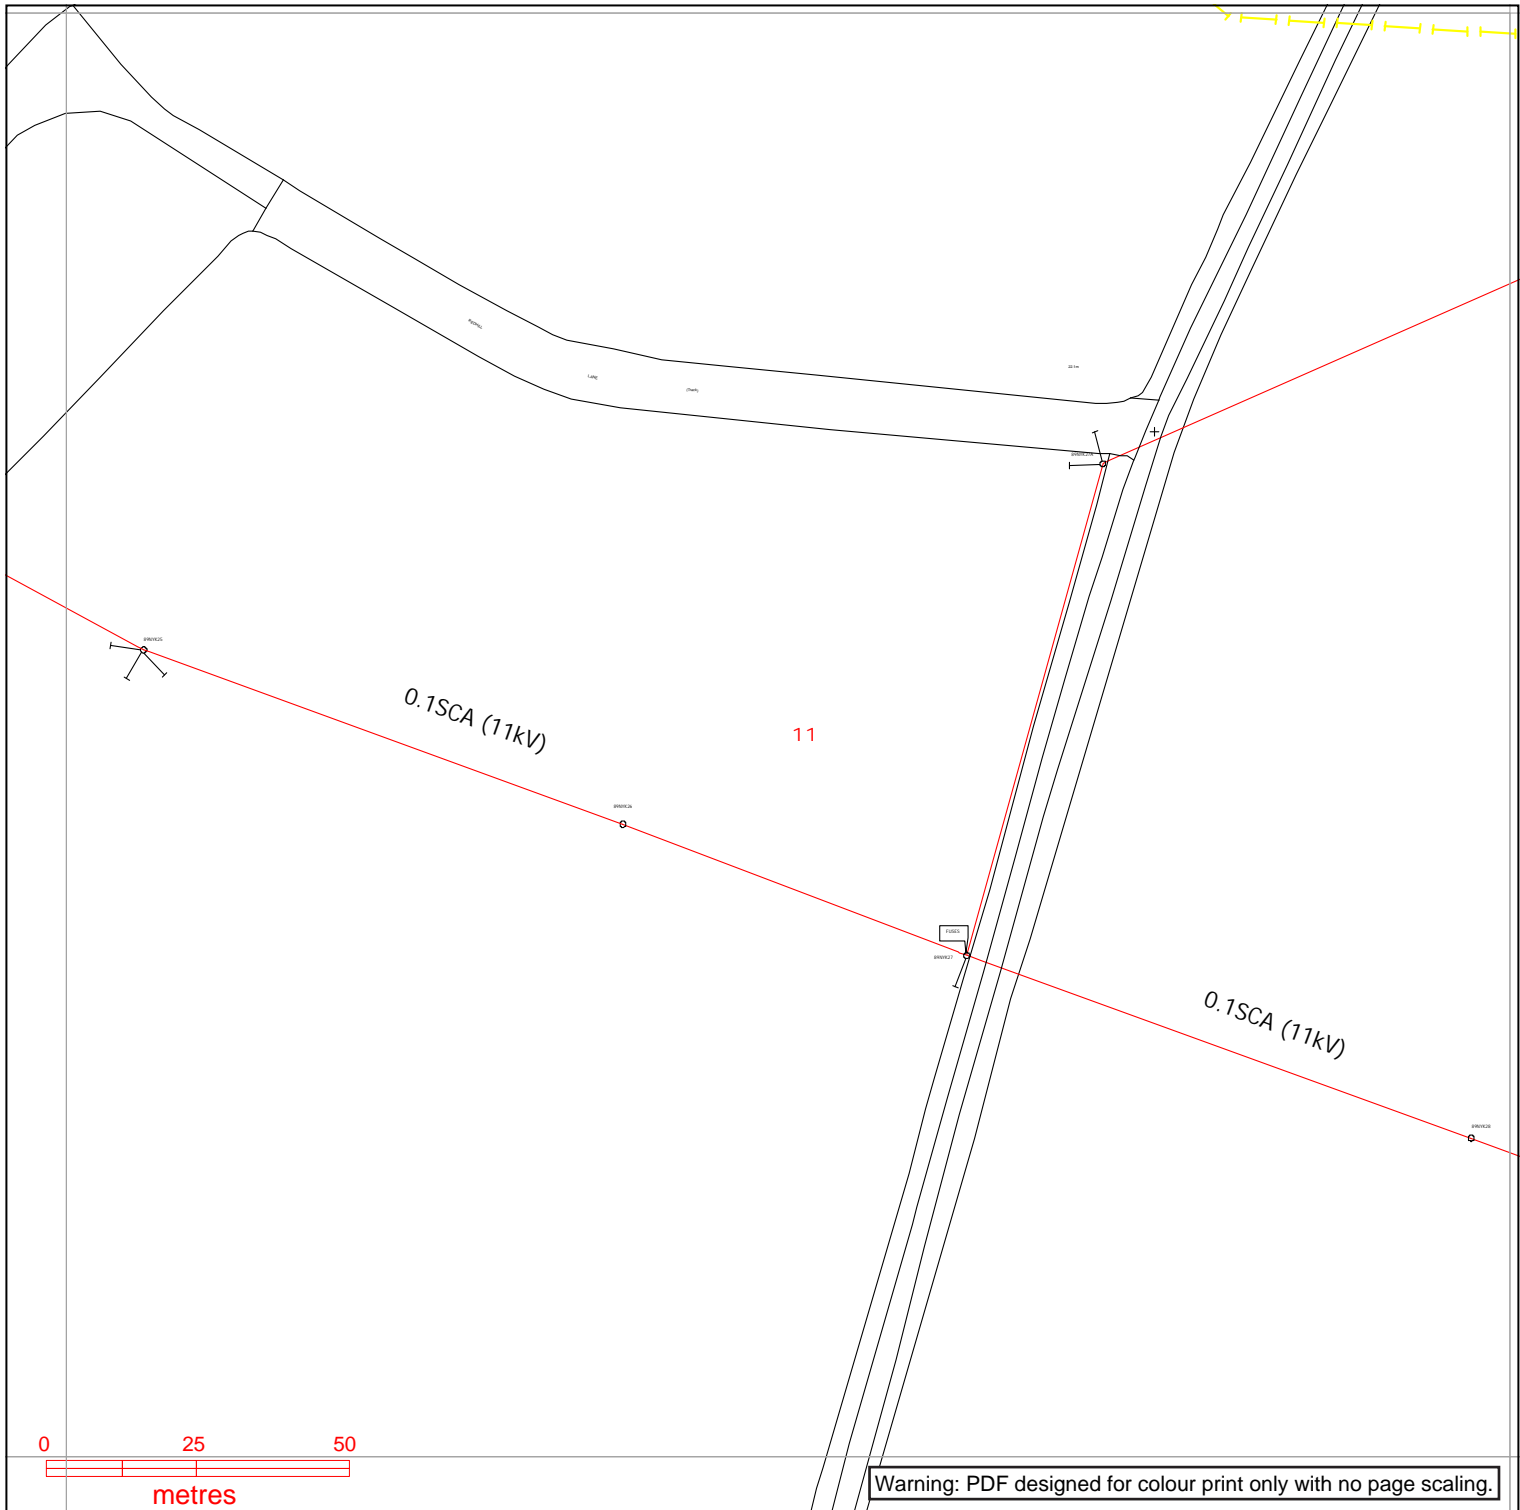

nationalgrid Electricity Distribution

Contact Us

Mapping Enquiries:
All areas 0121 623 9780

General Enquiries:
All areas 0800 096 3080

Date Requested: 08/05/2023
Job Reference: 29406949
Site Location: 477455 384776
Requested by:
Mr Ben Evans
Your Scheme/Reference:
LM 203570/DK - 11

Exact Scales:
1:1250 Area or Circle dig site
1:500 Line dig site


Link Box	Overhead Line	Underground Cable	National Grid Telecoms	Pilot Cables
●	○ PL ○ Service ○ LV ○ HV (11kV) ○ HV (33kV) ○ HV (66kV) ○ HV (132kV)	---	--- PME Earth ---E Underground Earth	○ Pole Mounted Transformer □ Ground Mounted Transformer
Site Location Line/Area	--- --- --- --- --- --- ---	---		

IMPORTANT NOTICES

- This information is given as a guide only and its accuracy cannot be guaranteed. Services or recent additions to the network may not be shown.
- Cables, overhead lines & substations owned by other electricity network owners or private companies may be present and may not be shown.
- You should always verify exact locations of cables using a cable locator and by careful use of hand tools in accordance with HSE guidance note HSG47.
- When working within 10m of any overhead electric line you should follow the requirements of HSE Guidance Note GS6.
- For further advice on working near our electricity cables or lines, call our General Enquiries number.
- Advice should be sought from the National Grid Electricity Distribution General Enquiries team for any work that is to take place in proximity to 132kV underground cables and 132kV overhead lines.

Report damage immediately – KEEP EVERYONE AWAY FROM THE AREA
0800 6783 105

Crown Copyright © All Rights Reserved. Ordnance Survey Licence numbers: 100022432
NGED Copyright: This copy has been made by or with the authority of National Grid Electricity Distribution (NGED) pursuant to Section 47 of the Copyright Designs and Patents Act 1988 unless that Act provides a relevant exception to copyright the copy must not be copied without the prior permission of the copyright owner.

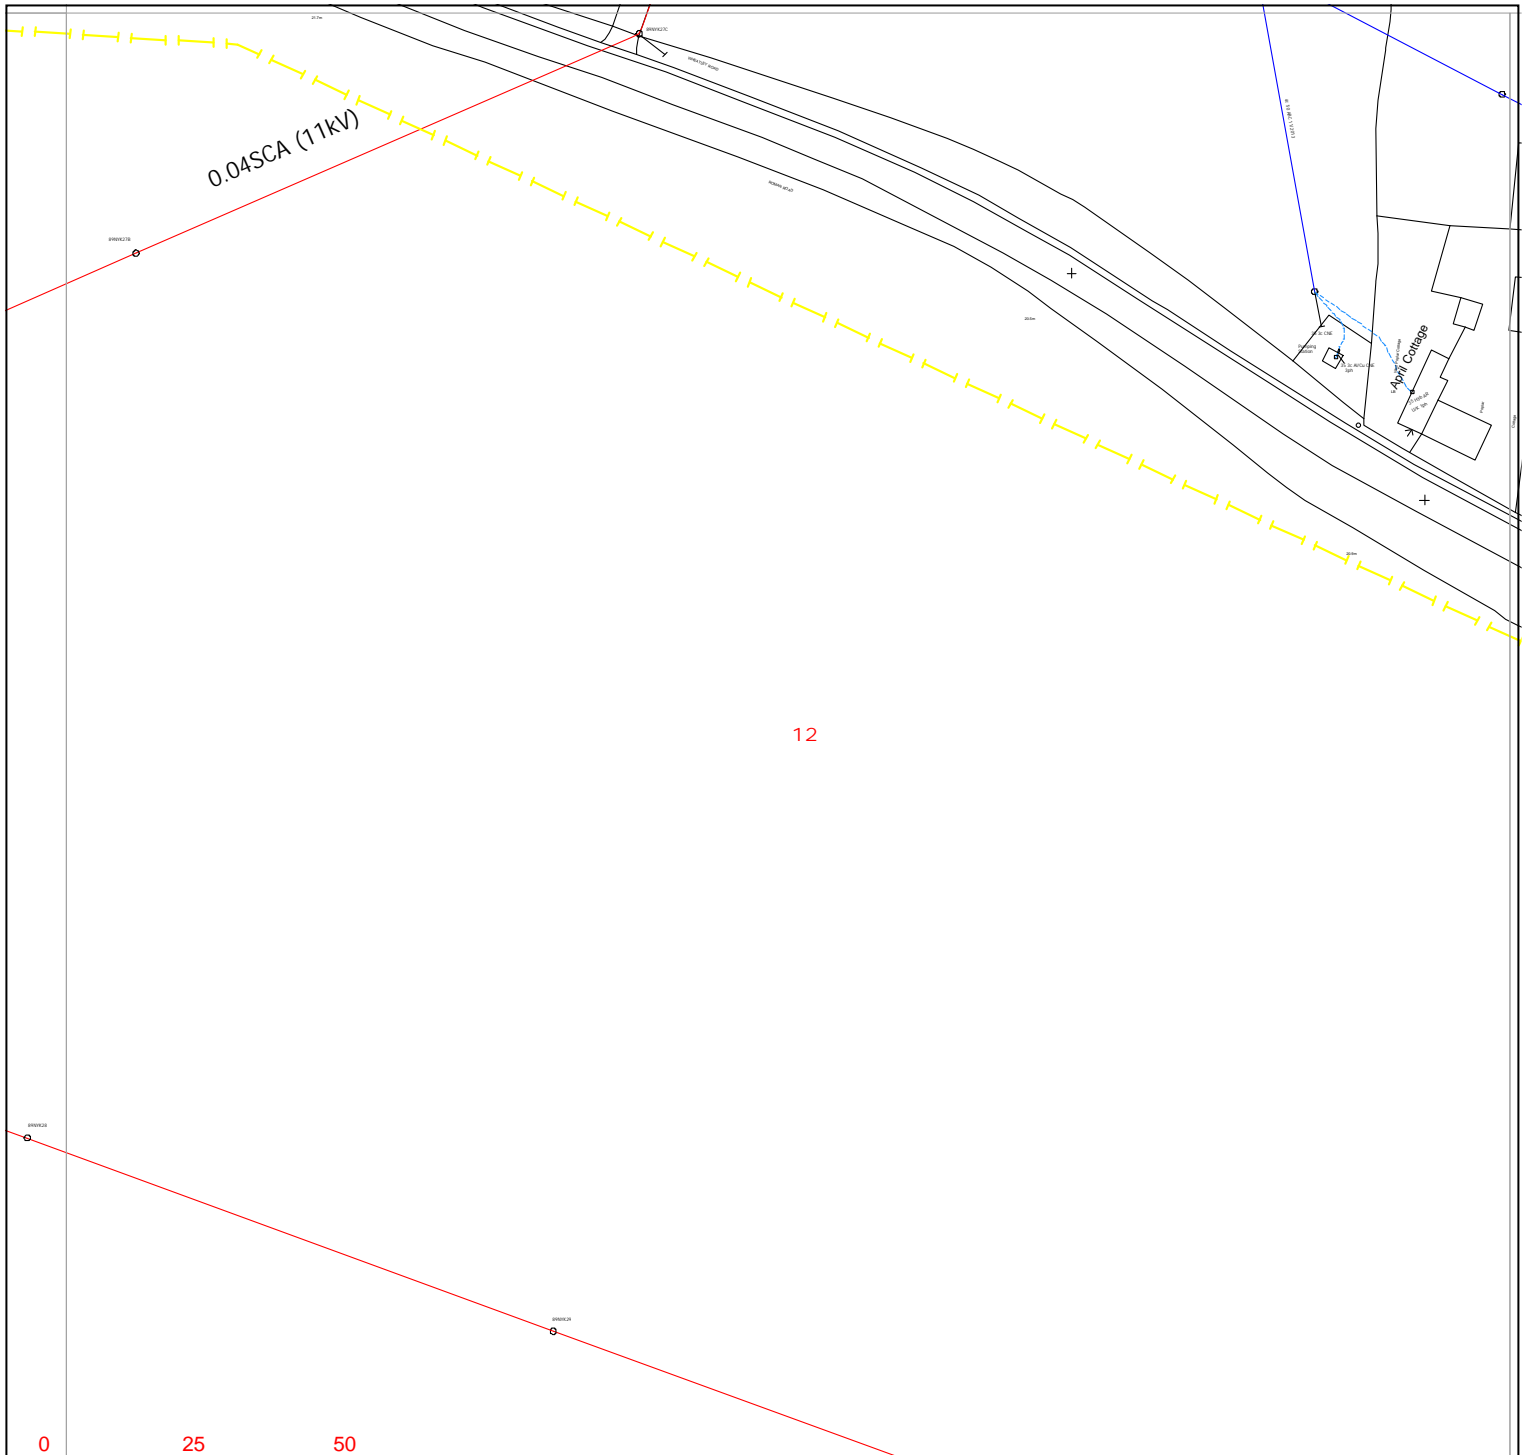

Warning: PDF designed for colour print only with no page scaling.

nationalgrid Electricity Distribution

Contact Us

Mapping Enquiries:
All areas 0121 623 9780

General Enquiries:
All areas 0800 096 3080

Date Requested: 08/05/2023
Job Reference: 29406949
Site Location: 477455 384776
Requested by:
Mr Ben Evans
Your Scheme/Reference:
LM 203570/DK - 11

Exact Scales:
1:1250 Area or Circle dig site
1:500 Line dig site


Link Box	Overhead Line	Underground Cable	National Grid Telecoms	Pilot Cables
●				

IMPORTANT NOTICES

- This information is given as a guide only and its accuracy cannot be guaranteed. Services or recent additions to the network may not be shown.
- Cables, overhead lines & substations owned by other electricity network owners or private companies may be present and may not be shown.
- You should always verify exact locations of cables using a cable locator and by careful use of hand tools in accordance with HSE guidance note HSG47.
- When working within 10m of any overhead electric line you should follow the requirements of HSE Guidance Note GS6.
- For further advice on working near our electricity cables or lines, call our General Enquiries number.
- Advice should be sought from the National Grid Electricity Distribution General Enquiries team for any work that is to take place in proximity to 132kV underground cables and 132kV overhead lines.

Report damage immediately – KEEP EVERYONE AWAY FROM THE AREA
0800 6783 105

Crown Copyright © All Rights Reserved. Ordnance Survey Licence numbers: 100022432
NGED Copyright: This copy has been made by or with the authority of National Grid Electricity Distribution (NGED) pursuant to Section 47 of the Copyright Designs and Patents Act 1988 unless that Act provides a relevant exception to copyright the copy must not be copied without the prior permission of the copyright owner.

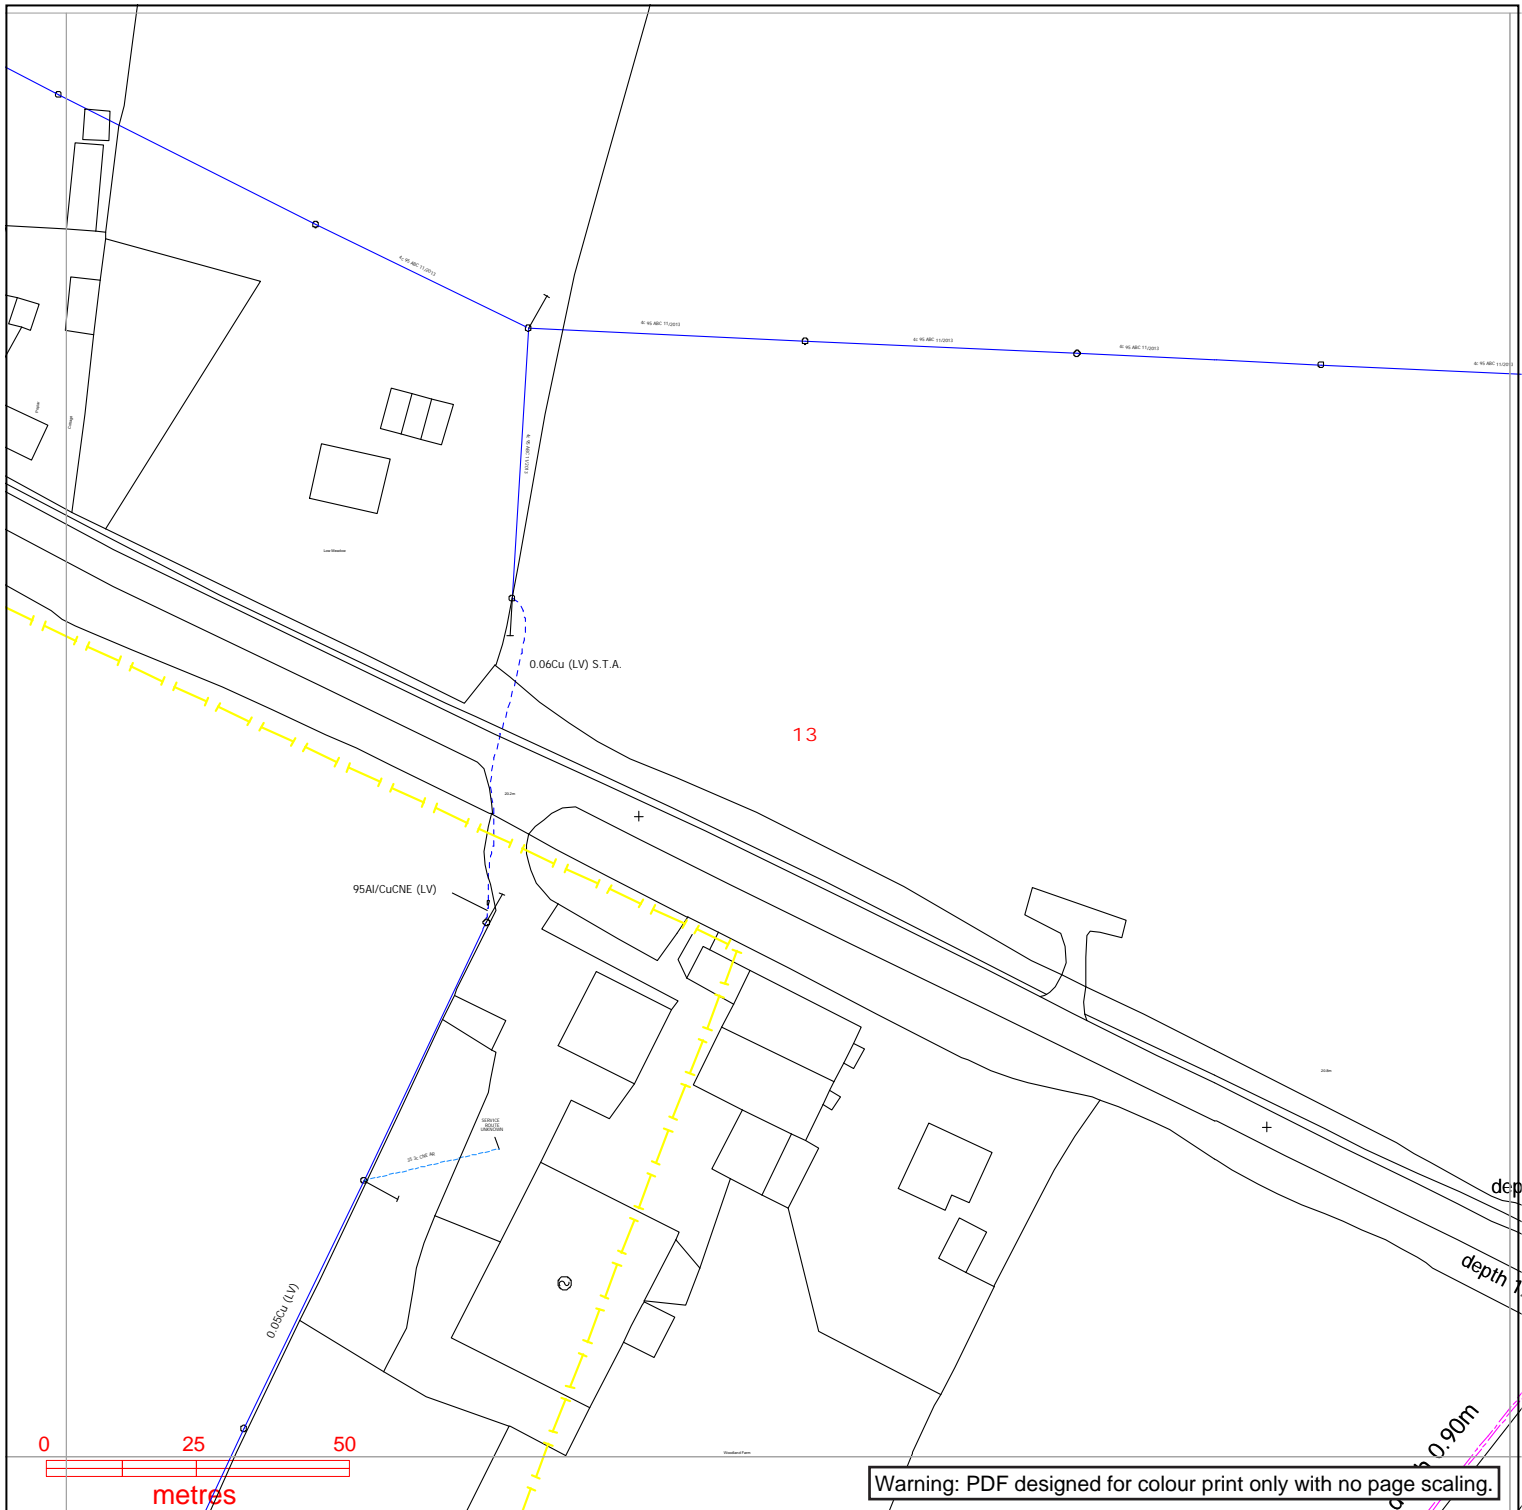

nationalgrid Electricity Distribution

Contact Us

Mapping Enquiries:
All areas 0121 623 9780

General Enquiries:
All areas 0800 096 3080

Date Requested: 08/05/2023
Job Reference: 29406949
Site Location: 477455 384776
Requested by:
Mr Ben Evans
Your Scheme/Reference:
LM 203570/DK - 11

Exact Scales:
1:1250 Area or Circle dig site
1:500 Line dig site


Link Box	Overhead Line	Underground Cable	National Grid Telecoms	Pilot Cables
●	○ PL ○ Service ○ LV ○ HV (11kV) ○ HV (33kV) ○ HV (66kV) ○ HV (132kV)	---	---	---
■	■	---	⎓ PME Earth ⎓ Underground Earth	○ Pole Mounted Transformer □ Ground Mounted Transformer

IMPORTANT NOTICES

- This information is given as a guide only and its accuracy cannot be guaranteed. Services or recent additions to the network may not be shown.
- Cables, overhead lines & substations owned by other electricity network owners or private companies may be present and may not be shown.
- You should always verify exact locations of cables using a cable locator and by careful use of hand tools in accordance with HSE guidance note HSG47.
- When working within 10m of any overhead electric line you should follow the requirements of HSE Guidance Note GS6.
- For further advice on working near our electricity cables or lines, call our General Enquiries number.
- Advice should be sought from the National Grid Electricity Distribution General Enquiries team for any work that is to take place in proximity to 132kV underground cables and 132kV overhead lines.

Report damage immediately – KEEP EVERYONE AWAY FROM THE AREA
0800 6783 105

Crown Copyright © All Rights Reserved. Ordnance Survey Licence numbers: 100022432
NGED Copyright: This copy has been made by or with the authority of National Grid Electricity Distribution (NGED) pursuant to Section 47 of the Copyright Designs and Patents Act 1988 unless that Act provides a relevant exception to copyright the copy must not be copied without the prior permission of the copyright owner.

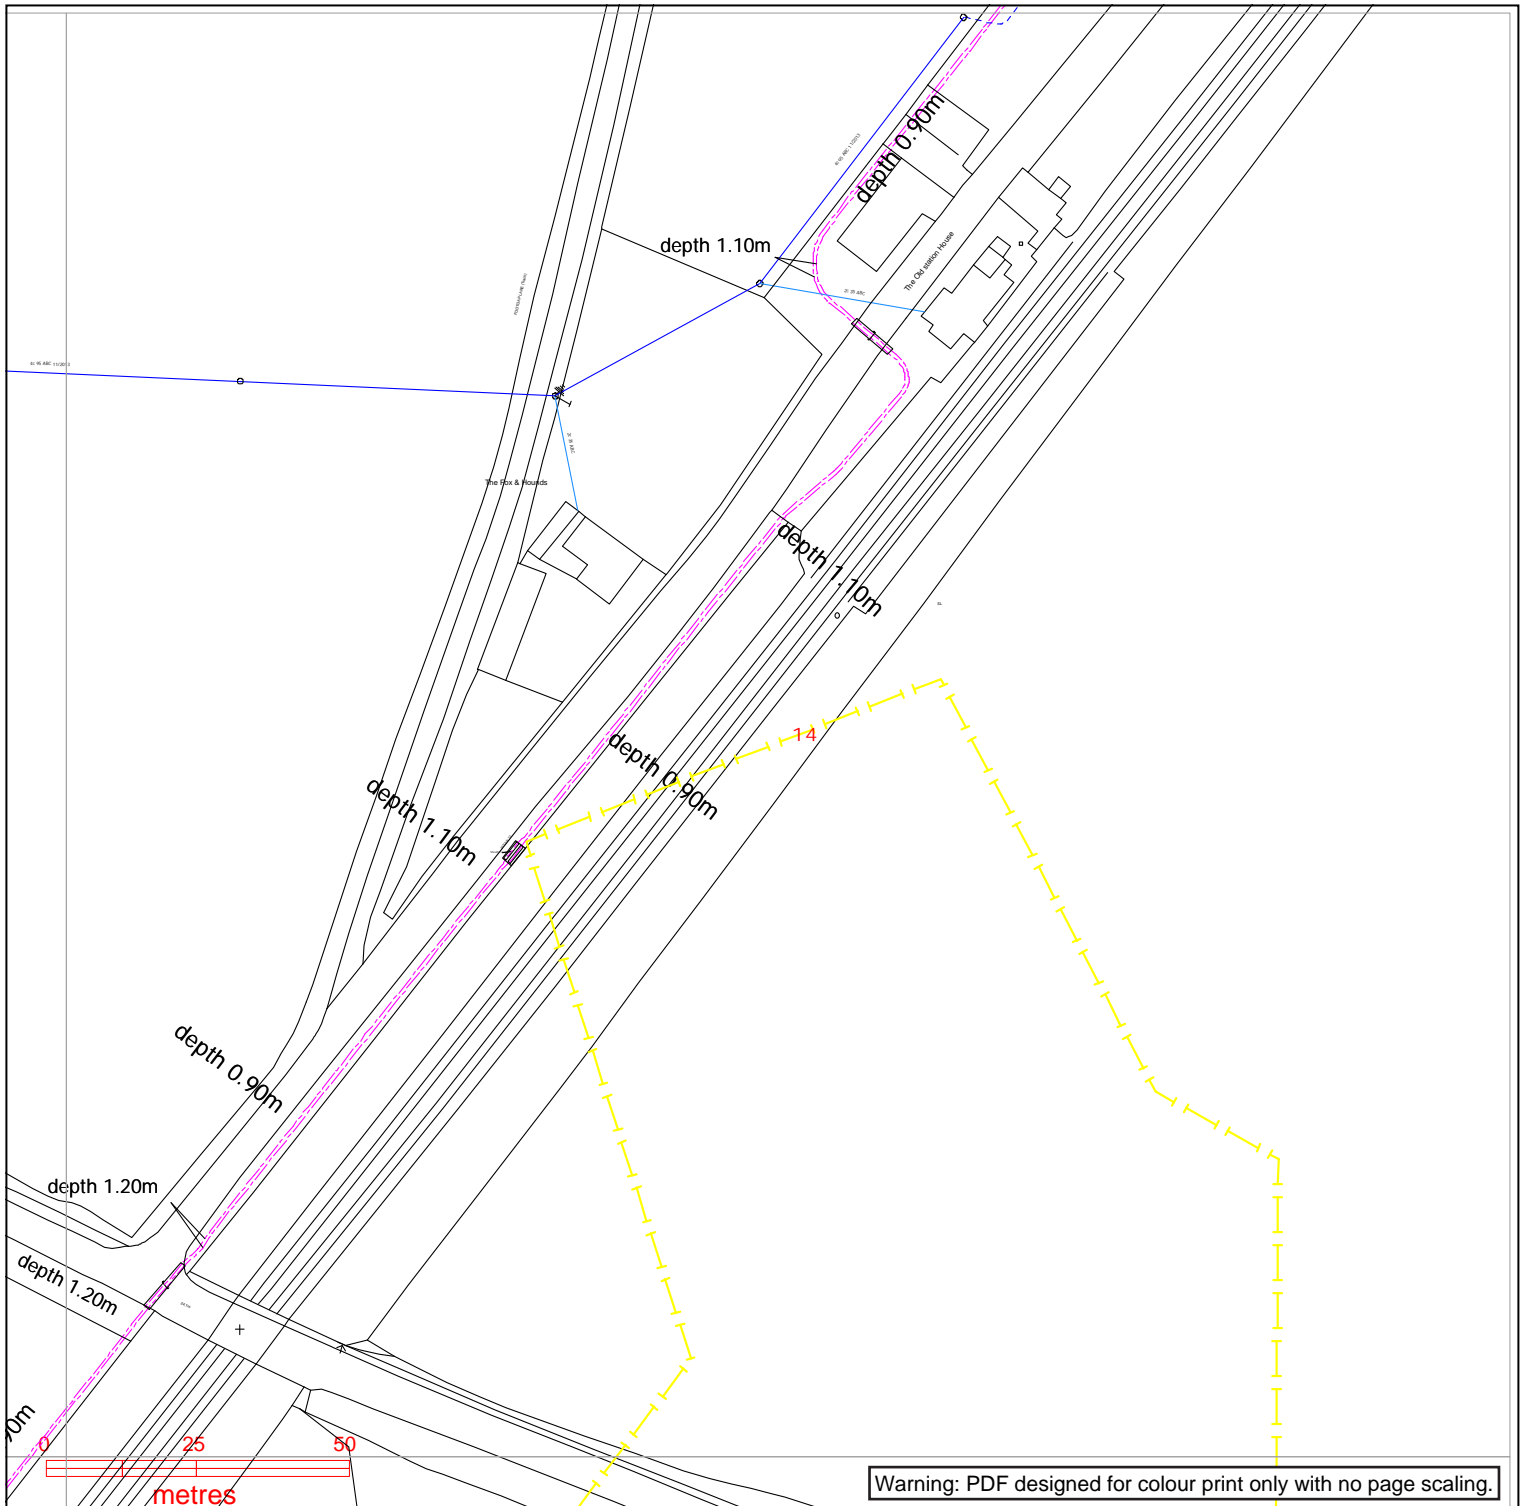

nationalgrid Electricity Distribution

Contact Us

Mapping Enquiries:
All areas 0121 623 9780

General Enquiries:
All areas 0800 096 3080

Date Requested: 08/05/2023
Job Reference: 29406949
Site Location: 477455 384776
Requested by:
Mr Ben Evans
Your Scheme/Reference:
LM 203570/DK - 11

Exact Scales:
1:1250 Area or Circle dig site
1:500 Line dig site


Link Box	Overhead Line	Underground Cable	National Grid Telecoms	Pilot Cables
●	○ PL ○ Service ○ LV ○ HV (11kV) ○ HV (33kV) ○ HV (66kV) ○ HV (132kV)	— —	— — — — — PME Earth — — — — — — — — — — Underground Earth	○ Pole Mounted Transformer □ Ground Mounted Transformer

IMPORTANT NOTICES

- This information is given as a guide only and its accuracy cannot be guaranteed. Services or recent additions to the network may not be shown.
- Cables, overhead lines & substations owned by other electricity network owners or private companies may be present and may not be shown.
- You should always verify exact locations of cables using a cable locator and by careful use of hand tools in accordance with HSE guidance note HSG47.
- When working within 10m of any overhead electric line you should follow the requirements of HSE Guidance Note GS6.
- For further advice on working near our electricity cables or lines, call our General Enquiries number.
- Advice should be sought from the National Grid Electricity Distribution General Enquiries team for any work that is to take place in proximity to 132kV underground cables and 132kV overhead lines.

Report damage immediately – KEEP EVERYONE AWAY FROM THE AREA
0800 6783 105

Crown Copyright © All Rights Reserved. Ordnance Survey Licence numbers: 100022432
NGED Copyright: This copy has been made by or with the authority of National Grid Electricity Distribution (NGED) pursuant to Section 47 of the Copyright Designs and Patents Act 1988 unless that Act provides a relevant exception to copyright the copy must not be copied without the prior permission of the copyright owner.

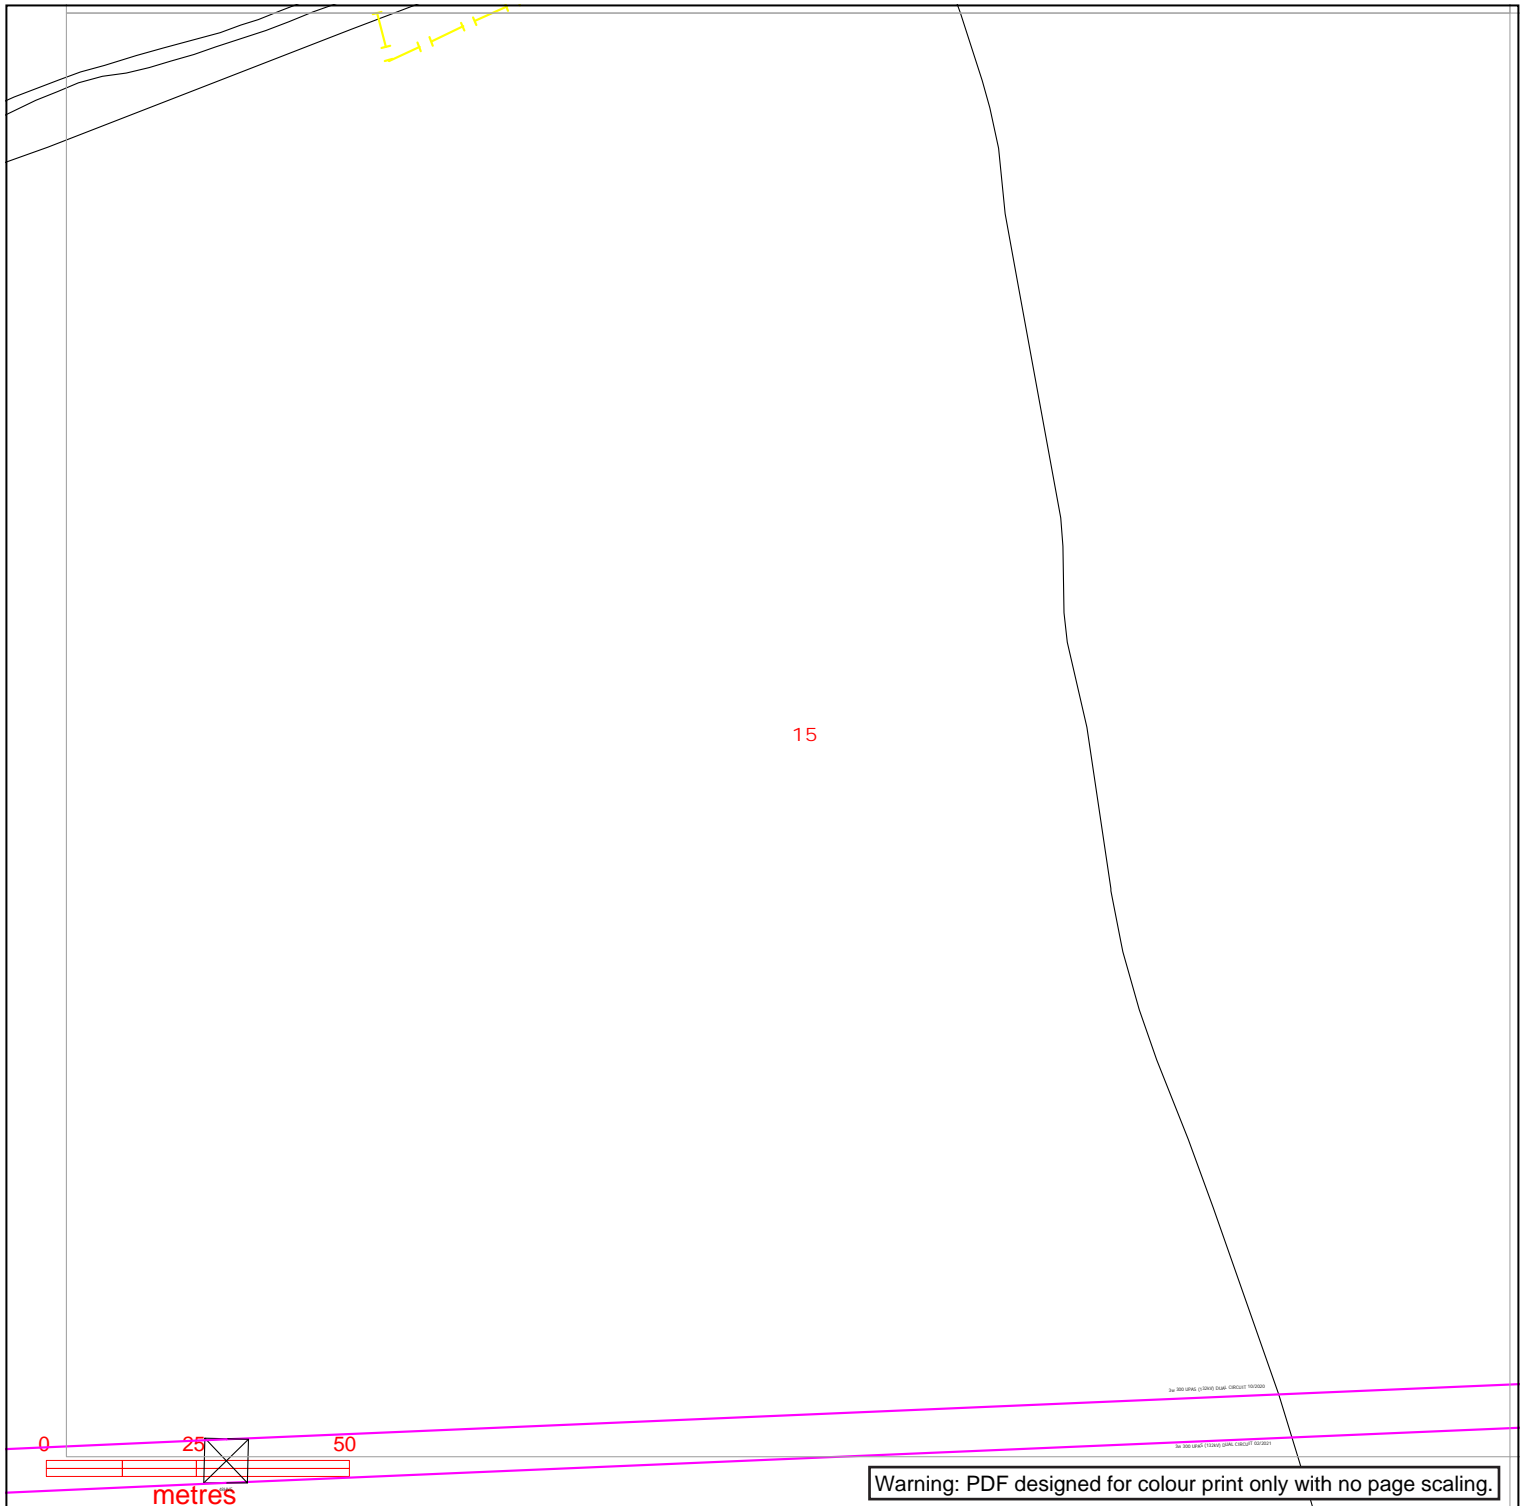

Warning: PDF designed for colour print only with no page scaling.

nationalgrid Electricity Distribution

Contact Us

Mapping Enquiries:
All areas 0121 623 9780

General Enquiries:
All areas 0800 096 3080

Date Requested: 08/05/2023
Job Reference: 29406949
Site Location: 477455 384776
Requested by:
Mr Ben Evans
Your Scheme/Reference:
LM 203570/DK - 11

Exact Scales:
1:1250 Area or Circle dig site
1:500 Line dig site


Link Box	Overhead Line	Underground Cable	National Grid Telecoms	Pilot Cables
●				
Site Location 	Line/Area 			

IMPORTANT NOTICES

- This information is given as a guide only and its accuracy cannot be guaranteed. Services or recent additions to the network may not be shown.
- Cables, overhead lines & substations owned by other electricity network owners or private companies may be present and may not be shown.
- You should always verify exact locations of cables using a cable locator and by careful use of hand tools in accordance with HSE guidance note HSG47.
- When working within 10m of any overhead electric line you should follow the requirements of HSE Guidance Note GS6.
- For further advice on working near our electricity cables or lines, call our General Enquiries number.
- Advice should be sought from the National Grid Electricity Distribution General Enquiries team for any work that is to take place in proximity to 132kV underground cables and 132kV overhead lines.

Report damage immediately – KEEP EVERYONE AWAY FROM THE AREA
0800 6783 105

Crown Copyright © All Rights Reserved. Ordnance Survey Licence numbers: 100022432
NGED Copyright: This copy has been made by or with the authority of National Grid Electricity Distribution (NGED) pursuant to Section 47 of the Copyright Designs and Patents Act 1988 unless that Act provides a relevant exception to copyright the copy must not be copied without the prior permission of the copyright owner.

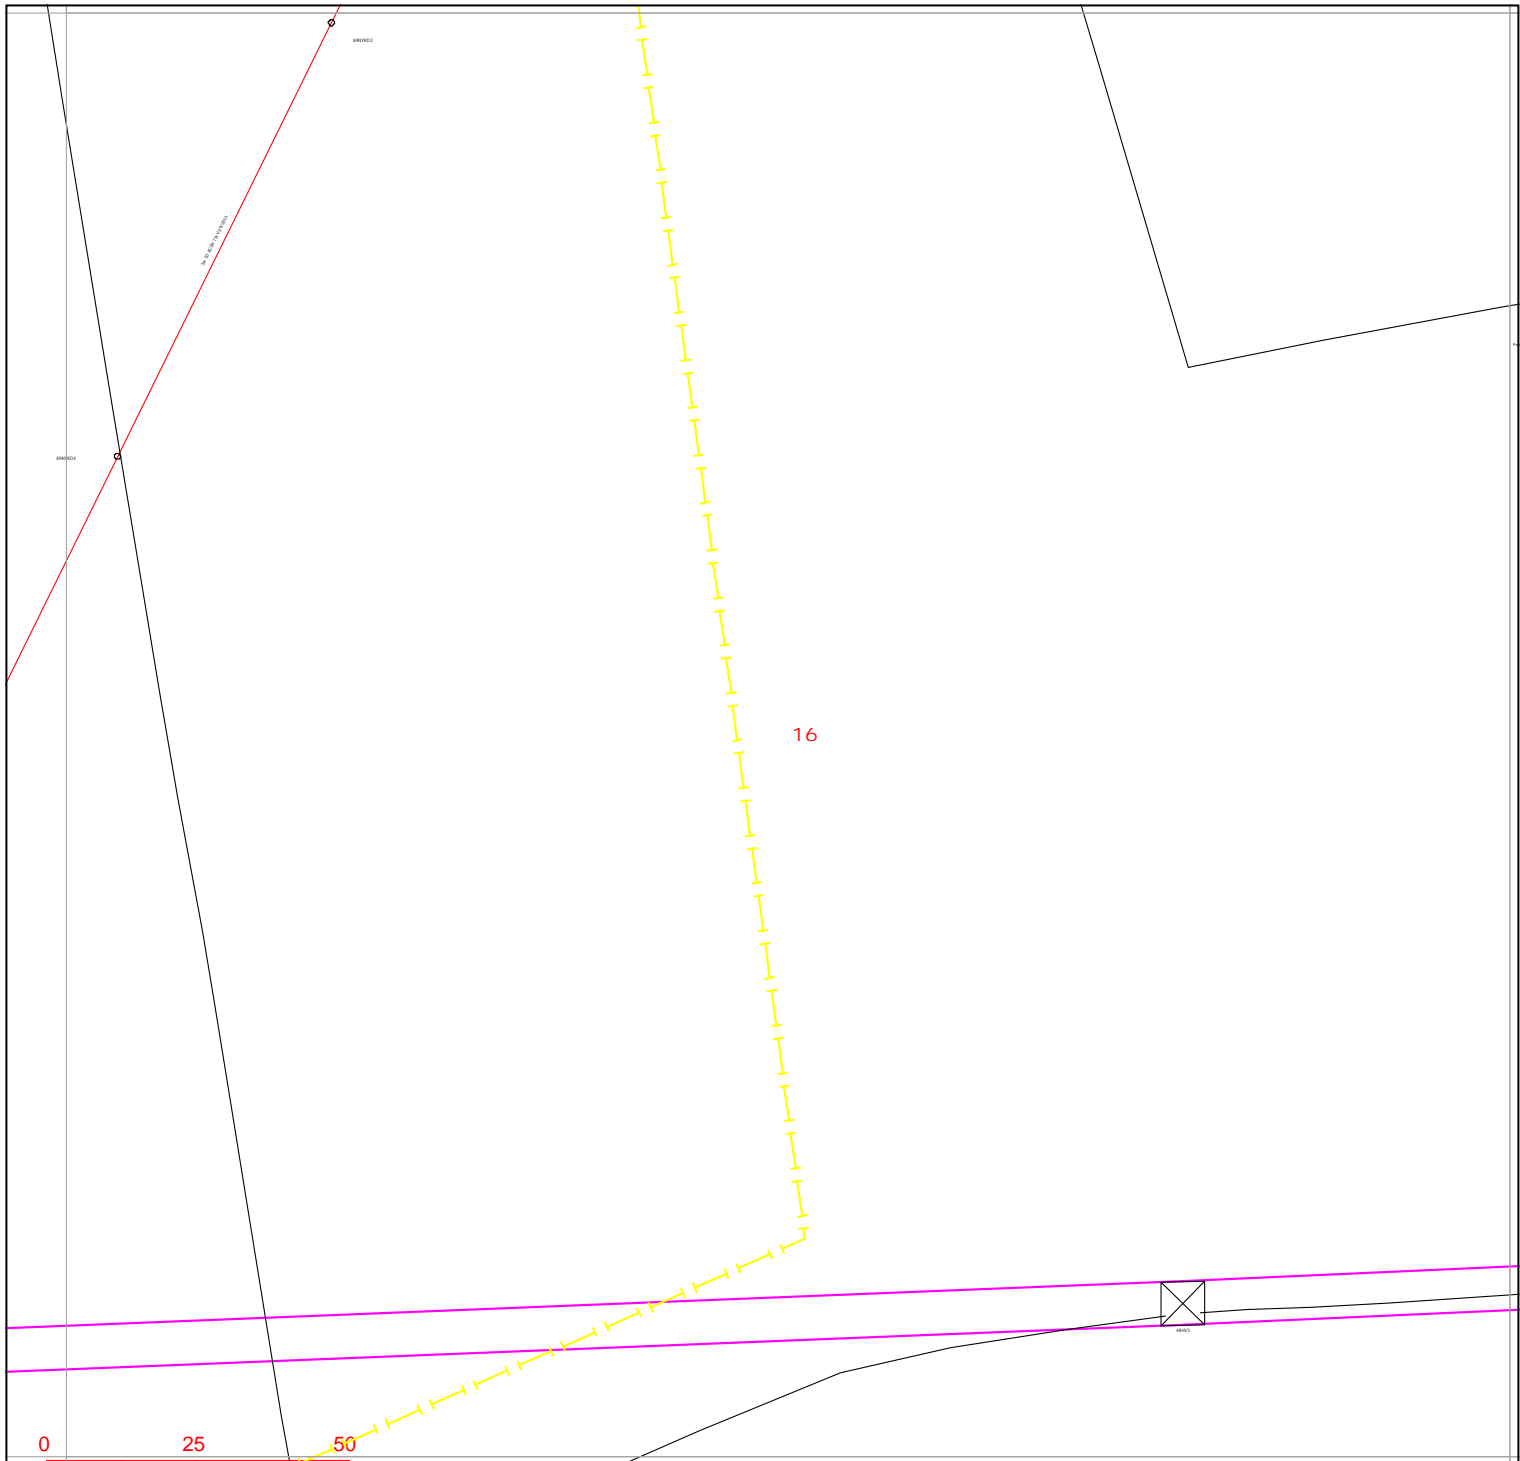

nationalgrid Electricity Distribution

Contact Us

Mapping Enquiries:
All areas 0121 623 9780

General Enquiries:
All areas 0800 096 3080

Date Requested: 08/05/2023
Job Reference: 29406949
Site Location: 477455 384776
Requested by:
Mr Ben Evans
Your Scheme/Reference:
LM 203570/DK - 11

Exact Scales:
1:1250 Area or Circle dig site
1:500 Line dig site


Link Box ●	Overhead Line ○—○ PL ○—○ Service ○—○ LV ○—○ HV (11kV) ○—○ HV (33kV) ○—○ HV (66kV) ○—○ HV (132kV)	Underground Cable -	National Grid Telecoms - - - - - PME Earth Underground Earth	Pilot Cables ○ □ Pole Mounted Transformer Ground Mounted Transformer
----------------------	--	---	--	---

IMPORTANT NOTICES

- This information is given as a guide only and its accuracy cannot be guaranteed. Services or recent additions to the network may not be shown.
- Cables, overhead lines & substations owned by other electricity network owners or private companies may be present and may not be shown.
- You should always verify exact locations of cables using a cable locator and by careful use of hand tools in accordance with HSE guidance note HSG47.
- When working within 10m of any overhead electric line you should follow the requirements of HSE Guidance Note GS6.
- For further advice on working near our electricity cables or lines, call our General Enquiries number.
- Advice should be sought from the National Grid Electricity Distribution General Enquiries team for any work that is to take place in proximity to 132kV underground cables and 132kV overhead lines.

Report damage immediately – KEEP EVERYONE AWAY FROM THE AREA
0800 6783 105

Crown Copyright © All Rights Reserved. Ordnance Survey Licence numbers: 100022432
NGED Copyright: This copy has been made by or with the authority of National Grid Electricity Distribution (NGED) pursuant to Section 47 of the Copyright Designs and Patents Act 1988 unless that Act provides a relevant exception to copyright the copy must not be copied without the prior permission of the copyright owner.

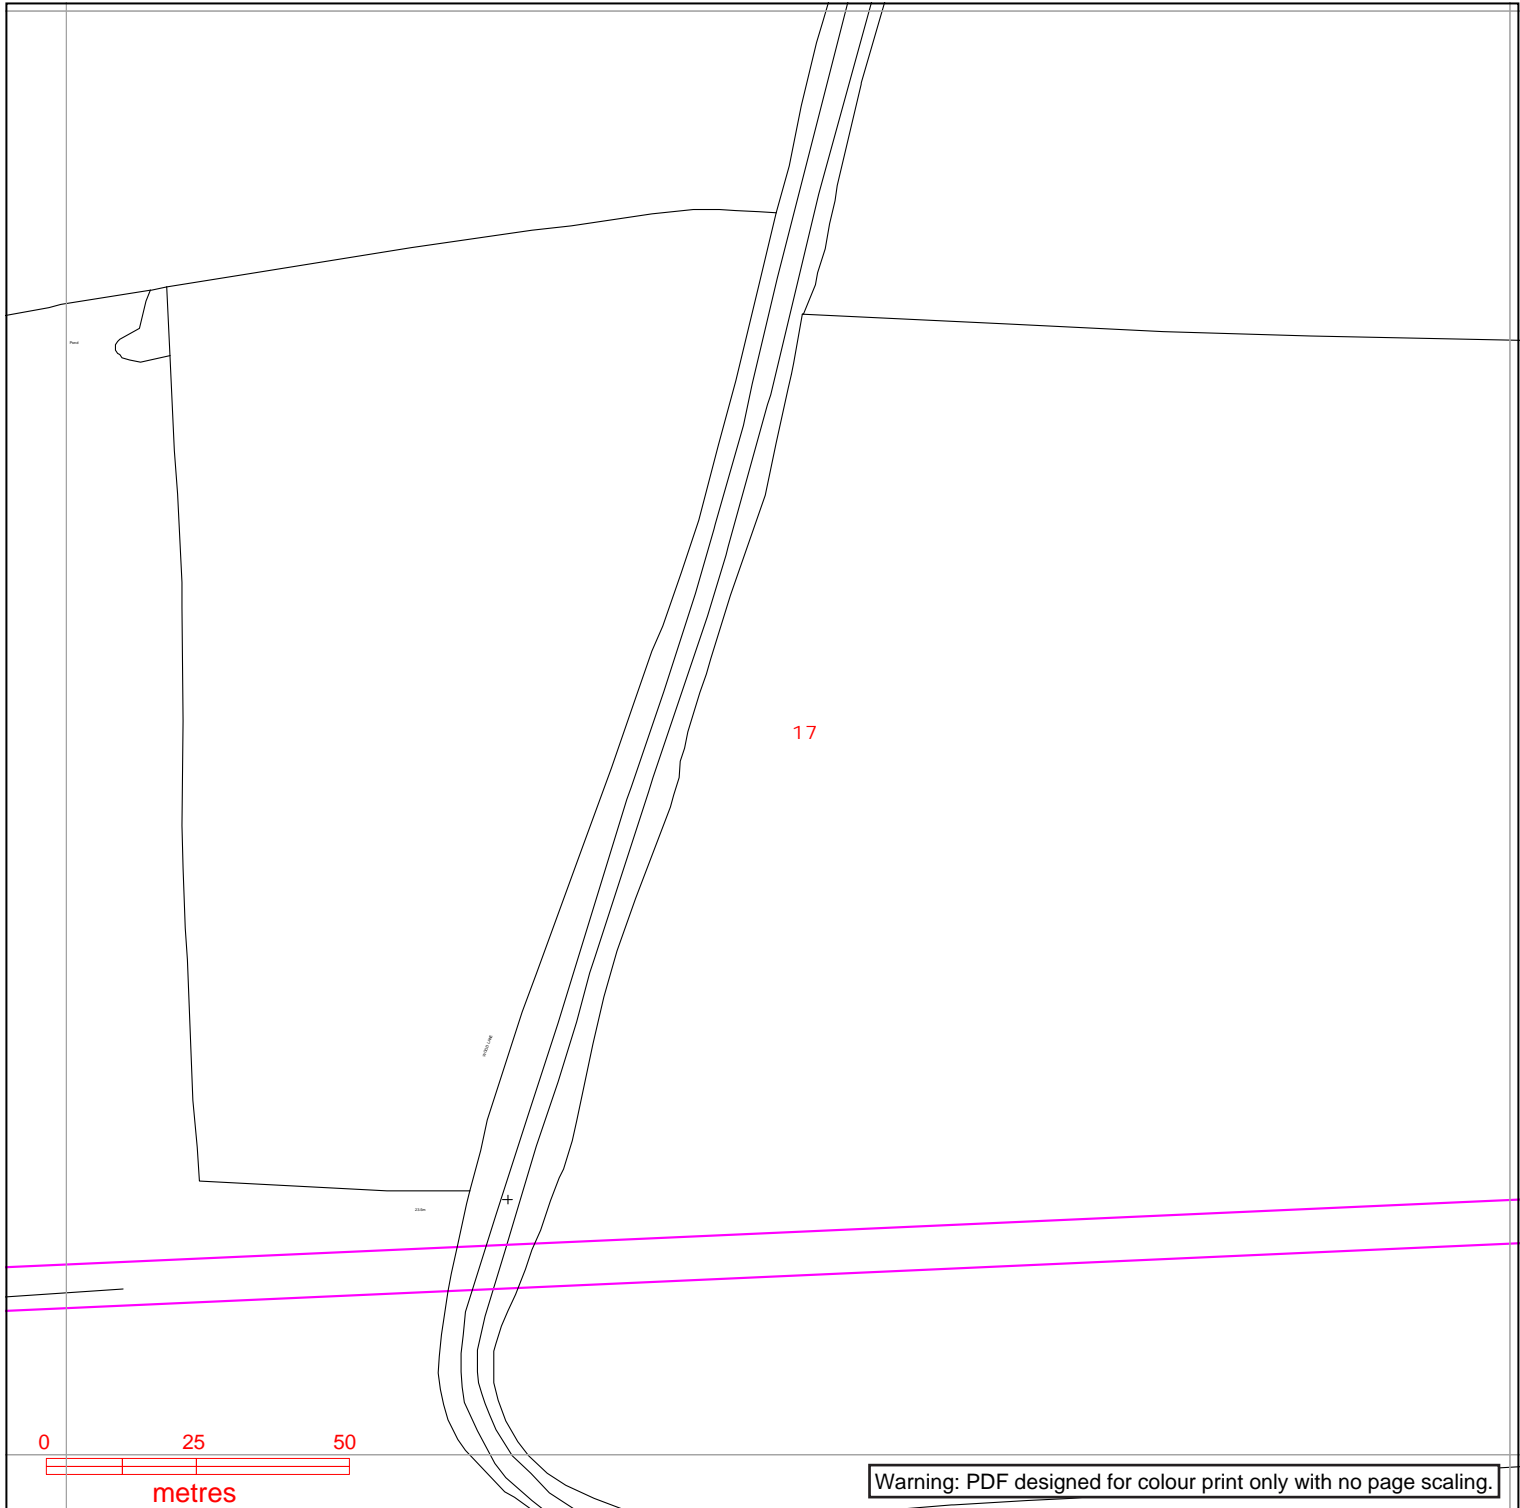

nationalgrid Electricity Distribution


Contact Us

Mapping Enquiries:
All areas 0121 623 9780

General Enquiries:
All areas 0800 096 3080

Date Requested: 08/05/2023
Job Reference: 29406949
Site Location: 477455 384776
Requested by:
Mr Ben Evans
Your Scheme/Reference:
LM 203570/DK - 11

Exact Scales:
1:1250 Area or Circle dig site
1:500 Line dig site

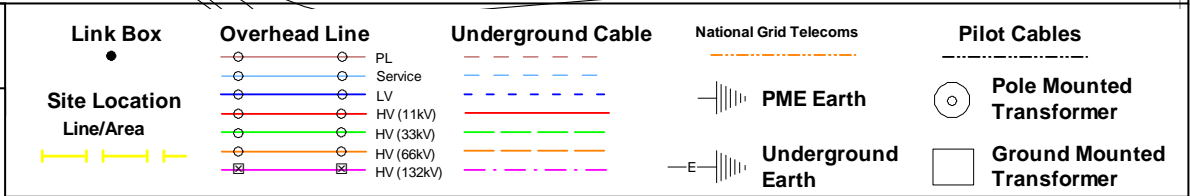


IMPORTANT NOTICES

- This information is given as a guide only and its accuracy cannot be guaranteed. Services or recent additions to the network may not be shown.
- Cables, overhead lines & substations owned by other electricity network owners or private companies may be present and may not be shown.
- You should always verify exact locations of cables using a cable locator and by careful use of hand tools in accordance with HSE guidance note HSG47.
- When working within 10m of any overhead electric line you should follow the requirements of HSE Guidance Note GS6.
- For further advice on working near our electricity cables or lines, call our General Enquiries number.
- Advice should be sought from the National Grid Electricity Distribution General Enquiries team for any work that is to take place in proximity to 132kV underground cables and 132kV overhead lines.

Report damage immediately – KEEP EVERYONE AWAY FROM THE AREA
0800 6783 105

Crown Copyright © All Rights Reserved. Ordnance Survey Licence numbers: 100022432
NGED Copyright: This copy has been made by or with the authority of National Grid Electricity Distribution (NGED) pursuant to Section 47 of the Copyright Designs and Patents Act 1988 unless that Act provides a relevant exception to copyright the copy must not be copied without the prior permission of the copyright owner.

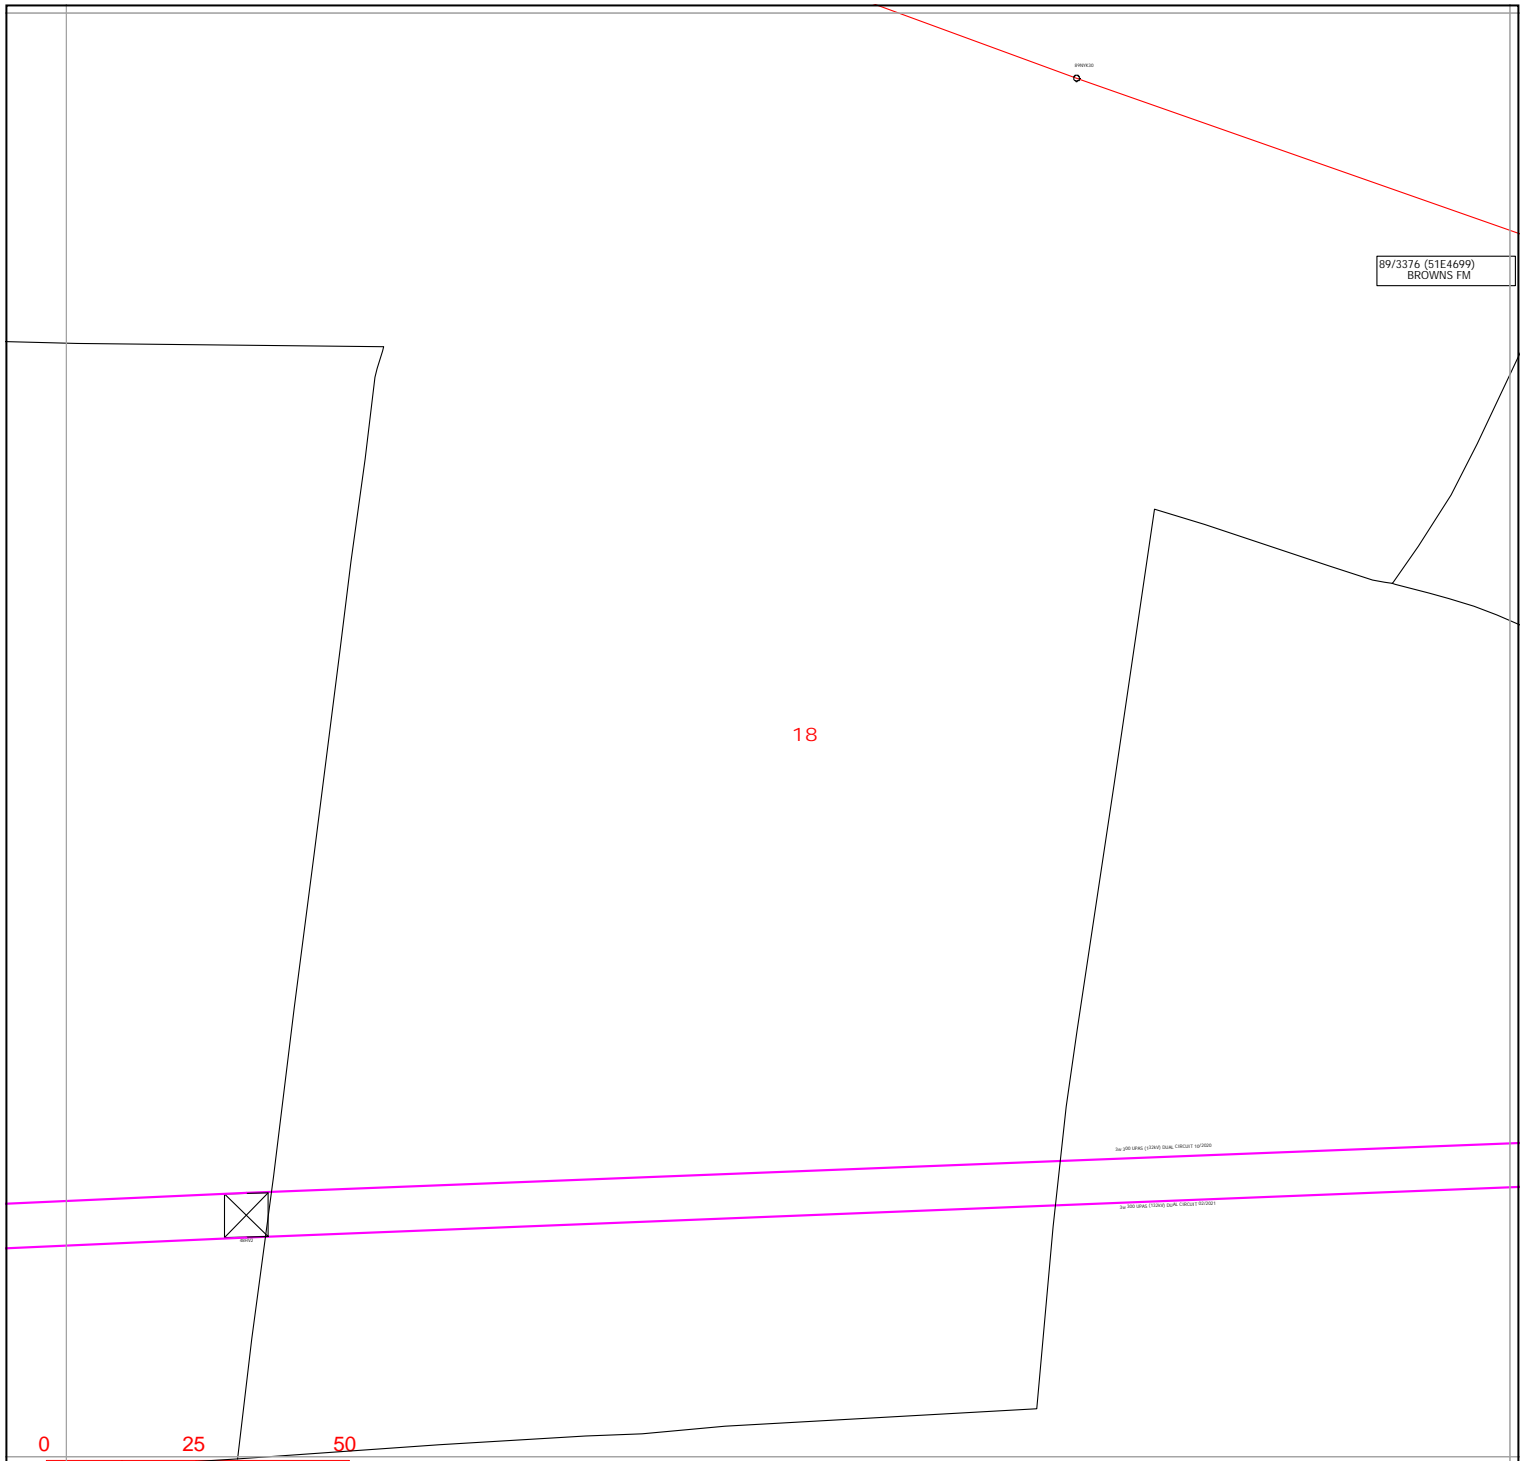

Warning: PDF designed for colour print only with no page scaling.

nationalgrid Electricity Distribution

Contact Us

Mapping Enquiries:
All areas 0121 623 9780

General Enquiries:
All areas 0800 096 3080

Date Requested: 08/05/2023
Job Reference: 29406949
Site Location: 477455 384776
Requested by:
Mr Ben Evans
Your Scheme/Reference:
LM 203570/DK - 11

Exact Scales:
1:1250 Area or Circle dig site
1:500 Line dig site


Link Box	Overhead Line	Underground Cable	National Grid Telecoms	Pilot Cables
●	<ul style="list-style-type: none"> ○ PL ○ Service ○ LV ○ HV (11kV) ○ HV (33kV) ○ HV (66kV) ○ HV (132kV) 	<ul style="list-style-type: none"> --- --- --- --- --- --- --- 	<ul style="list-style-type: none"> --- PME Earth ---E Underground Earth 	<ul style="list-style-type: none"> ○ Pole Mounted Transformer □ Ground Mounted Transformer
<ul style="list-style-type: none"> Site Location Line/Area 	<ul style="list-style-type: none"> --- --- --- --- --- --- --- 			

IMPORTANT NOTICES

- This information is given as a guide only and its accuracy cannot be guaranteed. Services or recent additions to the network may not be shown.
- Cables, overhead lines & substations owned by other electricity network owners or private companies may be present and may not be shown.
- You should always verify exact locations of cables using a cable locator and by careful use of hand tools in accordance with HSE guidance note HSG47.
- When working within 10m of any overhead electric line you should follow the requirements of HSE Guidance Note GS6.
- For further advice on working near our electricity cables or lines, call our General Enquiries number.
- Advice should be sought from the National Grid Electricity Distribution General Enquiries team for any work that is to take place in proximity to 132kV underground cables and 132kV overhead lines.

Report damage immediately – KEEP EVERYONE AWAY FROM THE AREA
0800 6783 105

Crown Copyright © All Rights Reserved. Ordnance Survey Licence numbers: 100022432
NGED Copyright: This copy has been made by or with the authority of National Grid Electricity Distribution (NGED) pursuant to Section 47 of the Copyright Designs and Patents Act 1988 unless that Act provides a relevant exception to copyright the copy must not be copied without the prior permission of the copyright owner.

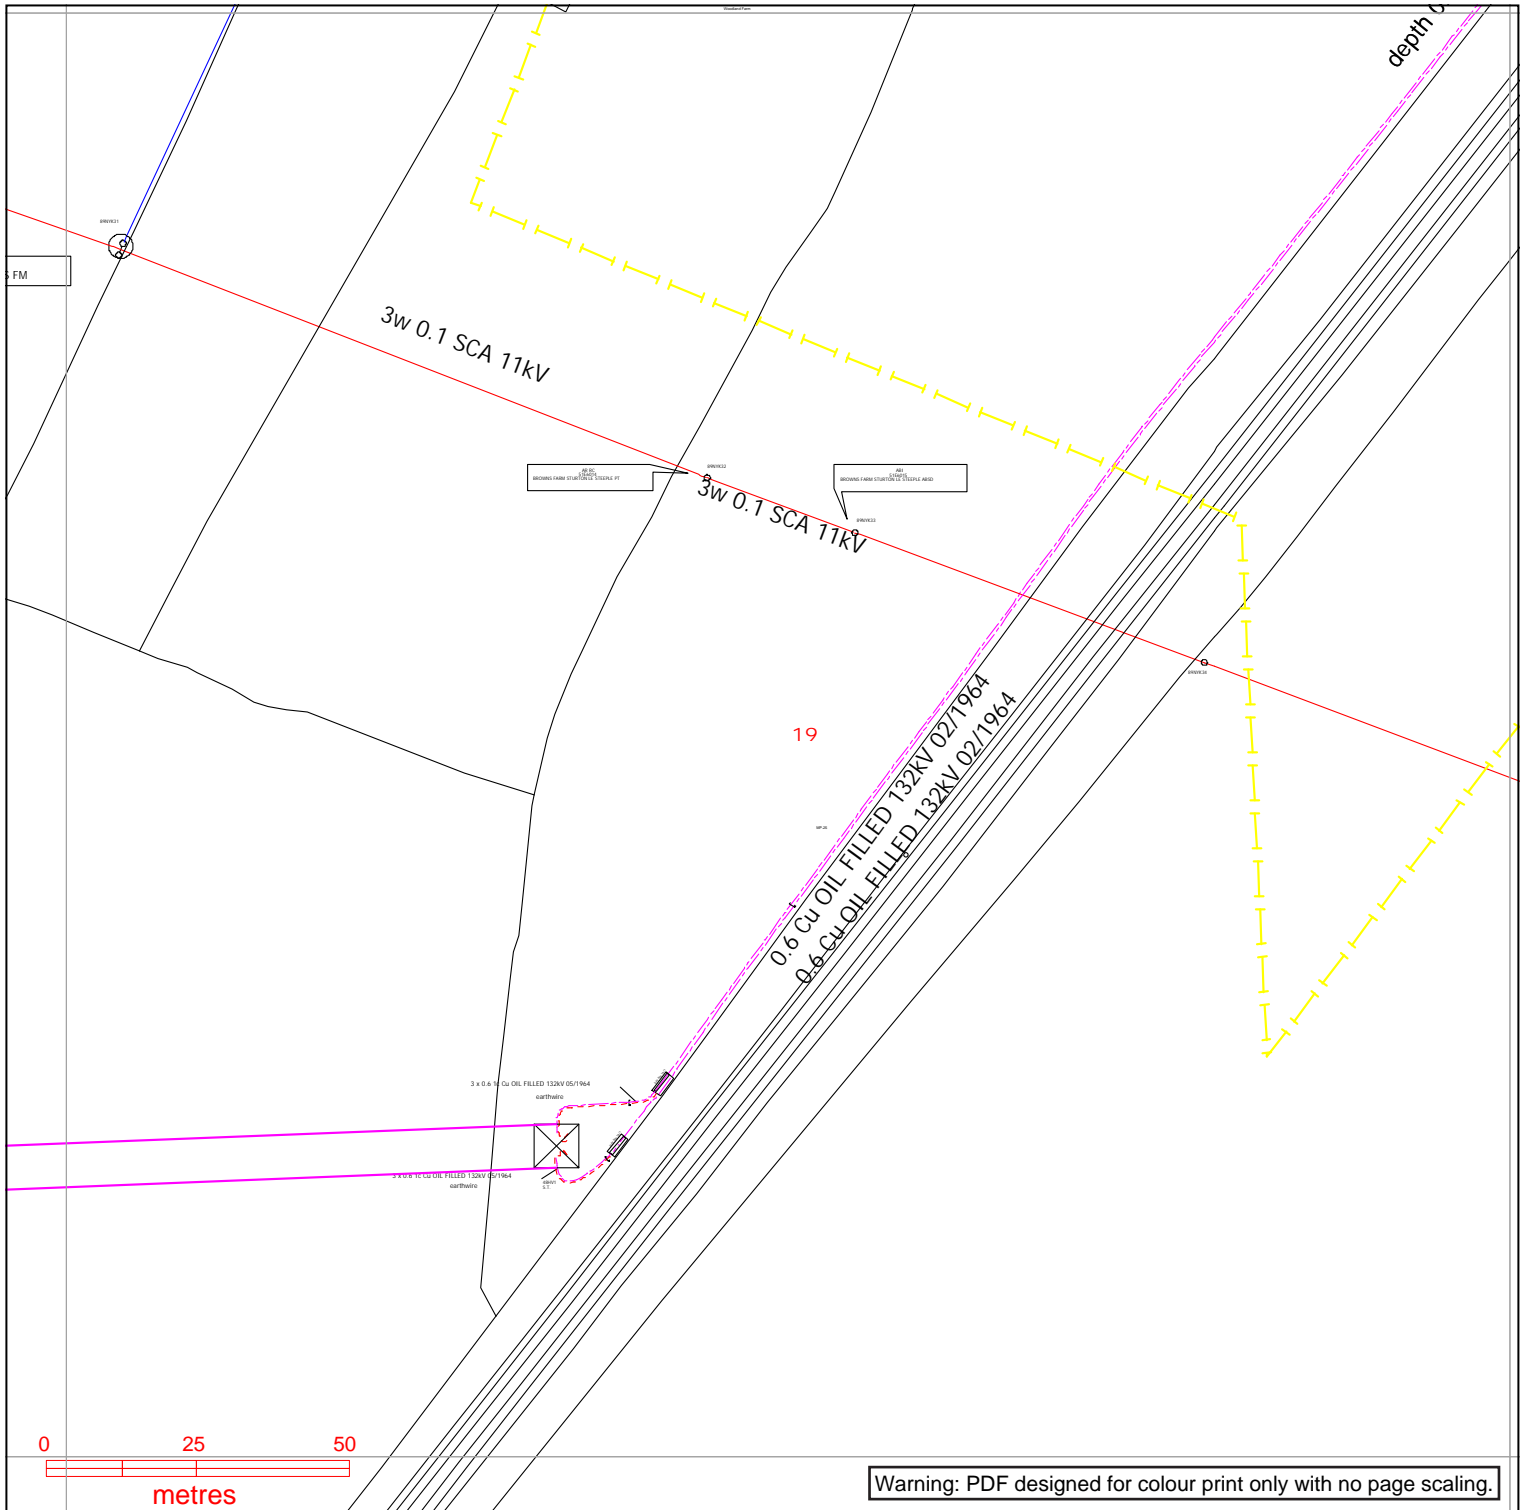

nationalgrid Electricity Distribution

Contact Us

Mapping Enquiries:
All areas 0121 623 9780

General Enquiries:
All areas 0800 096 3080

Date Requested: 08/05/2023
Job Reference: 29406949
Site Location: 477455 384776
Requested by:
Mr Ben Evans
Your Scheme/Reference:
LM 203570/DK - 11

Exact Scales:
1:1250 Area or Circle dig site
1:500 Line dig site


Link Box	Overhead Line	Underground Cable	National Grid Telecoms	Pilot Cables
●	○ PL ○ Service ○ LV ○ HV (11kV) ○ HV (33kV) ○ HV (66kV) ○ HV (132kV)	---	---	○
■	■	---	⏏ PME Earth ⏏ Underground Earth	□ Pole Mounted Transformer □ Ground Mounted Transformer

IMPORTANT NOTICES


- This information is given as a guide only and its accuracy cannot be guaranteed. Services or recent additions to the network may not be shown.
- Cables, overhead lines & substations owned by other electricity network owners or private companies may be present and may not be shown.
- You should always verify exact locations of cables using a cable locator and by careful use of hand tools in accordance with HSE guidance note HSG47.
- When working within 10m of any overhead electric line you should follow the requirements of HSE Guidance Note GS6.
- For further advice on working near our electricity cables or lines, call our General Enquiries number.
- Advice should be sought from the National Grid Electricity Distribution General Enquiries team for any work that is to take place in proximity to 132kV underground cables and 132kV overhead lines.

Report damage immediately – KEEP EVERYONE AWAY FROM THE AREA
0800 6783 105

Crown Copyright © All Rights Reserved. Ordnance Survey Licence numbers: 100022432
NGED Copyright: This copy has been made by or with the authority of National Grid Electricity Distribution (NGED) pursuant to Section 47 of the Copyright Designs and Patents Act 1988 unless that Act provides a relevant exception to copyright the copy must not be copied without the prior permission of the copyright owner.

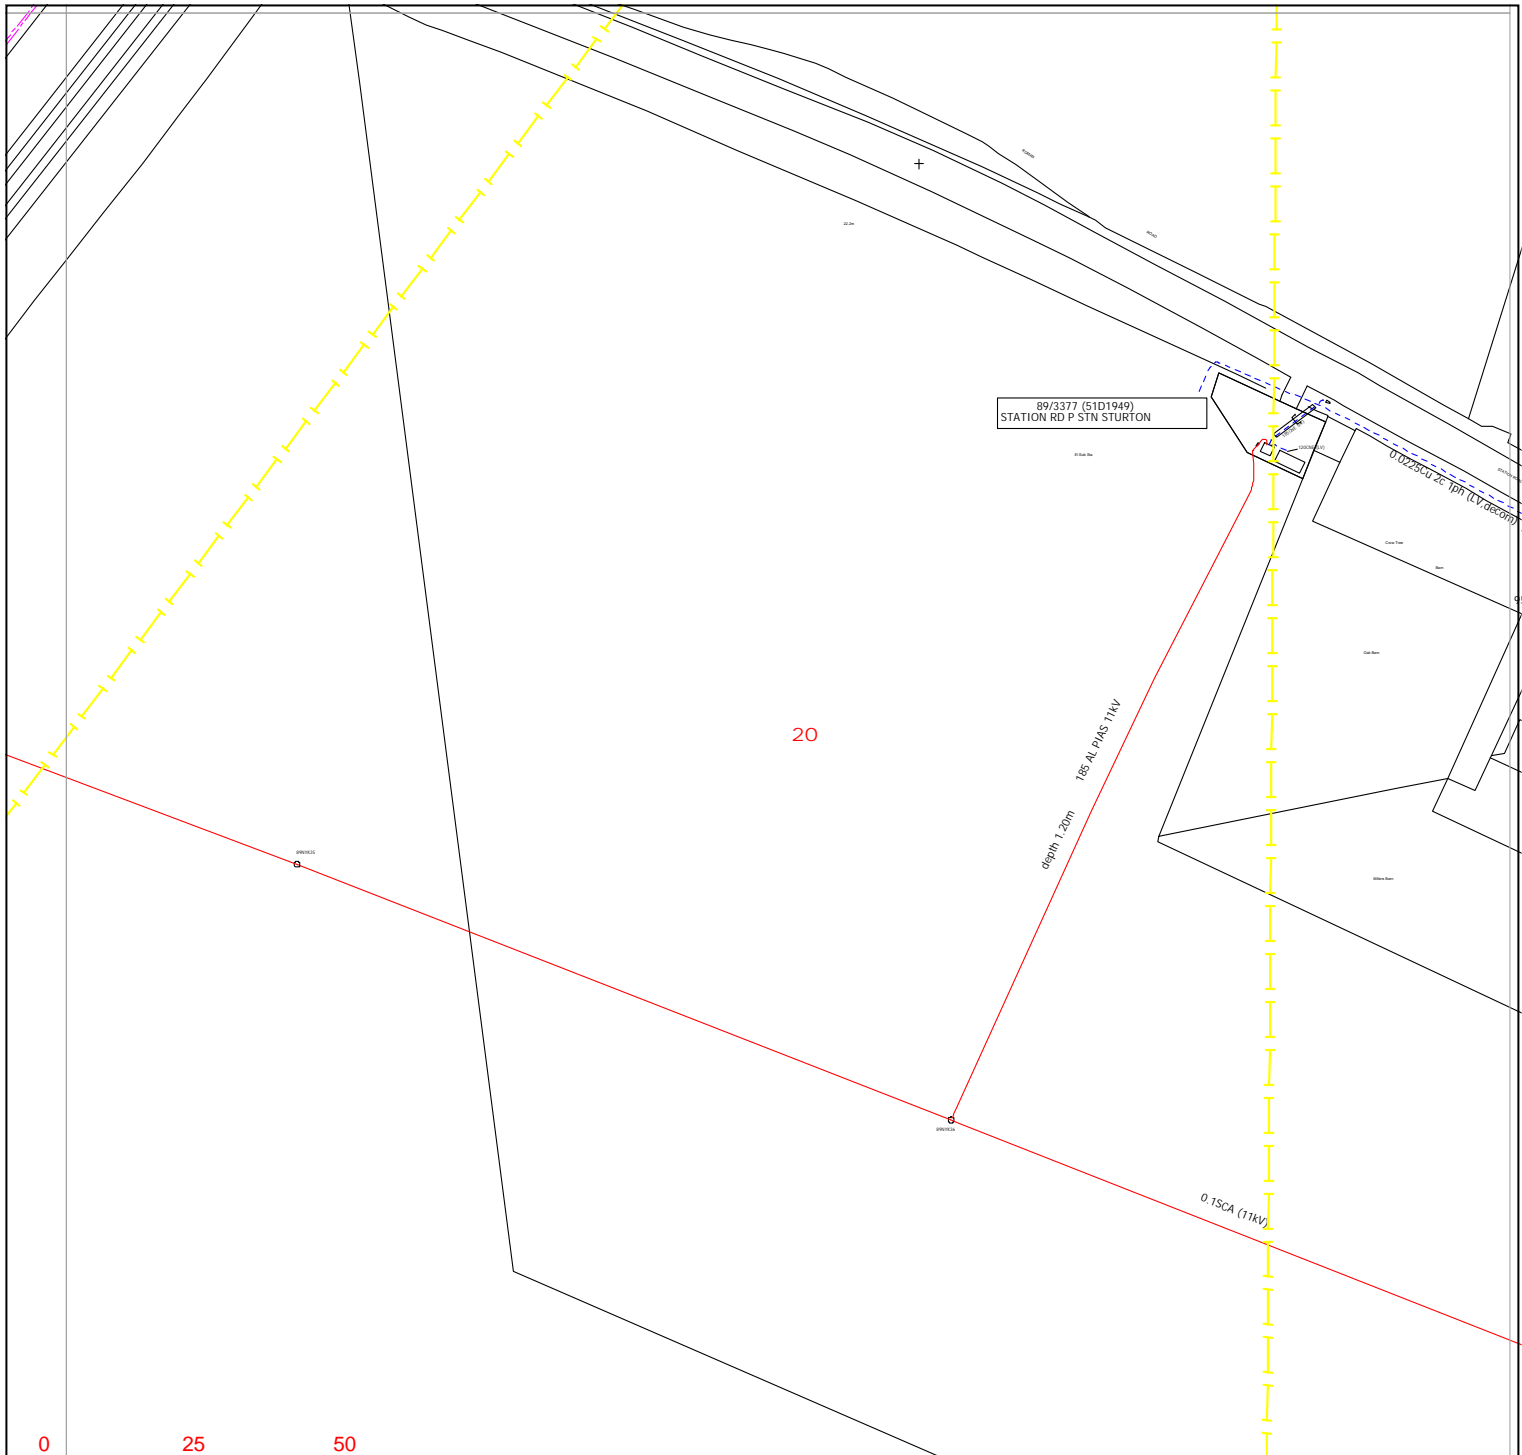

	Warning: PDF designed for colour print only with no page scaling.				
Contact Us	Link Box 	Overhead Line 	Underground Cable 	National Grid Telecoms 	Pilot Cables
Mapping Enquiries: All areas 0121 623 9780	Site Location Line/Area 				
General Enquiries: All areas 0800 096 3080	IMPORTANT NOTICES <ul style="list-style-type: none"> This information is given as a guide only and its accuracy cannot be guaranteed. Services or recent additions to the network may not be shown. Cables, overhead lines & substations owned by other electricity network owners or private companies may be present and may not be shown. You should always verify exact locations of cables using a cable locator and by careful use of hand tools in accordance with HSE guidance note HSG47. When working within 10m of any overhead electric line you should follow the requirements of HSE Guidance Note GS6. For further advice on working near our electricity cables or lines, call our General Enquiries number. Advice should be sought from the National Grid Electricity Distribution General Enquiries team for any work that is to take place in proximity to 132kV underground cables and 132kV overhead lines. 				
Date Requested: 08/05/2023 Job Reference: 29406949 Site Location: 477455 384776 Requested by: Mr Ben Evans Your Scheme/Reference: LM 203570/DK - 11	Report damage immediately – KEEP EVERYONE AWAY FROM THE AREA 0800 6783 105				
Exact Scales: 1:1250 Area or Circle dig site 1:500 Line dig site	Crown Copyright © All Rights Reserved. Ordnance Survey Licence numbers: 100022432 NGED Copyright: This copy has been made by or with the authority of National Grid Electricity Distribution (NGED) pursuant to Section 47 of the Copyright Designs and Patents Act 1988 unless that Act provides a relevant exception to copyright the copy must not be copied without the prior permission of the copyright owner.				

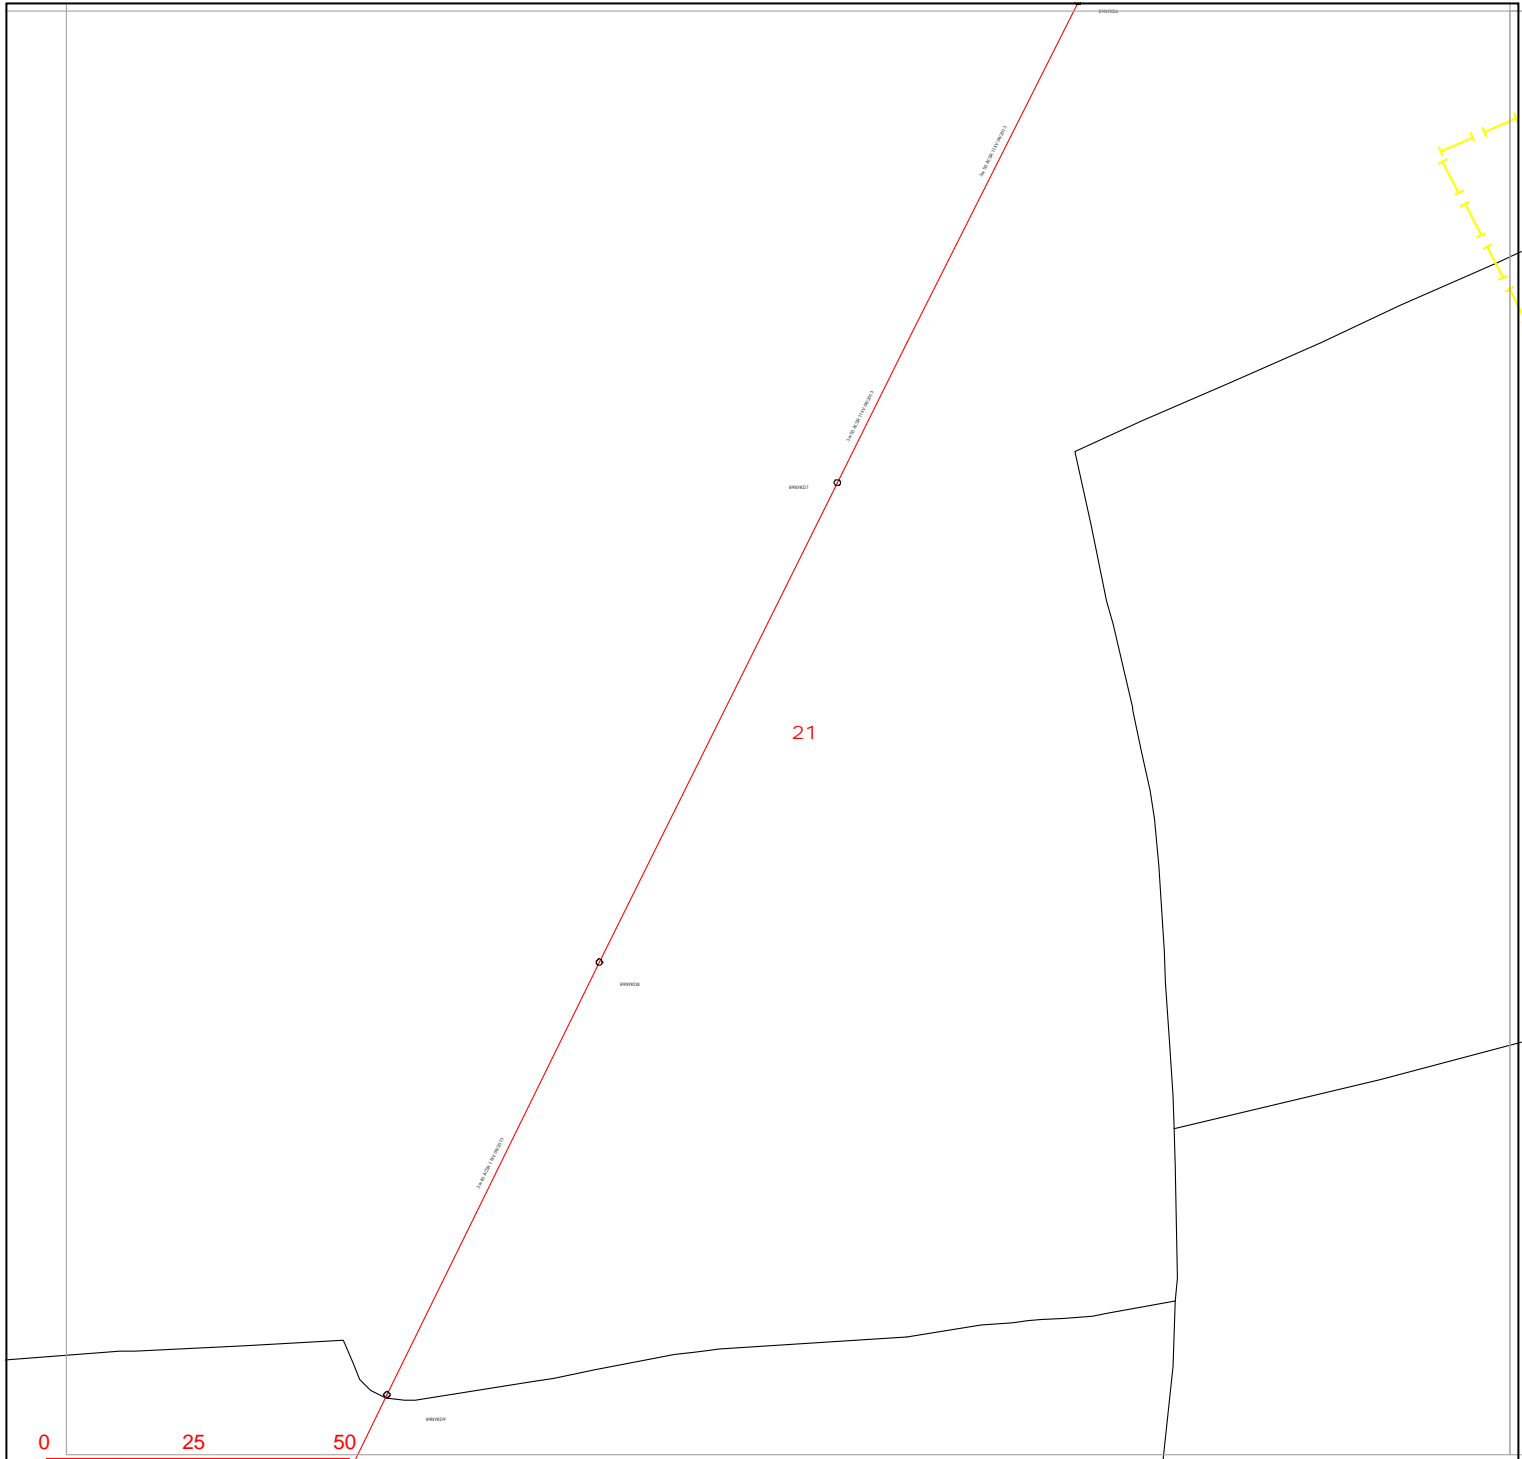

Warning: PDF designed for colour print only with no page scaling.

nationalgrid Electricity Distribution

Contact Us

Mapping Enquiries:
All areas 0121 623 9780

General Enquiries:
All areas 0800 096 3080

Date Requested: 08/05/2023
Job Reference: 29406949
Site Location: 477455 384776
Requested by:
Mr Ben Evans
Your Scheme/Reference:
LM 203570/DK - 11

Exact Scales:
1:1250 Area or Circle dig site
1:500 Line dig site


Link Box	Overhead Line	Underground Cable	National Grid Telecoms	Pilot Cables
●	○ PL ○ Service ○ LV ○ HV (11kV) ○ HV (33kV) ○ HV (66kV) ○ HV (132kV)	---	--- PME Earth ---E Underground Earth	○ Pole Mounted Transformer □ Ground Mounted Transformer
Site Location Line/Area	--- --- --- --- --- ---	---		

IMPORTANT NOTICES

- This information is given as a guide only and its accuracy cannot be guaranteed. Services or recent additions to the network may not be shown.
- Cables, overhead lines & substations owned by other electricity network owners or private companies may be present and may not be shown.
- You should always verify exact locations of cables using a cable locator and by careful use of hand tools in accordance with HSE guidance note HSG47.
- When working within 10m of any overhead electric line you should follow the requirements of HSE Guidance Note GS6.
- For further advice on working near our electricity cables or lines, call our General Enquiries number.
- Advice should be sought from the National Grid Electricity Distribution General Enquiries team for any work that is to take place in proximity to 132kV underground cables and 132kV overhead lines.

Report damage immediately – KEEP EVERYONE AWAY FROM THE AREA
0800 6783 105

Crown Copyright © All Rights Reserved. Ordnance Survey Licence numbers: 100022432
NGED Copyright: This copy has been made by or with the authority of National Grid Electricity Distribution (NGED) pursuant to Section 47 of the Copyright Designs and Patents Act 1988 unless that Act provides a relevant exception to copyright the copy must not be copied without the prior permission of the copyright owner.

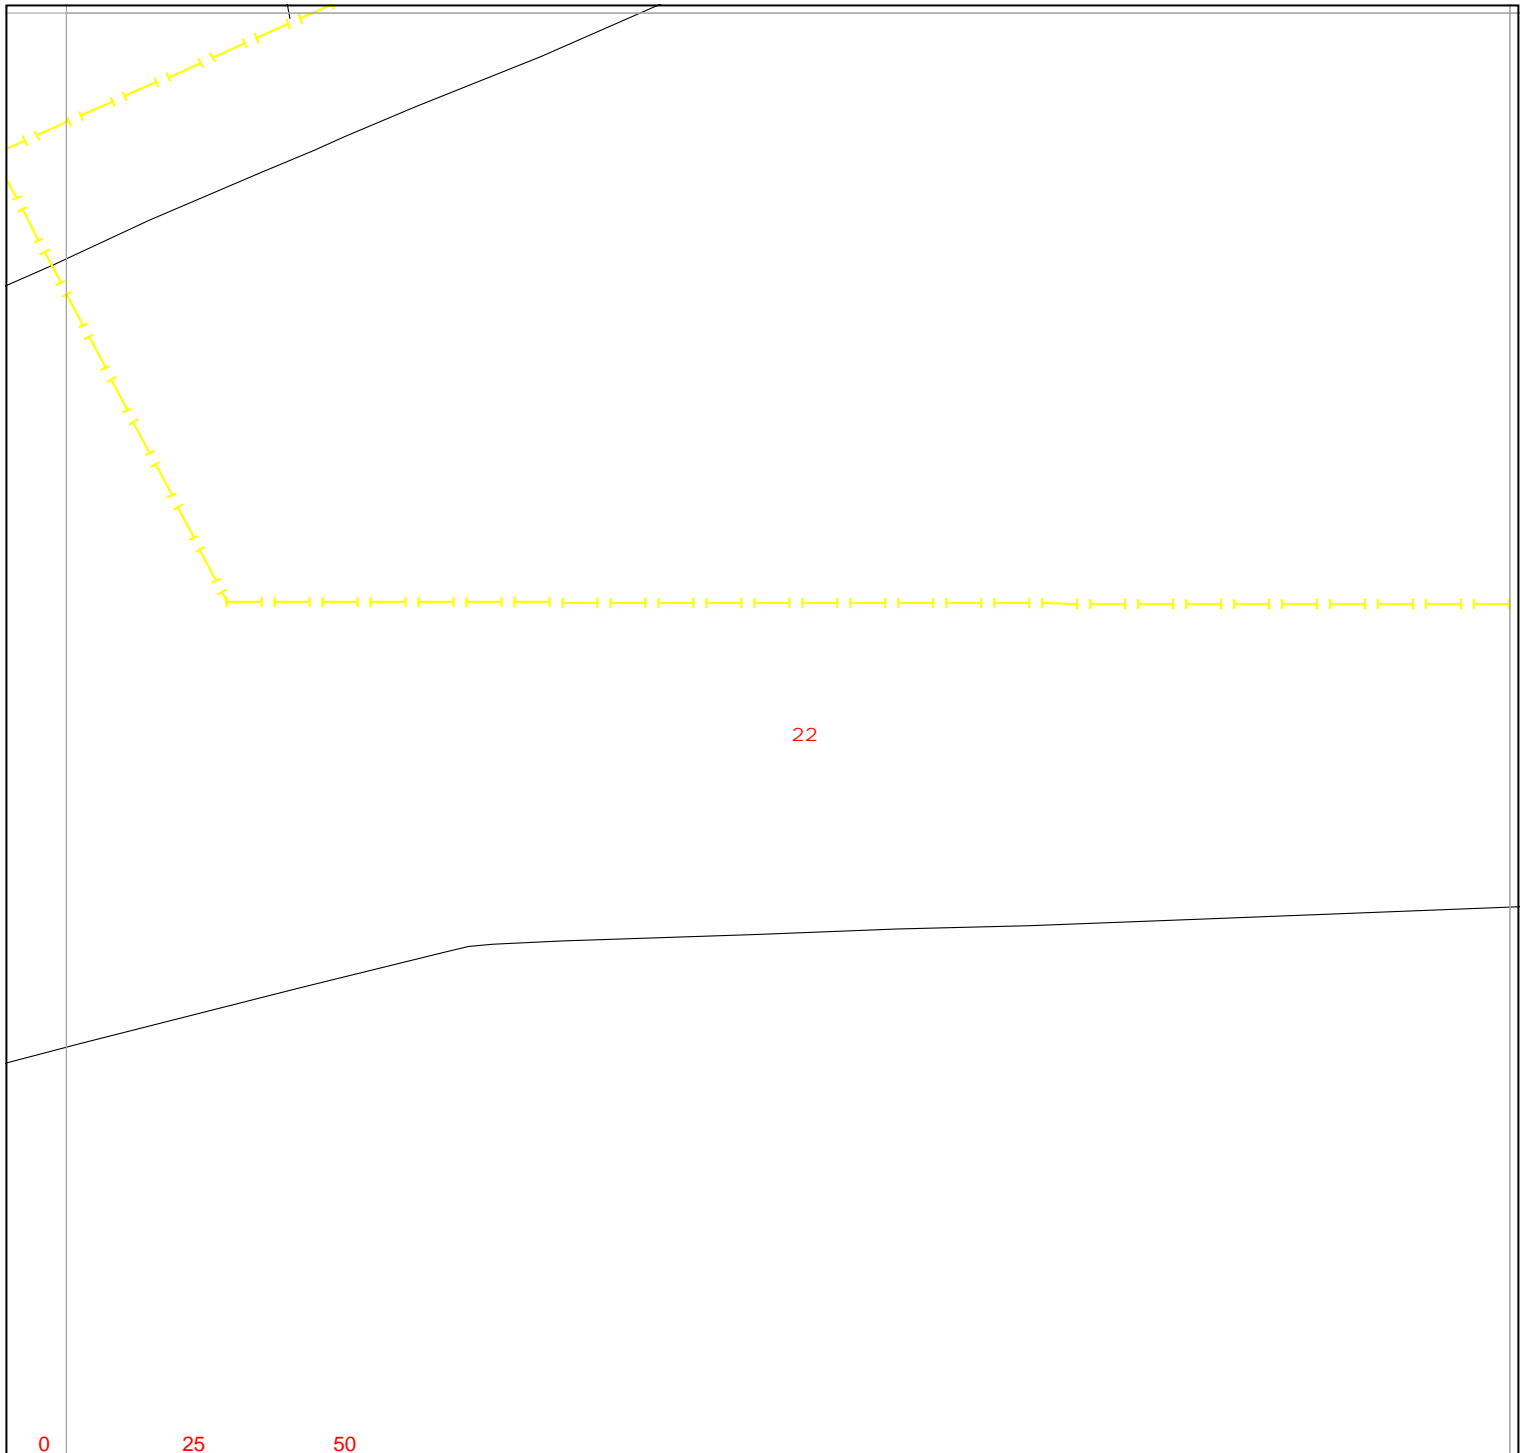

Warning: PDF designed for colour print only with no page scaling.

nationalgrid Electricity Distribution

Contact Us

Mapping Enquiries:
All areas 0121 623 9780

General Enquiries:
All areas 0800 096 3080

Date Requested: 08/05/2023
Job Reference: 29406949
Site Location: 477455 384776
Requested by:
Mr Ben Evans
Your Scheme/Reference:
LM 203570/DK - 11

Exact Scales:
1:1250 Area or Circle dig site
1:500 Line dig site


Link Box ●	Overhead Line ○—○ PL ○—○ Service ○—○ LV ○—○ HV (11kV) ○—○ HV (33kV) ○—○ HV (66kV) □—□ HV (132kV)	Underground Cable -	National Grid Telecoms - - - - - PME Earth Underground Earth	Pilot Cables ○ Pole Mounted Transformer □ Ground Mounted Transformer
----------------------	--	---	--	---

IMPORTANT NOTICES

- This information is given as a guide only and its accuracy cannot be guaranteed. Services or recent additions to the network may not be shown.
- Cables, overhead lines & substations owned by other electricity network owners or private companies may be present and may not be shown.
- You should always verify exact locations of cables using a cable locator and by careful use of hand tools in accordance with HSE guidance note HSG47.
- When working within 10m of any overhead electric line you should follow the requirements of HSE Guidance Note GS6.
- For further advice on working near our electricity cables or lines, call our General Enquiries number.
- Advice should be sought from the National Grid Electricity Distribution General Enquiries team for any work that is to take place in proximity to 132kV underground cables and 132kV overhead lines.

Report damage immediately – KEEP EVERYONE AWAY FROM THE AREA
0800 6783 105

Crown Copyright © All Rights Reserved. Ordnance Survey Licence numbers: 100022432
NGED Copyright: This copy has been made by or with the authority of National Grid Electricity Distribution (NGED) pursuant to Section 47 of the Copyright Designs and Patents Act 1988 unless that Act provides a relevant exception to copyright the copy must not be copied without the prior permission of the copyright owner.

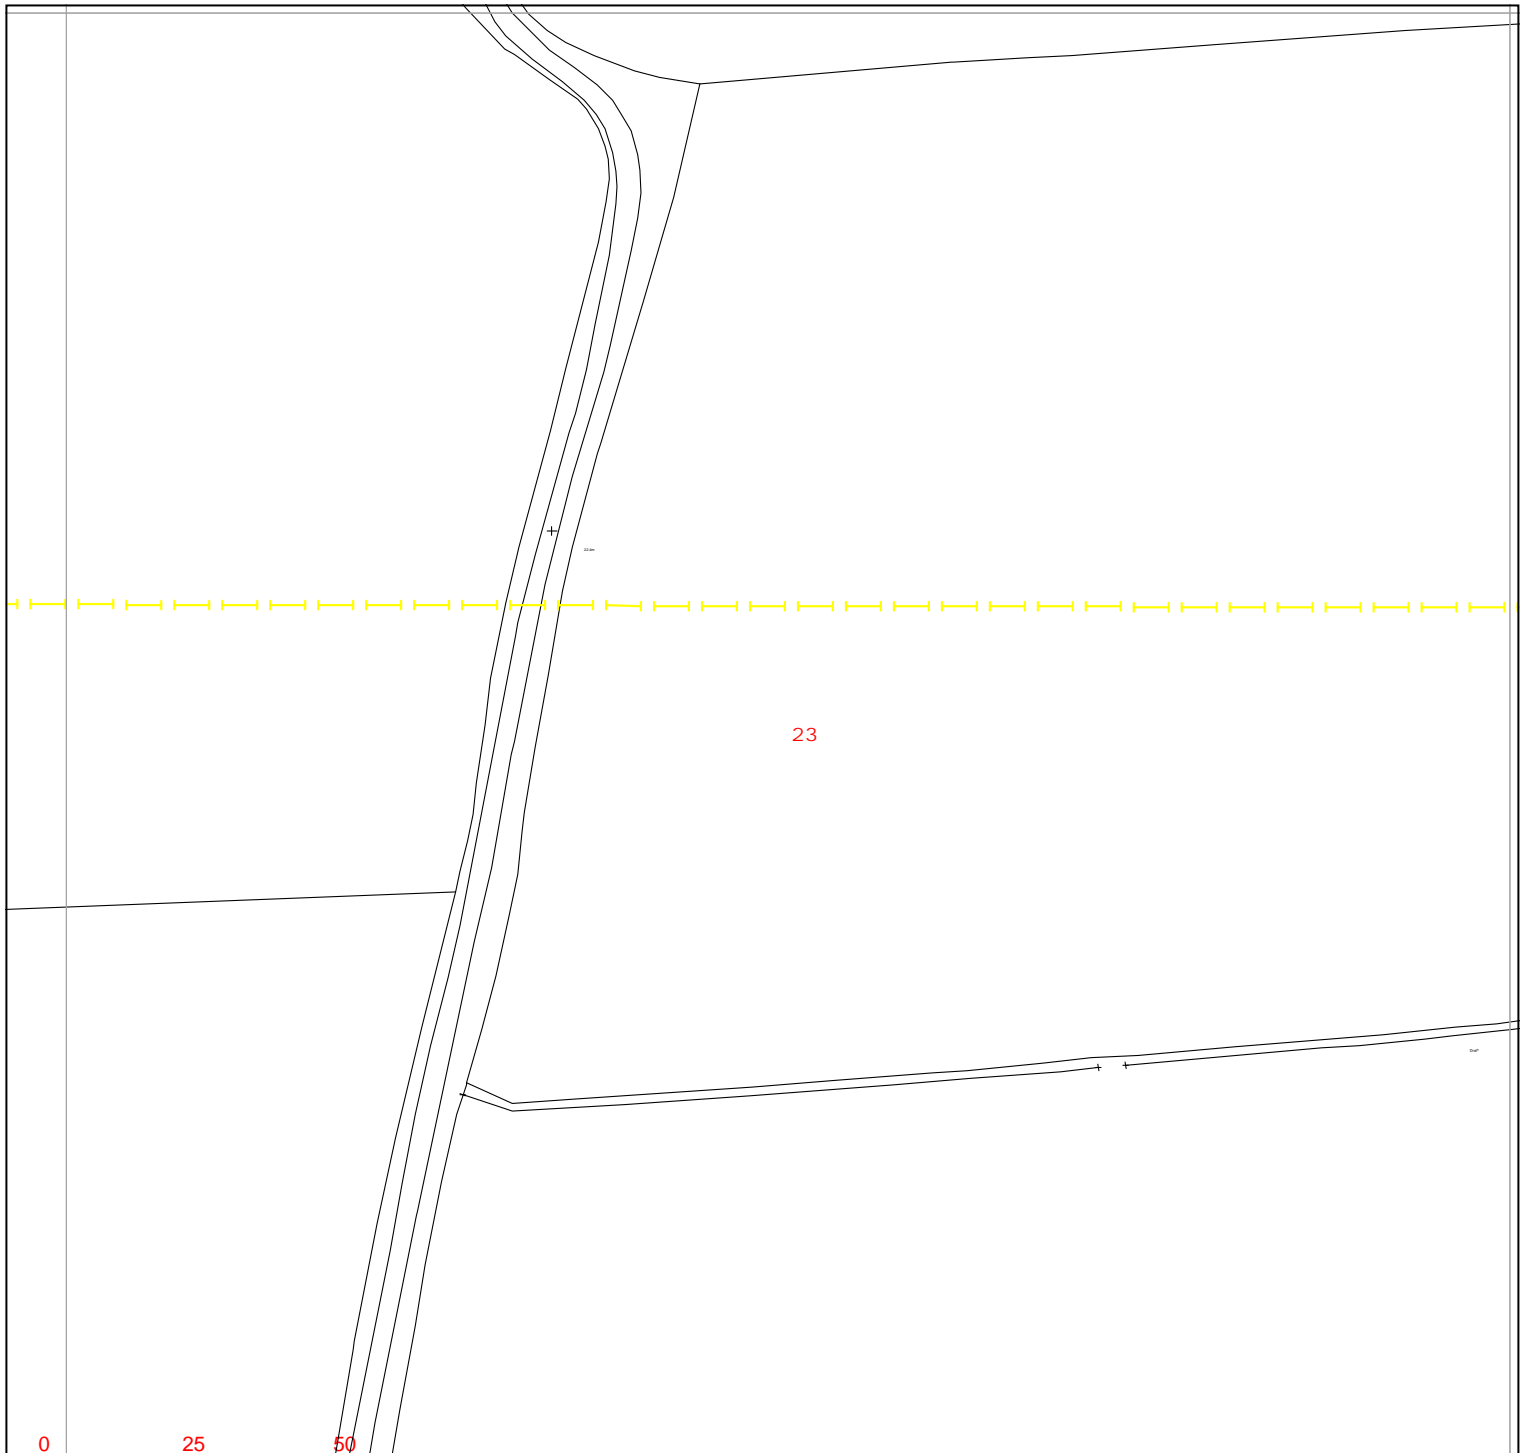

Warning: PDF designed for colour print only with no page scaling.

nationalgrid Electricity Distribution

Contact Us

Mapping Enquiries:
All areas 0121 623 9780

General Enquiries:
All areas 0800 096 3080

Date Requested: 08/05/2023
Job Reference: 29406949
Site Location: 477455 384776
Requested by:
Mr Ben Evans
Your Scheme/Reference:
LM 203570/DK - 11

Exact Scales:
1:1250 Area or Circle dig site
1:500 Line dig site


Link Box ●	Overhead Line ○ ○ PL ○ ○ Service ○ ○ LV ○ ○ HV (11kV) ○ ○ HV (33kV) ○ ○ HV (66kV) ○ ○ HV (132kV)	Underground Cable -	National Grid Telecoms - - - - - PME Earth - E - - - - - Underground Earth	Pilot Cables - - - - - ○ Pole Mounted Transformer □ Ground Mounted Transformer
----------------------	--	---	---	--

IMPORTANT NOTICES

- This information is given as a guide only and its accuracy cannot be guaranteed. Services or recent additions to the network may not be shown.
- Cables, overhead lines & substations owned by other electricity network owners or private companies may be present and may not be shown.
- You should always verify exact locations of cables using a cable locator and by careful use of hand tools in accordance with HSE guidance note HSG47.
- When working within 10m of any overhead electric line you should follow the requirements of HSE Guidance Note GS6.
- For further advice on working near our electricity cables or lines, call our General Enquiries number.
- Advice should be sought from the National Grid Electricity Distribution General Enquiries team for any work that is to take place in proximity to 132kV underground cables and 132kV overhead lines.

Report damage immediately – KEEP EVERYONE AWAY FROM THE AREA
0800 6783 105

Crown Copyright © All Rights Reserved. Ordnance Survey Licence numbers: 100022432
NGED Copyright: This copy has been made by or with the authority of National Grid Electricity Distribution (NGED) pursuant to Section 47 of the Copyright Designs and Patents Act 1988 unless that Act provides a relevant exception to copyright the copy must not be copied without the prior permission of the copyright owner.

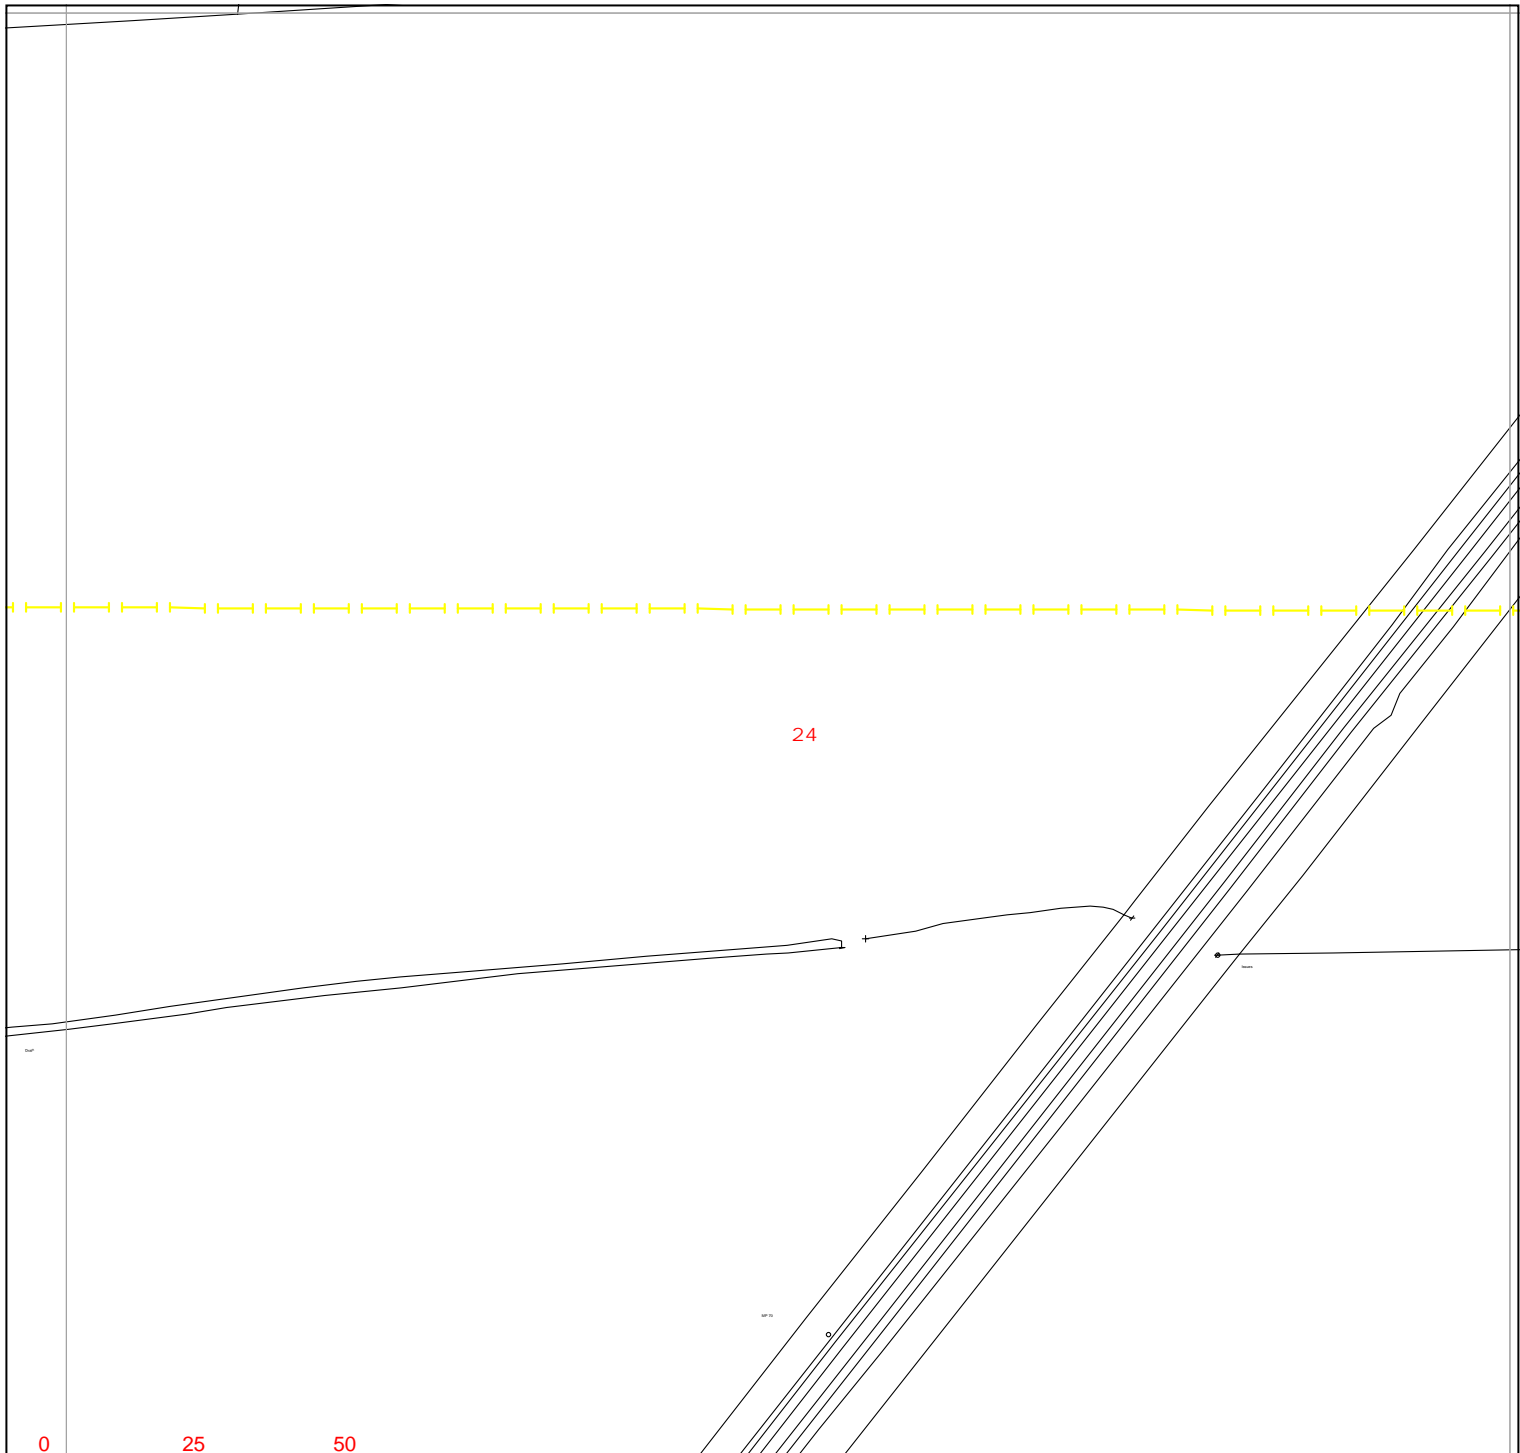

Warning: PDF designed for colour print only with no page scaling.

nationalgrid Electricity Distribution


Contact Us

Mapping Enquiries:
All areas 0121 623 9780

General Enquiries:
All areas 0800 096 3080

Date Requested: 08/05/2023
Job Reference: 29406949
Site Location: 477455 384776
Requested by:
Mr Ben Evans
Your Scheme/Reference:
LM 203570/DK - 11

Exact Scales:
1:1250 Area or Circle dig site
1:500 Line dig site

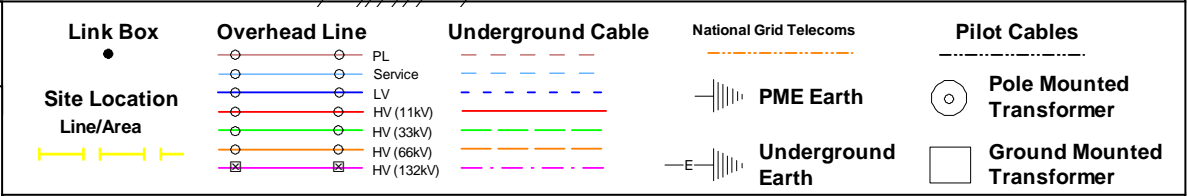


IMPORTANT NOTICES

- This information is given as a guide only and its accuracy cannot be guaranteed. Services or recent additions to the network may not be shown.
- Cables, overhead lines & substations owned by other electricity network owners or private companies may be present and may not be shown.
- You should always verify exact locations of cables using a cable locator and by careful use of hand tools in accordance with HSE guidance note HSG47.
- When working within 10m of any overhead electric line you should follow the requirements of HSE Guidance Note GS6.
- For further advice on working near our electricity cables or lines, call our General Enquiries number.
- Advice should be sought from the National Grid Electricity Distribution General Enquiries team for any work that is to take place in proximity to 132kV underground cables and 132kV overhead lines.

Report damage immediately – KEEP EVERYONE AWAY FROM THE AREA
0800 6783 105

Crown Copyright © All Rights Reserved. Ordnance Survey Licence numbers: 100022432
NGED Copyright: This copy has been made by or with the authority of National Grid Electricity Distribution (NGED) pursuant to Section 47 of the Copyright Designs and Patents Act 1988 unless that Act provides a relevant exception to copyright the copy must not be copied without the prior permission of the copyright owner.

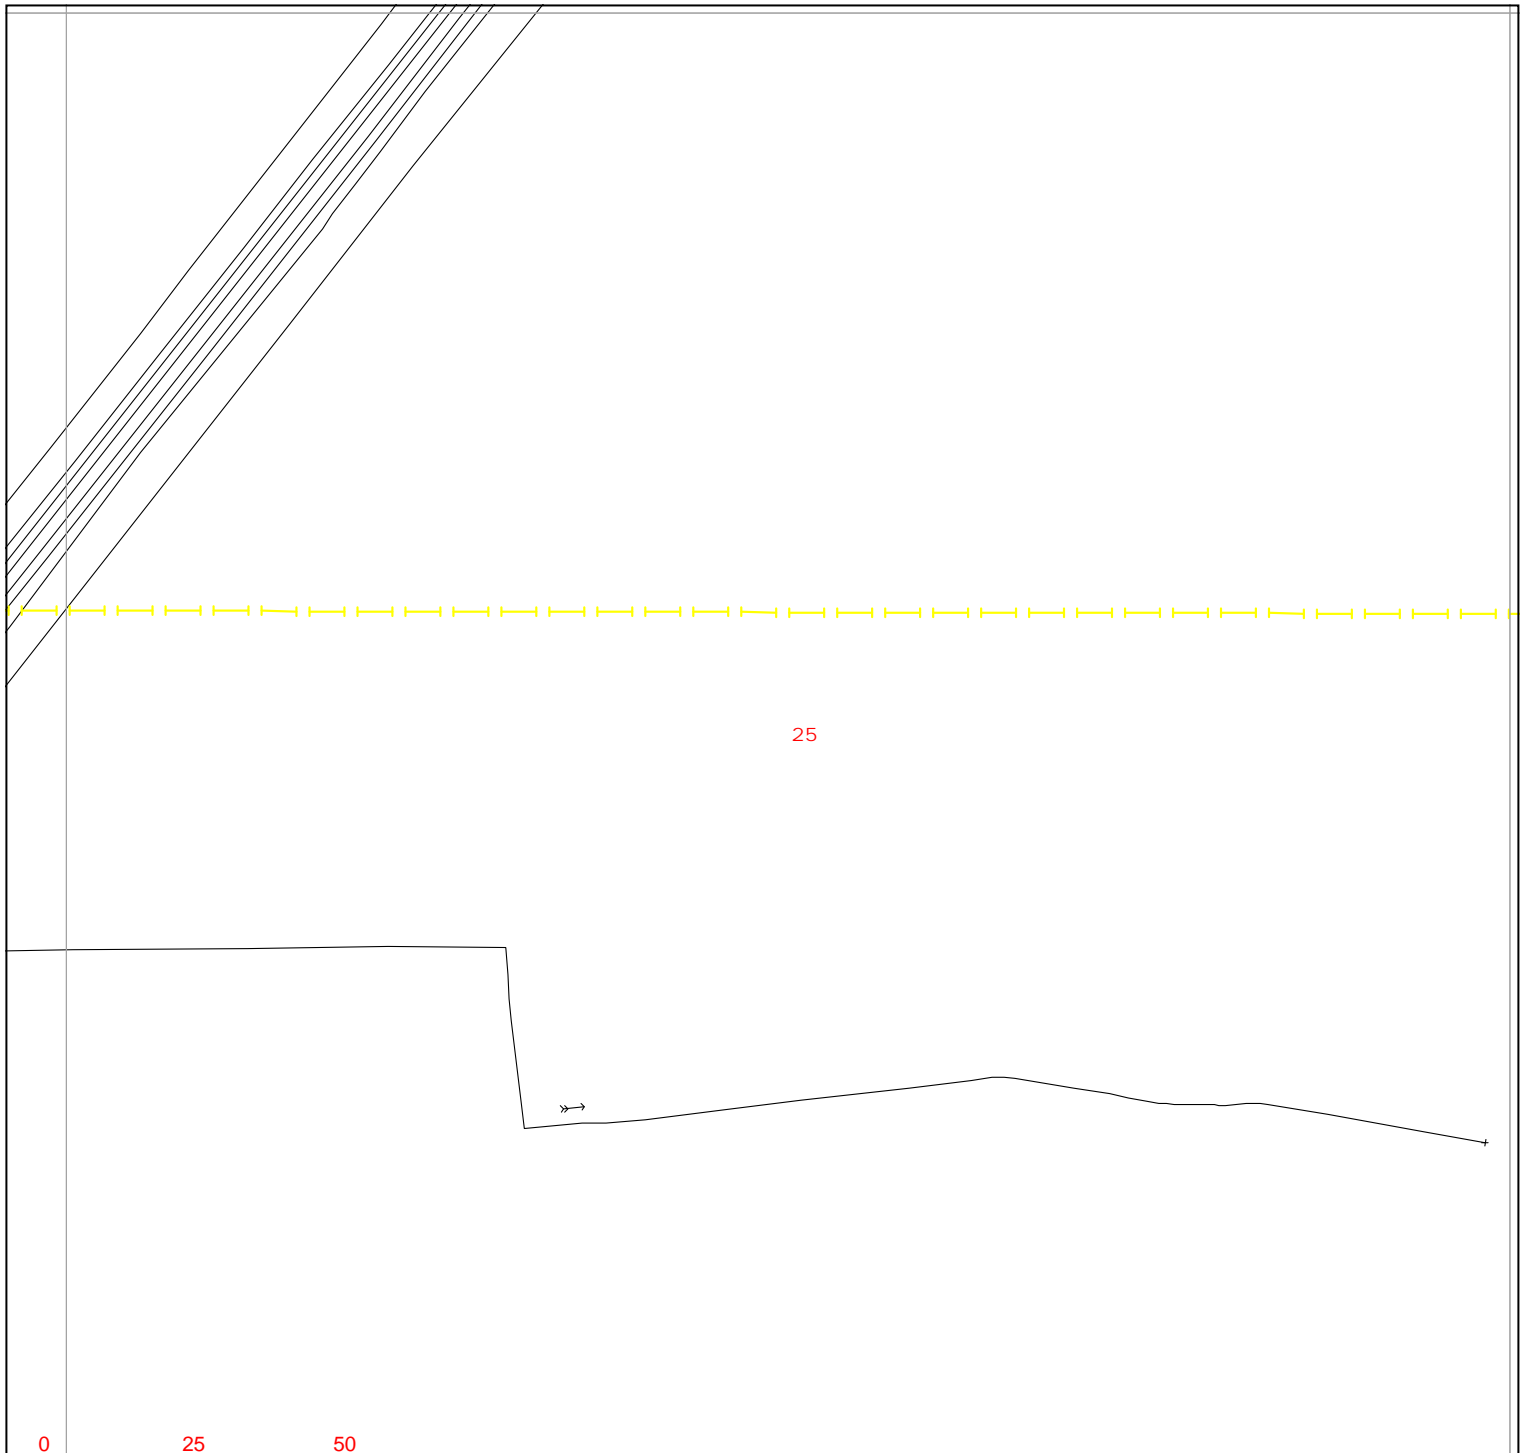

0 25 50
metres

Warning: PDF designed for colour print only with no page scaling.

nationalgrid Electricity Distribution

Contact Us

Mapping Enquiries:
All areas 0121 623 9780

General Enquiries:
All areas 0800 096 3080

Date Requested: 08/05/2023
Job Reference: 29406949
Site Location: 477455 384776
Requested by:
Mr Ben Evans
Your Scheme/Reference:
LM 203570/DK - 11

Exact Scales:
1:1250 Area or Circle dig site
1:500 Line dig site


Link Box	Overhead Line	Underground Cable	National Grid Telecoms	Pilot Cables
●	○—○ PL ○—○ Service ○—○ LV ○—○ HV (11kV) ○—○ HV (33kV) ○—○ HV (66kV) ○—○ HV (132kV)	— —	— — — — — — — — — — — — — — —	○ Pole Mounted Transformer □ Ground Mounted Transformer

IMPORTANT NOTICES

- This information is given as a guide only and its accuracy cannot be guaranteed. Services or recent additions to the network may not be shown.
- Cables, overhead lines & substations owned by other electricity network owners or private companies may be present and may not be shown.
- You should always verify exact locations of cables using a cable locator and by careful use of hand tools in accordance with HSE guidance note HSG47.
- When working within 10m of any overhead electric line you should follow the requirements of HSE Guidance Note GS6.
- For further advice on working near our electricity cables or lines, call our General Enquiries number.
- Advice should be sought from the National Grid Electricity Distribution General Enquiries team for any work that is to take place in proximity to 132kV underground cables and 132kV overhead lines.

Report damage immediately – KEEP EVERYONE AWAY FROM THE AREA
0800 6783 105

Crown Copyright © All Rights Reserved. Ordnance Survey Licence numbers: 100022432
NGED Copyright: This copy has been made by or with the authority of National Grid Electricity Distribution (NGED) pursuant to Section 47 of the Copyright Designs and Patents Act 1988 unless that Act provides a relevant exception to copyright the copy must not be copied without the prior permission of the copyright owner.

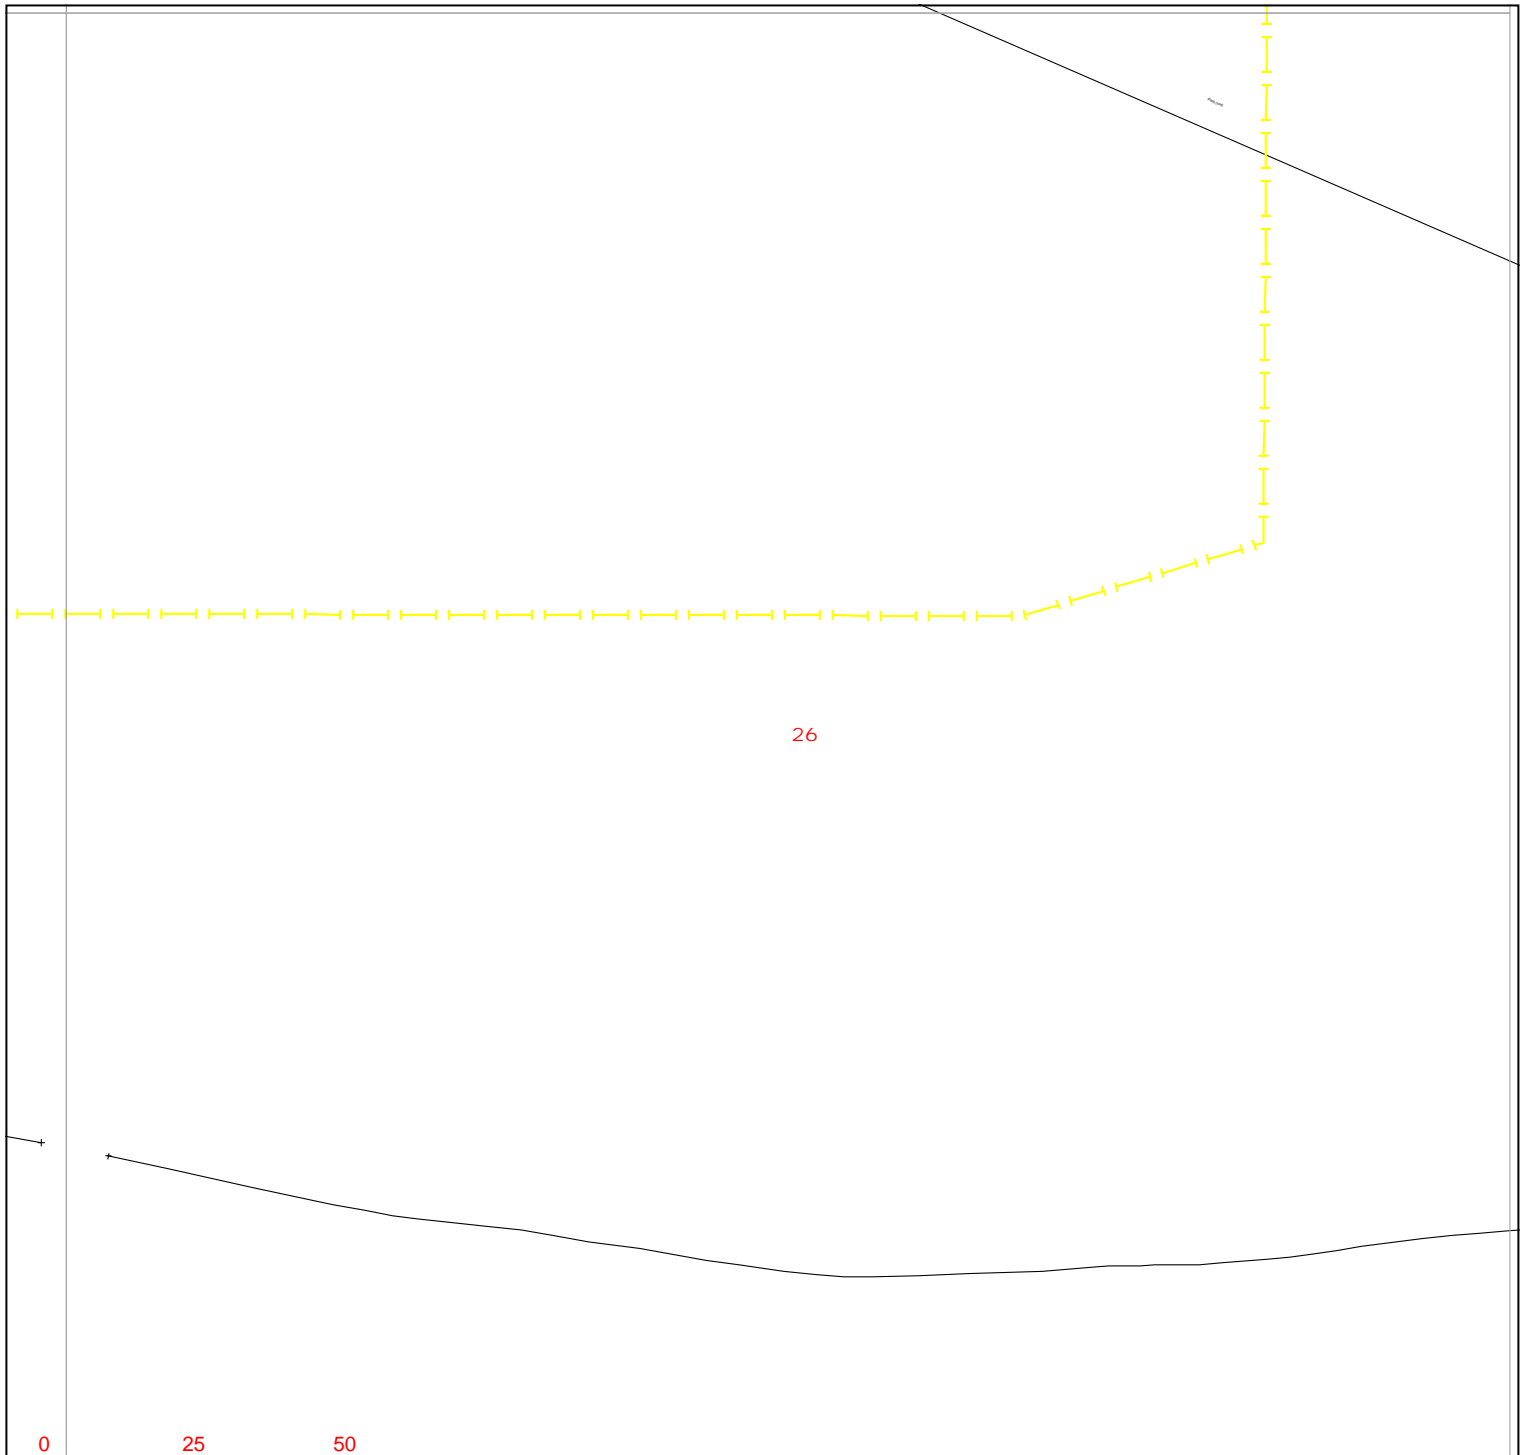

Warning: PDF designed for colour print only with no page scaling.



Contact Us
Mapping Enquiries:
 All areas 0121 623 9780
General Enquiries:
 All areas 0800 096 3080

Date Requested: 08/05/2023
 Job Reference: 29406949
 Site Location: 477455 384776
 Requested by:
 Mr Ben Evans
 Your Scheme/Reference:
 LM 203570/DK - 11

Exact Scales:
 1:1250 Area or Circle dig site
 1:500 Line dig site


Link Box	Overhead Line	Underground Cable	National Grid Telecoms	Pilot Cables
●				
●				

IMPORTANT NOTICES

- This information is given as a guide only and its accuracy cannot be guaranteed. Services or recent additions to the network may not be shown.
- Cables, overhead lines & substations owned by other electricity network owners or private companies may be present and may not be shown.
- You should always verify exact locations of cables using a cable locator and by careful use of hand tools in accordance with HSE guidance note HSG47.
- When working within 10m of any overhead electric line you should follow the requirements of HSE Guidance Note GS6.
- For further advice on working near our electricity cables or lines, call our General Enquiries number.
- Advice should be sought from the National Grid Electricity Distribution General Enquiries team for any work that is to take place in proximity to 132kV underground cables and 132kV overhead lines.

Report damage immediately – KEEP EVERYONE AWAY FROM THE AREA
0800 6783 105

Crown Copyright © All Rights Reserved. Ordnance Survey Licence numbers: 100022432
 NGED Copyright: This copy has been made by or with the authority of National Grid Electricity Distribution (NGED) pursuant to Section 47 of the Copyright Designs and Patents Act 1988 unless that Act provides a relevant exception to copyright the copy must not be copied without the prior permission of the copyright owner.

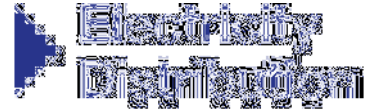

Our Ref: 29406951 Your Ref: LM 203570/DK - 12

Monday, 08 May 2023

Ben Evans
The Hub, 500 Park Avenue, Aztec West
Almondsbury
Bristol
BS32 4RZ

**National Grid Electricity
Distribution**
Mapping Centre
Toll End Road
Tipton
West Midlands
United Kingdom
DY4 0HH
www.nationalgrid.co.uk

Dear Ben Evans

Thank you for your enquiry dated Monday, 08 May 2023

I now enclose a copy of our plan showing existing National Grid Electricity Distribution (NGED) Electricity / National Grid Telecoms (NGT) apparatus in the vicinity of your proposed works. This information is given as a general guide only and its accuracy cannot be guaranteed. Please note that all NGED equipment on site should be assumed to be LIVE until NGED prove otherwise and provide you with confirmation to this effect in writing. Recent additions to our network, or service connections between the main cable and a building or street lamp may not be shown.

Map Response
T 0121 623 9780
NGED.MapResponse
@nationalgrid.co.uk

Damage to underground cables and contact with overhead lines can cause severe injury or may prove fatal. If you are excavating on site in the vicinity of either NGED Electrical apparatus or NGT Telecoms apparatus you must comply with the requirements of the following:-

Health & Safety Executive guidance HS(G)47, Avoiding Danger from underground services.

Work taking place in the vicinity of our plant is also regulated under the:-

Electricity at Work Regulations 1989, Health and Safety Act 1974, CDM Regulations 2015.
Safe working procedures should be defined and practiced

Please ensure that the use of mechanical excavators in the vicinity of our plant is kept to a minimum. NGT Telecoms ducts contain fibre cables, which are expensive to repair. Therefore, extreme care must be taken whilst working in the vicinity of these ducts, hand digging methods being used to determine their precise position.

If there are overhead lines crossing your site and your proposal involves building works which may infringe the clearance to our overhead system then you should call the relevant general enquiries number (see page 2 of this letter) for advice. Where overhead lines cross your site you must comply with the requirements of Health & Safety Executive guidance as laid down in GS6, Avoidance of Danger from Overhead Electric Lines.

National Grid Electricity
Distribution
South West - 02366894
South Wales - 02366985
East Midlands - 02366923
West Midlands - 03600574

Where diversions to NGED apparatus are needed to allow change to occur on site, the cost of these alterations may be charged to the persons responsible for the works.

If you require advice in connection with your proposals please contact the relevant general enquiries number (see page 2 of this letter)

Registered in
England and Wales


Following consultation the local NGED team will where necessary prepare detailed proposals and provide a quotation for any necessary alterations and/or development of our equipment on the site.

Registered Office:
Avonbank
Feeder Road
Bristol
BS2 0TB

This information is given as a guide only and its accuracy cannot be guaranteed. This plan is based on data from our Geographic Information System, which is updated every 24 hours to reflect changes to our network. The information contained in this plan reflects the most recent network GIS data, however changes to the network (including network additions and new service

Safety Documents:

<https://www.nationalgrid.co.uk/customers-and-community/health-safety/public-safety-advice>

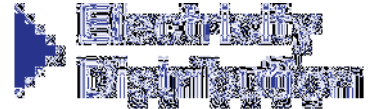

connections) may not be shown. You are advised to obtain an up to date plan on the date of commencing on-site works.

Yours sincerely
NGED Map Response Team

Contact Us

Emergency or Power Supply issues

In an emergency call 105, 24 hours a day.

Mapping Enquiries

If you have an enquiry relating to this letter or the attached map plan, please contact us using the following information:

Telephone 0121 623 9780
Email NGED.MapResponse@nationalgrid.co.uk

General Enquiries


If you have a general enquiry, please call us on the following telephone number:

All areas 0800 096 3080

LSBUD

If you have an enquiry relating to the use of the LSBUD website please contact LSBUD using the following information:

Telephone 0345 437 7365
Email enquiries@LSBUD.co.uk
Website www.LSBUD.co.uk

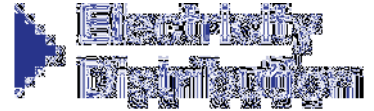

Steps to help keep you safe

- **If you are working within 10 metres of our 33kV, 66kV, 132kV underground electricity cables or within 10 meters of an overhead electricity line you should call the relevant General Enquiries for free safety advice.**

Safety Documents – please download our informative safety documents to help ensure that you, your staff and the public are kept safe whilst working in the vicinity of electricity.

<https://www.nationalgrid.co.uk/customers-and-community/health-safety/public-safety-advice>

- **Make sure you have up to date plans** - remember that recent additions to our network or service connections between the main cable and a building or street lamp may not be shown.
- **Look for signs of service cables** - an electricity meter box or nearby streetlamp may give you an indication that service cables are present in your area of work.
- **Non NGED Network** - electricity cables, lines and equipment owned by others may also be present in addition to NGED network. They are unlikely to be shown on our plans.
- **Use a cable locator** - trace electricity cables and mark the position of them using paint or other waterproof marking on the ground.
- **Hand dig trial holes** - to confirm the position of cables in close proximity to your area of your work and use spades and shovels rather than picks, pins or forks.
- **Have an emergency plan** - so that everyone working on site understands what to do in the event of an underground electricity cable being damaged or contact being made with an overhead electricity line.
- **If you are working within 10 meters** of an overhead electricity line then it may be necessary for you to erect warning signs and markers, or height restriction goal posts. Ensure that you comply with the requirements of Health & Safety Executive guidance laid down in GS6, Avoidance of Danger from Overhead Electric Lines.
- **If you are erecting a structure** that could allow anyone standing on it, or its access device (ladder, scaffold, MEWP), to come within 3m of any overhead electric line then **you must inform us**. This is your duty and a legal requirement under the Electricity Safety, Quality & Continuity Regulations 2002.
- **If you cannot work safely** around the underground electricity cable or overhead electricity line, then you may need to get it moved to allow your works to go ahead. Call the general enquiry numbers above for guidance.
- **It is possible that cables or pipes may be embedded in concrete** - electricity cables embedded in concrete **MUST** be made 'dead' by Western Power Distribution or the cable owner before the concrete is broken out. Alternatively, another safe way of working should be agreed.
- **Cables are sometimes covered by tiles or a marker tape** - these can be concrete, polythene or earthenware and are a useful early warning of the presence of cables; you should avoid disturbing any tiles or tape to expose the cable. Not all cables have these warning indicators.



nationalgrid Electricity Distribution

Contact Us

Mapping Enquiries:
All areas 0121 623 9780

General Enquiries:
All areas 0800 096 3080

Date Requested: 08/05/2023
Job Reference: 29406951
Site Location: 478133 385117
Requested by:
Mr Ben Evans
Your Scheme/Reference:
LM 203570/DK - 12


Link Box	Overhead Line	Underground Cable	National Grid Telecoms	Pilot Cables
●	○ PL ○ Service ○ LV ○ HV (11kV) ○ HV (33kV) ○ HV (66kV) ○ HV (132kV)	--- --- ---	--- PME Earth --- Underground Earth	○ Pole Mounted Transformer □ Ground Mounted Transformer

IMPORTANT NOTICES

- This information is given as a guide only and its accuracy cannot be guaranteed. Services or recent additions to the network may not be shown.
- Cables, overhead lines & substations owned by other electricity network owners or private companies may be present and may not be shown.
- You should always verify exact locations of cables using a cable locator and by careful use of hand tools in accordance with HSE guidance note HSG47.
- When working within 10m of any overhead electric line you should follow the requirements of HSE Guidance Note GS6.
- For further advice on working near our electricity cables or lines, call our General Enquiries number.
- Advice should be sought from the National Grid Electricity Distribution General Enquiries team for any work that is to take place in proximity to 132kV underground cables and 132kV overhead lines.

Report damage immediately – KEEP EVERYONE AWAY FROM THE AREA
0800 6783 105

Crown Copyright © All Rights Reserved. Ordnance Survey Licence numbers: 100022432
NGED Copyright: This copy has been made by or with the authority of National Grid Electricity Distribution (NGED) pursuant to Section 47 of the Copyright Designs and Patents Act 1988 unless that Act provides a relevant exception to copyright the copy must not be copied without the prior permission of the copyright owner.

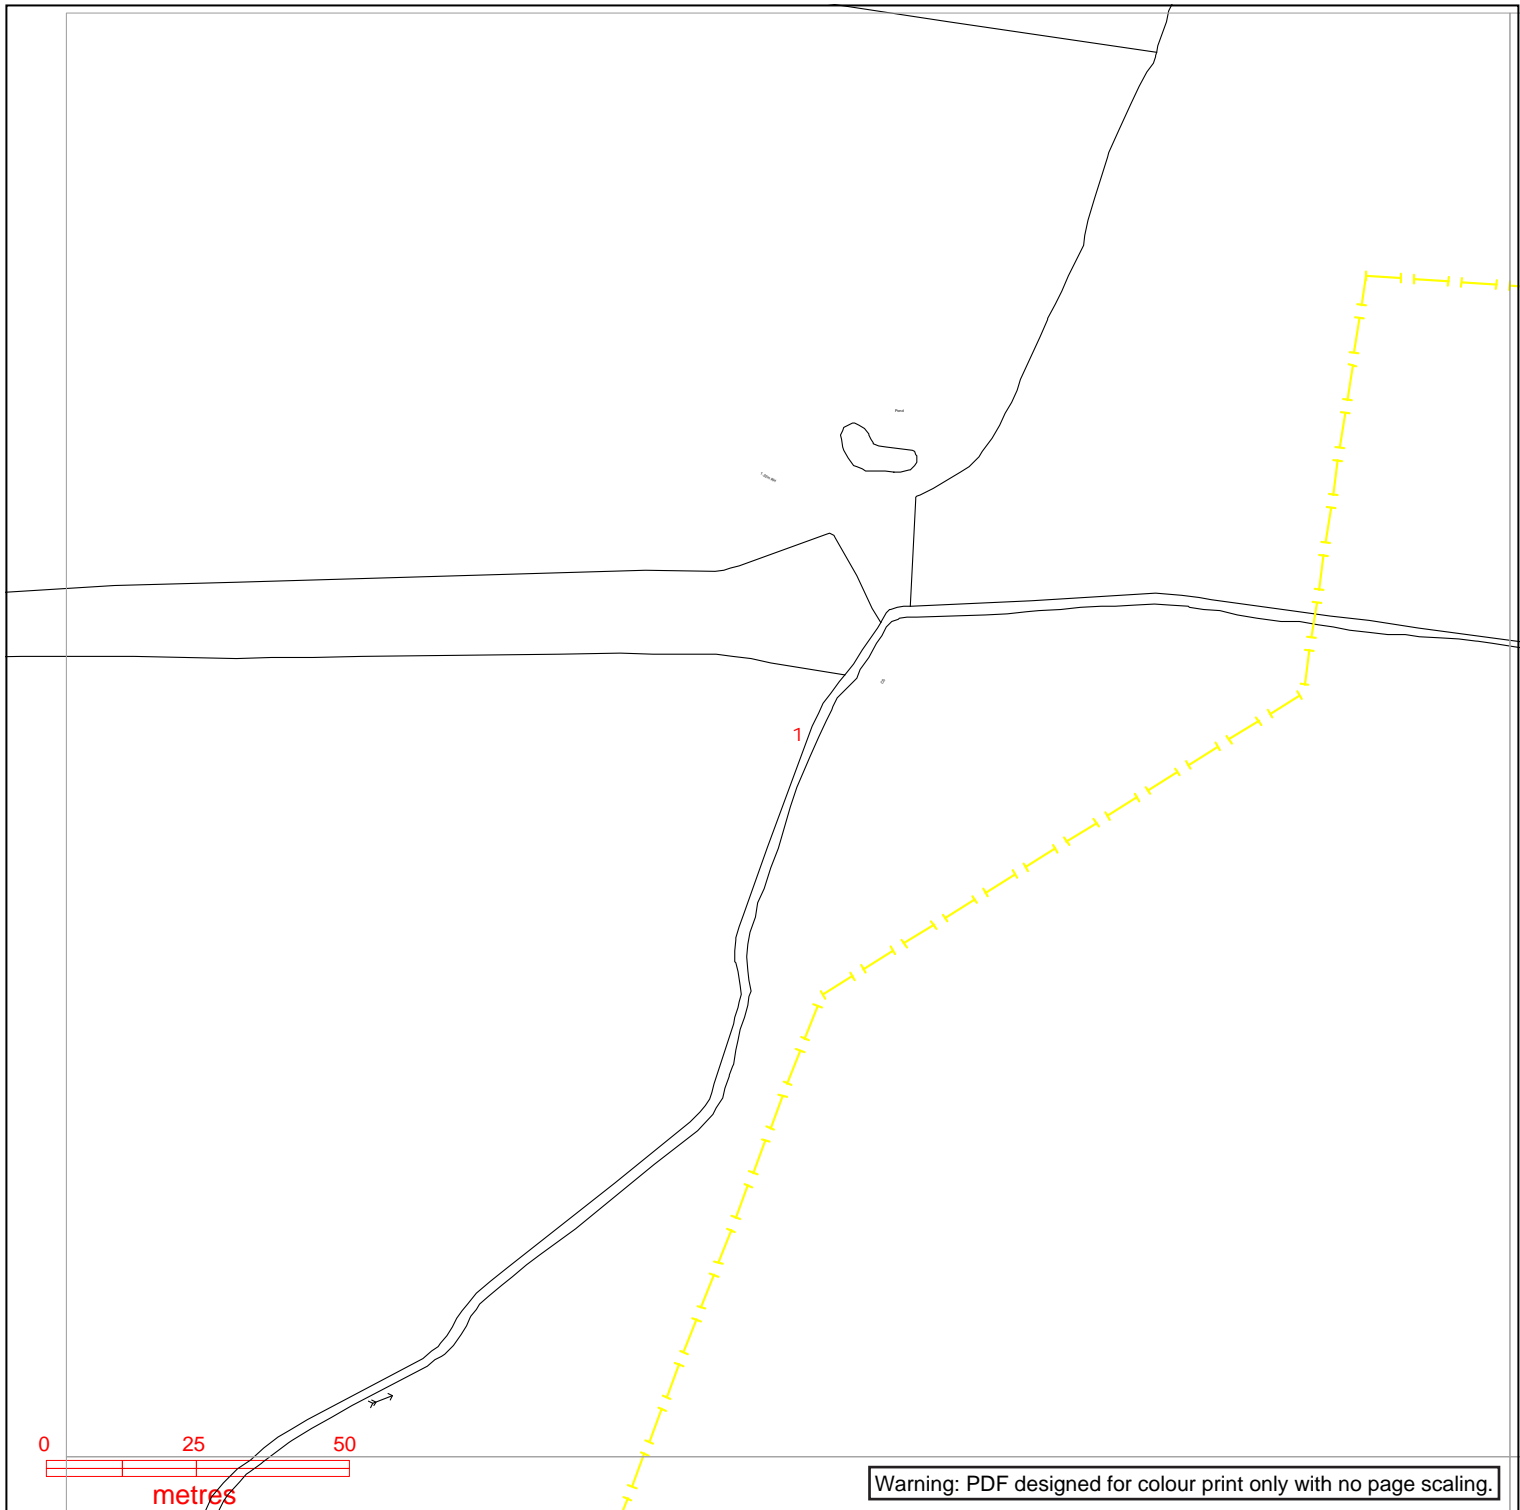

Warning: PDF designed for colour print only with no page scaling.

nationalgrid Electricity Distribution

Contact Us

Mapping Enquiries:
All areas 0121 623 9780

General Enquiries:
All areas 0800 096 3080

Date Requested: 08/05/2023
Job Reference: 29406951
Site Location: 478133 385117
Requested by:
Mr Ben Evans
Your Scheme/Reference:
LM 203570/DK - 12

Exact Scales:
1:1250 Area or Circle dig site
1:500 Line dig site


Link Box	Overhead Line	Underground Cable	National Grid Telecoms	Pilot Cables
●	○ PL ○ Service ○ LV ○ HV (11kV) ○ HV (33kV) ○ HV (66kV) ○ HV (132kV)	---	--- PME Earth ---E Underground Earth	○ Pole Mounted Transformer □ Ground Mounted Transformer
Site Location Line/Area	--- --- --- --- --- --- ---	---		

IMPORTANT NOTICES

- This information is given as a guide only and its accuracy cannot be guaranteed. Services or recent additions to the network may not be shown.
- Cables, overhead lines & substations owned by other electricity network owners or private companies may be present and may not be shown.
- You should always verify exact locations of cables using a cable locator and by careful use of hand tools in accordance with HSE guidance note HSG47.
- When working within 10m of any overhead electric line you should follow the requirements of HSE Guidance Note GS6.
- For further advice on working near our electricity cables or lines, call our General Enquiries number.
- Advice should be sought from the National Grid Electricity Distribution General Enquiries team for any work that is to take place in proximity to 132kV underground cables and 132kV overhead lines.

Report damage immediately – KEEP EVERYONE AWAY FROM THE AREA
0800 6783 105

Crown Copyright © All Rights Reserved. Ordnance Survey Licence numbers: 100022432
NGED Copyright: This copy has been made by or with the authority of National Grid Electricity Distribution (NGED) pursuant to Section 47 of the Copyright Designs and Patents Act 1988 unless that Act provides a relevant exception to copyright the copy must not be copied without the prior permission of the copyright owner.

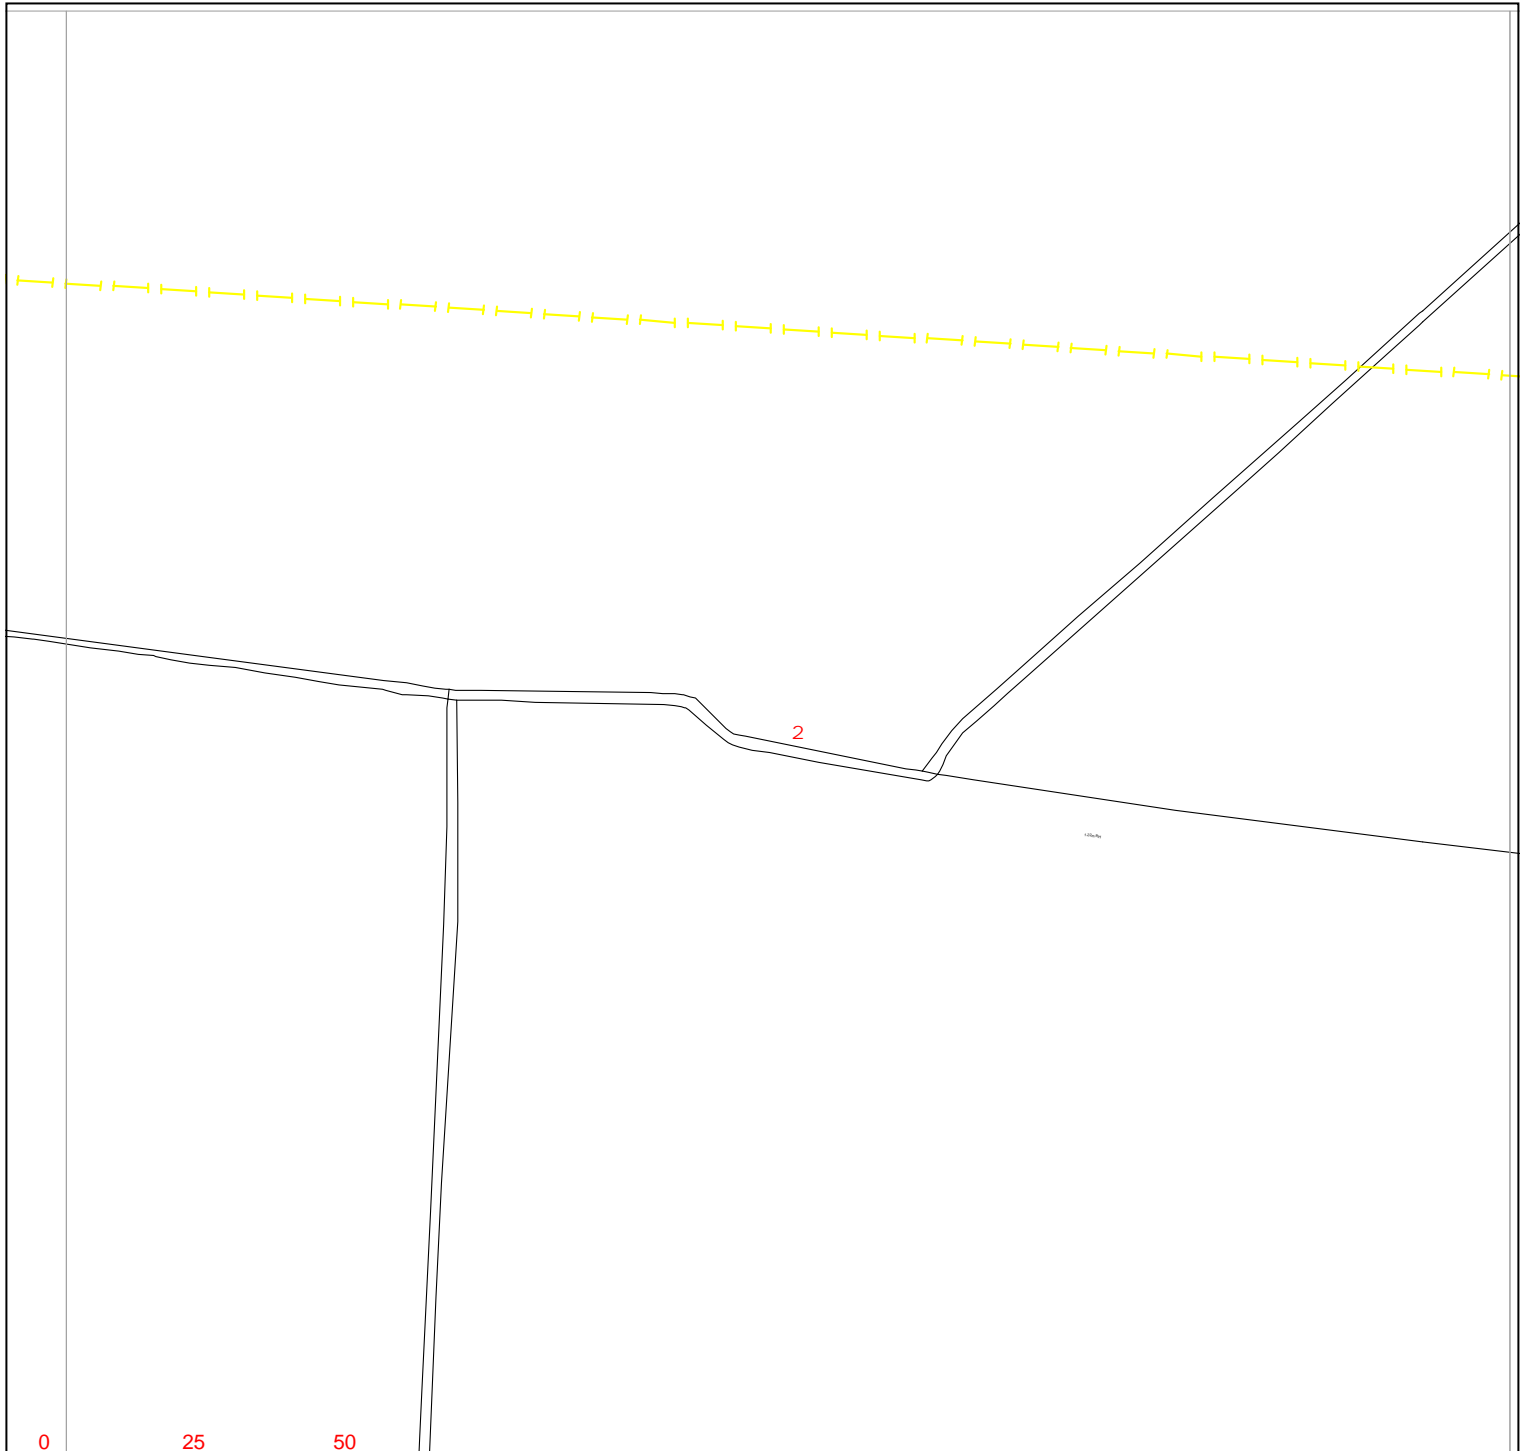

Warning: PDF designed for colour print only with no page scaling.



Contact Us
Mapping Enquiries:
 All areas 0121 623 9780
General Enquiries:
 All areas 0800 096 3080

Date Requested: 08/05/2023
 Job Reference: 29406951
 Site Location: 478133 385117
 Requested by:
 Mr Ben Evans
 Your Scheme/Reference:
 LM 203570/DK - 12

Exact Scales:
 1:1250 Area or Circle dig site
 1:500 Line dig site


Link Box ●	Overhead Line ○ ○ PL ○ ○ Service ○ ○ LV ○ ○ HV (11kV) ○ ○ HV (33kV) ○ ○ HV (66kV) ○ ○ HV (132kV)	Underground Cable -	National Grid Telecoms - - - - - PME Earth -E- - - - - Underground Earth	Pilot Cables ○ Pole Mounted Transformer □ Ground Mounted Transformer
----------------------	--	---	---	---

IMPORTANT NOTICES

- This information is given as a guide only and its accuracy cannot be guaranteed. Services or recent additions to the network may not be shown.
- Cables, overhead lines & substations owned by other electricity network owners or private companies may be present and may not be shown.
- You should always verify exact locations of cables using a cable locator and by careful use of hand tools in accordance with HSE guidance note HSG47.
- When working within 10m of any overhead electric line you should follow the requirements of HSE Guidance Note GS6.
- For further advice on working near our electricity cables or lines, call our General Enquiries number.
- Advice should be sought from the National Grid Electricity Distribution General Enquiries team for any work that is to take place in proximity to 132kV underground cables and 132kV overhead lines.

Report damage immediately – KEEP EVERYONE AWAY FROM THE AREA
0800 6783 105

Crown Copyright © All Rights Reserved. Ordnance Survey Licence numbers: 100022432
 NGED Copyright: This copy has been made by or with the authority of National Grid Electricity Distribution (NGED) pursuant to Section 47 of the Copyright Designs and Patents Act 1988 unless that Act provides a relevant exception to copyright the copy must not be copied without the prior permission of the copyright owner.

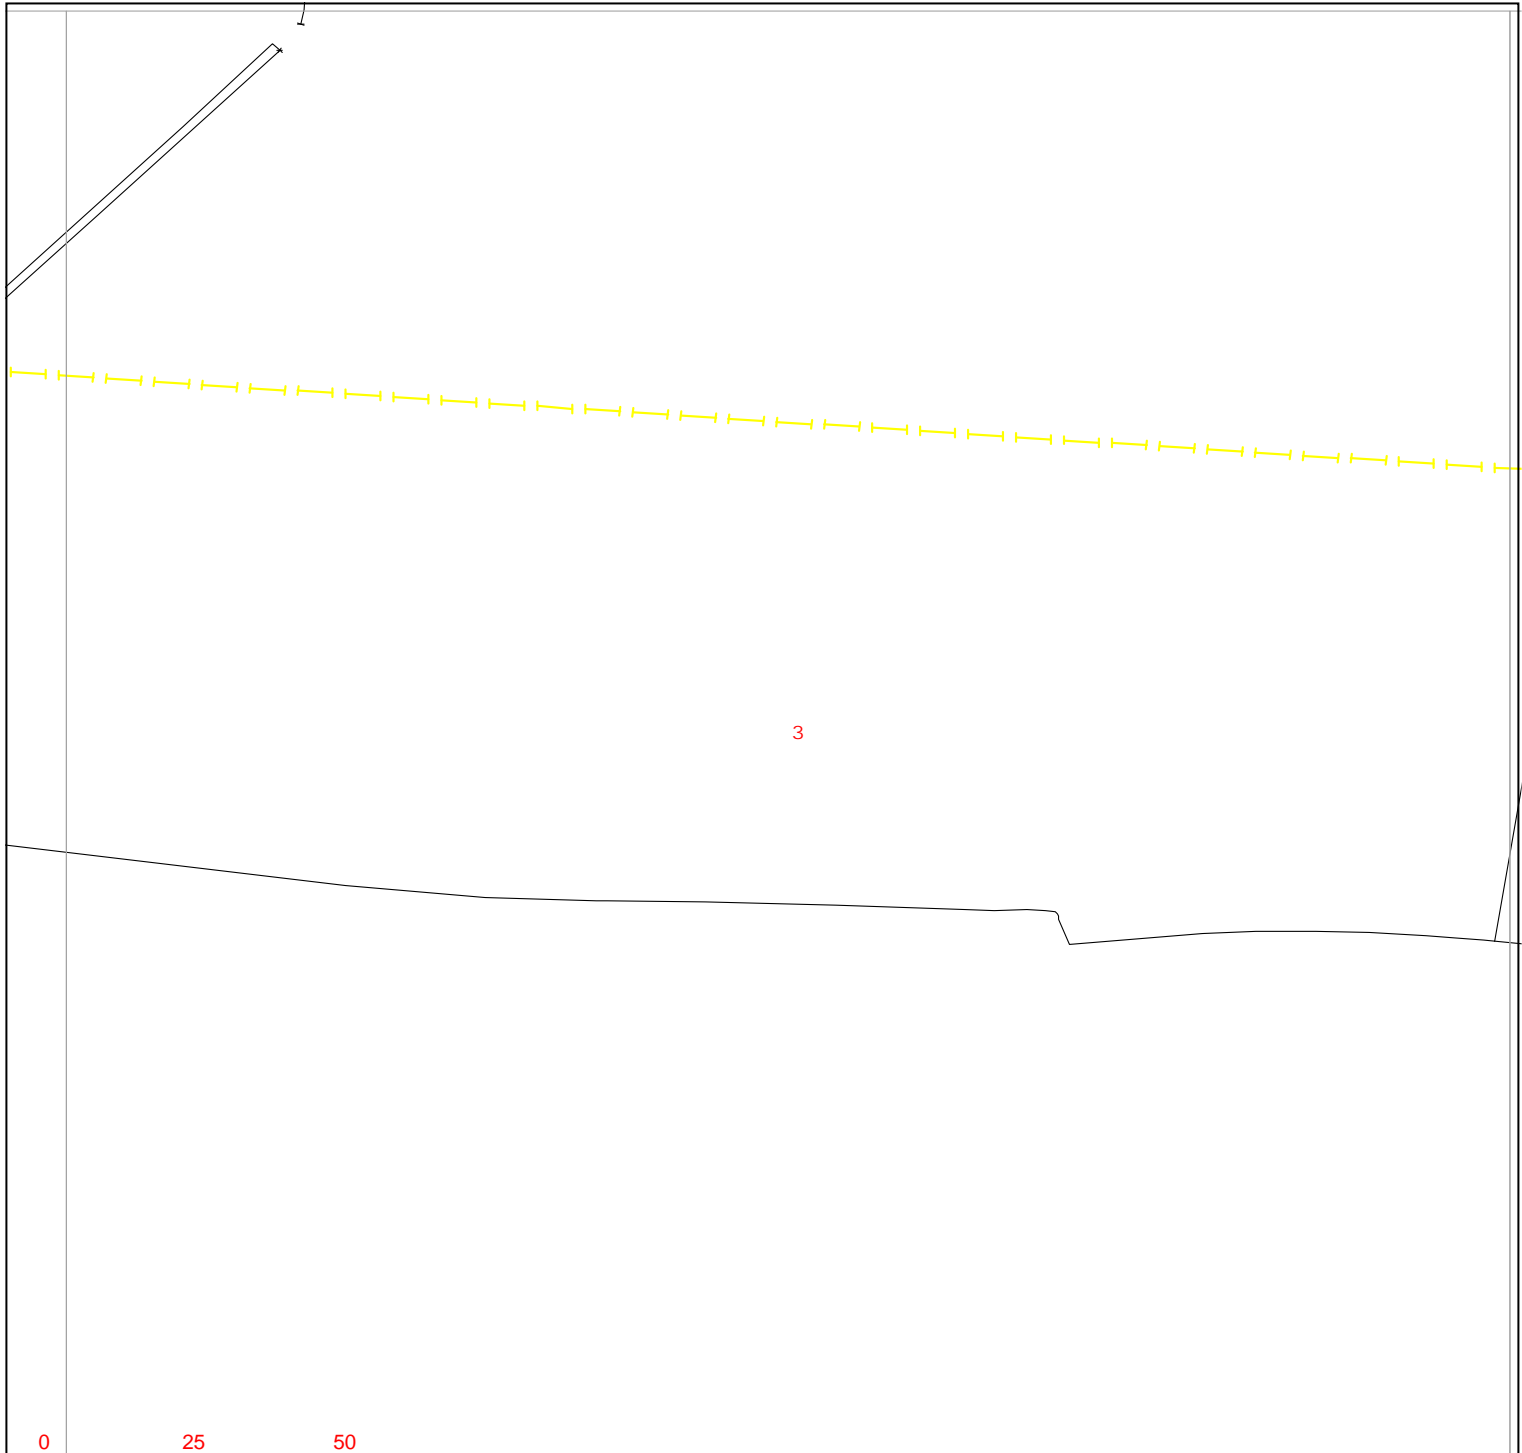

0 25 50
metres

Warning: PDF designed for colour print only with no page scaling.

nationalgrid Electricity Distribution

Contact Us

Mapping Enquiries:
All areas 0121 623 9780

General Enquiries:
All areas 0800 096 3080

Date Requested: 08/05/2023
Job Reference: 29406951
Site Location: 478133 385117
Requested by:
Mr Ben Evans
Your Scheme/Reference:
LM 203570/DK - 12

Exact Scales:
1:1250 Area or Circle dig site
1:500 Line dig site


Link Box	Overhead Line	Underground Cable	National Grid Telecoms	Pilot Cables
●	<ul style="list-style-type: none"> ○ PL ○ Service ○ LV ○ HV (11kV) ○ HV (33kV) ○ HV (66kV) ○ HV (132kV) 	<ul style="list-style-type: none"> --- --- --- --- --- --- --- 	<ul style="list-style-type: none"> —E— —E— 	<ul style="list-style-type: none"> ○ Pole Mounted Transformer □ Ground Mounted Transformer

IMPORTANT NOTICES

- This information is given as a guide only and its accuracy cannot be guaranteed. Services or recent additions to the network may not be shown.
- Cables, overhead lines & substations owned by other electricity network owners or private companies may be present and may not be shown.
- You should always verify exact locations of cables using a cable locator and by careful use of hand tools in accordance with HSE guidance note HSG47.
- When working within 10m of any overhead electric line you should follow the requirements of HSE Guidance Note GS6.
- For further advice on working near our electricity cables or lines, call our General Enquiries number.
- Advice should be sought from the National Grid Electricity Distribution General Enquiries team for any work that is to take place in proximity to 132kV underground cables and 132kV overhead lines.

Report damage immediately – KEEP EVERYONE AWAY FROM THE AREA
0800 6783 105

Crown Copyright © All Rights Reserved. Ordnance Survey Licence numbers: 100022432
NGED Copyright: This copy has been made by or with the authority of National Grid Electricity Distribution (NGED) pursuant to Section 47 of the Copyright Designs and Patents Act 1988 unless that Act provides a relevant exception to copyright the copy must not be copied without the prior permission of the copyright owner.

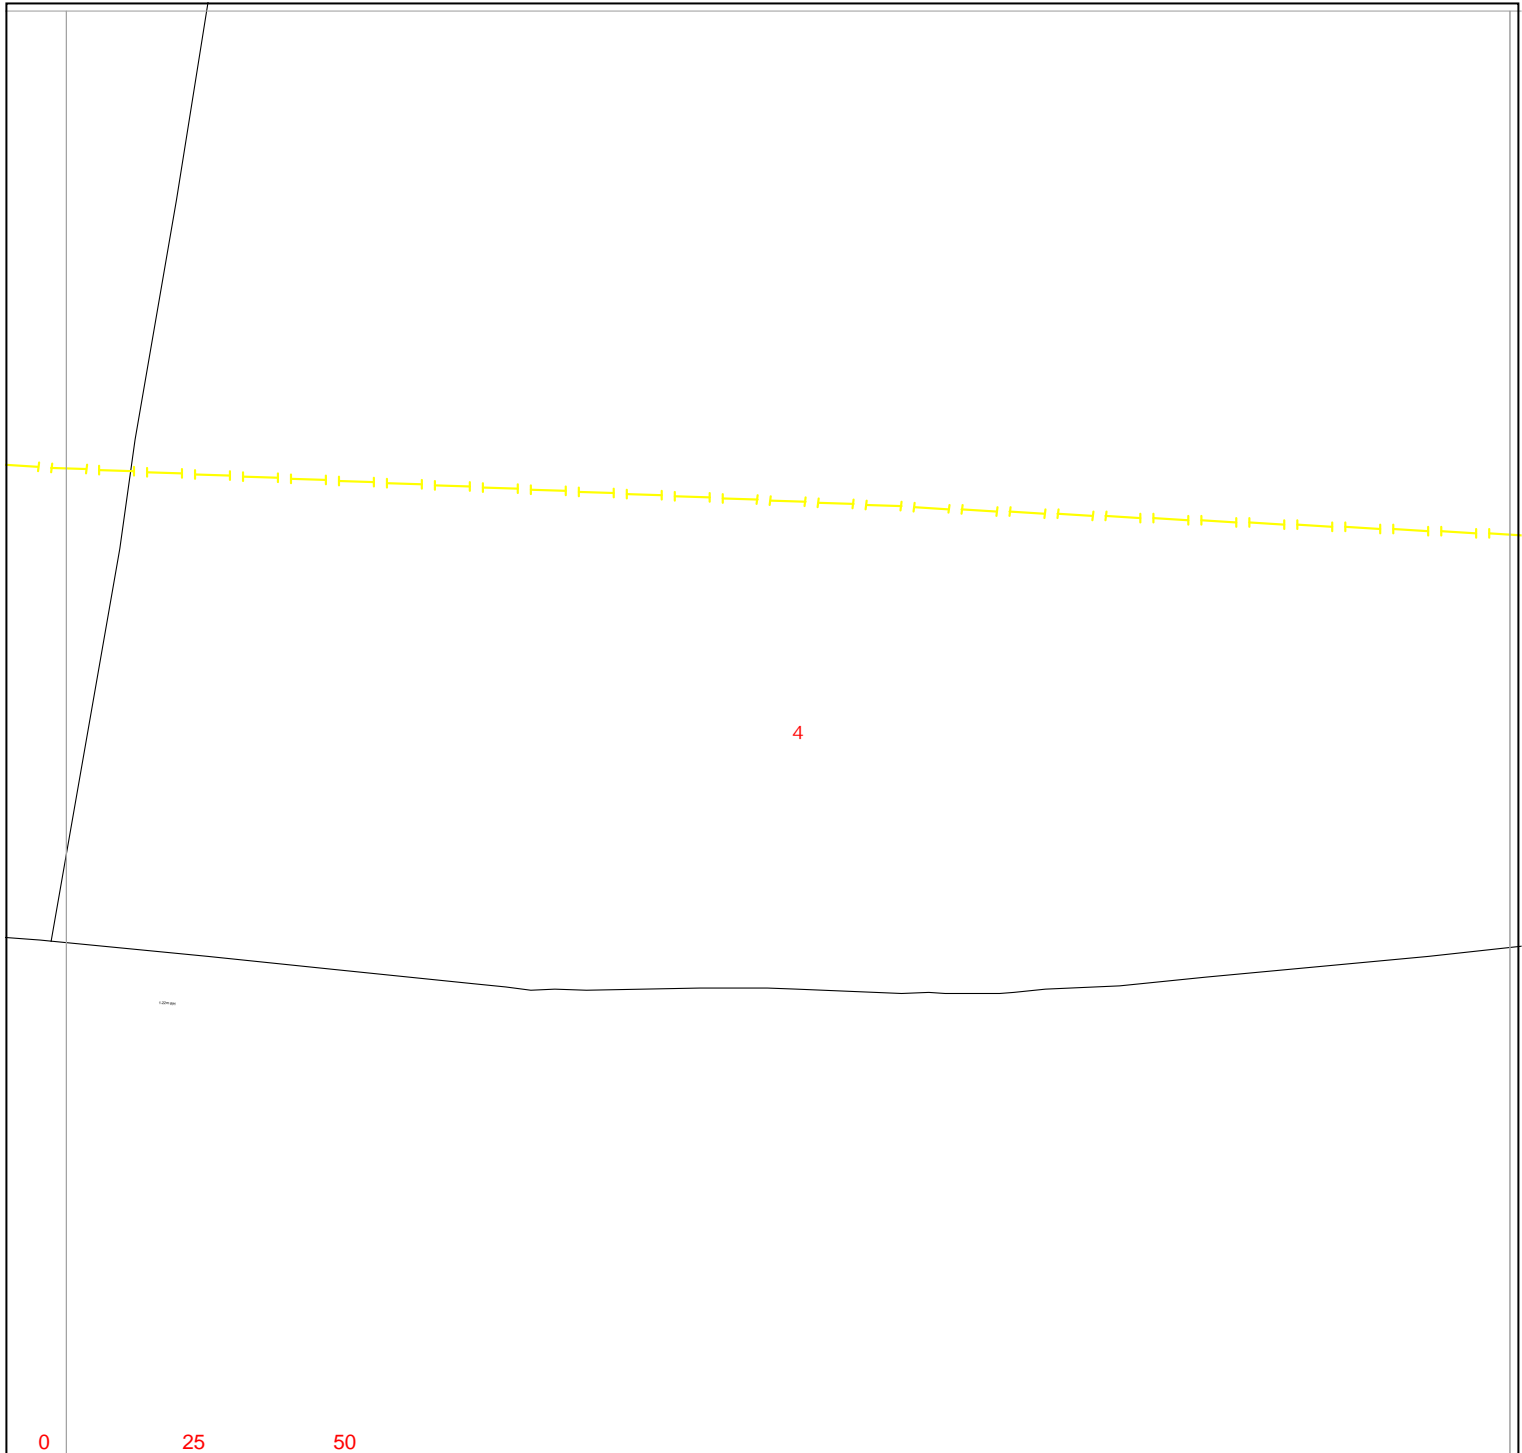

Warning: PDF designed for colour print only with no page scaling.

nationalgrid Electricity Distribution

Contact Us

Mapping Enquiries:
All areas 0121 623 9780

General Enquiries:
All areas 0800 096 3080

Date Requested: 08/05/2023
Job Reference: 29406951
Site Location: 478133 385117
Requested by:
Mr Ben Evans
Your Scheme/Reference:
LM 203570/DK - 12

Exact Scales:
1:1250 Area or Circle dig site
1:500 Line dig site


Link Box ●	Overhead Line ○ ○ PL ○ ○ Service ○ ○ LV ○ ○ HV (11kV) ○ ○ HV (33kV) ○ ○ HV (66kV) ○ ○ HV (132kV)	Underground Cable --- ---	National Grid Telecoms --- --- PME Earth Underground Earth	Pilot Cables --- ○ Pole Mounted Transformer □ Ground Mounted Transformer
----------------------	--	--	---	--

IMPORTANT NOTICES

- This information is given as a guide only and its accuracy cannot be guaranteed. Services or recent additions to the network may not be shown.
- Cables, overhead lines & substations owned by other electricity network owners or private companies may be present and may not be shown.
- You should always verify exact locations of cables using a cable locator and by careful use of hand tools in accordance with HSE guidance note HSG47.
- When working within 10m of any overhead electric line you should follow the requirements of HSE Guidance Note GS6.
- For further advice on working near our electricity cables or lines, call our General Enquiries number.
- Advice should be sought from the National Grid Electricity Distribution General Enquiries team for any work that is to take place in proximity to 132kV underground cables and 132kV overhead lines.

Report damage immediately – KEEP EVERYONE AWAY FROM THE AREA
0800 6783 105

Crown Copyright © All Rights Reserved. Ordnance Survey Licence numbers: 100022432
NGED Copyright: This copy has been made by or with the authority of National Grid Electricity Distribution (NGED) pursuant to Section 47 of the Copyright Designs and Patents Act 1988 unless that Act provides a relevant exception to copyright the copy must not be copied without the prior permission of the copyright owner.

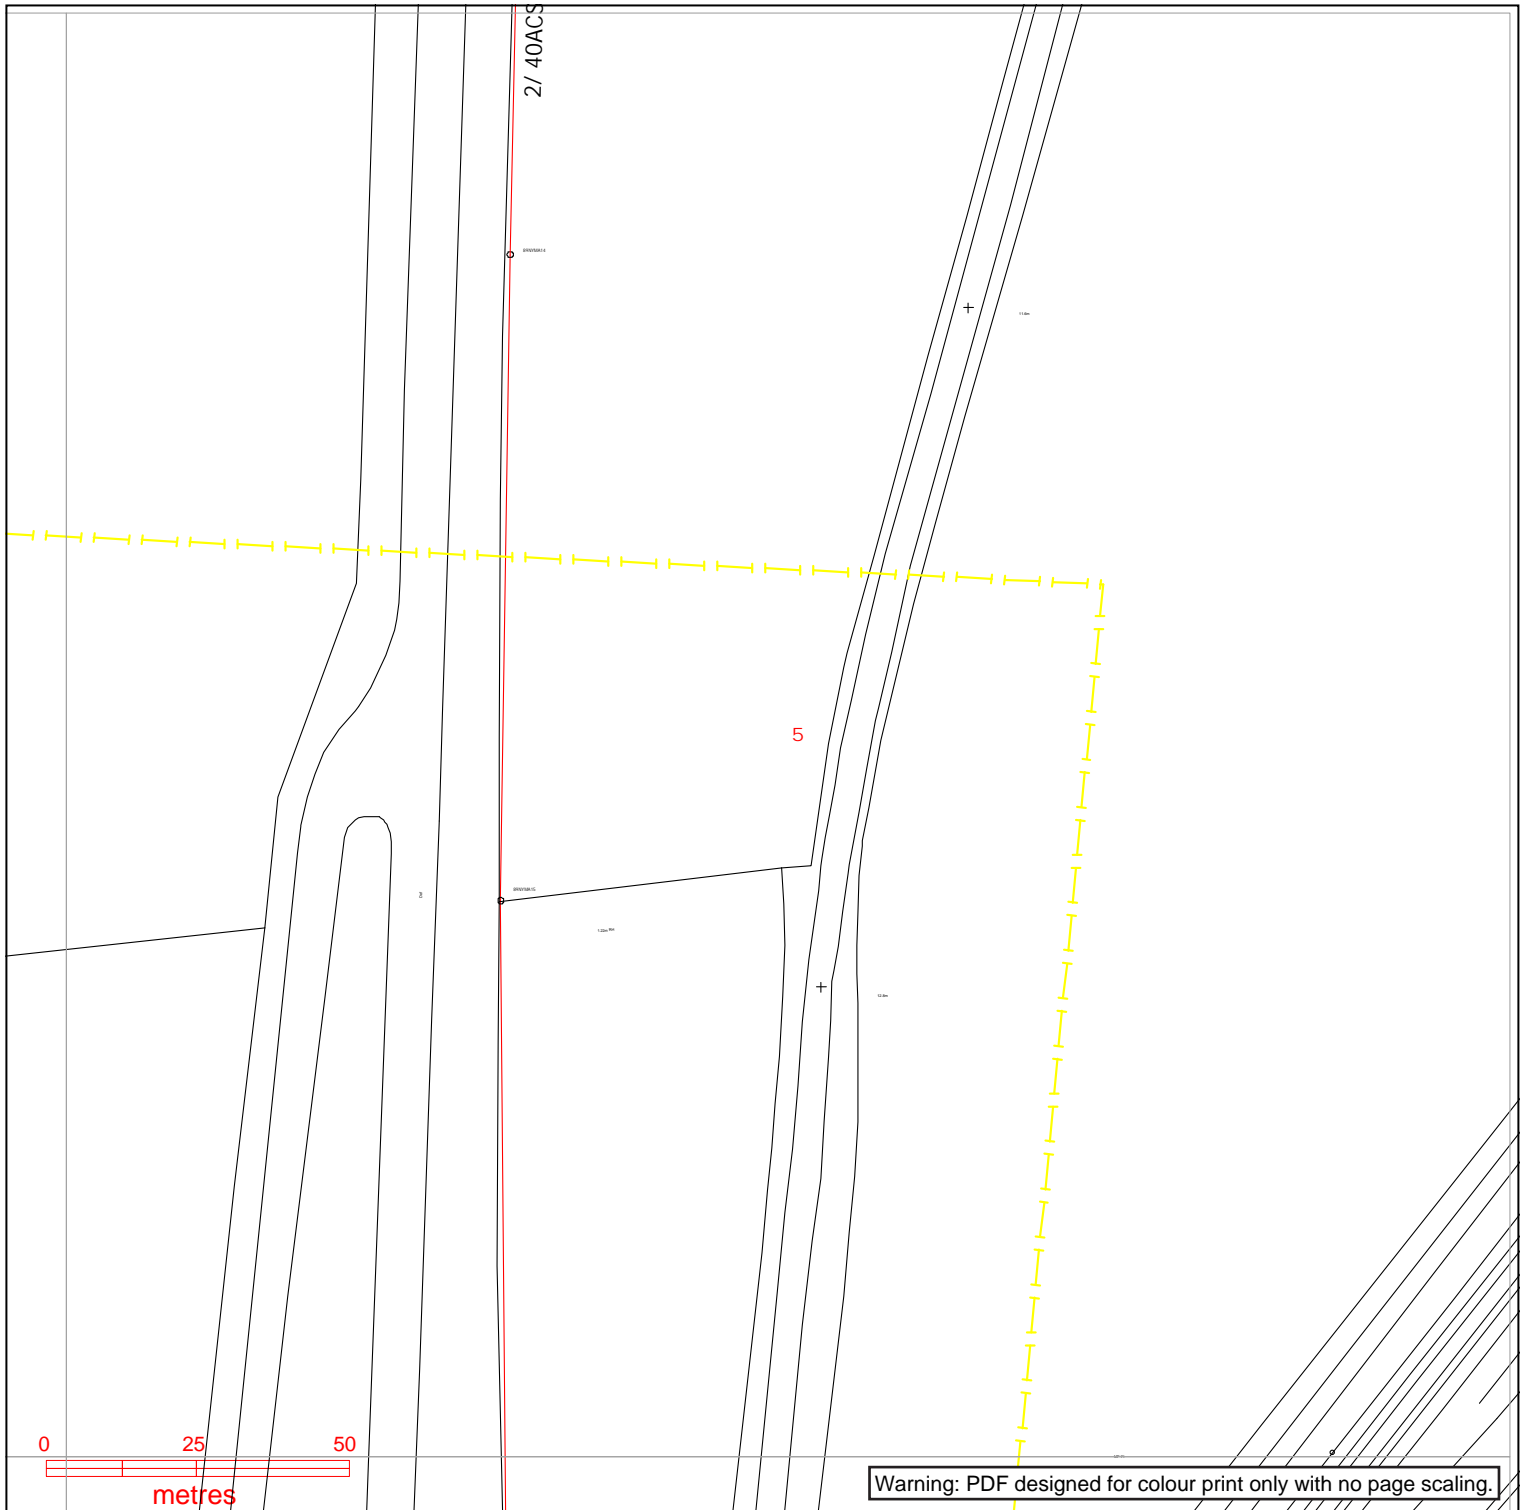

nationalgrid Electricity Distribution

Contact Us

Mapping Enquiries:
All areas 0121 623 9780

General Enquiries:
All areas 0800 096 3080

Date Requested: 08/05/2023
Job Reference: 29406951
Site Location: 478133 385117
Requested by:
Mr Ben Evans
Your Scheme/Reference:
LM 203570/DK - 12

Exact Scales:
1:1250 Area or Circle dig site
1:500 Line dig site


Link Box ●	Overhead Line ○ ○ PL ○ ○ Service ○ ○ LV ○ ○ HV (11kV) ○ ○ HV (33kV) ○ ○ HV (66kV) ○ ○ HV (132kV)	Underground Cable -	National Grid Telecoms - - - - - PME Earth - E - Underground Earth	Pilot Cables - - - - - ○ Pole Mounted Transformer □ Ground Mounted Transformer
----------------------	--	---	---	--

IMPORTANT NOTICES

- This information is given as a guide only and its accuracy cannot be guaranteed. Services or recent additions to the network may not be shown.
- Cables, overhead lines & substations owned by other electricity network owners or private companies may be present and may not be shown.
- You should always verify exact locations of cables using a cable locator and by careful use of hand tools in accordance with HSE guidance note HSG47.
- When working within 10m of any overhead electric line you should follow the requirements of HSE Guidance Note GS6.
- For further advice on working near our electricity cables or lines, call our General Enquiries number.
- Advice should be sought from the National Grid Electricity Distribution General Enquiries team for any work that is to take place in proximity to 132kV underground cables and 132kV overhead lines.

Report damage immediately – KEEP EVERYONE AWAY FROM THE AREA
0800 6783 105

Crown Copyright © All Rights Reserved. Ordnance Survey Licence numbers: 100022432
NGED Copyright: This copy has been made by or with the authority of National Grid Electricity Distribution (NGED) pursuant to Section 47 of the Copyright Designs and Patents Act 1988 unless that Act provides a relevant exception to copyright the copy must not be copied without the prior permission of the copyright owner.

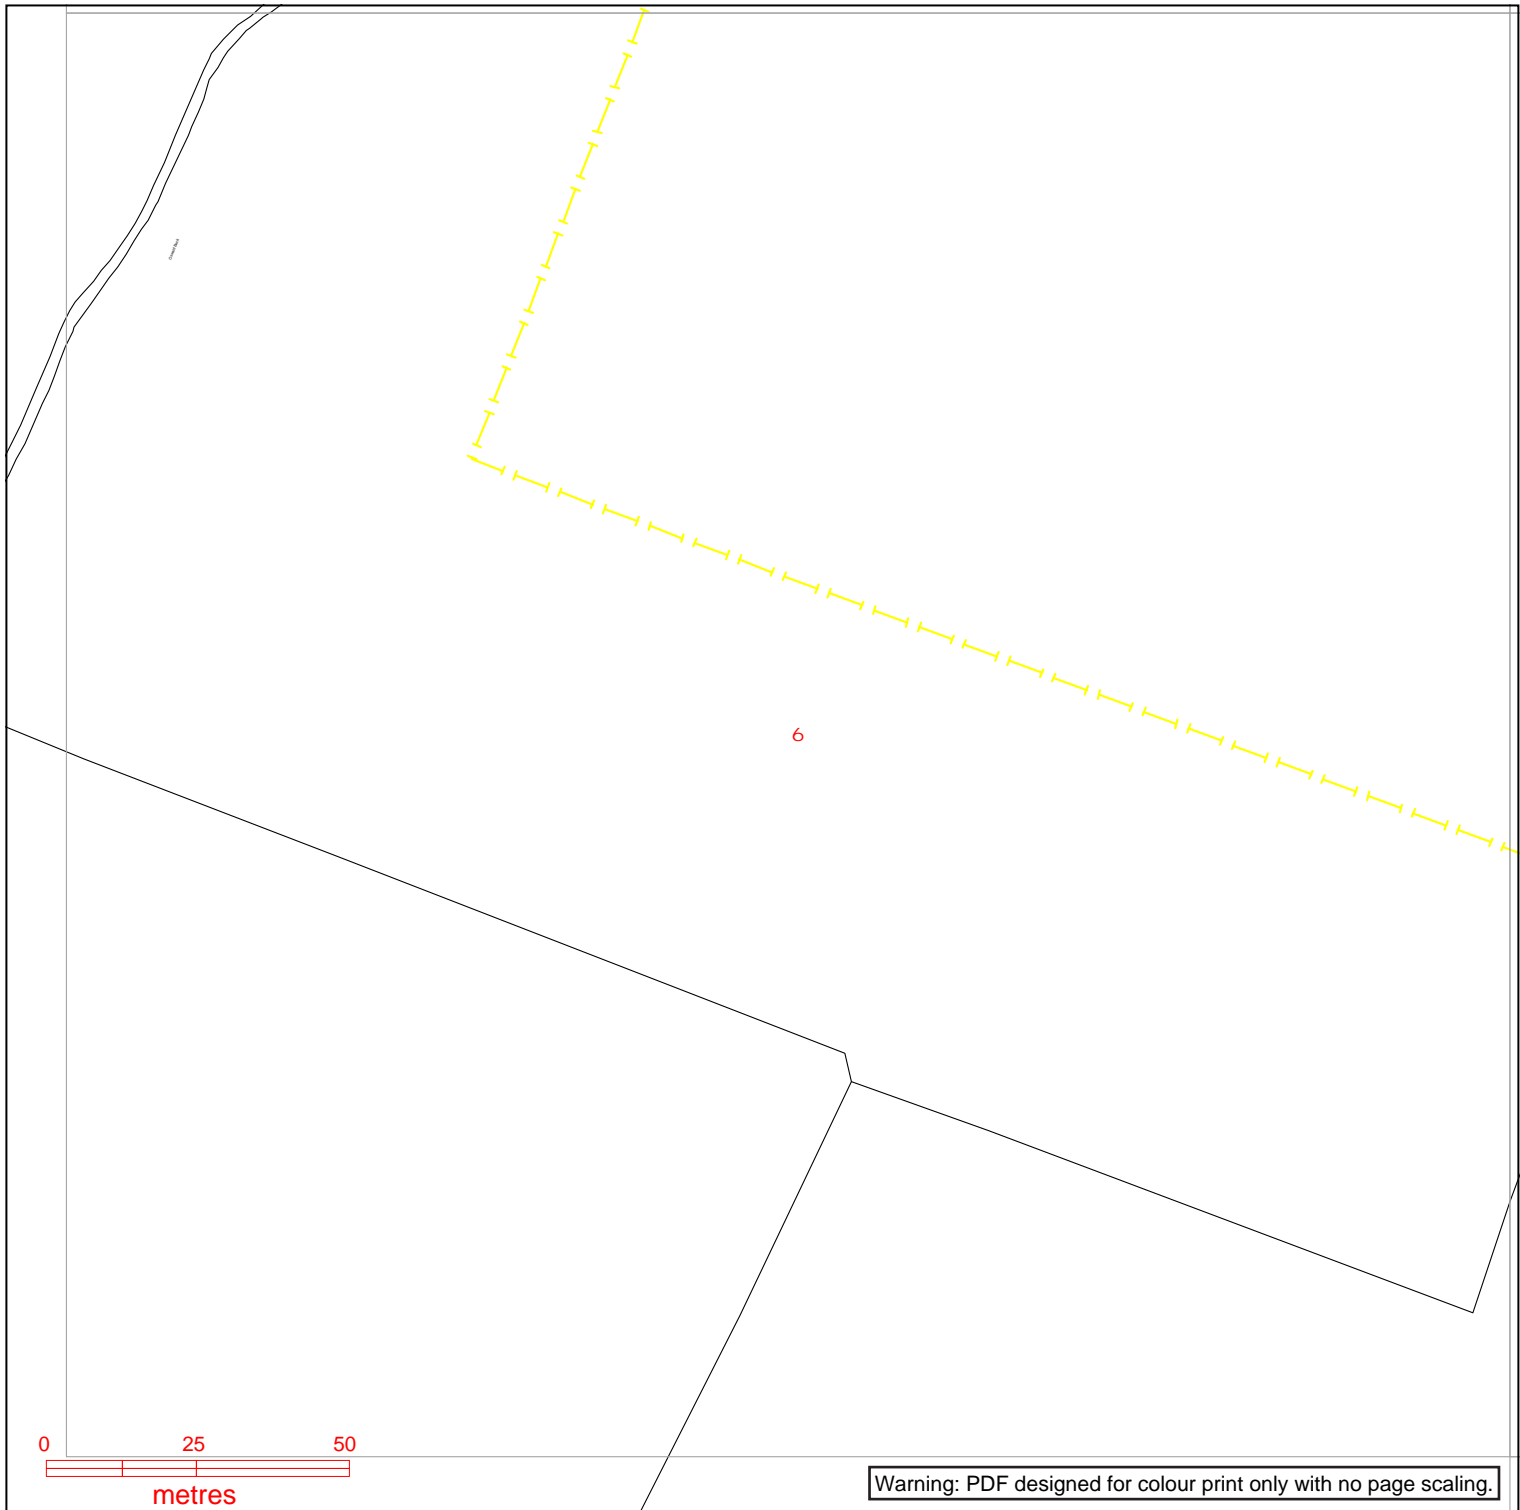

Warning: PDF designed for colour print only with no page scaling.

nationalgrid Electricity Distribution

Contact Us

Mapping Enquiries:
All areas 0121 623 9780

General Enquiries:
All areas 0800 096 3080

Date Requested: 08/05/2023
Job Reference: 29406951
Site Location: 478133 385117
Requested by:
Mr Ben Evans
Your Scheme/Reference:
LM 203570/DK - 12

Exact Scales:
1:1250 Area or Circle dig site
1:500 Line dig site


Link Box ●	Overhead Line ○—○ PL ○—○ Service ○—○ LV ○—○ HV (11kV) ○—○ HV (33kV) ○—○ HV (66kV) ○—○ HV (132kV)	Underground Cable -	National Grid Telecoms - - - - - PME Earth Underground Earth	Pilot Cables ○ □ Pole Mounted Transformer Ground Mounted Transformer
----------------------	--	---	--	---

IMPORTANT NOTICES

- This information is given as a guide only and its accuracy cannot be guaranteed. Services or recent additions to the network may not be shown.
- Cables, overhead lines & substations owned by other electricity network owners or private companies may be present and may not be shown.
- You should always verify exact locations of cables using a cable locator and by careful use of hand tools in accordance with HSE guidance note HSG47.
- When working within 10m of any overhead electric line you should follow the requirements of HSE Guidance Note GS6.
- For further advice on working near our electricity cables or lines, call our General Enquiries number.
- Advice should be sought from the National Grid Electricity Distribution General Enquiries team for any work that is to take place in proximity to 132kV underground cables and 132kV overhead lines.

Report damage immediately – KEEP EVERYONE AWAY FROM THE AREA
0800 6783 105

Crown Copyright © All Rights Reserved. Ordnance Survey Licence numbers: 100022432
NGED Copyright: This copy has been made by or with the authority of National Grid Electricity Distribution (NGED) pursuant to Section 47 of the Copyright Designs and Patents Act 1988 unless that Act provides a relevant exception to copyright the copy must not be copied without the prior permission of the copyright owner.

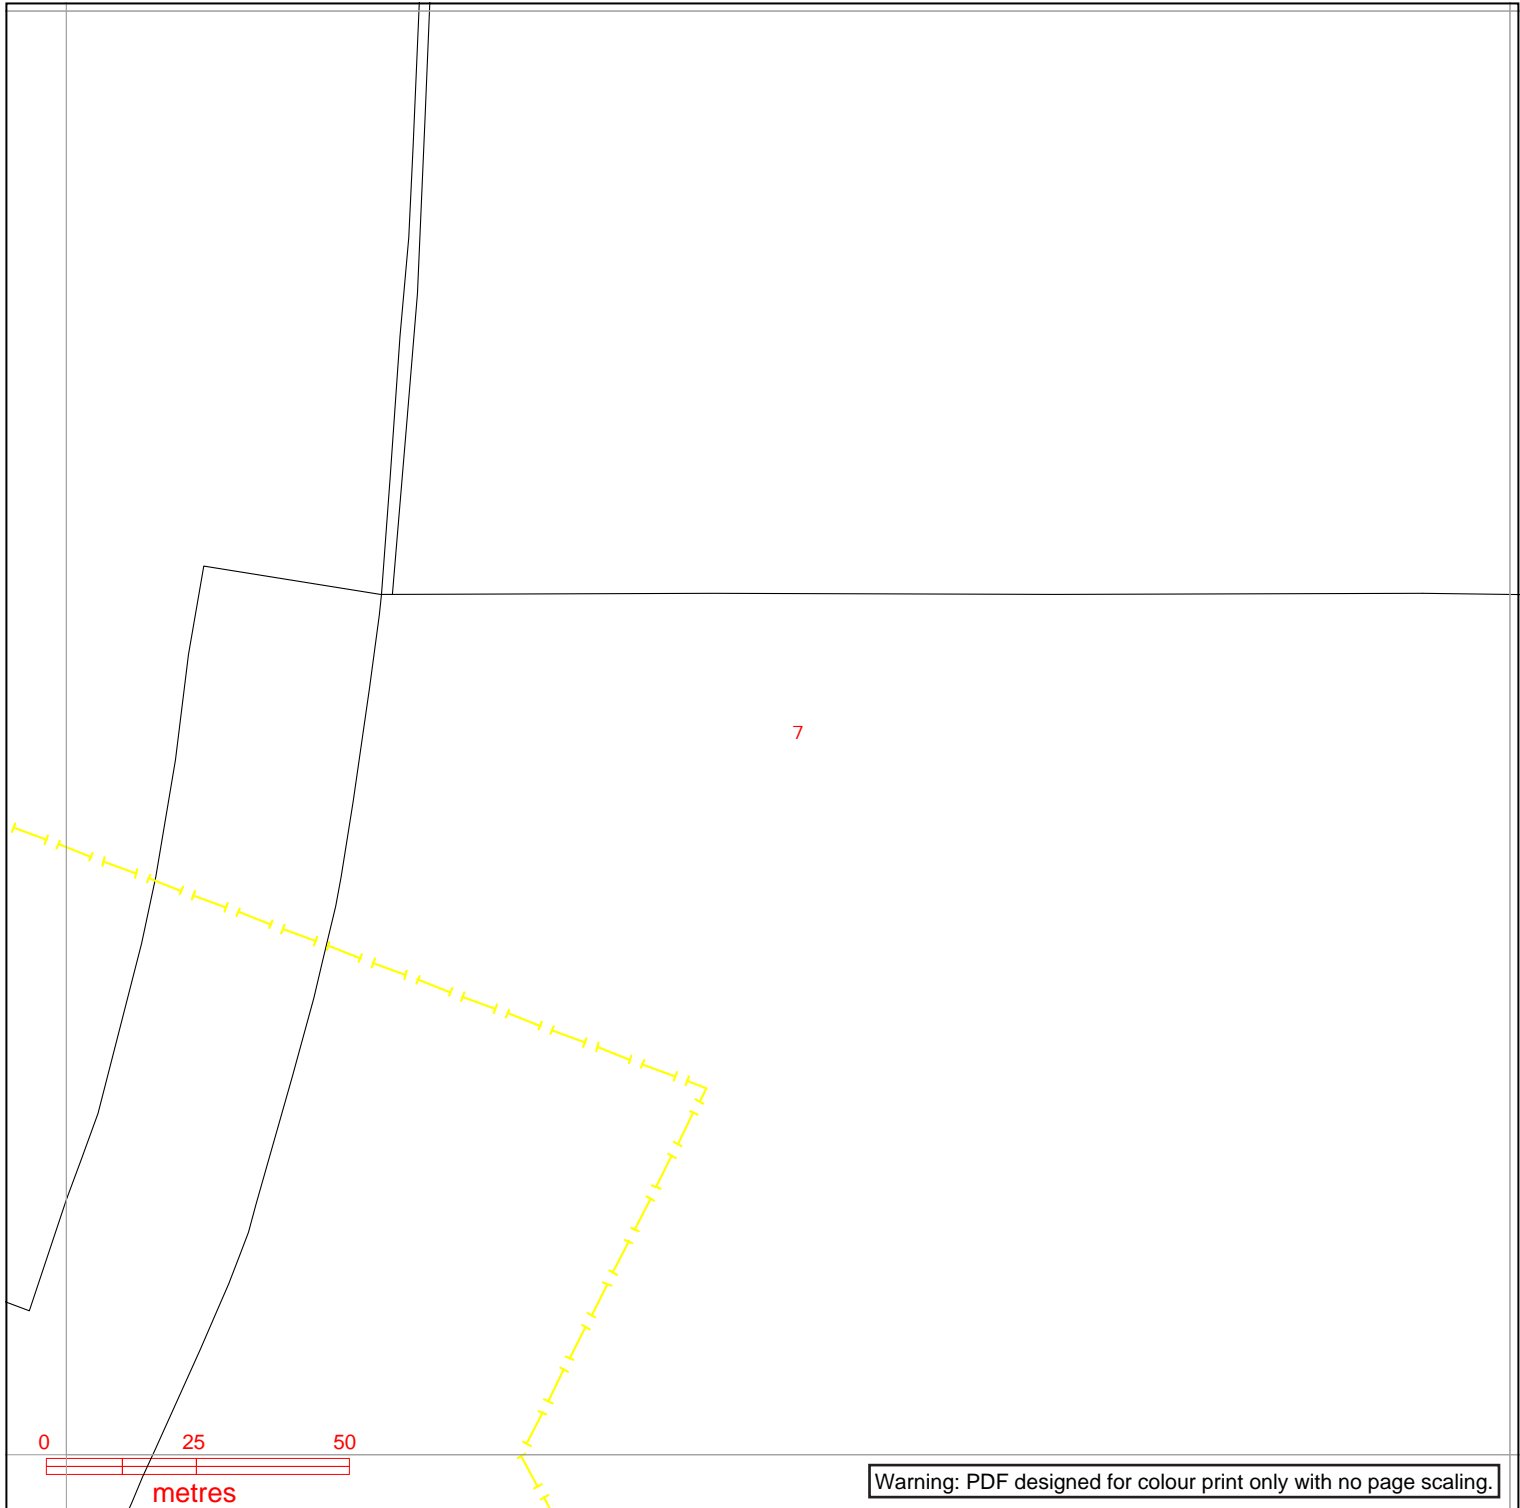

Warning: PDF designed for colour print only with no page scaling.

nationalgrid Electricity Distribution

Contact Us

Mapping Enquiries:
All areas 0121 623 9780

General Enquiries:
All areas 0800 096 3080

Date Requested: 08/05/2023
Job Reference: 29406951
Site Location: 478133 385117
Requested by:
Mr Ben Evans
Your Scheme/Reference:
LM 203570/DK - 12

Exact Scales:
1:1250 Area or Circle dig site
1:500 Line dig site


Link Box ●	Overhead Line ○ ○ PL ○ ○ Service ○ ○ LV ○ ○ HV (11kV) ○ ○ HV (33kV) ○ ○ HV (66kV) ○ ○ HV (132kV)	Underground Cable -	National Grid Telecoms - - - - - PME Earth -E- - - - - Underground Earth	Pilot Cables - - - - - ○ Pole Mounted Transformer □ Ground Mounted Transformer
----------------------	--	---	---	--

IMPORTANT NOTICES

- This information is given as a guide only and its accuracy cannot be guaranteed. Services or recent additions to the network may not be shown.
- Cables, overhead lines & substations owned by other electricity network owners or private companies may be present and may not be shown.
- You should always verify exact locations of cables using a cable locator and by careful use of hand tools in accordance with HSE guidance note HSG47.
- When working within 10m of any overhead electric line you should follow the requirements of HSE Guidance Note GS6.
- For further advice on working near our electricity cables or lines, call our General Enquiries number.
- Advice should be sought from the National Grid Electricity Distribution General Enquiries team for any work that is to take place in proximity to 132kV underground cables and 132kV overhead lines.

Report damage immediately – KEEP EVERYONE AWAY FROM THE AREA
0800 6783 105

Crown Copyright © All Rights Reserved. Ordnance Survey Licence numbers: 100022432
NGED Copyright: This copy has been made by or with the authority of National Grid Electricity Distribution (NGED) pursuant to Section 47 of the Copyright Designs and Patents Act 1988 unless that Act provides a relevant exception to copyright the copy must not be copied without the prior permission of the copyright owner.

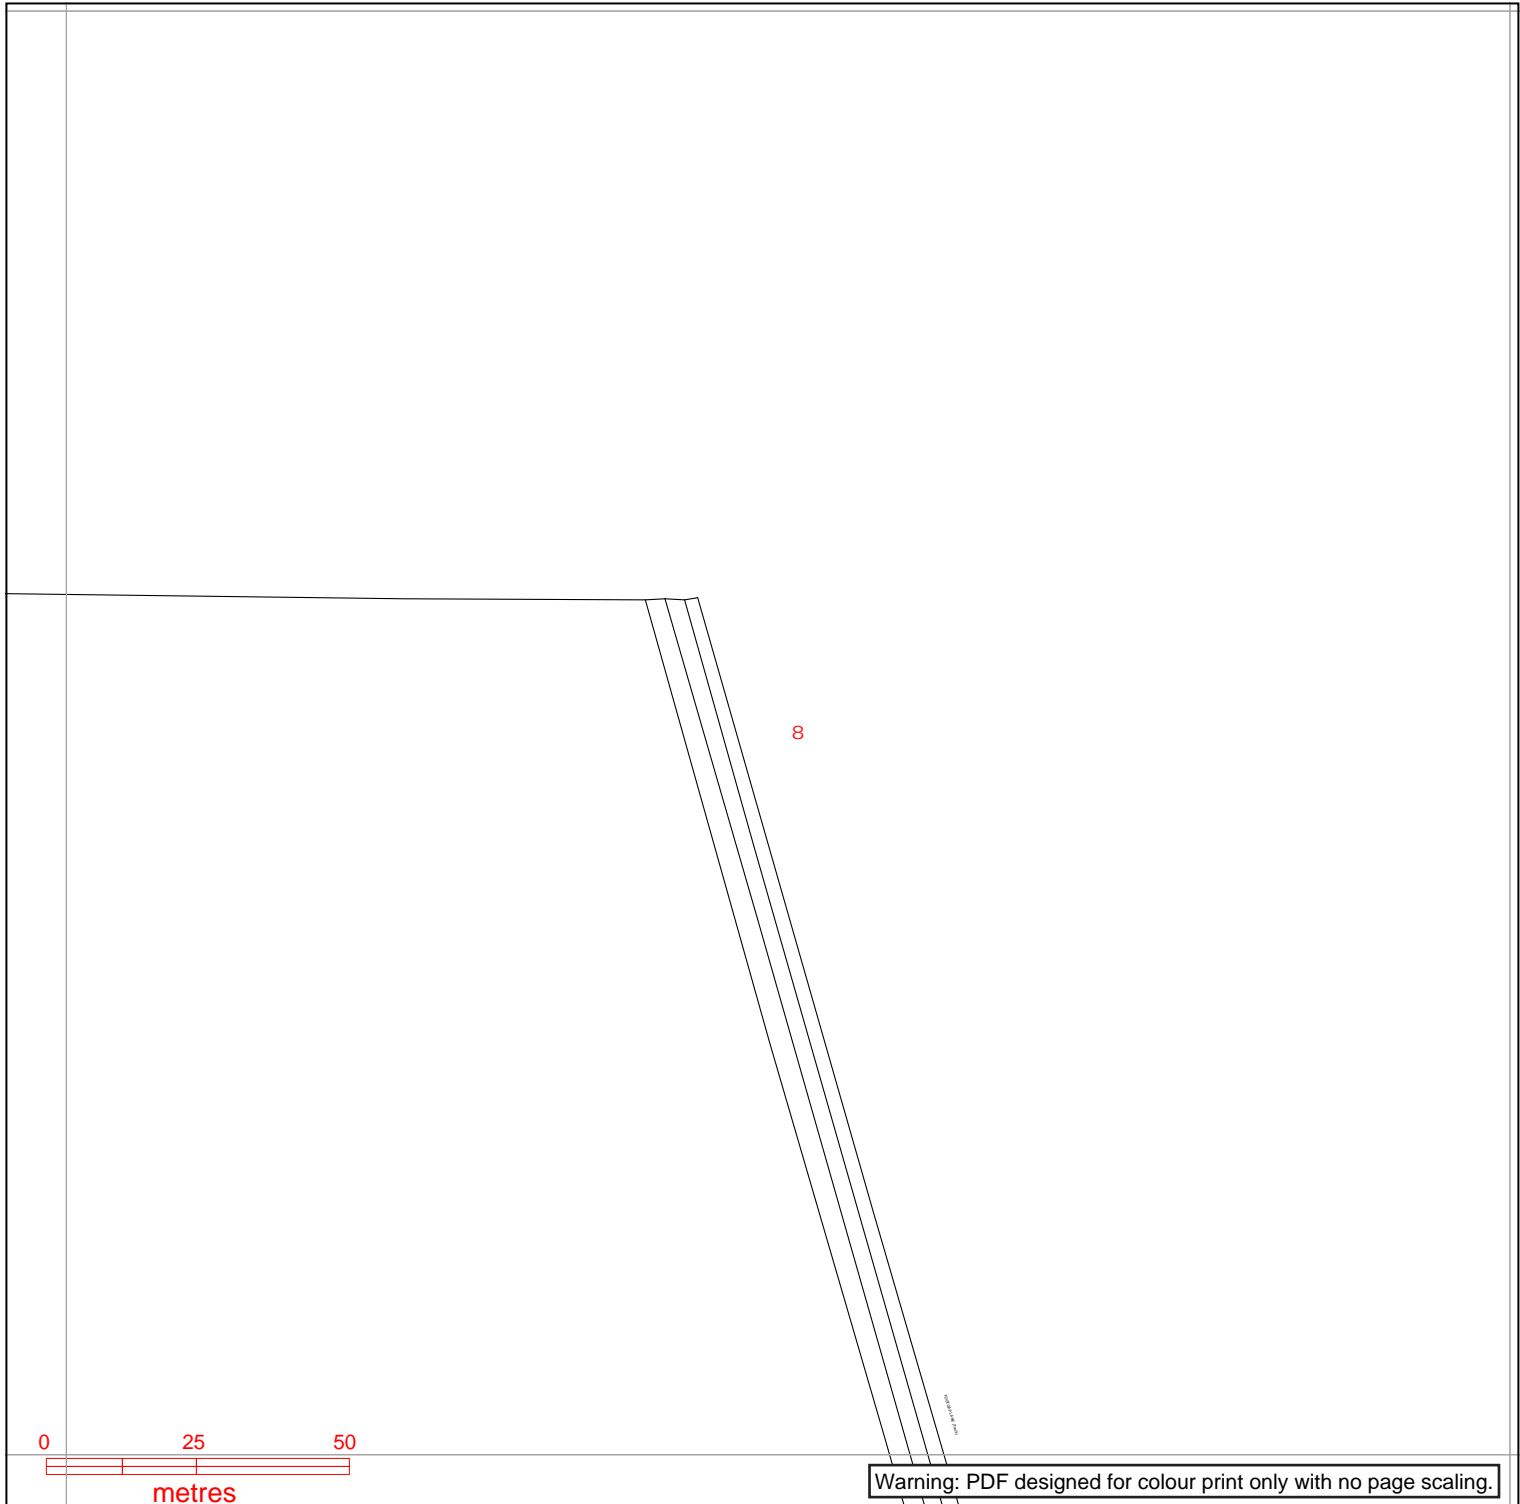

nationalgrid Electricity Distribution

Contact Us

Mapping Enquiries:
All areas 0121 623 9780

General Enquiries:
All areas 0800 096 3080

Date Requested: 08/05/2023
Job Reference: 29406951
Site Location: 478133 385117
Requested by:
Mr Ben Evans
Your Scheme/Reference:
LM 203570/DK - 12

Exact Scales:
1:1250 Area or Circle dig site
1:500 Line dig site

Link Box ●	Overhead Line ○—○ PL ○—○ Service ○—○ LV ○—○ HV (11kV) ○—○ HV (33kV) ○—○ HV (66kV) □—□ HV (132kV)	Underground Cable -	National Grid Telecoms - - - - - -E- - - - - -E- - - - -	Pilot Cables ○ □
Site Location Line/Area 			PME Earth	Pole Mounted Transformer
			Underground Earth	Ground Mounted Transformer

IMPORTANT NOTICES

- This information is given as a guide only and its accuracy cannot be guaranteed. Services or recent additions to the network may not be shown.
- Cables, overhead lines & substations owned by other electricity network owners or private companies may be present and may not be shown.
- You should always verify exact locations of cables using a cable locator and by careful use of hand tools in accordance with HSE guidance note HSG47.
- When working within 10m of any overhead electric line you should follow the requirements of HSE Guidance Note GS6.
- For further advice on working near our electricity cables or lines, call our General Enquiries number.
- Advice should be sought from the National Grid Electricity Distribution General Enquiries team for any work that is to take place in proximity to 132kV underground cables and 132kV overhead lines.

Report damage immediately – KEEP EVERYONE AWAY FROM THE AREA
0800 6783 105

Crown Copyright © All Rights Reserved. Ordnance Survey Licence numbers: 100022432
NGED Copyright: This copy has been made by or with the authority of National Grid Electricity Distribution (NGED) pursuant to Section 47 of the Copyright Designs and Patents Act 1988 unless that Act provides a relevant exception to copyright the copy must not be copied without the prior permission of the copyright owner.



Warning: PDF designed for colour print only with no page scaling.




Contact Us

Mapping Enquiries:
All areas 0121 623 9780

General Enquiries:
All areas 0800 096 3080

Date Requested: 08/05/2023
Job Reference: 29406951
Site Location: 478133 385117
Requested by:
Mr Ben Evans
Your Scheme/Reference:
LM 203570/DK - 12

Exact Scales:
1:1250 Area or Circle dig site
1:500 Line dig site

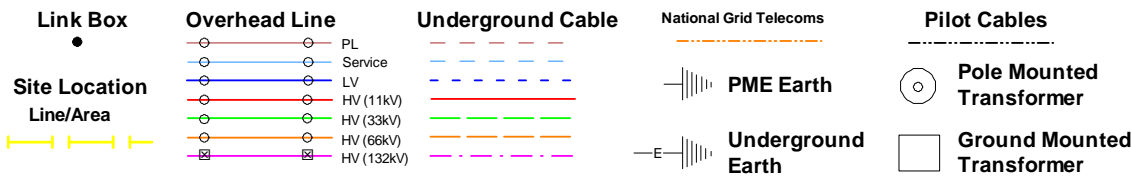


IMPORTANT NOTICES

- This information is given as a guide only and its accuracy cannot be guaranteed. Services or recent additions to the network may not be shown.
- Cables, overhead lines & substations owned by other electricity network owners or private companies may be present and may not be shown.
- You should always verify exact locations of cables using a cable locator and by careful use of hand tools in accordance with HSE guidance note HSG47.
- When working within 10m of any overhead electric line you should follow the requirements of HSE Guidance Note GS6.
- For further advice on working near our electricity cables or lines, call our General Enquiries number.
- Advice should be sought from the National Grid Electricity Distribution General Enquiries team for any work that is to take place in proximity to 132kV underground cables and 132kV overhead lines.

Report damage immediately – KEEP EVERYONE AWAY FROM THE AREA
0800 6783 105

Crown Copyright © All Rights Reserved. Ordnance Survey Licence numbers: 100022432
NGED Copyright: This copy has been made by or with the authority of National Grid Electricity Distribution (NGED) pursuant to Section 47 of the Copyright Designs and Patents Act 1988 unless that Act provides a relevant exception to copyright the copy must not be copied without the prior permission of the copyright owner.

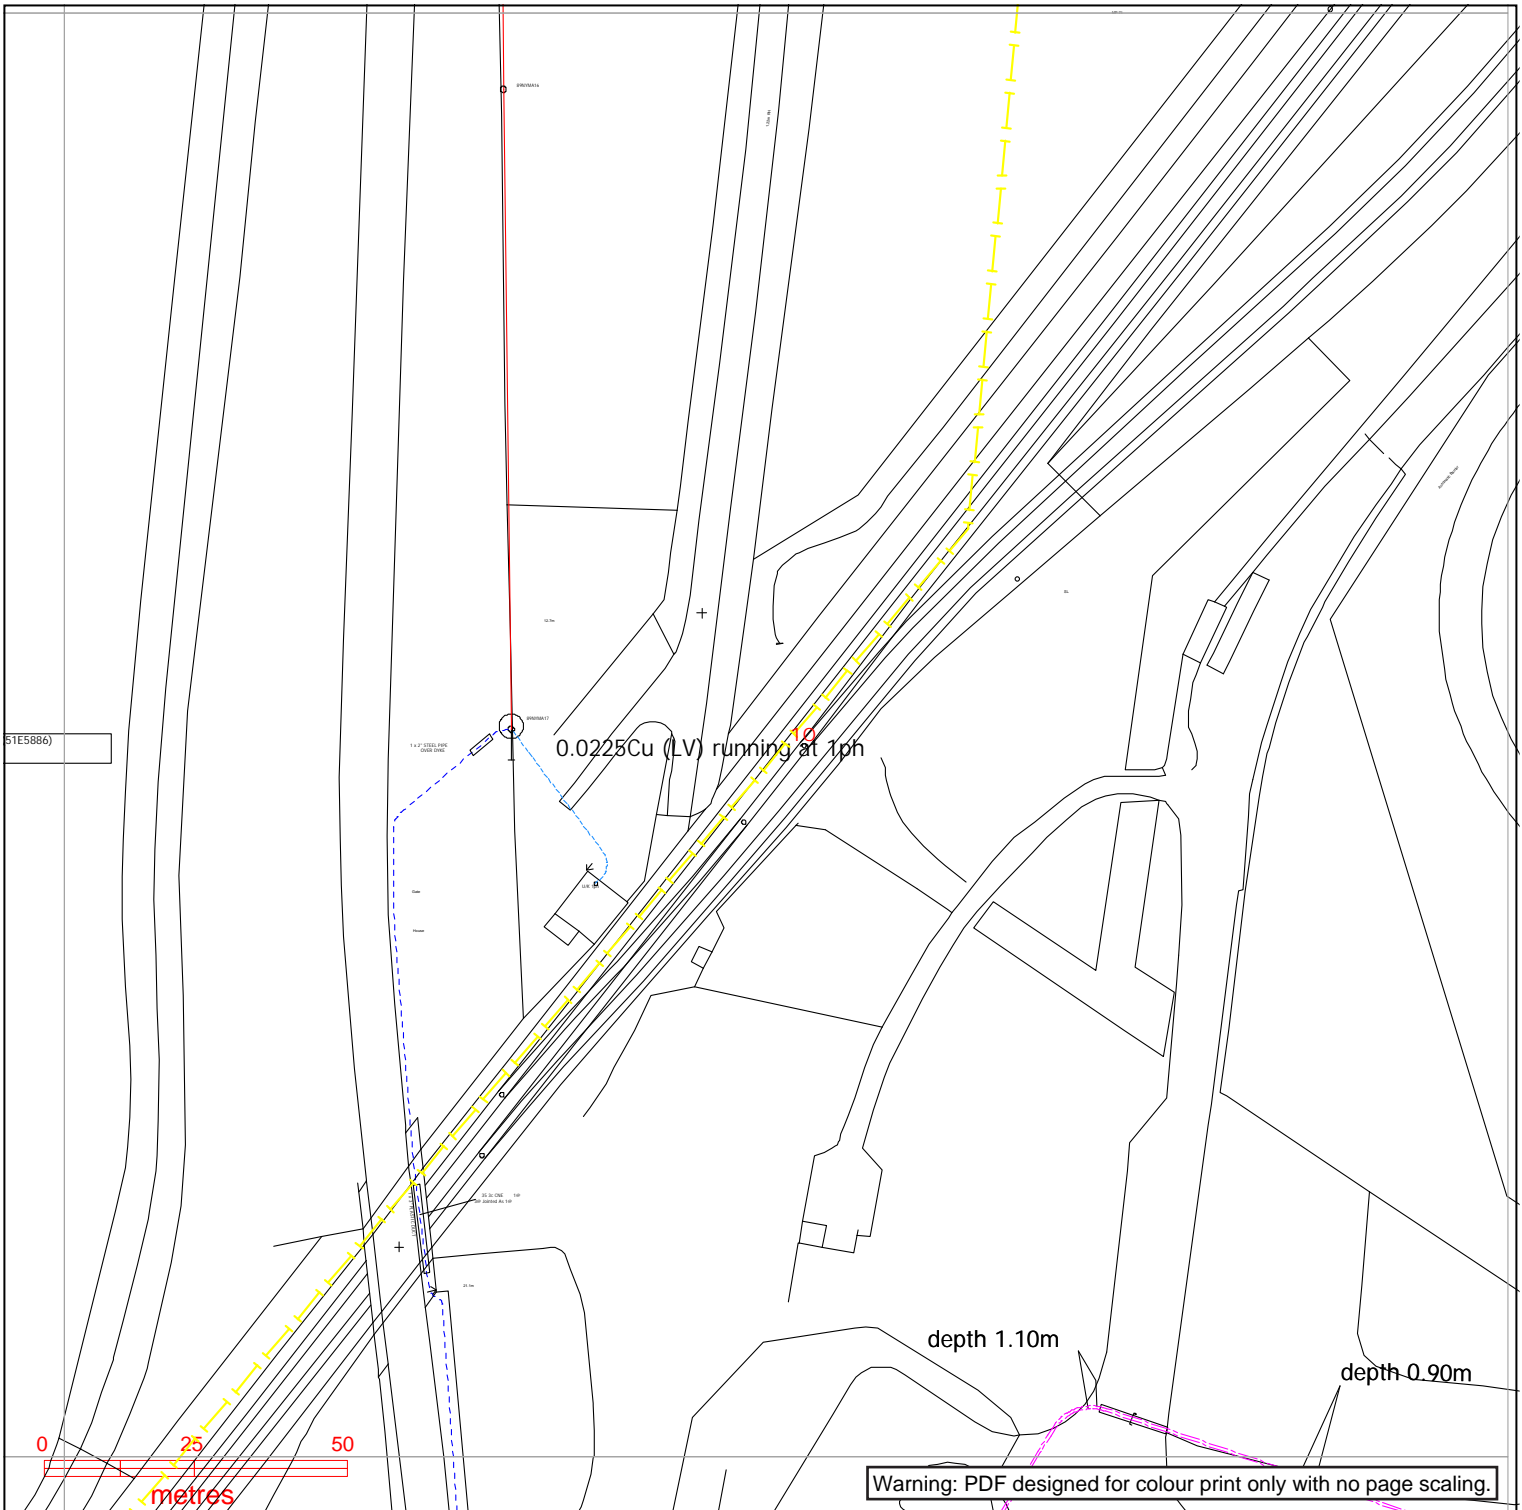

Contact Us
 Mapping Enquiries:
 All areas 0121 623 9780
 General Enquiries:
 All areas 0800 096 3080

Date Requested: 08/05/2023
 Job Reference: 29406951
 Site Location: 478133 385117
 Requested by:
 Mr Ben Evans
 Your Scheme/Reference:
 LM 203570/DK - 12

Exact Scales:
 1:1250 Area or Circle dig site
 1:500 Line dig site


Link Box	Overhead Line	Underground Cable	National Grid Telecoms	Pilot Cables
●	○ PL ○ Service ○ LV ○ HV (11kV) ○ HV (33kV) ○ HV (66kV) ○ HV (132kV)	--- --- --- ---	--- --- --- ---	○ Pole Mounted Transformer □ Ground Mounted Transformer
○ Site Location	○ Line/Area		⎮ PME Earth ⎮ Underground Earth	
---	---			

IMPORTANT NOTICES

- This information is given as a guide only and its accuracy cannot be guaranteed. Services or recent additions to the network may not be shown.
- Cables, overhead lines & substations owned by other electricity network owners or private companies may be present and may not be shown.
- You should always verify exact locations of cables using a cable locator and by careful use of hand tools in accordance with HSE guidance note HSG47.
- When working within 10m of any overhead electric line you should follow the requirements of HSE Guidance Note GS6.
- For further advice on working near our electricity cables or lines, call our General Enquiries number.
- Advice should be sought from the National Grid Electricity Distribution General Enquiries team for any work that is to take place in proximity to 132kV underground cables and 132kV overhead lines.

Report damage immediately – KEEP EVERYONE AWAY FROM THE AREA
0800 6783 105

Crown Copyright © All Rights Reserved. Ordnance Survey Licence numbers: 100022432
 NGED Copyright: This copy has been made by or with the authority of National Grid Electricity Distribution (NGED) pursuant to Section 47 of the Copyright Designs and Patents Act 1988 unless that Act provides a relevant exception to copyright the copy must not be copied without the prior permission of the copyright owner.

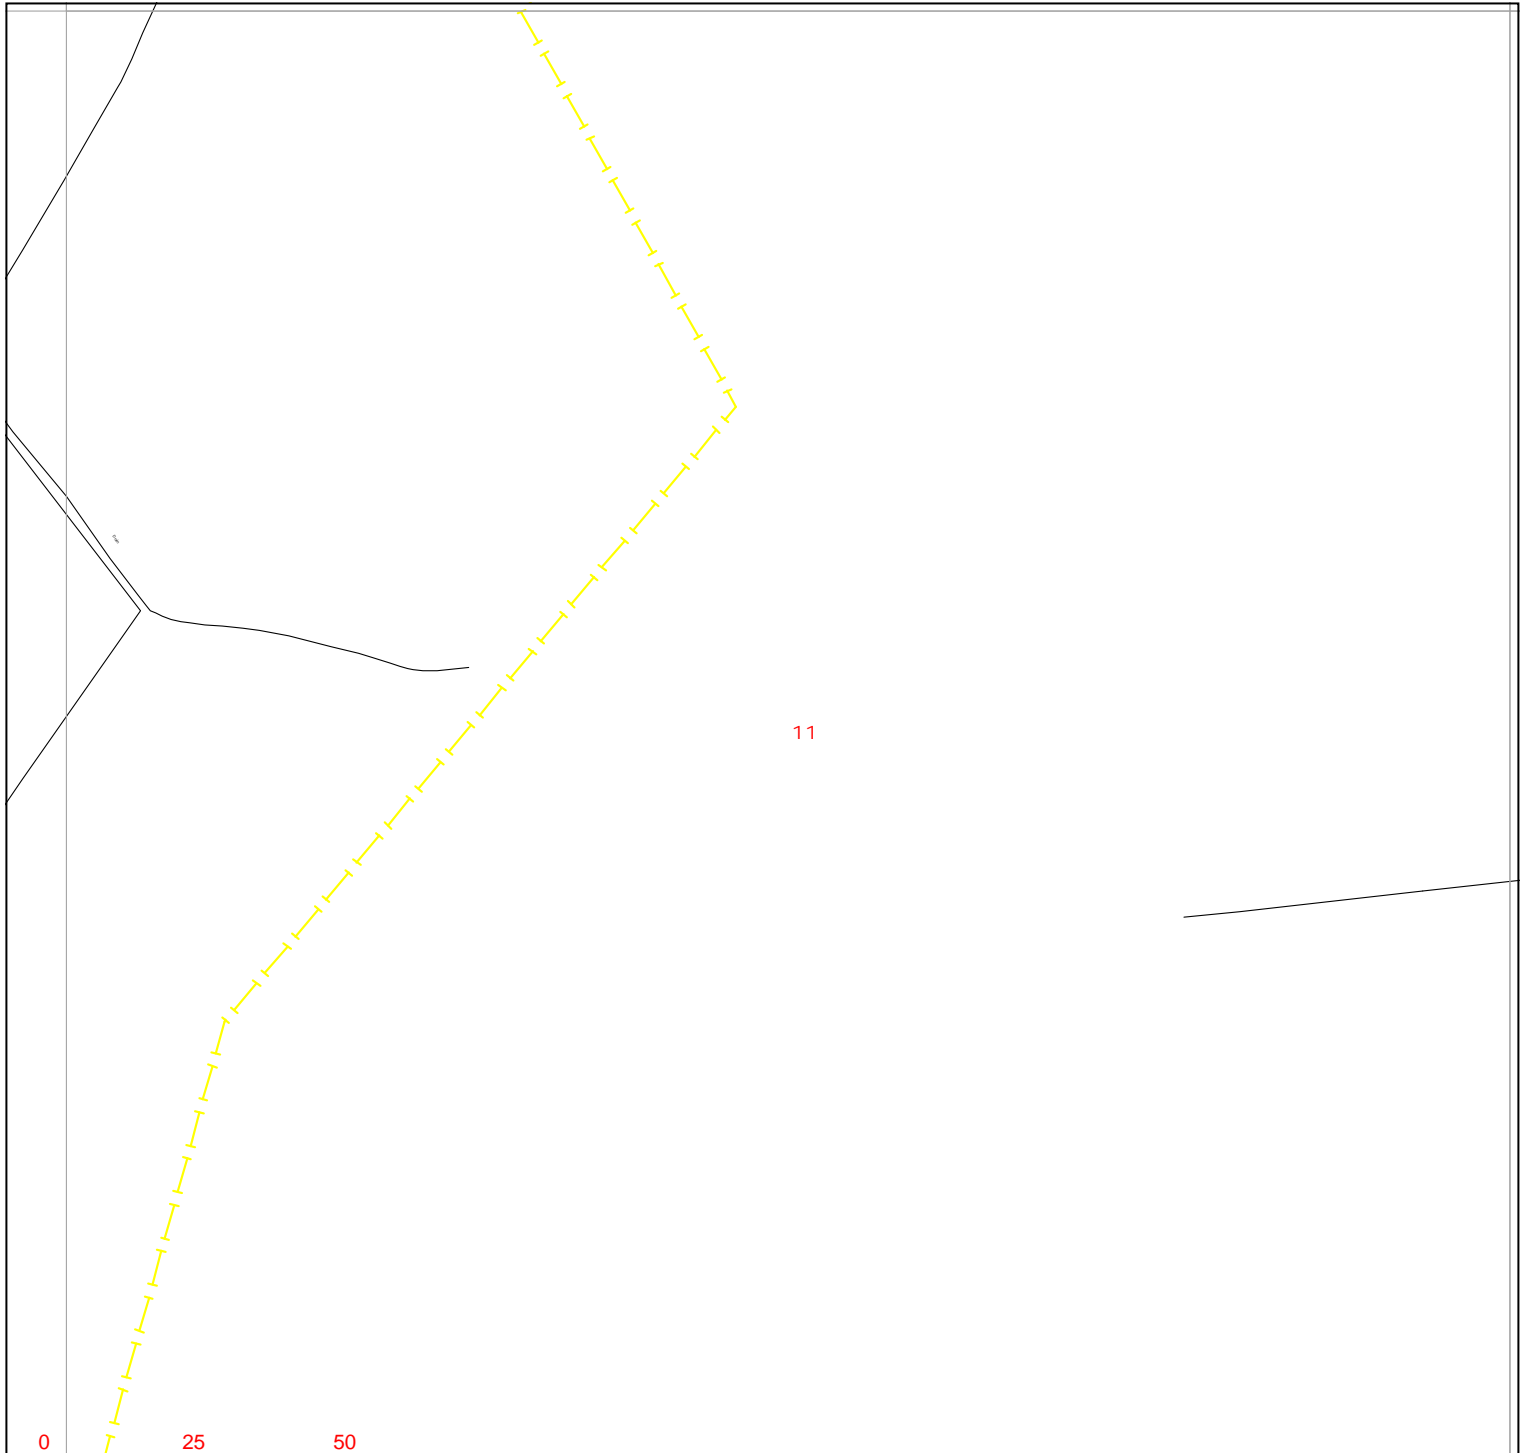

Warning: PDF designed for colour print only with no page scaling.



Contact Us

Mapping Enquiries:
All areas 0121 623 9780

General Enquiries:
All areas 0800 096 3080

Date Requested: 08/05/2023
Job Reference: 29406951
Site Location: 478133 385117
Requested by:
Mr Ben Evans
Your Scheme/Reference:
LM 203570/DK - 12

Exact Scales:
1:1250 Area or Circle dig site
1:500 Line dig site


Link Box ●	Overhead Line ○—○ PL ○—○ Service ○—○ LV ○—○ HV (11kV) ○—○ HV (33kV) ○—○ HV (66kV) ○—○ HV (132kV)	Underground Cable -	National Grid Telecoms - - - - - PME Earth Underground Earth	Pilot Cables ○ Pole Mounted Transformer □ Ground Mounted Transformer
----------------------	--	---	--	---

IMPORTANT NOTICES

- This information is given as a guide only and its accuracy cannot be guaranteed. Services or recent additions to the network may not be shown.
- Cables, overhead lines & substations owned by other electricity network owners or private companies may be present and may not be shown.
- You should always verify exact locations of cables using a cable locator and by careful use of hand tools in accordance with HSE guidance note HSG47.
- When working within 10m of any overhead electric line you should follow the requirements of HSE Guidance Note GS6.
- For further advice on working near our electricity cables or lines, call our General Enquiries number.
- Advice should be sought from the National Grid Electricity Distribution General Enquiries team for any work that is to take place in proximity to 132kV underground cables and 132kV overhead lines.

Report damage immediately – KEEP EVERYONE AWAY FROM THE AREA
0800 6783 105

Crown Copyright © All Rights Reserved. Ordnance Survey Licence numbers: 100022432
NGED Copyright: This copy has been made by or with the authority of National Grid Electricity Distribution (NGED) pursuant to Section 47 of the Copyright Designs and Patents Act 1988 unless that Act provides a relevant exception to copyright the copy must not be copied without the prior permission of the copyright owner.

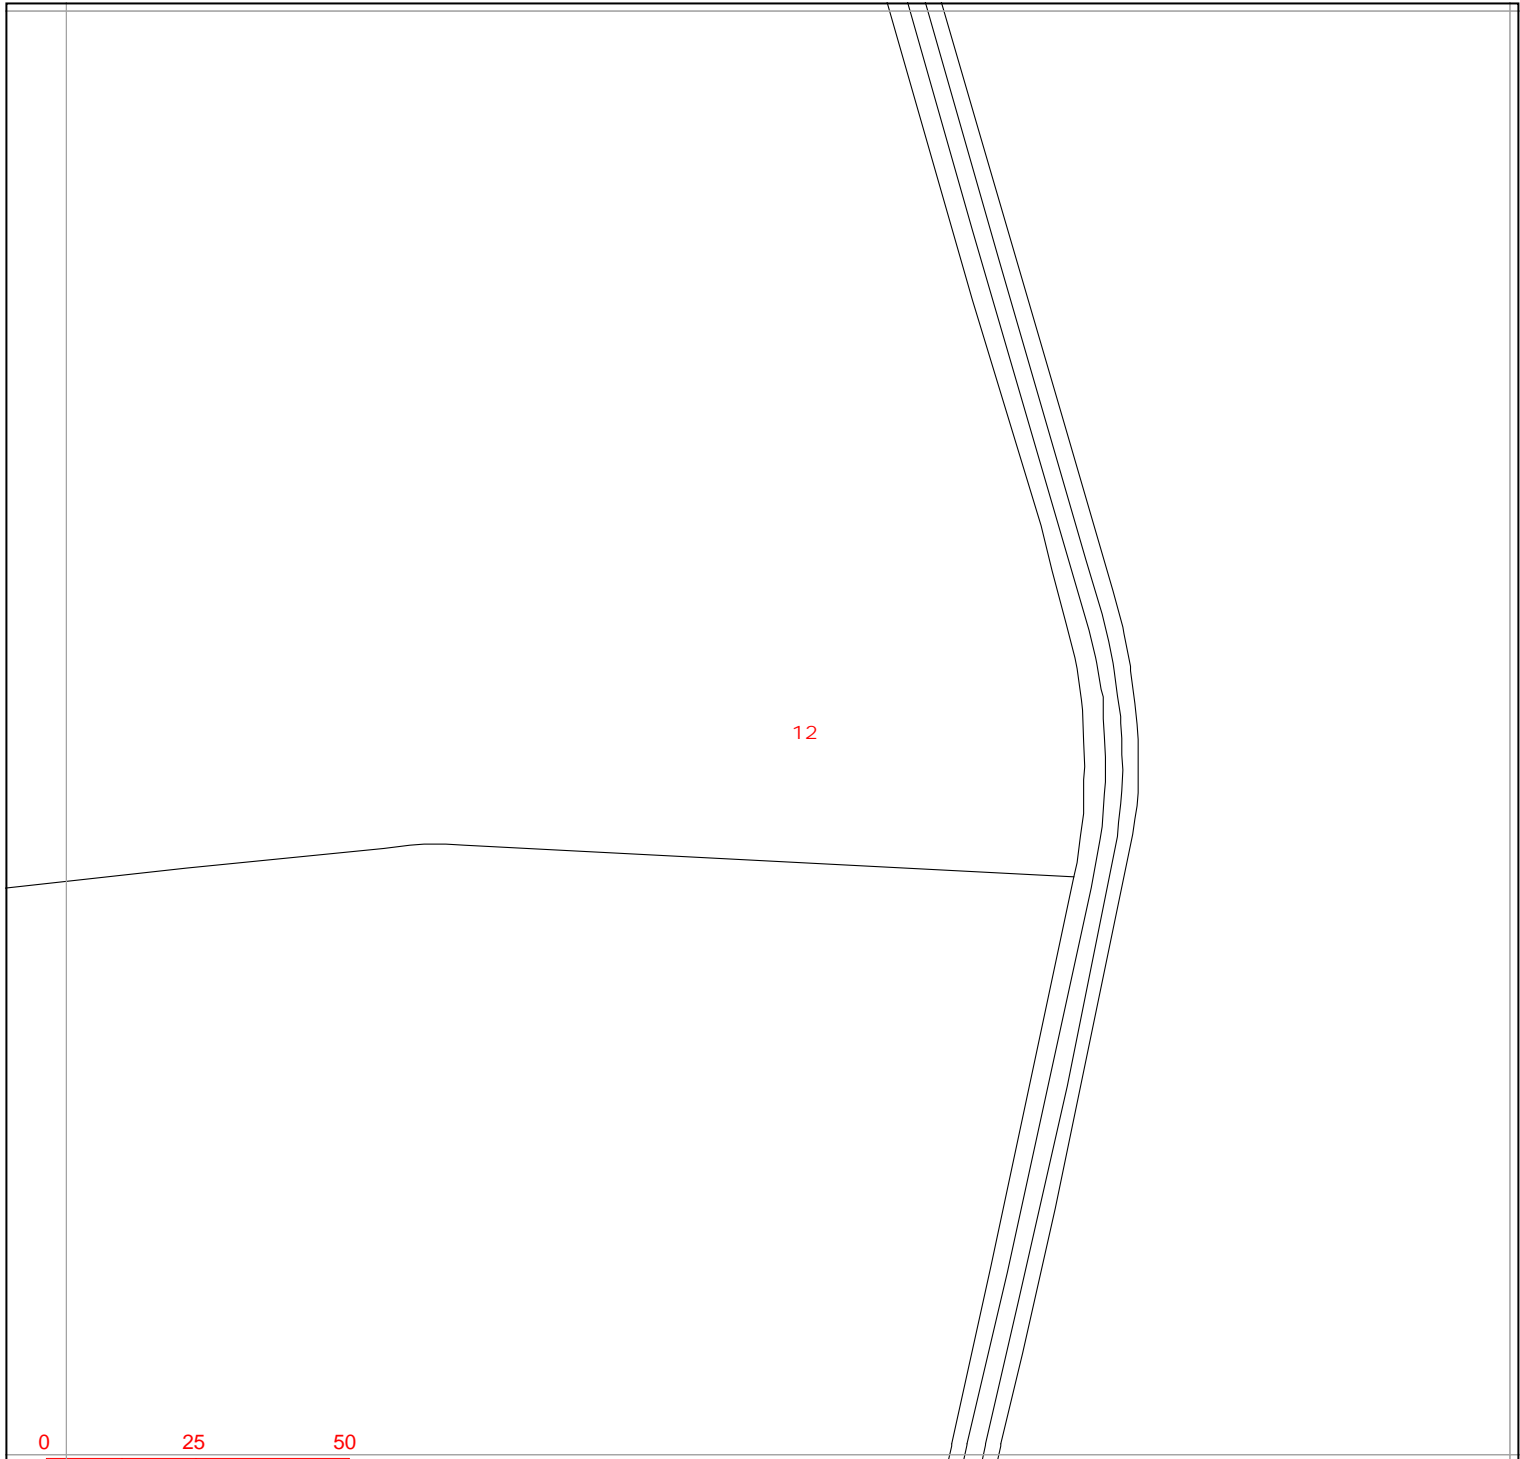

Warning: PDF designed for colour print only with no page scaling.

nationalgrid Electricity Distribution

Contact Us

Mapping Enquiries:
All areas 0121 623 9780

General Enquiries:
All areas 0800 096 3080

Date Requested: 08/05/2023
Job Reference: 29406951
Site Location: 478133 385117
Requested by:
Mr Ben Evans
Your Scheme/Reference:
LM 203570/DK - 12

Exact Scales:
1:1250 Area or Circle dig site
1:500 Line dig site


Link Box ●	Overhead Line ○—○ PL ○—○ Service ○—○ LV ○—○ HV (11kV) ○—○ HV (33kV) ○—○ HV (66kV) □—□ HV (132kV)	Underground Cable -	National Grid Telecoms - - - - - PME Earth -E- - - - - Underground Earth	Pilot Cables ○ Pole Mounted Transformer □ Ground Mounted Transformer
----------------------	--	---	---	---

IMPORTANT NOTICES

- This information is given as a guide only and its accuracy cannot be guaranteed. Services or recent additions to the network may not be shown.
- Cables, overhead lines & substations owned by other electricity network owners or private companies may be present and may not be shown.
- You should always verify exact locations of cables using a cable locator and by careful use of hand tools in accordance with HSE guidance note HSG47.
- When working within 10m of any overhead electric line you should follow the requirements of HSE Guidance Note GS6.
- For further advice on working near our electricity cables or lines, call our General Enquiries number.
- Advice should be sought from the National Grid Electricity Distribution General Enquiries team for any work that is to take place in proximity to 132kV underground cables and 132kV overhead lines.

Report damage immediately – KEEP EVERYONE AWAY FROM THE AREA
0800 6783 105

Crown Copyright © All Rights Reserved. Ordnance Survey Licence numbers: 100022432
NGED Copyright: This copy has been made by or with the authority of National Grid Electricity Distribution (NGED) pursuant to Section 47 of the Copyright Designs and Patents Act 1988 unless that Act provides a relevant exception to copyright the copy must not be copied without the prior permission of the copyright owner.

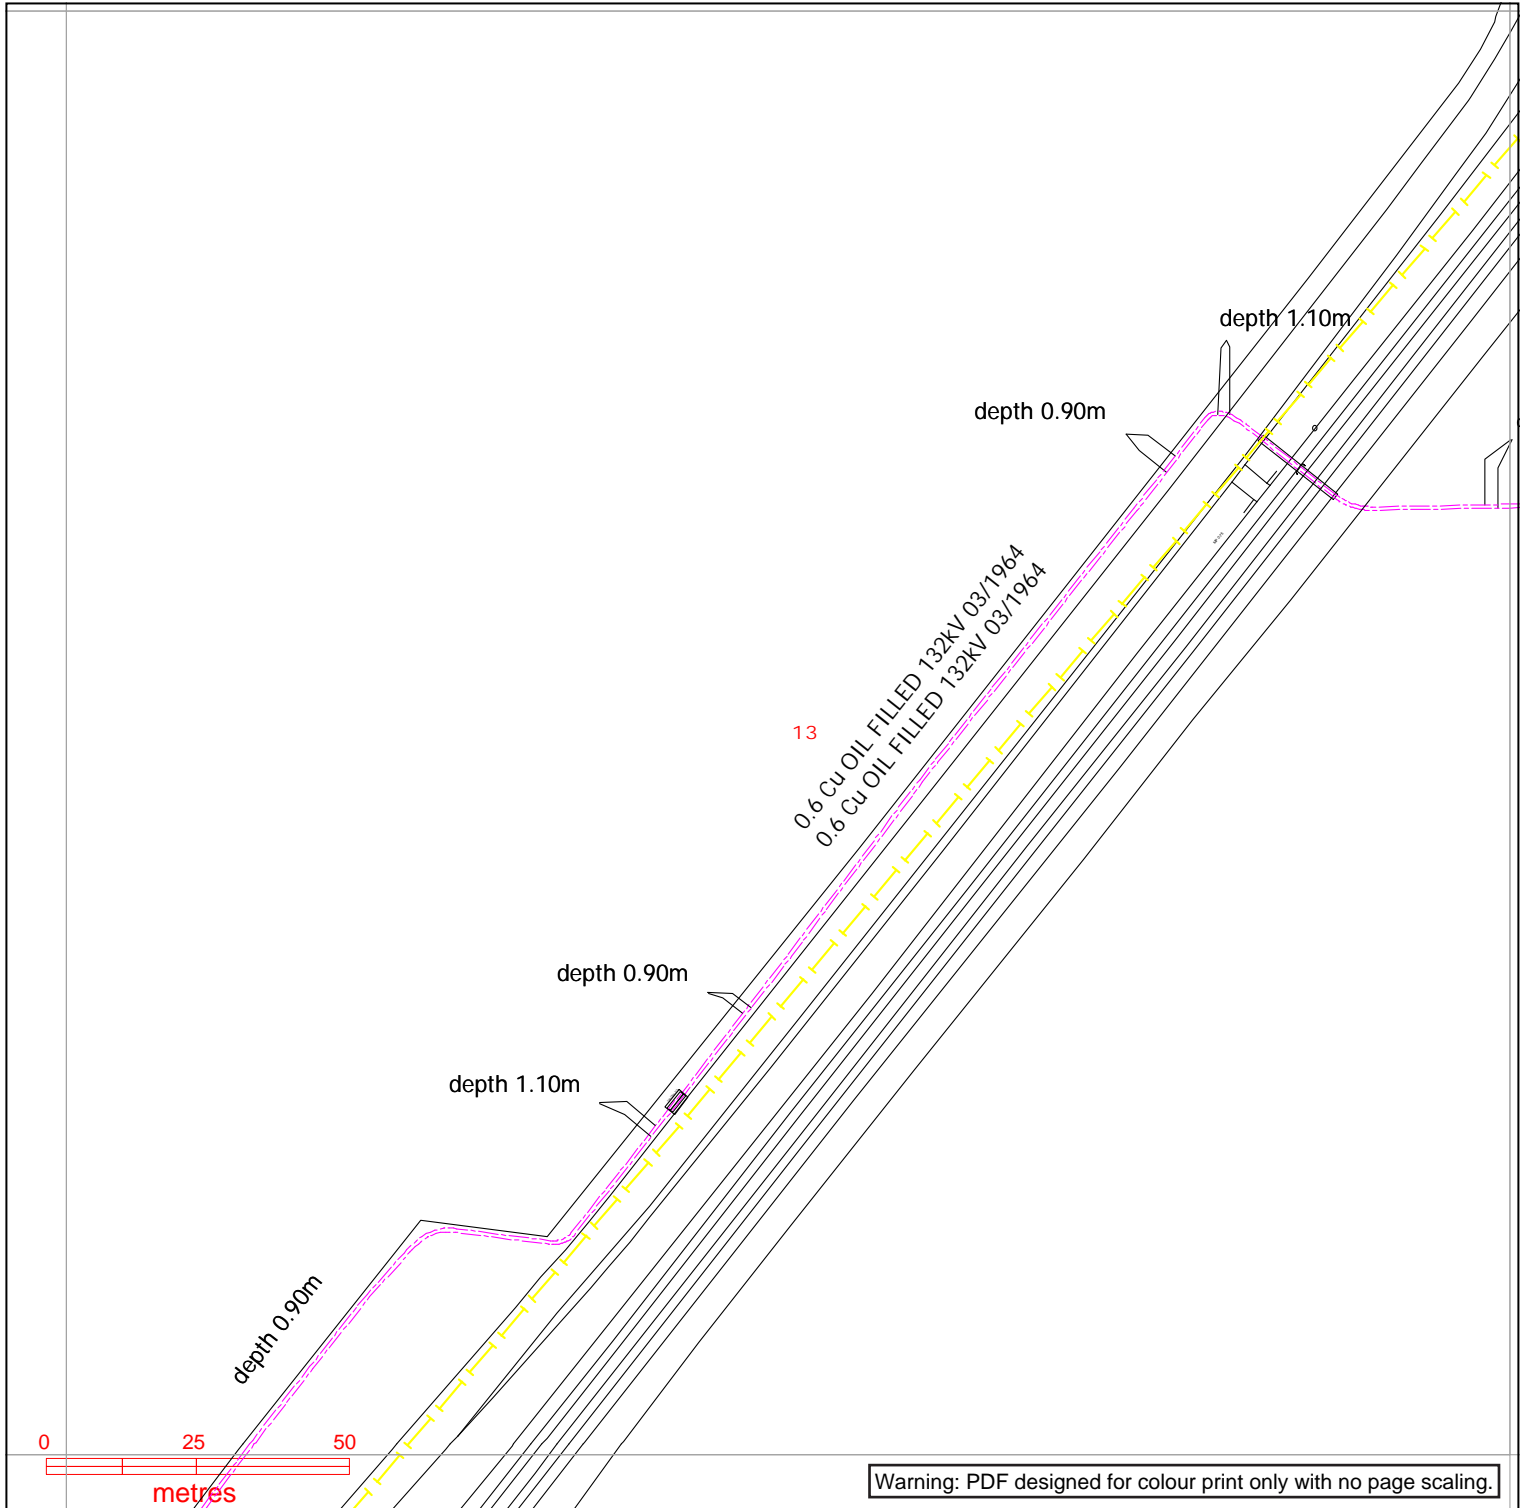

Contact Us
 Mapping Enquiries:
 All areas 0121 623 9780

General Enquiries:
 All areas 0800 096 3080

Date Requested: 08/05/2023
 Job Reference: 29406951
 Site Location: 478133 385117
 Requested by:
 Mr Ben Evans
 Your Scheme/Reference:
 LM 203570/DK - 12

Exact Scales:
 1:1250 Area or Circle dig site
 1:500 Line dig site


Link Box	Overhead Line	Underground Cable	National Grid Telecoms	Pilot Cables
●	○ PL ○ Service ○ LV ○ HV (11kV) ○ HV (33kV) ○ HV (66kV) ○ HV (132kV)	--- --- ---	--- --- ---	○ Pole Mounted Transformer □ Ground Mounted Transformer
●	○	---	⎓ PME Earth ⎓ Underground Earth	

IMPORTANT NOTICES

- This information is given as a guide only and its accuracy cannot be guaranteed. Services or recent additions to the network may not be shown.
- Cables, overhead lines & substations owned by other electricity network owners or private companies may be present and may not be shown.
- You should always verify exact locations of cables using a cable locator and by careful use of hand tools in accordance with HSE guidance note HSG47.
- When working within 10m of any overhead electric line you should follow the requirements of HSE Guidance Note GS6.
- For further advice on working near our electricity cables or lines, call our General Enquiries number.
- Advice should be sought from the National Grid Electricity Distribution General Enquiries team for any work that is to take place in proximity to 132kV underground cables and 132kV overhead lines.

Report damage immediately – KEEP EVERYONE AWAY FROM THE AREA
0800 6783 105

Crown Copyright © All Rights Reserved. Ordnance Survey Licence numbers: 100022432
 NGED Copyright: This copy has been made by or with the authority of National Grid Electricity Distribution (NGED) pursuant to Section 47 of the Copyright Designs and Patents Act 1988 unless that Act provides a relevant exception to copyright the copy must not be copied without the prior permission of the copyright owner.

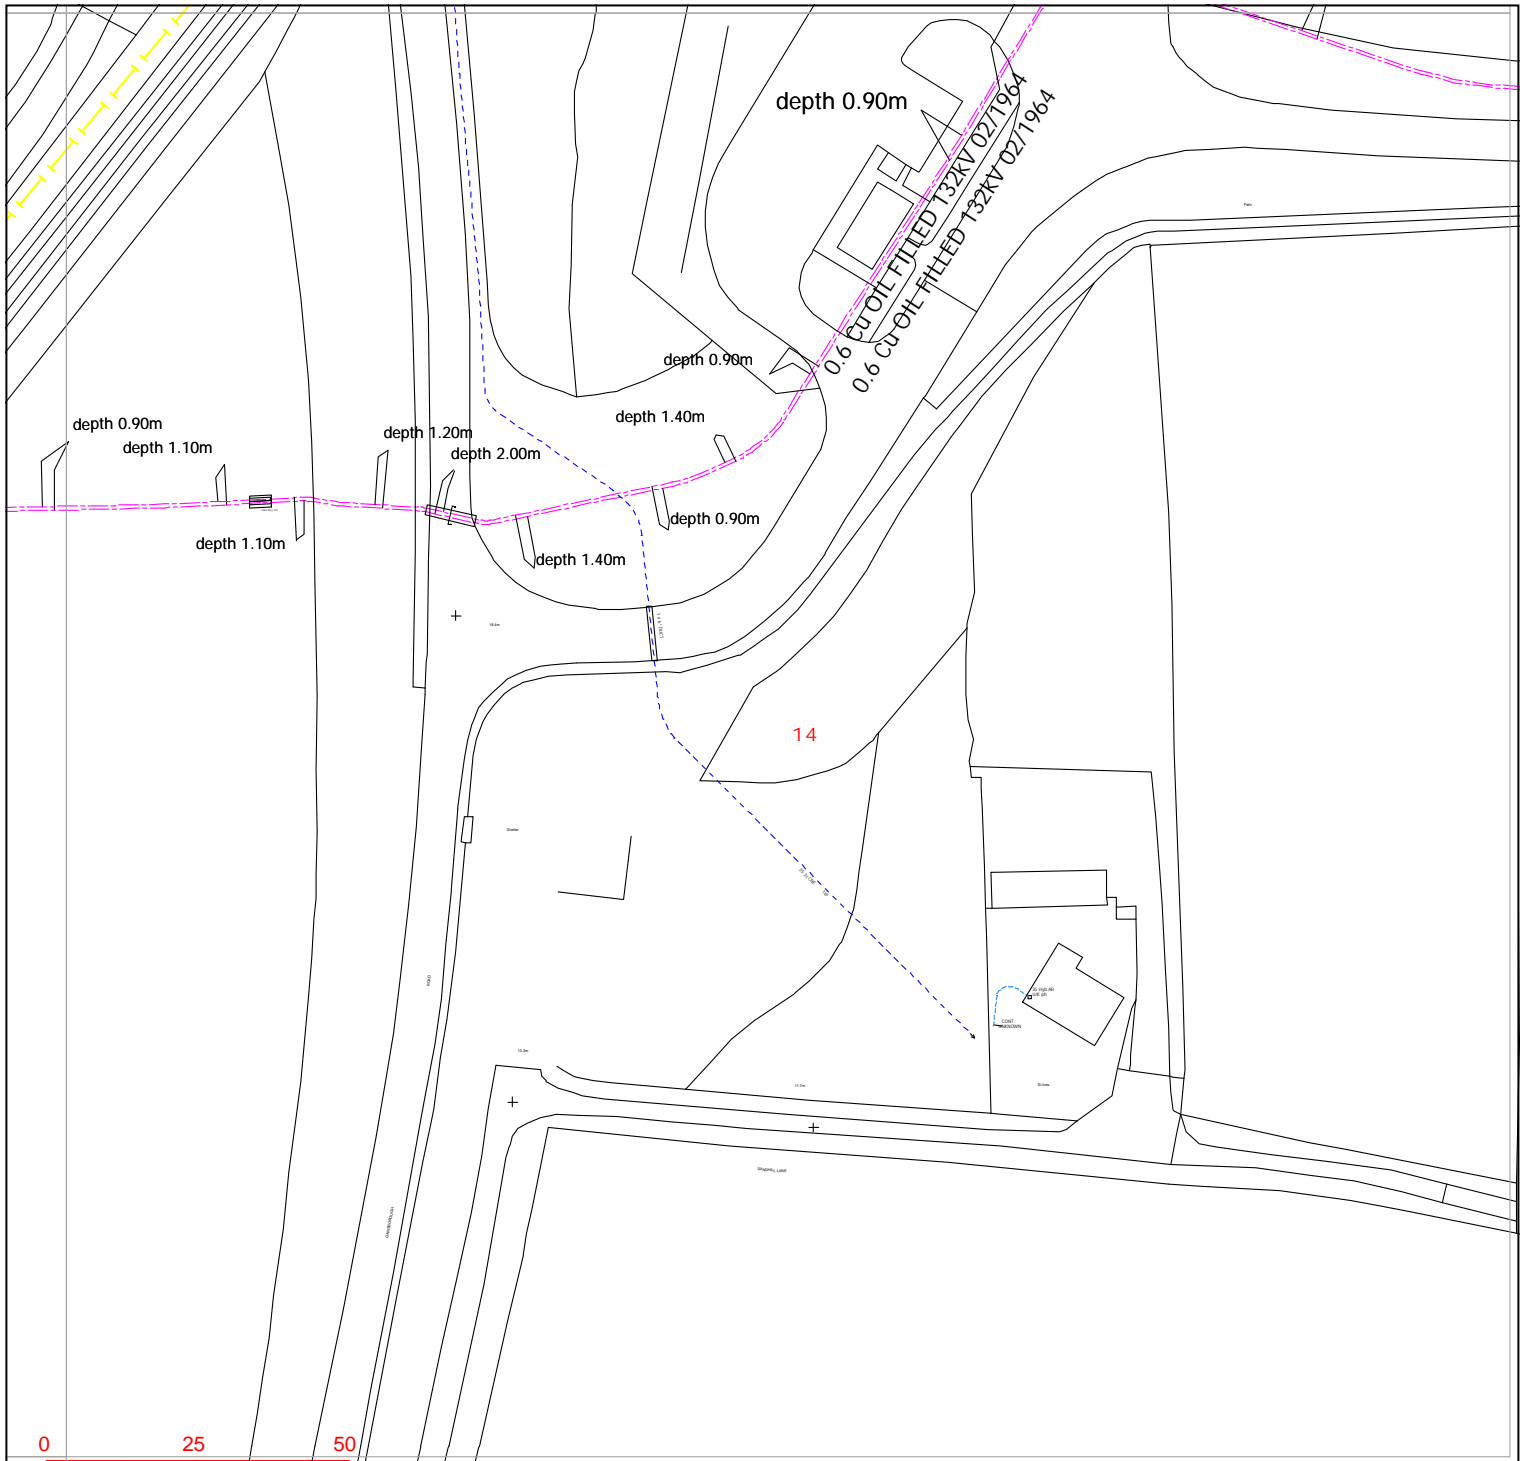

Contact Us
Mapping Enquiries:
 All areas 0121 623 9780

General Enquiries:
 All areas 0800 096 3080

Date Requested: 08/05/2023
 Job Reference: 29406951
 Site Location: 478133 385117
 Requested by:
 Mr Ben Evans
 Your Scheme/Reference:
 LM 203570/DK - 12

Exact Scales:
 1:1250 Area or Circle dig site
 1:500 Line dig site



Link Box	Overhead Line	Underground Cable	National Grid Telecoms	Pilot Cables
●	<ul style="list-style-type: none"> ○ PL ○ Service ○ LV ○ HV (11kV) ○ HV (33kV) ○ HV (66kV) ○ HV (132kV) 	<ul style="list-style-type: none"> --- --- --- --- --- --- --- 	<ul style="list-style-type: none"> --- PME Earth --- Underground Earth 	<ul style="list-style-type: none"> ○ Pole Mounted Transformer □ Ground Mounted Transformer
Site Location Line/Area	<ul style="list-style-type: none"> --- --- --- --- --- --- --- 			

IMPORTANT NOTICES

- This information is given as a guide only and its accuracy cannot be guaranteed. Services or recent additions to the network may not be shown.
- Cables, overhead lines & substations owned by other electricity network owners or private companies may be present and may not be shown.
- You should always verify exact locations of cables using a cable locator and by careful use of hand tools in accordance with HSE guidance note HSG47.
- When working within 10m of any overhead electric line you should follow the requirements of HSE Guidance Note GS6.
- For further advice on working near our electricity cables or lines, call our General Enquiries number.
- Advice should be sought from the National Grid Electricity Distribution General Enquiries team for any work that is to take place in proximity to 132kV underground cables and 132kV overhead lines.

Report damage immediately – KEEP EVERYONE AWAY FROM THE AREA
0800 6783 105

Crown Copyright © All Rights Reserved. Ordnance Survey Licence numbers: 100022432
 NGED Copyright: This copy has been made by or with the authority of National Grid Electricity Distribution (NGED) pursuant to Section 47 of the Copyright Designs and Patents Act 1988 unless that Act provides a relevant exception to copyright the copy must not be copied without the prior permission of the copyright owner.

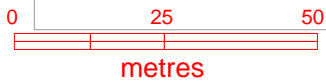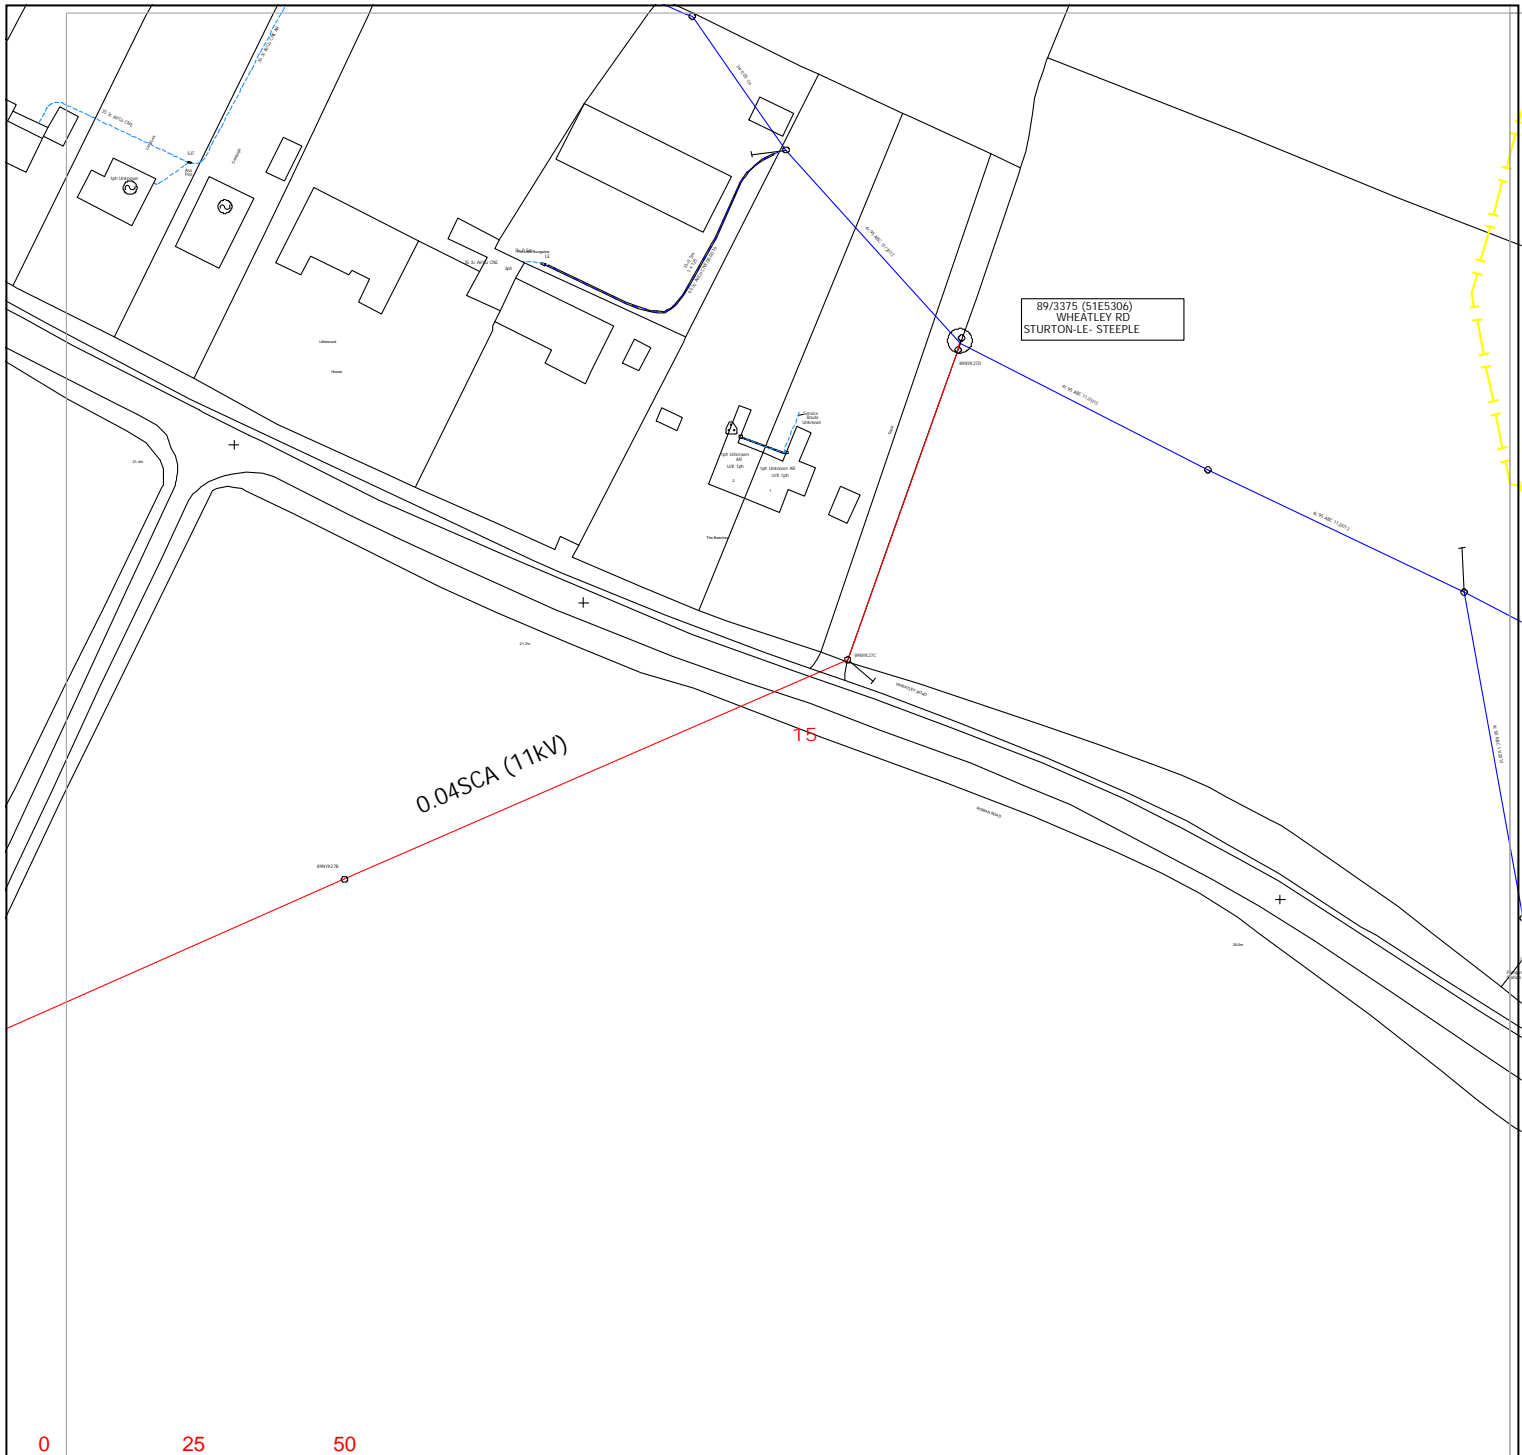

Warning: PDF designed for colour print only with no page scaling.

nationalgrid Electricity Distribution

Contact Us

Mapping Enquiries:
All areas 0121 623 9780

General Enquiries:
All areas 0800 096 3080

Date Requested: 08/05/2023
Job Reference: 29406951
Site Location: 478133 385117
Requested by:
Mr Ben Evans
Your Scheme/Reference:
LM 203570/DK - 12

Exact Scales:
1:1250 Area or Circle dig site
1:500 Line dig site


Link Box	Overhead Line	Underground Cable	National Grid Telecoms	Pilot Cables
●	○ PL ○ Service ○ LV ○ HV (11kV) ○ HV (33kV) ○ HV (66kV) ○ HV (132kV)	---	--- PME Earth ---E Underground Earth	○ Pole Mounted Transformer □ Ground Mounted Transformer

IMPORTANT NOTICES

- This information is given as a guide only and its accuracy cannot be guaranteed. Services or recent additions to the network may not be shown.
- Cables, overhead lines & substations owned by other electricity network owners or private companies may be present and may not be shown.
- You should always verify exact locations of cables using a cable locator and by careful use of hand tools in accordance with HSE guidance note HSG47.
- When working within 10m of any overhead electric line you should follow the requirements of HSE Guidance Note GS6.
- For further advice on working near our electricity cables or lines, call our General Enquiries number.
- Advice should be sought from the National Grid Electricity Distribution General Enquiries team for any work that is to take place in proximity to 132kV underground cables and 132kV overhead lines.

Report damage immediately – KEEP EVERYONE AWAY FROM THE AREA
0800 6783 105

Crown Copyright © All Rights Reserved. Ordnance Survey Licence numbers: 100022432
NGED Copyright: This copy has been made by or with the authority of National Grid Electricity Distribution (NGED) pursuant to Section 47 of the Copyright Designs and Patents Act 1988 unless that Act provides a relevant exception to copyright the copy must not be copied without the prior permission of the copyright owner.

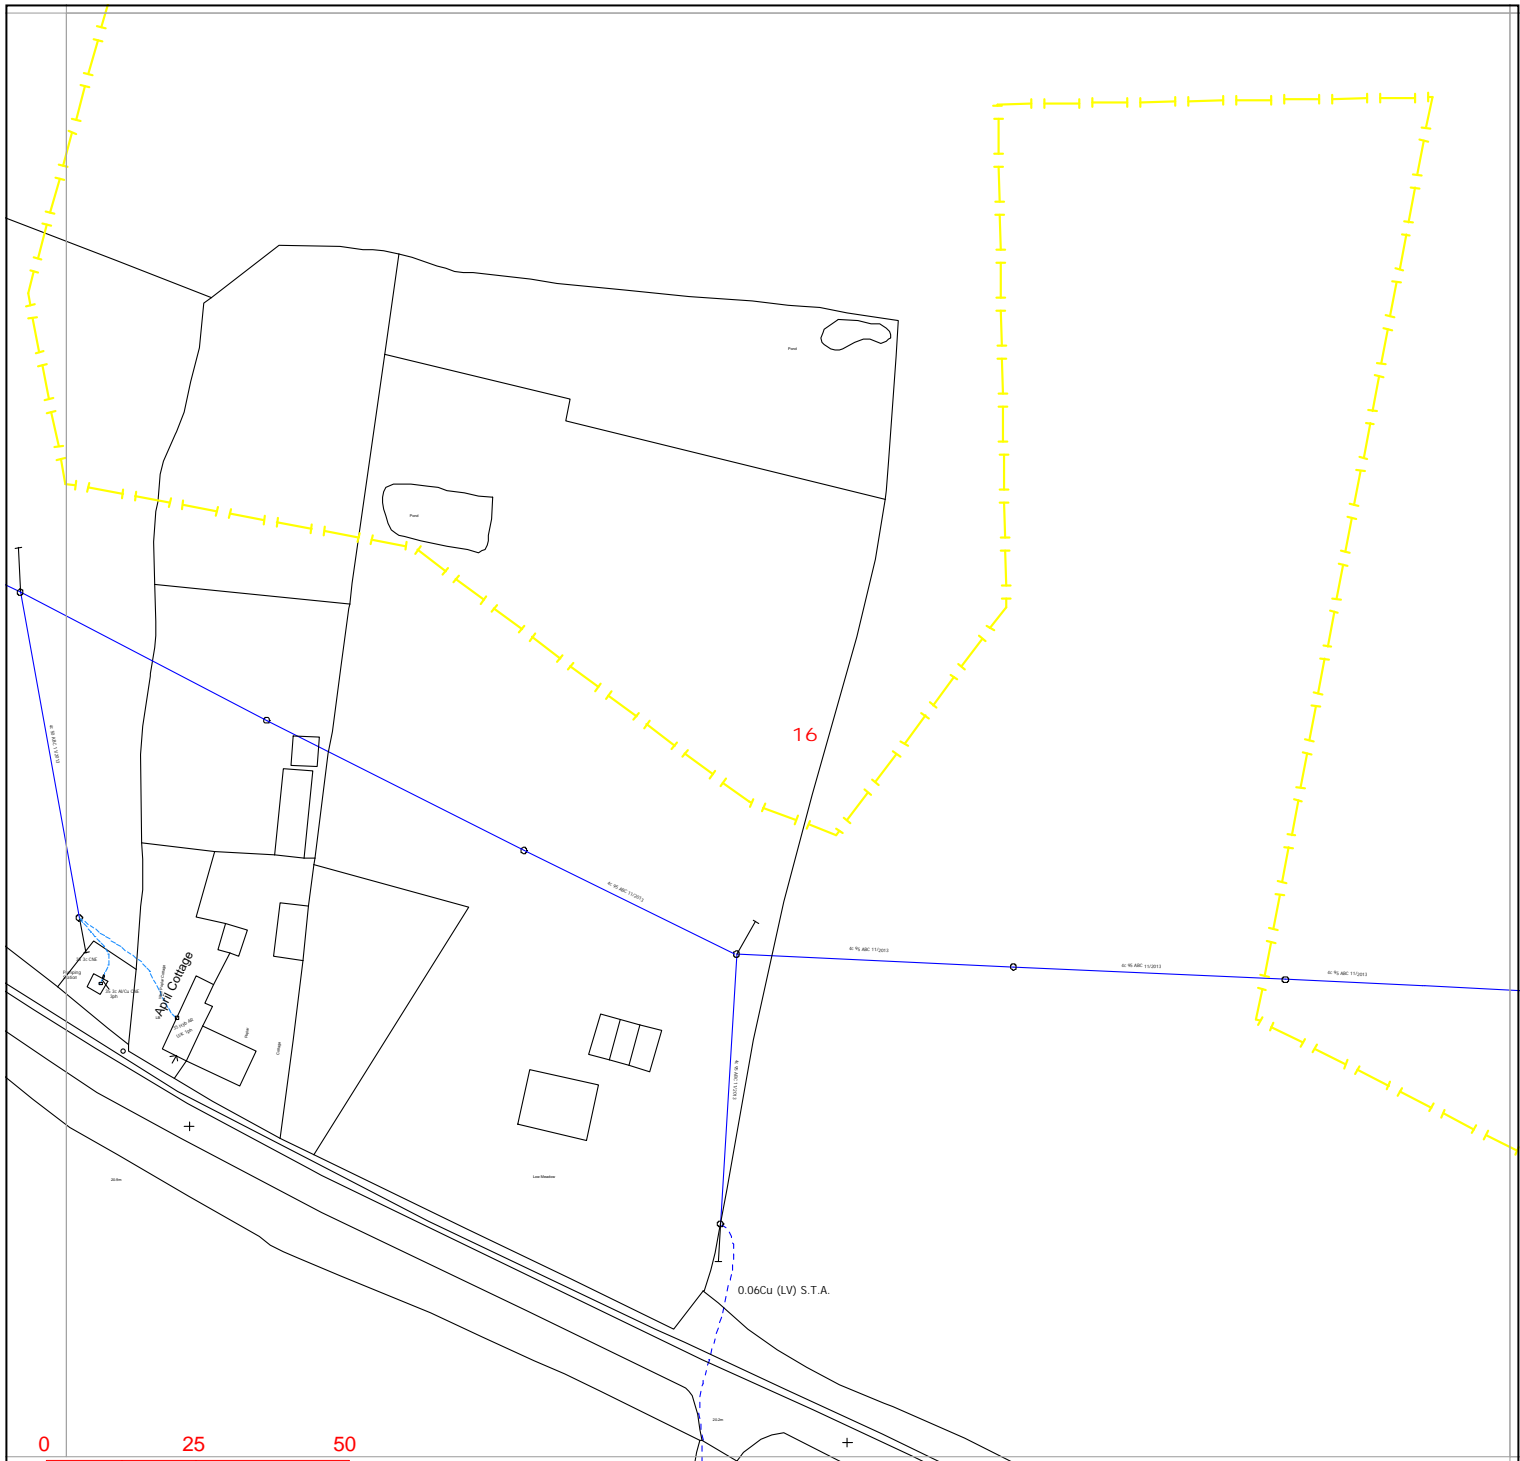

Warning: PDF designed for colour print only with no page scaling.

nationalgrid Electricity Distribution

Contact Us

Mapping Enquiries:
All areas 0121 623 9780

General Enquiries:
All areas 0800 096 3080

Date Requested: 08/05/2023
Job Reference: 29406951
Site Location: 478133 385117
Requested by:
Mr Ben Evans
Your Scheme/Reference:
LM 203570/DK - 12

Exact Scales:
1:1250 Area or Circle dig site
1:500 Line dig site


Link Box	Overhead Line	Underground Cable	National Grid Telecoms	Pilot Cables
●	○ PL ○ Service ○ LV ○ HV (11kV) ○ HV (33kV) ○ HV (66kV) ○ HV (132kV)	---	--- PME Earth --- Underground Earth	○ Pole Mounted Transformer □ Ground Mounted Transformer

IMPORTANT NOTICES

- This information is given as a guide only and its accuracy cannot be guaranteed. Services or recent additions to the network may not be shown.
- Cables, overhead lines & substations owned by other electricity network owners or private companies may be present and may not be shown.
- You should always verify exact locations of cables using a cable locator and by careful use of hand tools in accordance with HSE guidance note HSG47.
- When working within 10m of any overhead electric line you should follow the requirements of HSE Guidance Note GS6.
- For further advice on working near our electricity cables or lines, call our General Enquiries number.
- Advice should be sought from the National Grid Electricity Distribution General Enquiries team for any work that is to take place in proximity to 132kV underground cables and 132kV overhead lines.

Report damage immediately – KEEP EVERYONE AWAY FROM THE AREA
0800 6783 105

Crown Copyright © All Rights Reserved. Ordnance Survey Licence numbers: 100022432
NGED Copyright: This copy has been made by or with the authority of National Grid Electricity Distribution (NGED) pursuant to Section 47 of the Copyright Designs and Patents Act 1988 unless that Act provides a relevant exception to copyright the copy must not be copied without the prior permission of the copyright owner.

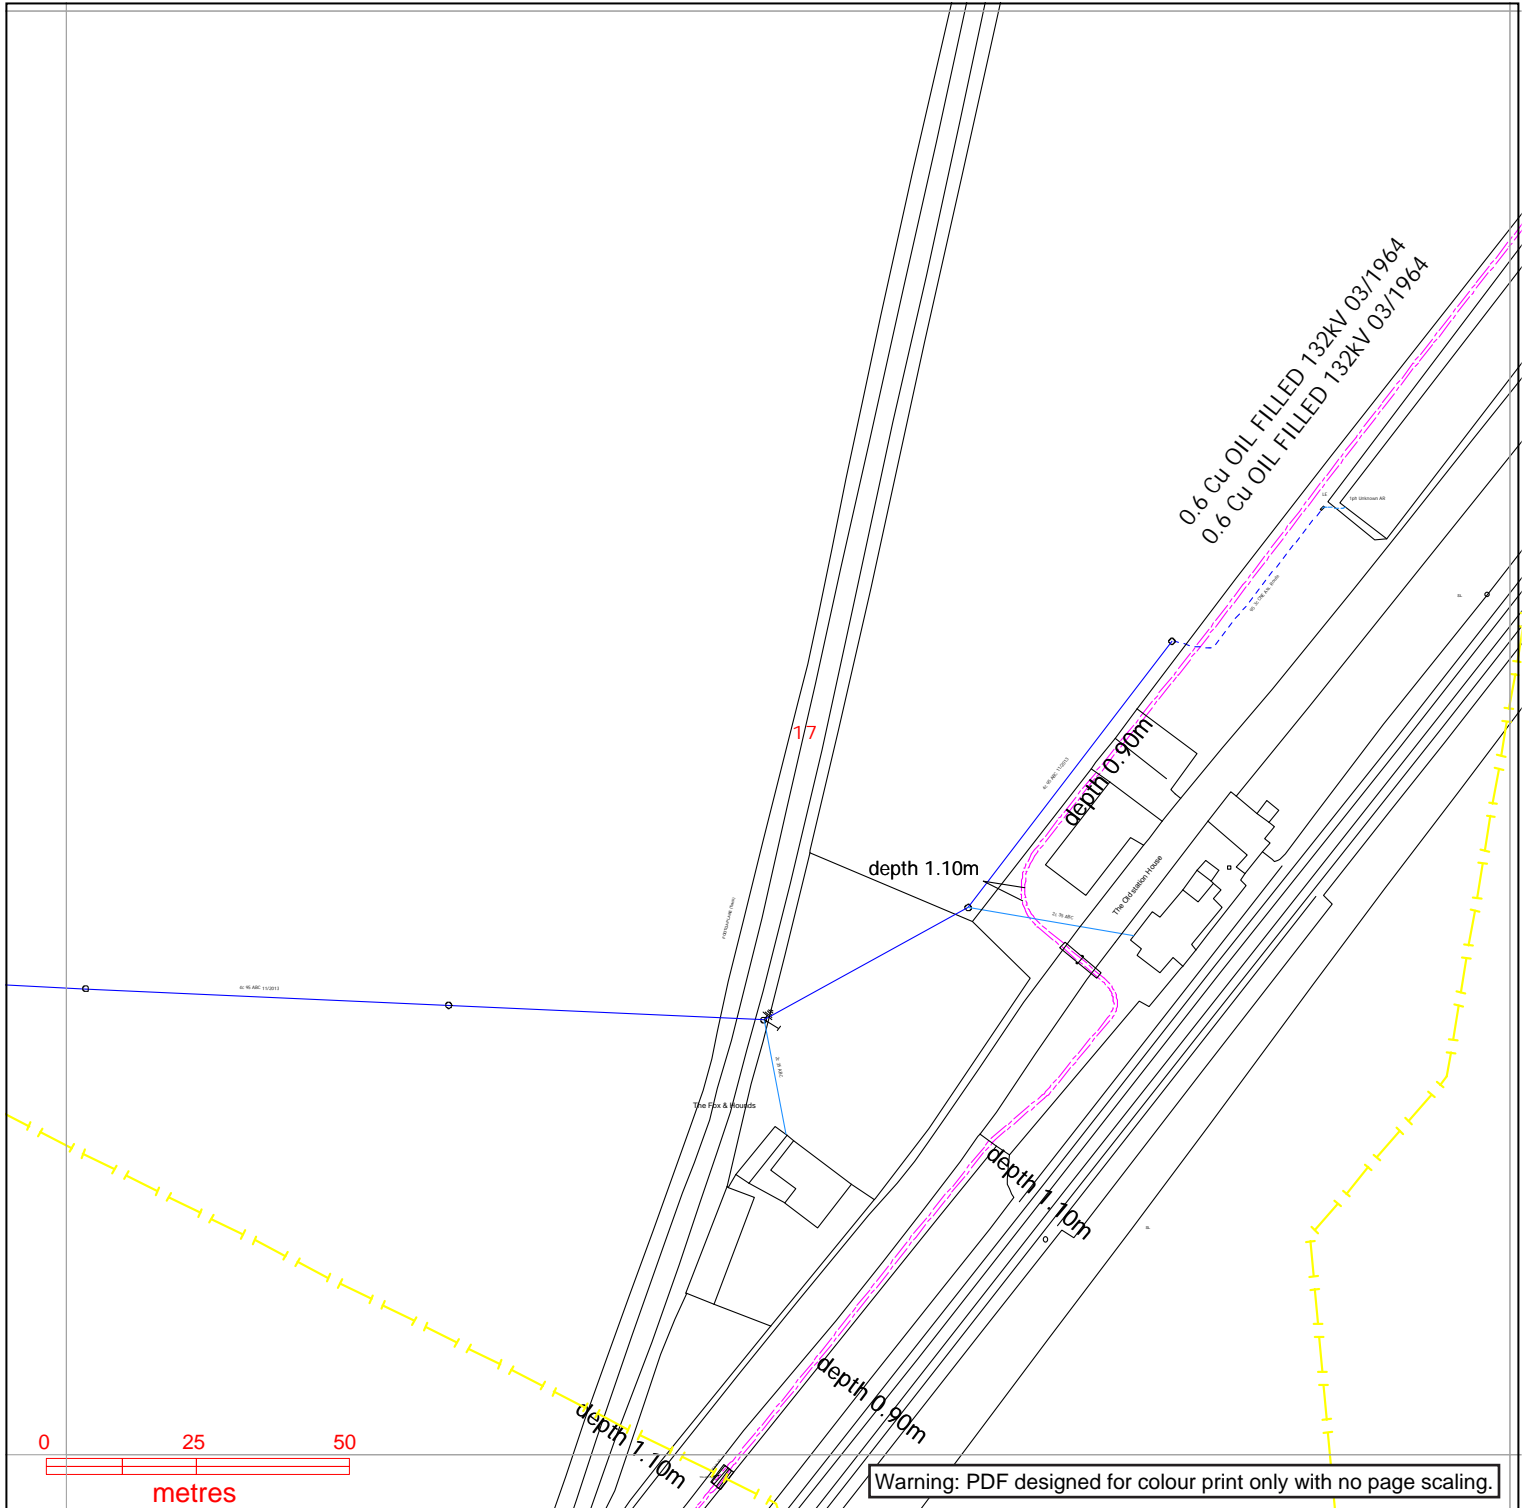

nationalgrid Electricity Distribution

Contact Us

Mapping Enquiries:
All areas 0121 623 9780

General Enquiries:
All areas 0800 096 3080

Date Requested: 08/05/2023
Job Reference: 29406951
Site Location: 478133 385117
Requested by:
Mr Ben Evans
Your Scheme/Reference:
LM 203570/DK - 12

Exact Scales:
1:1250 Area or Circle dig site
1:500 Line dig site


Link Box	Overhead Line	Underground Cable	National Grid Telecoms	Pilot Cables
●	○ PL ○ Service ○ LV ○ HV (11kV) ○ HV (33kV) ○ HV (66kV) ○ HV (132kV)	— —	— — — — — — — — — — — — — — —	○ Pole Mounted Transformer □ Ground Mounted Transformer
Site Location Line/Area	— —	— —	— — — — — — — — — — — — — — —	— — — — — — — — — — — — — — —

IMPORTANT NOTICES


- This information is given as a guide only and its accuracy cannot be guaranteed. Services or recent additions to the network may not be shown.
- Cables, overhead lines & substations owned by other electricity network owners or private companies may be present and may not be shown.
- You should always verify exact locations of cables using a cable locator and by careful use of hand tools in accordance with HSE guidance note HSG47.
- When working within 10m of any overhead electric line you should follow the requirements of HSE Guidance Note GS6.
- For further advice on working near our electricity cables or lines, call our General Enquiries number.
- Advice should be sought from the National Grid Electricity Distribution General Enquiries team for any work that is to take place in proximity to 132kV underground cables and 132kV overhead lines.

Report damage immediately – KEEP EVERYONE AWAY FROM THE AREA
0800 6783 105

Crown Copyright © All Rights Reserved. Ordnance Survey Licence numbers: 100022432
NGED Copyright: This copy has been made by or with the authority of National Grid Electricity Distribution (NGED) pursuant to Section 47 of the Copyright Designs and Patents Act 1988 unless that Act provides a relevant exception to copyright the copy must not be copied without the prior permission of the copyright owner.

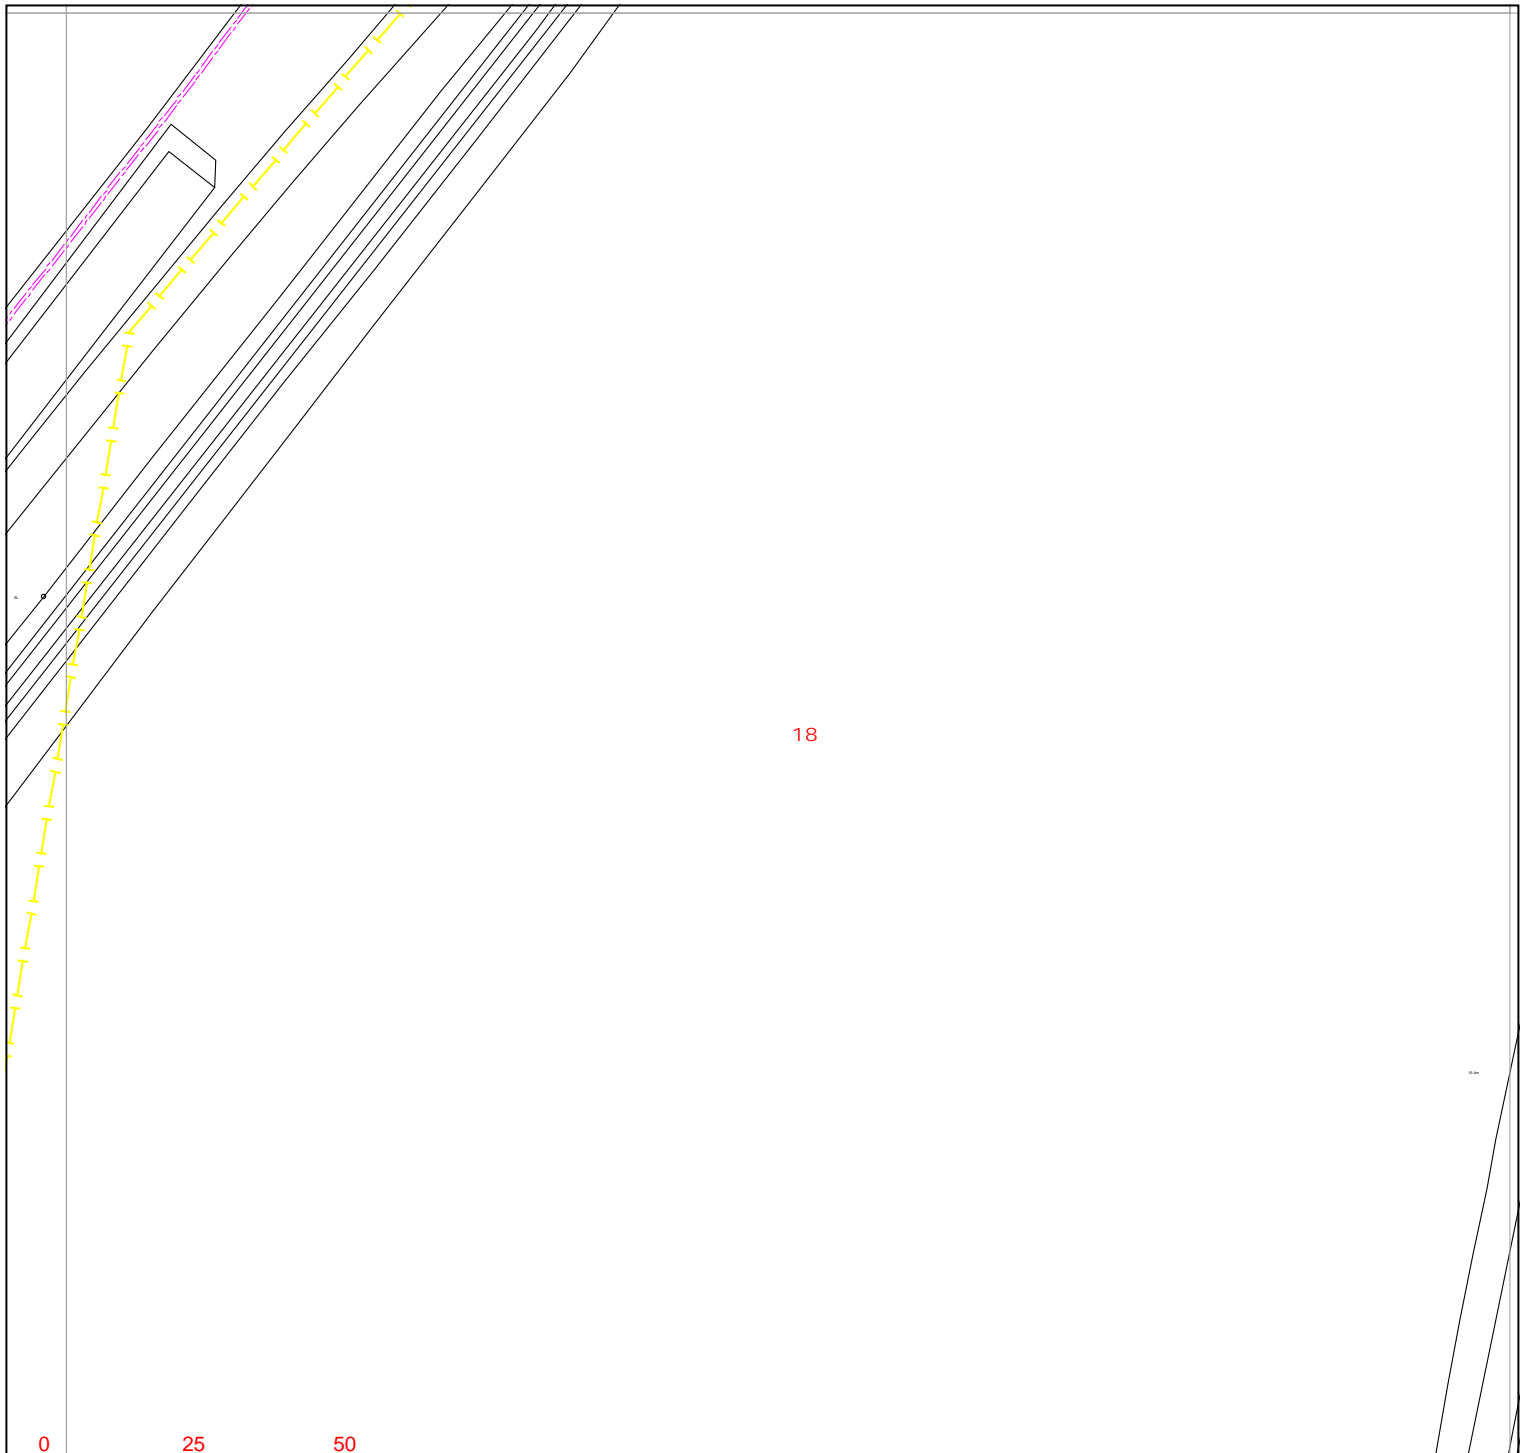

18

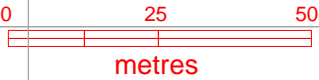

Warning: PDF designed for colour print only with no page scaling.



Contact Us

Mapping Enquiries:
All areas 0121 623 9780

General Enquiries:
All areas 0800 096 3080

Date Requested: 08/05/2023
Job Reference: 29406951
Site Location: 478133 385117
Requested by:
Mr Ben Evans
Your Scheme/Reference:
LM 203570/DK - 12

Exact Scales:
1:1250 Area or Circle dig site
1:500 Line dig site


Link Box ●	Overhead Line ○—○ PL ○—○ Service ○—○ LV ○—○ HV (11kV) ○—○ HV (33kV) ○—○ HV (66kV) ○—○ HV (132kV)	Underground Cable --- --- --- ---	National Grid Telecoms --- PME Earth Underground Earth	Pilot Cables ○ Pole Mounted Transformer □ Ground Mounted Transformer
----------------------	--	--	--	---

IMPORTANT NOTICES

- This information is given as a guide only and its accuracy cannot be guaranteed. Services or recent additions to the network may not be shown.
- Cables, overhead lines & substations owned by other electricity network owners or private companies may be present and may not be shown.
- You should always verify exact locations of cables using a cable locator and by careful use of hand tools in accordance with HSE guidance note HSG47.
- When working within 10m of any overhead electric line you should follow the requirements of HSE Guidance Note GS6.
- For further advice on working near our electricity cables or lines, call our General Enquiries number.
- Advice should be sought from the National Grid Electricity Distribution General Enquiries team for any work that is to take place in proximity to 132kV underground cables and 132kV overhead lines.

Report damage immediately – KEEP EVERYONE AWAY FROM THE AREA
0800 6783 105

Crown Copyright © All Rights Reserved. Ordnance Survey Licence numbers: 100022432
NGED Copyright: This copy has been made by or with the authority of National Grid Electricity Distribution (NGED) pursuant to Section 47 of the Copyright Designs and Patents Act 1988 unless that Act provides a relevant exception to copyright the copy must not be copied without the prior permission of the copyright owner.

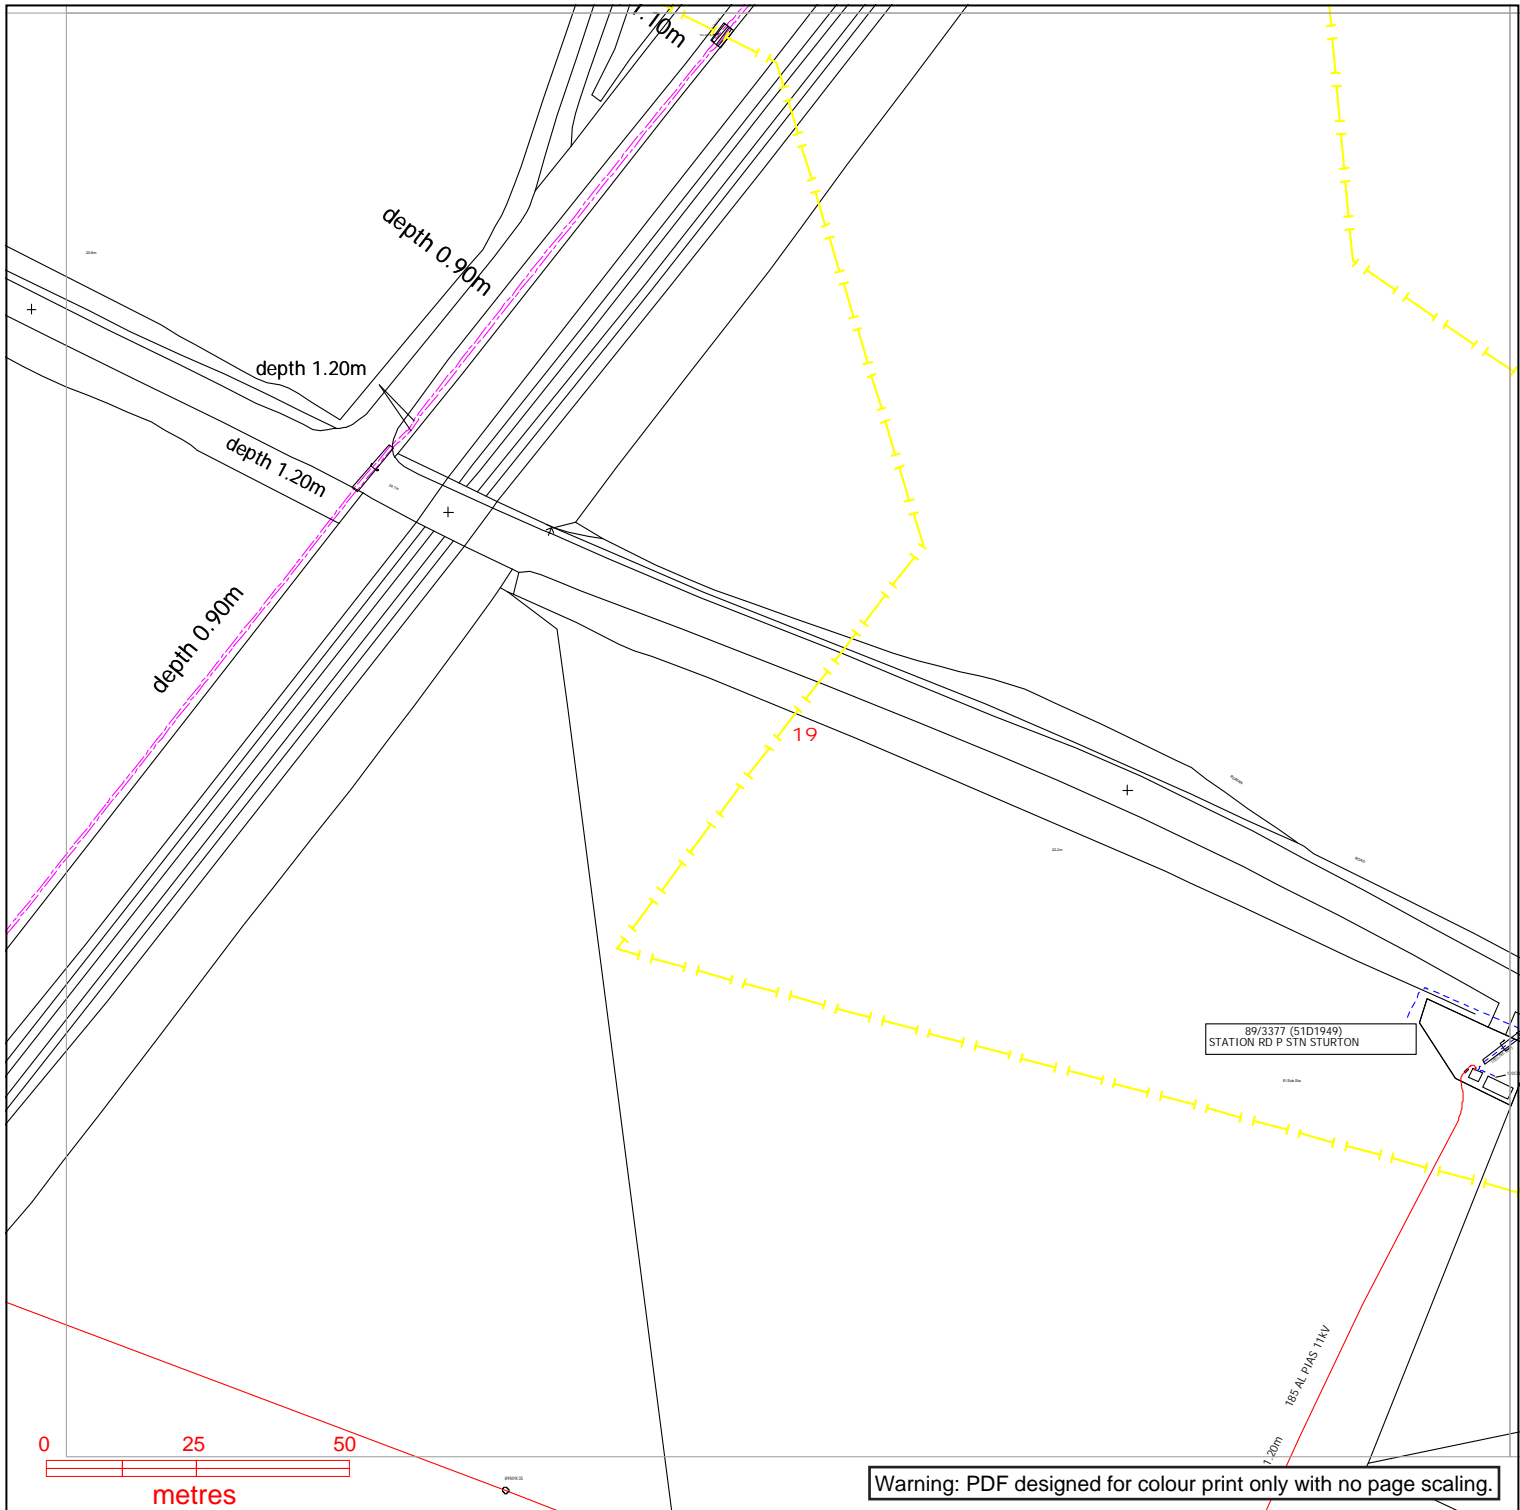

Warning: PDF designed for colour print only with no page scaling.

nationalgrid Electricity Distribution

Contact Us

Mapping Enquiries:
All areas 0121 623 9780

General Enquiries:
All areas 0800 096 3080

Date Requested: 08/05/2023
Job Reference: 29406951
Site Location: 478133 385117
Requested by:
Mr Ben Evans
Your Scheme/Reference:
LM 203570/DK - 12

Exact Scales:
1:1250 Area or Circle dig site
1:500 Line dig site


Link Box	Overhead Line	Underground Cable	National Grid Telecoms	Pilot Cables
●	<ul style="list-style-type: none"> ○ PL ○ Service ○ LV ○ HV (11kV) ○ HV (33kV) ○ HV (66kV) ○ HV (132kV) 	<ul style="list-style-type: none"> --- --- --- --- --- --- --- 	<ul style="list-style-type: none"> --- PME Earth ---E Underground Earth 	<ul style="list-style-type: none"> ○ Pole Mounted Transformer □ Ground Mounted Transformer
●	<ul style="list-style-type: none"> --- Site Location --- Line/Area 			

IMPORTANT NOTICES

- This information is given as a guide only and its accuracy cannot be guaranteed. Services or recent additions to the network may not be shown.
- Cables, overhead lines & substations owned by other electricity network owners or private companies may be present and may not be shown.
- You should always verify exact locations of cables using a cable locator and by careful use of hand tools in accordance with HSE guidance note HSG47.
- When working within 10m of any overhead electric line you should follow the requirements of HSE Guidance Note GS6.
- For further advice on working near our electricity cables or lines, call our General Enquiries number.
- Advice should be sought from the National Grid Electricity Distribution General Enquiries team for any work that is to take place in proximity to 132kV underground cables and 132kV overhead lines.

Report damage immediately – KEEP EVERYONE AWAY FROM THE AREA
0800 6783 105

Crown Copyright © All Rights Reserved. Ordnance Survey Licence numbers: 100022432
NGED Copyright: This copy has been made by or with the authority of National Grid Electricity Distribution (NGED) pursuant to Section 47 of the Copyright Designs and Patents Act 1988 unless that Act provides a relevant exception to copyright the copy must not be copied without the prior permission of the copyright owner.

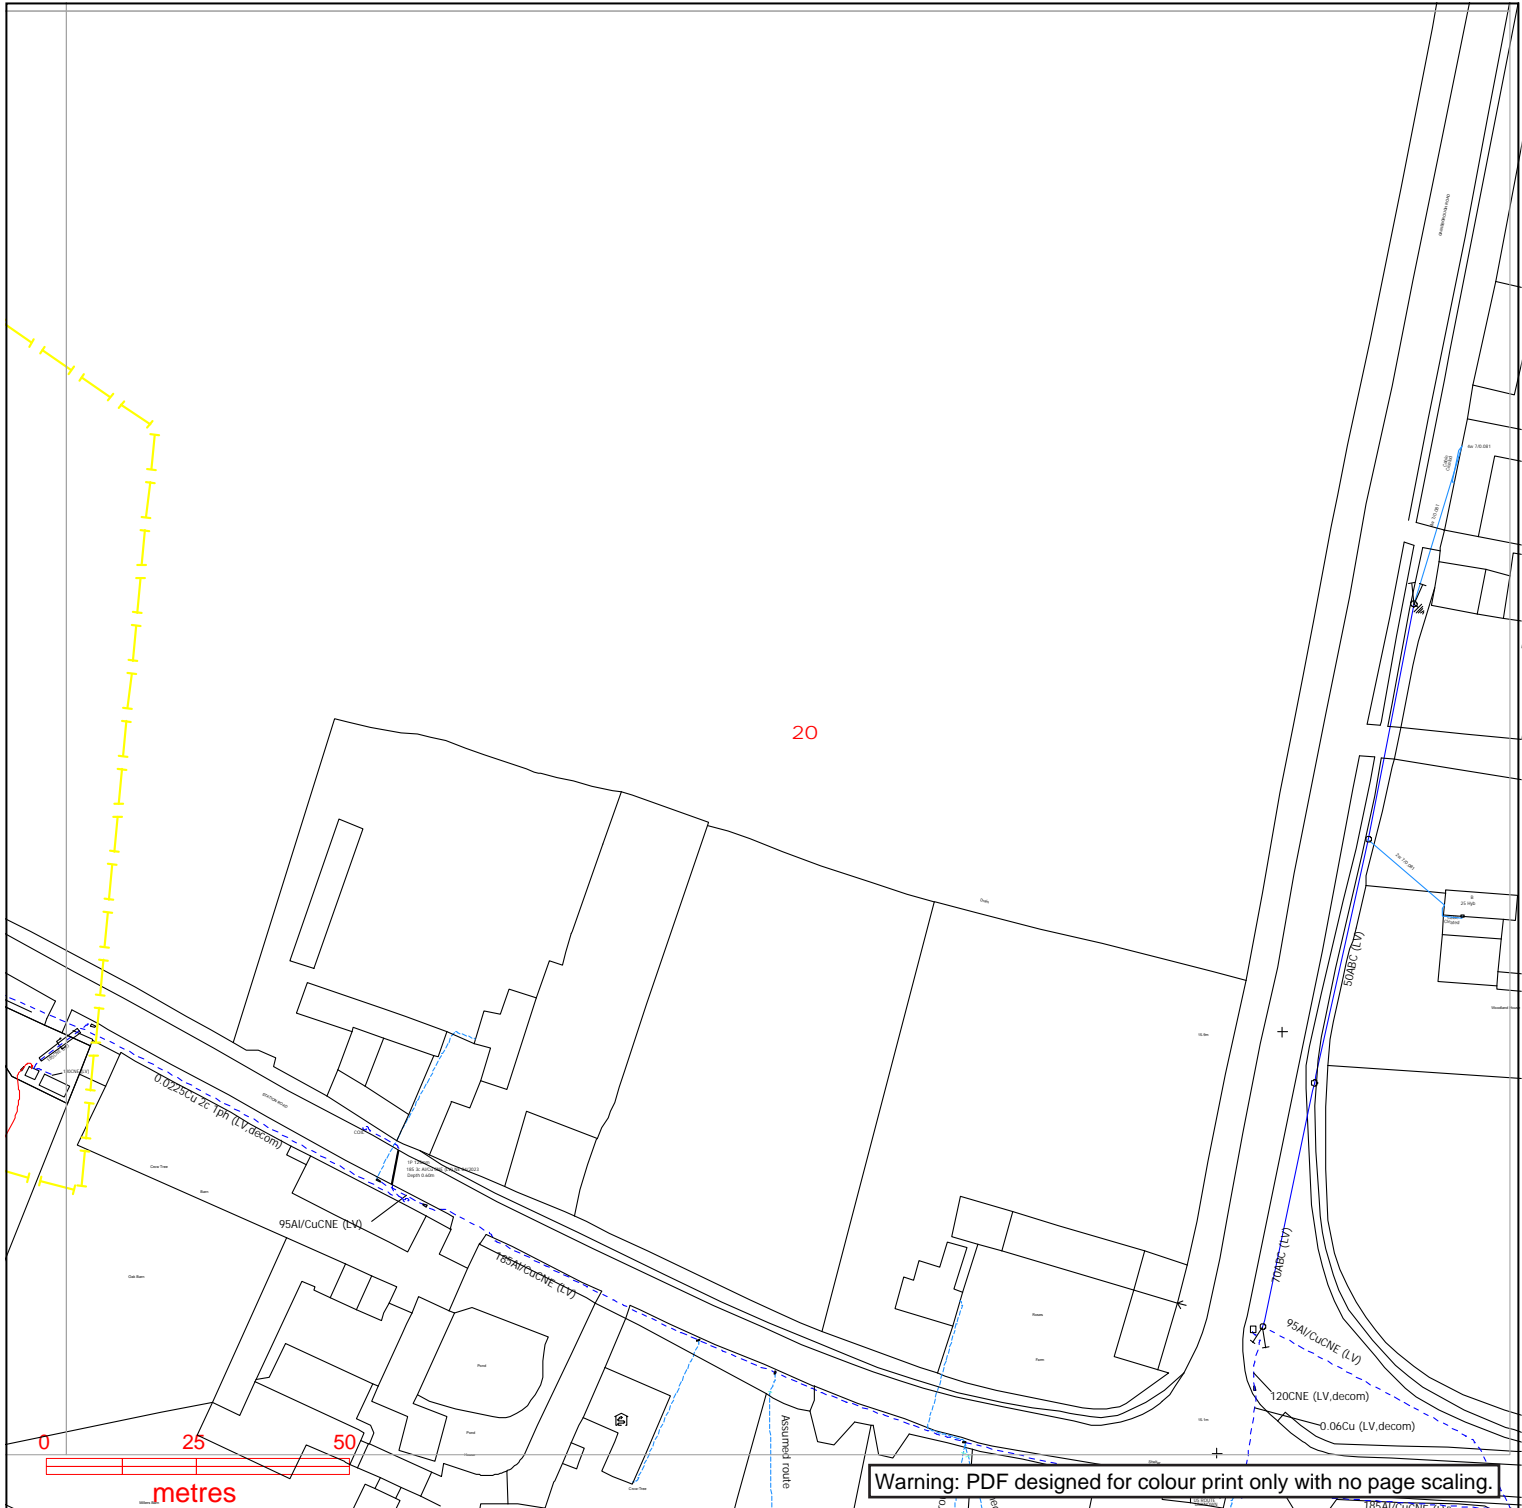

Warning: PDF designed for colour print only with no page scaling.

nationalgrid Electricity Distribution

Contact Us

Mapping Enquiries:
All areas 0121 623 9780

General Enquiries:
All areas 0800 096 3080

Date Requested: 08/05/2023
Job Reference: 29406951
Site Location: 478133 385117
Requested by:
Mr Ben Evans
Your Scheme/Reference:
LM 203570/DK - 12

Exact Scales:
1:1250 Area or Circle dig site
1:500 Line dig site

Link Box	Overhead Line	Underground Cable	National Grid Telecoms	Pilot Cables
●	○ PL ○ Service ○ LV ○ HV (11kV) ○ HV (33kV) ○ HV (66kV) ○ HV (132kV)	---	--- PME Earth ---E Underground Earth	○ Pole Mounted Transformer □ Ground Mounted Transformer
Site Location Line/Area	--- (various colors)	---		

IMPORTANT NOTICES

- This information is given as a guide only and its accuracy cannot be guaranteed. Services or recent additions to the network may not be shown.
- Cables, overhead lines & substations owned by other electricity network owners or private companies may be present and may not be shown.
- You should always verify exact locations of cables using a cable locator and by careful use of hand tools in accordance with HSE guidance note HSG47.
- When working within 10m of any overhead electric line you should follow the requirements of HSE Guidance Note GS6.
- For further advice on working near our electricity cables or lines, call our General Enquiries number.
- Advice should be sought from the National Grid Electricity Distribution General Enquiries team for any work that is to take place in proximity to 132kV underground cables and 132kV overhead lines.

Report damage immediately – KEEP EVERYONE AWAY FROM THE AREA
0800 6783 105

Crown Copyright © All Rights Reserved. Ordnance Survey Licence numbers: 100022432
NGED Copyright: This copy has been made by or with the authority of National Grid Electricity Distribution (NGED) pursuant to Section 47 of the Copyright Designs and Patents Act 1988 unless that Act provides a relevant exception to copyright the copy must not be copied without the prior permission of the copyright owner.

A photograph of a worker in a yellow safety suit and white helmet working on a large array of red cables in a tunnel. The worker is on the right side of the frame, looking towards the camera. The cables are arranged in a long, parallel line, extending from the foreground into the background. The background is dark, suggesting an underground environment. The worker is wearing a white hard hat with a logo, safety glasses, and a yellow high-visibility jacket with reflective stripes. The cables are thick and red, with metal clamps or connectors visible. The overall scene is dimly lit, with the worker's jacket and the cables providing the main sources of color.

nationalgrid

Avoidance of danger from electricity overhead lines and underground cables

National Grid Electricity
Distribution's information
to manage safety whilst
working in the vicinity
of our equipment.

nationalgrid.co.uk

CALL 105
⚡


Avoidance of danger from electricity overhead lines and underground cables

Every year in the UK on average, two people are killed and many more are injured when mechanical plant and machinery comes into contact or close proximity to overhead electricity lines.

Although electric shock is the first thing that people associate with coming into contact with our network, those who have witnessed the effects of damage to our system are shocked by the amount of heat, light and noise that are the result of an electrical flashover.

In the Midlands, South West and South Wales, National Grid Electricity Distribution (NGED) have had to attend to incidents where people have accidentally made contact with one of our live electricity overhead lines or damaged an underground cable and became seriously injured.

A significant number of these accidents occurred whilst people were working in the vicinity of overhead and underground electrical apparatus and this booklet has been produced to provide general guidance on how you and your employees can avoid becoming one of these statistics.

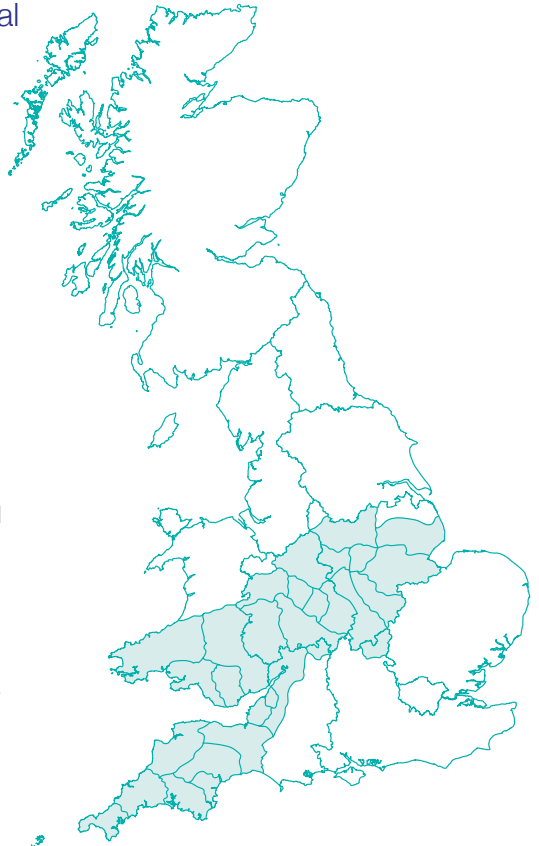

Planning your work

It makes sense to consider your safety while in the vicinity of our equipment as early in your planning process as possible.

One of the first things you should do whenever you are planning your work is to check whether there is any of our equipment in the immediate vicinity. You should do this whether your work is taking place on public (e.g. highways and footpaths) or on private land.

Companies and organisations can request plans through LSBUD (Linesearch BeforeUdig) **lsbud.co.uk** – this site provides the same high quality plans and service that the NGED Webmap system has provided in the past, with the significant added benefit of searching over 40 other asset owners from a single query, including underground and overhead electricity networks, gas, high pressure fuel, water and fibre optic networks.

(Please note: not all asset owners are represented by LSBUD, and enquiries should also be made independently to all other relevant organisations).

This service allows you to request plans online and receive an information pack back via email within minutes.

Domestic/private customers should request plans using the phone number, email or postal address shown at the bottom of this section.

For instance, take a good look around your site to see if there are any visible overhead lines.

You should also bear in mind that we have a very extensive network of underground cables, and we are always happy to supply a plan from our Map Response Team who can be contacted via the following;

Tel:

0121 623 9780

Email:

nged.mapresponse@nationalgrid.co.uk

It is always safer to assume that there are underground cables present in the ground until you have proven otherwise.

An online mapping service is available at: **nationalgrid.co.uk/our-network/check-before-you-dig-location-of-our-cables-and-equipment**

Working in the vicinity of underground cables

Having obtained copies of our network maps, it is important to recognise that in most cases there will be no surface indication of the presence of underground cables.



We therefore advise that you take the following actions:

- make sure that you have up-to-date copies of our cable record plans on site - not back in the office
- don't assume that these plans are to scale if they have been faxed or copied
- make sure that a competent person using a Cable Avoidance Tool (CAT) locates all of the cables shown on these plans
- mark the locations of cables on the ground surface with waterproof road paint or other permanent marker
- always assume that our cables are live unless we have informed you, in writing, otherwise
- by hand, dig trial holes to locate the exact position of all cables. Always use an insulated spade or shovel – never use a pick, fork or power tool – push the spade or shovel into the ground applying foot pressure
- look out for ducts, marker tape or tiles but do not rely on these. Even if a cable route was originally laid in a duct or with a marker tape, these may have been removed during other excavations at a later date along with all or part of the cable route
- brief all people working in the vicinity of the presence and location of all underground cables.



Under no circumstances should you attempt to work on, or interfere with, any of our underground cables

The only people qualified to work on this equipment are our operatives; who have been specifically trained and are authorised in writing to do so.

Please also be aware that:

- cable record plans are not guaranteed to be completely accurate. Kerb lines, roads and buildings may have been moved or altered since the cables were laid
- cables should ordinarily be at least 450mm deep, but don't assume this to be the case where you are working – ground levels could have changed
- not all service cables are shown on record plans, so look for cables running down poles and bear in mind that all buildings, street lights and street furniture are likely to have cables running to them. Cables feeding street furniture may be relatively shallow near to the furniture
- cables do not run in straight lines. They often “snake” through the ground avoiding surface and buried obstacles that may not be visible to you
- cables are flexible and can change direction and depth abruptly – for this reason never use mechanical excavators within 0.5m of any underground electricity cable even if you have located it with trial holes
- **no attempt should be made to break out concrete surrounding a cable. Please contact us immediately on our general enquiries number and we will discuss the options for safe working which may include making the cable dead or you moving your work site if possible. If we need to make the cable dead we may need to provide our customers with two weeks notice of the power interruption**
- our cables and joints are not designed to act as steps or to be left unsupported. If you remove support from any cable, you will need to support it using temporary hangers at not more than 0.5m intervals.
- when backfilling, please consolidate the ground under the cables, cover the cable with soil free of stones or with stone dust and replace any cable marker tiles, ducts and tape.

If you damage an underground cable

You must immediately clear the area of personnel because the cable could still be live, or become live again.

If a machine is still in contact with the cable, instruct the driver to jump clear of the vehicle, avoiding simultaneous contact with any part of the machine and the ground. Try to land with your feet as close together as possible.

Where possible, continue to move away from the vehicle using “bunny hops” with your feet together until at least 15m from the vehicle.


Please contact us on our emergency number immediately and tell us what has happened. Please be ready to provide us with a contact telephone number and an accurate location or set of directions – this will help us in getting our staff to site quickly to minimise any danger and lessen the disruption to your work.

Incident locations can be hard to describe. Using the free What3Words app will enable us to quickly and easily identify where the incident has taken place across our network.

CALL 105



Please report any damage to a cable, however superficial it might seem. The cable may not fail at the time of damage, but it could fail later, causing danger to our staff and other contractors, disruption to our customers’ supplies, and also – if we trace the damage back to you – a large repair bill.

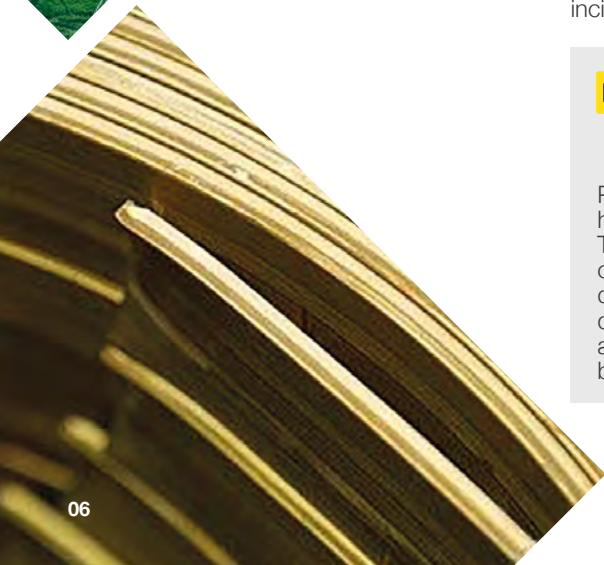


Working in the vicinity of overhead lines

Under no circumstances should you attempt to work on, or interfere with any of our overhead line equipment or service wires.


The only people qualified to work on this equipment are our operatives; who have been specifically trained and are authorised in writing to do so. Overhead lines have the advantage that, unlike underground cables, they can easily be seen.

- Always assume that our overhead lines are live unless we have informed you otherwise in writing.
- We will be able to advise you about the type and voltage of the overhead lines in question and provide you with information about the clearances that you must adhere to during your work. Please ring our regional general enquiries number for further advice.
- In some circumstances, we may be able to temporarily shroud low voltage overhead lines and services running to buildings if you need to work in the vicinity e.g. for scaffolding erection, fascia repairs and painting work on domestic properties. We don't normally charge for the shrouding of overhead lines, but please give us as much notice as possible.
- If you think that you will be working close to our overhead lines and they need shrouding – please don't start work until we have agreed what needs to be done and all safety precautions are in place.
- If you are in any doubt about whether the overhead lines in question are power or telephone (this is a very common mistake) – please ask us.
- Please note that it is not technically possible to shroud high voltage lines, so if you cannot avoid working near to our high voltage lines, contact us and we will be happy to meet with you to discuss safe alternatives.


- If it is decided that work can go ahead in the vicinity of our overhead lines but there is a risk of you infringing the safety clearances from the overhead lines, you have a responsibility to erect safety barriers to segregate your works from the area around the overhead lines. The detailed requirements for these barriers are provided in the HSE document GS6 'Avoidance of Danger from Overhead Lines'. As a summary they should consist of:
 - red and white coloured posts erected at 6m intervals, with coloured bunting stretched between their tops, supplemented by low level bunting erected at 1m above ground level, supported at 3m intervals on red and white coloured posts. This is shown below.
- We are able to advise you on the height of the barriers and any additional clearances necessary if you are using large plant on your site.
- Any bunting, ropes and lanyards used should be made from an insulating material.
- These barriers should be erected parallel to the overhead line at a minimum distance of 6m horizontally from the outermost conductor of the overhead line.
- The supports may be supported by rubble or concrete filled barrels or buried directly in the ground.
- Danger notices should be fixed to all of your high level supports.
- The ground enclosed within these barriers is best regarded as "dead ground" in which all foot and vehicular traffic is forbidden, in all circumstances, for the duration of your work.

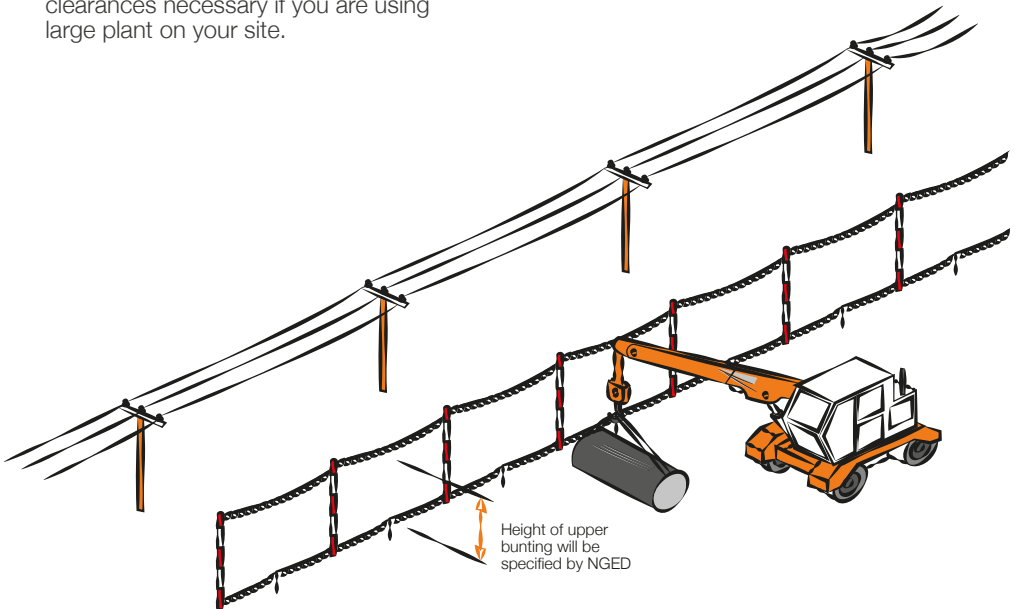

- Where it is necessary for foot and vehicular traffic to pass under the line, you will need to form a marked access way between the barriers as shown below.
- This access way should comprise of bunting erected 1m above ground, supplemented by high level “goal-posts” erected at either end.
- The goal post cross bars should be rigid, made of insulating material and positioned in a location and at a height specified by us.
- The access route should be as narrow as possible and should not normally exceed 10m in width.
- If it is necessary to make the access route wider than this, you may find it impractical to use rigid cross bars, so you may use a tensioned rope and bunting instead. If you use rope and bunting as a cross bar, you should move the entrance to the access route out to a minimum distance of 12m from the outermost conductor of the line. This is to allow for any stretching of the rope if pulled by your plant.

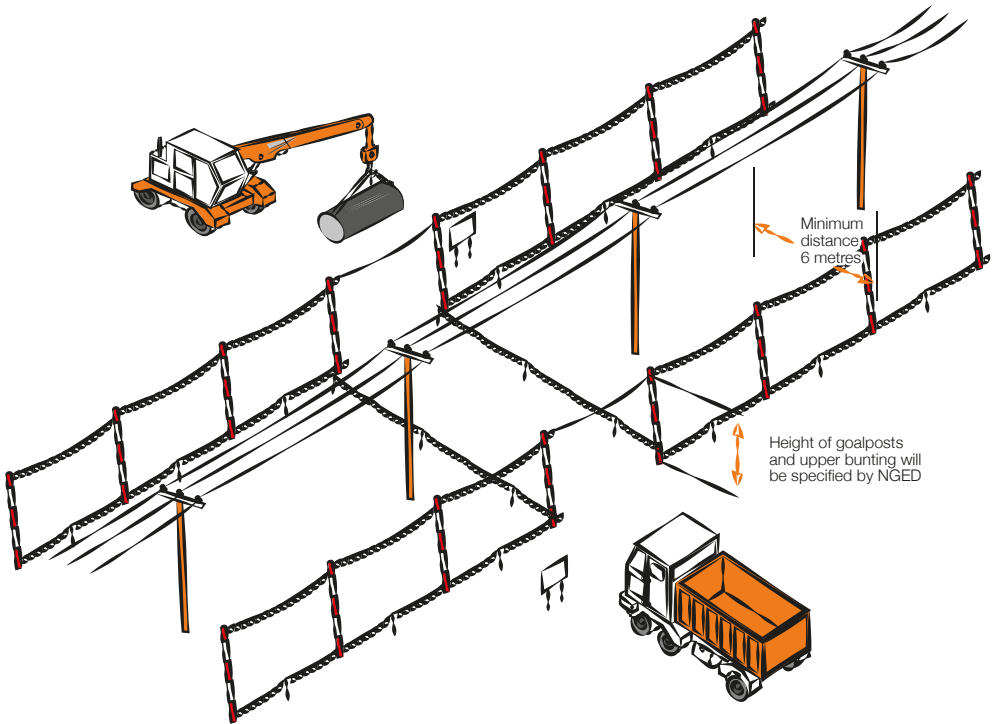

- If you decide to use steel wire rope to support the barrier, this must be effectively connected to earth at both ends.
- You should also install Danger Notices at all probable directions of approach and clearly display the cross bar height.
- Whatever measures you take, you should ensure that everyone working in the vicinity of overhead lines is briefed about the risks and what safety measures are in place. Do not permit anyone to carry long objects, especially scaffold poles, ladders and irrigation pipes in the vicinity of overhead lines.
- If you are working at night, or in conditions of poor visibility, you should ensure the area is well lit and that the overhead lines are clearly visible.
- You should ensure that all shrouding, barriers and signs are regularly inspected and maintained so that they remain effective.
- Overhead lines are not normally insulated and electricity at high voltages may jump, so a dangerous situation can arise just from a close approach.
- Cranes and excavators working near overhead lines are at increased risk because of the possibility of the jib/arm slewing or being raised into the overhead line, or the load swinging into the overhead line. You may therefore also need to fit plant and vehicles with restricting chains etc. to physically restrain their operation – we can advise on this if you wish.
- If you are planning to carry out tree cutting or arboriculture work in the vicinity of our overhead lines, you need to be aware that this is a complex, high risk activity and we recommend that you employ a competent tree surgeon, who complies with all of the requirements of Forestry industry Safety Accord (FISA) publication FISA 804 - Electricity at work: Forestry.

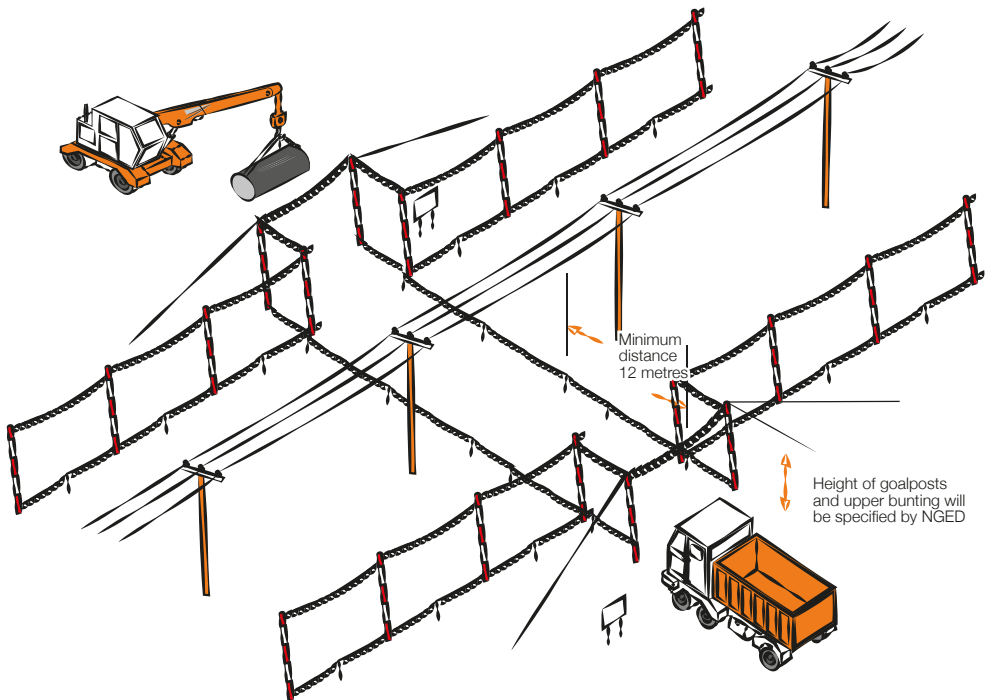

If contact is made with an overhead line

You must immediately clear the area and suspend all work within 50m of the damage because the line could still be live, or become live again. The operator of a machine that is in contact with an overhead line should:

- **If the machine is still operable and the operator is still in the cab:**
 - provided that you do not risk breaking the overhead line or dragging it to the ground, immediately lower the raised parts of the machine using only the controls in the cab and/or drive the vehicle clear of the overhead line
 - contact us immediately on our emergency number so that we can check the overhead lines
 - instruct other people in the vicinity not to approach the vehicle.
- **If the machine is not operable, cannot be driven clear of the overhead line or there is a risk that doing so will break the line or drag it to the ground:**
 - stay in the cab
 - contact your site manager or us immediately on our emergency number by radio or mobile phone or as soon as possible by any other method
 - instruct everyone outside the vehicle not to approach it
 - do not exit the cab until given confirmation by wpd personnel that it is safe to do so.

- **If the machine is inoperable or cannot be driven free and there is risk of fire or other immediate hazard:**

- jump clear of the vehicle, avoiding simultaneous contact with any part of the machine and the ground
- try to land with your feet as close together as possible
- where possible, continue to move away from the vehicle jumping with both feet together until at least 15m from the vehicle. Instruct other people in the vicinity not to approach the vehicle. Contact us immediately on our emergency number
- do not return to the vehicle until given confirmation by wpd personnel that it is safe to do so.

Whatever the circumstances please contact us on our emergency number immediately and tell us what has happened. Please be ready to provide us with a contact telephone number and an accurate location or set of directions – this will help us in getting our staff to site quickly to minimise any danger and lessen any disruption to your work.

CALL 105



Please report any damage or contact no matter how minor they may seem to you at the time. The damage may not cause a serious problem at the time of damage, but it could fail later, causing danger to our staff and members of the public, disruption to our customers' supplies, and – if we trace the damage back to you – a large repair bill.

More information

For your information, we are legally obliged to report all contact with our system to the Health and Safety Executive (HSE), and, if you are an employer, you may be obliged to report incidents involving your staff or contractors to the HSE.

Even if no one is hurt, you could be prosecuted for failing to report such an incident.

More detailed general information on this subject is available in the following publications from the HSE:

- HSG(47) – Avoiding Danger from Underground Services
- GS6 – Avoidance of Danger from Overhead Lines
- along with Forestry Industry Safety Accord (FISA) publication FISA 804 – Electricity at Work: Forestry

If you require more site-specific information relating to our equipment at your location please contact us on our general enquiry number:

Our general enquiry number is:

0800 096 3080

National Grid Electricity Distribution plc
Avonbank
Feeder Road
Bristol BS2 0TB
United Kingdom

[nationalgrid.co.uk](https://www.nationalgrid.co.uk)

Finally

Please, always remember that electricity cables and overhead lines can be very dangerous – the general rule is **stay away and stay safe.**

nationalgrid

Look out, look up!

National Grid Electricity Distribution's
guide to the safe use of mechanical
plant in the vicinity of electricity
overhead lines



nationalgrid.co.uk

CALL 105



The safe use of mechanical plant in the vicinity of electricity overhead lines

Every year in the UK on average, two people are killed and many more are injured when mechanical plant and machinery comes into contact or close proximity to overhead electricity lines.

This booklet has been produced for anyone who uses mobile plant, (such as Hiabs, MEWPs, tipper lorries and trailers, grab lorries, concrete conveyors and excavators) for short duration work and provides general guidance on how to avoid becoming part of these statistics.

1 Before starting work

Overhead lines have the advantage that they can easily be seen, so before you set up your vehicle or plant always:


Stop and look up!



If you are working at night, or in conditions of poor visibility, you should use spotlights or a torch to carefully check that there are no overhead lines within your vehicle's reach.



If you are in any doubt about whether the lines in question are power or telephone (this is a very common mistake) – always assume that they are power lines and are live.

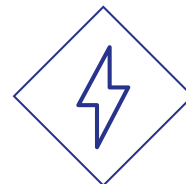


It is not normally practical for electricity companies to shroud high voltage conductors and even when low voltage conductors are shrouded, the shrouding is not designed to protect against contact by mechanical plant – again, always assume the lines are live.

2 Exclusion zones

Overhead power lines are not normally insulated and so any contact can result in serious or fatal injuries. Electricity at high voltages can also jump gaps with no warning whatsoever, so it is also dangerous to let your plant approach too close to a line. The distance that electricity can jump depends on the voltage of the line.


The higher the voltage, the further you must stay away from the line and any other equipment that may be fitted to the pole or pylon. This distance is called the **exclusion zone**. Examples of this are shown highlighted in the diagram below.

Exclusion zones are shown in blue

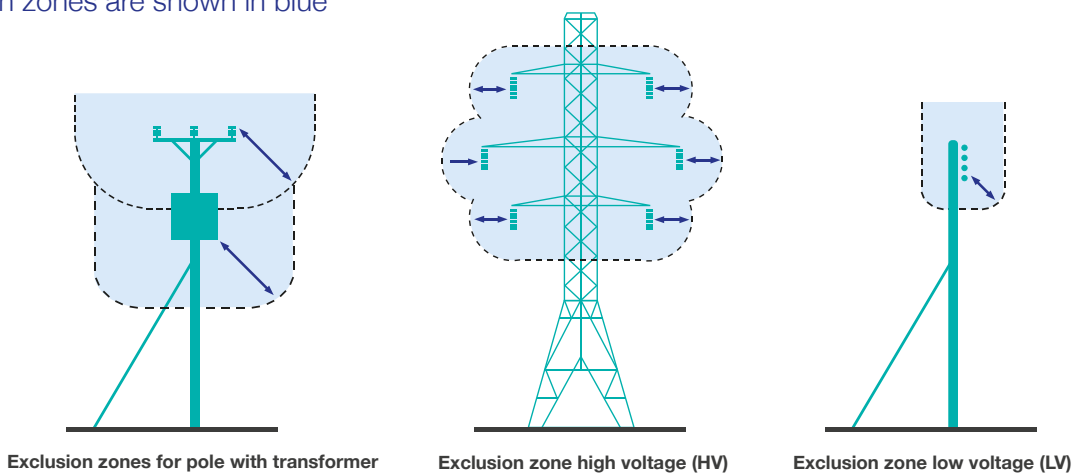

You must not allow any part of your plant to enter the **exclusion zone**. The diagram below shows typical types of overhead lines and provides a guide to help

you assess the line voltage of lines on wooden poles or steel pylons. The minimum **exclusion zone distance** is shown for each example.

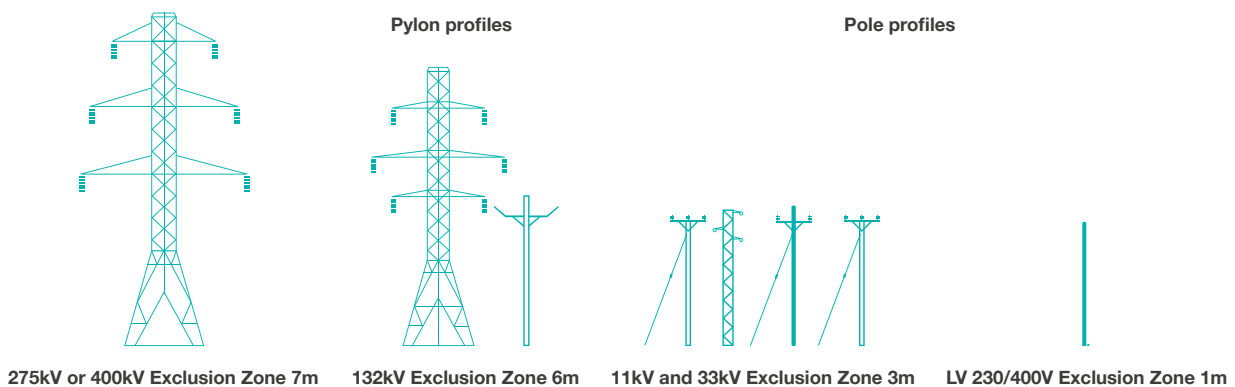

Please note that these are absolute minimum distances that should under no circumstances be infringed. If you do – it could prove fatal. As well as staying away from the lines or equipment, you should also stay at least

600mm away from any part of poles, pylons and stay wires. Please remember that is for guidance only, and if you are in any doubt, please call us for advice before setting up your plant or starting work.

3 Stand off distances

If there are power lines in the vicinity of your work the best way to make sure you stay out of the **exclusion zone** is to position your vehicle at a **safe stand off distance** so that, even when fully extended, no part of it can accidentally reach inside the **exclusion zone**.

This **safe stand off distance** can be calculated by adding the **exclusion zone** distance for the appropriate voltage of the line to the **maximum operating reach** of your vehicle.

This is shown in the diagram opposite.

If you position your vehicle outside of the **safe stand off distance**, there is no risk of accidental contact with the lines and no danger of electricity jumping from the line to your vehicle.

If you cannot achieve a **safe stand off distance**, consider moving your vehicle to a safer location.

It may make your job a bit more difficult, but if it means you stay away from the **exclusion zone** - it will be safer.

The next best option would be to consider using smaller plant with a **maximum operating reach** that cannot enter the **exclusion zone**.

You may not be able to achieve either of these options, so, as a last resort, if you cannot avoid operating large items of plant in the vicinity of lines, you must make sure that the plant is fitted with restraints to ensure that the **exclusion zone** cannot be entered.




These restraints may be electrical or hydraulic systems fitted to the plant, or mechanical devices such as chains.

Please seek advice from the plant manufacturer for more information on choices available for your particular item of plant. If you are using a mechanical excavator to dig parallel to the line, it is good practice to position the excavator with the tracks or wheels parallel to the line, so as you move along the excavation the safe stand off distance is easily maintained.

Care must also be taken to avoid non mechanical equipment, (e.g. scaffold poles, ladders and long loads such as lengths of steel or timber) from entering the exclusion zone.

Always maintain at least 600mm clearance from your plant to any of our poles, stay wires or pylons. Any contact with these by your plant could cause the line to break and fall to the ground.



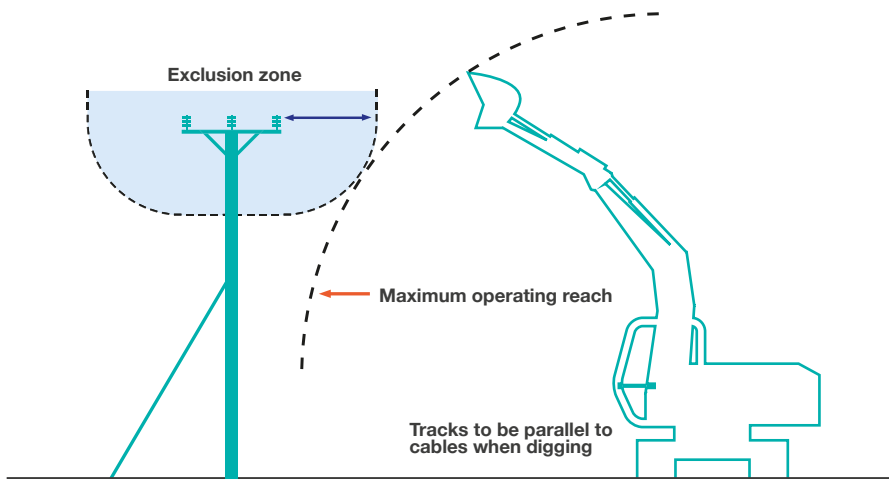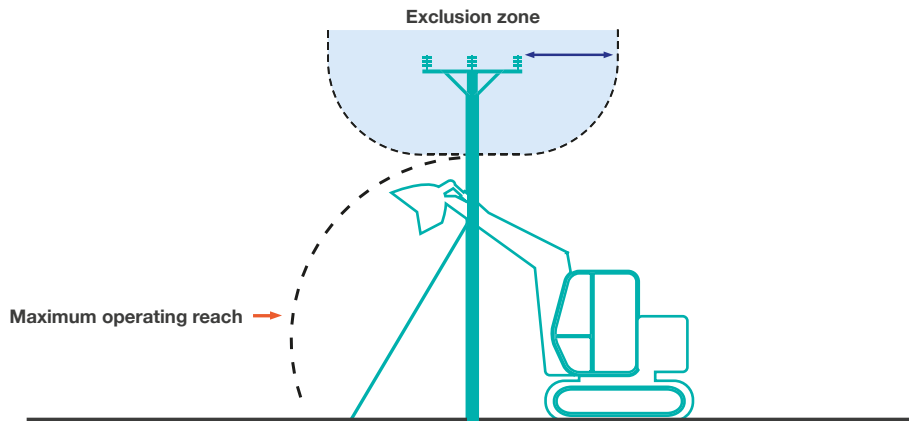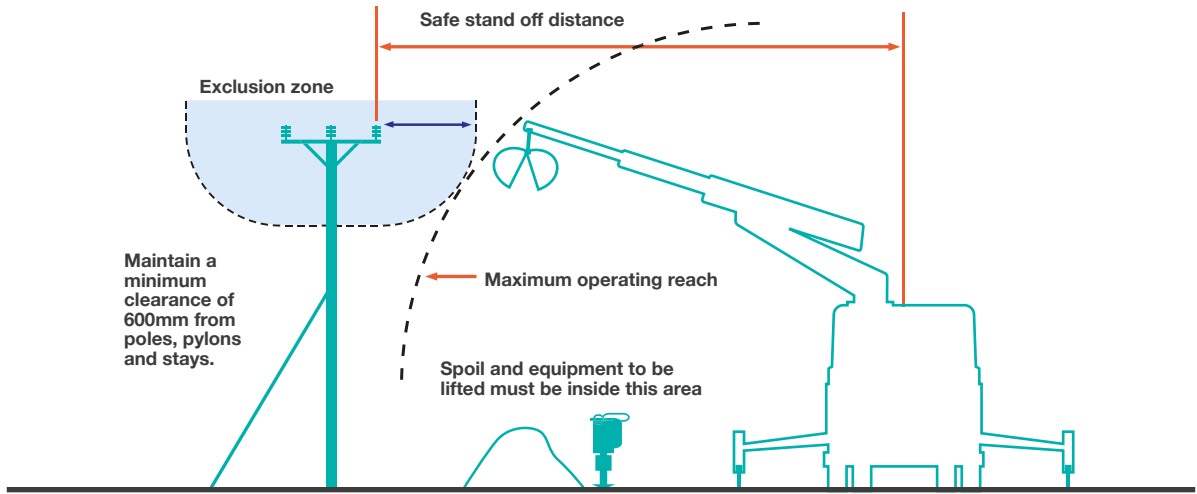

4 Emergency procedures

If contact is made with an overhead line, you must immediately clear the area and suspend all work within 50m of the damage because the line could still be live, or become live again.

The operator of a machine that is in contact with an overhead line should take the following steps:

If the machine is still operable:

- lower any raised parts that are controlled from the driving position and/or drive the vehicle clear of the line, as long as neither of these actions risk breaking the line or dragging it to the ground.

If the machine is not operable or cannot be driven clear of the line:

- stay in the cab
- contact your site manager or us immediately by radio or mobile phone or as soon as possible by any other method
- instruct everyone outside the vehicle not to approach it
- do not exit the cab until given confirmation by National Grid Electricity Distribution personnel that it is safe to do so.

If the machine is inoperable or cannot be driven free and there is risk of fire or other immediate hazard:

- jump clear of the vehicle, avoiding simultaneous contact with any part of the machine and the ground
- try to land with your feet as close together as possible
- where possible, continue to move away from the vehicle using “bunny hops” with your feet together until at least 15m from the vehicle
- instruct other people in the vicinity not to approach the vehicle
- do not return to the vehicle until given confirmation by National Grid Electricity Distribution personnel that it is safe to do so.

Whatever the circumstances please contact us on our emergency number immediately and tell us what has happened.

Please be ready to provide us with a contact telephone number and an accurate location or set of directions – this will help us in getting our staff to site quickly to minimise any danger and to reduce any disruption to your work.

**Our emergency number is:
105 or 0800 6783 105**

Please report any damage or contact no matter how minor they may seem to you at the time.

Whilst the damage may not cause a serious problem at the time of contact it could fail later, causing danger to our staff and members of the public, disruption to our customer’s supplies, and – if we trace the damage back to you – a larger repair bill!

CALL 105



5 More information

Proximity Warning Systems (such as Wire Watcher – see wirewatcher.co.uk for information) may be fitted to your vehicle. Never turn these devices off or disable them in any way.

Take note of any warnings these proximity warning systems may provide but do not use the presence of such devices as a reason not to follow the advice provided in this leaflet.

For your information, we are legally obliged to report all contact with our system to the Department of Trade and Industry (DTI), and, if you are an employer, you may be obliged to report incidents involving your staff or contractors to the Health & Safety Executive (HSE). Even if no one is hurt, you could still find yourself being prosecuted for causing a dangerous occurrence.

6 Further reading

For advice related to signing and guarding at longer term work sites please also refer to National Grid Electricity Distribution booklet “Avoidance of Danger from Electricity Overhead Lines and Underground Cables”. More detailed information is also published in the following documents available from the HSE.

GS6 – Avoidance of Danger from Overhead Lines.

HS(G) 47 – Avoiding Danger from Underground Services.


Along with Forestry Industry Safety Accord (FISA) publication **FISA 804 - Electricity at Work: Forestry.**



If you require more site-specific information relating to our equipment at your location please contact us on the relevant **general enquiries number**:

0800 096 3080

Finally... please, always remember that electricity overhead lines can be very dangerous – **the general rule is stay away and stay safe!**

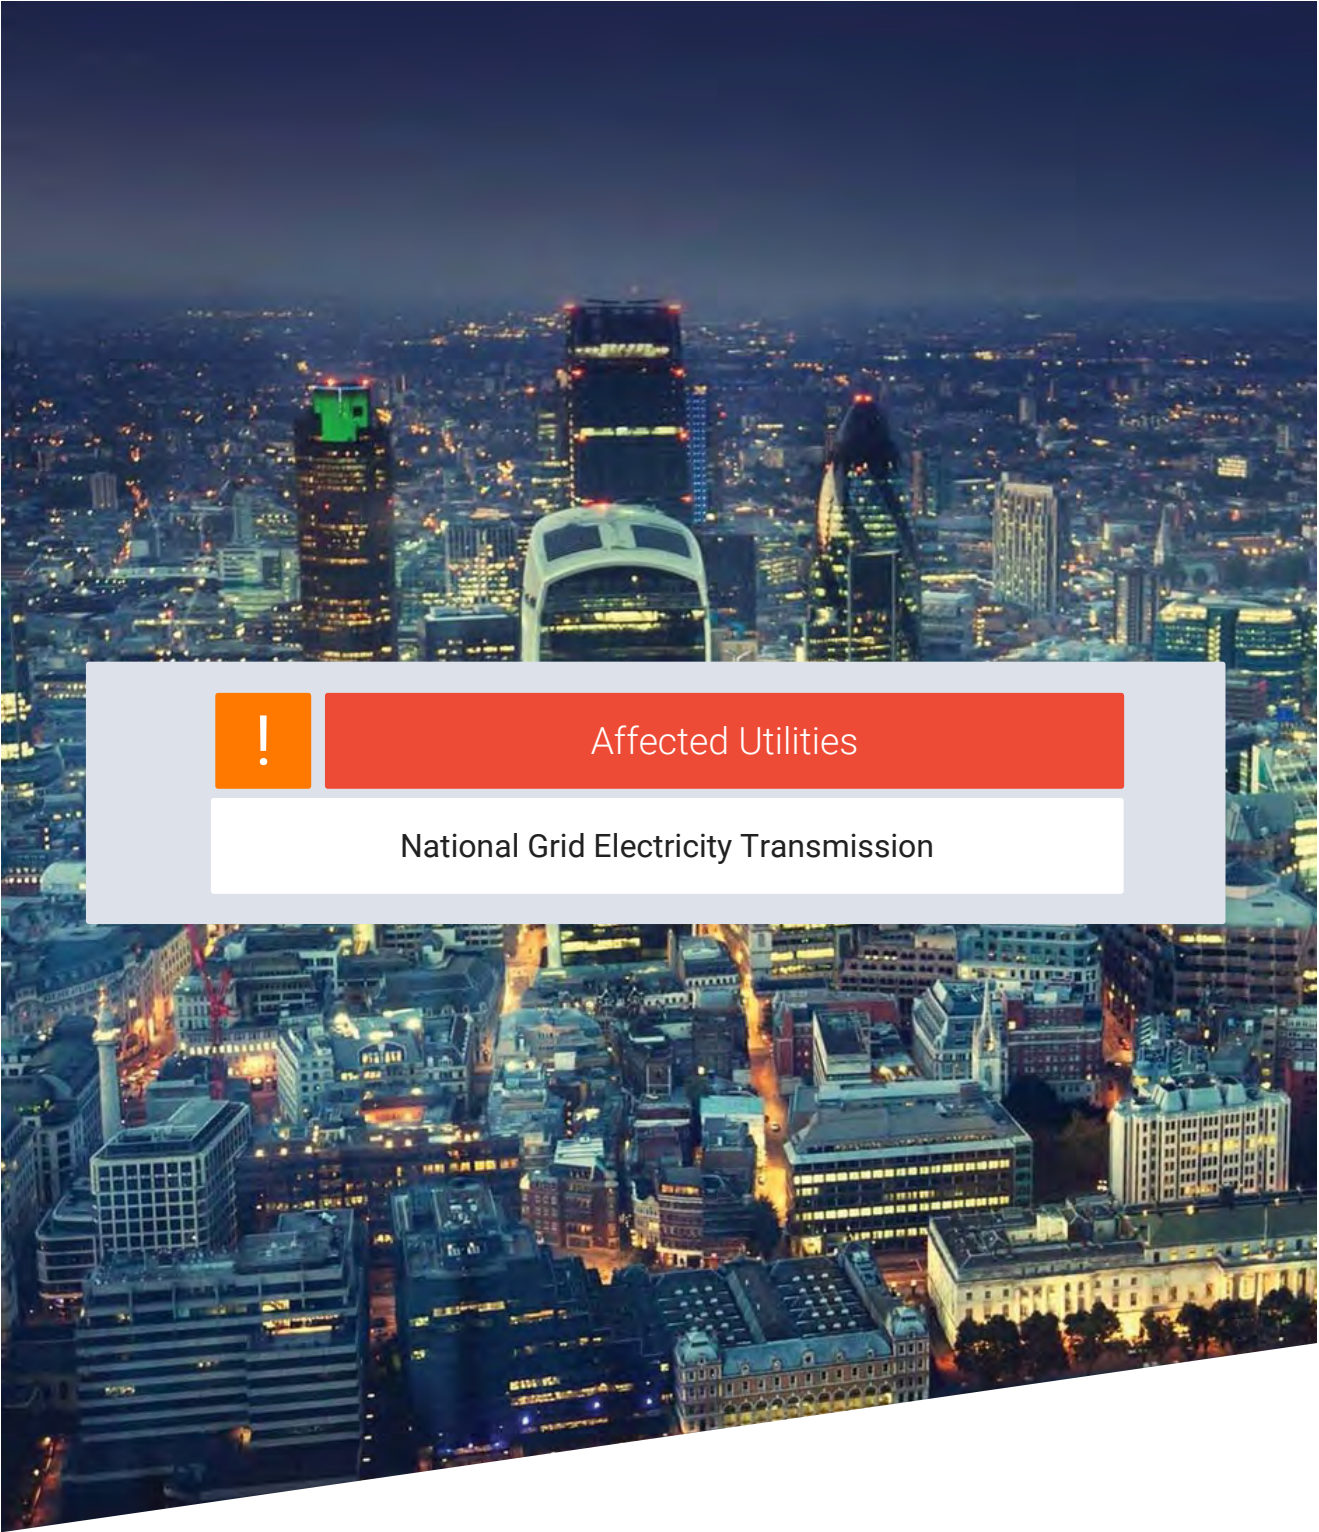

Affected Utilities

National Grid Electricity Transmission

Our Ref: 29406934 LM 203570/DK - 1

Monday, 08 May 2023

Ben Evans
The Hub, 500 Park Avenue, Aztec West

Bristol
BS32 4RZ

National Grid House
Warwick Technology Park
Gallows Hill, Warwick
CV34 6DA

Electricity Emergency Number:
0800 40 40 90*
*Available 24 hours, 7 days/week.
Calls may be recorded and monitored.
www.nationalgrid.com

Asset Protection
Gas Transmission
National Grid
Warwick
Email: assetprotection@nationalgrid.com

National Grid Electricity – Moderate Response Letter

Dear Sir/ Madam,

An assessment has been carried out with respect to National Grid Electricity Transmission plc's apparatus and the proposed work location. Based on the location entered into the system for assessment the area has been found to be outside the High Risk zone from National Grid Electricity Transmission plc's apparatus and can proceed. Should the work area change or type of activity being undertaken, a new enquiry must be submitted for assessment.

Please carefully read the guidance notes on the next pages.

You will have received cable route drawings if your enquiry is located within the Medium Risk zone from National Grid Electricity Transmission buried assets. Please familiarise yourself with the location of these assets and should the works location change a new enquiry must be submitted for assessment.

Please note this response and any attached map(s) are valid for 28 days from the date of this letter.

Yours sincerely

Asset Protection Team

Your Responsibilities and Obligations

The "Assessment" Section below outlines the detailed requirements that must be followed when planning or undertaking your activities at this location.

It is your responsibility to ensure that the information you have submitted is accurate and that all relevant documents including links are provided to all persons (either direct labour or contractors) working for you near National Grid Electricity Transmission plc's apparatus, e.g. as contained within the Construction (Design and Management) Regulations.

This assessment solely relates to National Grid Electricity Transmission plc (NGET)

This assessment does **NOT** include:

- National Grid's legal interest (easements or wayleaves) in the land which restricts activity in proximity to National Grid's assets in private land. You must obtain details of any such restrictions from the landowner in the first instance and if in doubt contact Asset Protection.
- Recently installed apparatus
- National Grid Gas plc.
- Apparatus owned by other organisations, e.g. Cadent, other gas distribution operators, local electricity companies, other utilities, etc.

It is **YOUR** responsibility to take into account whether the items listed above may be present and if they could be affected by your proposed activities.

This communication does not constitute any formal agreement or consent for any proposed development work; either generally or with regard to National Grid Electricity Transmission plc easements or wayleaves nor any planning or building regulations applications.

National Grid Electricity Transmission plc or their agents, servants or contractors do not accept any liability for any losses arising under or in connection with this information. This limit on liability applies to all and any claims in contract, tort (including negligence), misrepresentation (excluding fraudulent misrepresentation), breach of statutory duty or otherwise. This limit on liability does not exclude or restrict liability where prohibited by the law nor does it supersede the express terms of any related agreements.

If you require further assistance please contact the Asset Protection team via e-mail (assetprotection@nationalgrid.com) or via the contact details at the top of this response.

GUIDANCE

National Grid Electricity Transmission Network data

- The Network map for National Grid Electricity Transmission assets can be downloaded at the following link in GIS format.

<https://www.nationalgrid.com/uk/electricity-transmission/network-and-infrastructure/network-route-maps>

Overhead Lines

- National Grid's Overhead Line/s is protected by a Deed of Easement/Wayleave Agreement which provides full right of access to retain, maintain, repair and inspect our asset.
- The submitted proposed design does not change after the date of this letter. Any design change that moves the proposal closer to National Grid Overhead Line Assets shall be submitted for assessment.
- Statutory electrical safety clearances shall be maintained at all times. National Grid recommends that no permanent structures are built directly beneath our overhead lines. These distances are set out in EN 43 – 8 Technical Specification for “Overhead Line Clearances Issue 5 (2019). To purchase & download EN 43 – 8 Technical Specification for “Overhead Line Clearances Issue 5 (2019) go to <https://www.ena-eng.org/ENA-Docs/>
- Any changes in ground levels which are proposed either beneath or in close proximity to our existing overhead lines would serve to reduce safety clearances. Safety clearances to existing overhead lines must be maintained in all circumstances.
- To view the Development Near Overhead Lines Document.
<https://www.nationalgridet.com/document/130626/download>
- To view the National Grid Third Party Guidance for working near National Grid Electricity Transmission equipment.
<https://www.nationalgridet.com/sites/et/files/documents/Working%20near%20electricity%20equipment.pdf>
- The relevant guidance in relation to working safely near to existing overhead lines is contained within the Health and Safety Executive's (www.hse.gov.uk) Guidance Note GS 6 “Avoidance of Danger from Overhead Electric Lines.”
- If a landscaping scheme is proposed as part of the proposal, only slow and low growing species of trees and shrubs shall be planted beneath and adjacent to the existing overhead line to reduce the risk of growth to a height which compromises statutory safety clearances.
- Drilling or excavation works shall not be undertaken if they have the potential to disturb or adversely affect the foundations or “pillars of support” of our towers. These foundations extend beyond the base of the tower. Pillar of Support drawings shall be obtained using the contact details above.
- Due to the scale, bulk and cost of the transmission equipment required to operate at 275kV or 400kV we only support proposals for the relocation of existing high voltage overhead lines where such proposals directly facilitate a major development or infrastructure project of national importance which has been identified as such by government.
- To promote the successful development of sites crossed by existing overhead lines, and the creation of well-designed places, National Grid has produced ‘Design guidelines for development near pylons and high voltage overhead power lines’, which look at how to create high quality development near overhead lines and offer practical solutions which can assist in avoiding the unnecessary sterilisation of land in the vicinity of high voltage overhead lines.

- Further information regarding our undergrounding policy and development near transmission overhead lines is available on our website at: <https://www.nationalgridet.com/network-and-assets/planning-and-development>


Buried Cables

- National Grid's underground cables are protected by a Deed of grant; Easement; Wayleave Agreement or the provisions of the New Roads and Street Works Act. Which provide full right of access to retain, maintain, repair and inspect our asset. Hence we require that no permanent structures are to be built over our cables or within the easement strip.
- Ground levels above our cables must not be altered in any way. Any alterations to the depth of our cables will subsequently alter the rating of the circuit and can compromise the reliability, efficiency and safety of our electricity network.
- The supplied detailed route records should not be taken as positive indication of the cable location. This can only be determined by digging trial holes. Where trial holes are dug the concrete and / or polymeric cable protection tiles must not be disturbed.
- The normal recommendation is to keep 2 metres clear either side of the 1 metre wide trench containing the AC cable.
- National Grid should be made aware of the works starting and may put in place a representative to monitor the works. The works should be carried out in accordance with the recommendations in document HS (G) 47 available from the HSE web site.
- The relocation of existing underground cables is not normally feasible on grounds of cost, operation and maintenance and environmental impact and we believe that successful development can take place in their vicinity.
- The information supplied is given in good faith and only as a guide to the location of our underground cables. The accuracy of this information cannot be guaranteed. The physical presence of such cables may also be evident from physical protection measures such as ducts or concrete protection tiles. The person(s) responsible for planning, supervising and carrying out work in proximity to our cable(s) shall be liable to us, as cable(s) owner, as well as to any third party who may be affected in any way by any loss or damage resulting from their failure to locate and avoid any damage to such a cable(s).
- The relevant guidance in relation to working safely near to existing underground cables is contained within the Health and Safety Executive's (www.hse.gov.uk) Guidance HS(G)47 "Avoiding Danger From Underground Services" and all relevant site staff should make sure that they are both aware of and understand this guidance.
- Our cables are normally buried to a depth of 0.9 metres to the protective covers but this depth can vary depending on location (bridges may have cables 100mm below surface level)..The specific cable route record drawings show further details along the route of the particular cable. The cable route drawings are attached to this letter for your information.
- Cables installed in cable tunnels, whilst less likely to be affected by surface or shallow works may be affected by activities such as piling.
- National Grid assets can be adversely affected by vibration and can provide guidance on the acceptable levels of vibration due to piling and other construction related operations in the vicinity of national grid assets
- Ground cover above our cables should not be reduced or increased without consultation with National Grid.

- If a landscaping scheme is proposed as part of the works, we request that no trees and shrubs are planted either directly above or within 3 metres of the existing underground cable, as ultimately the roots may grow to cause damage to the cable.

Cables Tunnels

- National Grid's underground cable tunnels are protected by the provisions of a Wayleave/Easement or the New Roads and Street Works Act. This provides full right of access to retain, maintain, repair and inspect our asset.
- Further information and guidance regarding National Grid Cable Tunnels is available on our website at <https://www.nationalgrid.com/uk/electricity-transmission/document/121061/download>
- National Grid requires that the clearances indicated in the guidance document linked above are maintained at all times. Should it be necessary to enter the exclusion zone discussion/ agreement with National Grid is required to ensure the integrity of their tunnel asset and the high voltage cables is not compromised.
- Ground levels above our cable tunnels must not be altered in any way without prior agreement with National Grid; any alterations to the depth of our tunnels can compromise its integrity which could have an adverse impact on the reliability, efficiency and safety of our electricity network.
- Any works which would create high levels of vibration such as piling would need to be assessed by National Grid to ensure it has limited impact on our cable tunnels. National Grid can advise on acceptable vibration limits.

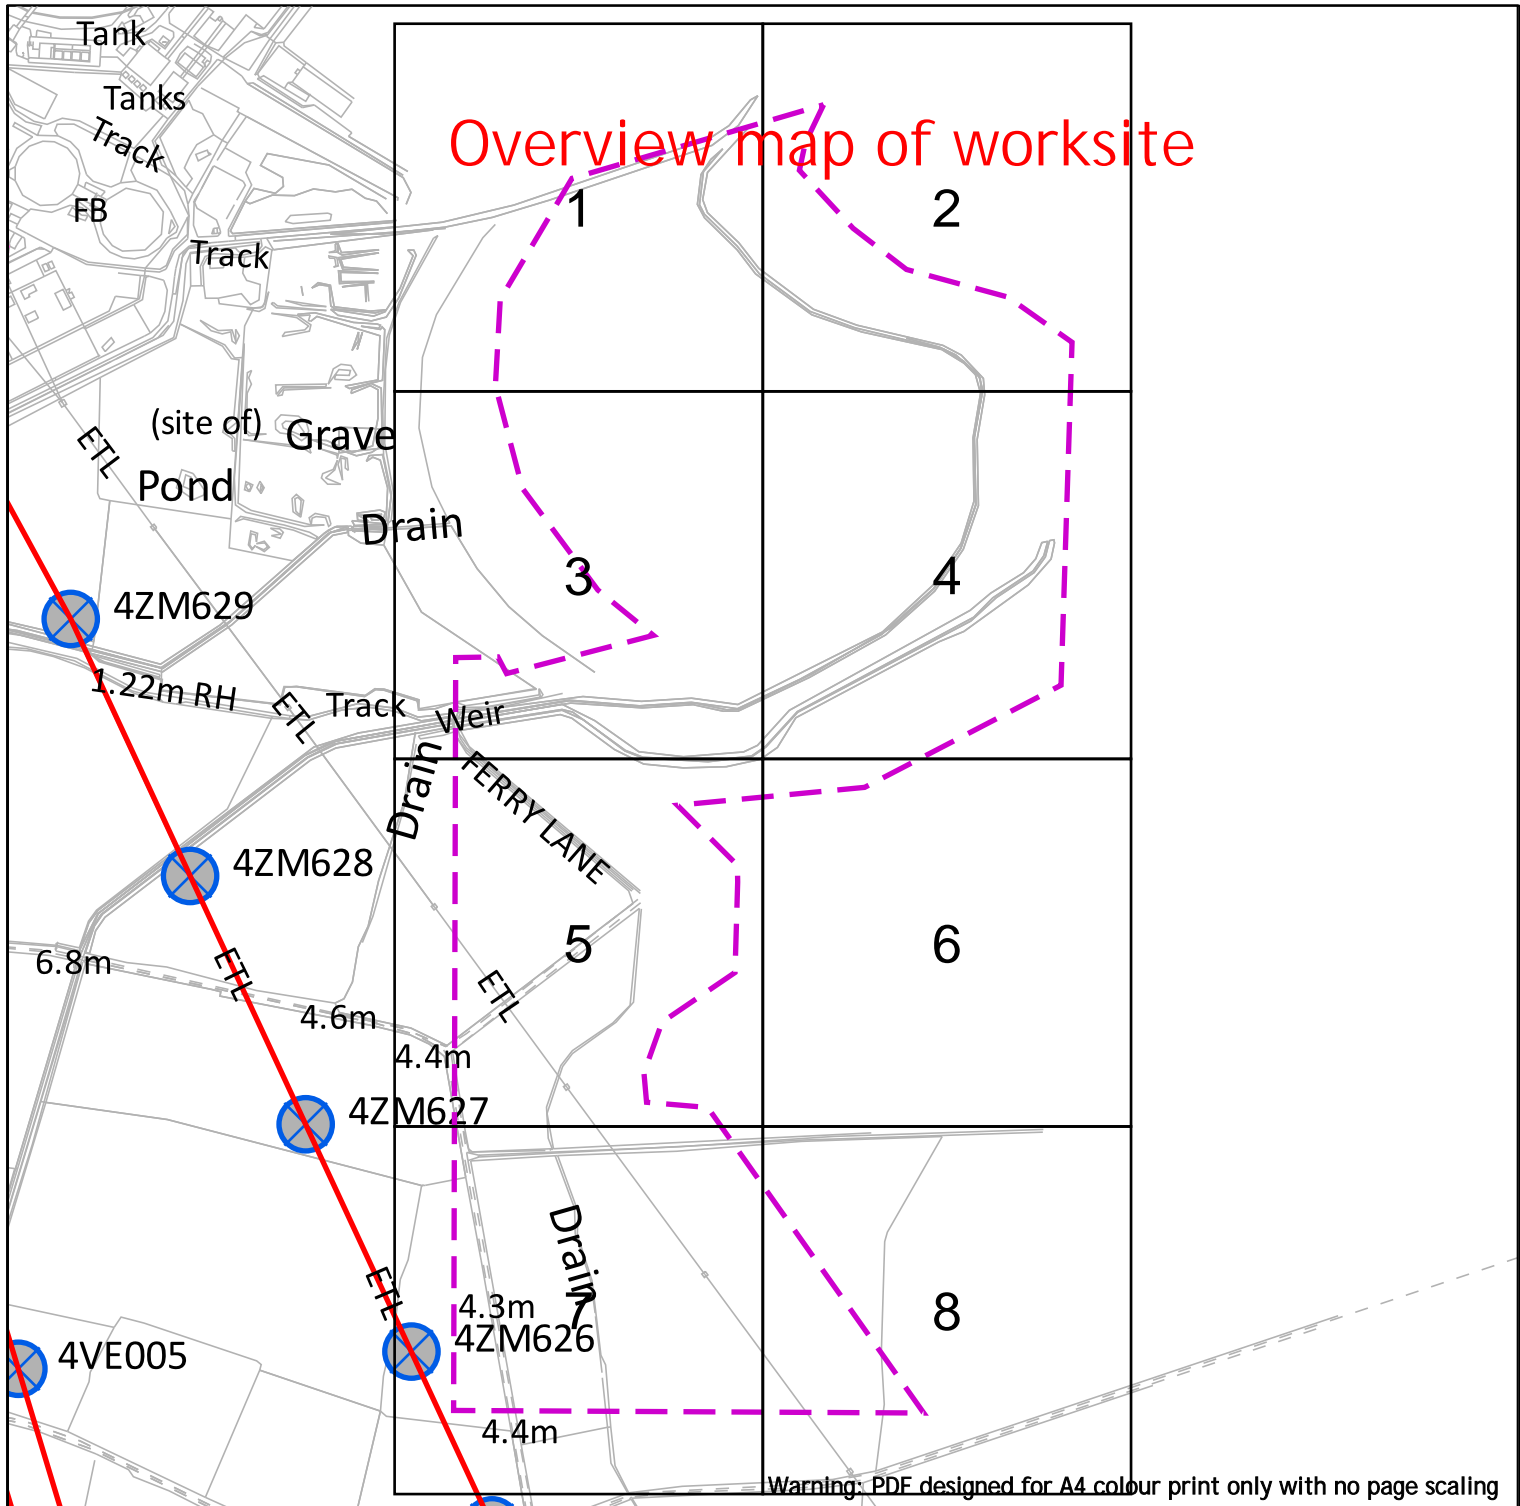

nationalgrid

**EXTREME CAUTION - HIGH VOLTAGE
RISK OF DEATH OR SERIOUS INJURY**

- Dig Sites
- Area:
- Line:
- Underground Cables
- Overhead Lines
- Fibre Cables

NationalGrid House
Warwick Technology Park
Gallows Hill
Warwick
CV34 6DA

AssetProtection@NationalGrid.com


Date Requested: 08/05/2023
Job Reference: 29406934
Site Location: 480476 384842
Requested by: Mr Ben Evans

Your Scheme/Reference: LM
203570/DK - 1

IMPORTANT NOTICES
This plan shows those pipes owned by National Grid Electricity Transmission plc in its role as a Licensed Electricity Transporter (ET). Electricity cables owned by other ETs, or otherwise privately owned, may be present in this area. Information with regards to such cables should be obtained from the relevant owners. The information shown on this plan is given without warranty, the accuracy thereof cannot be guaranteed. Ancillary equipment such as cooling systems and communication cables are not shown but their presence should be anticipated. No liability of any kind whatsoever is accepted by National Grid Electricity Transmission plc or their agents, servants or contractors for any error or omission. Safe digging practices, in accordance with HS(G)47, must be used to verify and establish the actual position of cables and other apparatus on site before any mechanical plant is used. It is your responsibility to ensure that this information is provided to all persons (either direct labour or contractors) working for you on or near electricity apparatus. The information included on this plan should not be referred to beyond a period of 28 days from the date of issue.

National Grid Electricity Emergency Number: 0800 40 40 90
Available 24 hours, 7 days/week. Calls may be recorded and monitored

Scale: 1:10250 (When plotted at A4)

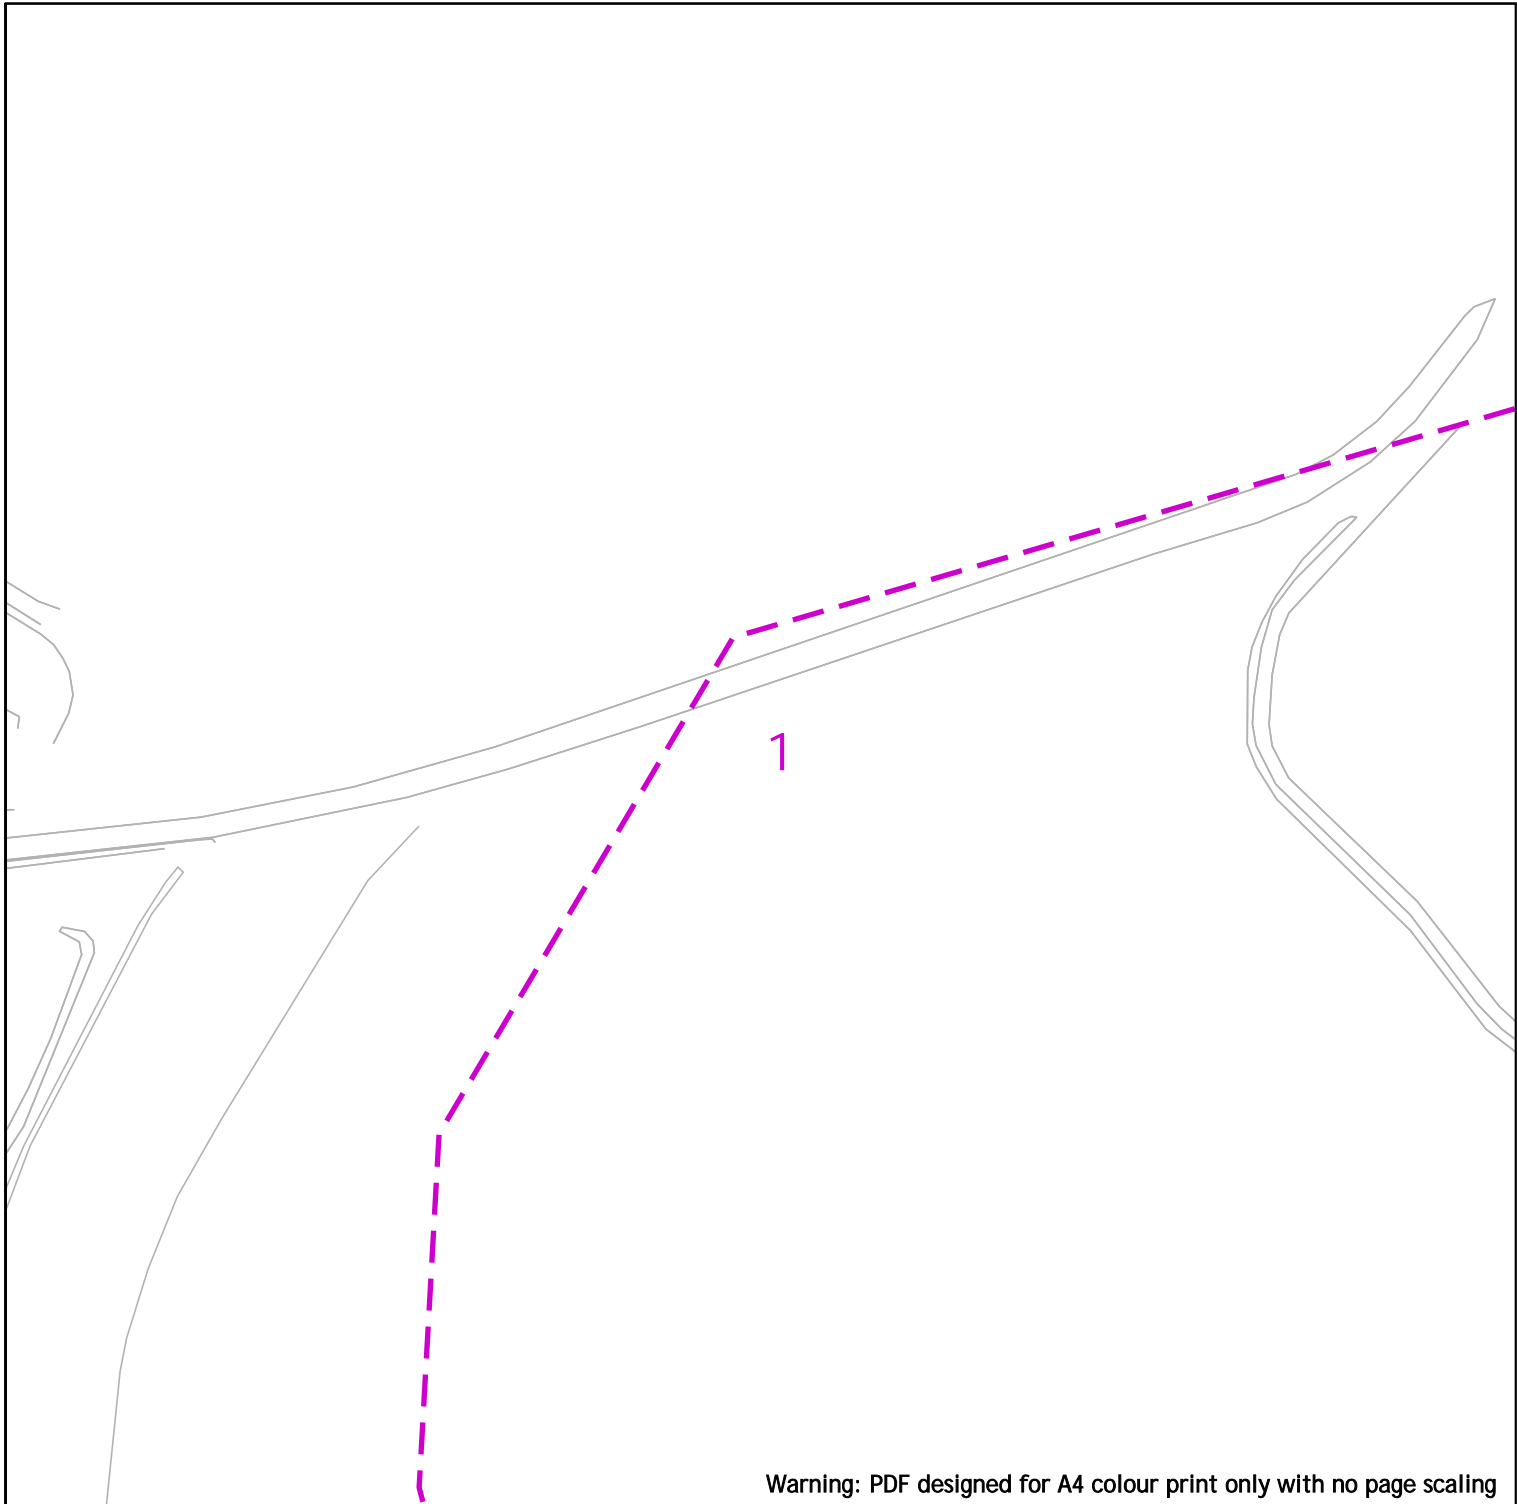

Warning: PDF designed for A4 colour print only with no page scaling

nationalgrid



**EXTREME CAUTION - HIGH VOLTAGE
RISK OF DEATH OR SERIOUS INJURY**

Dig Sites	Area:	Line:
	Underground Cables	
	Overhead Lines	
	Fibre Cables	

NationalGrid House
Warwick Technology Park
Gallows Hill
Warwick
CV34 6DA

AssetProtection@NationalGrid.com

Date Requested: 08/05/2023
Job Reference: 29406934
Site Location: 480476 384842
Requested by: Mr Ben Evans

Your Scheme/Reference: LM
203570/DK - 1


IMPORTANT NOTICES

This plan shows those pipes owned by National Grid Electricity Transmission plc in its role as a Licensed Electricity Transporter (ET). Electricity cables owned by other ETs, or otherwise privately owned, may be present in this area. Information with regards to such cables should be obtained from the relevant owners. The information shown on this plan is given without warranty, the accuracy thereof cannot be guaranteed. Ancillary equipment such as cooling systems and communication cables are not shown but their presence should be anticipated. No liability of any kind whatsoever is accepted by National Grid Electricity Transmission plc or their agents, servants or contractors for any error or omission. Safe digging practices, in accordance with HS(G)47, must be used to verify and establish the actual position of cables and other apparatus on site before any mechanical plant is used. It is your responsibility to ensure that this information is provided to all persons (either direct labour or contractors) working for you on or near electricity apparatus. The information included on this plan should not be referred to beyond a period of 28 days from the date of issue.

National Grid Electricity Emergency Number: 0800 40 40 90

Available 24 hours, 7 days/week. Calls may be recorded and monitored

Scale: 1:2500 (When plotted at A4)

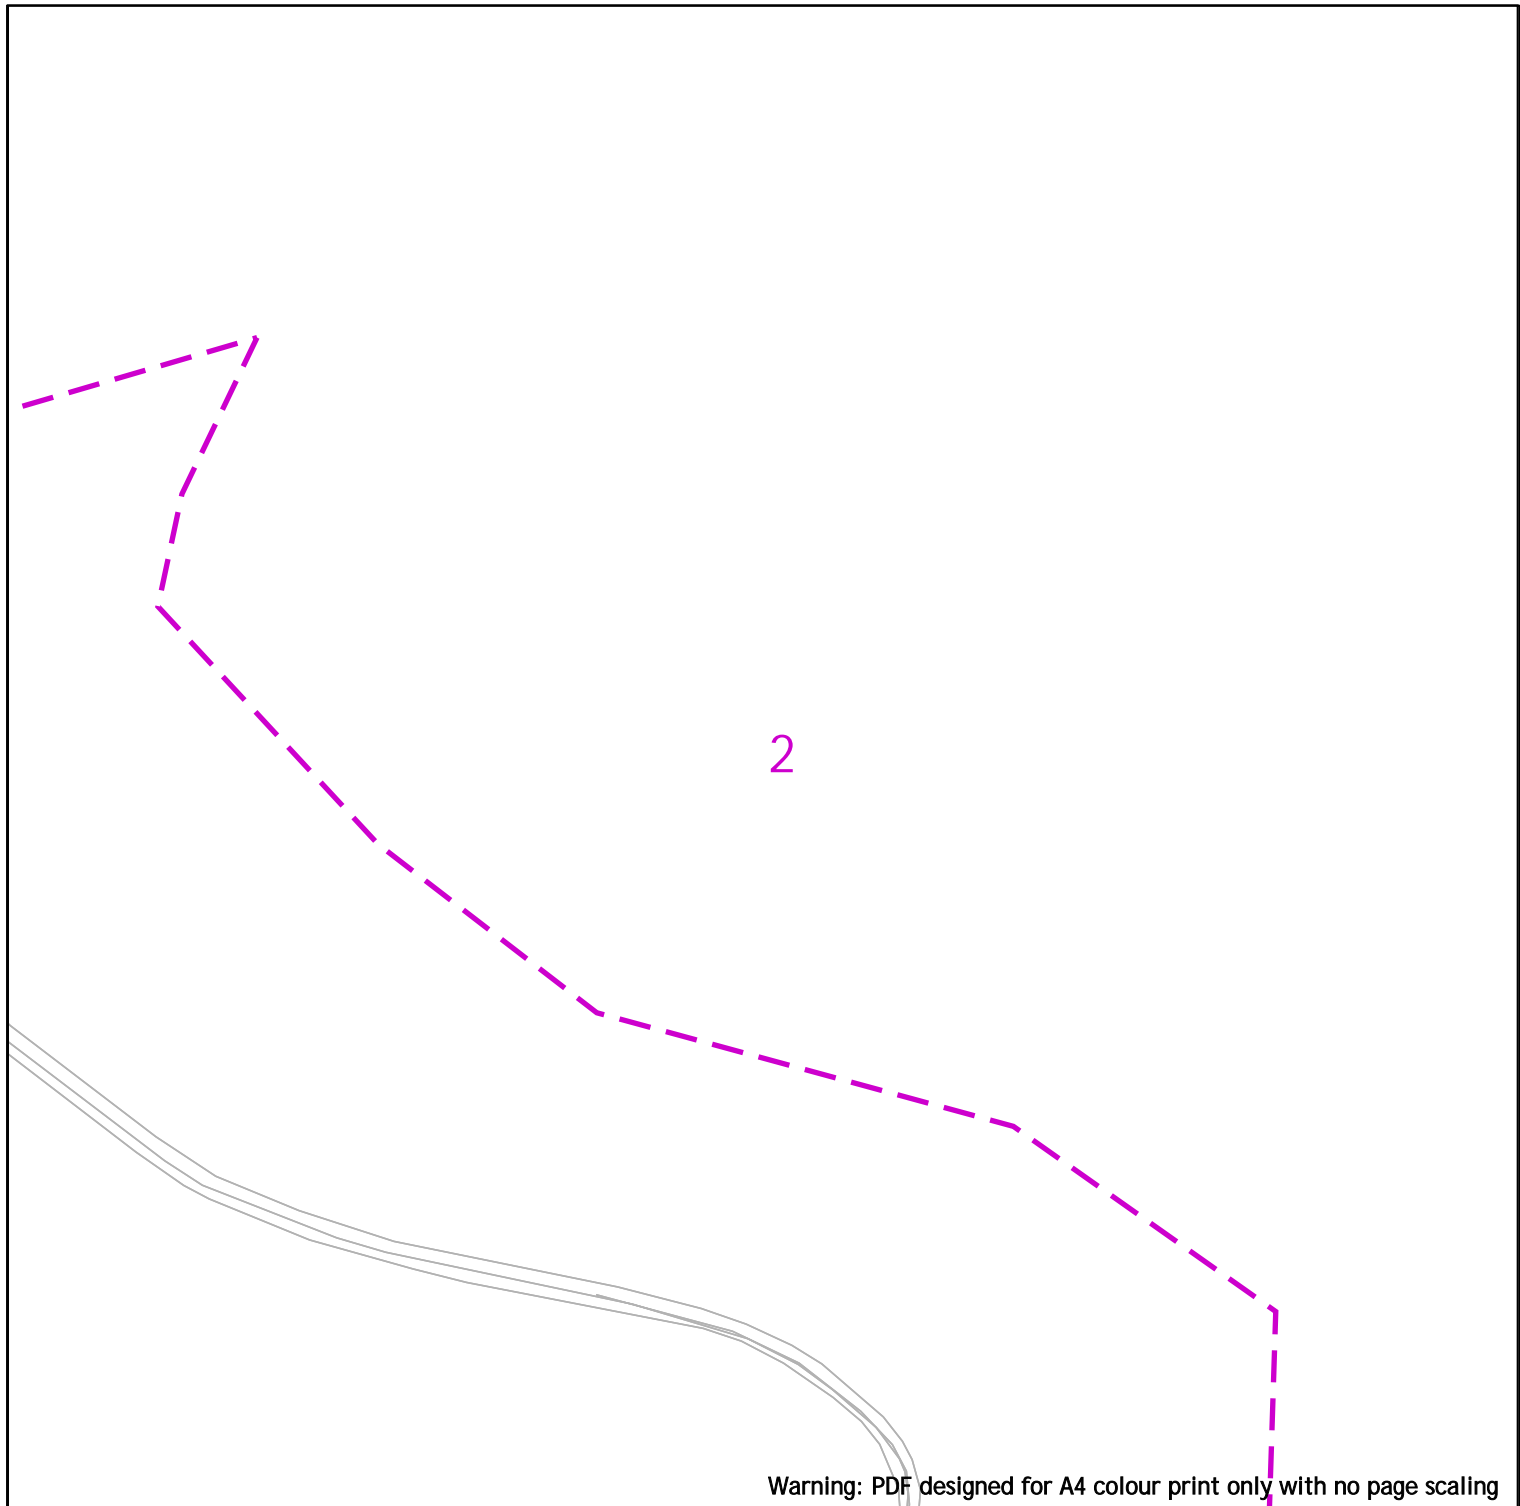

Warning: PDF designed for A4 colour print only with no page scaling



**EXTREME CAUTION - HIGH VOLTAGE
RISK OF DEATH OR SERIOUS INJURY**

NationalGrid House
Warwick Technology Park
Gallows Hill
Warwick
CV34 6DA

AssetProtection@NationalGrid.com

Dig Sites	Area:	Line:
	Underground Cables	
	Overhead Lines	
	Fibre Cables	

Date Requested: 08/05/2023
Job Reference: 29406934
Site Location: 480476 384842
Requested by: Mr Ben Evans


Your Scheme/Reference: LM
203570/DK - 1

Scale: 1:2500 (When plotted at A4)

IMPORTANT NOTICES
This plan shows those pipes owned by National Grid Electricity Transmission plc in its role as a Licensed Electricity Transporter (ET). Electricity cables owned by other ETs, or otherwise privately owned, may be present in this area. Information with regards to such cables should be obtained from the relevant owners. The information shown on this plan is given without warranty, the accuracy thereof cannot be guaranteed. Ancillary equipment such as cooling systems and communication cables are not shown but their presence should be anticipated. No liability of any kind whatsoever is accepted by National Grid Electricity Transmission plc or their agents, servants or contractors for any error or omission. Safe digging practices, in accordance with HS(G)47, must be used to verify and establish the actual position of cables and other apparatus on site before any mechanical plant is used. It is your responsibility to ensure that this information is provided to all persons (either direct labour or contractors) working for you on or near electricity apparatus. The information included on this plan should not be referred to beyond a period of 28 days from the date of issue.

National Grid Electricity Emergency Number: 0800 40 40 90
Available 24 hours, 7 days/week. Calls may be recorded and monitored

Crown Copyright © - Reproduced by permission of Ordnance Survey on behalf of HMSO. And database right 2023. All rights reserved. Ordnance Survey Licence number 0100059731.

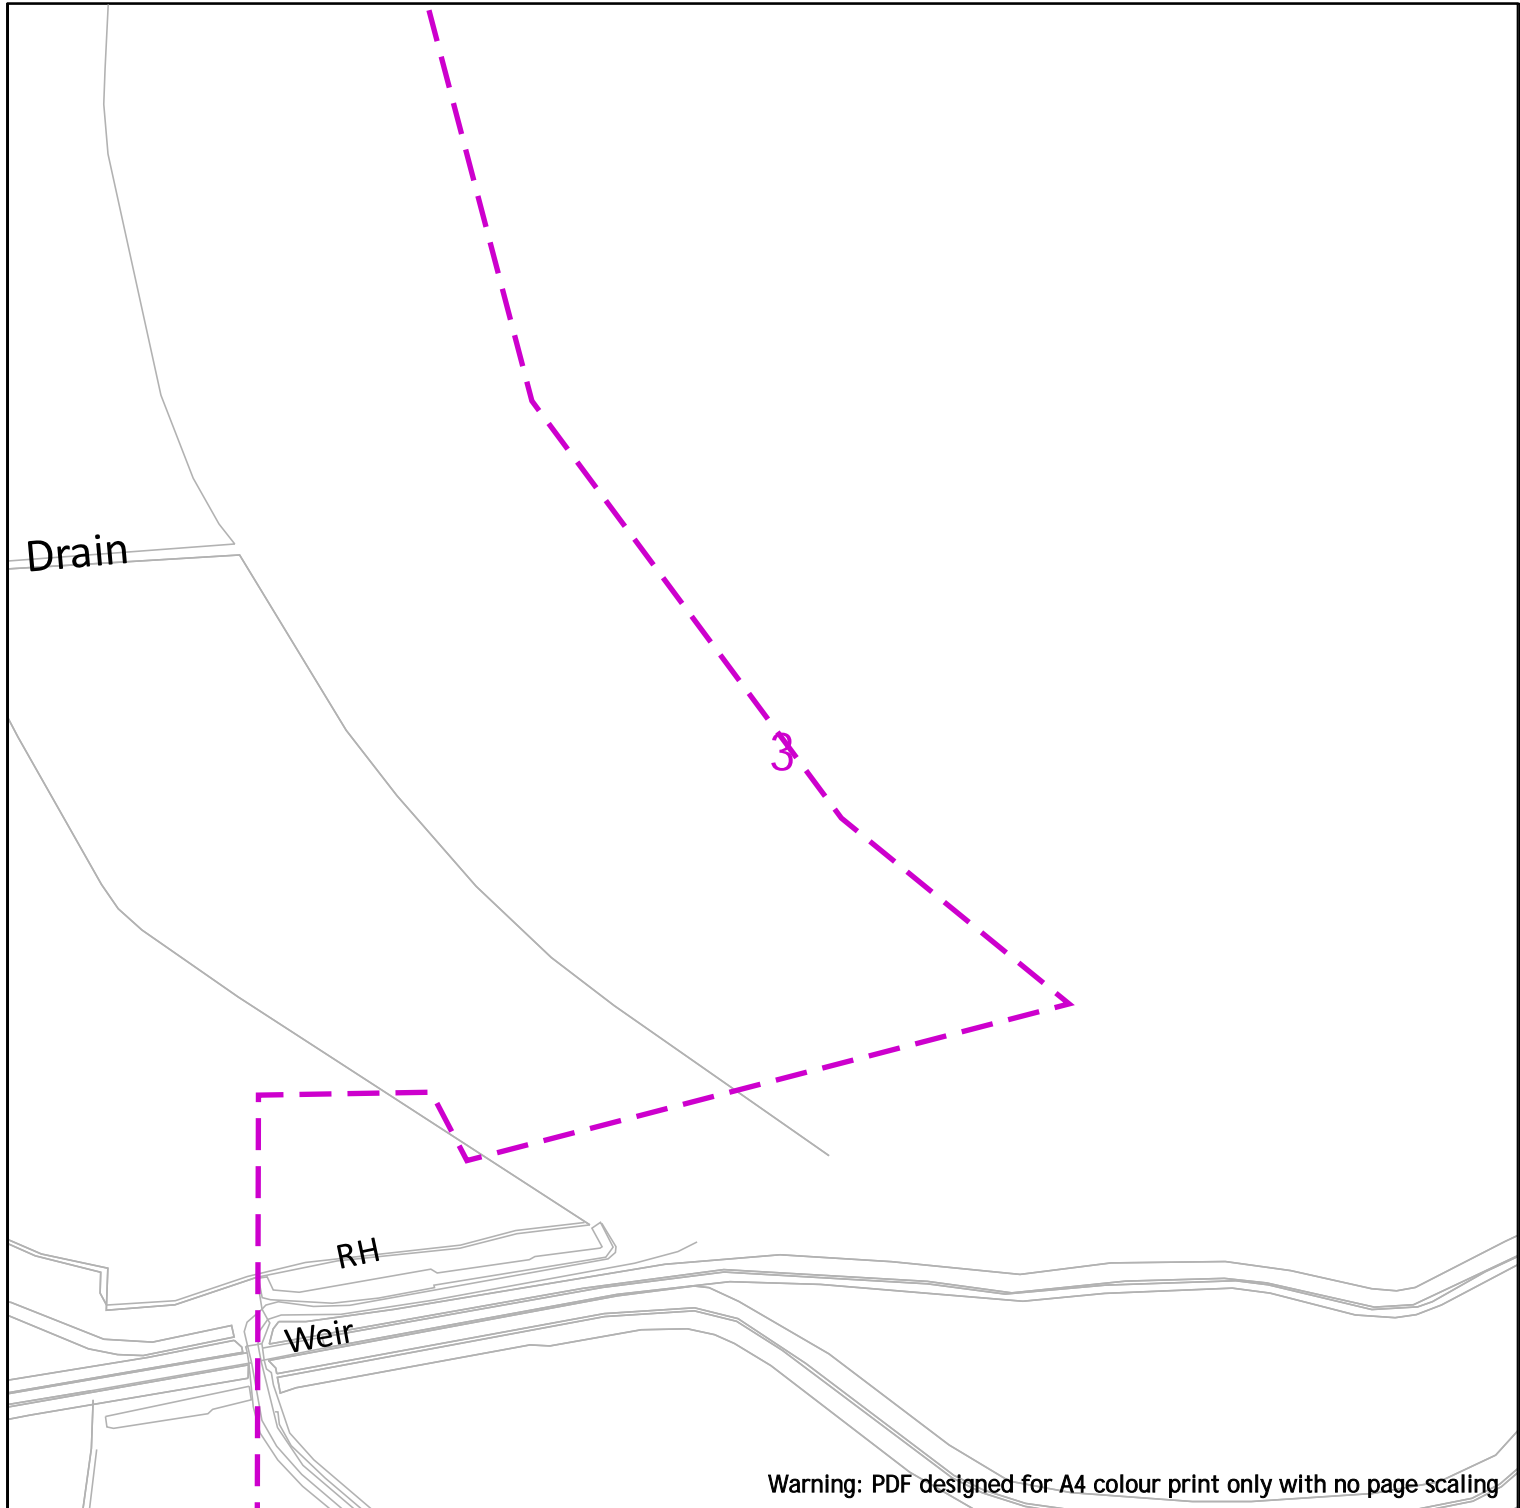

Warning: PDF designed for A4 colour print only with no page scaling

nationalgrid




**EXTREME CAUTION - HIGH VOLTAGE
RISK OF DEATH OR SERIOUS INJURY**

NationalGrid House
Warwick Technology Park
Gallows Hill
Warwick
CV34 6DA

AssetProtection@NationalGrid.com

Date Requested: 08/05/2023
Job Reference: 29406934
Site Location: 480476 384842
Requested by: Mr Ben Evans

Your Scheme/Reference: LM
203570/DK - 1

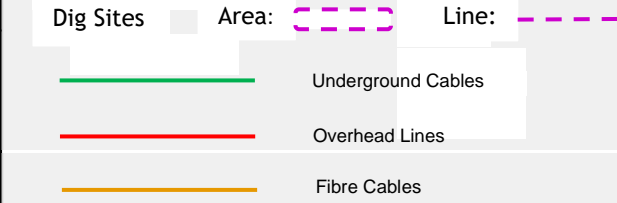


IMPORTANT NOTICES
This plan shows those pipes owned by National Grid Electricity Transmission plc in its role as a Licensed Electricity Transporter (ET). Electricity cables owned by other ETs, or otherwise privately owned, may be present in this area. Information with regards to such cables should be obtained from the relevant owners. The information shown on this plan is given without warranty, the accuracy thereof cannot be guaranteed. Ancillary equipment such as cooling systems and communication cables are not shown but their presence should be anticipated. No liability of any kind whatsoever is accepted by National Grid Electricity Transmission plc or their agents, servants or contractors for any error or omission. Safe digging practices, in accordance with HS(G)47, must be used to verify and establish the actual position of cables and other apparatus on site before any mechanical plant is used. It is your responsibility to ensure that this information is provided to all persons (either direct labour or contractors) working for you on or near electricity apparatus. The information included on this plan should not be referred to beyond a period of 28 days from the date of issue.

National Grid Electricity Emergency Number: 0800 40 40 90
Available 24 hours, 7 days/week. Calls may be recorded and monitored

Scale: 1:2500 (When plotted at A4)

Crown Copyright © - Reproduced by permission of Ordnance Survey on behalf of HMSO. And database right 2023. All rights reserved. Ordnance Survey Licence number 0100059731.

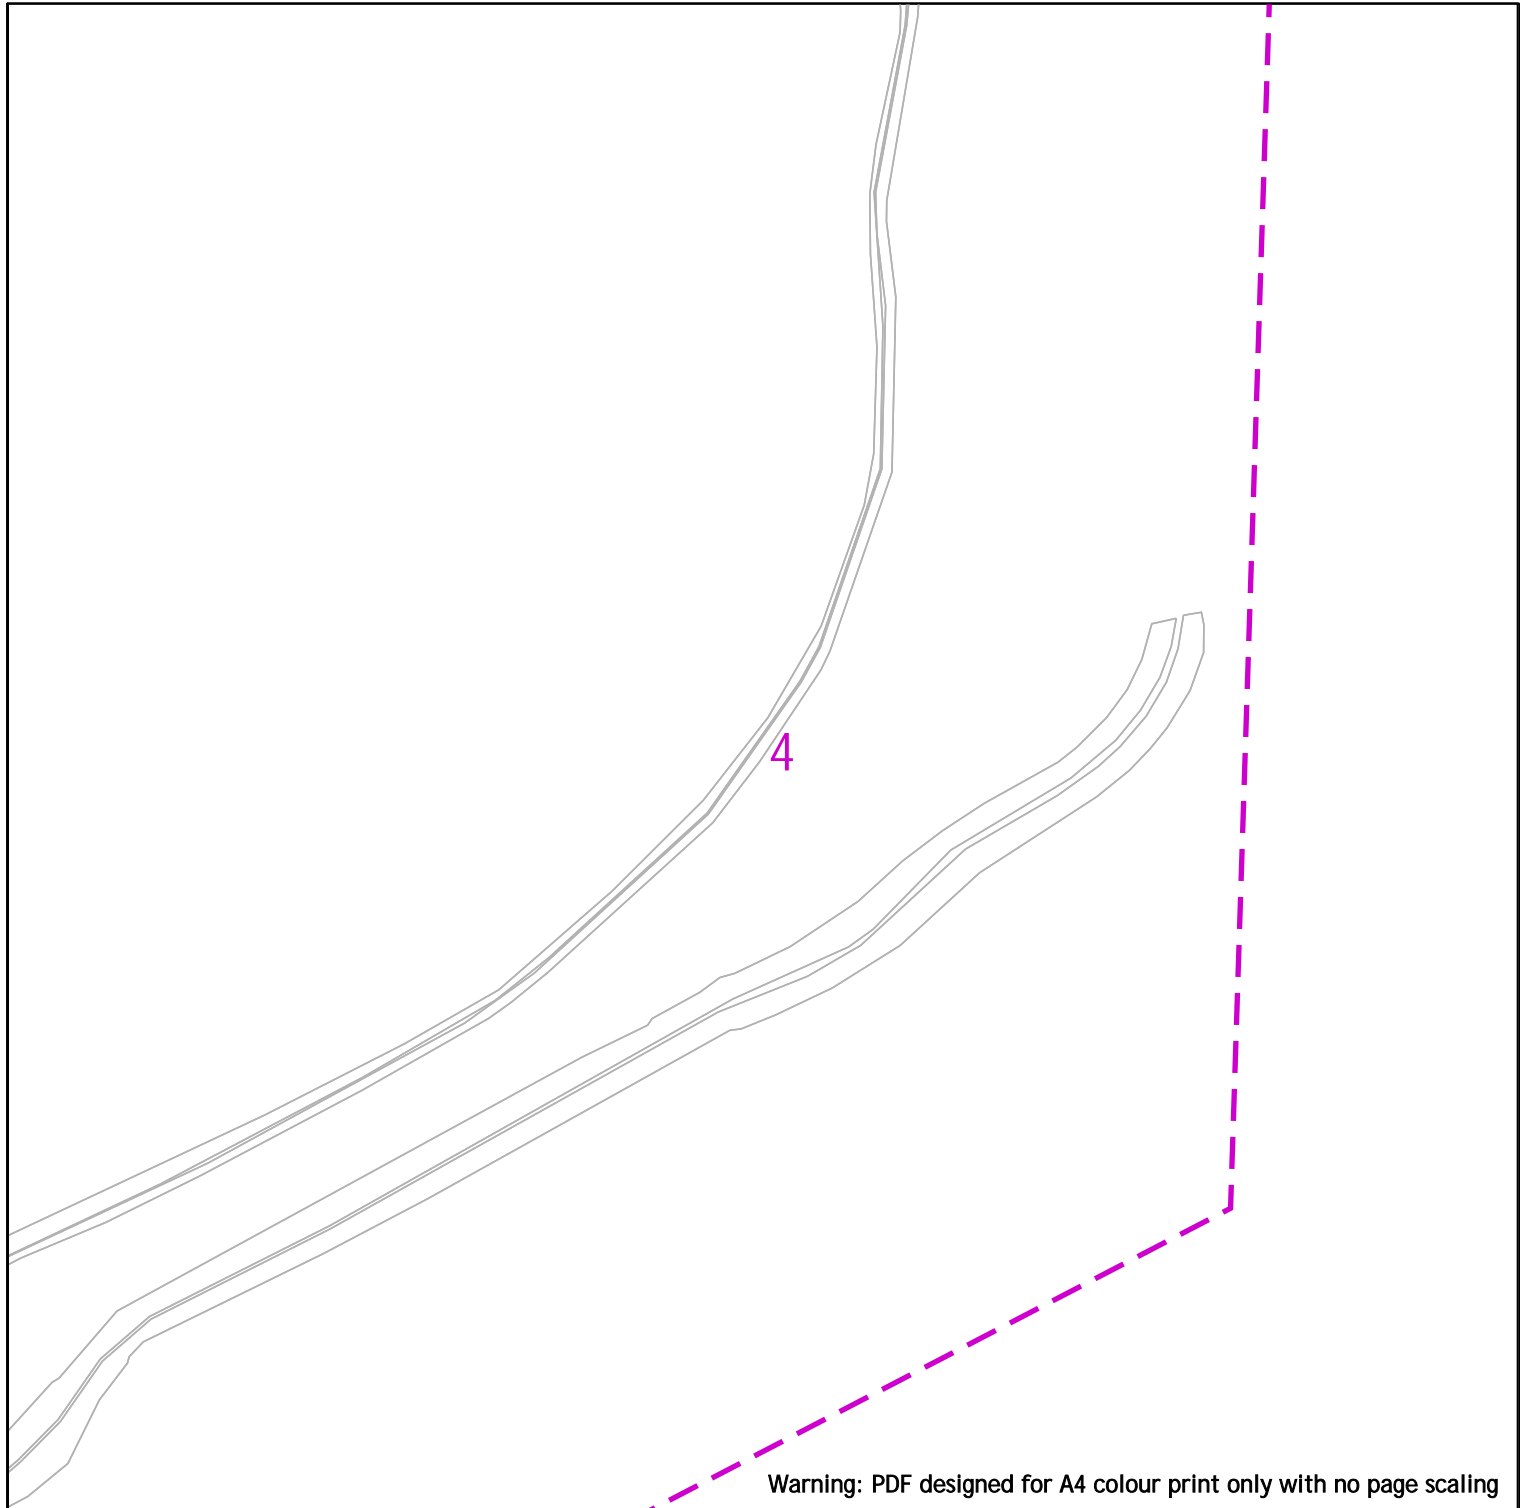

Warning: PDF designed for A4 colour print only with no page scaling

nationalgrid



**EXTREME CAUTION - HIGH VOLTAGE
RISK OF DEATH OR SERIOUS INJURY**

Dig Sites	Area:	Line:

NationalGrid House
Warwick Technology Park
Gallows Hill
Warwick
CV34 6DA

AssetProtection@NationalGrid.com

Date Requested: 08/05/2023
Job Reference: 29406934
Site Location: 480476 384842
Requested by: Mr Ben Evans


Your Scheme/Reference: LM
203570/DK - 1

IMPORTANT NOTICES

This plan shows those pipes owned by National Grid Electricity Transmission plc in its role as a Licensed Electricity Transporter (ET). Electricity cables owned by other ETs, or otherwise privately owned, may be present in this area. Information with regards to such cables should be obtained from the relevant owners. The information shown on this plan is given without warranty, the accuracy thereof cannot be guaranteed. Ancillary equipment such as cooling systems and communication cables are not shown but their presence should be anticipated. No liability of any kind whatsoever is accepted by National Grid Electricity Transmission plc or their agents, servants or contractors for any error or omission. Safe digging practices, in accordance with HS(G)47, must be used to verify and establish the actual position of cables and other apparatus on site before any mechanical plant is used. It is your responsibility to ensure that this information is provided to all persons (either direct labour or contractors) working for you on or near electricity apparatus. The information included on this plan should not be referred to beyond a period of 28 days from the date of issue.

National Grid Electricity Emergency Number: 0800 40 40 90
Available 24 hours, 7 days/week. Calls may be recorded and monitored

Scale: 1:2500 (When plotted at A4)

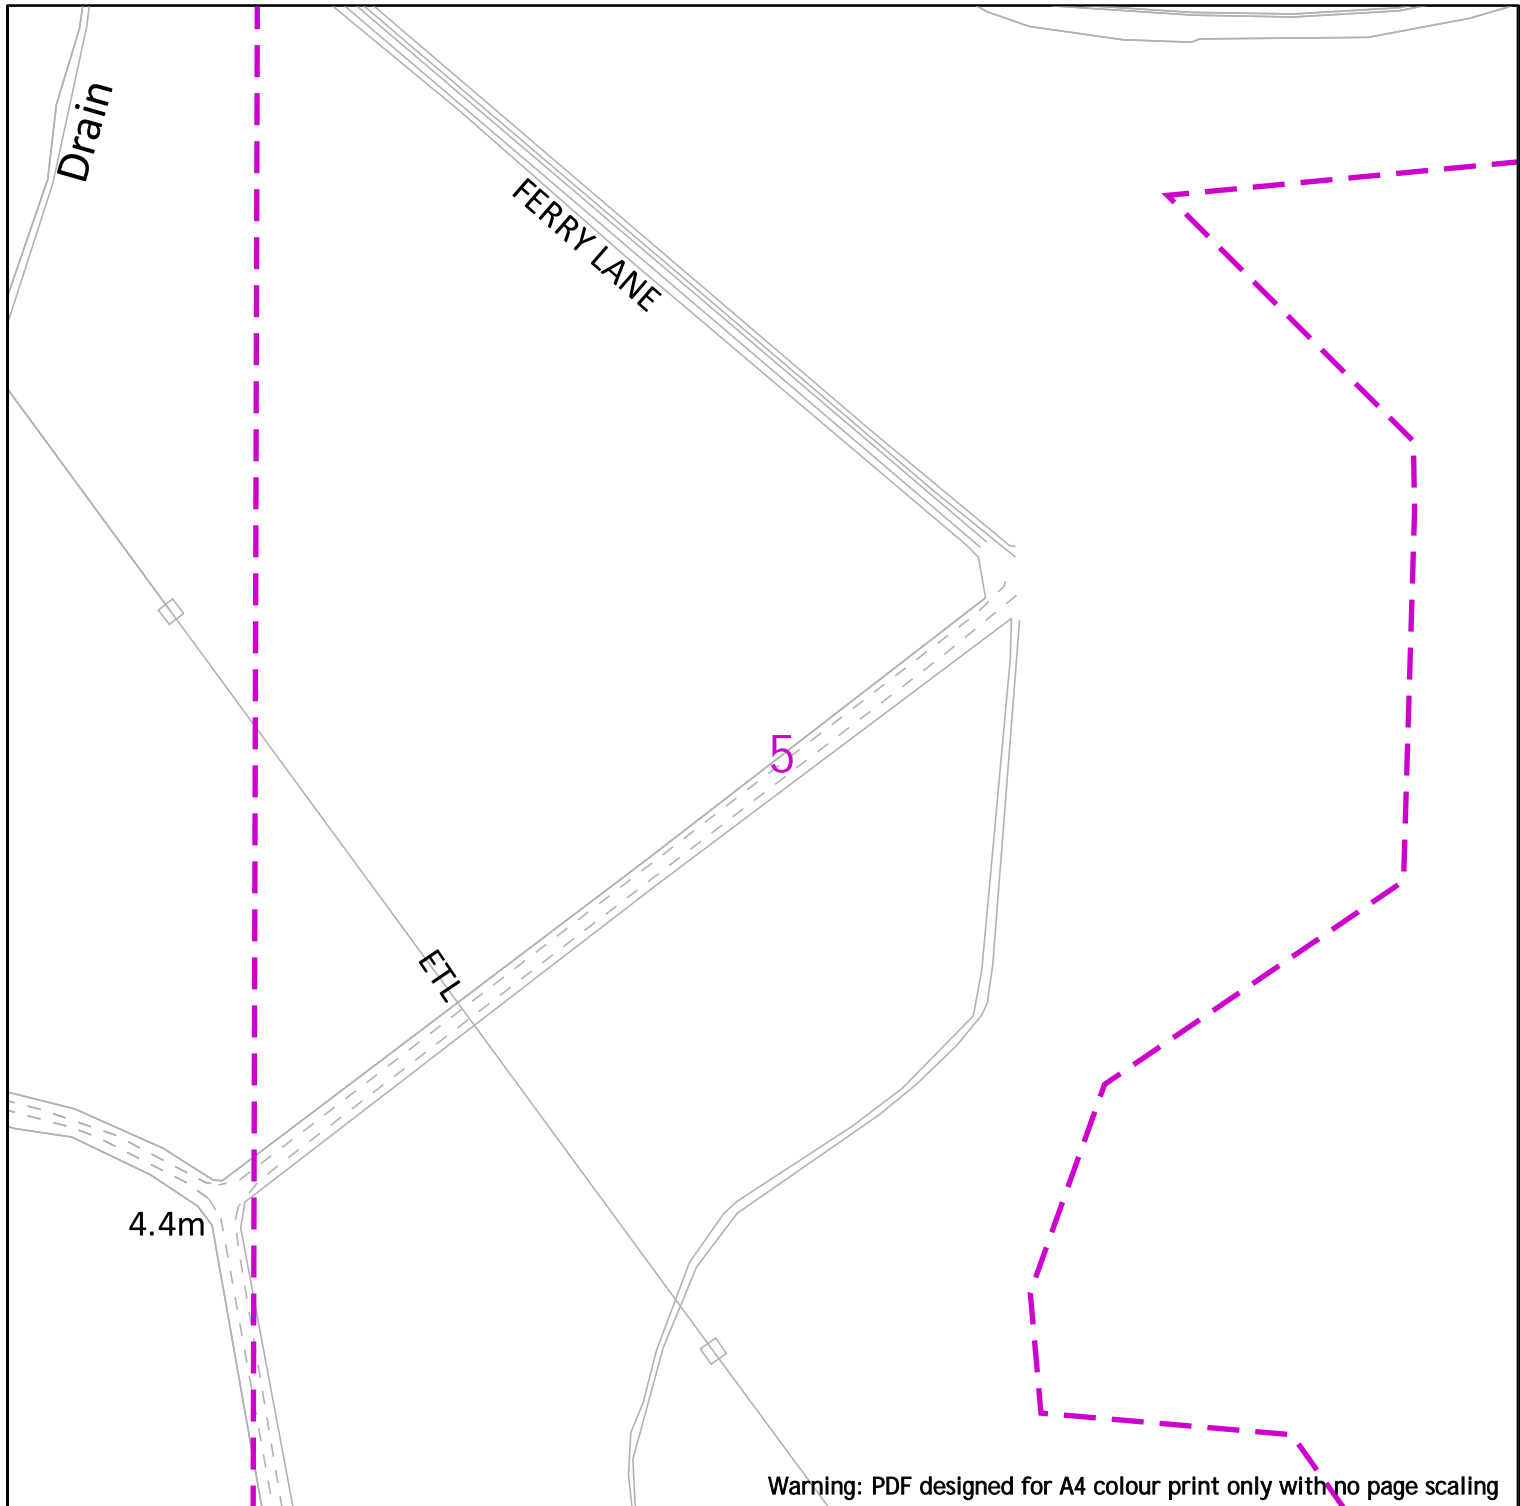

Warning: PDF designed for A4 colour print only with no page scaling



EXTREME CAUTION - HIGH VOLTAGE
****RISK OF DEATH OR SERIOUS INJURY****

Dig Sites	Area:	Line:
	Underground Cables	
	Overhead Lines	
	Fibre Cables	

NationalGrid House
 Warwick Technology Park
 Gallows Hill
 Warwick
 CV34 6DA
 AssetProtection@NationalGrid.com

Date Requested: 08/05/2023
 Job Reference: 29406934
 Site Location: 480476 384842
 Requested by: Mr Ben Evans
 Your Scheme/Reference: LM
 203570/DK - 1

IMPORTANT NOTICES

This plan shows those pipes owned by National Grid Electricity Transmission plc in its role as a Licensed Electricity Transporter (ET). Electricity cables owned by other ETs, or otherwise privately owned, may be present in this area. Information with regards to such cables should be obtained from the relevant owners. The information shown on this plan is given without warranty, the accuracy thereof cannot be guaranteed. Ancillary equipment such as cooling systems and communication cables are not shown but their presence should be anticipated. No liability of any kind whatsoever is accepted by National Grid Electricity Transmission plc or their agents, servants or contractors for any error or omission. Safe digging practices, in accordance with HS(G)47, must be used to verify and establish the actual position of cables and other apparatus on site before any mechanical plant is used. It is your responsibility to ensure that this information is provided to all persons (either direct labour or contractors) working for you on or near electricity apparatus. The information included on this plan should not be referred to beyond a period of 28 days from the date of issue.

National Grid Electricity Emergency Number: 0800 40 40 90
 Available 24 hours, 7 days/week. Calls may be recorded and monitored

Scale: 1:2500 (When plotted at A4)

Warning: PDF designed for A4 colour print only with no page scaling



EXTREME CAUTION - HIGH VOLTAGE
****RISK OF DEATH OR SERIOUS INJURY****

NationalGrid House
Warwick Technology Park
Gallows Hill
Warwick
CV34 6DA

AssetProtection@NationalGrid.com

Dig Sites Area: Line:

 Underground Cables

 Overhead Lines

 Fibre Cables


Date Requested: 08/05/2023
Job Reference: 29406934
Site Location: 480476 384842
Requested by: Mr Ben Evans

Your Scheme/Reference: LM
203570/DK - 1

IMPORTANT NOTICES
This plan shows those pipes owned by National Grid Electricity Transmission plc in its role as a Licensed Electricity Transporter (ET). Electricity cables owned by other ETs, or otherwise privately owned, may be present in this area. Information with regards to such cables should be obtained from the relevant owners. The information shown on this plan is given without warranty, the accuracy thereof cannot be guaranteed. Ancillary equipment such as cooling systems and communication cables are not shown but their presence should be anticipated. No liability of any kind whatsoever is accepted by National Grid Electricity Transmission plc or their agents, servants or contractors for any error or omission. Safe digging practices, in accordance with HS(G)47, must be used to verify and establish the actual position of cables and other apparatus on site before any mechanical plant is used. It is your responsibility to ensure that this information is provided to all persons (either direct labour or contractors) working for you on or near electricity apparatus. The information included on this plan should not be referred to beyond a period of 28 days from the date of issue.

National Grid Electricity Emergency Number: 0800 40 40 90
Available 24 hours, 7 days/week. Calls may be recorded and monitored

Scale: 1:2500 (When plotted at A4)

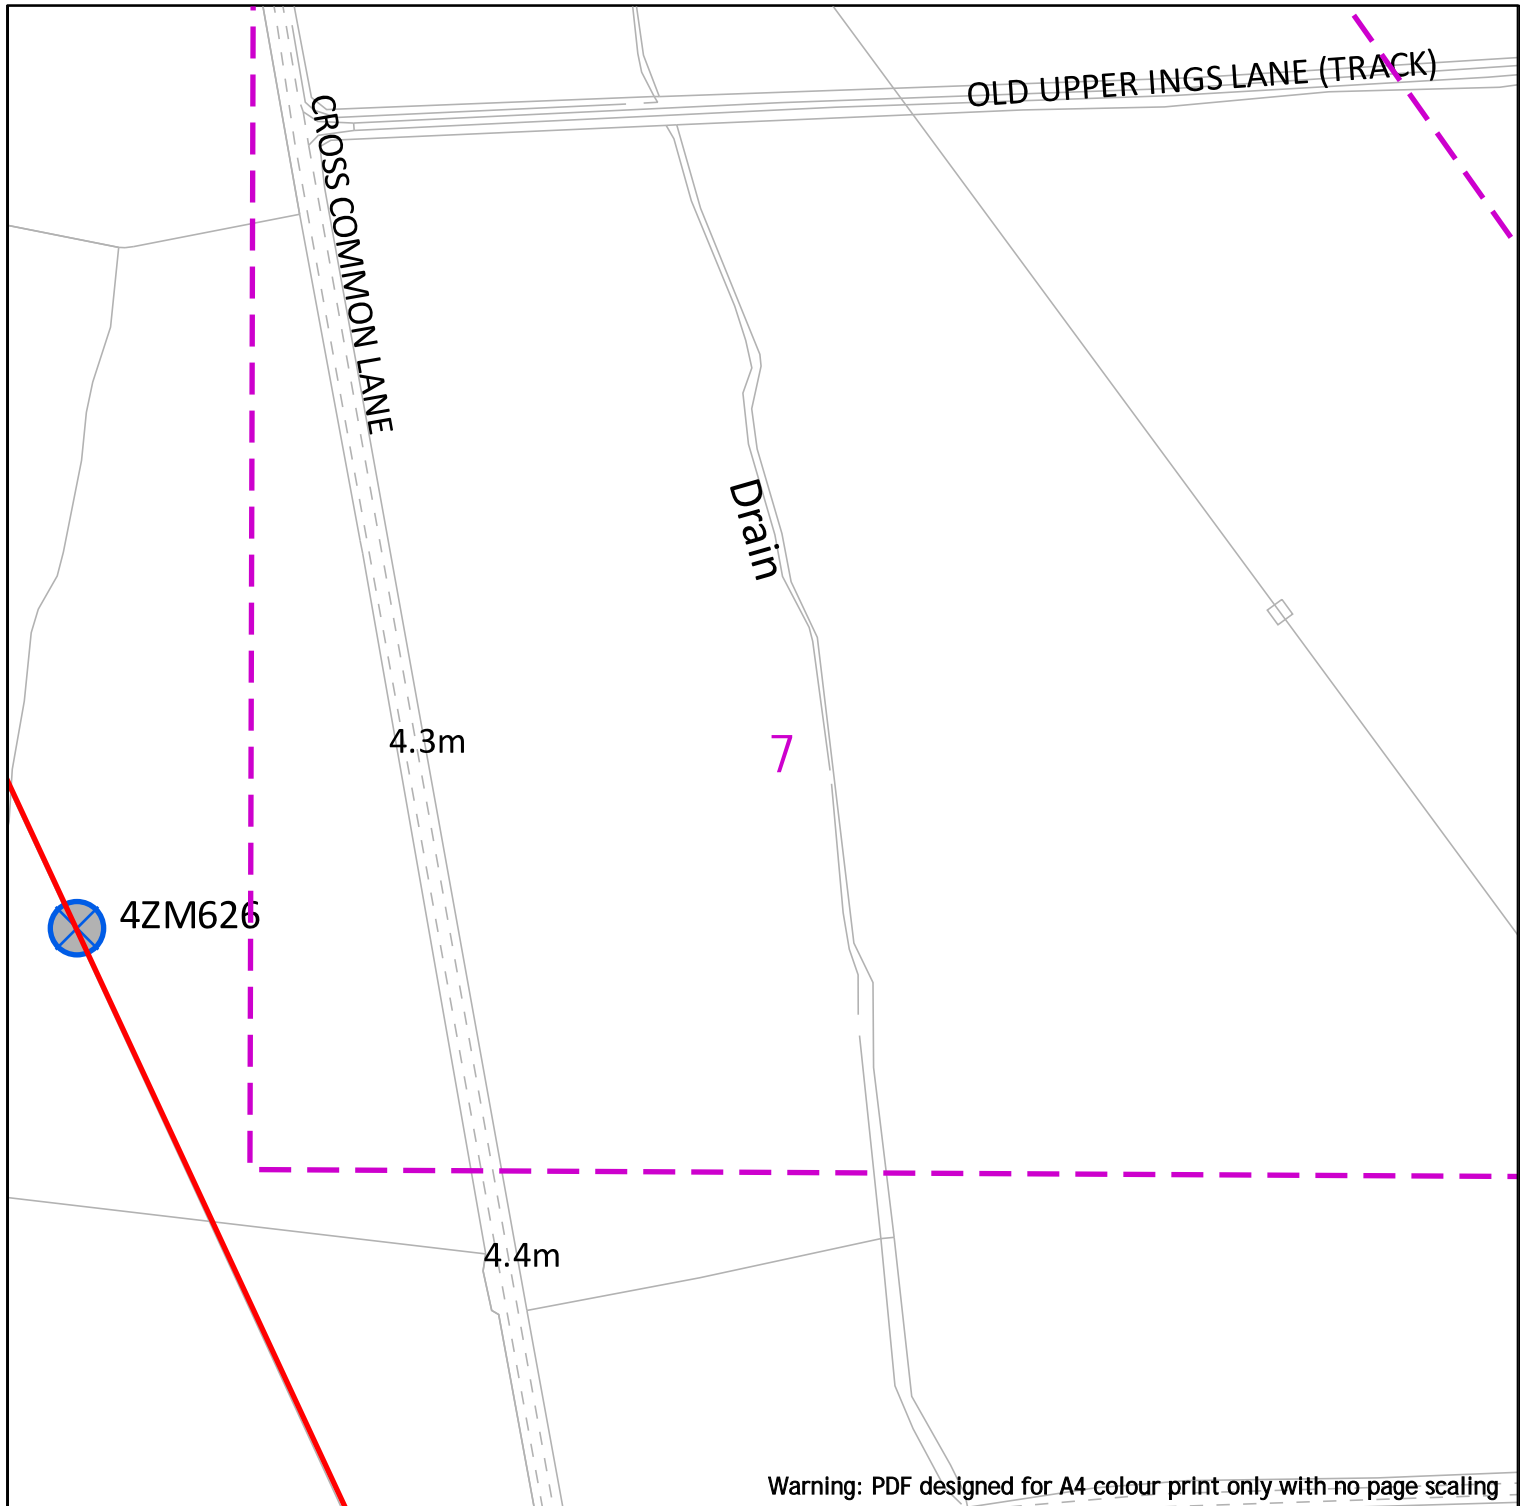

nationalgrid

NationalGrid House
 Warwick Technology Park
 Gallows Hill
 Warwick
 CV34 6DA

AssetProtection@NationalGrid.com

Date Requested: 08/05/2023
 Job Reference: 29406934
 Site Location: 480476 384842
 Requested by: Mr Ben Evans

Your Scheme/Reference: LM
 203570/DK - 1

Scale: 1:2500 (When plotted at A4)

Warning: PDF designed for A4 colour print only with no page scaling

0 200

**EXTREME CAUTION - HIGH VOLTAGE
 RISK OF DEATH OR SERIOUS INJURY**

Dig Sites Area: Line:

 Underground Cables


 Overhead Lines

 Fibre Cables

IMPORTANT NOTICES
 This plan shows those pipes owned by National Grid Electricity Transmission plc in its role as a Licensed Electricity Transporter (ET). Electricity cables owned by other ETs, or otherwise privately owned, may be present in this area. Information with regards to such cables should be obtained from the relevant owners. The information shown on this plan is given without warranty, the accuracy thereof cannot be guaranteed. Ancillary equipment such as cooling systems and communication cables are not shown but their presence should be anticipated. No liability of any kind whatsoever is accepted by National Grid Electricity Transmission plc or their agents, servants or contractors for any error or omission. Safe digging practices, in accordance with HS(G)47, must be used to verify and establish the actual position of cables and other apparatus on site before any mechanical plant is used. It is your responsibility to ensure that this information is provided to all persons (either direct labour or contractors) working for you on or near electricity apparatus. The information included on this plan should not be referred to beyond a period of 28 days from the date of issue.

National Grid Electricity Emergency Number: 0800 40 40 90
 Available 24 hours, 7 days/week. Calls may be recorded and monitored

Crown Copyright © - Reproduced by permission of Ordnance Survey on behalf of HMSO. And database right 2023. All rights reserved. Ordnance Survey Licence number 0100059731.

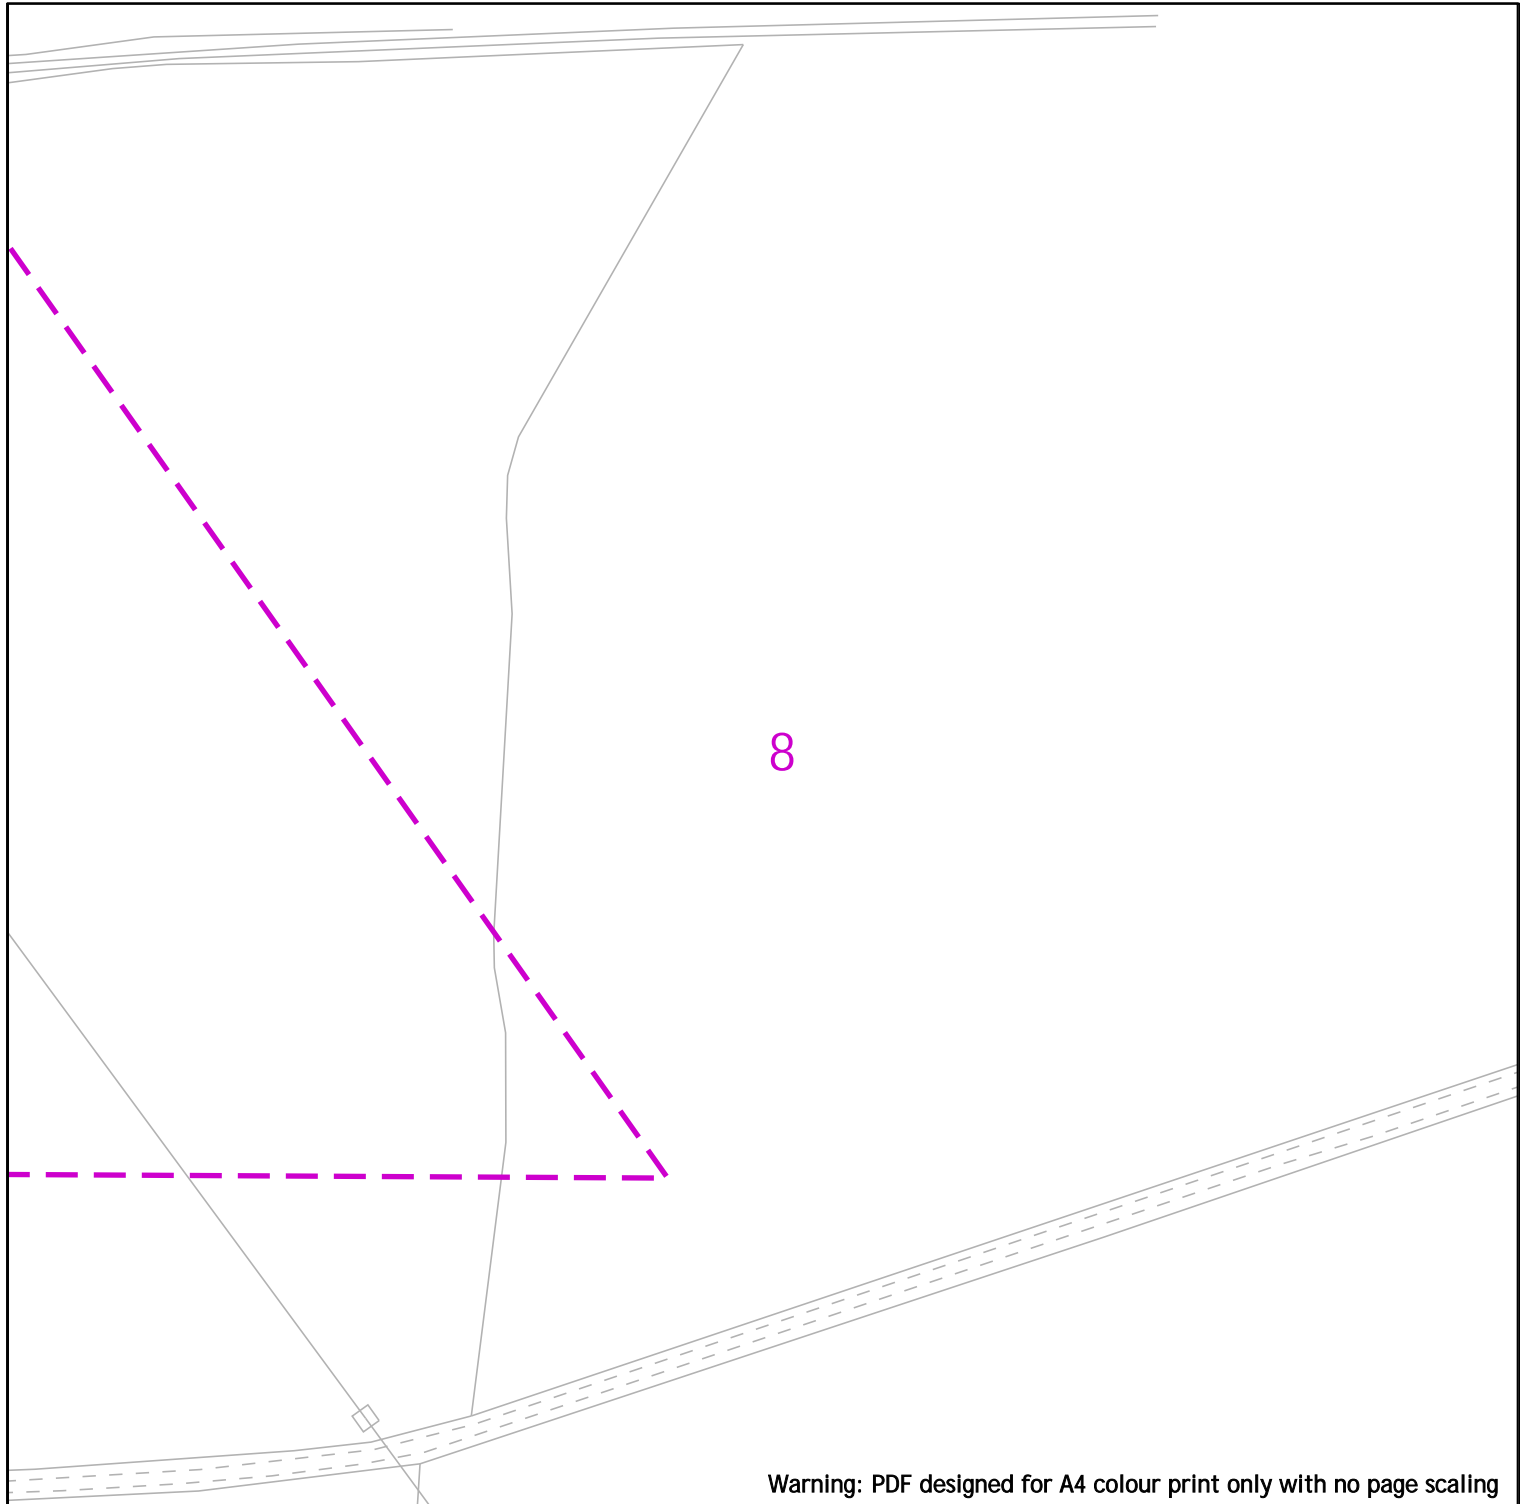

Warning: PDF designed for A4 colour print only with no page scaling



**EXTREME CAUTION - HIGH VOLTAGE
RISK OF DEATH OR SERIOUS INJURY**

Dig Sites	Area:	Line:
	Underground Cables	
	Overhead Lines	
	Fibre Cables	

NationalGrid House
Warwick Technology Park
Gallows Hill
Warwick
CV34 6DA

AssetProtection@NationalGrid.com

Date Requested: 08/05/2023
Job Reference: 29406934
Site Location: 480476 384842
Requested by: Mr Ben Evans

Your Scheme/Reference: LM
203570/DK - 1

IMPORTANT NOTICES

This plan shows those pipes owned by National Grid Electricity Transmission plc in its role as a Licensed Electricity Transporter (ET). Electricity cables owned by other ETs, or otherwise privately owned, may be present in this area. Information with regards to such cables should be obtained from the relevant owners. The information shown on this plan is given without warranty, the accuracy thereof cannot be guaranteed. Ancillary equipment such as cooling systems and communication cables are not shown but their presence should be anticipated. No liability of any kind whatsoever is accepted by National Grid Electricity Transmission plc or their agents, servants or contractors for any error or omission. Safe digging practices, in accordance with HS(G)47, must be used to verify and establish the actual position of cables and other apparatus on site before any mechanical plant is used. It is your responsibility to ensure that this information is provided to all persons (either direct labour or contractors) working for you on or near electricity apparatus. The information included on this plan should not be referred to beyond a period of 28 days from the date of issue.

National Grid Electricity Emergency Number: 0800 40 40 90
Available 24 hours, 7 days/week. Calls may be recorded and monitored

Scale: 1:2500 (When plotted at A4)

ENQUIRY SUMMARY

Received Date

08/05/2023 9:33

Work Start Date

30/05/2023

Your Reference

LM 203570/DK - 1

Location

Centre Point: 480476 384842

X Extent:

Y Extent:

Postcode: DN229HH

Map Options

Paper Size: A4

Orientation: PORTRAIT

Scale: 1:2500

Real World Extents: 838m x 1773m

Enquirer Details

Organisation Name: Atkins - Utility Solutions

Contact Name: Ben Evans

Email Address: searches.utilitysolutions@atkinglobal.com

Telephone: 01454662086

Address: The Hub, 500 Park Avenue, Aztec West, , Bristol, BS32 4RZ

Enquiry Type

Initial Enquiry

Activity Type

Utility Works

Work Types

Single excavations site (deeper than 1.5m)

Notes/Works Description (if supplied)

Site Contact Name (if supplied)

Site Contact Number (if supplied)

Our Ref: 29406935 LM 203570/DK - 2

Monday, 08 May 2023

Ben Evans
The Hub, 500 Park Avenue, Aztec West

Bristol
BS32 4RZ

National Grid House
Warwick Technology Park
Gallows Hill, Warwick
CV34 6DA

Electricity Emergency Number:
0800 40 40 90*
*Available 24 hours, 7 days/week.
Calls may be recorded and monitored.
www.nationalgrid.com

Asset Protection
Gas Transmission
National Grid
Warwick
Email: assetprotection@nationalgrid.com

National Grid Electricity – High Risk Response Letter

Dear Sir/ Madam,

An assessment has been carried out with respect to National Grid Electricity Transmission plc's apparatus and the proposed work location. Based on the location entered into the system for assessment the area has been found to be within the High Risk zone from National Grid Electricity Transmission plc's apparatus and **Must Not Proceed** without further assessment by Asset Protection.

Could you please send a works description (including how deep you are excavating) and any plans including any commencement dates to the following email address assetprotection@nationalgrid.com including the LSBUD enquiry reference number.

Failure to provide this information will result in a delay to your works being assessed.

Please note this response and any attached map(s) are valid for 28 days from date of this letter. A new enquiry will need to be submitted into LSBUD if the requested information above is not supplied within 28 days.

Yours sincerely,

Asset Protection

Your Responsibilities and Obligations

The "Assessment" Section below outlines the detailed requirements that must be followed when planning or undertaking your activities at this location.

It is your responsibility to ensure that the information you have submitted is accurate and that all relevant documents including links are provided to all persons (either direct labour or contractors) working for you near National Grid Electricity Transmission plc's apparatus, e.g. as contained within the Construction (Design and Management) Regulations.

This assessment solely relates to National Grid Electricity Transmission plc (NGET)

This assessment does **NOT** include:

- National Grid's legal interest (easements or wayleaves) in the land which restricts activity in proximity to National Grid's assets in private land. You must obtain details of any such restrictions from the landowner in the first instance and if in doubt contact Asset Protection.
- Recently installed apparatus
- National Grid Gas plc.
- Apparatus owned by other organisations, e.g. Cadent, other gas distribution operators, local electricity companies, other utilities, etc.

It is **YOUR** responsibility to take into account whether the items listed above may be present and if they could be affected by your proposed activities.

This communication does not constitute any formal agreement or consent for any proposed development work; either generally or with regard to National Grid Electricity Transmission plc easements or wayleaves nor any planning or building regulations applications.

National Grid Electricity Transmission plc or their agents, servants or contractors do not accept any liability for any losses arising under or in connection with this information. This limit on liability applies to all and any claims in contract, tort (including negligence), misrepresentation (excluding fraudulent misrepresentation), breach of statutory duty or otherwise. This limit on liability does not exclude or restrict liability where prohibited by the law nor does it supersede the express terms of any related agreements.

If you require further assistance please contact the Asset Protection team via e-mail (assetprotection@nationalgrid.com) or via the contact details at the top of this response.

Assessment

Affected Apparatus

The apparatus that has been identified as being in the vicinity of your proposed works is:

- Electricity Transmission Overhead Line apparatus.

Requirements

Over Head Lines

BEFORE carrying out any work you must:

(N.B. Works only to be undertaken when contact has been made and response received from Asset Protection)

- Carefully read these requirements including the attached guidance documents and maps showing the location of apparatus.
- Contact the landowner and ensure any proposed works in private land do not infringe National Grid Electricity Transmission plc's legal rights (i.e. easements or wayleaves). If the works are in the road or footpath the relevant local authority should be contacted.
- Ensure that all persons, including direct labour and contractors, working for you on or near National Grid Electricity Transmission plc's apparatus follow the requirements of the HSE Guidance Notes HSG47 - 'Avoiding Danger from Underground Services' and GS6 – 'Avoidance of danger from overhead electric power lines'. This guidance can be downloaded free of charge at www.hse.gov.uk
- In line with the above guidance, verify and establish the actual position of mains, pipes, cables, services and other apparatus on site before any activities are undertaken.

DURING any work you must:

- Comply with all guidance for working within the vicinity of overhead lines as detailed within the guidance documents listed below.
- Comply with all guidance relating to general activities and any specific guidance for each asset type as specified in the Guidance Section below.
- Ensure that access to National Grid Electricity Transmission plc's apparatus is maintained at all times.
- Prevent the placing of heavy construction plant, equipment, materials or the passage of heavy vehicles over National Grid Electricity Transmission plc's apparatus unless specifically agreed with National Grid Electricity Transmission plc's apparatus in advance.
- Exercise extreme caution if slab (mass) concrete is encountered during excavation works as this maybe protecting or supporting National Grid Electricity Transmission plc's apparatus.

Underground Cables

BEFORE carrying out any work you must:

(N.B. Works only to be undertaken when contact has been made and response received from Asset Protection)

- Refer to the attached cable profile drawings which provide details about the location of National Grid's high voltage underground cables.
- Carefully read these requirements including the attached guidance documents and maps showing the location of apparatus.
- Contact the landowner and ensure any proposed works in private land do not infringe National Grid Electricity Transmission plc's legal rights (i.e. easements or wayleaves). If the works are in the road or footpath the relevant local authority should be contacted.
- Ensure that all persons, including direct labour and contractors, working for you on or near infringe National Grid Electricity Transmission plc's follow the requirements of the HSE Guidance Notes HS(G)47 "Avoiding Danger From Underground Services". This guidance can be downloaded free of charge at www.hse.gov.uk
- In line with the above guidance, verify and establish the actual position of mains, pipes, cables,

National Grid is a trading name for:

National Grid Electricity Transmission plc

Registered Office: 1-3 Strand, London WC2N 5EH

Registered in England and Wales, No 2366977

services and other apparatus on site before any activities are undertaken.

DURING any work you must:

- Comply with all guidance for working within the vicinity of Electricity Underground Cables as detailed within the guidance documents listed below.
- Comply with all guidance relating to general activities and any specific guidance for each asset type as specified in the Guidance Section below.
- Ensure that access to National Grid Electricity Transmission plc's apparatus is maintained at all times.
- Prevent the placing of heavy construction plant, equipment, materials or the passage of heavy vehicles over National Grid Electricity Transmission plc's apparatus unless specifically agreed with National Grid Electricity Transmission plc's in advance.
- Exercise extreme caution if slab (mass) concrete is encountered during excavation works as this maybe protecting or supporting National Grid Electricity Transmission plc's apparatus.

GUIDANCE

National Grid Electricity Transmission Network data

- The Network map for National Grid Electricity Transmission assets can be downloaded at the following link in GIS format.

<https://www.nationalgrid.com/uk/electricity-transmission/network-and-infrastructure/network-route-maps>

Buried Cables

- National Grid's underground cables are protected by a Deed of grant; Easement; Wayleave Agreement or the provisions of the New Roads and Street Works Act. Which provide full right of access to retain, maintain, repair and inspect our asset. Hence we require that no permanent structures are to be built over our cables or within the easement strip.
- Ground levels above our cables must not be altered in any way. Any alterations to the depth of our cables will subsequently alter the rating of the circuit and can compromise the reliability, efficiency and safety of our electricity network.
- The supplied detailed route records should not be taken as positive indication of the cable location. This can only be determined by digging trial holes. Where trial holes are dug the concrete and / or polymeric cable protection tiles must not be disturbed.
- The normal recommendation is to keep 2 metres clear either side of the 1 metre wide trench containing the AC cable.
- National Grid should be made aware of the works starting and may put in place a representative to monitor the works. The works should be carried out in accordance with the recommendations in document HS (G) 47 available from the HSE web site.
- The relocation of existing underground cables is not normally feasible on grounds of cost, operation and maintenance and environmental impact and we believe that successful development can take place in their vicinity.
- The information supplied is given in good faith and only as a guide to the location of our underground cables. The accuracy of this information cannot be guaranteed. The physical presence of such cables may also be evident from physical protection measures such as ducts or concrete protection tiles. The person(s) responsible for planning, supervising and carrying out work in proximity to our cable(s) shall be liable to us, as cable(s) owner, as well as to any third party who may be affected in any way by any loss or damage resulting from their failure to locate and avoid any damage to such a cable(s).
- The relevant guidance in relation to working safely near to existing underground cables is contained within the Health and Safety Executive's (www.hse.gov.uk) Guidance HS(G)47 "Avoiding Danger From Underground Services" and all relevant site staff should make sure that they are both aware of and understand this guidance.
- Our cables are normally buried to a depth of 0.9 metres to the protective covers but this depth can vary depending on location (bridges may have cables 100mm below surface level)..The specific cable route record drawings show further details along the route of the particular cable. The cable route drawings are attached to this letter for your information.
- Cables installed in cable tunnels, whilst less likely to be affected by surface or shallow works may be affected by activities such as piling.
- National Grid assets can be adversely affected by vibration and can provide guidance on the acceptable levels of vibration due to piling and other construction related operations in the vicinity of national grid assets
- Ground cover above our cables should not be reduced or increased without consultation with National Grid.

National Grid is a trading name for:

National Grid Electricity Transmission plc

Registered Office: 1-3 Strand, London WC2N 5EH

Registered in England and Wales, No 2366977

- If a landscaping scheme is proposed as part of the works, we request that no trees and shrubs are planted either directly above or within 3 metres of the existing underground cable, as ultimately the roots may grow to cause damage to the cable.

Cables Tunnels


- National Grid's underground cable tunnels are protected by the provisions of a Wayleave/Easement or the New Roads and Street Works Act. This provides full right of access to retain, maintain, repair and inspect our asset.
- Further information and guidance regarding National Grid Cable Tunnels is available on our website at <https://www.nationalgrid.com/uk/electricity-transmission/document/121061/download>
- National Grid requires that the clearances indicated in the guidance document linked above are maintained at all times. Should it be necessary to enter the exclusion zone discussion/ agreement with National Grid is required to ensure the integrity of their tunnel asset and the high voltage cables is not compromised.
- Ground levels above our cable tunnels must not be altered in any way without prior agreement with National Grid; any alterations to the depth of our tunnels can compromise its integrity which could have an adverse impact on the reliability, efficiency and safety of our electricity network.
- Any works which would create high levels of vibration such as piling would need to be assessed by National Grid to ensure it has limited impact on our cable tunnels. National Grid can advise on acceptable vibration limits.

Overhead Lines

- National Grid's Overhead Line/s is protected by a Deed of Easement/Wayleave Agreement which provides full right of access to retain, maintain, repair and inspect our asset.
- The submitted proposed design does not change after the date of this letter. Any design change that moves the proposal closer to National Grid Overhead Line Assets shall be submitted for assessment.
- Statutory electrical safety clearances shall be maintained at all times. National Grid recommends that no permanent structures are built directly beneath our overhead lines. These distances are set out in EN 43 – 8 Technical Specification for "Overhead Line Clearances Issue 5 (2019). To purchase & download EN 43 – 8 Technical Specification for "Overhead Line Clearances Issue 5 (2019) go to <https://www.ena-eng.org/ENA-Docs/>
- Any changes in ground levels which are proposed either beneath or in close proximity to our existing overhead lines would serve to reduce safety clearances. Safety clearances to existing overhead lines must be maintained in all circumstances.
- To view the Development Near Overhead Lines Document.
<https://www.nationalgridet.com/document/130626/download>
- To view the National Grid Third Party Guidance for working near National Grid Electricity Transmission equipment.
<https://www.nationalgridet.com/sites/et/files/documents/Working%20near%20electricity%20equipment.pdf>

- The relevant guidance in relation to working safely near to existing overhead lines is contained within the Health and Safety Executive's (www.hse.gov.uk) Guidance Note GS 6 "Avoidance of Danger from Overhead Electric Lines."
- If a landscaping scheme is proposed as part of the proposal, only slow and low growing species of trees and shrubs shall be planted beneath and adjacent to the existing overhead line to reduce the risk of growth to a height which compromises statutory safety clearances.
- Drilling or excavation works shall not be undertaken if they have the potential to disturb or adversely affect the foundations or "pillars of support" of our towers. These foundations extend beyond the base of the tower. Pillar of Support drawings shall be obtained using the contact details above.
- Due to the scale, bulk and cost of the transmission equipment required to operate at 275kV or 400kV we only support proposals for the relocation of existing high voltage overhead lines where such proposals directly facilitate a major development or infrastructure project of national importance which has been identified as such by government.
- To promote the successful development of sites crossed by existing overhead lines, and the creation of well-designed places, National Grid has produced 'Design guidelines for development near pylons and high voltage overhead power lines', which look at how to create high quality development near overhead lines and offer practical solutions which can assist in avoiding the unnecessary sterilisation of land in the vicinity of high voltage overhead lines.
- Further information regarding our undergrounding policy and development near transmission overhead lines is available on our website at: <https://www.nationalgridet.com/network-and-assets/planning-and-development>

Overview map of worksite

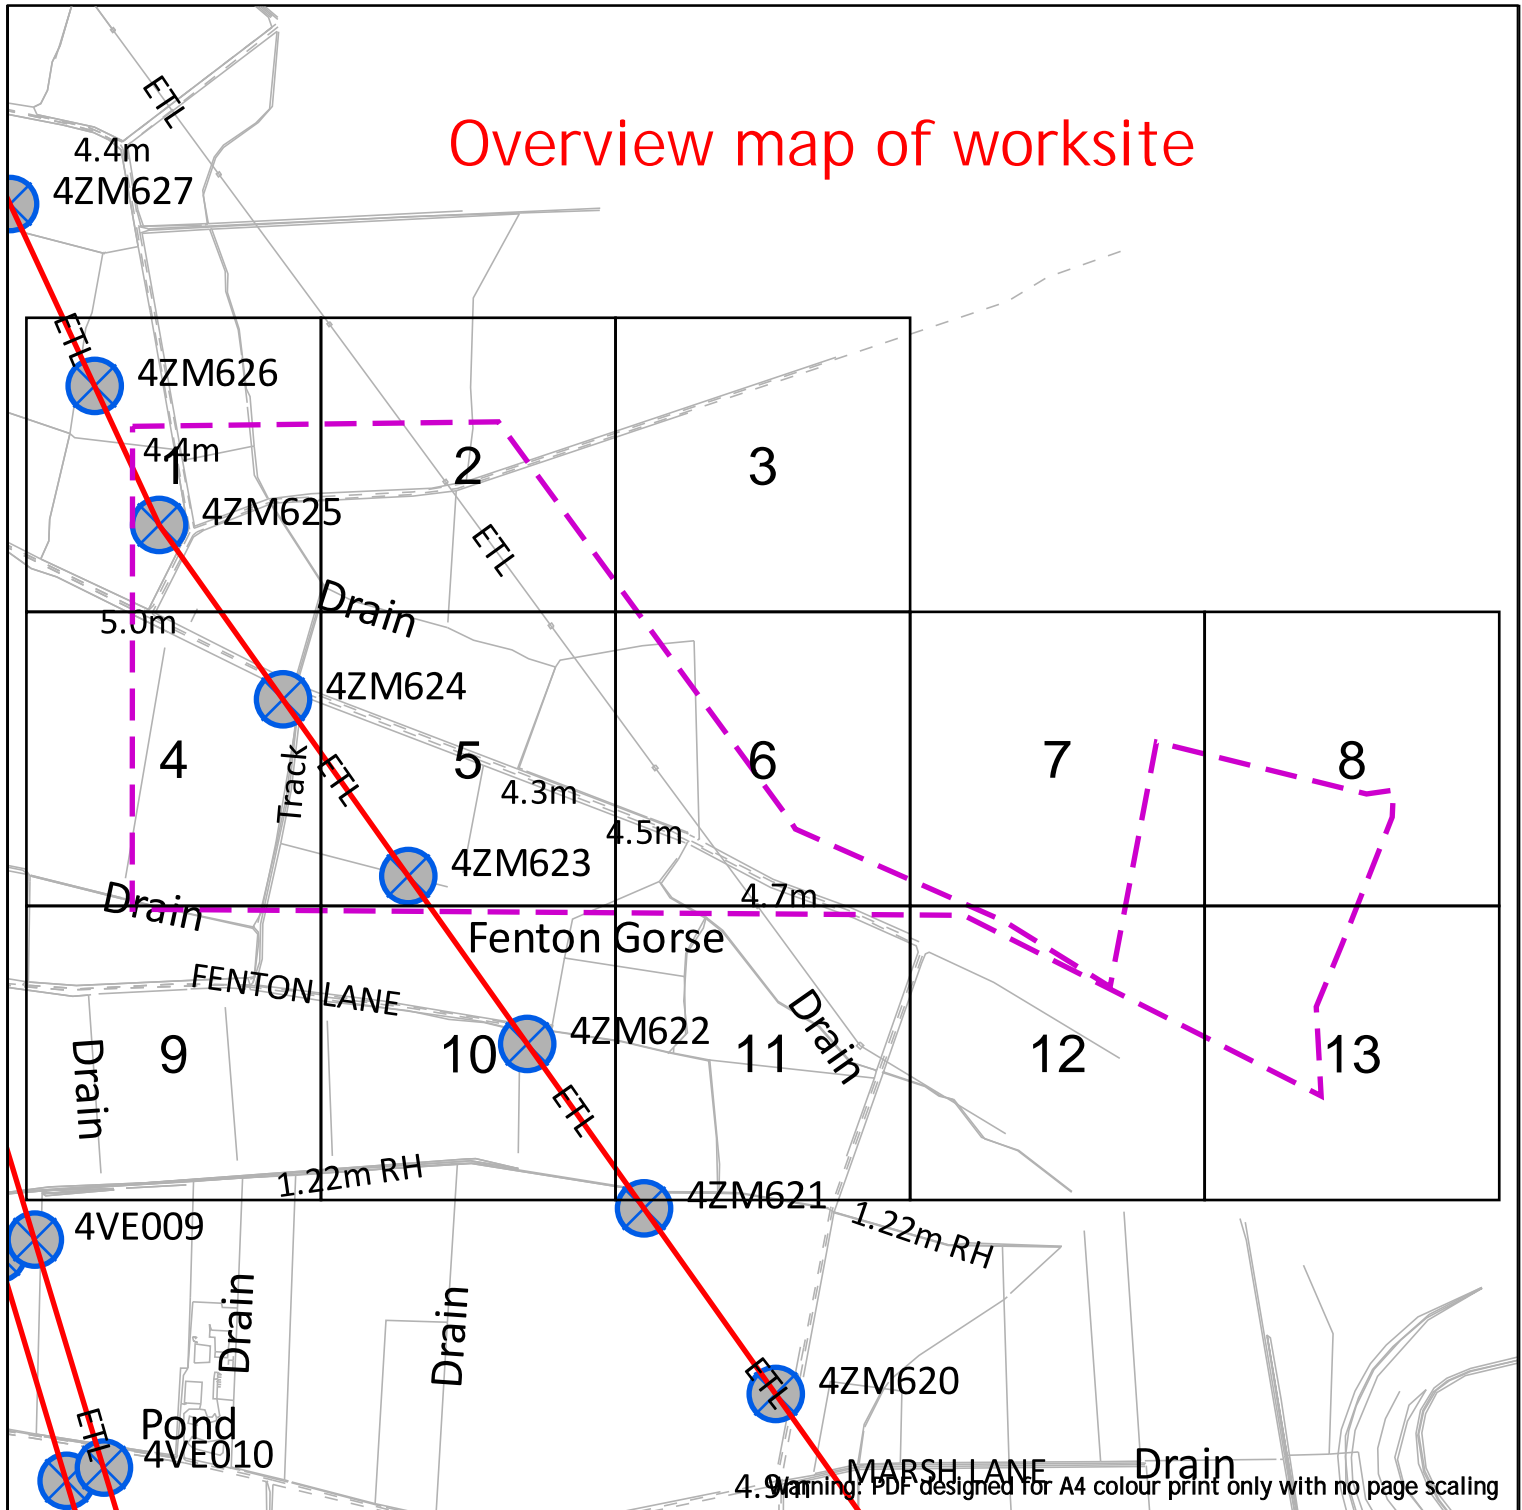

Warning: PDF designed for A4 colour print only with no page scaling



**EXTREME CAUTION - HIGH VOLTAGE
RISK OF DEATH OR SERIOUS INJURY**

Dig Sites	Area:	Line:
	Underground Cables	
	Overhead Lines	
	Fibre Cables	

NationalGrid House
Warwick Technology Park
Gallows Hill
Warwick
CV34 6DA

AssetProtection@NationalGrid.com


Date Requested: 08/05/2023
Job Reference: 29406935
Site Location: 480665 383345
Requested by: Mr Ben Evans

Your Scheme/Reference: LM
203570/DK - 2

IMPORTANT NOTICES
This plan shows those pipes owned by National Grid Electricity Transmission plc in its role as a Licensed Electricity Transporter (ET). Electricity cables owned by other ETs, or otherwise privately owned, may be present in this area. Information with regards to such cables should be obtained from the relevant owners. The information shown on this plan is given without warranty, the accuracy thereof cannot be guaranteed. Ancillary equipment such as cooling systems and communication cables are not shown but their presence should be anticipated. No liability of any kind whatsoever is accepted by National Grid Electricity Transmission plc or their agents, servants or contractors for any error or omission. Safe digging practices, in accordance with HS(G)47, must be used to verify and establish the actual position of cables and other apparatus on site before any mechanical plant is used. It is your responsibility to ensure that this information is provided to all persons (either direct labour or contractors) working for you on or near electricity apparatus. The information included on this plan should not be referred to beyond a period of 28 days from the date of issue.

National Grid Electricity Emergency Number: 0800 40 40 90
Available 24 hours, 7 days/week. Calls may be recorded and monitored

Scale: 1:12813 (When plotted at A4)

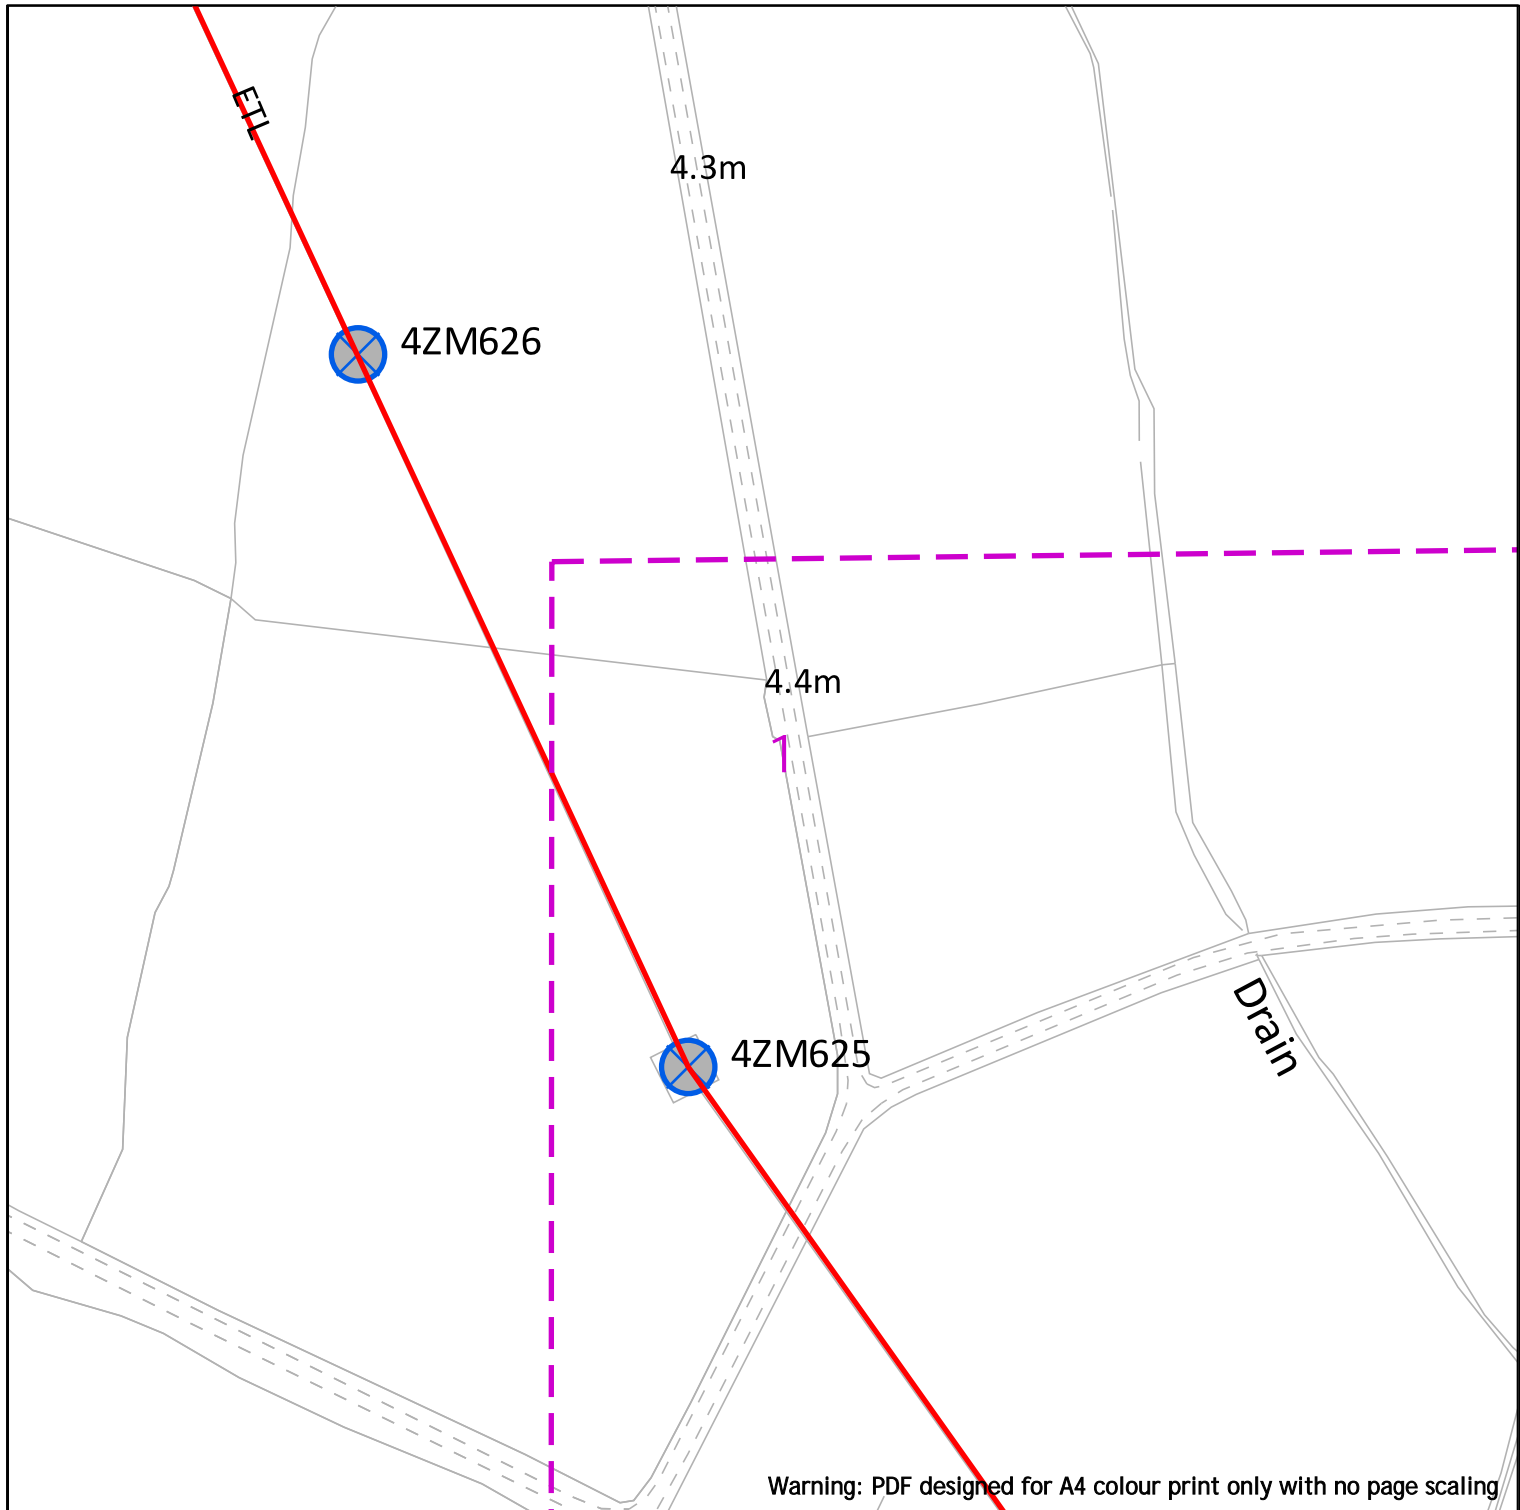

Warning: PDF designed for A4 colour print only with no page scaling

nationalgrid



**EXTREME CAUTION - HIGH VOLTAGE
RISK OF DEATH OR SERIOUS INJURY**

Dig Sites	Area:	Line:
	Underground Cables	
	Overhead Lines	
	Fibre Cables	

NationalGrid House
Warwick Technology Park
Gallows Hill
Warwick
CV34 6DA

AssetProtection@NationalGrid.com

Date Requested: 08/05/2023
Job Reference: 29406935
Site Location: 480665 383345
Requested by: Mr Ben Evans


Your Scheme/Reference: LM
203570/DK - 2

IMPORTANT NOTICES

This plan shows those pipes owned by National Grid Electricity Transmission plc in its role as a Licensed Electricity Transporter (ET). Electricity cables owned by other ETs, or otherwise privately owned, may be present in this area. Information with regards to such cables should be obtained from the relevant owners. The information shown on this plan is given without warranty, the accuracy thereof cannot be guaranteed. Ancillary equipment such as cooling systems and communication cables are not shown but their presence should be anticipated. No liability of any kind whatsoever is accepted by National Grid Electricity Transmission plc or their agents, servants or contractors for any error or omission. Safe digging practices, in accordance with HS(G)47, must be used to verify and establish the actual position of cables and other apparatus on site before any mechanical plant is used. It is your responsibility to ensure that this information is provided to all persons (either direct labour or contractors) working for you on or near electricity apparatus. The information included on this plan should not be referred to beyond a period of 28 days from the date of issue.

National Grid Electricity Emergency Number: 0800 40 40 90
Available 24 hours, 7 days/week. Calls may be recorded and monitored

Scale: 1:2500 (When plotted at A4)

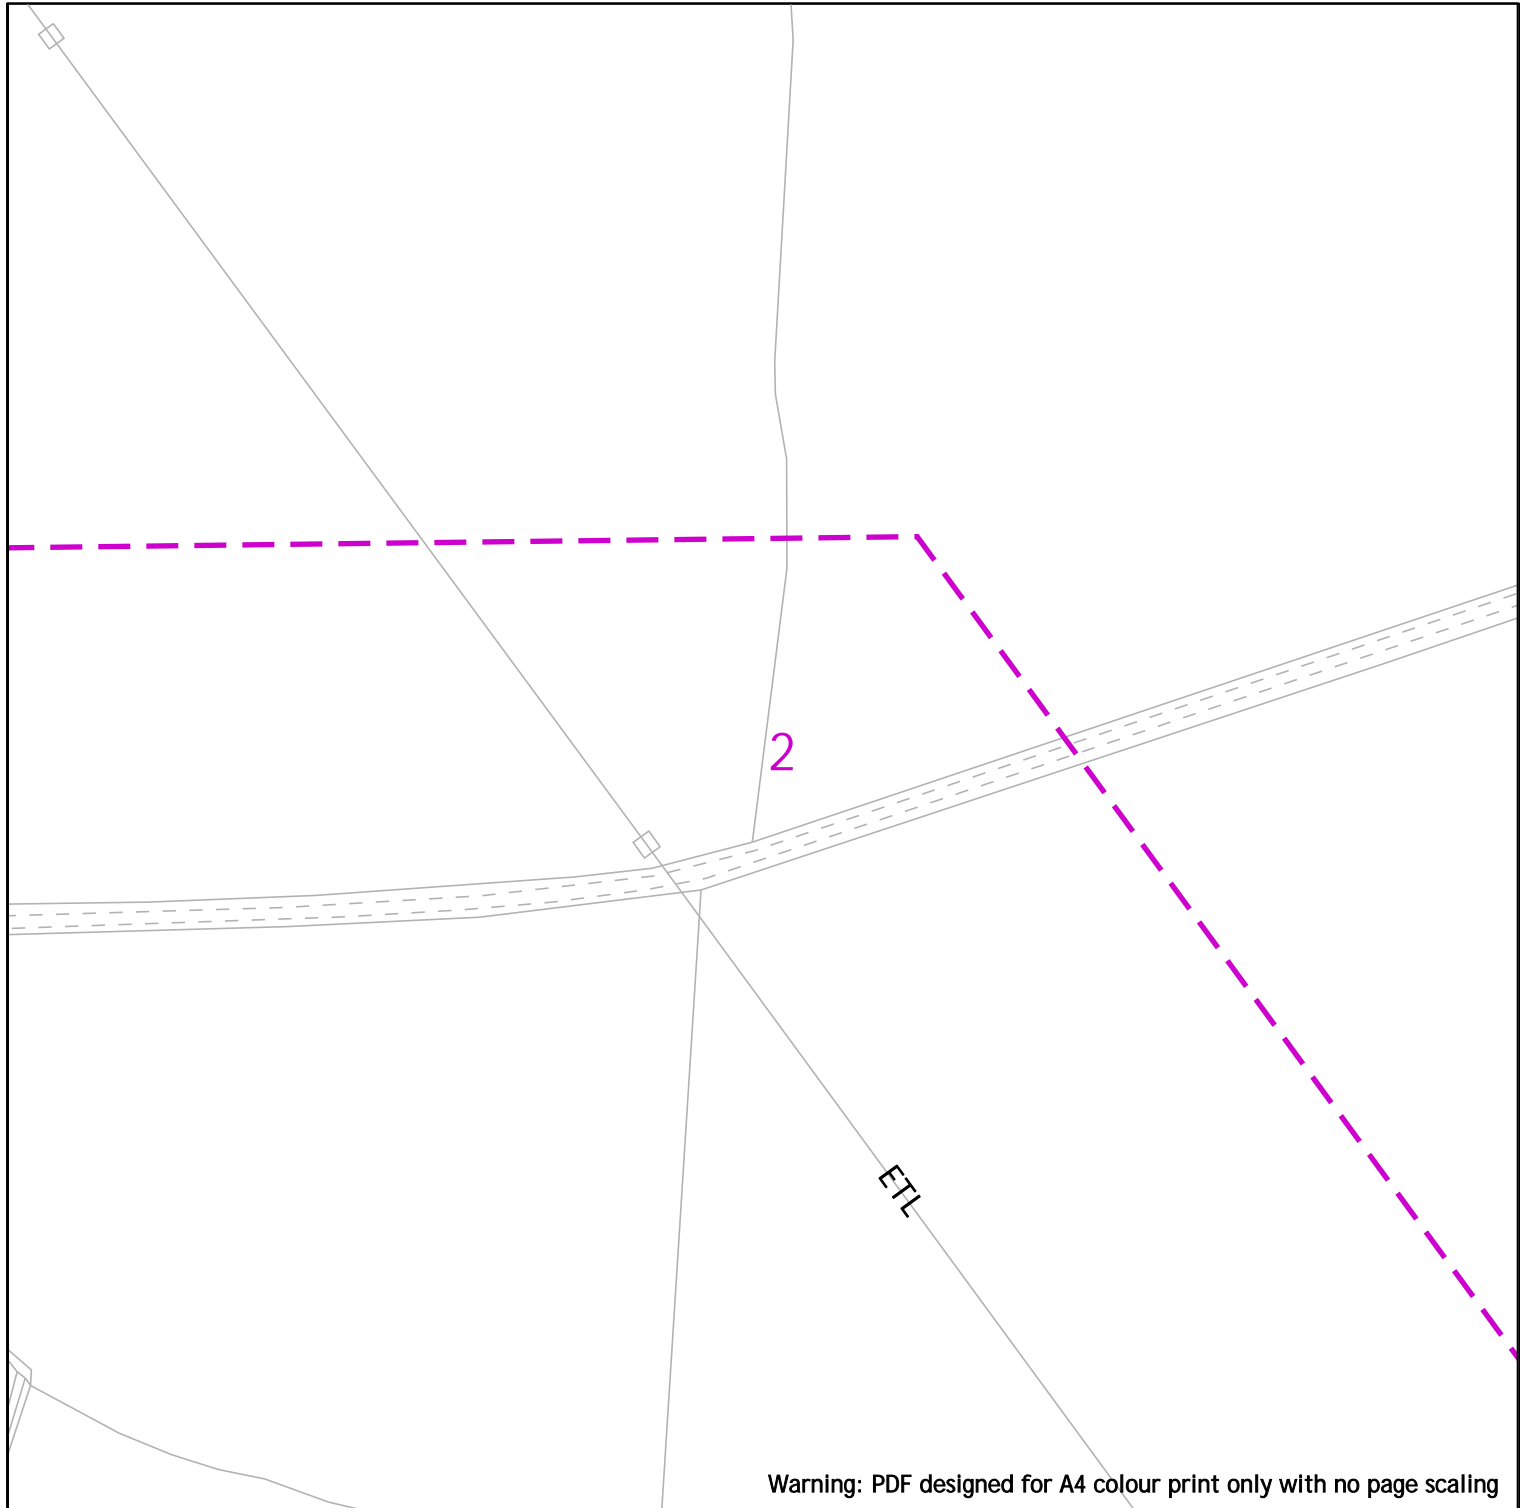

Warning: PDF designed for A4 colour print only with no page scaling



**EXTREME CAUTION - HIGH VOLTAGE
RISK OF DEATH OR SERIOUS INJURY**

Dig Sites	Area:	Line:
	Underground Cables	
	Overhead Lines	
	Fibre Cables	

NationalGrid House
Warwick Technology Park
Gallows Hill
Warwick
CV34 6DA

AssetProtection@NationalGrid.com

Date Requested: 08/05/2023
Job Reference: 29406935
Site Location: 480665 383345
Requested by: Mr Ben Evans


Your Scheme/Reference: LM
203570/DK - 2

IMPORTANT NOTICES

This plan shows those pipes owned by National Grid Electricity Transmission plc in its role as a Licensed Electricity Transporter (ET). Electricity cables owned by other ETs, or otherwise privately owned, may be present in this area. Information with regards to such cables should be obtained from the relevant owners. The information shown on this plan is given without warranty, the accuracy thereof cannot be guaranteed. Ancillary equipment such as cooling systems and communication cables are not shown but their presence should be anticipated. No liability of any kind whatsoever is accepted by National Grid Electricity Transmission plc or their agents, servants or contractors for any error or omission. Safe digging practices, in accordance with HS(G)47, must be used to verify and establish the actual position of cables and other apparatus on site before any mechanical plant is used. It is your responsibility to ensure that this information is provided to all persons (either direct labour or contractors) working for you on or near electricity apparatus. The information included on this plan should not be referred to beyond a period of 28 days from the date of issue.

National Grid Electricity Emergency Number: 0800 40 40 90
Available 24 hours, 7 days/week. Calls may be recorded and monitored

Scale: 1:2500 (When plotted at A4)

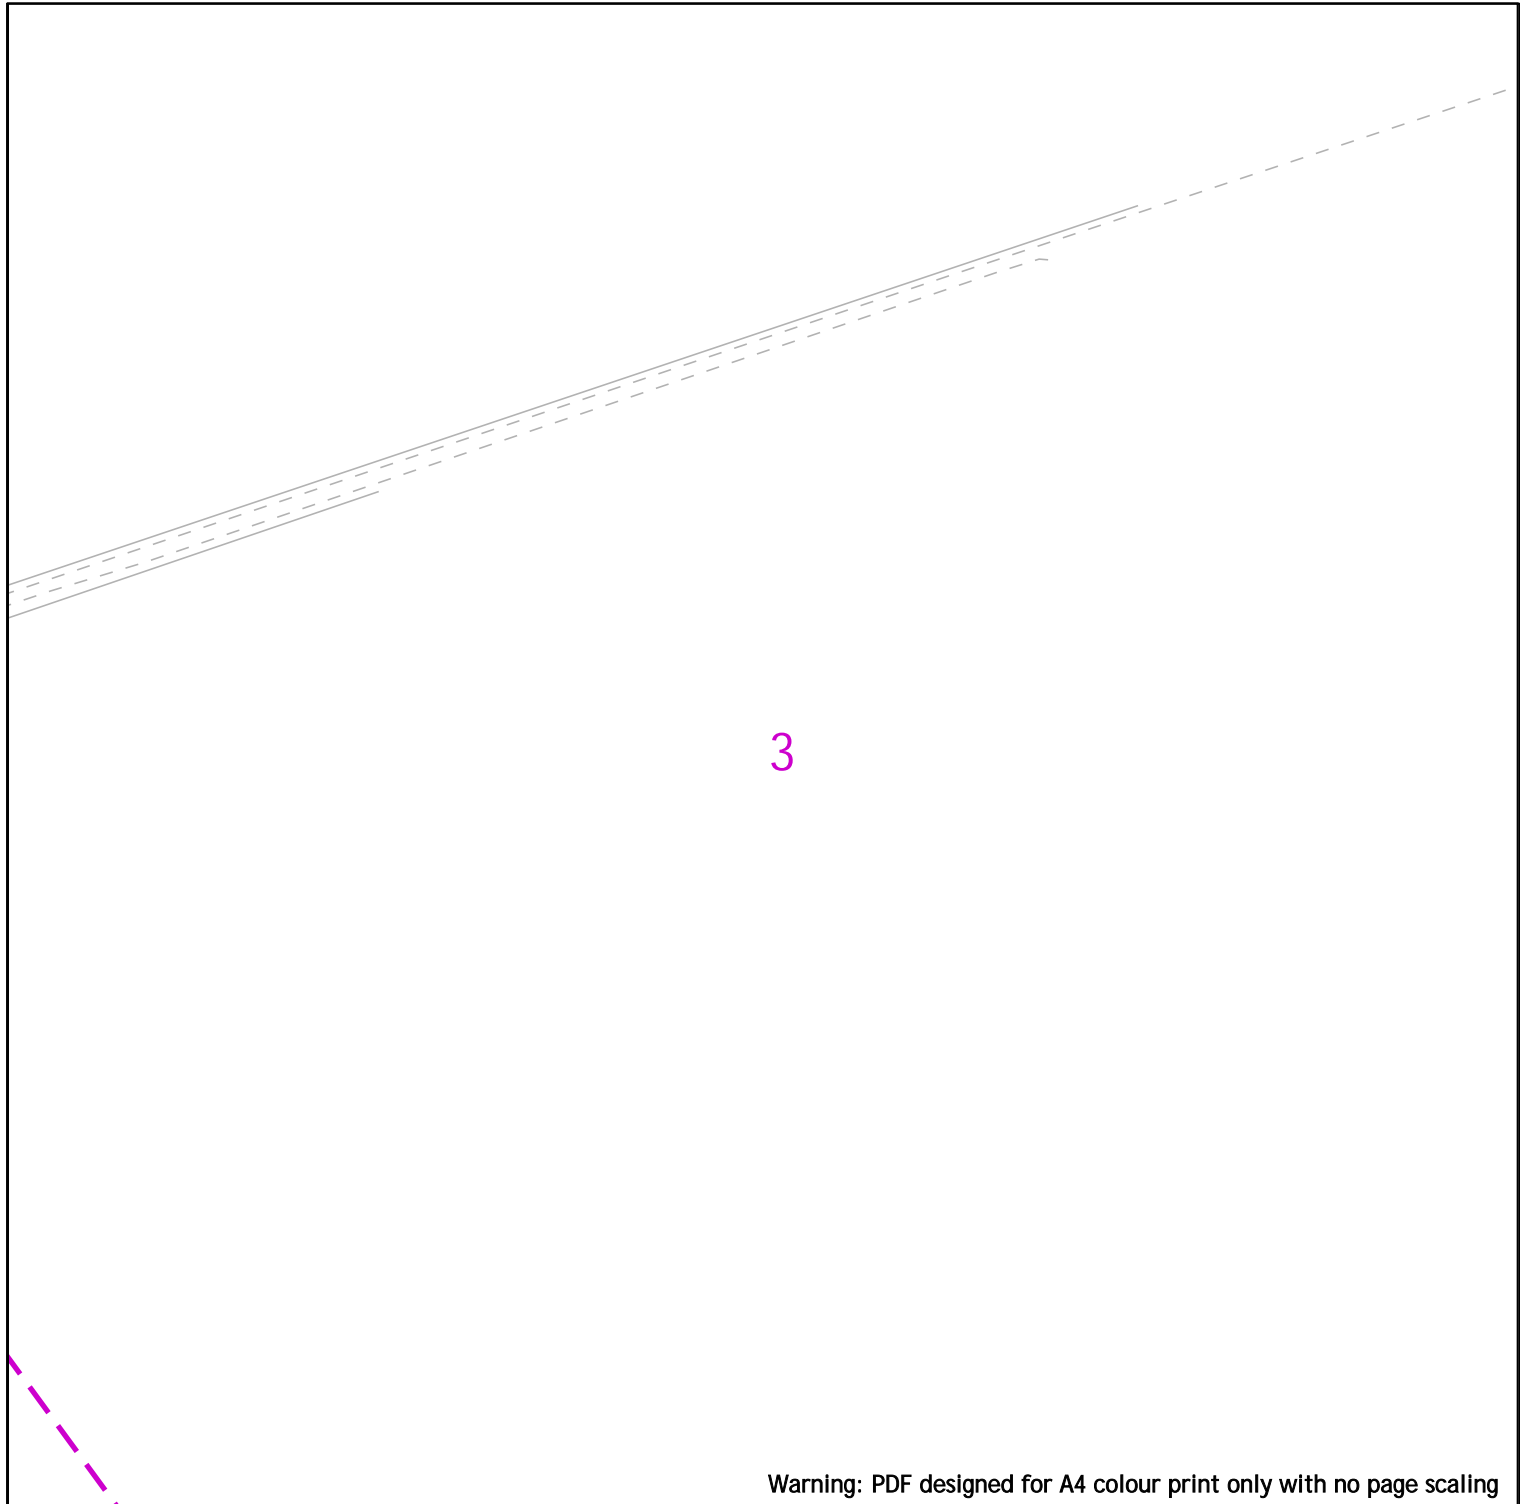


Warning: PDF designed for A4 colour print only with no page scaling

nationalgrid



**EXTREME CAUTION - HIGH VOLTAGE
RISK OF DEATH OR SERIOUS INJURY**

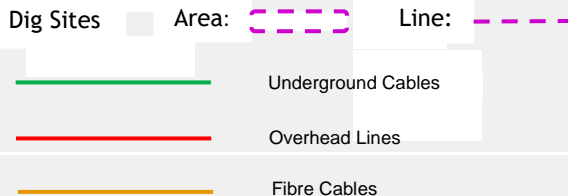

NationalGrid House
Warwick Technology Park
Gallows Hill
Warwick
CV34 6DA

AssetProtection@NationalGrid.com

Date Requested: 08/05/2023
Job Reference: 29406935
Site Location: 480665 383345
Requested by: Mr Ben Evans


Your Scheme/Reference: LM
203570/DK - 2

IMPORTANT NOTICES

This plan shows those pipes owned by National Grid Electricity Transmission plc in its role as a Licensed Electricity Transporter (ET). Electricity cables owned by other ETs, or otherwise privately owned, may be present in this area. Information with regards to such cables should be obtained from the relevant owners. The information shown on this plan is given without warranty, the accuracy thereof cannot be guaranteed. Ancillary equipment such as cooling systems and communication cables are not shown but their presence should be anticipated. No liability of any kind whatsoever is accepted by National Grid Electricity Transmission plc or their agents, servants or contractors for any error or omission. Safe digging practices, in accordance with HS(G)47, must be used to verify and establish the actual position of cables and other apparatus on site before any mechanical plant is used. It is your responsibility to ensure that this information is provided to all persons (either direct labour or contractors) working for you on or near electricity apparatus. The information included on this plan should not be referred to beyond a period of 28 days from the date of issue.

National Grid Electricity Emergency Number: 0800 40 40 90
Available 24 hours, 7 days/week. Calls may be recorded and monitored

Scale: 1:2500 (When plotted at A4)

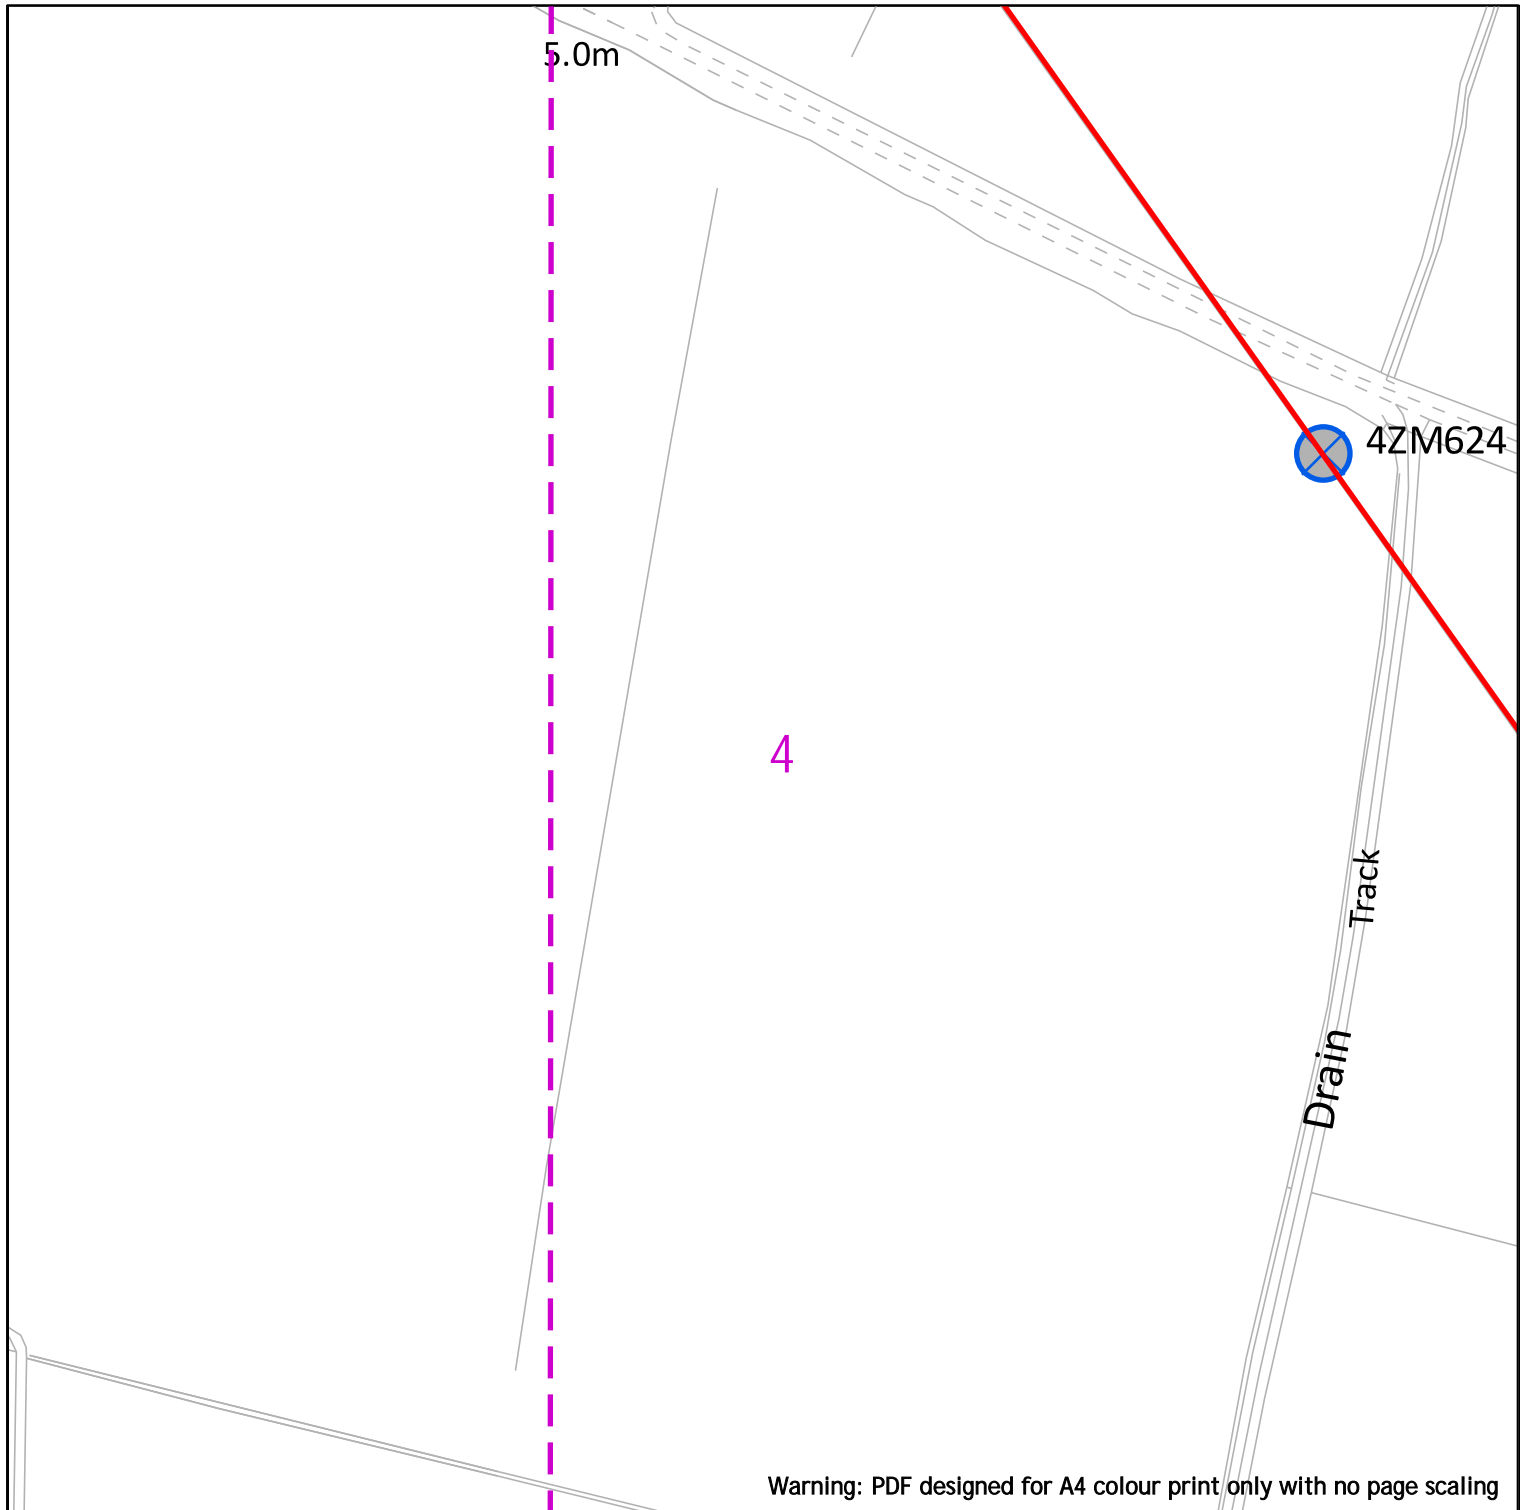

Warning: PDF designed for A4 colour print only with no page scaling

nationalgrid



**EXTREME CAUTION - HIGH VOLTAGE
RISK OF DEATH OR SERIOUS INJURY**

Dig Sites	Area:	Line:
	Underground Cables	
	Overhead Lines	
	Fibre Cables	

NationalGrid House
Warwick Technology Park
Gallows Hill
Warwick
CV34 6DA

AssetProtection@NationalGrid.com

Date Requested: 08/05/2023
Job Reference: 29406935
Site Location: 480665 383345
Requested by: Mr Ben Evans



Your Scheme/Reference: LM
203570/DK - 2

IMPORTANT NOTICES

This plan shows those pipes owned by National Grid Electricity Transmission plc in its role as a Licensed Electricity Transporter (ET). Electricity cables owned by other ETs, or otherwise privately owned, may be present in this area. Information with regards to such cables should be obtained from the relevant owners. The information shown on this plan is given without warranty, the accuracy thereof cannot be guaranteed. Ancillary equipment such as cooling systems and communication cables are not shown but their presence should be anticipated. No liability of any kind whatsoever is accepted by National Grid Electricity Transmission plc or their agents, servants or contractors for any error or omission. Safe digging practices, in accordance with HS(G)47, must be used to verify and establish the actual position of cables and other apparatus on site before any mechanical plant is used. It is your responsibility to ensure that this information is provided to all persons (either direct labour or contractors) working for you on or near electricity apparatus. The information included on this plan should not be referred to beyond a period of 28 days from the date of issue.

National Grid Electricity Emergency Number: 0800 40 40 90
Available 24 hours, 7 days/week. Calls may be recorded and monitored

Scale: 1:2500 (When plotted at A4)

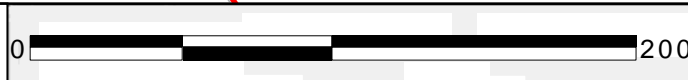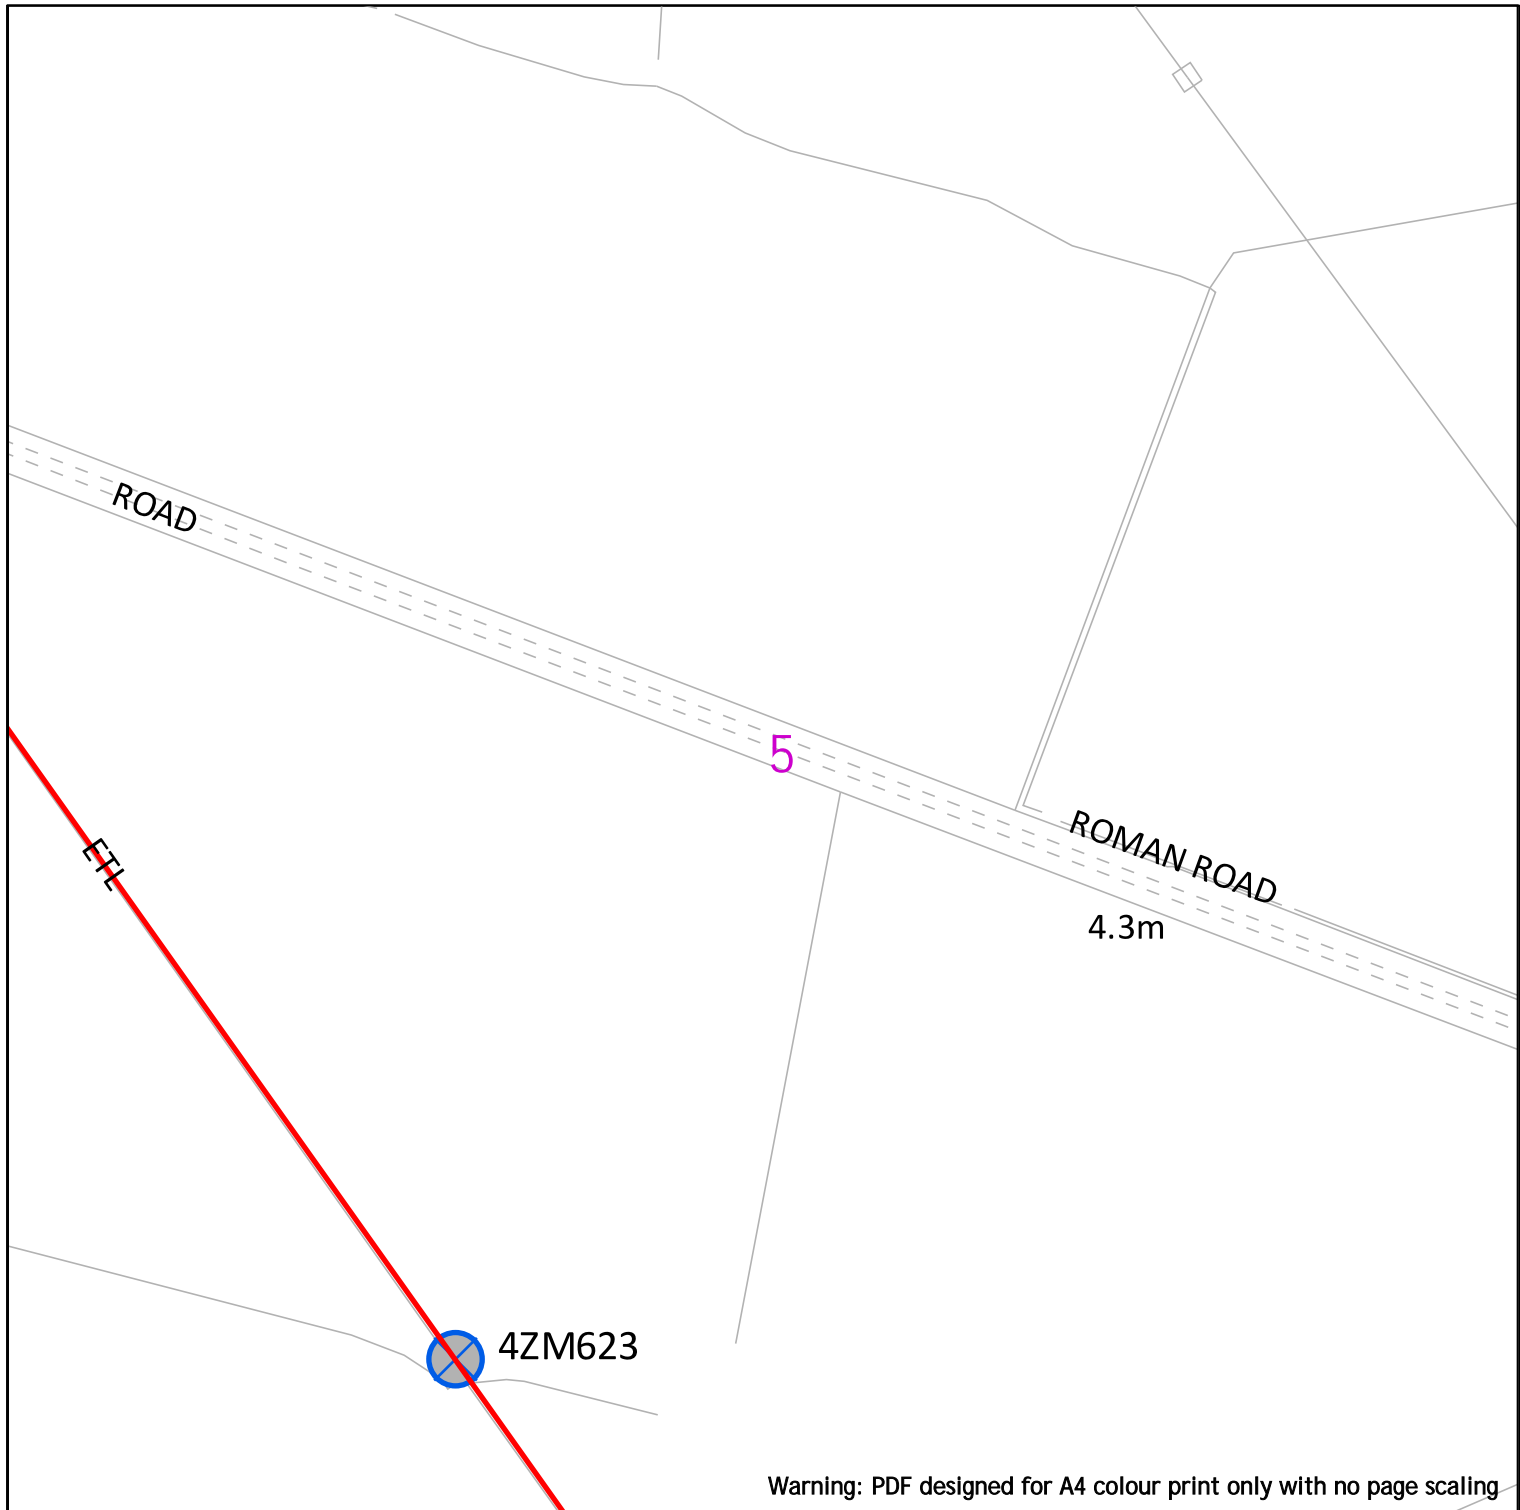

**EXTREME CAUTION - HIGH VOLTAGE
RISK OF DEATH OR SERIOUS INJURY**

NationalGrid House
Warwick Technology Park
Gallows Hill
Warwick
CV34 6DA

AssetProtection@NationalGrid.com

Dig Sites	Area:	Line:
	Underground Cables	
	Overhead Lines	
	Fibre Cables	

Date Requested: 08/05/2023
Job Reference: 29406935
Site Location: 480665 383345
Requested by: Mr Ben Evans


Your Scheme/Reference: LM
203570/DK - 2

Scale: 1:2500 (When plotted at A4)

IMPORTANT NOTICES
This plan shows those pipes owned by National Grid Electricity Transmission plc in its role as a Licensed Electricity Transporter (ET). Electricity cables owned by other ETs, or otherwise privately owned, may be present in this area. Information with regards to such cables should be obtained from the relevant owners. The information shown on this plan is given without warranty, the accuracy thereof cannot be guaranteed. Ancillary equipment such as cooling systems and communication cables are not shown but their presence should be anticipated. No liability of any kind whatsoever is accepted by National Grid Electricity Transmission plc or their agents, servants or contractors for any error or omission. Safe digging practices, in accordance with HS(G)47, must be used to verify and establish the actual position of cables and other apparatus on site before any mechanical plant is used. It is your responsibility to ensure that this information is provided to all persons (either direct labour or contractors) working for you on or near electricity apparatus. The information included on this plan should not be referred to beyond a period of 28 days from the date of issue.

National Grid Electricity Emergency Number: 0800 40 40 90
Available 24 hours, 7 days/week. Calls may be recorded and monitored

Crown Copyright © - Reproduced by permission of Ordnance Survey on behalf of HMSO. And database right 2023. All rights reserved. Ordnance Survey Licence number 0100059731.

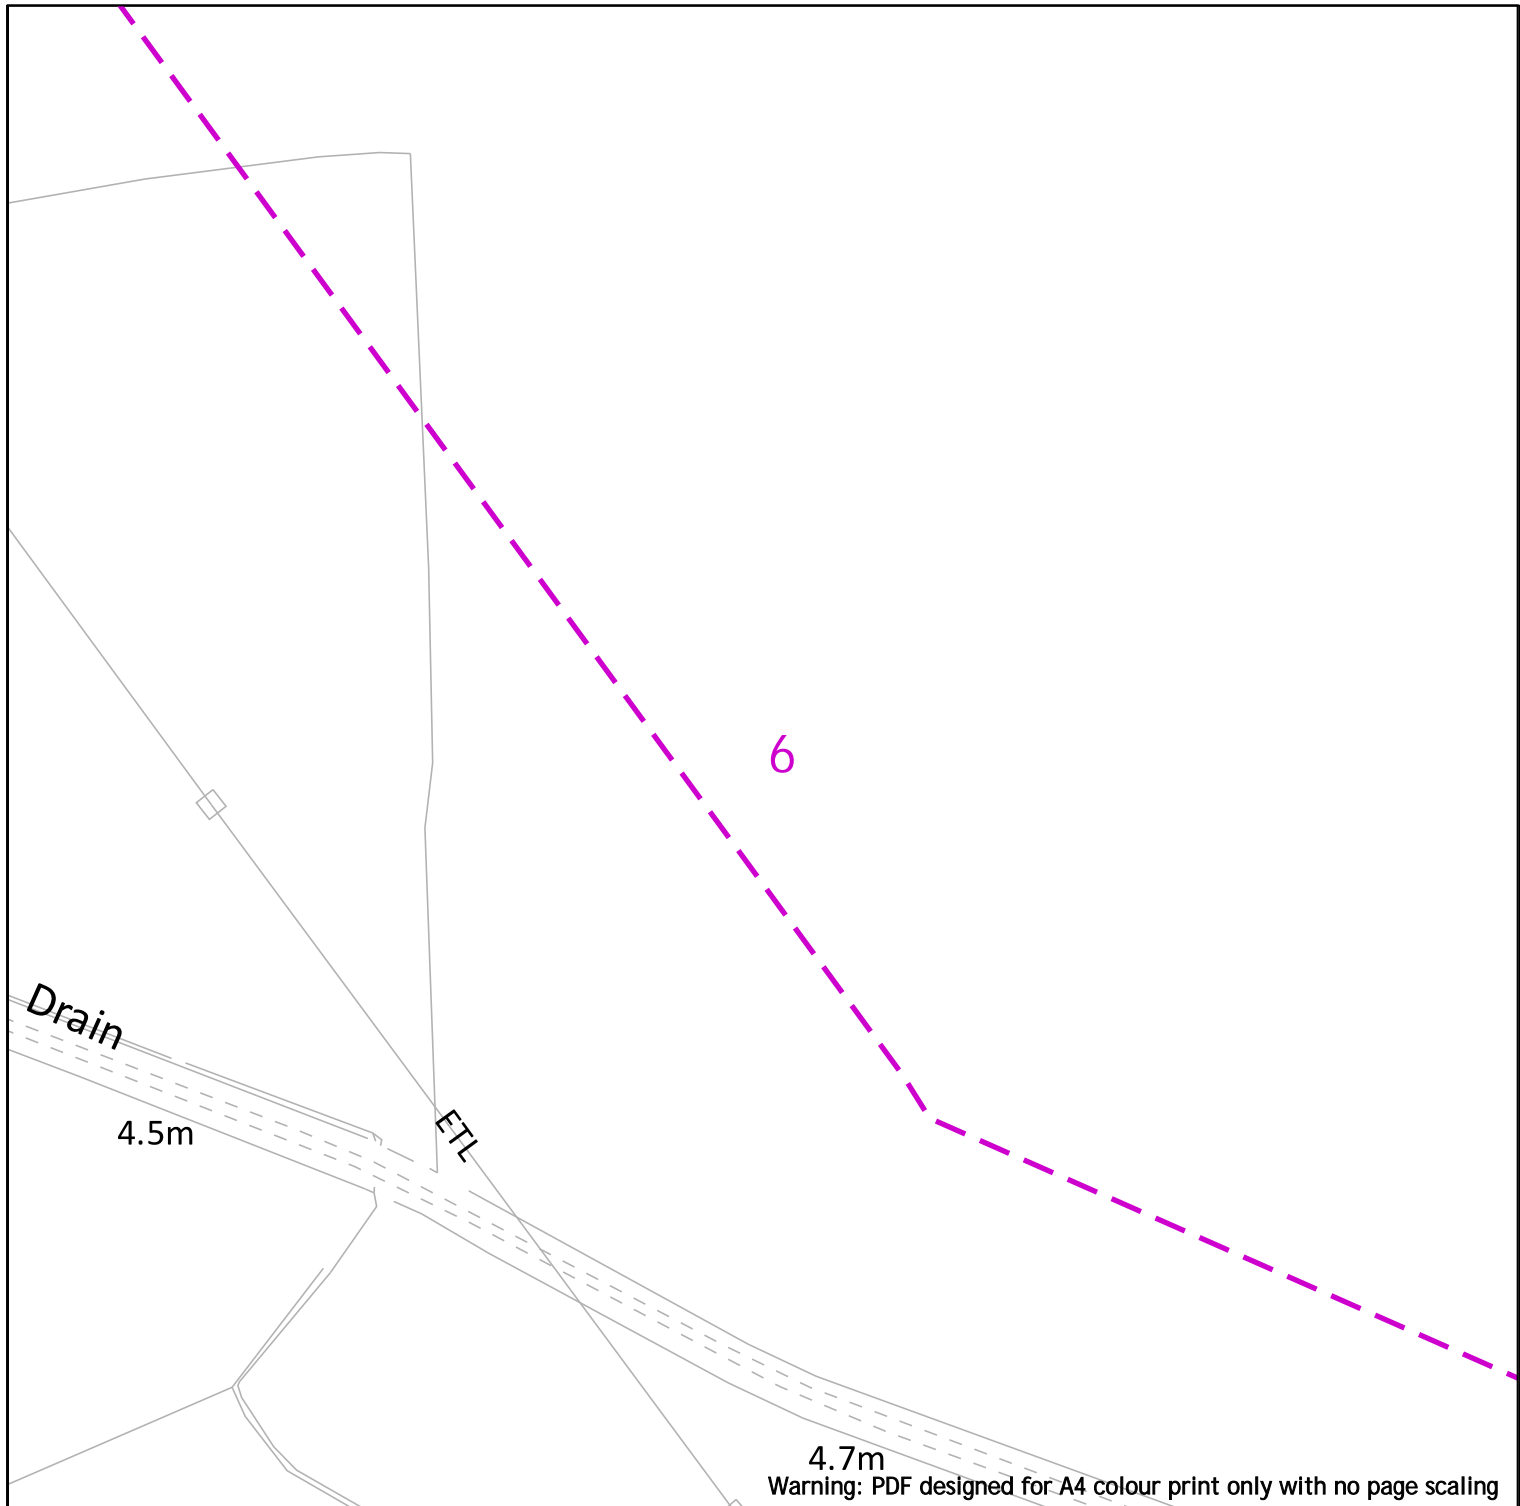

Warning: PDF designed for A4 colour print only with no page scaling

nationalgrid

NationalGrid House
 Warwick Technology Park
 Gallows Hill
 Warwick
 CV34 6DA

AssetProtection@NationalGrid.com

0 200

Dig Sites Area: Line:

- Underground Cables
- Overhead Lines
- Fibre Cables

EXTREME CAUTION - HIGH VOLTAGE
****RISK OF DEATH OR SERIOUS INJURY****


Date Requested: 08/05/2023
 Job Reference: 29406935
 Site Location: 480665 383345
 Requested by: Mr Ben Evans

Your Scheme/Reference: LM
 203570/DK - 2


IMPORTANT NOTICES
 This plan shows those pipes owned by National Grid Electricity Transmission plc in its role as a Licensed Electricity Transporter (ET). Electricity cables owned by other ETs, or otherwise privately owned, may be present in this area. Information with regards to such cables should be obtained from the relevant owners. The information shown on this plan is given without warranty, the accuracy thereof cannot be guaranteed. Ancillary equipment such as cooling systems and communication cables are not shown but their presence should be anticipated. No liability of any kind whatsoever is accepted by National Grid Electricity Transmission plc or their agents, servants or contractors for any error or omission. Safe digging practices, in accordance with HS(G)47, must be used to verify and establish the actual position of cables and other apparatus on site before any mechanical plant is used. It is your responsibility to ensure that this information is provided to all persons (either direct labour or contractors) working for you on or near electricity apparatus. The information included on this plan should not be referred to beyond a period of 28 days from the date of issue.

National Grid Electricity Emergency Number: 0800 40 40 90
 Available 24 hours, 7 days/week. Calls may be recorded and monitored

Scale: 1:2500 (When plotted at A4)

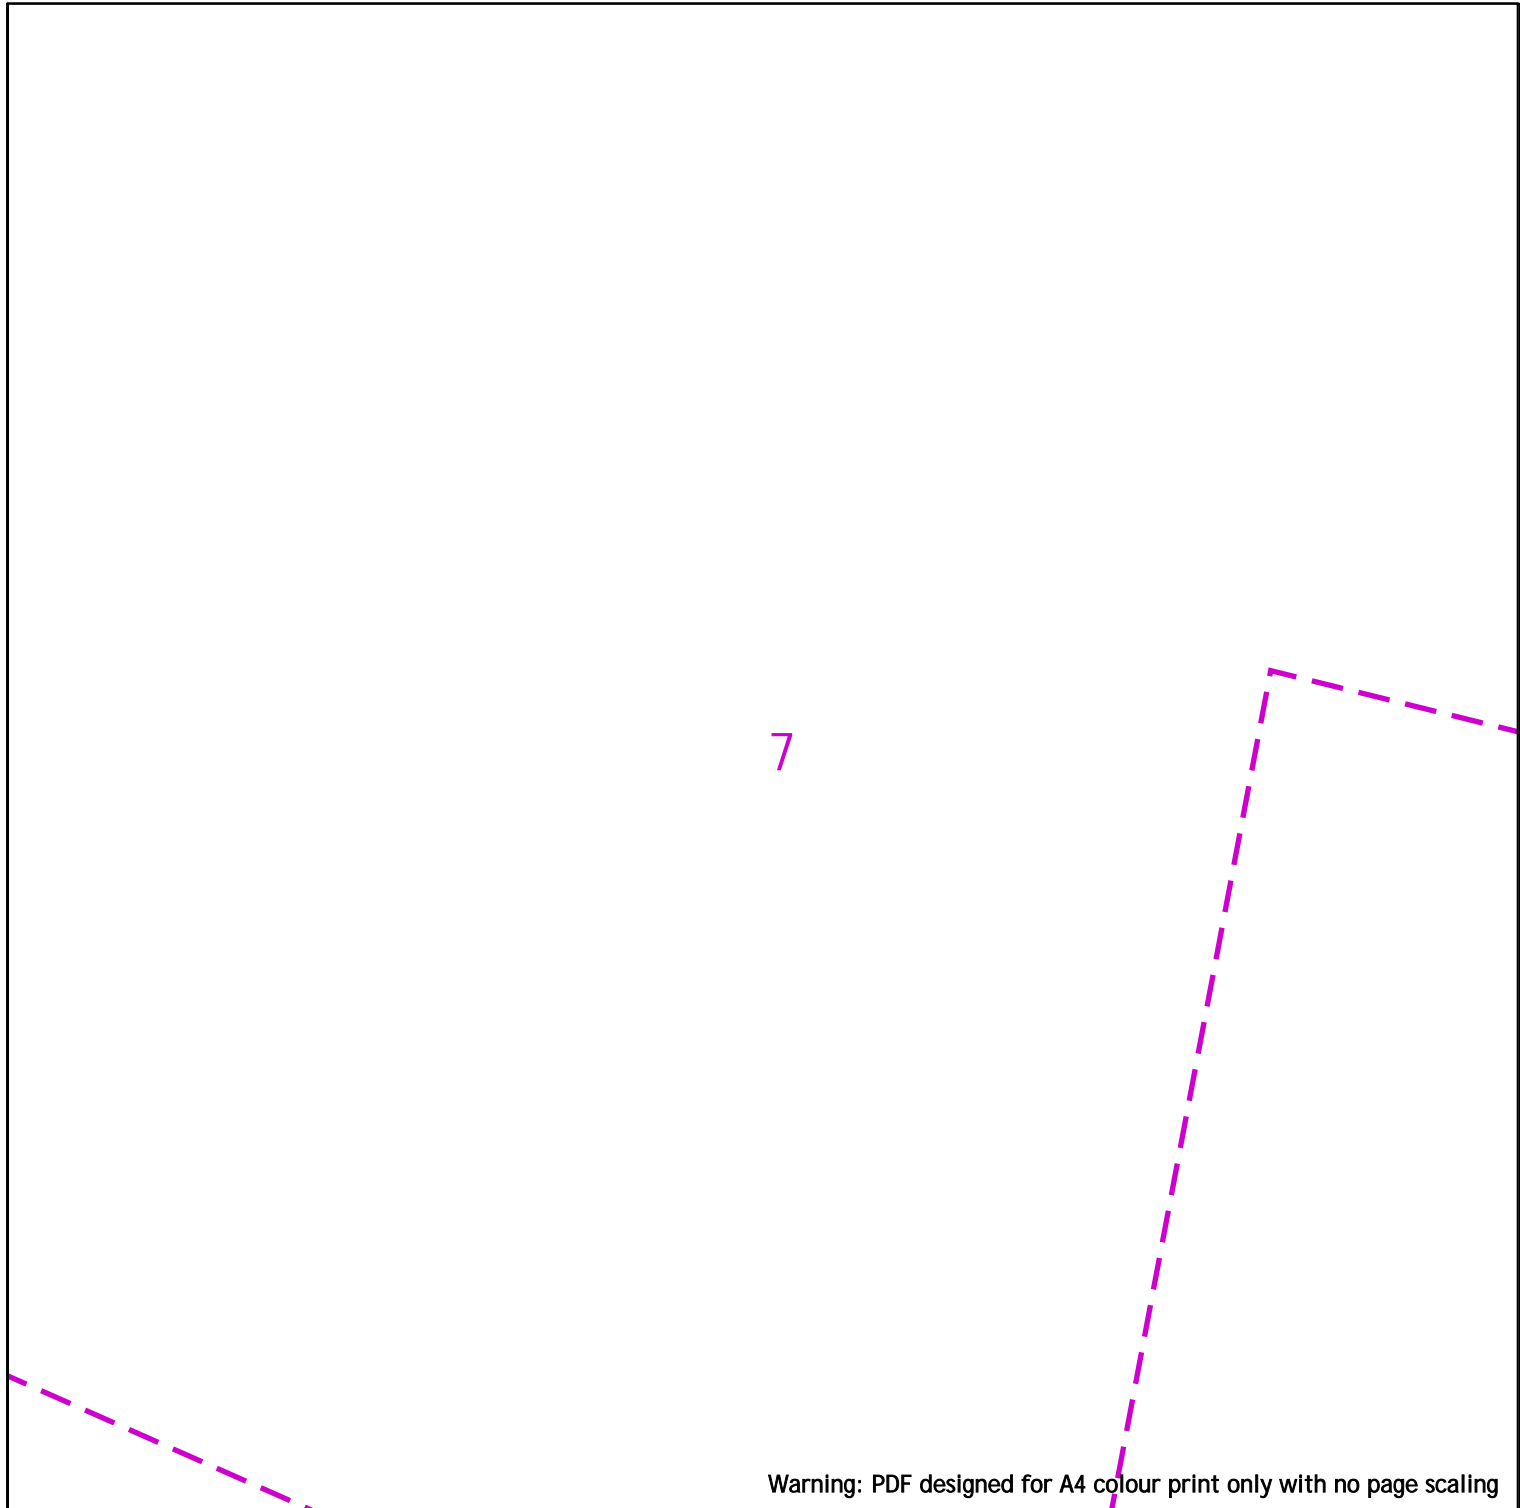

Warning: PDF designed for A4 colour print only with no page scaling

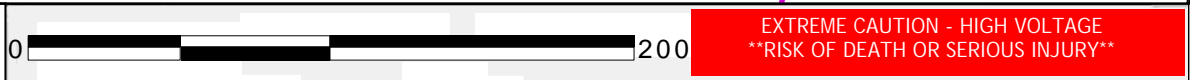

**EXTREME CAUTION - HIGH VOLTAGE
RISK OF DEATH OR SERIOUS INJURY**

Dig Sites	Area:	Line:
	Underground Cables	
	Overhead Lines	
	Fibre Cables	

NationalGrid House
Warwick Technology Park
Gallows Hill
Warwick
CV34 6DA

AssetProtection@NationalGrid.com


Date Requested: 08/05/2023
Job Reference: 29406935
Site Location: 480665 383345
Requested by: Mr Ben Evans

Your Scheme/Reference: LM
203570/DK - 2

IMPORTANT NOTICES
This plan shows those pipes owned by National Grid Electricity Transmission plc in its role as a Licensed Electricity Transporter (ET). Electricity cables owned by other ETs, or otherwise privately owned, may be present in this area. Information with regards to such cables should be obtained from the relevant owners. The information shown on this plan is given without warranty, the accuracy thereof cannot be guaranteed. Ancillary equipment such as cooling systems and communication cables are not shown but their presence should be anticipated. No liability of any kind whatsoever is accepted by National Grid Electricity Transmission plc or their agents, servants or contractors for any error or omission. Safe digging practices, in accordance with HS(G)47, must be used to verify and establish the actual position of cables and other apparatus on site before any mechanical plant is used. It is your responsibility to ensure that this information is provided to all persons (either direct labour or contractors) working for you on or near electricity apparatus. The information included on this plan should not be referred to beyond a period of 28 days from the date of issue.

National Grid Electricity Emergency Number: 0800 40 40 90
Available 24 hours, 7 days/week. Calls may be recorded and monitored

Scale: 1:2500 (When plotted at A4)

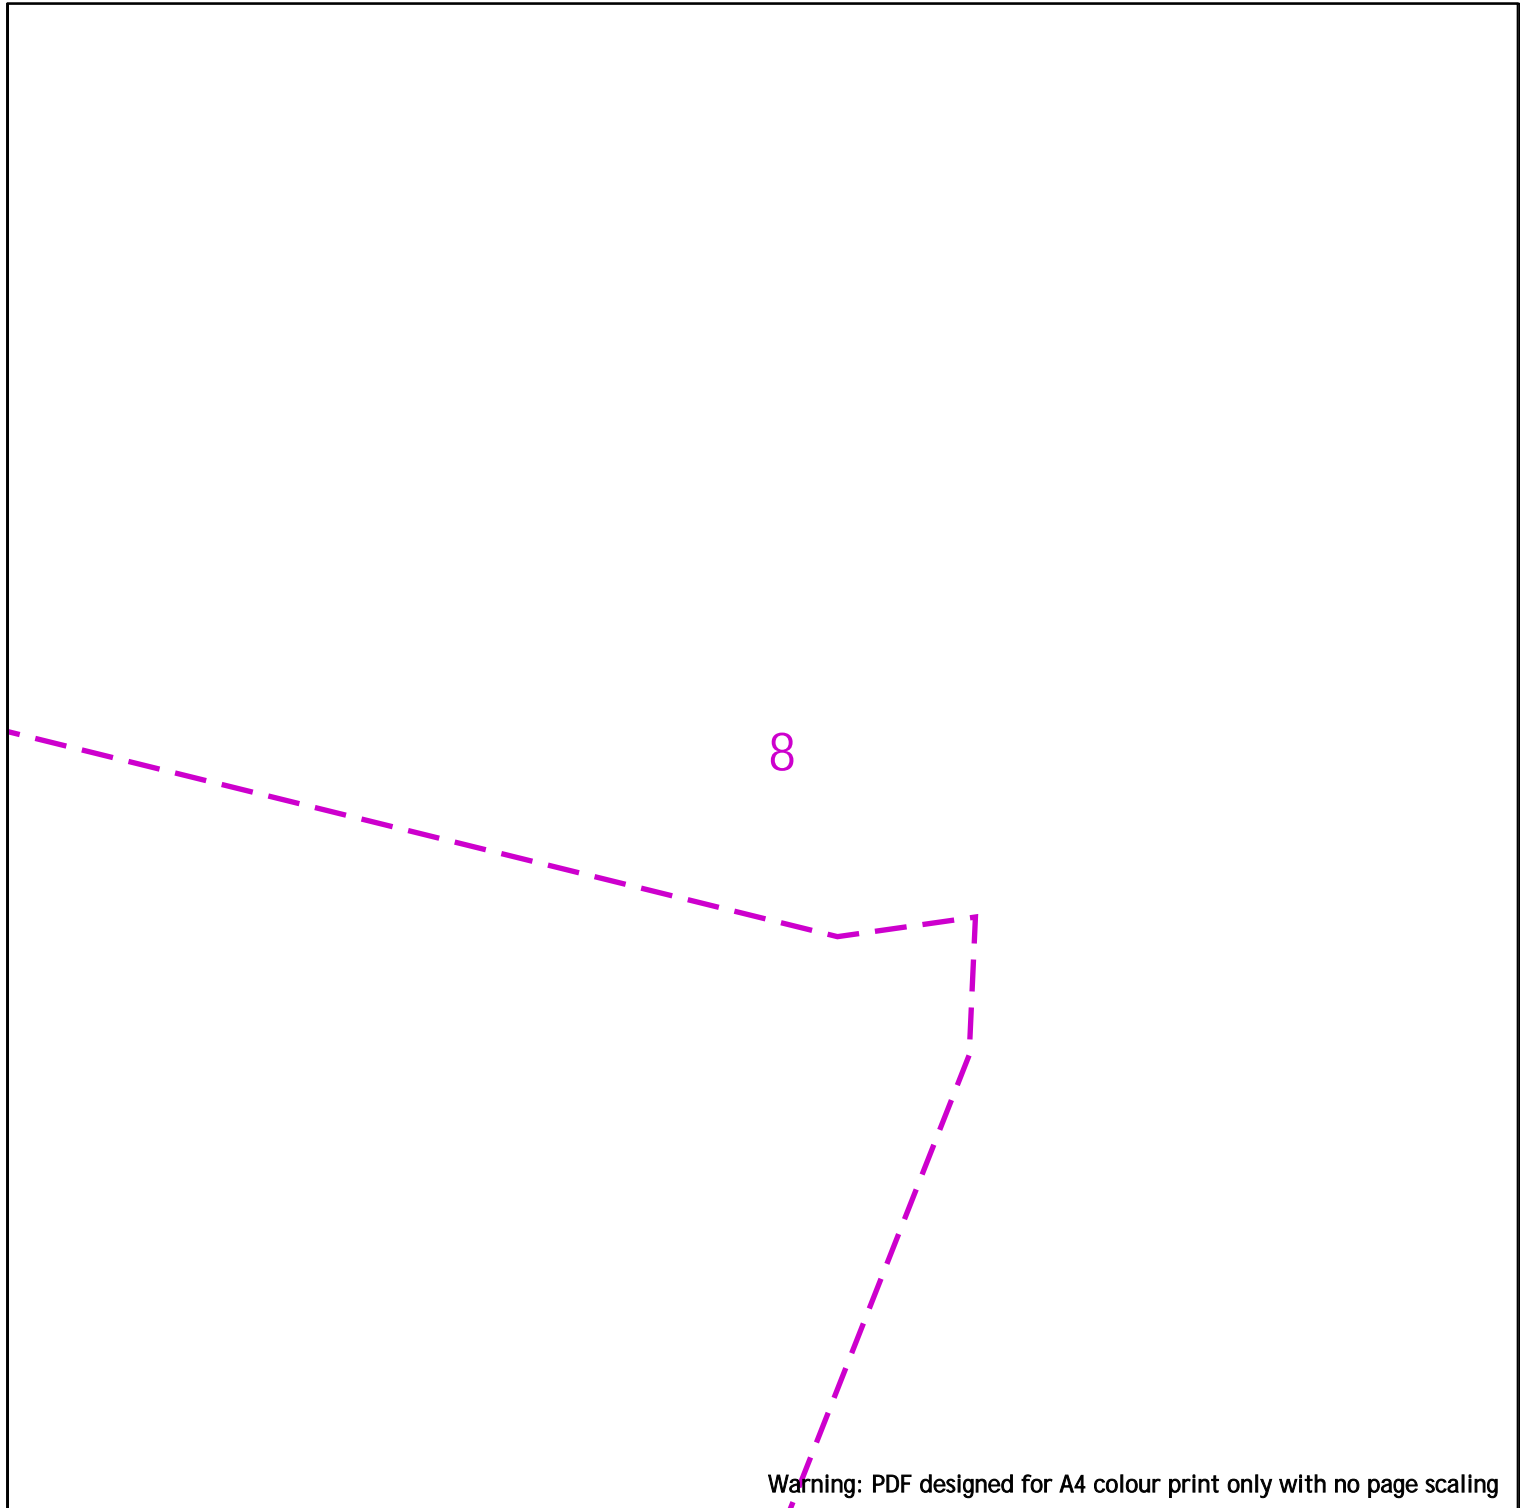

Warning: PDF designed for A4 colour print only with no page scaling



**EXTREME CAUTION - HIGH VOLTAGE
RISK OF DEATH OR SERIOUS INJURY**

Dig Sites	Area:	Line:
	Underground Cables	
	Overhead Lines	
	Fibre Cables	

NationalGrid House
Warwick Technology Park
Gallows Hill
Warwick
CV34 6DA

AssetProtection@NationalGrid.com


Date Requested: 08/05/2023
Job Reference: 29406935
Site Location: 480665 383345
Requested by: Mr Ben Evans

Your Scheme/Reference: LM
203570/DK - 2

IMPORTANT NOTICES
This plan shows those pipes owned by National Grid Electricity Transmission plc in its role as a Licensed Electricity Transporter (ET). Electricity cables owned by other ETs, or otherwise privately owned, may be present in this area. Information with regards to such cables should be obtained from the relevant owners. The information shown on this plan is given without warranty, the accuracy thereof cannot be guaranteed. Ancillary equipment such as cooling systems and communication cables are not shown but their presence should be anticipated. No liability of any kind whatsoever is accepted by National Grid Electricity Transmission plc or their agents, servants or contractors for any error or omission. Safe digging practices, in accordance with HS(G)47, must be used to verify and establish the actual position of cables and other apparatus on site before any mechanical plant is used. It is your responsibility to ensure that this information is provided to all persons (either direct labour or contractors) working for you on or near electricity apparatus. The information included on this plan should not be referred to beyond a period of 28 days from the date of issue.

National Grid Electricity Emergency Number: 0800 40 40 90
Available 24 hours, 7 days/week. Calls may be recorded and monitored

Scale: 1:2500 (When plotted at A4)

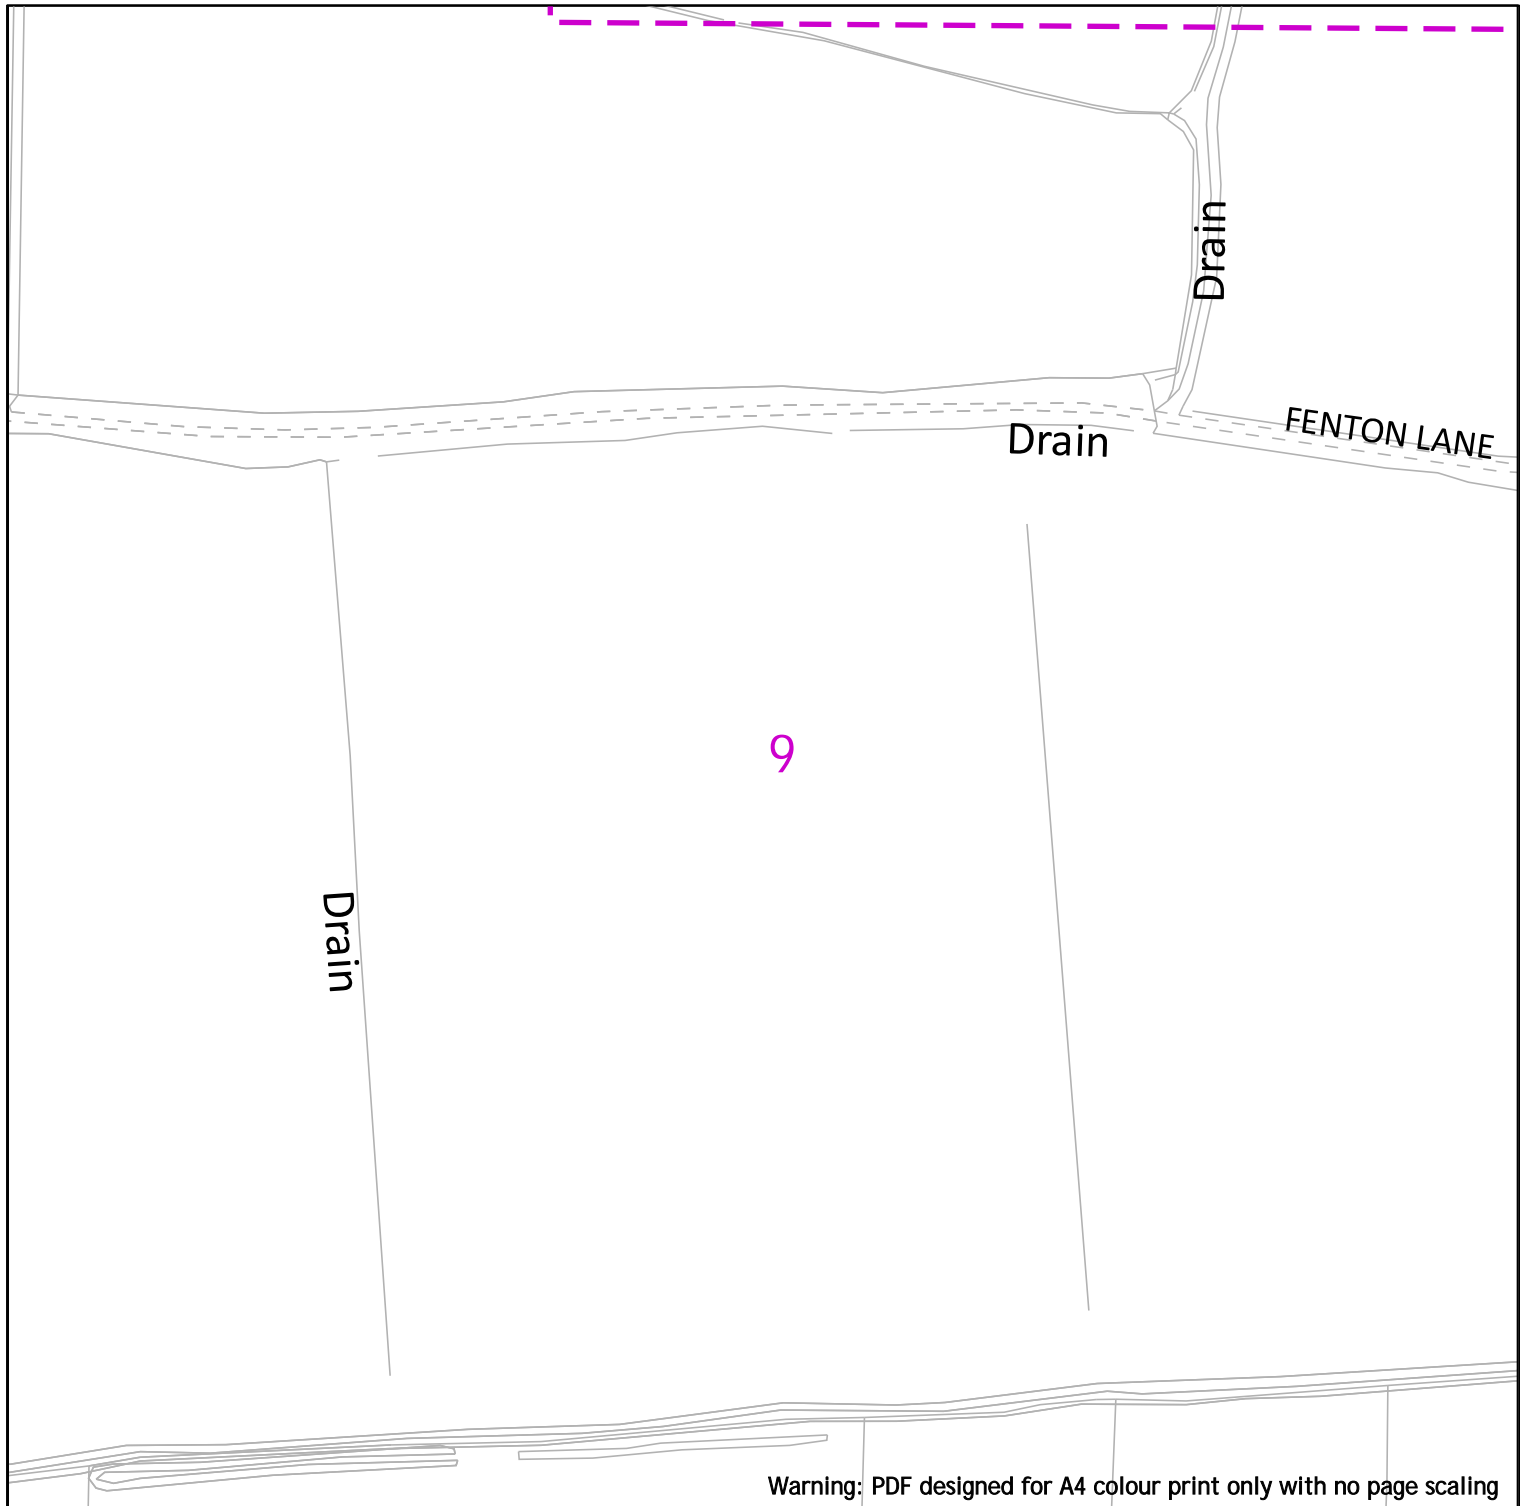

Warning: PDF designed for A4 colour print only with no page scaling

nationalgrid



**EXTREME CAUTION - HIGH VOLTAGE
RISK OF DEATH OR SERIOUS INJURY**

Dig Sites	Area:	Line:
	Underground Cables	
	Overhead Lines	
	Fibre Cables	

NationalGrid House
Warwick Technology Park
Gallows Hill
Warwick
CV34 6DA

AssetProtection@NationalGrid.com

Date Requested: 08/05/2023
Job Reference: 29406935
Site Location: 480665 383345
Requested by: Mr Ben Evans


Your Scheme/Reference: LM
203570/DK - 2

IMPORTANT NOTICES

This plan shows those pipes owned by National Grid Electricity Transmission plc in its role as a Licensed Electricity Transporter (ET). Electricity cables owned by other ETs, or otherwise privately owned, may be present in this area. Information with regards to such cables should be obtained from the relevant owners. The information shown on this plan is given without warranty, the accuracy thereof cannot be guaranteed. Ancillary equipment such as cooling systems and communication cables are not shown but their presence should be anticipated. No liability of any kind whatsoever is accepted by National Grid Electricity Transmission plc or their agents, servants or contractors for any error or omission. Safe digging practices, in accordance with HS(G)47, must be used to verify and establish the actual position of cables and other apparatus on site before any mechanical plant is used. It is your responsibility to ensure that this information is provided to all persons (either direct labour or contractors) working for you on or near electricity apparatus. The information included on this plan should not be referred to beyond a period of 28 days from the date of issue.

National Grid Electricity Emergency Number: 0800 40 40 90
Available 24 hours, 7 days/week. Calls may be recorded and monitored

Scale: 1:2500 (When plotted at A4)

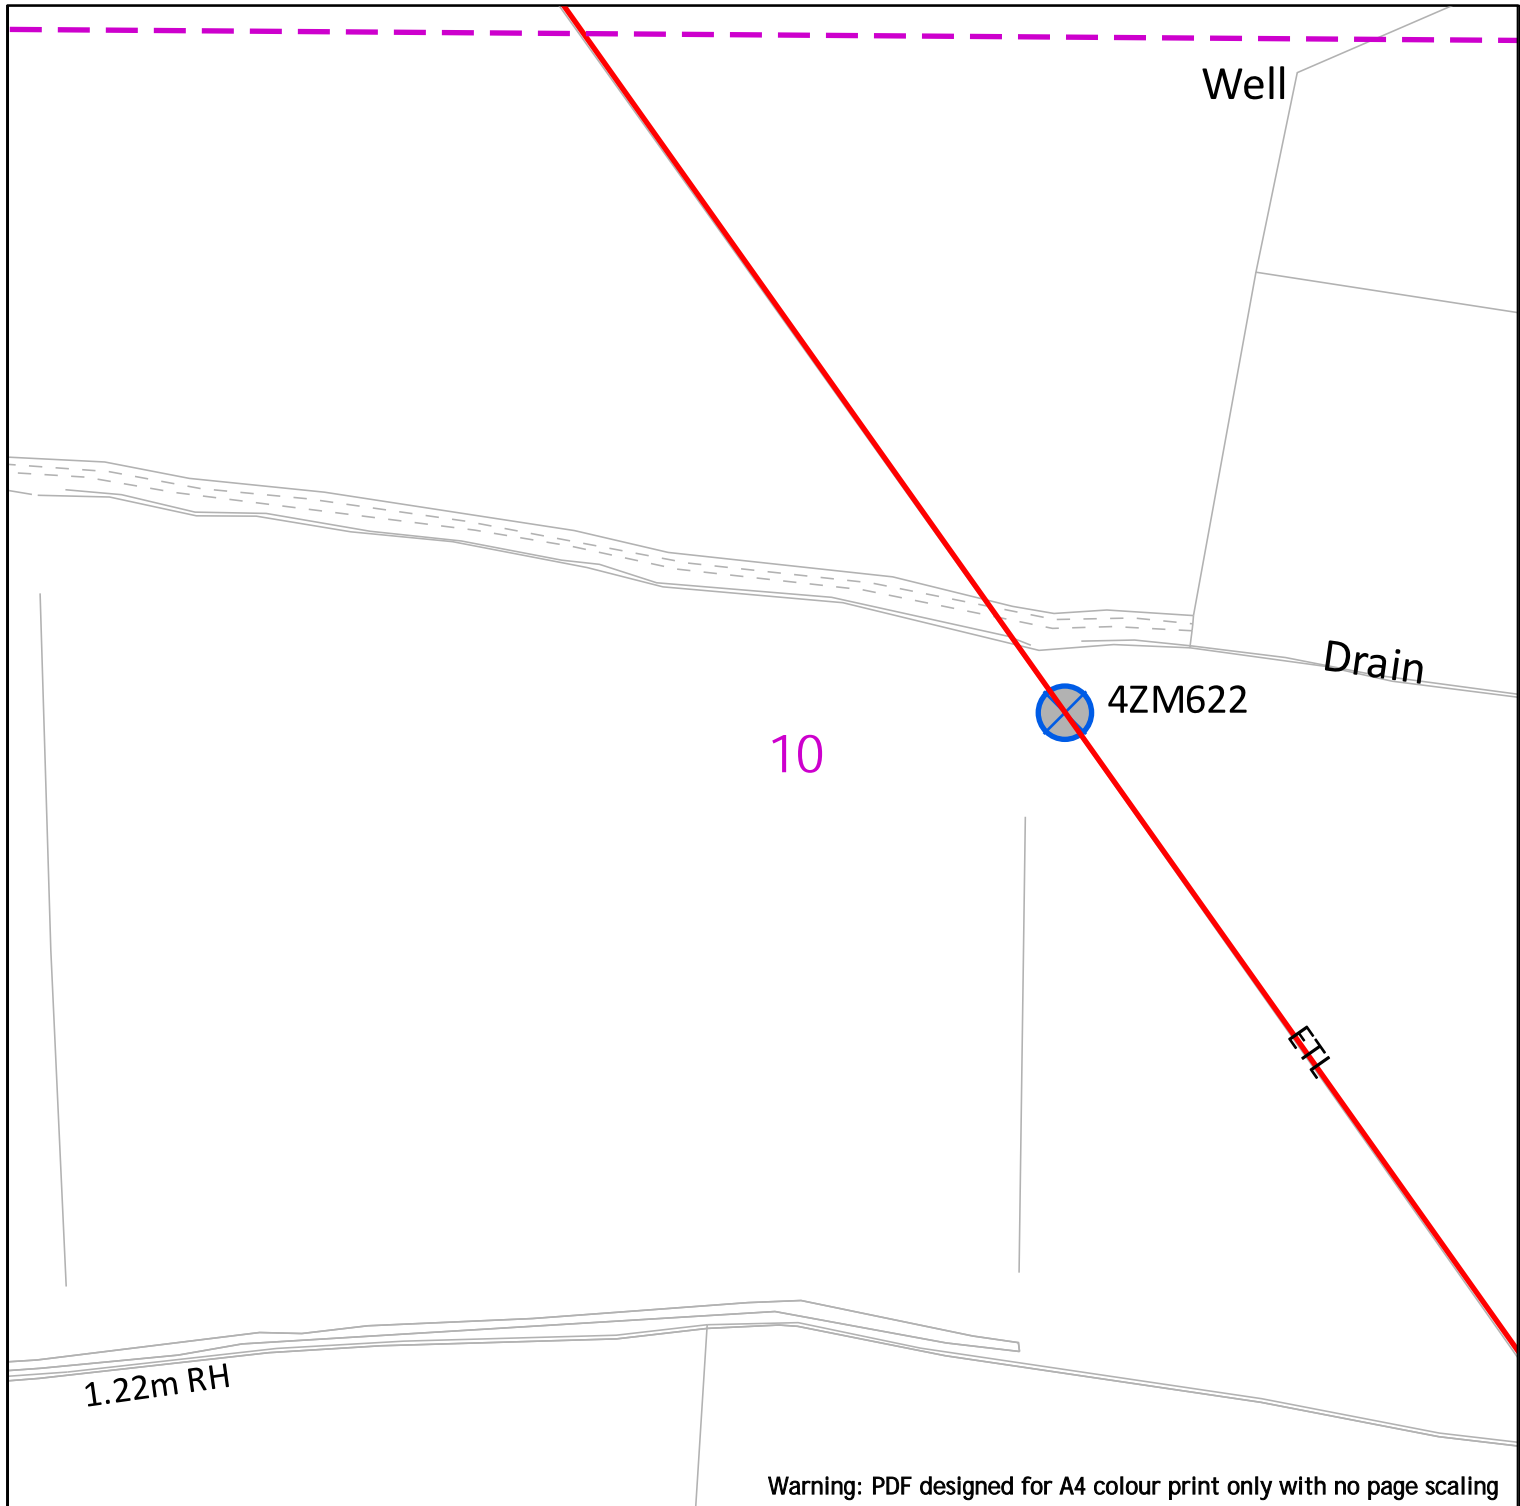

Warning: PDF designed for A4 colour print only with no page scaling

nationalgrid

NationalGrid House
 Warwick Technology Park
 Gallows Hill
 Warwick
 CV34 6DA

AssetProtection@NationalGrid.com

0 200

Dig Sites Area: Line:

Underground Cables

Overhead Lines

Fibre Cables

EXTREME CAUTION - HIGH VOLTAGE
****RISK OF DEATH OR SERIOUS INJURY****

Date Requested: 08/05/2023
 Job Reference: 29406935
 Site Location: 480665 383345
 Requested by: Mr Ben Evans


Your Scheme/Reference: LM
 203570/DK - 2

Scale: 1:2500 (When plotted at A4)

IMPORTANT NOTICES
 This plan shows those pipes owned by National Grid Electricity Transmission plc in its role as a Licensed Electricity Transporter (ET). Electricity cables owned by other ETs, or otherwise privately owned, may be present in this area. Information with regards to such cables should be obtained from the relevant owners. The information shown on this plan is given without warranty, the accuracy thereof cannot be guaranteed. Ancillary equipment such as cooling systems and communication cables are not shown but their presence should be anticipated. No liability of any kind whatsoever is accepted by National Grid Electricity Transmission plc or their agents, servants or contractors for any error or omission. Safe digging practices, in accordance with HS(G)47, must be used to verify and establish the actual position of cables and other apparatus on site before any mechanical plant is used. It is your responsibility to ensure that this information is provided to all persons (either direct labour or contractors) working for you on or near electricity apparatus. The information included on this plan should not be referred to beyond a period of 28 days from the date of issue.


National Grid Electricity Emergency Number: 0800 40 40 90
 Available 24 hours, 7 days/week. Calls may be recorded and monitored

Crown Copyright © - Reproduced by permission of Ordnance Survey on behalf of HMSO. And database right 2023. All rights reserved. Ordnance Survey Licence number 0100059731.

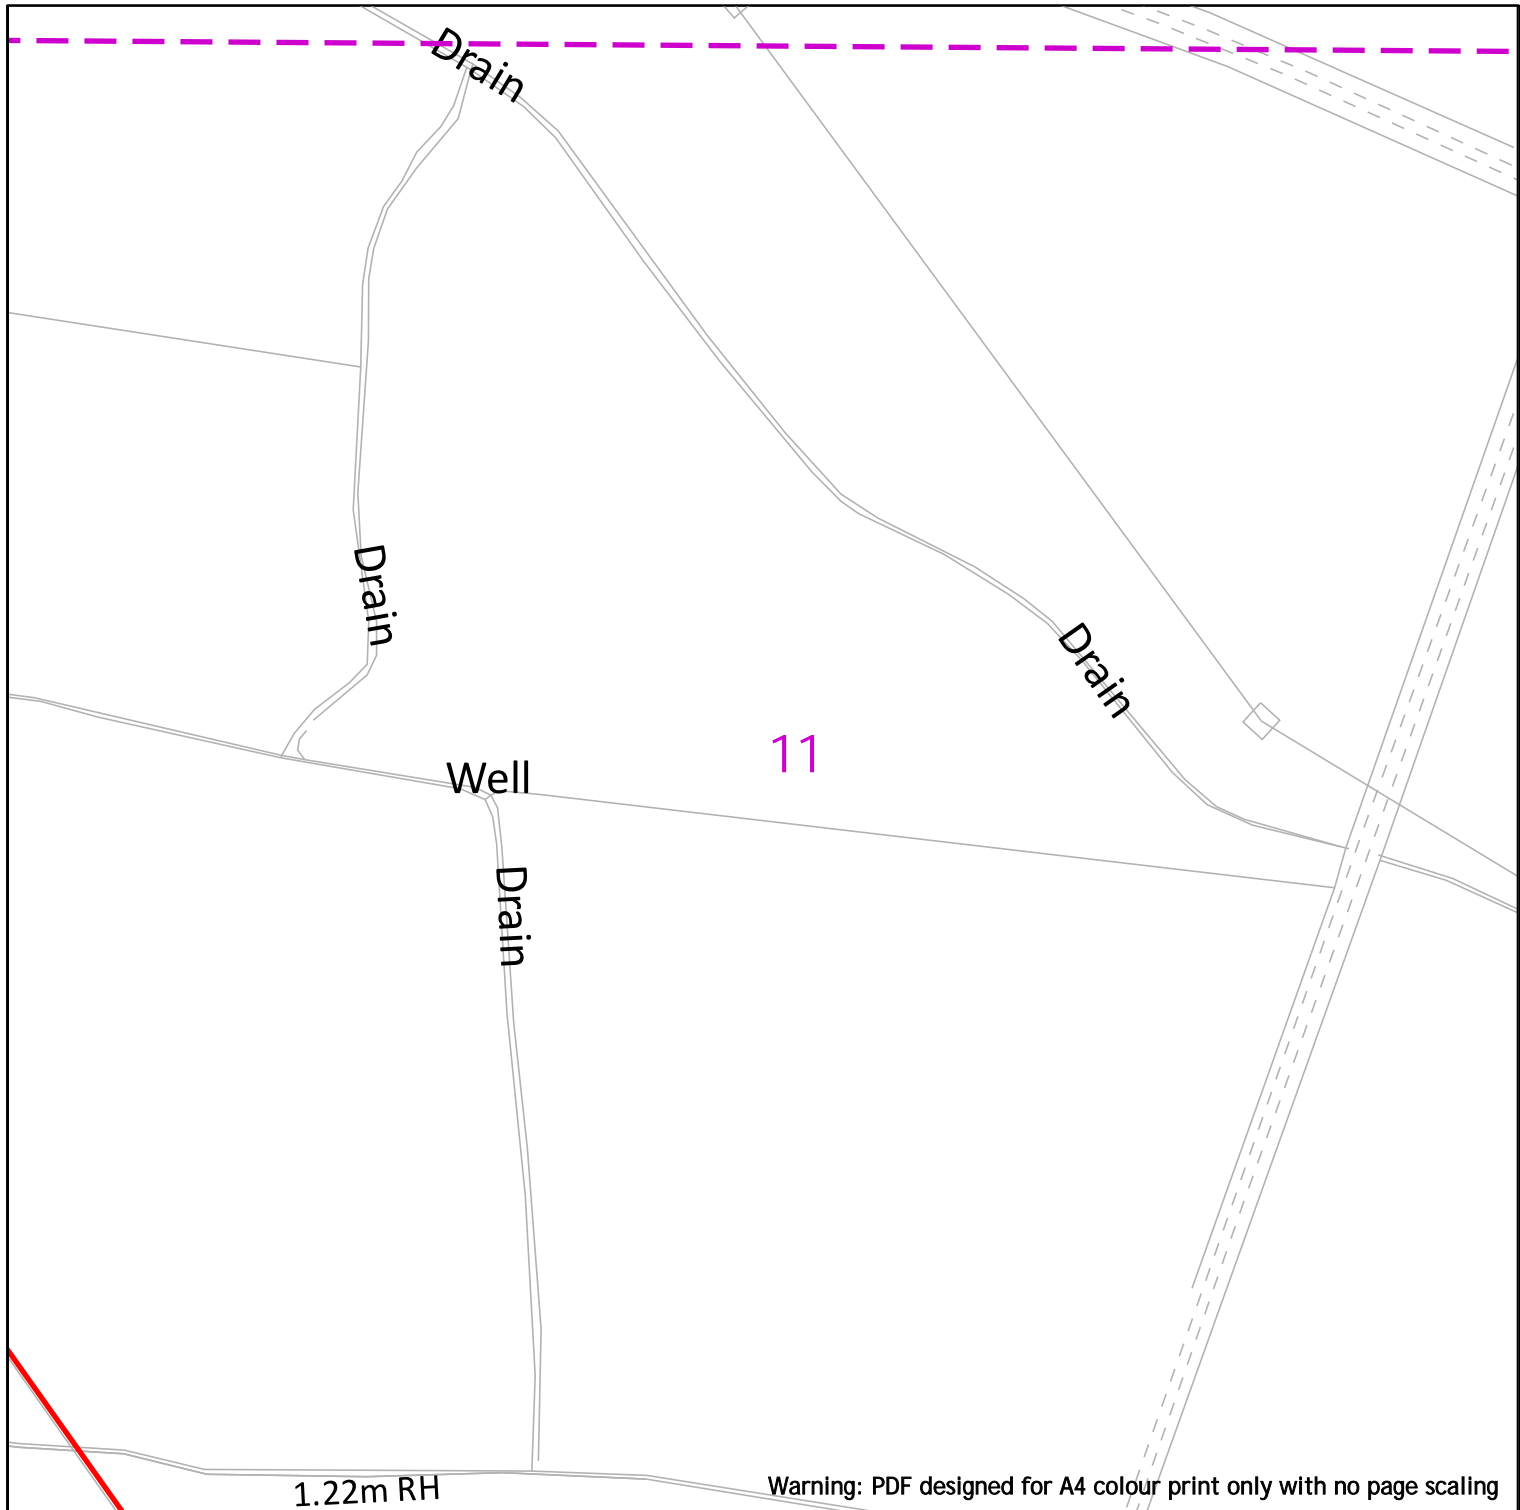

NationalGrid House
 Warwick Technology Park
 Gallows Hill
 Warwick
 CV34 6DA
 AssetProtection@NationalGrid.com

Date Requested: 08/05/2023
 Job Reference: 29406935
 Site Location: 480665 383345
 Requested by: Mr Ben Evans
 Your Scheme/Reference: LM
 203570/DK - 2
 Scale: 1:2500 (When plotted at A4)

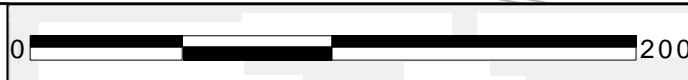

Dig Sites Area: Line:

 Underground Cables

 Overhead Lines


 Fibre Cables

EXTREME CAUTION - HIGH VOLTAGE
****RISK OF DEATH OR SERIOUS INJURY****

IMPORTANT NOTICES
 This plan shows those pipes owned by National Grid Electricity Transmission plc in its role as a Licensed Electricity Transporter (ET). Electricity cables owned by other ETs, or otherwise privately owned, may be present in this area. Information with regards to such cables should be obtained from the relevant owners. The information shown on this plan is given without warranty, the accuracy thereof cannot be guaranteed. Ancillary equipment such as cooling systems and communication cables are not shown but their presence should be anticipated. No liability of any kind whatsoever is accepted by National Grid Electricity Transmission plc or their agents, servants or contractors for any error or omission. Safe digging practices, in accordance with HS(G)47, must be used to verify and establish the actual position of cables and other apparatus on site before any mechanical plant is used. It is your responsibility to ensure that this information is provided to all persons (either direct labour or contractors) working for you on or near electricity apparatus. The information included on this plan should not be referred to beyond a period of 28 days from the date of issue.

National Grid Electricity Emergency Number: 0800 40 40 90
 Available 24 hours, 7 days/week. Calls may be recorded and monitored

Crown Copyright © - Reproduced by permission of Ordnance Survey on behalf of HMSO. And database right 2023. All rights reserved. Ordnance Survey Licence number 0100059731.

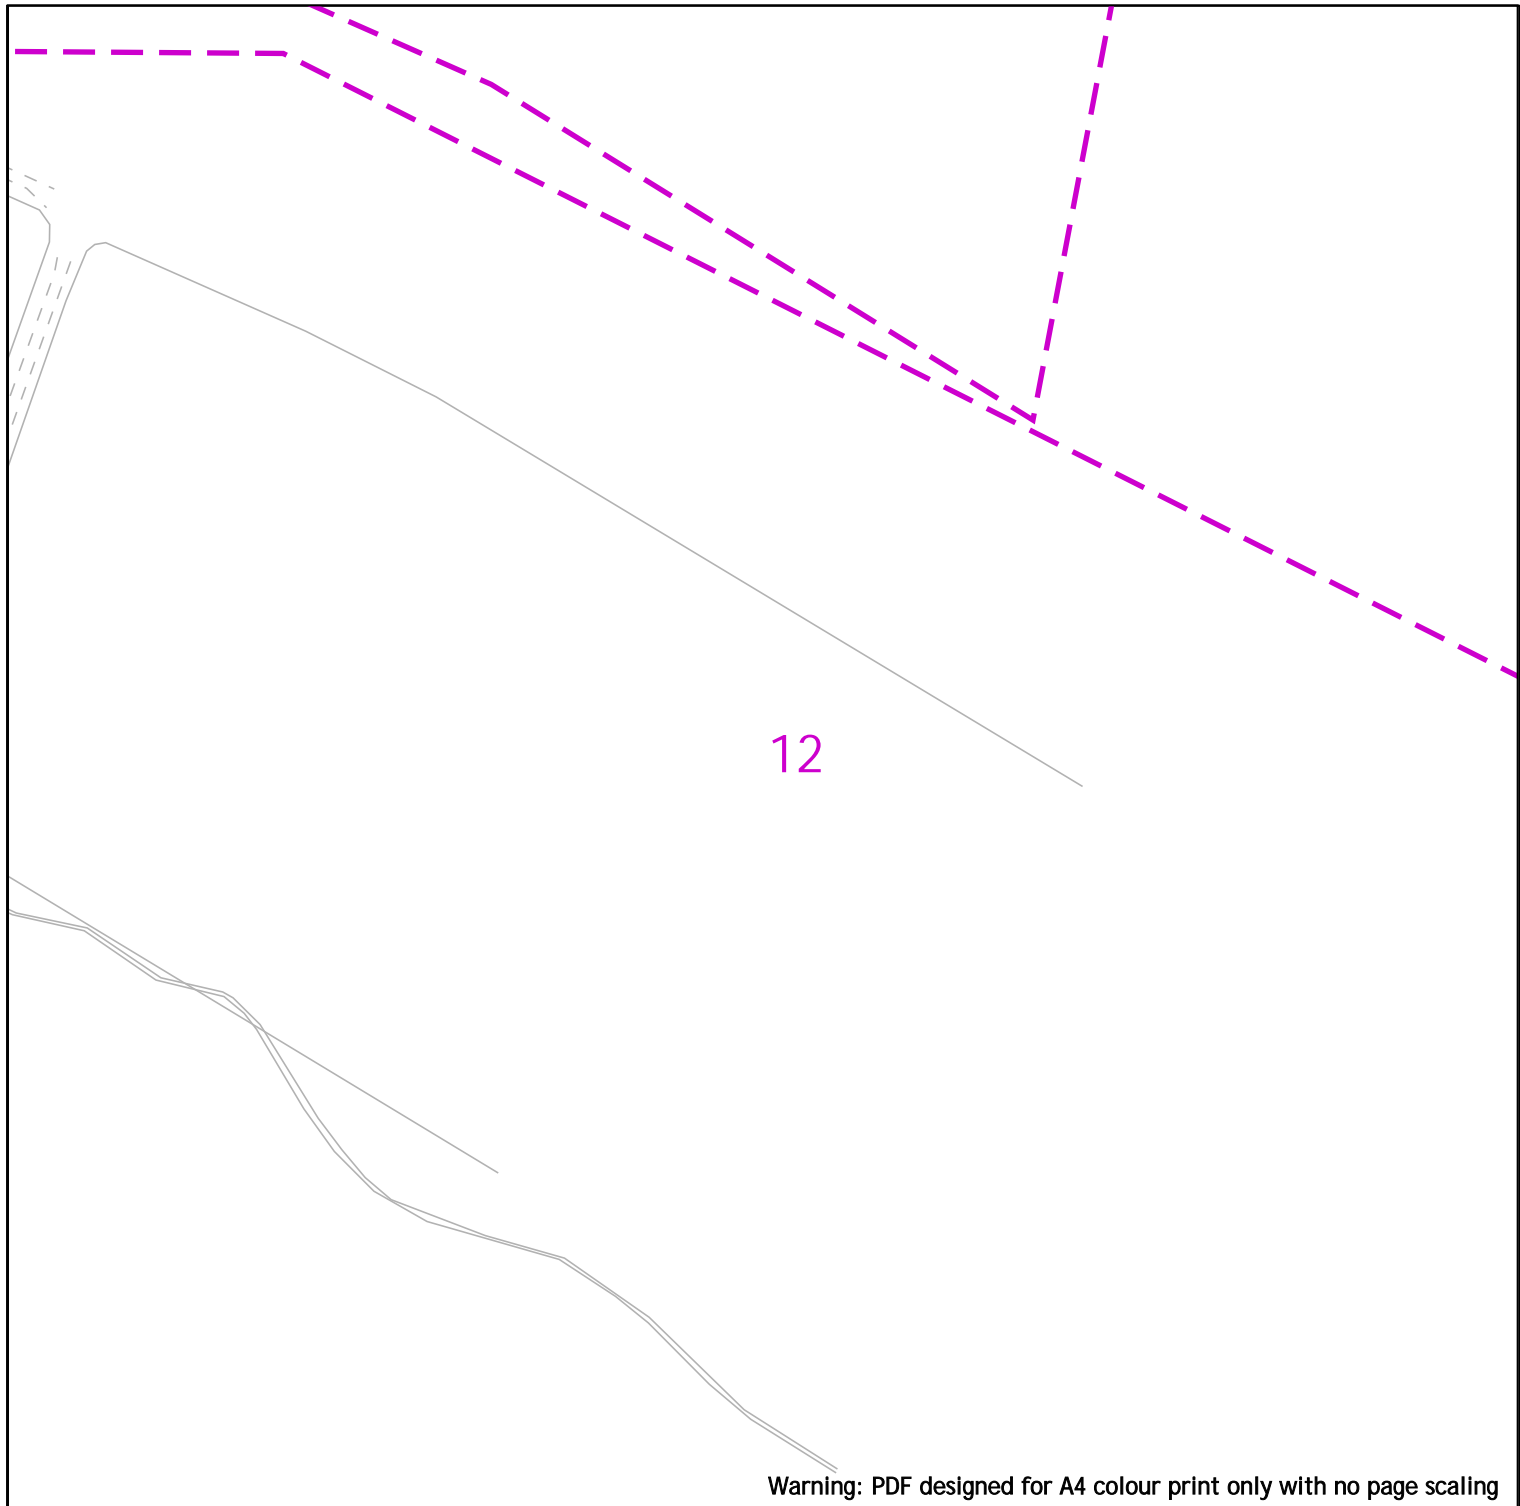


Warning: PDF designed for A4 colour print only with no page scaling

nationalgrid



**EXTREME CAUTION - HIGH VOLTAGE
RISK OF DEATH OR SERIOUS INJURY**

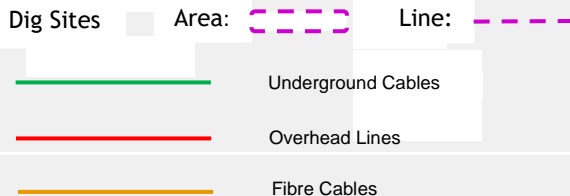

NationalGrid House
Warwick Technology Park
Gallows Hill
Warwick
CV34 6DA

AssetProtection@NationalGrid.com

Date Requested: 08/05/2023
Job Reference: 29406935
Site Location: 480665 383345
Requested by: Mr Ben Evans


Your Scheme/Reference: LM
203570/DK - 2

IMPORTANT NOTICES

This plan shows those pipes owned by National Grid Electricity Transmission plc in its role as a Licensed Electricity Transporter (ET). Electricity cables owned by other ETs, or otherwise privately owned, may be present in this area. Information with regards to such cables should be obtained from the relevant owners. The information shown on this plan is given without warranty, the accuracy thereof cannot be guaranteed. Ancillary equipment such as cooling systems and communication cables are not shown but their presence should be anticipated. No liability of any kind whatsoever is accepted by National Grid Electricity Transmission plc or their agents, servants or contractors for any error or omission. Safe digging practices, in accordance with HS(G)47, must be used to verify and establish the actual position of cables and other apparatus on site before any mechanical plant is used. It is your responsibility to ensure that this information is provided to all persons (either direct labour or contractors) working for you on or near electricity apparatus. The information included on this plan should not be referred to beyond a period of 28 days from the date of issue.

National Grid Electricity Emergency Number: 0800 40 40 90
Available 24 hours, 7 days/week. Calls may be recorded and monitored

Scale: 1:2500 (When plotted at A4)

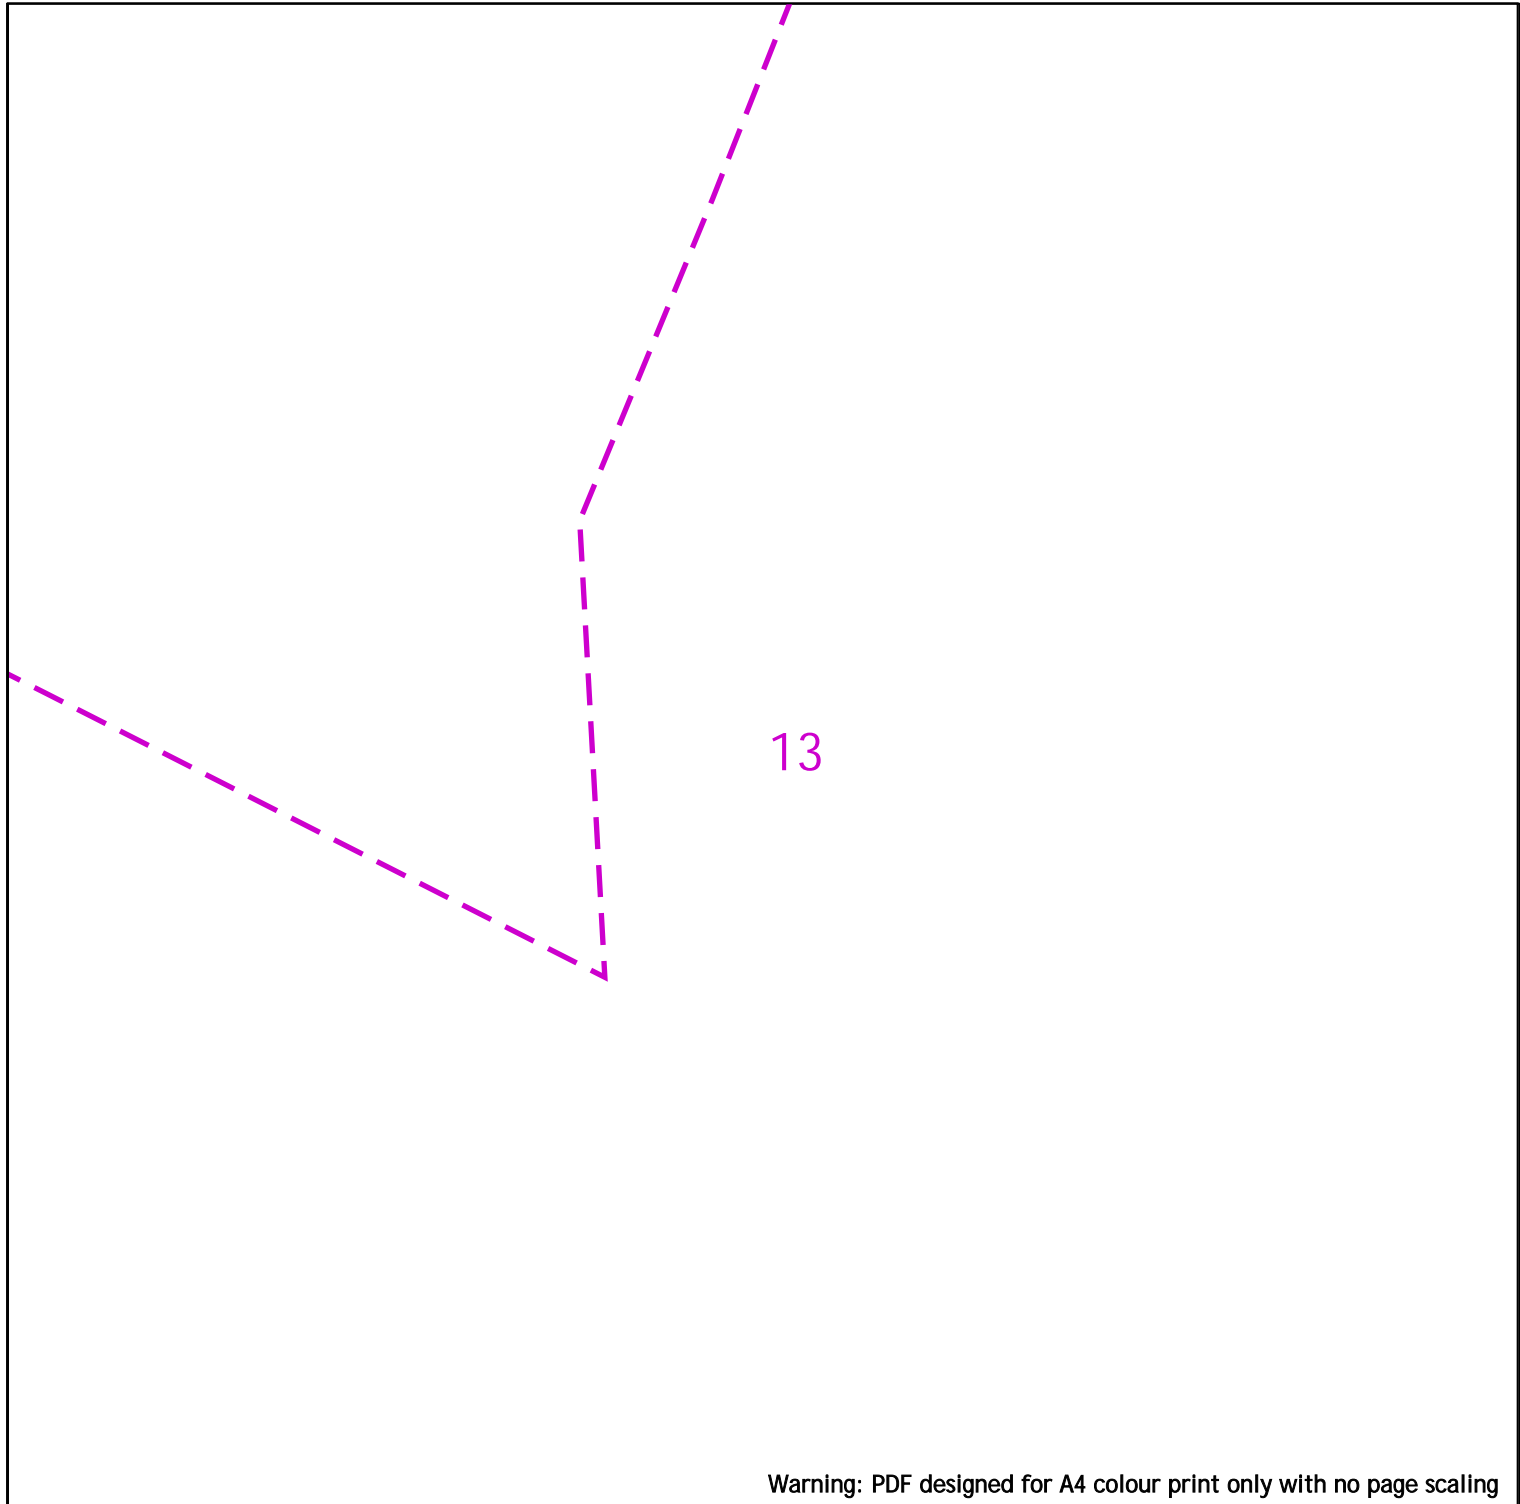

Warning: PDF designed for A4 colour print only with no page scaling

	<div style="background-color: red; color: white; padding: 5px; text-align: center;"> EXTREME CAUTION - HIGH VOLTAGE **RISK OF DEATH OR SERIOUS INJURY** </div>
<p>NationalGrid House Warwick Technology Park Gallows Hill Warwick CV34 6DA</p> <p>AssetProtection@NationalGrid.com</p>	<p>Dig Sites Area: Line: </p> <p> Underground Cables</p> <p> Overhead Lines</p> <p> Fibre Cables</p>
<p>Date Requested: 08/05/2023 Job Reference: 29406935 Site Location: 480665 383345 Requested by: Mr Ben Evans</p> <p>Your Scheme/Reference: LM 203570/DK - 2</p> <p>Scale: 1:2500 (When plotted at A4)</p>	<p>IMPORTANT NOTICES This plan shows those pipes owned by National Grid Electricity Transmission plc in its role as a Licensed Electricity Transporter (ET). Electricity cables owned by other ETs, or otherwise privately owned, may be present in this area. Information with regards to such cables should be obtained from the relevant owners. The information shown on this plan is given without warranty, the accuracy thereof cannot be guaranteed. Ancillary equipment such as cooling systems and communication cables are not shown but their presence should be anticipated. No liability of any kind whatsoever is accepted by National Grid Electricity Transmission plc or their agents, servants or contractors for any error or omission. Safe digging practices, in accordance with HS(G)47, must be used to verify and establish the actual position of cables and other apparatus on site before any mechanical plant is used. It is your responsibility to ensure that this information is provided to all persons (either direct labour or contractors) working for you on or near electricity apparatus. The information included on this plan should not be referred to beyond a period of 28 days from the date of issue.</p> <p style="text-align: center;">National Grid Electricity Emergency Number: 0800 40 40 90 Available 24 hours, 7 days/week. Calls may be recorded and monitored</p> <p style="font-size: small; text-align: center;">Crown Copyright © - Reproduced by permission of Ordnance Survey on behalf of HMSO. And database right 2023. All rights reserved. Ordnance Survey Licence number 0100059731.</p>

ENQUIRY SUMMARY

Received Date

08/05/2023 9:33

Work Start Date

30/05/2023

Your Reference

LM 203570/DK - 2

Location

Centre Point: 480665 383345

X Extent:

Y Extent:

Postcode: DN220HB

Map Options

Paper Size: A4

Orientation: PORTRAIT

Scale: 1:2500

Real World Extents: 2137m x 1142m

Enquirer Details

Organisation Name: Atkins - Utility Solutions

Contact Name: Ben Evans

Email Address: searches.utilitysolutions@atkinglobal.com

Telephone: 01454662086

Address: The Hub, 500 Park Avenue, Aztec West, , Bristol, BS32 4RZ

Enquiry Type

Initial Enquiry

Activity Type

Utility Works

Work Types

Single excavations site (deeper than 1.5m)

Notes/Works Description (if supplied)

Site Contact Name (if supplied)

Site Contact Number (if supplied)

Our Ref: 29406936 LM 203570/DK - 3

Monday, 08 May 2023

Ben Evans
The Hub, 500 Park Avenue, Aztec West

Bristol
BS32 4RZ

National Grid House
Warwick Technology Park
Gallows Hill, Warwick
CV34 6DA

Electricity Emergency Number:
0800 40 40 90*
*Available 24 hours, 7 days/week.
Calls may be recorded and monitored.
www.nationalgrid.com

Asset Protection
Gas Transmission
National Grid
Warwick
Email: assetprotection@nationalgrid.com

National Grid Electricity – High Risk Response Letter

Dear Sir/ Madam,

An assessment has been carried out with respect to National Grid Electricity Transmission plc's apparatus and the proposed work location. Based on the location entered into the system for assessment the area has been found to be within the High Risk zone from National Grid Electricity Transmission plc's apparatus and **Must Not Proceed** without further assessment by Asset Protection.

Could you please send a works description (including how deep you are excavating) and any plans including any commencement dates to the following email address assetprotection@nationalgrid.com including the LSBUD enquiry reference number.

Failure to provide this information will result in a delay to your works being assessed.

Please note this response and any attached map(s) are valid for 28 days from date of this letter. A new enquiry will need to be submitted into LSBUD if the requested information above is not supplied within 28 days.

Yours sincerely,

Asset Protection

Your Responsibilities and Obligations

The "Assessment" Section below outlines the detailed requirements that must be followed when planning or undertaking your activities at this location.

It is your responsibility to ensure that the information you have submitted is accurate and that all relevant documents including links are provided to all persons (either direct labour or contractors) working for you near National Grid Electricity Transmission plc's apparatus, e.g. as contained within the Construction (Design and Management) Regulations.

This assessment solely relates to National Grid Electricity Transmission plc (NGET)

This assessment does **NOT** include:

- National Grid's legal interest (easements or wayleaves) in the land which restricts activity in proximity to National Grid's assets in private land. You must obtain details of any such restrictions from the landowner in the first instance and if in doubt contact Asset Protection.
- Recently installed apparatus
- National Grid Gas plc.
- Apparatus owned by other organisations, e.g. Cadent, other gas distribution operators, local electricity companies, other utilities, etc.

It is **YOUR** responsibility to take into account whether the items listed above may be present and if they could be affected by your proposed activities.

This communication does not constitute any formal agreement or consent for any proposed development work; either generally or with regard to National Grid Electricity Transmission plc easements or wayleaves nor any planning or building regulations applications.

National Grid Electricity Transmission plc or their agents, servants or contractors do not accept any liability for any losses arising under or in connection with this information. This limit on liability applies to all and any claims in contract, tort (including negligence), misrepresentation (excluding fraudulent misrepresentation), breach of statutory duty or otherwise. This limit on liability does not exclude or restrict liability where prohibited by the law nor does it supersede the express terms of any related agreements.

If you require further assistance please contact the Asset Protection team via e-mail (assetprotection@nationalgrid.com) or via the contact details at the top of this response.

Assessment

Affected Apparatus

The apparatus that has been identified as being in the vicinity of your proposed works is:

- Electricity Transmission Overhead Line apparatus.

Requirements

Over Head Lines

BEFORE carrying out any work you must:

(N.B. Works only to be undertaken when contact has been made and response received from Asset Protection)

- Carefully read these requirements including the attached guidance documents and maps showing the location of apparatus.
- Contact the landowner and ensure any proposed works in private land do not infringe National Grid Electricity Transmission plc's legal rights (i.e. easements or wayleaves). If the works are in the road or footpath the relevant local authority should be contacted.
- Ensure that all persons, including direct labour and contractors, working for you on or near National Grid Electricity Transmission plc's apparatus follow the requirements of the HSE Guidance Notes HSG47 - 'Avoiding Danger from Underground Services' and GS6 – 'Avoidance of danger from overhead electric power lines'. This guidance can be downloaded free of charge at www.hse.gov.uk
- In line with the above guidance, verify and establish the actual position of mains, pipes, cables, services and other apparatus on site before any activities are undertaken.

DURING any work you must:

- Comply with all guidance for working within the vicinity of overhead lines as detailed within the guidance documents listed below.
- Comply with all guidance relating to general activities and any specific guidance for each asset type as specified in the Guidance Section below.
- Ensure that access to National Grid Electricity Transmission plc's apparatus is maintained at all times.
- Prevent the placing of heavy construction plant, equipment, materials or the passage of heavy vehicles over National Grid Electricity Transmission plc's apparatus unless specifically agreed with National Grid Electricity Transmission plc's apparatus in advance.
- Exercise extreme caution if slab (mass) concrete is encountered during excavation works as this maybe protecting or supporting National Grid Electricity Transmission plc's apparatus.

Underground Cables

BEFORE carrying out any work you must:

(N.B. Works only to be undertaken when contact has been made and response received from Asset Protection)

- Refer to the attached cable profile drawings which provide details about the location of National Grid's high voltage underground cables.
- Carefully read these requirements including the attached guidance documents and maps showing the location of apparatus.
- Contact the landowner and ensure any proposed works in private land do not infringe National Grid Electricity Transmission plc's legal rights (i.e. easements or wayleaves). If the works are in the road or footpath the relevant local authority should be contacted.
- Ensure that all persons, including direct labour and contractors, working for you on or near infringe National Grid Electricity Transmission plc's follow the requirements of the HSE Guidance Notes HS(G)47 "Avoiding Danger From Underground Services". This guidance can be downloaded free of charge at www.hse.gov.uk
- In line with the above guidance, verify and establish the actual position of mains, pipes, cables,

services and other apparatus on site before any activities are undertaken.

DURING any work you must:

- Comply with all guidance for working within the vicinity of Electricity Underground Cables as detailed within the guidance documents listed below.
- Comply with all guidance relating to general activities and any specific guidance for each asset type as specified in the Guidance Section below.
- Ensure that access to National Grid Electricity Transmission plc's apparatus is maintained at all times.
- Prevent the placing of heavy construction plant, equipment, materials or the passage of heavy vehicles over National Grid Electricity Transmission plc's apparatus unless specifically agreed with National Grid Electricity Transmission plc's in advance.
- Exercise extreme caution if slab (mass) concrete is encountered during excavation works as this maybe protecting or supporting National Grid Electricity Transmission plc's apparatus.

GUIDANCE

National Grid Electricity Transmission Network data

- The Network map for National Grid Electricity Transmission assets can be downloaded at the following link in GIS format.

<https://www.nationalgrid.com/uk/electricity-transmission/network-and-infrastructure/network-route-maps>

Buried Cables

- National Grid's underground cables are protected by a Deed of grant; Easement; Wayleave Agreement or the provisions of the New Roads and Street Works Act. Which provide full right of access to retain, maintain, repair and inspect our asset. Hence we require that no permanent structures are to be built over our cables or within the easement strip.
- Ground levels above our cables must not be altered in any way. Any alterations to the depth of our cables will subsequently alter the rating of the circuit and can compromise the reliability, efficiency and safety of our electricity network.
- The supplied detailed route records should not be taken as positive indication of the cable location. This can only be determined by digging trial holes. Where trial holes are dug the concrete and / or polymeric cable protection tiles must not be disturbed.
- The normal recommendation is to keep 2 metres clear either side of the 1 metre wide trench containing the AC cable.
- National Grid should be made aware of the works starting and may put in place a representative to monitor the works. The works should be carried out in accordance with the recommendations in document HS (G) 47 available from the HSE web site.
- The relocation of existing underground cables is not normally feasible on grounds of cost, operation and maintenance and environmental impact and we believe that successful development can take place in their vicinity.
- The information supplied is given in good faith and only as a guide to the location of our underground cables. The accuracy of this information cannot be guaranteed. The physical presence of such cables may also be evident from physical protection measures such as ducts or concrete protection tiles. The person(s) responsible for planning, supervising and carrying out work in proximity to our cable(s) shall be liable to us, as cable(s) owner, as well as to any third party who may be affected in any way by any loss or damage resulting from their failure to locate and avoid any damage to such a cable(s).
- The relevant guidance in relation to working safely near to existing underground cables is contained within the Health and Safety Executive's (www.hse.gov.uk) Guidance HS(G)47 "Avoiding Danger From Underground Services" and all relevant site staff should make sure that they are both aware of and understand this guidance.
- Our cables are normally buried to a depth of 0.9 metres to the protective covers but this depth can vary depending on location (bridges may have cables 100mm below surface level)..The specific cable route record drawings show further details along the route of the particular cable. The cable route drawings are attached to this letter for your information.
- Cables installed in cable tunnels, whilst less likely to be affected by surface or shallow works may be affected by activities such as piling.
- National Grid assets can be adversely affected by vibration and can provide guidance on the acceptable levels of vibration due to piling and other construction related operations in the vicinity of national grid assets
- Ground cover above our cables should not be reduced or increased without consultation with National Grid.

National Grid is a trading name for:

National Grid Electricity Transmission plc

Registered Office: 1-3 Strand, London WC2N 5EH

Registered in England and Wales, No 2366977

- If a landscaping scheme is proposed as part of the works, we request that no trees and shrubs are planted either directly above or within 3 metres of the existing underground cable, as ultimately the roots may grow to cause damage to the cable.

Cables Tunnels

- National Grid's underground cable tunnels are protected by the provisions of a Wayleave/Easement or the New Roads and Street Works Act. This provides full right of access to retain, maintain, repair and inspect our asset.
- Further information and guidance regarding National Grid Cable Tunnels is available on our website at <https://www.nationalgrid.com/uk/electricity-transmission/document/121061/download>
- National Grid requires that the clearances indicated in the guidance document linked above are maintained at all times. Should it be necessary to enter the exclusion zone discussion/ agreement with National Grid is required to ensure the integrity of their tunnel asset and the high voltage cables is not compromised.
- Ground levels above our cable tunnels must not be altered in any way without prior agreement with National Grid; any alterations to the depth of our tunnels can compromise its integrity which could have an adverse impact on the reliability, efficiency and safety of our electricity network.
- Any works which would create high levels of vibration such as piling would need to be assessed by National Grid to ensure it has limited impact on our cable tunnels. National Grid can advise on acceptable vibration limits.

Overhead Lines

- National Grid's Overhead Line/s is protected by a Deed of Easement/Wayleave Agreement which provides full right of access to retain, maintain, repair and inspect our asset.
- The submitted proposed design does not change after the date of this letter. Any design change that moves the proposal closer to National Grid Overhead Line Assets shall be submitted for assessment.
- Statutory electrical safety clearances shall be maintained at all times. National Grid recommends that no permanent structures are built directly beneath our overhead lines. These distances are set out in EN 43 – 8 Technical Specification for "Overhead Line Clearances Issue 5 (2019). To purchase & download EN 43 – 8 Technical Specification for "Overhead Line Clearances Issue 5 (2019) go to <https://www.ena-eng.org/ENA-Docs/>
- Any changes in ground levels which are proposed either beneath or in close proximity to our existing overhead lines would serve to reduce safety clearances. Safety clearances to existing overhead lines must be maintained in all circumstances.
- To view the Development Near Overhead Lines Document.
<https://www.nationalgridet.com/document/130626/download>
- To view the National Grid Third Party Guidance for working near National Grid Electricity Transmission equipment.
<https://www.nationalgridet.com/sites/et/files/documents/Working%20near%20electricity%20equipment.pdf>

- The relevant guidance in relation to working safely near to existing overhead lines is contained within the Health and Safety Executive's (www.hse.gov.uk) Guidance Note GS 6 "Avoidance of Danger from Overhead Electric Lines."
- If a landscaping scheme is proposed as part of the proposal, only slow and low growing species of trees and shrubs shall be planted beneath and adjacent to the existing overhead line to reduce the risk of growth to a height which compromises statutory safety clearances.
- Drilling or excavation works shall not be undertaken if they have the potential to disturb or adversely affect the foundations or "pillars of support" of our towers. These foundations extend beyond the base of the tower. Pillar of Support drawings shall be obtained using the contact details above.
- Due to the scale, bulk and cost of the transmission equipment required to operate at 275kV or 400kV we only support proposals for the relocation of existing high voltage overhead lines where such proposals directly facilitate a major development or infrastructure project of national importance which has been identified as such by government.
- To promote the successful development of sites crossed by existing overhead lines, and the creation of well-designed places, National Grid has produced 'Design guidelines for development near pylons and high voltage overhead power lines', which look at how to create high quality development near overhead lines and offer practical solutions which can assist in avoiding the unnecessary sterilisation of land in the vicinity of high voltage overhead lines.
- Further information regarding our undergrounding policy and development near transmission overhead lines is available on our website at: <https://www.nationalgridet.com/network-and-assets/planning-and-development>

Overview map of worksite



nationalgrid

**EXTREME CAUTION - HIGH VOLTAGE
RISK OF DEATH OR SERIOUS INJURY**

NationalGrid House
Warwick Technology Park
Gallows Hill
Warwick
CV34 6DA

AssetProtection@NationalGrid.com

Date Requested: 08/05/2023
Job Reference: 29406936
Site Location: 481058 382910
Requested by: Mr Ben Evans

Your Scheme/Reference: LM
203570/DK - 3

Dig Sites: Area: Line:

Underground Cables
 Overhead Lines
 Fibre Cables

IMPORTANT NOTICES
This plan shows those pipes owned by National Grid Electricity Transmission plc in its role as a Licensed Electricity Transporter (ET). Electricity cables owned by other ETs, or otherwise privately owned, may be present in this area. Information with regards to such cables should be obtained from the relevant owners. The information shown on this plan is given without warranty, the accuracy thereof cannot be guaranteed. Ancillary equipment such as cooling systems and communication cables are not shown but their presence should be anticipated. No liability of any kind whatsoever is accepted by National Grid Electricity Transmission plc or their agents, servants or contractors for any error or omission. Safe digging practices, in accordance with HS(G)47, must be used to verify and establish the actual position of cables and other apparatus on site before any mechanical plant is used. It is your responsibility to ensure that this information is provided to all persons (either direct labour or contractors) working for you on or near electricity apparatus. The information included on this plan should not be referred to beyond a period of 28 days from the date of issue.

National Grid Electricity Emergency Number: 0800 40 40 90
Available 24 hours, 7 days/week. Calls may be recorded and monitored

Scale: 1:12813 (When plotted at A4)

Crown Copyright © - Reproduced by permission of Ordnance Survey on behalf of HMSO. And database right 2023. All rights reserved. Ordnance Survey Licence number 0100059731.



Warning: PDF designed for A4 colour print only with no page scaling

nationalgrid



**EXTREME CAUTION - HIGH VOLTAGE
RISK OF DEATH OR SERIOUS INJURY**

Dig Sites Area: Line:

 Underground Cables

 Overhead Lines

 Fibre Cables

NationalGrid House
Warwick Technology Park
Gallows Hill
Warwick
CV34 6DA

AssetProtection@NationalGrid.com


Date Requested: 08/05/2023
Job Reference: 29406936
Site Location: 481058 382910
Requested by: Mr Ben Evans

Your Scheme/Reference: LM
203570/DK - 3

IMPORTANT NOTICES
This plan shows those pipes owned by National Grid Electricity Transmission plc in its role as a Licensed Electricity Transporter (ET). Electricity cables owned by other ETs, or otherwise privately owned, may be present in this area. Information with regards to such cables should be obtained from the relevant owners. The information shown on this plan is given without warranty, the accuracy thereof cannot be guaranteed. Ancillary equipment such as cooling systems and communication cables are not shown but their presence should be anticipated. No liability of any kind whatsoever is accepted by National Grid Electricity Transmission plc or their agents, servants or contractors for any error or omission. Safe digging practices, in accordance with HS(G)47, must be used to verify and establish the actual position of cables and other apparatus on site before any mechanical plant is used. It is your responsibility to ensure that this information is provided to all persons (either direct labour or contractors) working for you on or near electricity apparatus. The information included on this plan should not be referred to beyond a period of 28 days from the date of issue.

National Grid Electricity Emergency Number: 0800 40 40 90
Available 24 hours, 7 days/week. Calls may be recorded and monitored

Scale: 1:2500 (When plotted at A4)

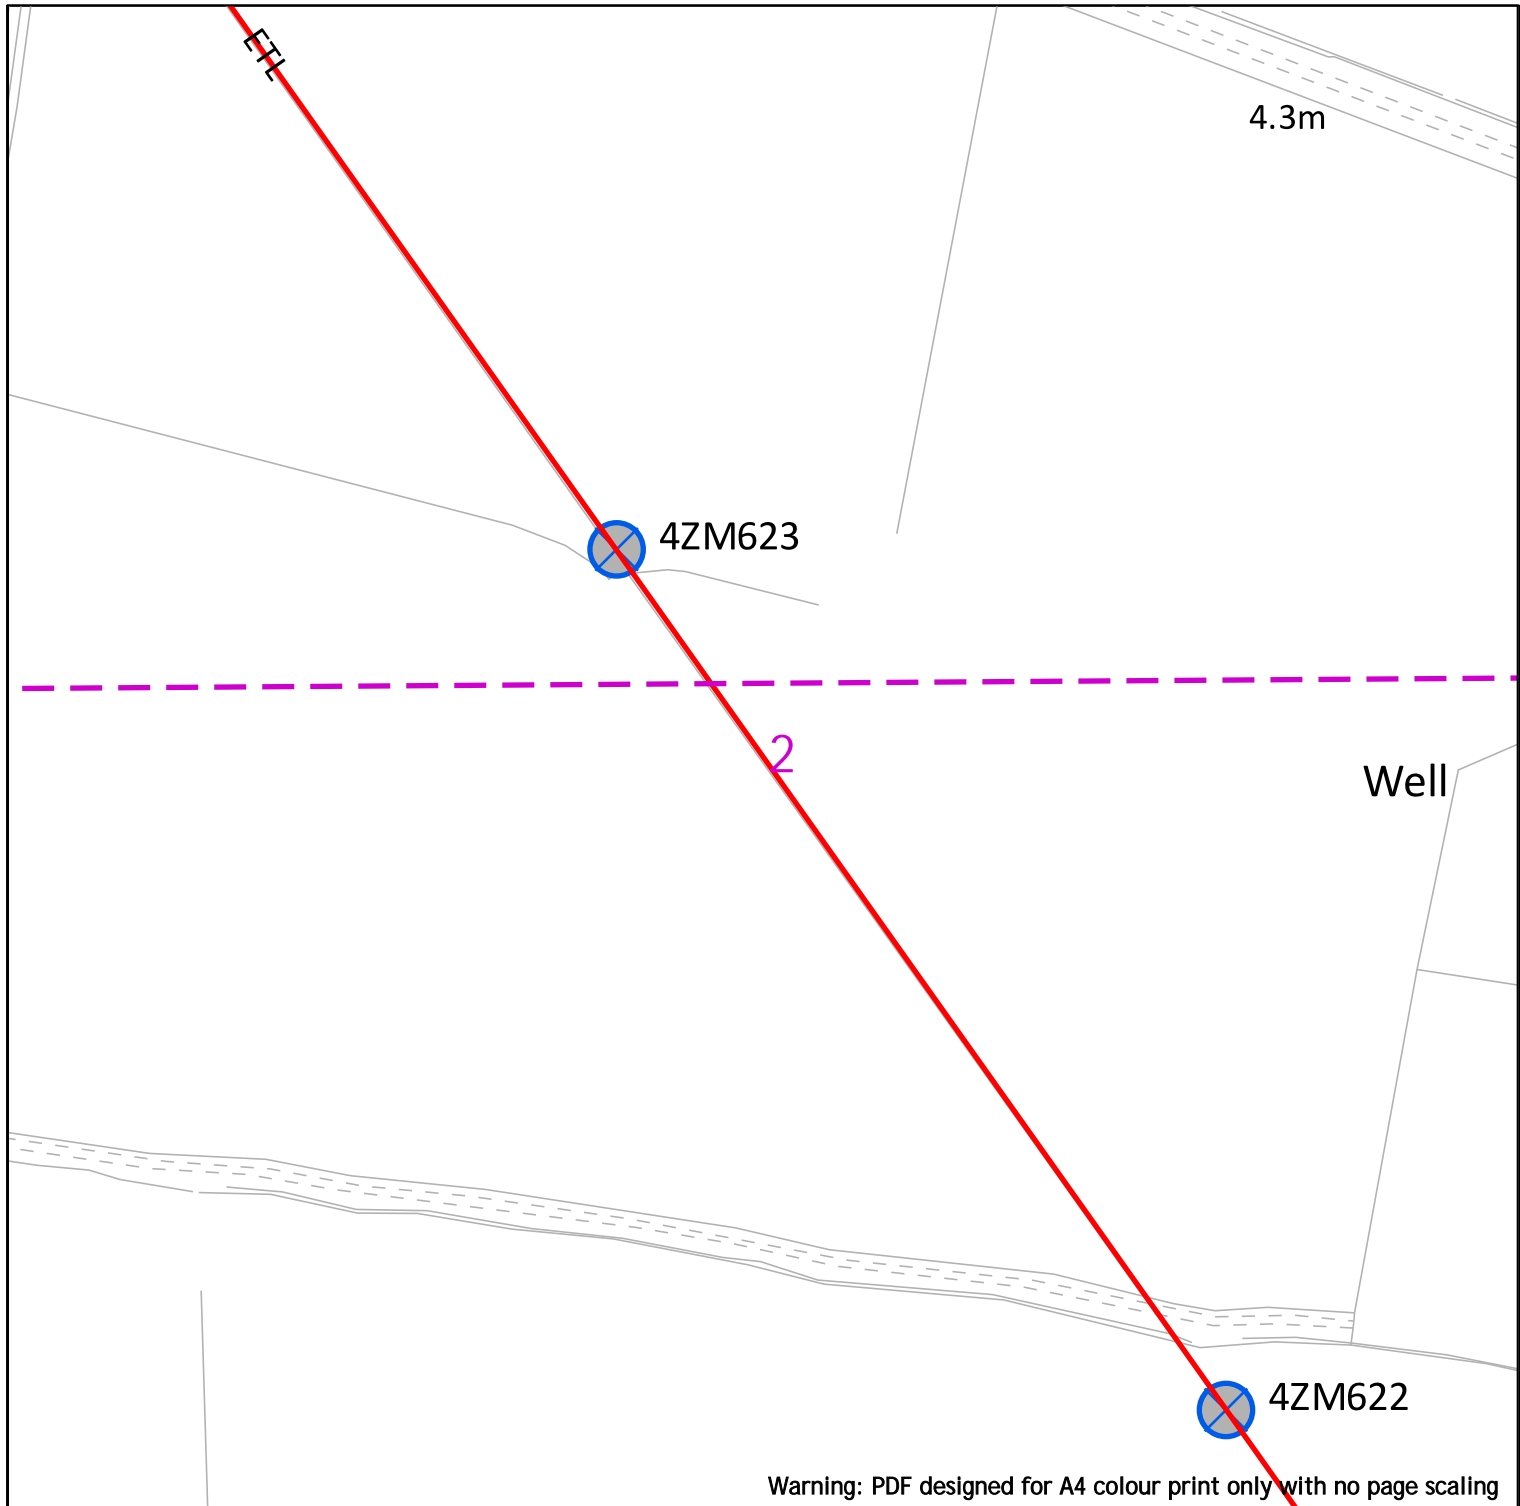

Warning: PDF designed for A4 colour print only with no page scaling

nationalgrid

0 200

**EXTREME CAUTION - HIGH VOLTAGE
RISK OF DEATH OR SERIOUS INJURY**

Dig Sites	Area:	Line:
	Underground Cables	
	Overhead Lines	
	Fibre Cables	

NationalGrid House
Warwick Technology Park
Gallows Hill
Warwick
CV34 6DA

AssetProtection@NationalGrid.com


Date Requested: 08/05/2023
Job Reference: 29406936
Site Location: 481058 382910
Requested by: Mr Ben Evans

Your Scheme/Reference: LM
203570/DK - 3

IMPORTANT NOTICES
This plan shows those pipes owned by National Grid Electricity Transmission plc in its role as a Licensed Electricity Transporter (ET). Electricity cables owned by other ETs, or otherwise privately owned, may be present in this area. Information with regards to such cables should be obtained from the relevant owners. The information shown on this plan is given without warranty, the accuracy thereof cannot be guaranteed. Ancillary equipment such as cooling systems and communication cables are not shown but their presence should be anticipated. No liability of any kind whatsoever is accepted by National Grid Electricity Transmission plc or their agents, servants or contractors for any error or omission. Safe digging practices, in accordance with HS(G)47, must be used to verify and establish the actual position of cables and other apparatus on site before any mechanical plant is used. It is your responsibility to ensure that this information is provided to all persons (either direct labour or contractors) working for you on or near electricity apparatus. The information included on this plan should not be referred to beyond a period of 28 days from the date of issue.

National Grid Electricity Emergency Number: 0800 40 40 90
Available 24 hours, 7 days/week. Calls may be recorded and monitored

Scale: 1:2500 (When plotted at A4)

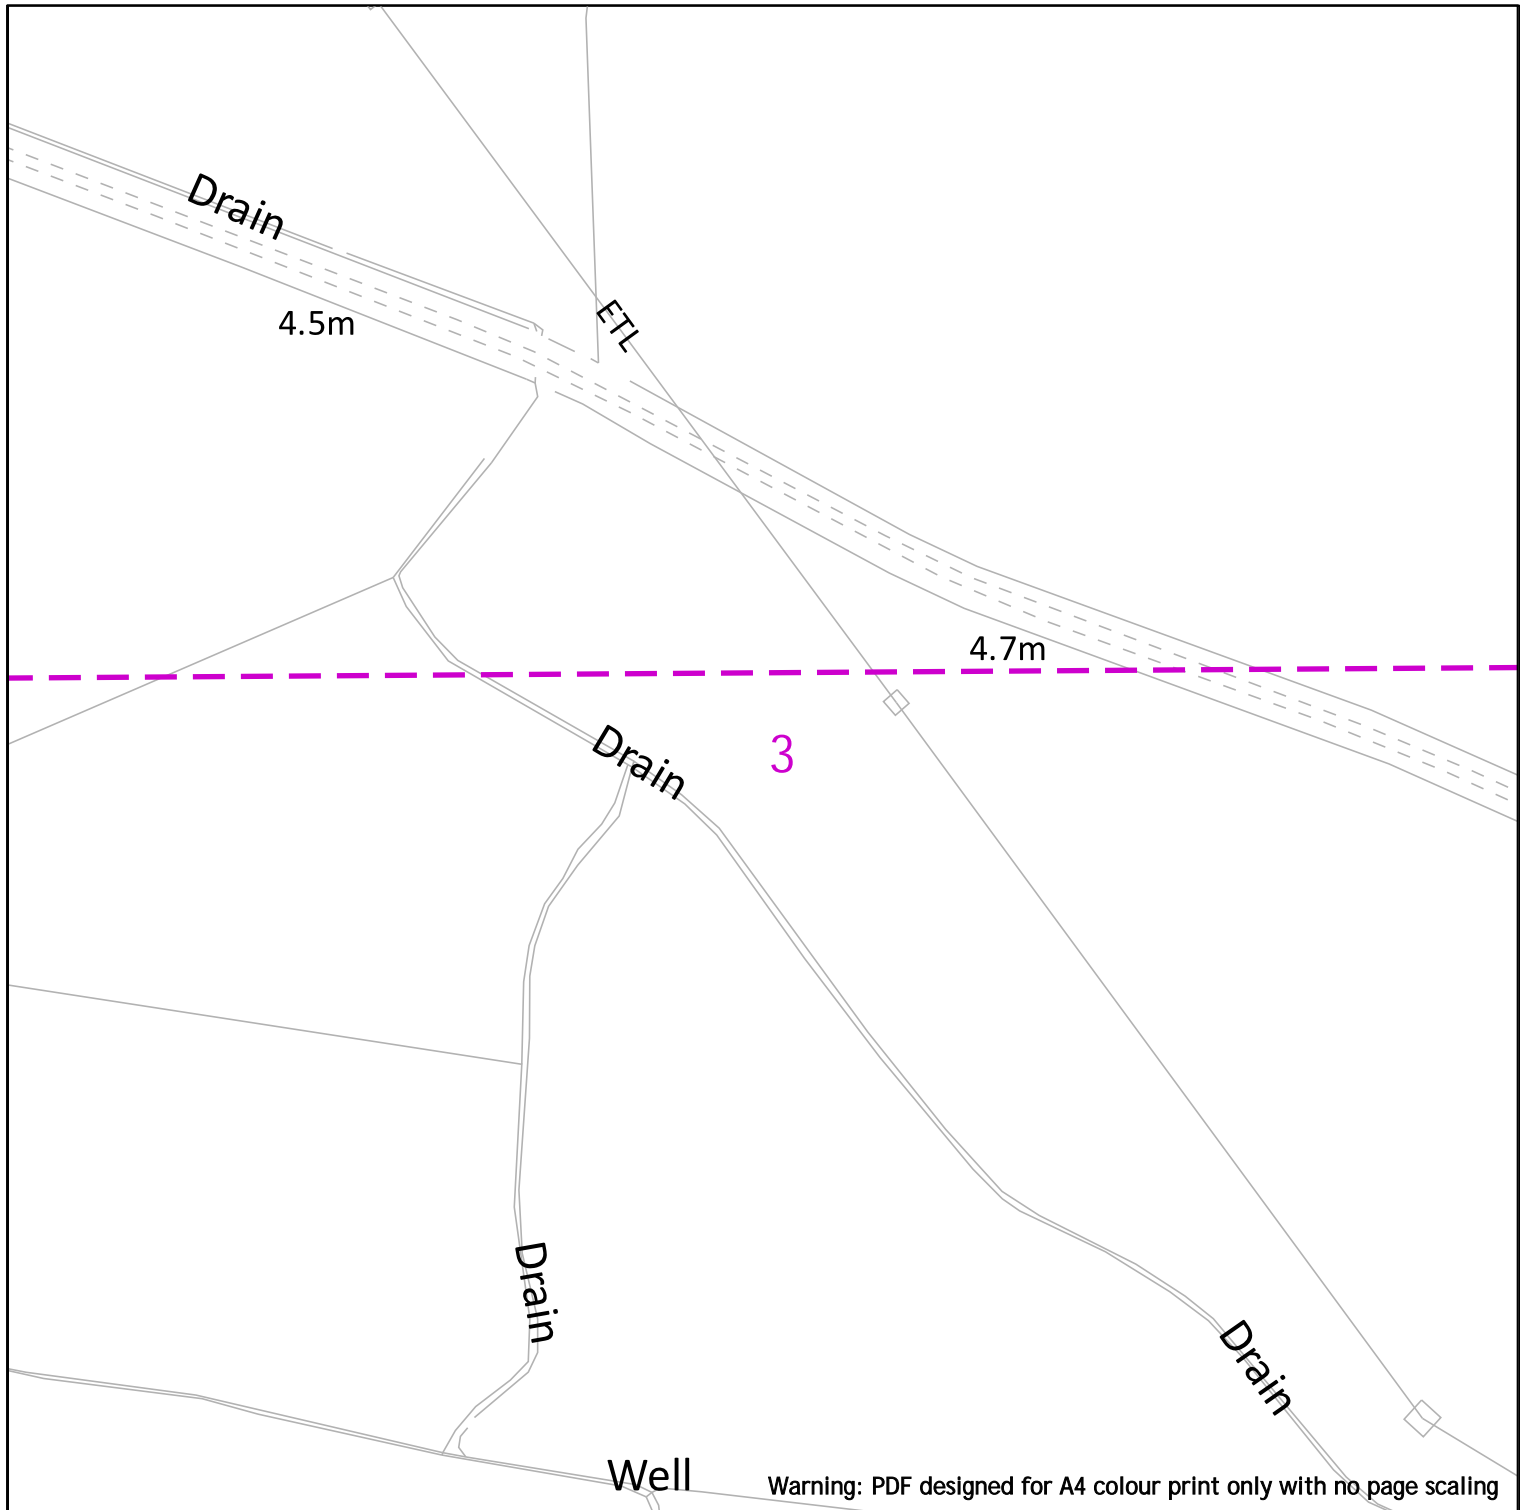

Warning: PDF designed for A4 colour print only with no page scaling

nationalgrid



**EXTREME CAUTION - HIGH VOLTAGE
RISK OF DEATH OR SERIOUS INJURY**

NationalGrid House
Warwick Technology Park
Gallows Hill
Warwick
CV34 6DA

AssetProtection@NationalGrid.com

Date Requested: 08/05/2023
Job Reference: 29406936
Site Location: 481058 382910
Requested by: Mr Ben Evans

Your Scheme/Reference: LM
203570/DK - 3

Scale: 1:2500 (When plotted at A4)

Dig Sites Area: Line:

 Underground Cables


 Overhead Lines

 Fibre Cables

IMPORTANT NOTICES

This plan shows those pipes owned by National Grid Electricity Transmission plc in its role as a Licensed Electricity Transporter (ET). Electricity cables owned by other ETs, or otherwise privately owned, may be present in this area. Information with regards to such cables should be obtained from the relevant owners. The information shown on this plan is given without warranty, the accuracy thereof cannot be guaranteed. Ancillary equipment such as cooling systems and communication cables are not shown but their presence should be anticipated. No liability of any kind whatsoever is accepted by National Grid Electricity Transmission plc or their agents, servants or contractors for any error or omission. Safe digging practices, in accordance with HS(G)47, must be used to verify and establish the actual position of cables and other apparatus on site before any mechanical plant is used. It is your responsibility to ensure that this information is provided to all persons (either direct labour or contractors) working for you on or near electricity apparatus. The information included on this plan should not be referred to beyond a period of 28 days from the date of issue.

National Grid Electricity Emergency Number: 0800 40 40 90
Available 24 hours, 7 days/week. Calls may be recorded and monitored

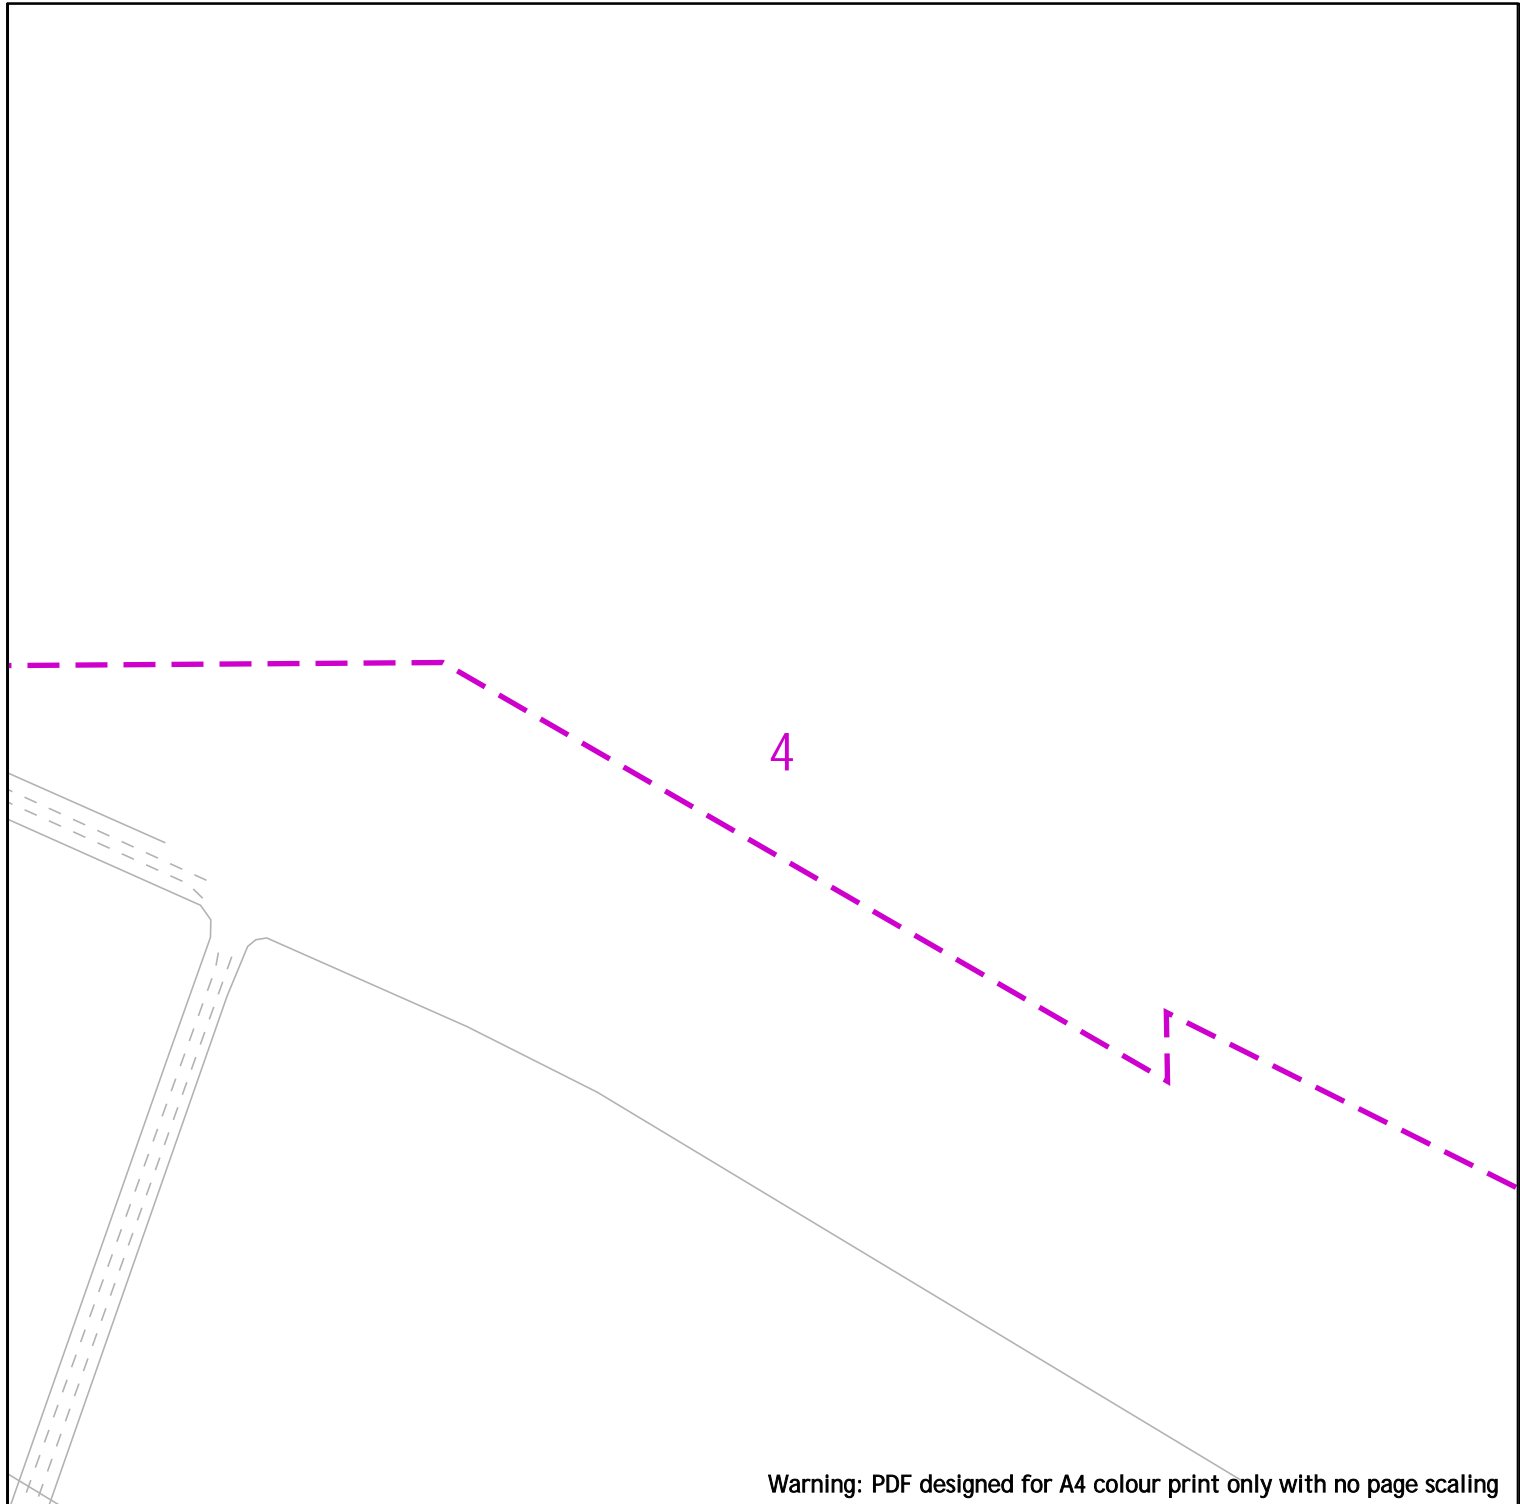

Warning: PDF designed for A4 colour print only with no page scaling



**EXTREME CAUTION - HIGH VOLTAGE
RISK OF DEATH OR SERIOUS INJURY**

Dig Sites	Area:		Line:	
				Underground Cables
				Overhead Lines
				Fibre Cables

NationalGrid House
Warwick Technology Park
Gallows Hill
Warwick
CV34 6DA

AssetProtection@NationalGrid.com

Date Requested: 08/05/2023
Job Reference: 29406936
Site Location: 481058 382910
Requested by: Mr Ben Evans

Your Scheme/Reference: LM
203570/DK - 3


IMPORTANT NOTICES

This plan shows those pipes owned by National Grid Electricity Transmission plc in its role as a Licensed Electricity Transporter (ET). Electricity cables owned by other ETs, or otherwise privately owned, may be present in this area. Information with regards to such cables should be obtained from the relevant owners. The information shown on this plan is given without warranty, the accuracy thereof cannot be guaranteed. Ancillary equipment such as cooling systems and communication cables are not shown but their presence should be anticipated. No liability of any kind whatsoever is accepted by National Grid Electricity Transmission plc or their agents, servants or contractors for any error or omission. Safe digging practices, in accordance with HS(G)47, must be used to verify and establish the actual position of cables and other apparatus on site before any mechanical plant is used. It is your responsibility to ensure that this information is provided to all persons (either direct labour or contractors) working for you on or near electricity apparatus. The information included on this plan should not be referred to beyond a period of 28 days from the date of issue.

National Grid Electricity Emergency Number: 0800 40 40 90
Available 24 hours, 7 days/week. Calls may be recorded and monitored

Scale: 1:2500 (When plotted at A4)

5

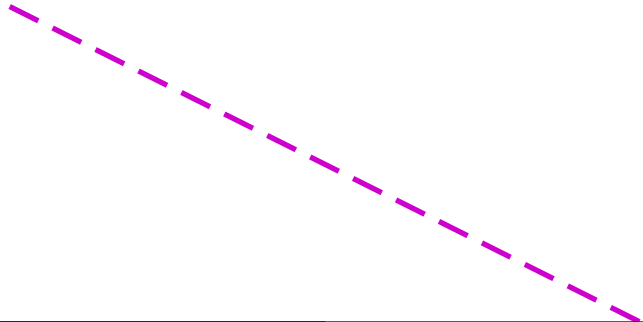


Warning: PDF designed for A4 colour print only with no page scaling



**EXTREME CAUTION - HIGH VOLTAGE
RISK OF DEATH OR SERIOUS INJURY**

NationalGrid House
Warwick Technology Park
Gallows Hill
Warwick
CV34 6DA

AssetProtection@NationalGrid.com

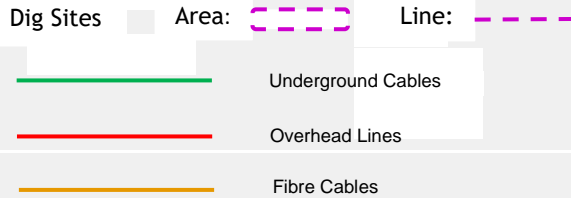

Date Requested: 08/05/2023
Job Reference: 29406936
Site Location: 481058 382910
Requested by: Mr Ben Evans


Your Scheme/Reference: LM
203570/DK - 3

IMPORTANT NOTICES

This plan shows those pipes owned by National Grid Electricity Transmission plc in its role as a Licensed Electricity Transporter (ET). Electricity cables owned by other ETs, or otherwise privately owned, may be present in this area. Information with regards to such cables should be obtained from the relevant owners. The information shown on this plan is given without warranty, the accuracy thereof cannot be guaranteed. Ancillary equipment such as cooling systems and communication cables are not shown but their presence should be anticipated. No liability of any kind whatsoever is accepted by National Grid Electricity Transmission plc or their agents, servants or contractors for any error or omission. Safe digging practices, in accordance with HS(G)47, must be used to verify and establish the actual position of cables and other apparatus on site before any mechanical plant is used. It is your responsibility to ensure that this information is provided to all persons (either direct labour or contractors) working for you on or near electricity apparatus. The information included on this plan should not be referred to beyond a period of 28 days from the date of issue.

National Grid Electricity Emergency Number: 0800 40 40 90
Available 24 hours, 7 days/week. Calls may be recorded and monitored

Scale: 1:2500 (When plotted at A4)

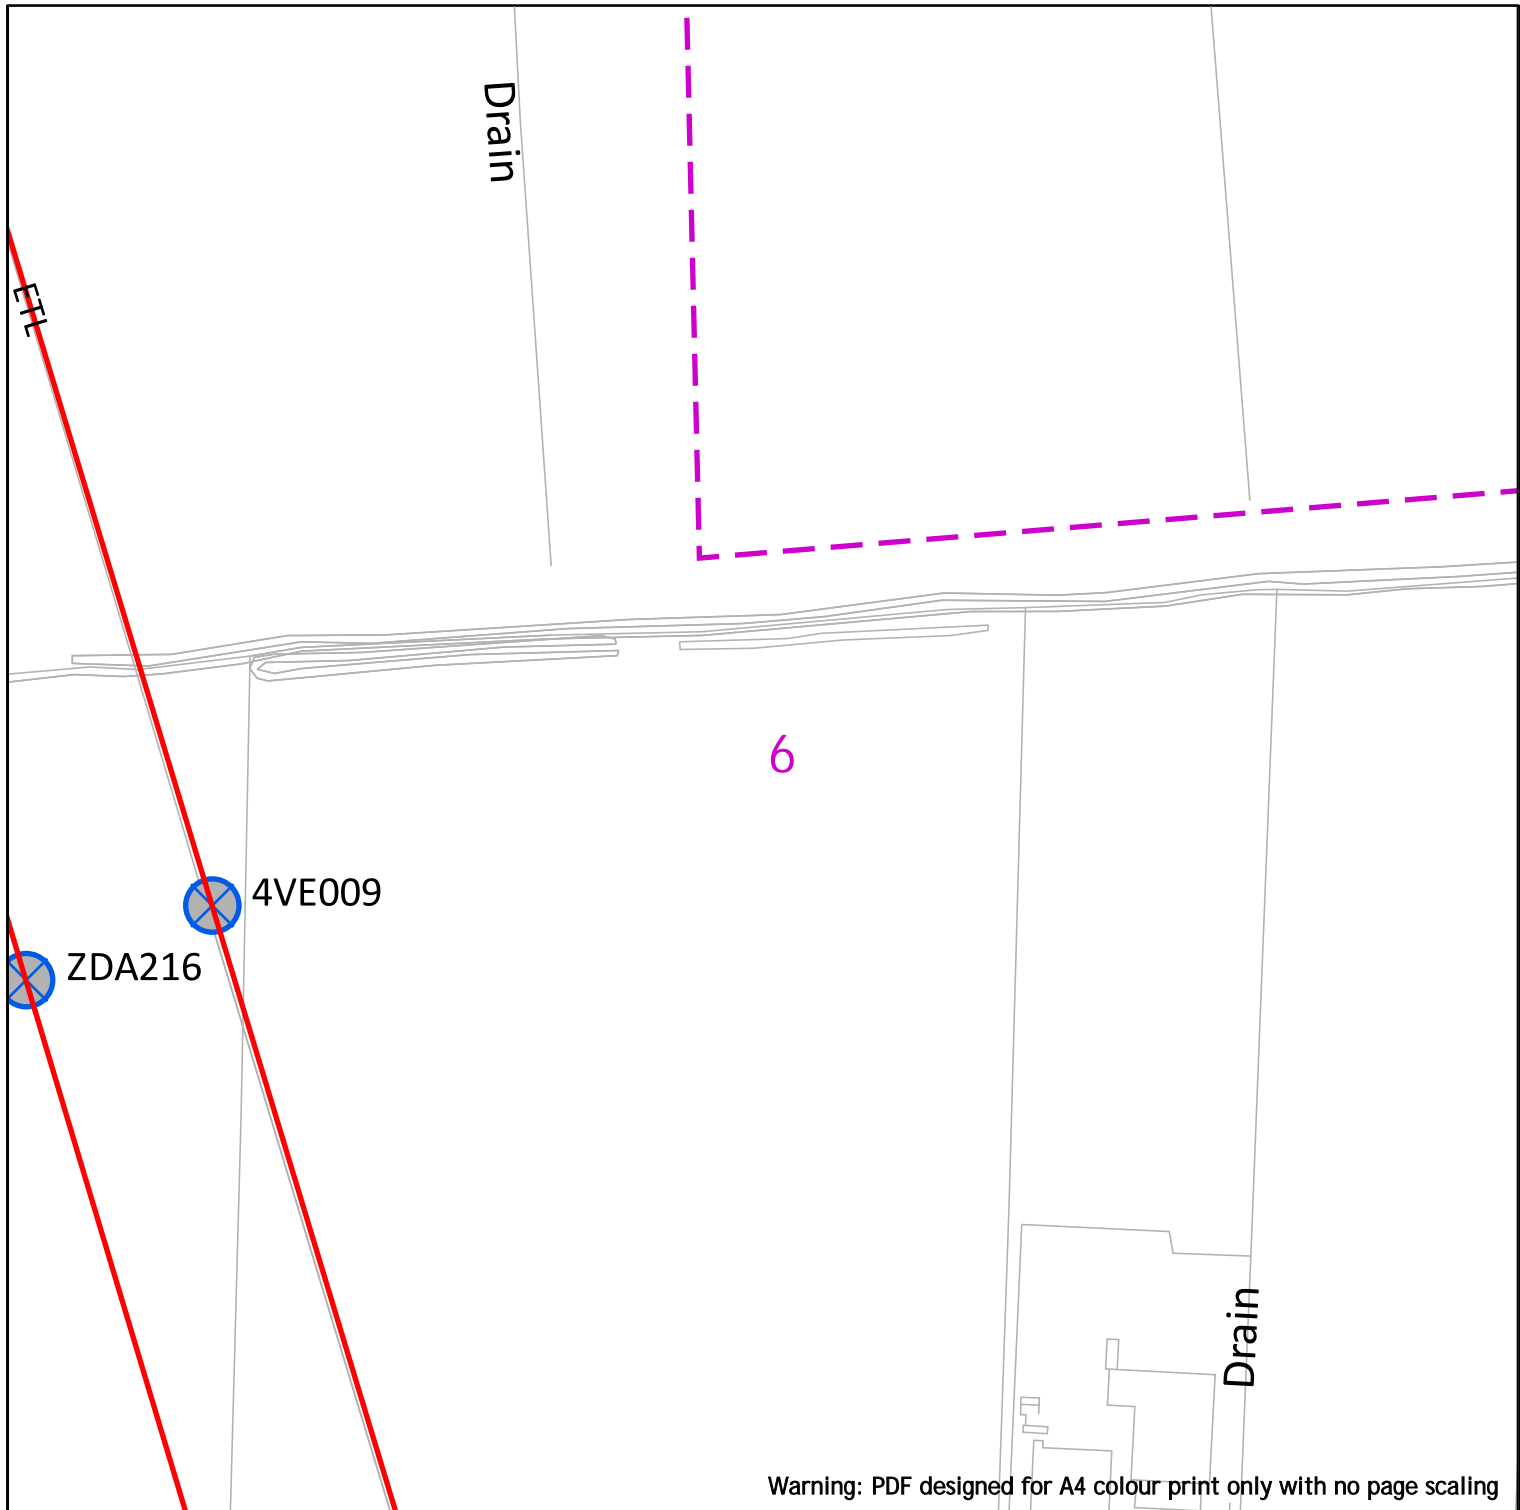

Warning: PDF designed for A4 colour print only with no page scaling

nationalgrid



**EXTREME CAUTION - HIGH VOLTAGE
RISK OF DEATH OR SERIOUS INJURY**

Dig Sites Area: Line:

 Underground Cables

 Overhead Lines

 Fibre Cables

NationalGrid House
Warwick Technology Park
Gallows Hill
Warwick
CV34 6DA

AssetProtection@NationalGrid.com


Date Requested: 08/05/2023
Job Reference: 29406936
Site Location: 481058 382910
Requested by: Mr Ben Evans

Your Scheme/Reference: LM
203570/DK - 3

IMPORTANT NOTICES
This plan shows those pipes owned by National Grid Electricity Transmission plc in its role as a Licensed Electricity Transporter (ET). Electricity cables owned by other ETs, or otherwise privately owned, may be present in this area. Information with regards to such cables should be obtained from the relevant owners. The information shown on this plan is given without warranty, the accuracy thereof cannot be guaranteed. Ancillary equipment such as cooling systems and communication cables are not shown but their presence should be anticipated. No liability of any kind whatsoever is accepted by National Grid Electricity Transmission plc or their agents, servants or contractors for any error or omission. Safe digging practices, in accordance with HS(G)47, must be used to verify and establish the actual position of cables and other apparatus on site before any mechanical plant is used. It is your responsibility to ensure that this information is provided to all persons (either direct labour or contractors) working for you on or near electricity apparatus. The information included on this plan should not be referred to beyond a period of 28 days from the date of issue.

National Grid Electricity Emergency Number: 0800 40 40 90
Available 24 hours, 7 days/week. Calls may be recorded and monitored

Scale: 1:2500 (When plotted at A4)

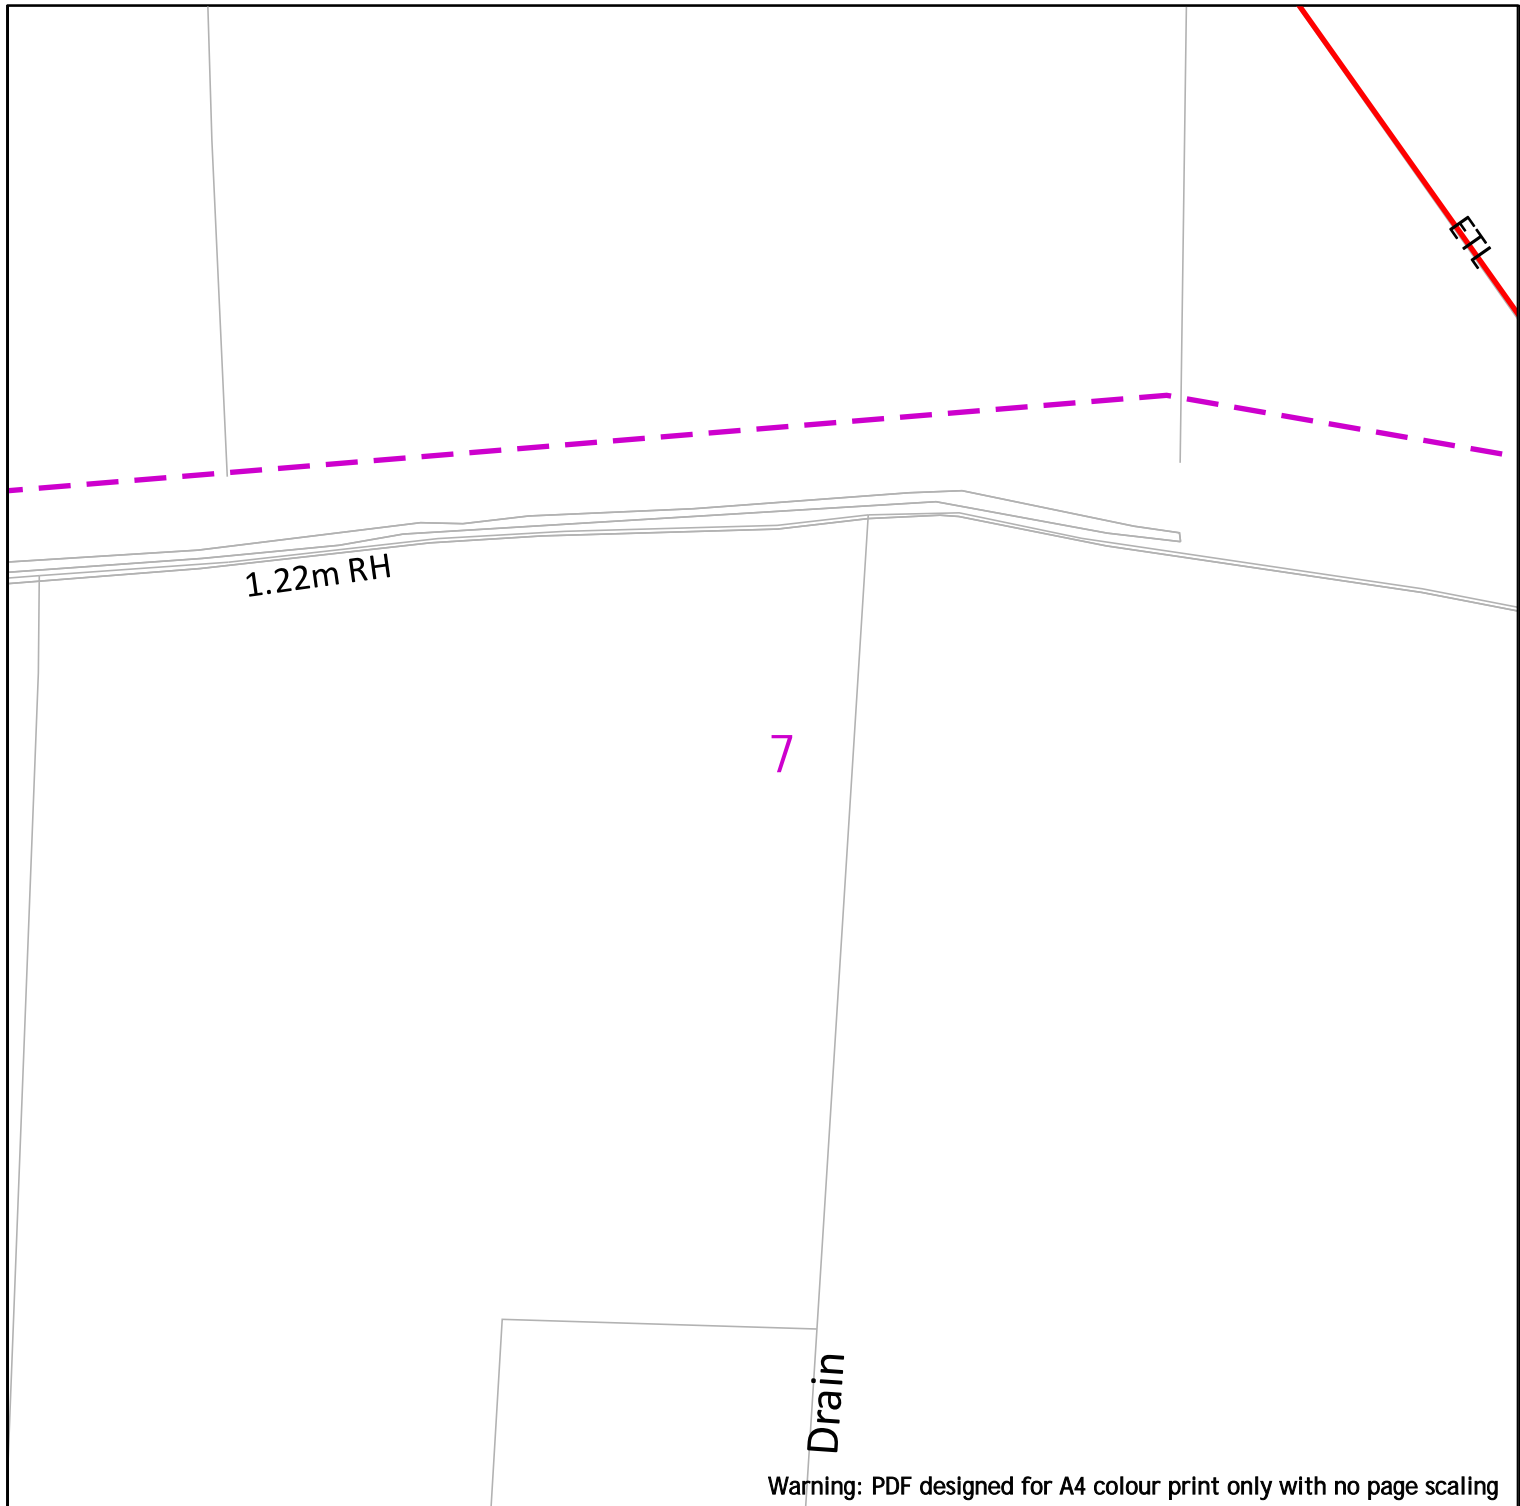

Warning: PDF designed for A4 colour print only with no page scaling

nationalgrid

0 200

**EXTREME CAUTION - HIGH VOLTAGE
RISK OF DEATH OR SERIOUS INJURY**

Dig Sites	Area:	Line:
	Underground Cables	
	Overhead Lines	
	Fibre Cables	

NationalGrid House
Warwick Technology Park
Gallows Hill
Warwick
CV34 6DA
AssetProtection@NationalGrid.com

Date Requested: 08/05/2023
Job Reference: 29406936
Site Location: 481058 382910
Requested by: Mr Ben Evans
Your Scheme/Reference: LM
203570/DK - 3


IMPORTANT NOTICES

This plan shows those pipes owned by National Grid Electricity Transmission plc in its role as a Licensed Electricity Transporter (ET). Electricity cables owned by other ETs, or otherwise privately owned, may be present in this area. Information with regards to such cables should be obtained from the relevant owners. The information shown on this plan is given without warranty, the accuracy thereof cannot be guaranteed. Ancillary equipment such as cooling systems and communication cables are not shown but their presence should be anticipated. No liability of any kind whatsoever is accepted by National Grid Electricity Transmission plc or their agents, servants or contractors for any error or omission. Safe digging practices, in accordance with HS(G)47, must be used to verify and establish the actual position of cables and other apparatus on site before any mechanical plant is used. It is your responsibility to ensure that this information is provided to all persons (either direct labour or contractors) working for you on or near electricity apparatus. The information included on this plan should not be referred to beyond a period of 28 days from the date of issue.

National Grid Electricity Emergency Number: 0800 40 40 90
Available 24 hours, 7 days/week. Calls may be recorded and monitored

Scale: 1:2500 (When plotted at A4)

Crown Copyright © - Reproduced by permission of Ordnance Survey on behalf of HMSO. And database right 2023. All rights reserved. Ordnance Survey Licence number 0100059731.

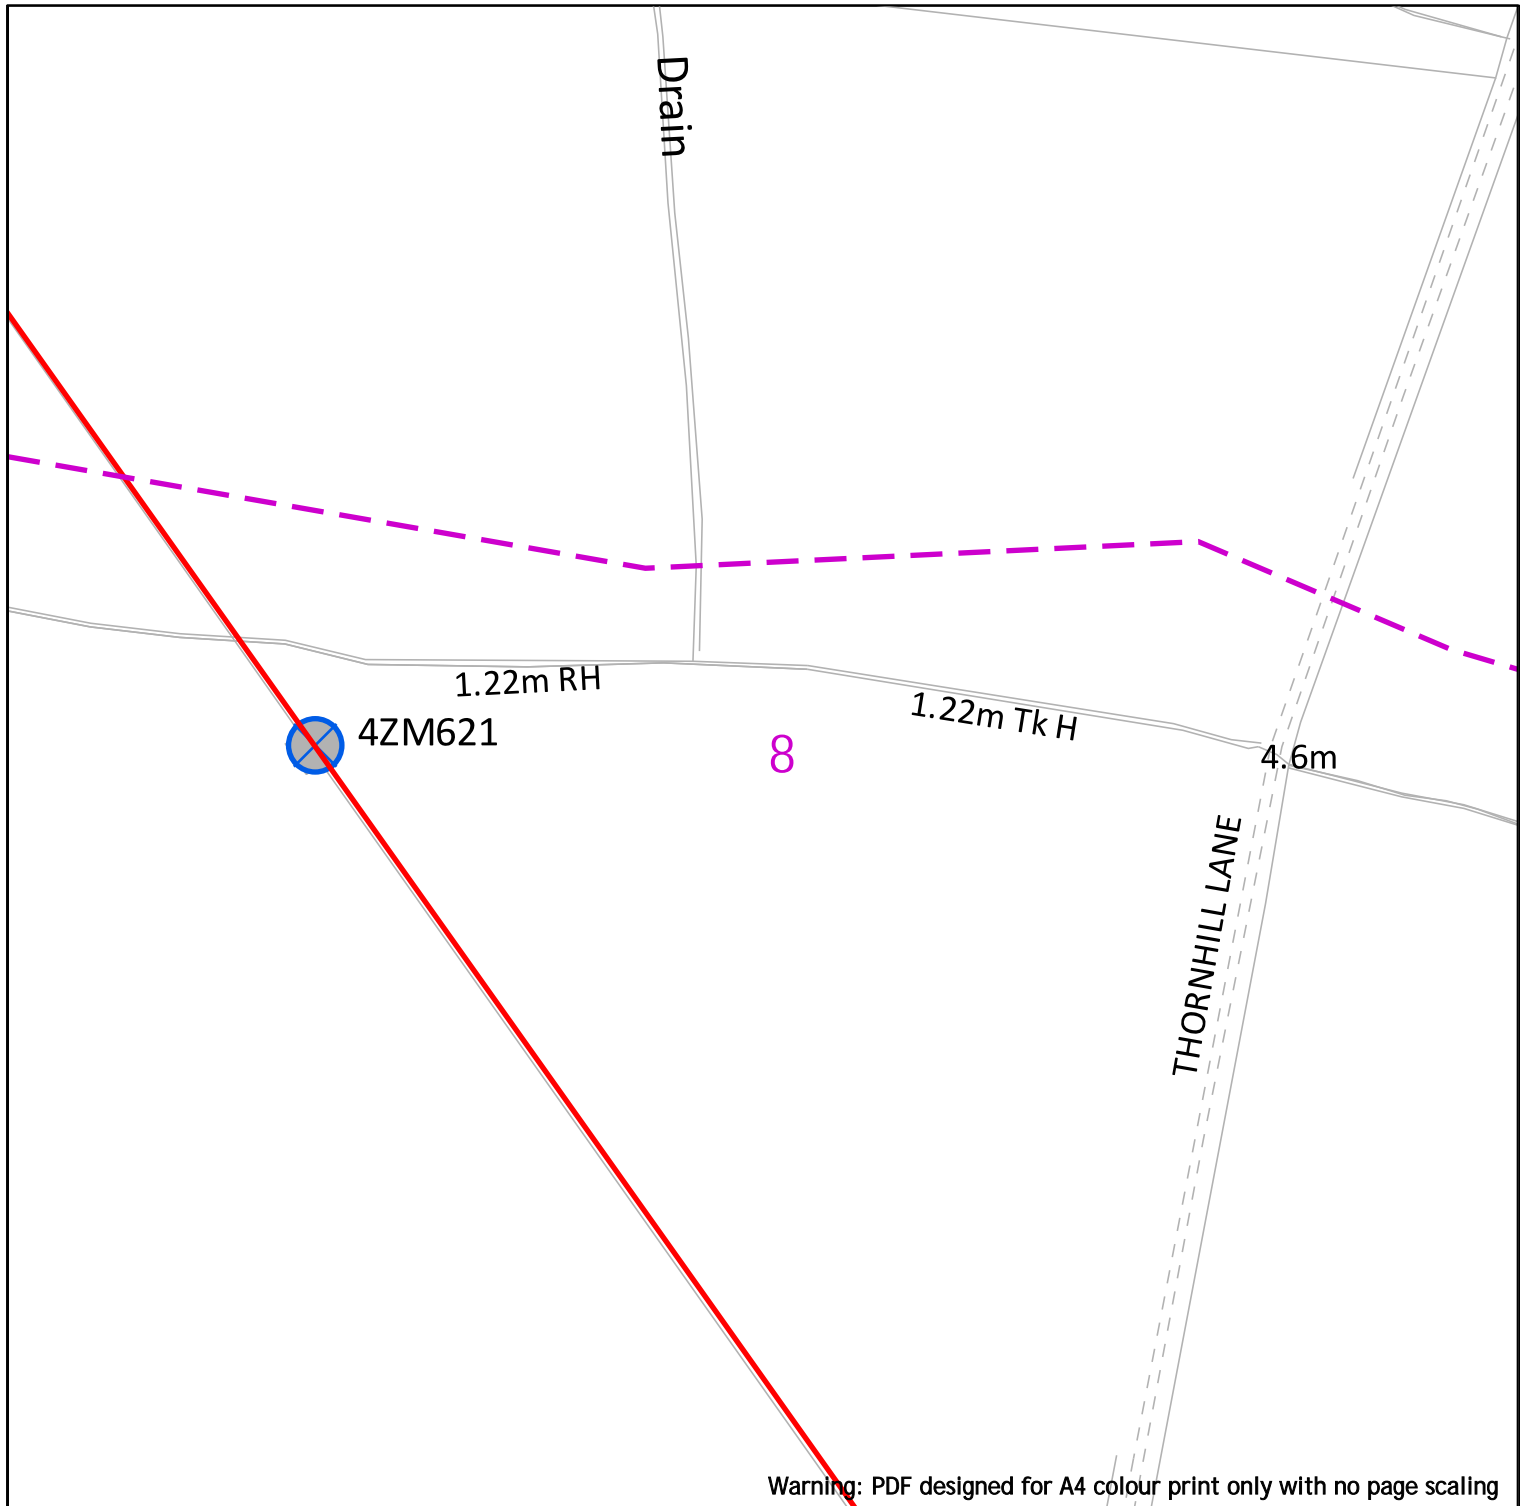

Warning: PDF designed for A4 colour print only with no page scaling

nationalgrid



**EXTREME CAUTION - HIGH VOLTAGE
RISK OF DEATH OR SERIOUS INJURY**

Dig Sites	Area:	Line:
	Underground Cables	
	Overhead Lines	
	Fibre Cables	

NationalGrid House
Warwick Technology Park
Gallows Hill
Warwick
CV34 6DA

AssetProtection@NationalGrid.com

Date Requested: 08/05/2023
Job Reference: 29406936
Site Location: 481058 382910
Requested by: Mr Ben Evans


Your Scheme/Reference: LM
203570/DK - 3

IMPORTANT NOTICES

This plan shows those pipes owned by National Grid Electricity Transmission plc in its role as a Licensed Electricity Transporter (ET). Electricity cables owned by other ETs, or otherwise privately owned, may be present in this area. Information with regards to such cables should be obtained from the relevant owners. The information shown on this plan is given without warranty, the accuracy thereof cannot be guaranteed. Ancillary equipment such as cooling systems and communication cables are not shown but their presence should be anticipated. No liability of any kind whatsoever is accepted by National Grid Electricity Transmission plc or their agents, servants or contractors for any error or omission. Safe digging practices, in accordance with HS(G)47, must be used to verify and establish the actual position of cables and other apparatus on site before any mechanical plant is used. It is your responsibility to ensure that this information is provided to all persons (either direct labour or contractors) working for you on or near electricity apparatus. The information included on this plan should not be referred to beyond a period of 28 days from the date of issue.

National Grid Electricity Emergency Number: 0800 40 40 90
Available 24 hours, 7 days/week. Calls may be recorded and monitored

Scale: 1:2500 (When plotted at A4)

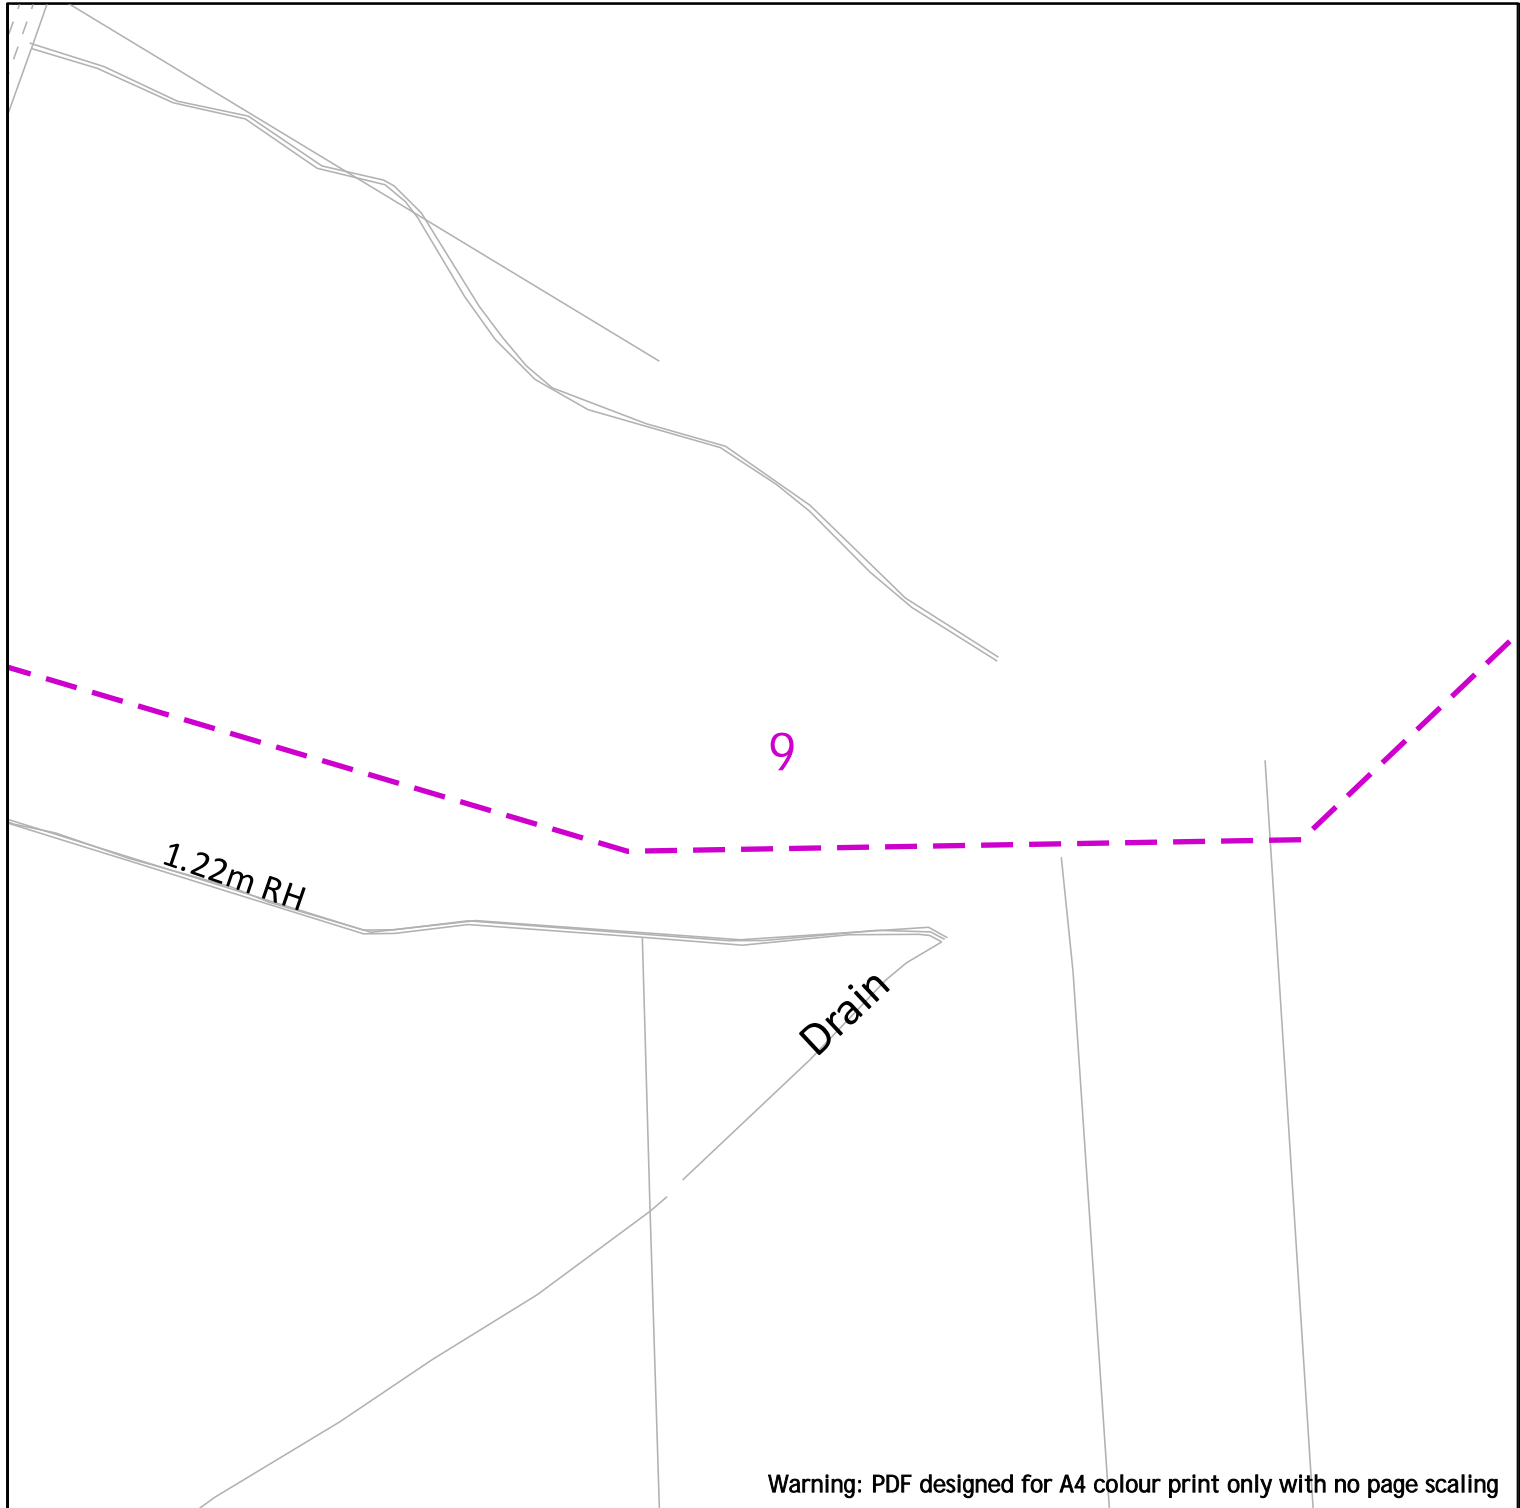

Warning: PDF designed for A4 colour print only with no page scaling

nationalgrid



**EXTREME CAUTION - HIGH VOLTAGE
RISK OF DEATH OR SERIOUS INJURY**

Dig Sites Area: Line:

 Underground Cables

 Overhead Lines

 Fibre Cables

NationalGrid House
Warwick Technology Park
Gallows Hill
Warwick
CV34 6DA

AssetProtection@NationalGrid.com


Date Requested: 08/05/2023
Job Reference: 29406936
Site Location: 481058 382910
Requested by: Mr Ben Evans

Your Scheme/Reference: LM
203570/DK - 3

IMPORTANT NOTICES
This plan shows those pipes owned by National Grid Electricity Transmission plc in its role as a Licensed Electricity Transporter (ET). Electricity cables owned by other ETs, or otherwise privately owned, may be present in this area. Information with regards to such cables should be obtained from the relevant owners. The information shown on this plan is given without warranty, the accuracy thereof cannot be guaranteed. Ancillary equipment such as cooling systems and communication cables are not shown but their presence should be anticipated. No liability of any kind whatsoever is accepted by National Grid Electricity Transmission plc or their agents, servants or contractors for any error or omission. Safe digging practices, in accordance with HS(G)47, must be used to verify and establish the actual position of cables and other apparatus on site before any mechanical plant is used. It is your responsibility to ensure that this information is provided to all persons (either direct labour or contractors) working for you on or near electricity apparatus. The information included on this plan should not be referred to beyond a period of 28 days from the date of issue.

National Grid Electricity Emergency Number: 0800 40 40 90
Available 24 hours, 7 days/week. Calls may be recorded and monitored

Scale: 1:2500 (When plotted at A4)

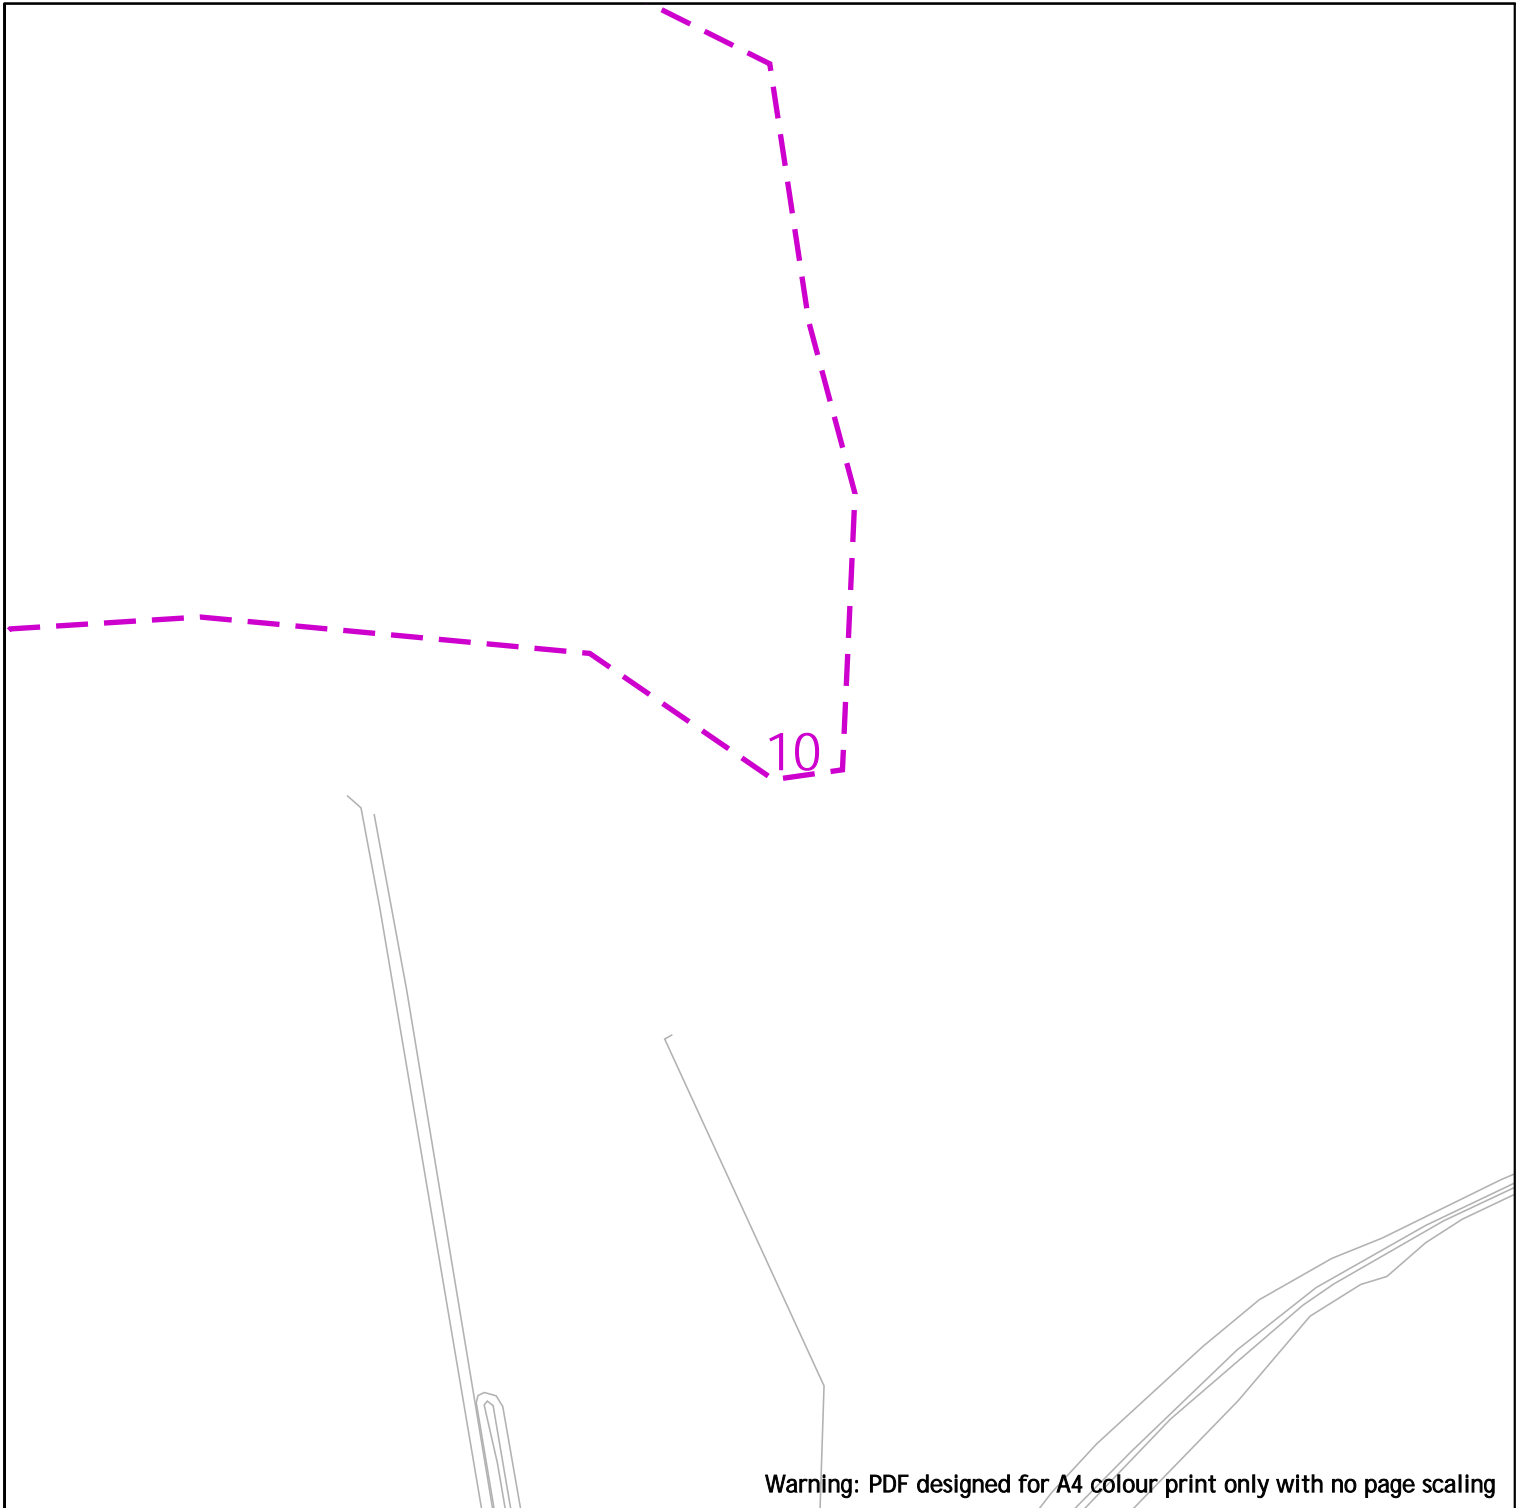

Warning: PDF designed for A4 colour print only with no page scaling

nationalgrid



**EXTREME CAUTION - HIGH VOLTAGE
RISK OF DEATH OR SERIOUS INJURY**

Dig Sites	Area:	Line:
	Underground Cables	
	Overhead Lines	
	Fibre Cables	

NationalGrid House
Warwick Technology Park
Gallows Hill
Warwick
CV34 6DA

AssetProtection@NationalGrid.com

Date Requested: 08/05/2023
Job Reference: 29406936
Site Location: 481058 382910
Requested by: Mr Ben Evans

Your Scheme/Reference: LM
203570/DK - 3

IMPORTANT NOTICES

This plan shows those pipes owned by National Grid Electricity Transmission plc in its role as a Licensed Electricity Transporter (ET). Electricity cables owned by other ETs, or otherwise privately owned, may be present in this area. Information with regards to such cables should be obtained from the relevant owners. The information shown on this plan is given without warranty, the accuracy thereof cannot be guaranteed. Ancillary equipment such as cooling systems and communication cables are not shown but their presence should be anticipated. No liability of any kind whatsoever is accepted by National Grid Electricity Transmission plc or their agents, servants or contractors for any error or omission. Safe digging practices, in accordance with HS(G)47, must be used to verify and establish the actual position of cables and other apparatus on site before any mechanical plant is used. It is your responsibility to ensure that this information is provided to all persons (either direct labour or contractors) working for you on or near electricity apparatus. The information included on this plan should not be referred to beyond a period of 28 days from the date of issue.

National Grid Electricity Emergency Number: 0800 40 40 90
Available 24 hours, 7 days/week. Calls may be recorded and monitored

Scale: 1:2500 (When plotted at A4)

ENQUIRY SUMMARY

Received Date

08/05/2023 9:33

Work Start Date

30/05/2023

Your Reference

LM 203570/DK - 3

Location

Centre Point: 481058 382910

X Extent:

Y Extent:

Postcode: DN220HB

Map Options

Paper Size: A4

Orientation: PORTRAIT

Scale: 1:2500

Real World Extents: 2060m x 561m

Enquirer Details

Organisation Name: Atkins - Utility Solutions

Contact Name: Ben Evans

Email Address: searches.utilitysolutions@atkinglobal.com

Telephone: 01454662086

Address: The Hub, 500 Park Avenue, Aztec West, , Bristol, BS32 4RZ

Enquiry Type

Initial Enquiry

Activity Type

Utility Works

Work Types

Single excavations site (deeper than 1.5m)

Notes/Works Description (if supplied)

Site Contact Name (if supplied)

Site Contact Number (if supplied)

Our Ref: 29406937 LM 203570/DK - 4

Monday, 08 May 2023

Ben Evans
The Hub, 500 Park Avenue, Aztec West

Bristol
BS32 4RZ

National Grid House
Warwick Technology Park
Gallows Hill, Warwick
CV34 6DA

Electricity Emergency Number:
0800 40 40 90*
*Available 24 hours, 7 days/week.
Calls may be recorded and monitored.
www.nationalgrid.com

Asset Protection
Electricity Transmission
National Grid
Warwick
Email: assetprotection@nationalgrid.com

National Grid Electricity – Small Scale Works - Initial Enquiry

Dear Sir/ Madam,

An assessment has been carried out with respect to National Grid Electricity Transmission plc's apparatus and the proposed work location. Based on the location entered into the system for assessment the area has been found to be within the High Risk zone from National Grid Electricity Transmission plc's apparatus and **Must Not Proceed** without further assessment by Asset Protection.

As you have entered an **Initial enquiry** please could you ensure that you submit a **Planned works enquiry** in Line Search (LSBUD) with a works description (including how deep you are excavating) at least **4 weeks** ahead of your scheduled start date. Once you receive the LSBUD Planned works response please submit plans to following email address assetprotection@nationalgrid.com including the LSBUD reference number.

If you require any additional information at this stage such as Overhead Line profile drawings please contact assetprotection@nationalgrid.com including the LSBUD reference number.

Failure to submit a Planned enquiry and requested information will result in a delay to your works being assessed.

Please do not commence with any works until you have been contacted by National Grid.

Please note this response and any attached map(s) are valid for 28 days from the date of this letter.

Yours sincerely,

Asset Protection

Your Responsibilities and Obligations

The "Assessment" Section below outlines the detailed requirements that must be followed when planning or undertaking your activities at this location.

It is your responsibility to ensure that the information you have submitted is accurate and that all relevant documents including links are provided to all persons (either direct labour or contractors) working for you near National Grid Electricity Transmission plc's apparatus, e.g. as contained within the Construction (Design and Management) Regulations.

This assessment solely relates to National Grid Electricity Transmission plc (NGET)

This assessment does **NOT** include:

- National Grid's legal interest (easements or wayleaves) in the land which restricts activity in proximity to National Grid's assets in private land. You must obtain details of any such restrictions from the landowner in the first instance and if in doubt contact Asset Protection.
- Recently installed apparatus
- National Grid Gas plc.
- Apparatus owned by other organisations, e.g. Cadent, other gas distribution operators, local electricity companies, other utilities, etc.

It is **YOUR** responsibility to take into account whether the items listed above may be present and if they could be affected by your proposed activities.

This communication does not constitute any formal agreement or consent for any proposed development work; either generally or with regard to National Grid Electricity Transmission plc easements or wayleaves nor any planning or building regulations applications.

National Grid Electricity Transmission plc or their agents, servants or contractors do not accept any liability for any losses arising under or in connection with this information. This limit on liability applies to all and any claims in contract, tort (including negligence), misrepresentation (excluding fraudulent misrepresentation), breach of statutory duty or otherwise. This limit on liability does not exclude or restrict liability where prohibited by the law nor does it supersede the express terms of any related agreements.

If you require further assistance please contact the Asset Protection team via e-mail (assetprotection@nationalgrid.com) or via the contact details at the top of this response.

Assessment

Affected Apparatus

The apparatus that has been identified as being in the vicinity of your proposed works is:

- Electricity Transmission Overhead Line apparatus.
- Electricity Transmission Underground Cables and associated apparatus.

Requirements

Over Head Lines

BEFORE carrying out any work you must:

(N.B. Works only to be undertaken when contact has been made and response received from Asset Protection)

- Carefully read these requirements including the attached guidance documents and maps showing the location of apparatus.
- Contact the landowner and ensure any proposed works in private land do not infringe National Grid Electricity Transmission plc's legal rights (i.e. easements or wayleaves). If the works are in the road or footpath the relevant local authority should be contacted.
- Ensure that all persons, including direct labour and contractors, working for you on or near National Grid Electricity Transmission plc's apparatus follow the requirements of the HSE Guidance Notes HSG47 - 'Avoiding Danger from Underground Services' and GS6 – 'Avoidance of danger from overhead electric power lines'. This guidance can be downloaded free of charge at www.hse.gov.uk
- In line with the above guidance, verify and establish the actual position of mains, pipes, cables, services and other apparatus on site before any activities are undertaken.

DURING any work you must:

- Comply with all guidance for working within the vicinity of overhead lines as detailed within the guidance documents listed below.
- Comply with all guidance relating to general activities and any specific guidance for each asset type as specified in the Guidance Section below.
- Ensure that access to National Grid Electricity Transmission plc's apparatus is maintained at all times.
- Prevent the placing of heavy construction plant, equipment, materials or the passage of heavy vehicles over National Grid Electricity Transmission plc's apparatus unless specifically agreed with National Grid Electricity Transmission plc's apparatus in advance.
- Exercise extreme caution if slab (mass) concrete is encountered during excavation works as this maybe protecting or supporting National Grid Electricity Transmission plc's apparatus.

Underground Cables

BEFORE carrying out any work you must:

(N.B. Works only to be undertaken when contact has been made and response received from Asset Protection)

- Refer to the attached cable profile drawings which provide details about the location of National Grid's high voltage underground cables.
- Carefully read these requirements including the attached guidance documents and maps showing the location of apparatus.
- Contact the landowner and ensure any proposed works in private land do not infringe National Grid Electricity Transmission plc's legal rights (i.e. easements or wayleaves). If the works are in the road or footpath the relevant local authority should be contacted.
- Ensure that all persons, including direct labour and contractors, working for you on or near infringe National Grid Electricity Transmission plc's follow the requirements of the HSE Guidance Notes HS(G)47 "Avoiding Danger From Underground Services". This guidance can be downloaded free of charge at www.hse.gov.uk
- In line with the above guidance, verify and establish the actual position of mains, pipes, cables,

National Grid is a trading name for:

National Grid Electricity Transmission plc

Registered Office: 1-3 Strand, London WC2N 5EH

Registered in England and Wales, No 2366977

services and other apparatus on site before any activities are undertaken.

DURING any work you must:

- Comply with all guidance for working within the vicinity of Electricity Underground Cables as detailed within the guidance documents listed below.
- Comply with all guidance relating to general activities and any specific guidance for each asset type as specified in the Guidance Section below.
- Ensure that access to National Grid Electricity Transmission plc's apparatus is maintained at all times.
- Prevent the placing of heavy construction plant, equipment, materials or the passage of heavy vehicles over National Grid Electricity Transmission plc's apparatus unless specifically agreed with National Grid Electricity Transmission plc's in advance.
- Exercise extreme caution if slab (mass) concrete is encountered during excavation works as this maybe protecting or supporting National Grid Electricity Transmission plc's apparatus.

GUIDANCE

National Grid is a trading name for:
National Grid Electricity Transmission plc
Registered Office: 1-3 Strand, London WC2N 5EH
Registered in England and Wales, No 2366977

National Grid Electricity Transmission Network data

- The Network map for National Grid Electricity Transmission assets can be downloaded at the following link in GIS format.

<https://www.nationalgrid.com/uk/electricity-transmission/network-and-infrastructure/network-route-maps>

Buried Cables

- National Grid's underground cables are protected by a Deed of grant; Easement; Wayleave Agreement or the provisions of the New Roads and Street Works Act. Which provide full right of access to retain, maintain, repair and inspect our asset. Hence we require that no permanent structures are to be built over our cables or within the easement strip.
- Ground levels above our cables must not be altered in any way. Any alterations to the depth of our cables will subsequently alter the rating of the circuit and can compromise the reliability, efficiency and safety of our electricity network.
- The supplied detailed route records should not be taken as positive indication of the cable location. This can only be determined by digging trial holes. Where trial holes are dug the concrete and / or polymeric cable protection tiles must not be disturbed.
- The normal recommendation is to keep 2 metres clear either side of the 1 metre wide trench containing the AC cable.
- National Grid should be made aware of the works starting and may put in place a representative to monitor the works. The works should be carried out in accordance with the recommendations in document HS (G) 47 available from the HSE web site.
- The relocation of existing underground cables is not normally feasible on grounds of cost, operation and maintenance and environmental impact and we believe that successful development can take place in their vicinity.
- The information supplied is given in good faith and only as a guide to the location of our underground cables. The accuracy of this information cannot be guaranteed. The physical presence of such cables may also be evident from physical protection measures such as ducts or concrete protection tiles. The person(s) responsible for planning, supervising and carrying out work in proximity to our cable(s) shall be liable to us, as cable(s) owner, as well as to any third party who may be affected in any way by any loss or damage resulting from their failure to locate and avoid any damage to such a cable(s).
- The relevant guidance in relation to working safely near to existing underground cables is contained within the Health and Safety Executive's (www.hse.gov.uk) Guidance HS(G)47 "Avoiding Danger From Underground Services" and all relevant site staff should make sure that they are both aware of and understand this guidance.
- Our cables are normally buried to a depth of 0.9 metres to the protective covers but this depth can vary depending on location (bridges may have cables 100mm below surface level)..The specific cable route record drawings show further details along the route of the particular cable. The cable route drawings are attached to this letter for your information.
- Cables installed in cable tunnels, whilst less likely to be affected by surface or shallow works may be affected by activities such as piling.
- National Grid assets can be adversely affected by vibration and can provide guidance on the acceptable levels of vibration due to piling and other construction related operations in the vicinity of national grid assets
- Ground cover above our cables should not be reduced or increased without consultation with National Grid.

- If a landscaping scheme is proposed as part of the works, we request that no trees and shrubs are planted either directly above or within 3 metres of the existing underground cable, as ultimately the roots may grow to cause damage to the cable.


Cables Tunnels

- National Grid's underground cable tunnels are protected by the provisions of a Wayleave/Easement or the New Roads and Street Works Act. This provides full right of access to retain, maintain, repair and inspect our asset.
- Further information and guidance regarding National Grid Cable Tunnels is available on our website at <https://www.nationalgrid.com/uk/electricity-transmission/document/121061/download>
- National Grid requires that the clearances indicated in the guidance document linked above are maintained at all times. Should it be necessary to enter the exclusion zone discussion/ agreement with National Grid is required to ensure the integrity of their tunnel asset and the high voltage cables is not compromised.
- Ground levels above our cable tunnels must not be altered in any way without prior agreement with National Grid; any alterations to the depth of our tunnels can compromise its integrity which could have an adverse impact on the reliability, efficiency and safety of our electricity network.
- Any works which would create high levels of vibration such as piling would need to be assessed by National Grid to ensure it has limited impact on our cable tunnels. National Grid can advise on acceptable vibration limits.

Overhead Lines

- National Grid's Overhead Line/s is protected by a Deed of Easement/Wayleave Agreement which provides full right of access to retain, maintain, repair and inspect our asset.
- The submitted proposed design does not change after the date of this letter. Any design change that moves the proposal closer to National Grid Overhead Line Assets shall be submitted for assessment.
- Statutory electrical safety clearances shall be maintained at all times. National Grid recommends that no permanent structures are built directly beneath our overhead lines. These distances are set out in EN 43 – 8 Technical Specification for "Overhead Line Clearances Issue 5 (2019). To purchase & download EN 43 – 8 Technical Specification for "Overhead Line Clearances Issue 5 (2019) go to <https://www.ena-eng.org/ENA-Docs/>
- Any changes in ground levels which are proposed either beneath or in close proximity to our existing overhead lines would serve to reduce safety clearances. Safety clearances to existing overhead lines must be maintained in all circumstances.
- To view the Development Near Overhead Lines Document.
<https://www.nationalgridet.com/document/130626/download>
- To view the National Grid Third Party Guidance for working near National Grid Electricity Transmission equipment.
<https://www.nationalgridet.com/sites/et/files/documents/Working%20near%20electricity%20equipment.pdf>
- The relevant guidance in relation to working safely near to existing overhead lines is contained within the Health and Safety Executive's (www.hse.gov.uk) Guidance Note GS 6 "Avoidance of Danger from Overhead Electric Lines."

- If a landscaping scheme is proposed as part of the proposal, only slow and low growing species of trees and shrubs shall be planted beneath and adjacent to the existing overhead line to reduce the risk of growth to a height which compromises statutory safety clearances.
- Drilling or excavation works shall not be undertaken if they have the potential to disturb or adversely affect the foundations or “pillars of support” of our towers. These foundations extend beyond the base of the tower. Pillar of Support drawings shall be obtained using the contact details above.
- Due to the scale, bulk and cost of the transmission equipment required to operate at 275kV or 400kV we only support proposals for the relocation of existing high voltage overhead lines where such proposals directly facilitate a major development or infrastructure project of national importance which has been identified as such by government.
- To promote the successful development of sites crossed by existing overhead lines, and the creation of well-designed places, National Grid has produced ‘Design guidelines for development near pylons and high voltage overhead power lines’, which look at how to create high quality development near overhead lines and offer practical solutions which can assist in avoiding the unnecessary sterilisation of land in the vicinity of high voltage overhead lines.
- Further information regarding our undergrounding policy and development near transmission overhead lines is available on our website at: <https://www.nationalgridet.com/network-and-assets/planning-and-development>

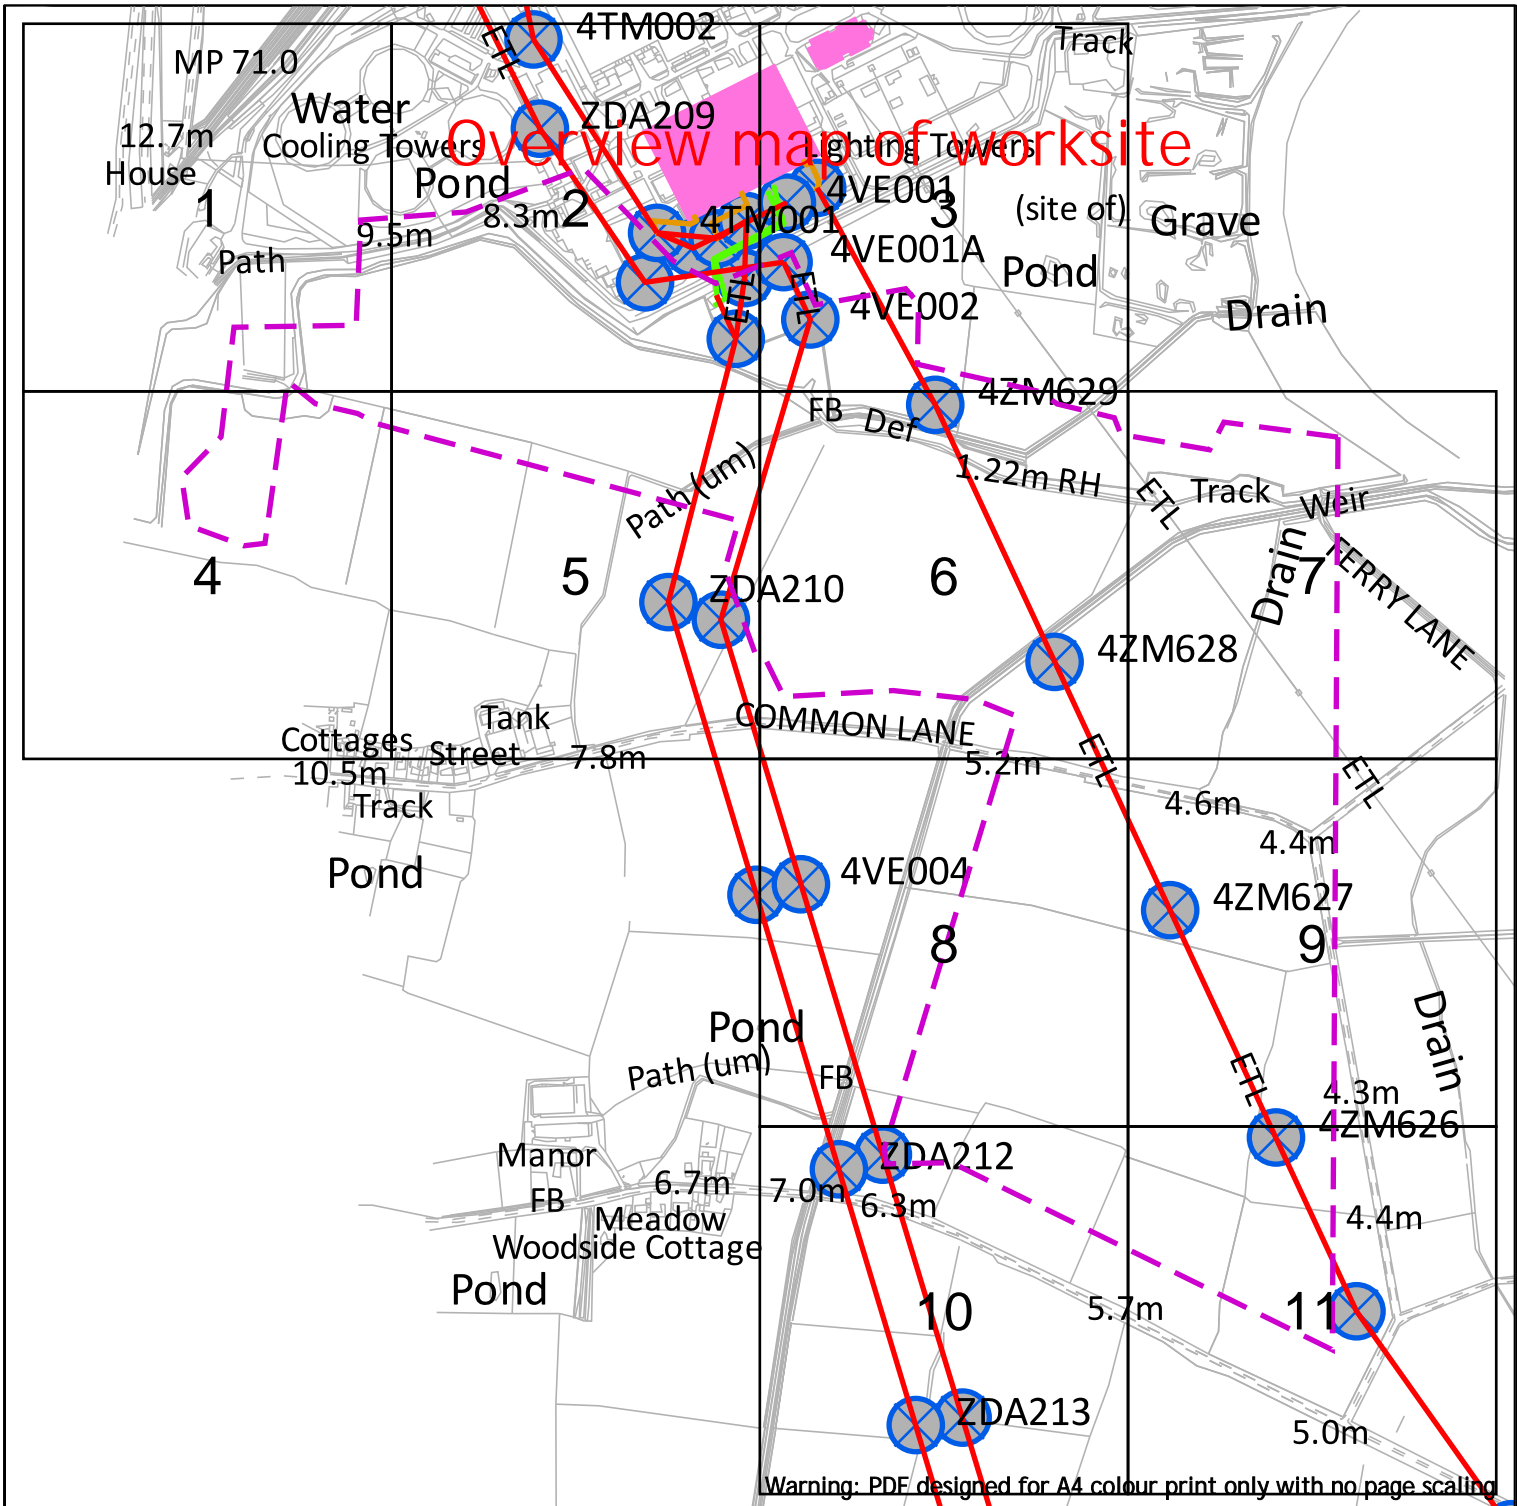

Warning: PDF designed for A4 colour print only with no page scaling

nationalgrid

**EXTREME CAUTION - HIGH VOLTAGE
RISK OF DEATH OR SERIOUS INJURY**


NationalGrid House
Warwick Technology Park
Gallows Hill
Warwick
CV34 6DA

AssetProtection@NationalGrid.com

Date Requested: 08/05/2023
Job Reference: 29406937
Site Location: 479891 384296
Requested by: Mr Ben Evans

Your Scheme/Reference: LM
203570/DK - 4


Scale: 1:10250 (When plotted at A4)

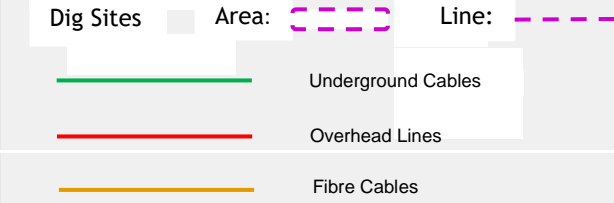

IMPORTANT NOTICES

This plan shows those pipes owned by National Grid Electricity Transmission plc in its role as a Licensed Electricity Transporter (ET). Electricity cables owned by other ETs, or otherwise privately owned, may be present in this area. Information with regards to such cables should be obtained from the relevant owners. The information shown on this plan is given without warranty, the accuracy thereof cannot be guaranteed. Ancillary equipment such as cooling systems and communication cables are not shown but their presence should be anticipated. No liability of any kind whatsoever is accepted by National Grid Electricity Transmission plc or their agents, servants or contractors for any error or omission. Safe digging practices, in accordance with HS(G)47, must be used to verify and establish the actual position of cables and other apparatus on site before any mechanical plant is used. It is your responsibility to ensure that this information is provided to all persons (either direct labour or contractors) working for you on or near electricity apparatus. The information included on this plan should not be referred to beyond a period of 28 days from the date of issue.

National Grid Electricity Emergency Number: 0800 40 40 90
Available 24 hours, 7 days/week. Calls may be recorded and monitored

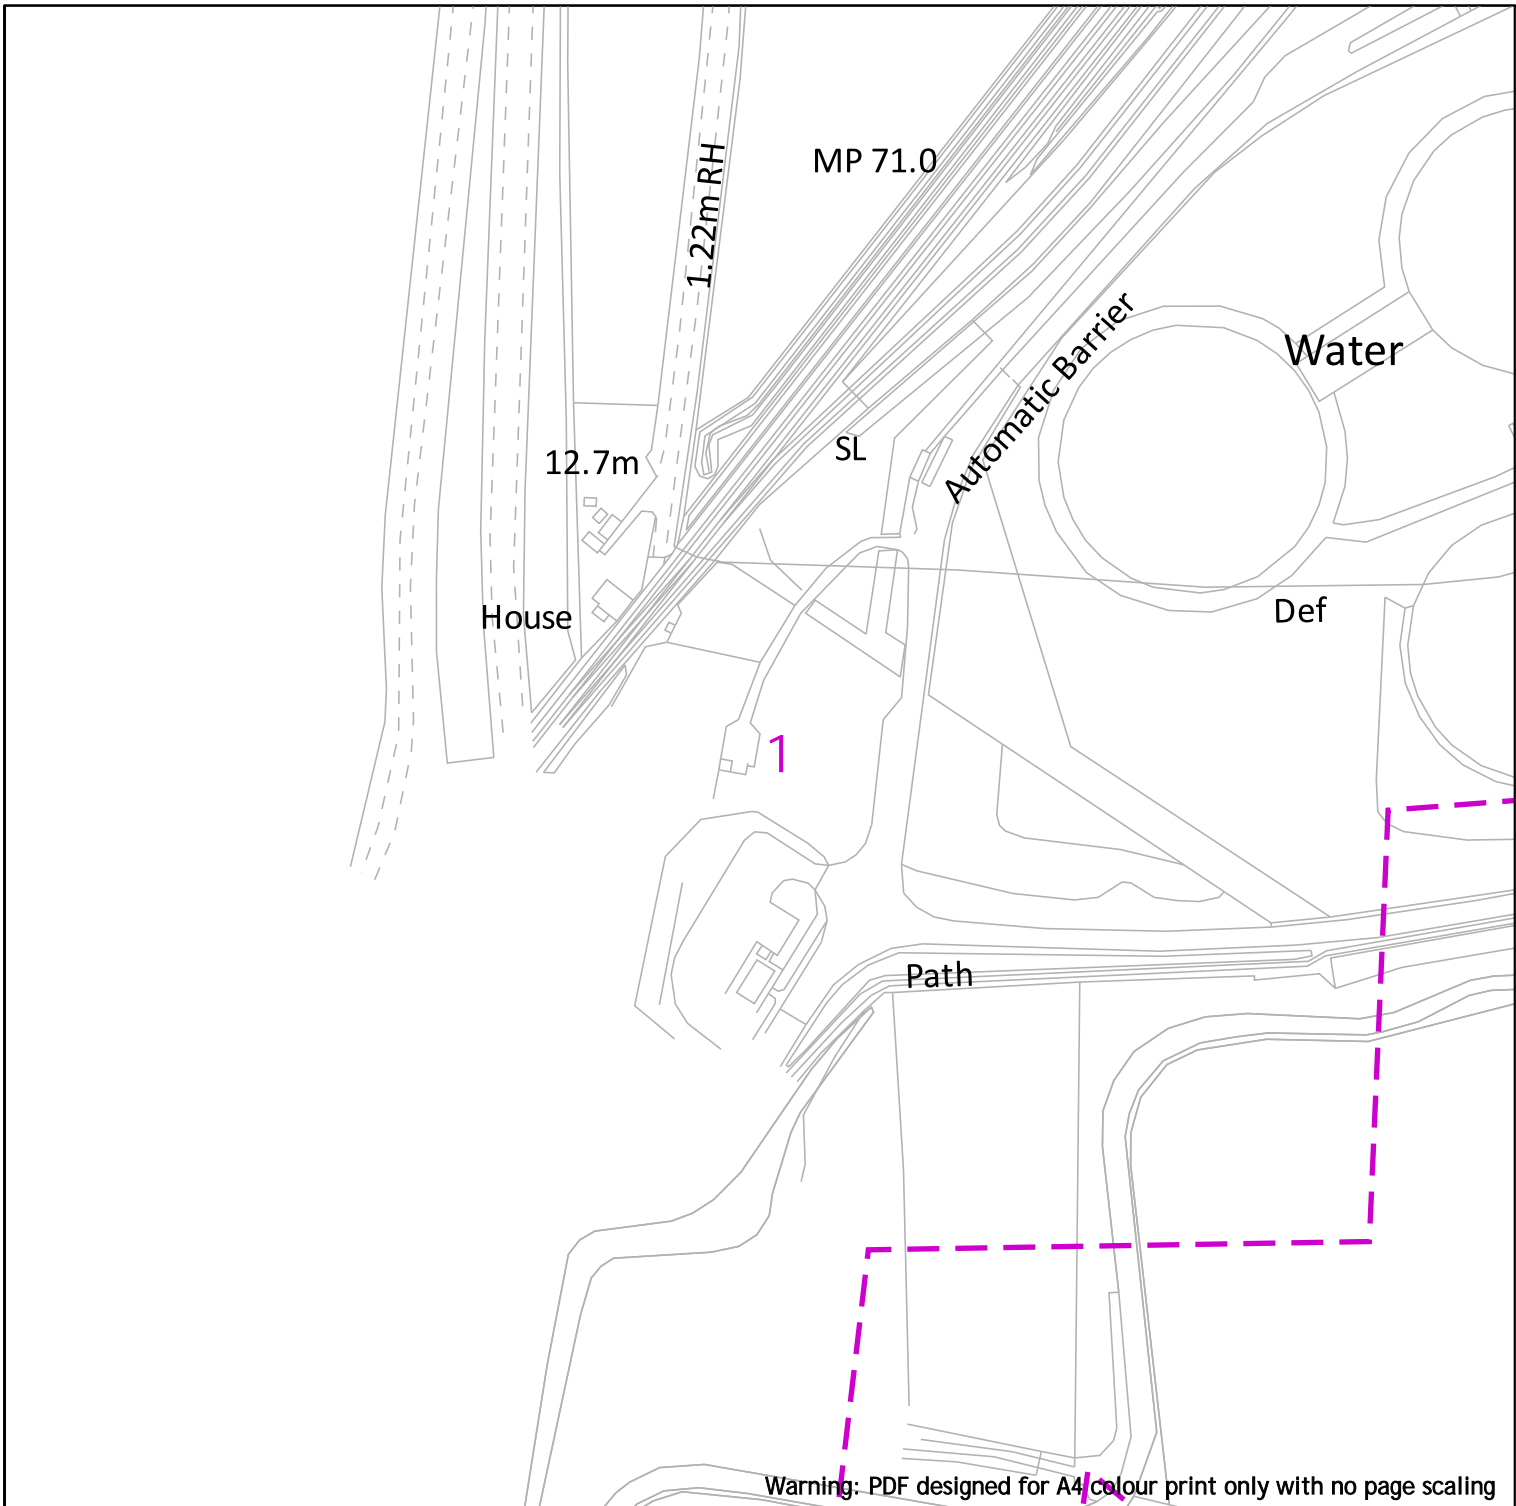

nationalgrid




**EXTREME CAUTION - HIGH VOLTAGE
RISK OF DEATH OR SERIOUS INJURY**

NationalGrid House
Warwick Technology Park
Gallows Hill
Warwick
CV34 6DA

AssetProtection@NationalGrid.com

Date Requested: 08/05/2023
Job Reference: 29406937
Site Location: 479891 384296
Requested by: Mr Ben Evans

Your Scheme/Reference: LM
203570/DK - 4

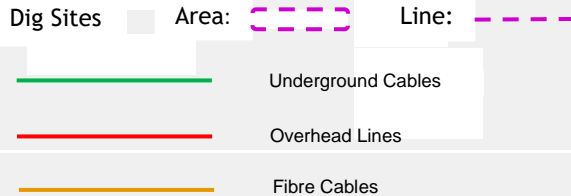


IMPORTANT NOTICES

This plan shows those pipes owned by National Grid Electricity Transmission plc in its role as a Licensed Electricity Transporter (ET). Electricity cables owned by other ETs, or otherwise privately owned, may be present in this area. Information with regards to such cables should be obtained from the relevant owners. The information shown on this plan is given without warranty, the accuracy thereof cannot be guaranteed. Ancillary equipment such as cooling systems and communication cables are not shown but their presence should be anticipated. No liability of any kind whatsoever is accepted by National Grid Electricity Transmission plc or their agents, servants or contractors for any error or omission. Safe digging practices, in accordance with HS(G)47, must be used to verify and establish the actual position of cables and other apparatus on site before any mechanical plant is used. It is your responsibility to ensure that this information is provided to all persons (either direct labour or contractors) working for you on or near electricity apparatus. The information included on this plan should not be referred to beyond a period of 28 days from the date of issue.

National Grid Electricity Emergency Number: 0800 40 40 90
Available 24 hours, 7 days/week. Calls may be recorded and monitored

Scale: 1:2500 (When plotted at A4)

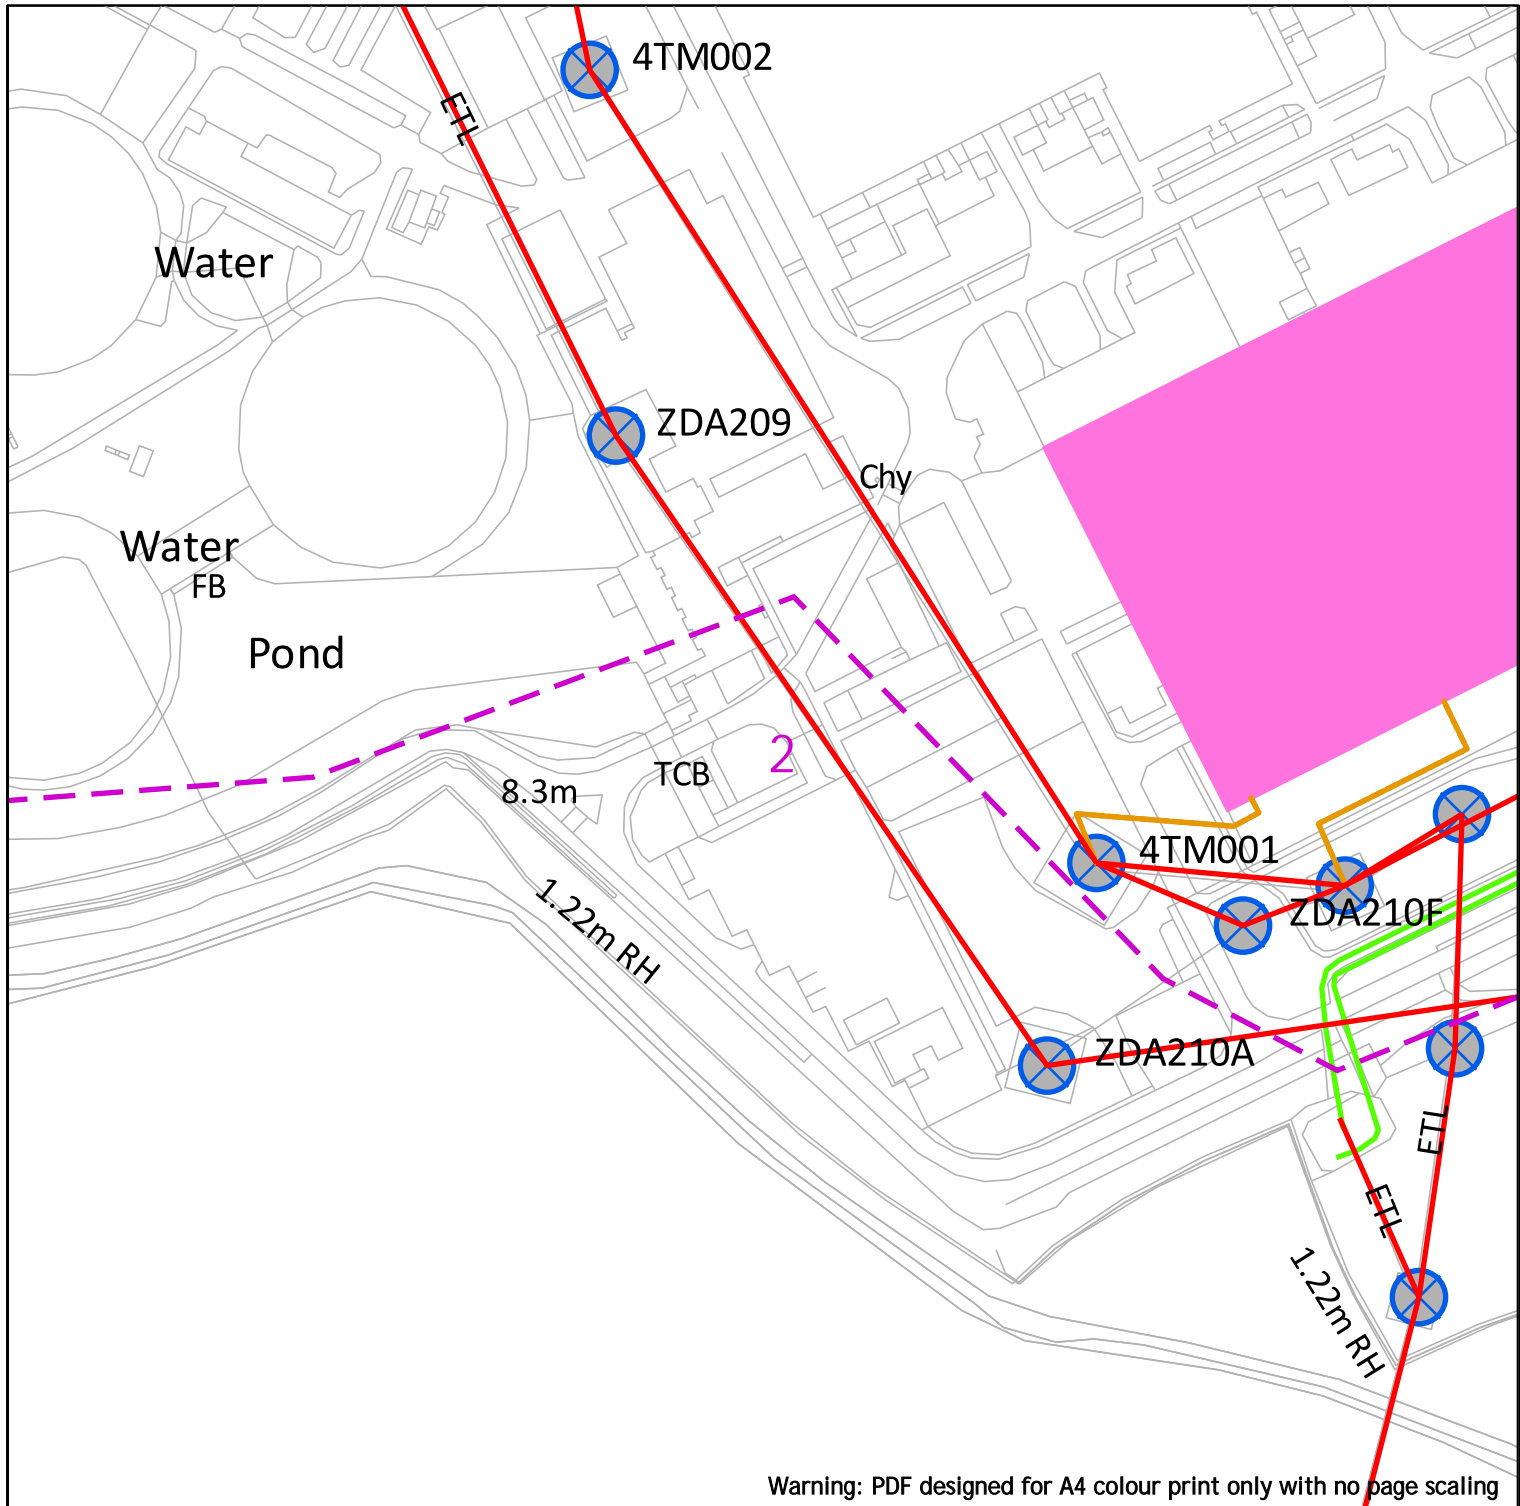

Warning: PDF designed for A4 colour print only with no page scaling

nationalgrid



**EXTREME CAUTION - HIGH VOLTAGE
RISK OF DEATH OR SERIOUS INJURY**

- Dig Sites
- Area:
- Line:
- Underground Cables
- Overhead Lines
- Fibre Cables

NationalGrid House
Warwick Technology Park
Gallows Hill
Warwick
CV34 6DA

AssetProtection@NationalGrid.com

Date Requested: 08/05/2023
Job Reference: 29406937
Site Location: 479891 384296
Requested by: Mr Ben Evans


Your Scheme/Reference: LM
203570/DK - 4

IMPORTANT NOTICES

This plan shows those pipes owned by National Grid Electricity Transmission plc in its role as a Licensed Electricity Transporter (ET). Electricity cables owned by other ETs, or otherwise privately owned, may be present in this area. Information with regards to such cables should be obtained from the relevant owners. The information shown on this plan is given without warranty, the accuracy thereof cannot be guaranteed. Ancillary equipment such as cooling systems and communication cables are not shown but their presence should be anticipated. No liability of any kind whatsoever is accepted by National Grid Electricity Transmission plc or their agents, servants or contractors for any error or omission. Safe digging practices, in accordance with HS(G)47, must be used to verify and establish the actual position of cables and other apparatus on site before any mechanical plant is used. It is your responsibility to ensure that this information is provided to all persons (either direct labour or contractors) working for you on or near electricity apparatus. The information included on this plan should not be referred to beyond a period of 28 days from the date of issue.

National Grid Electricity Emergency Number: 0800 40 40 90
Available 24 hours, 7 days/week. Calls may be recorded and monitored

Scale: 1:2500 (When plotted at A4)

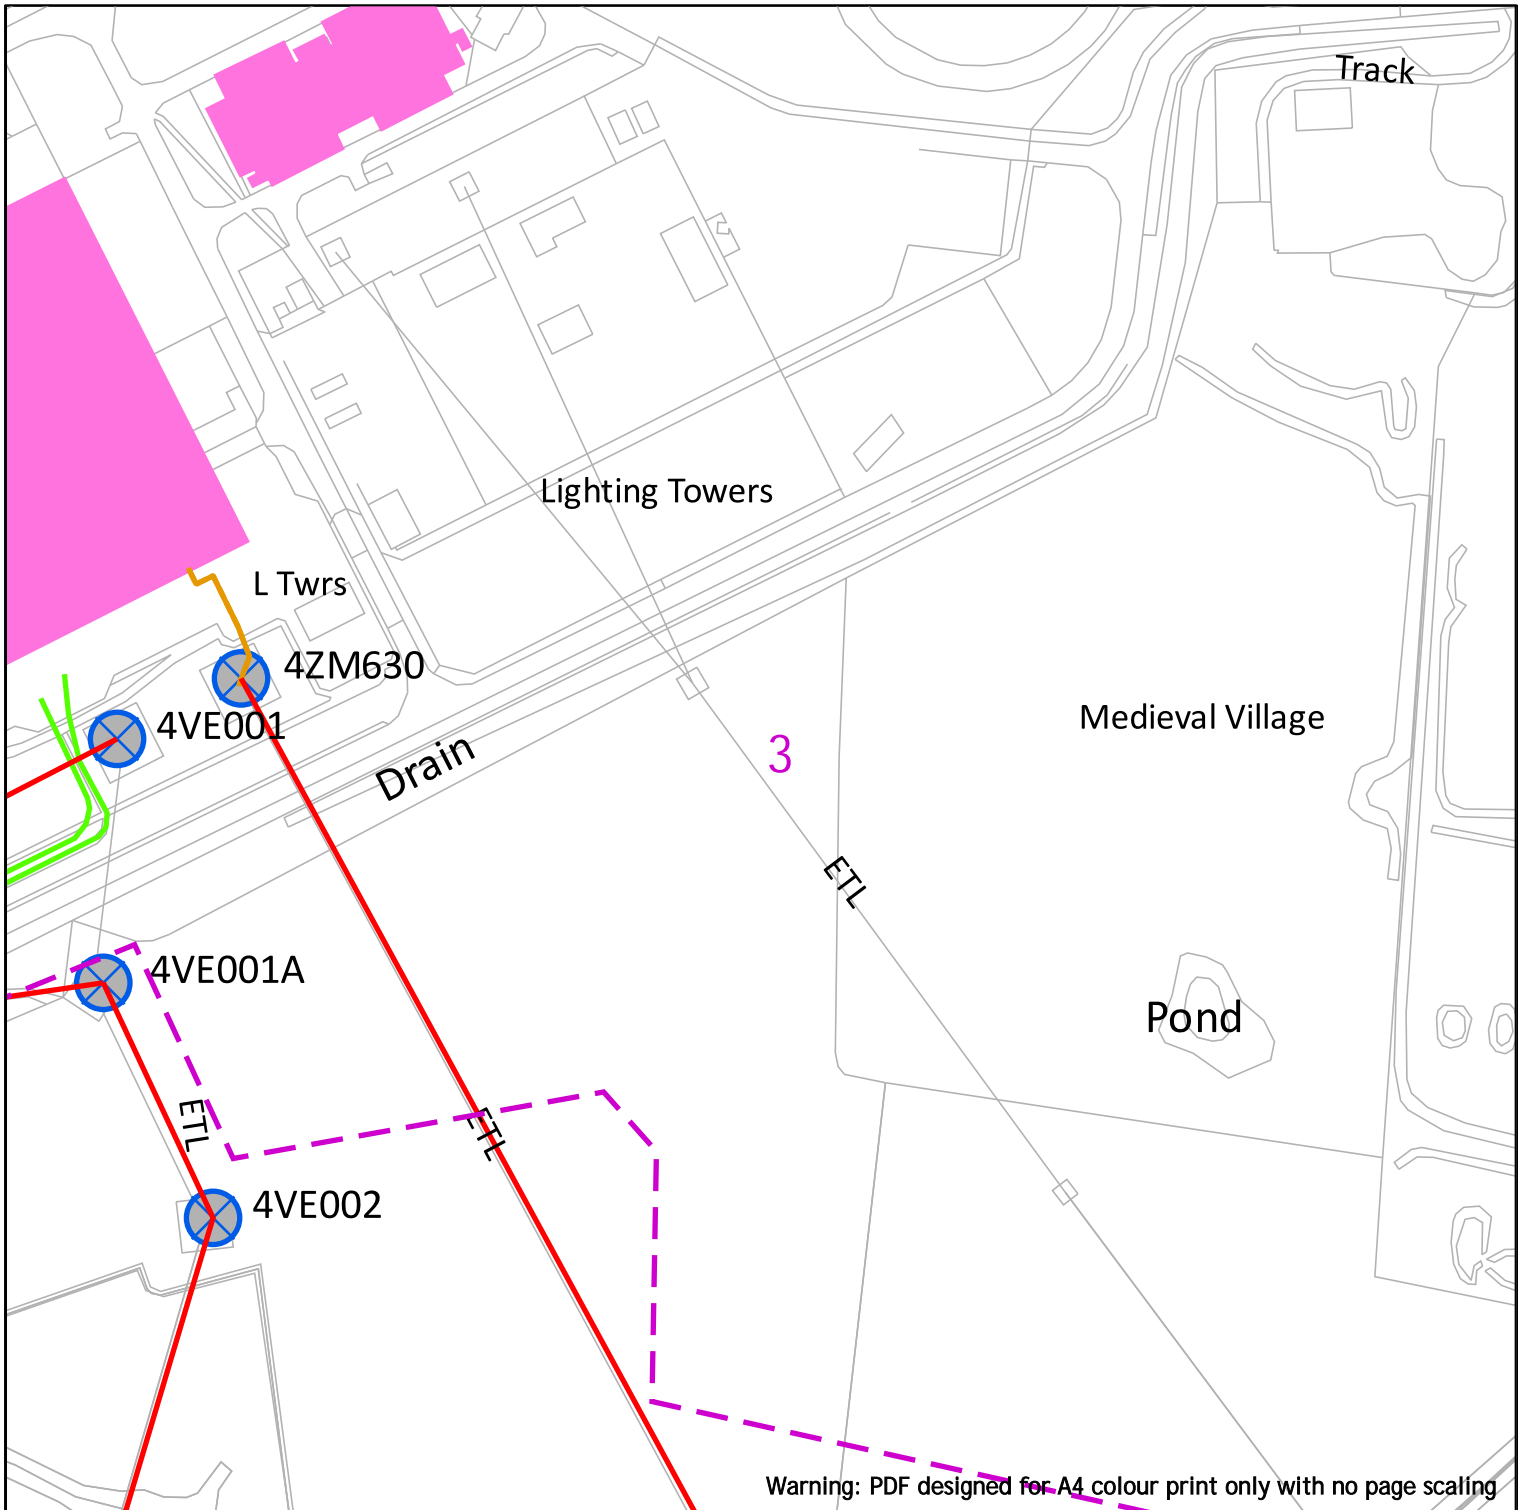

Warning: PDF designed for A4 colour print only with no page scaling



EXTREME CAUTION - HIGH VOLTAGE
****RISK OF DEATH OR SERIOUS INJURY****

Dig Sites	Area:	Line:
	Underground Cables	
	Overhead Lines	
	Fibre Cables	


NationalGrid House
 Warwick Technology Park
 Gallows Hill
 Warwick
 CV34 6DA
 AssetProtection@NationalGrid.com

Date Requested: 08/05/2023
 Job Reference: 29406937
 Site Location: 479891 384296
 Requested by: Mr Ben Evans
 Your Scheme/Reference: LM
 203570/DK - 4

IMPORTANT NOTICES
 This plan shows those pipes owned by National Grid Electricity Transmission plc in its role as a Licensed Electricity Transporter (ET). Electricity cables owned by other ETs, or otherwise privately owned, may be present in this area. Information with regards to such cables should be obtained from the relevant owners. The information shown on this plan is given without warranty, the accuracy thereof cannot be guaranteed. Ancillary equipment such as cooling systems and communication cables are not shown but their presence should be anticipated. No liability of any kind whatsoever is accepted by National Grid Electricity Transmission plc or their agents, servants or contractors for any error or omission. Safe digging practices, in accordance with HS(G)47, must be used to verify and establish the actual position of cables and other apparatus on site before any mechanical plant is used. It is your responsibility to ensure that this information is provided to all persons (either direct labour or contractors) working for you on or near electricity apparatus. The information included on this plan should not be referred to beyond a period of 28 days from the date of issue.

National Grid Electricity Emergency Number: 0800 40 40 90
 Available 24 hours, 7 days/week. Calls may be recorded and monitored

Scale: 1:2500 (When plotted at A4)

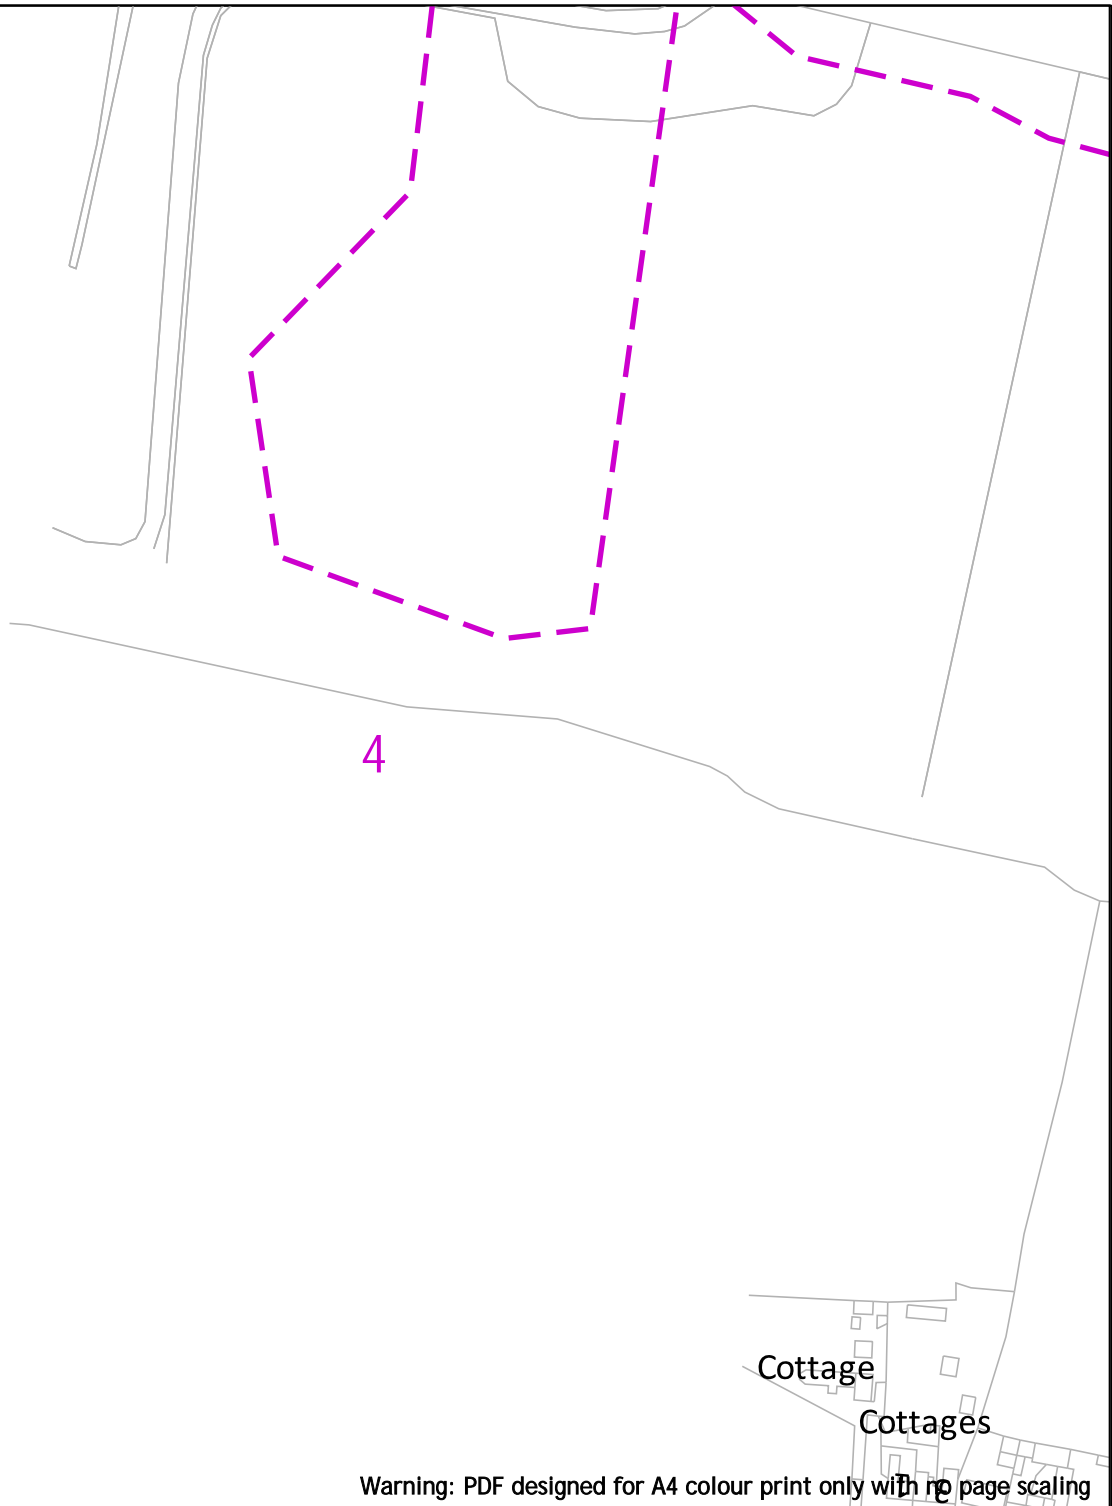

Warning: PDF designed for A4 colour print only with no page scaling



**EXTREME CAUTION - HIGH VOLTAGE
RISK OF DEATH OR SERIOUS INJURY**

Dig Sites Area: Line:

 Underground Cables

 Overhead Lines

 Fibre Cables

NationalGrid House
Warwick Technology Park
Gallows Hill
Warwick
CV34 6DA

AssetProtection@NationalGrid.com



Date Requested: 08/05/2023
Job Reference: 29406937
Site Location: 479891 384296
Requested by: Mr Ben Evans

Your Scheme/Reference: LM
203570/DK - 4

IMPORTANT NOTICES
This plan shows those pipes owned by National Grid Electricity Transmission plc in its role as a Licensed Electricity Transporter (ET). Electricity cables owned by other ETs, or otherwise privately owned, may be present in this area. Information with regards to such cables should be obtained from the relevant owners. The information shown on this plan is given without warranty, the accuracy thereof cannot be guaranteed. Ancillary equipment such as cooling systems and communication cables are not shown but their presence should be anticipated. No liability of any kind whatsoever is accepted by National Grid Electricity Transmission plc or their agents, servants or contractors for any error or omission. Safe digging practices, in accordance with HS(G)47, must be used to verify and establish the actual position of cables and other apparatus on site before any mechanical plant is used. It is your responsibility to ensure that this information is provided to all persons (either direct labour or contractors) working for you on or near electricity apparatus. The information included on this plan should not be referred to beyond a period of 28 days from the date of issue.

National Grid Electricity Emergency Number: 0800 40 40 90
Available 24 hours, 7 days/week. Calls may be recorded and monitored

Scale: 1:2500 (When plotted at A4)

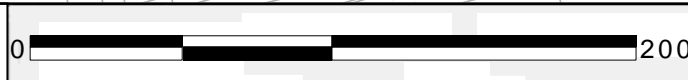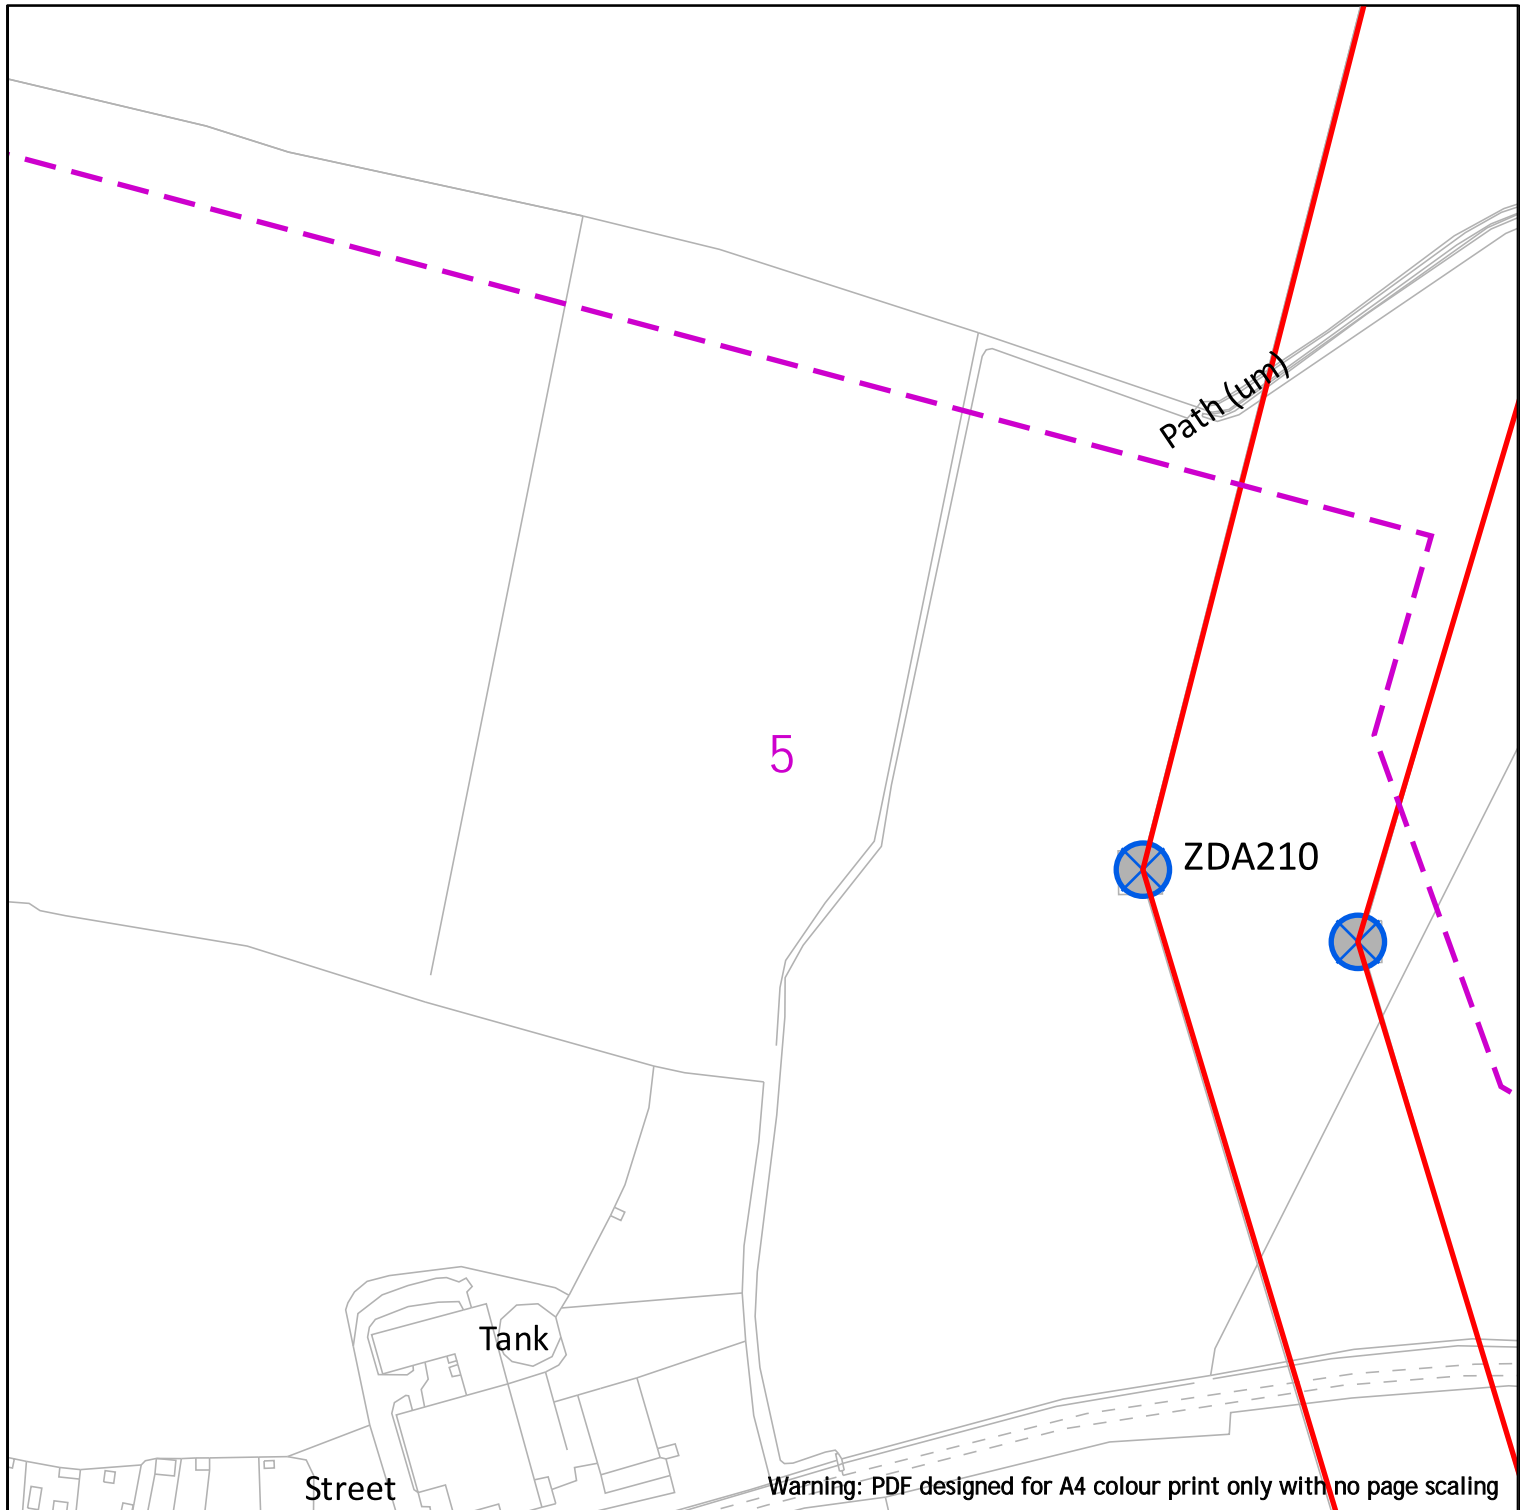

**EXTREME CAUTION - HIGH VOLTAGE
RISK OF DEATH OR SERIOUS INJURY**

NationalGrid House
Warwick Technology Park
Gallows Hill
Warwick
CV34 6DA

AssetProtection@NationalGrid.com

Dig Sites	Area:	Line:
	Underground Cables	
	Overhead Lines	
	Fibre Cables	

Date Requested: 08/05/2023
Job Reference: 29406937
Site Location: 479891 384296
Requested by: Mr Ben Evans


Your Scheme/Reference: LM
203570/DK - 4

Scale: 1:2500 (When plotted at A4)

IMPORTANT NOTICES
This plan shows those pipes owned by National Grid Electricity Transmission plc in its role as a Licensed Electricity Transporter (ET). Electricity cables owned by other ETs, or otherwise privately owned, may be present in this area. Information with regards to such cables should be obtained from the relevant owners. The information shown on this plan is given without warranty, the accuracy thereof cannot be guaranteed. Ancillary equipment such as cooling systems and communication cables are not shown but their presence should be anticipated. No liability of any kind whatsoever is accepted by National Grid Electricity Transmission plc or their agents, servants or contractors for any error or omission. Safe digging practices, in accordance with HS(G)47, must be used to verify and establish the actual position of cables and other apparatus on site before any mechanical plant is used. It is your responsibility to ensure that this information is provided to all persons (either direct labour or contractors) working for you on or near electricity apparatus. The information included on this plan should not be referred to beyond a period of 28 days from the date of issue.

National Grid Electricity Emergency Number: 0800 40 40 90
Available 24 hours, 7 days/week. Calls may be recorded and monitored

Crown Copyright © - Reproduced by permission of Ordnance Survey on behalf of HMSO. And database right 2023. All rights reserved. Ordnance Survey Licence number 0100059731.

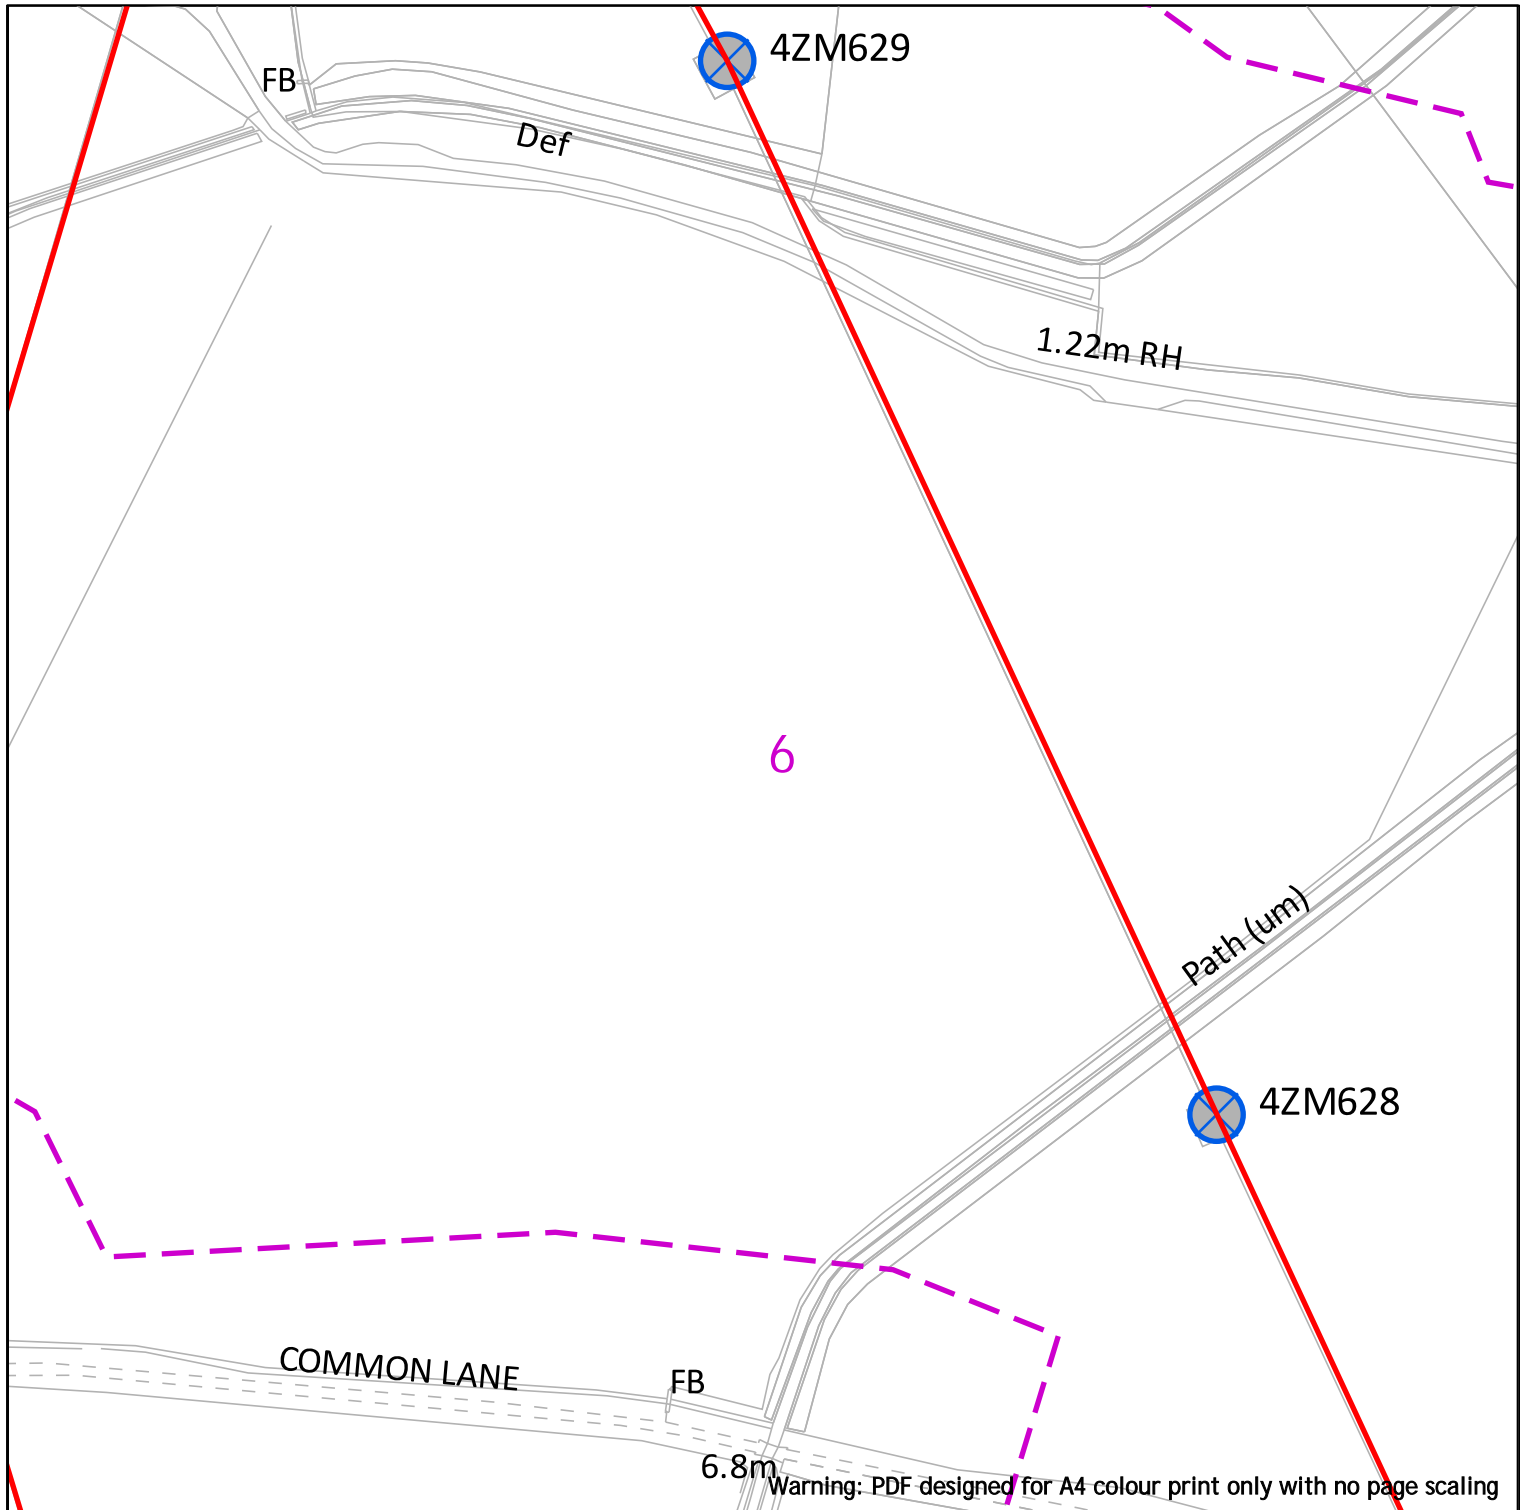

nationalgrid



**EXTREME CAUTION - HIGH VOLTAGE
RISK OF DEATH OR SERIOUS INJURY**


NationalGrid House
Warwick Technology Park
Gallows Hill
Warwick
CV34 6DA

AssetProtection@NationalGrid.com

Date Requested: 08/05/2023
Job Reference: 29406937
Site Location: 479891 384296
Requested by: Mr Ben Evans

Your Scheme/Reference: LM
203570/DK - 4


Scale: 1:2500 (When plotted at A4)

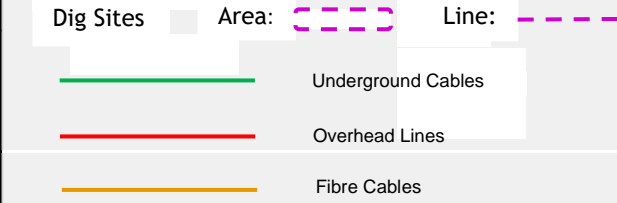

IMPORTANT NOTICES

This plan shows those pipes owned by National Grid Electricity Transmission plc in its role as a Licensed Electricity Transporter (ET). Electricity cables owned by other ETs, or otherwise privately owned, may be present in this area. Information with regards to such cables should be obtained from the relevant owners. The information shown on this plan is given without warranty, the accuracy thereof cannot be guaranteed. Ancillary equipment such as cooling systems and communication cables are not shown but their presence should be anticipated. No liability of any kind whatsoever is accepted by National Grid Electricity Transmission plc or their agents, servants or contractors for any error or omission. Safe digging practices, in accordance with HS(G)47, must be used to verify and establish the actual position of cables and other apparatus on site before any mechanical plant is used. It is your responsibility to ensure that this information is provided to all persons (either direct labour or contractors) working for you on or near electricity apparatus. The information included on this plan should not be referred to beyond a period of 28 days from the date of issue.

National Grid Electricity Emergency Number: 0800 40 40 90
Available 24 hours, 7 days/week. Calls may be recorded and monitored

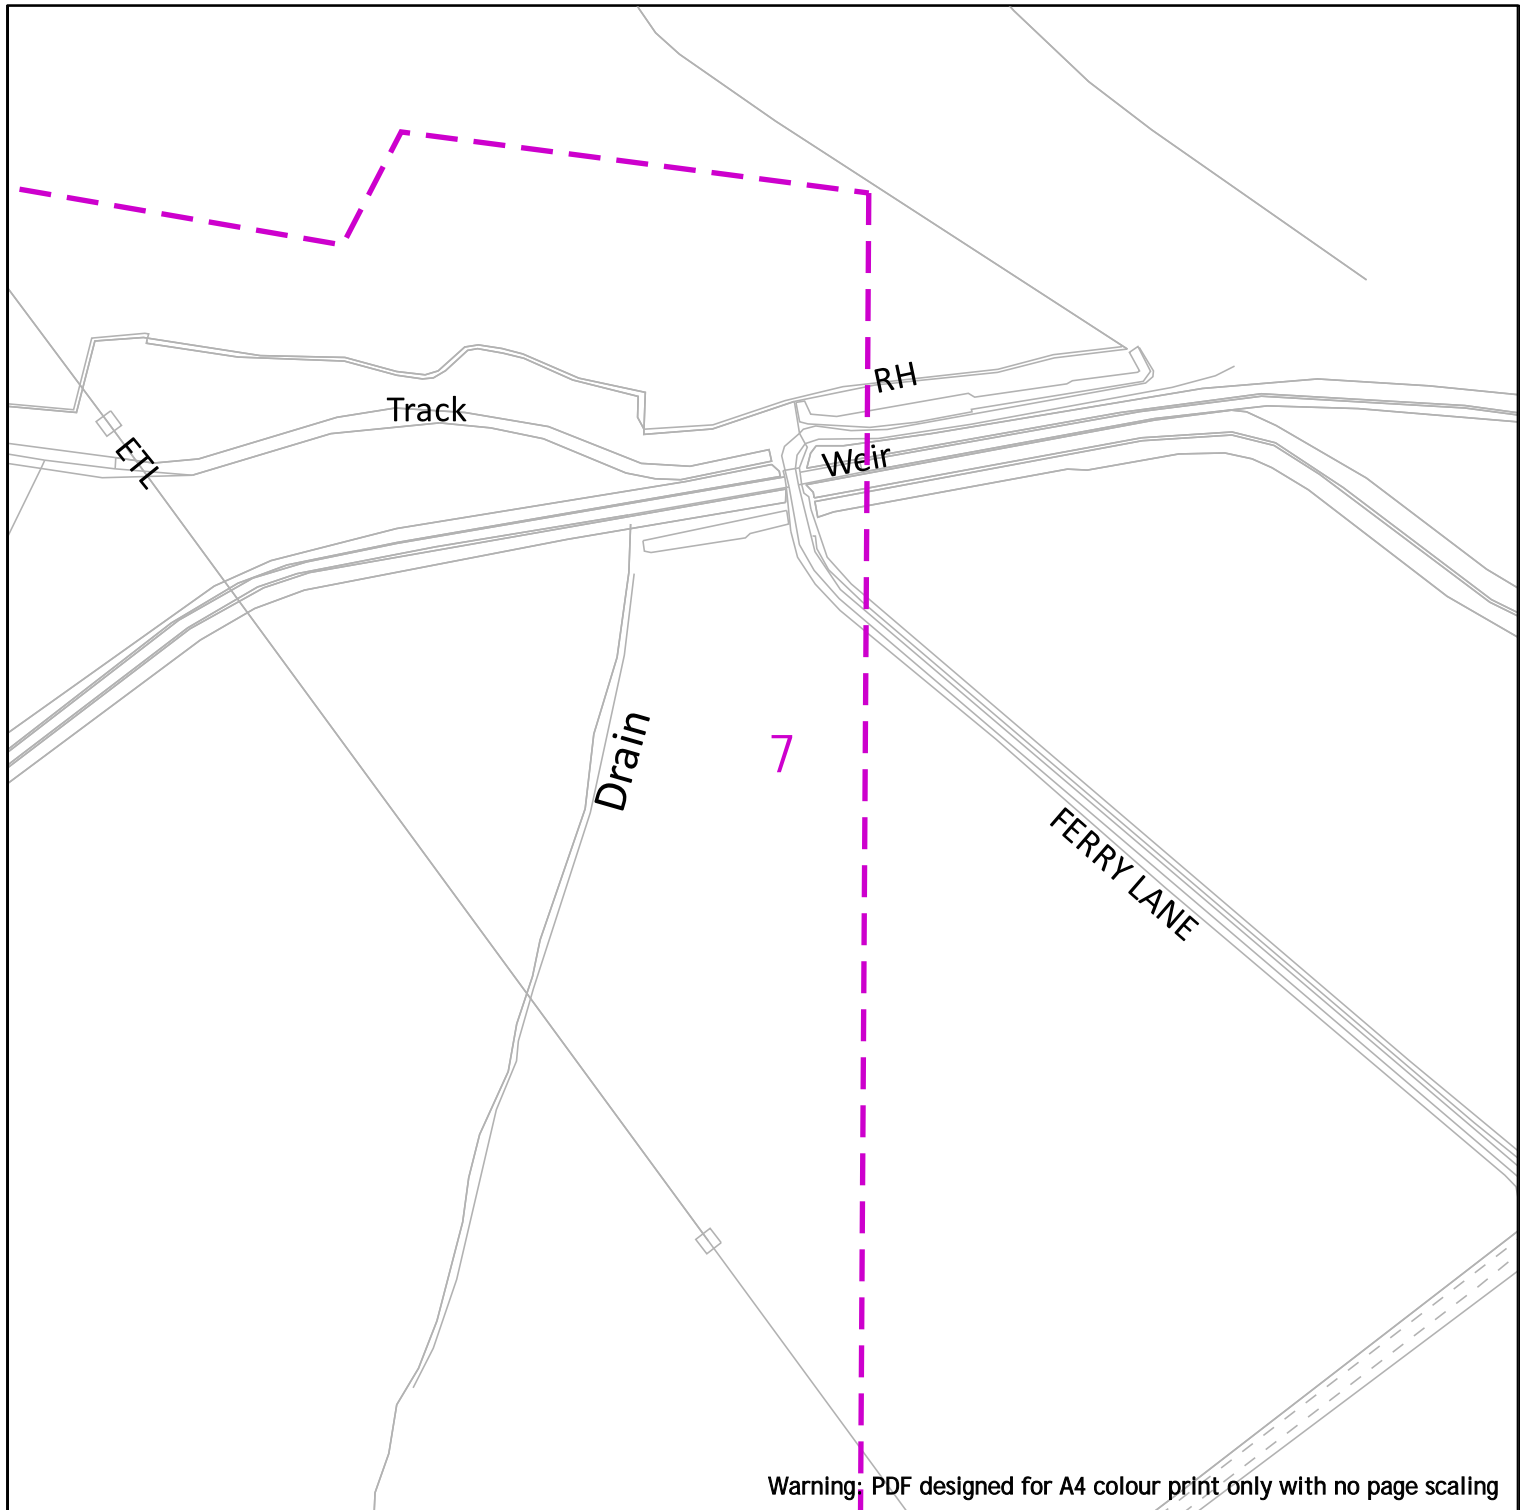

Warning: PDF designed for A4 colour print only with no page scaling

nationalgrid



**EXTREME CAUTION - HIGH VOLTAGE
RISK OF DEATH OR SERIOUS INJURY**

Dig Sites Area: Line:

 Underground Cables

 Overhead Lines

 Fibre Cables

NationalGrid House
Warwick Technology Park
Gallows Hill
Warwick
CV34 6DA

AssetProtection@NationalGrid.com

Date Requested: 08/05/2023
Job Reference: 29406937
Site Location: 479891 384296
Requested by: Mr Ben Evans


Your Scheme/Reference: LM
203570/DK - 4

IMPORTANT NOTICES

This plan shows those pipes owned by National Grid Electricity Transmission plc in its role as a Licensed Electricity Transporter (ET). Electricity cables owned by other ETs, or otherwise privately owned, may be present in this area. Information with regards to such cables should be obtained from the relevant owners. The information shown on this plan is given without warranty, the accuracy thereof cannot be guaranteed. Ancillary equipment such as cooling systems and communication cables are not shown but their presence should be anticipated. No liability of any kind whatsoever is accepted by National Grid Electricity Transmission plc or their agents, servants or contractors for any error or omission. Safe digging practices, in accordance with HS(G)47, must be used to verify and establish the actual position of cables and other apparatus on site before any mechanical plant is used. It is your responsibility to ensure that this information is provided to all persons (either direct labour or contractors) working for you on or near electricity apparatus. The information included on this plan should not be referred to beyond a period of 28 days from the date of issue.

National Grid Electricity Emergency Number: 0800 40 40 90
Available 24 hours, 7 days/week. Calls may be recorded and monitored

Scale: 1:2500 (When plotted at A4)

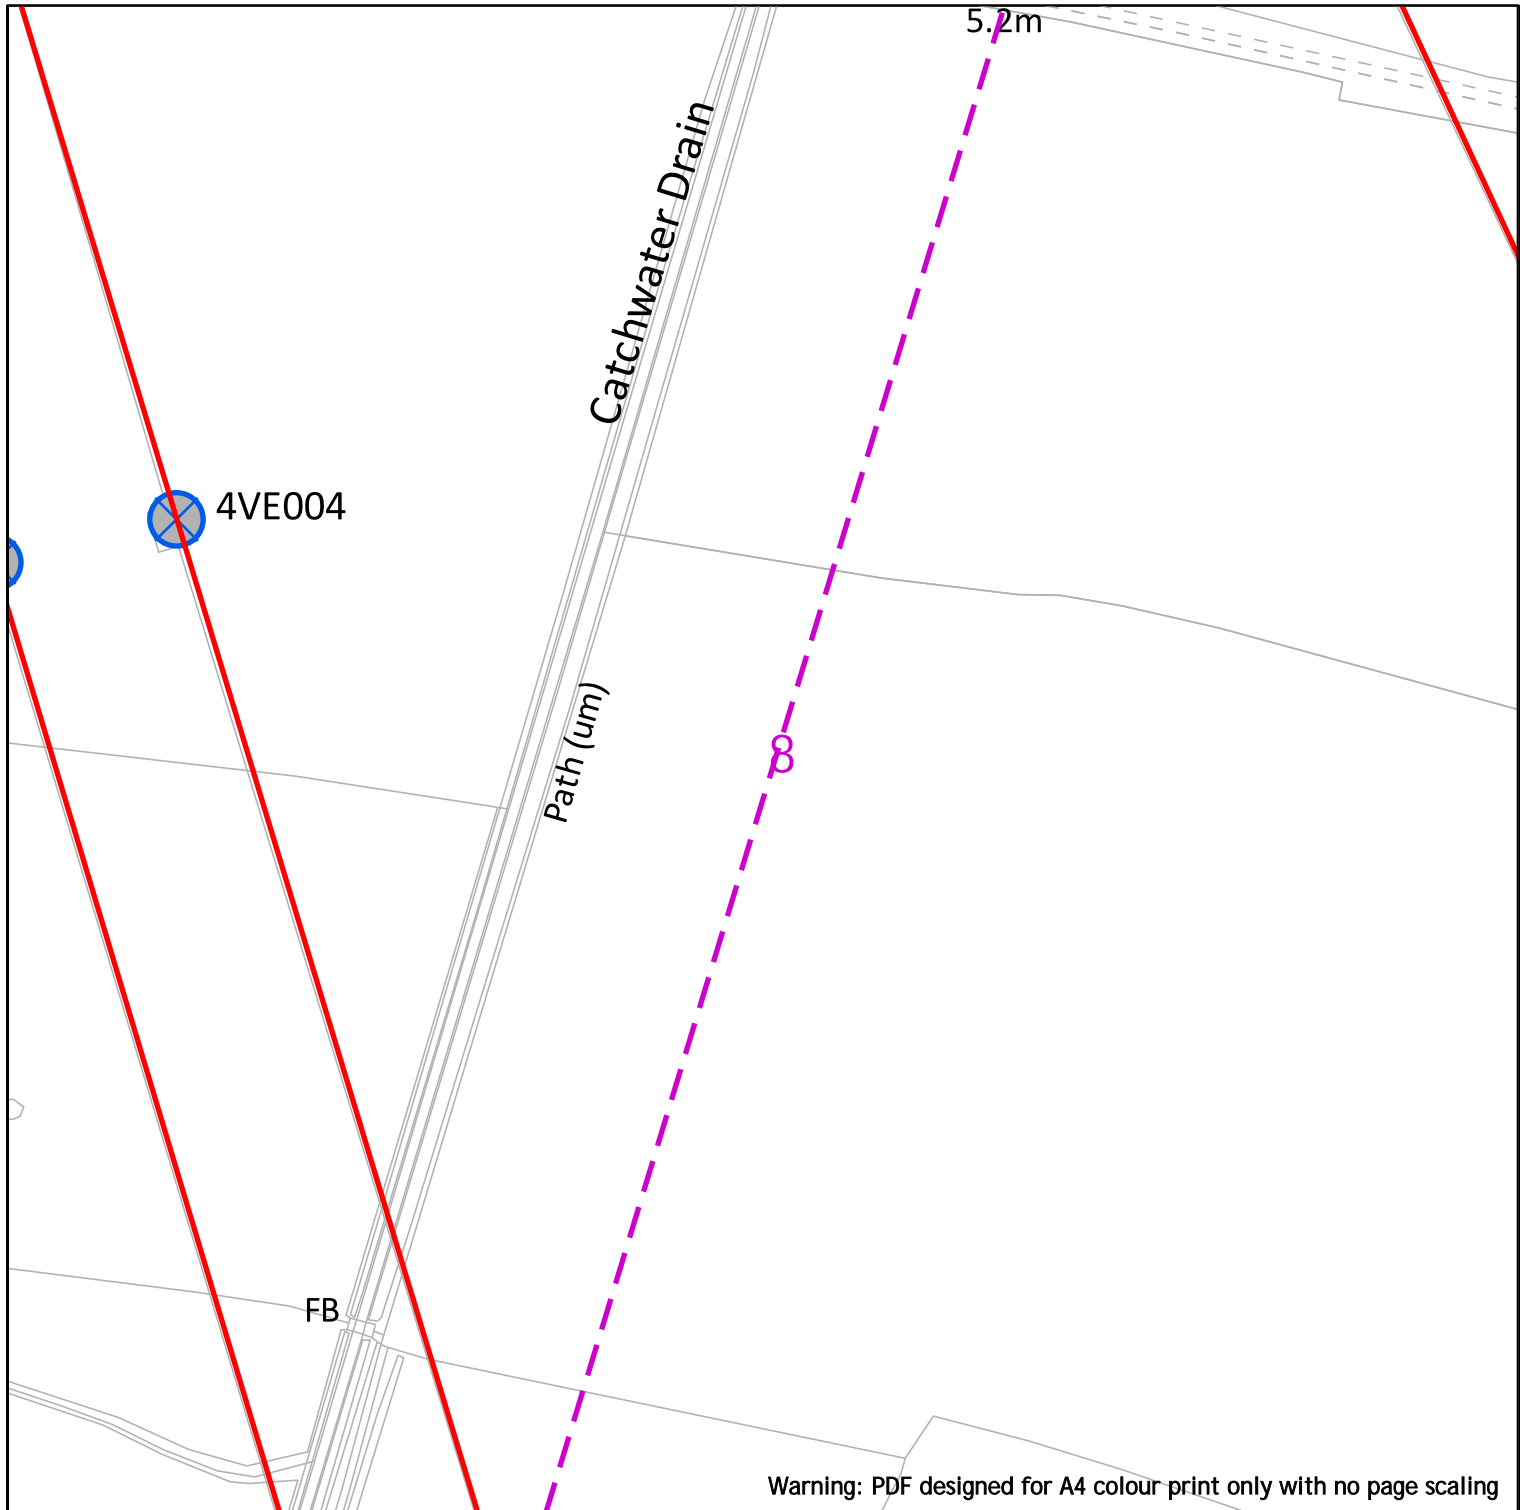

Warning: PDF designed for A4 colour print only with no page scaling

nationalgrid



**EXTREME CAUTION - HIGH VOLTAGE
RISK OF DEATH OR SERIOUS INJURY**

Dig Sites	Area:	Line:
	Underground Cables	
	Overhead Lines	
	Fibre Cables	

NationalGrid House
Warwick Technology Park
Gallows Hill
Warwick
CV34 6DA

AssetProtection@NationalGrid.com

Date Requested: 08/05/2023
Job Reference: 29406937
Site Location: 479891 384296
Requested by: Mr Ben Evans


Your Scheme/Reference: LM
203570/DK - 4

IMPORTANT NOTICES

This plan shows those pipes owned by National Grid Electricity Transmission plc in its role as a Licensed Electricity Transporter (ET). Electricity cables owned by other ETs, or otherwise privately owned, may be present in this area. Information with regards to such cables should be obtained from the relevant owners. The information shown on this plan is given without warranty, the accuracy thereof cannot be guaranteed. Ancillary equipment such as cooling systems and communication cables are not shown but their presence should be anticipated. No liability of any kind whatsoever is accepted by National Grid Electricity Transmission plc or their agents, servants or contractors for any error or omission. Safe digging practices, in accordance with HS(G)47, must be used to verify and establish the actual position of cables and other apparatus on site before any mechanical plant is used. It is your responsibility to ensure that this information is provided to all persons (either direct labour or contractors) working for you on or near electricity apparatus. The information included on this plan should not be referred to beyond a period of 28 days from the date of issue.

National Grid Electricity Emergency Number: 0800 40 40 90
Available 24 hours, 7 days/week. Calls may be recorded and monitored

Scale: 1:2500 (When plotted at A4)

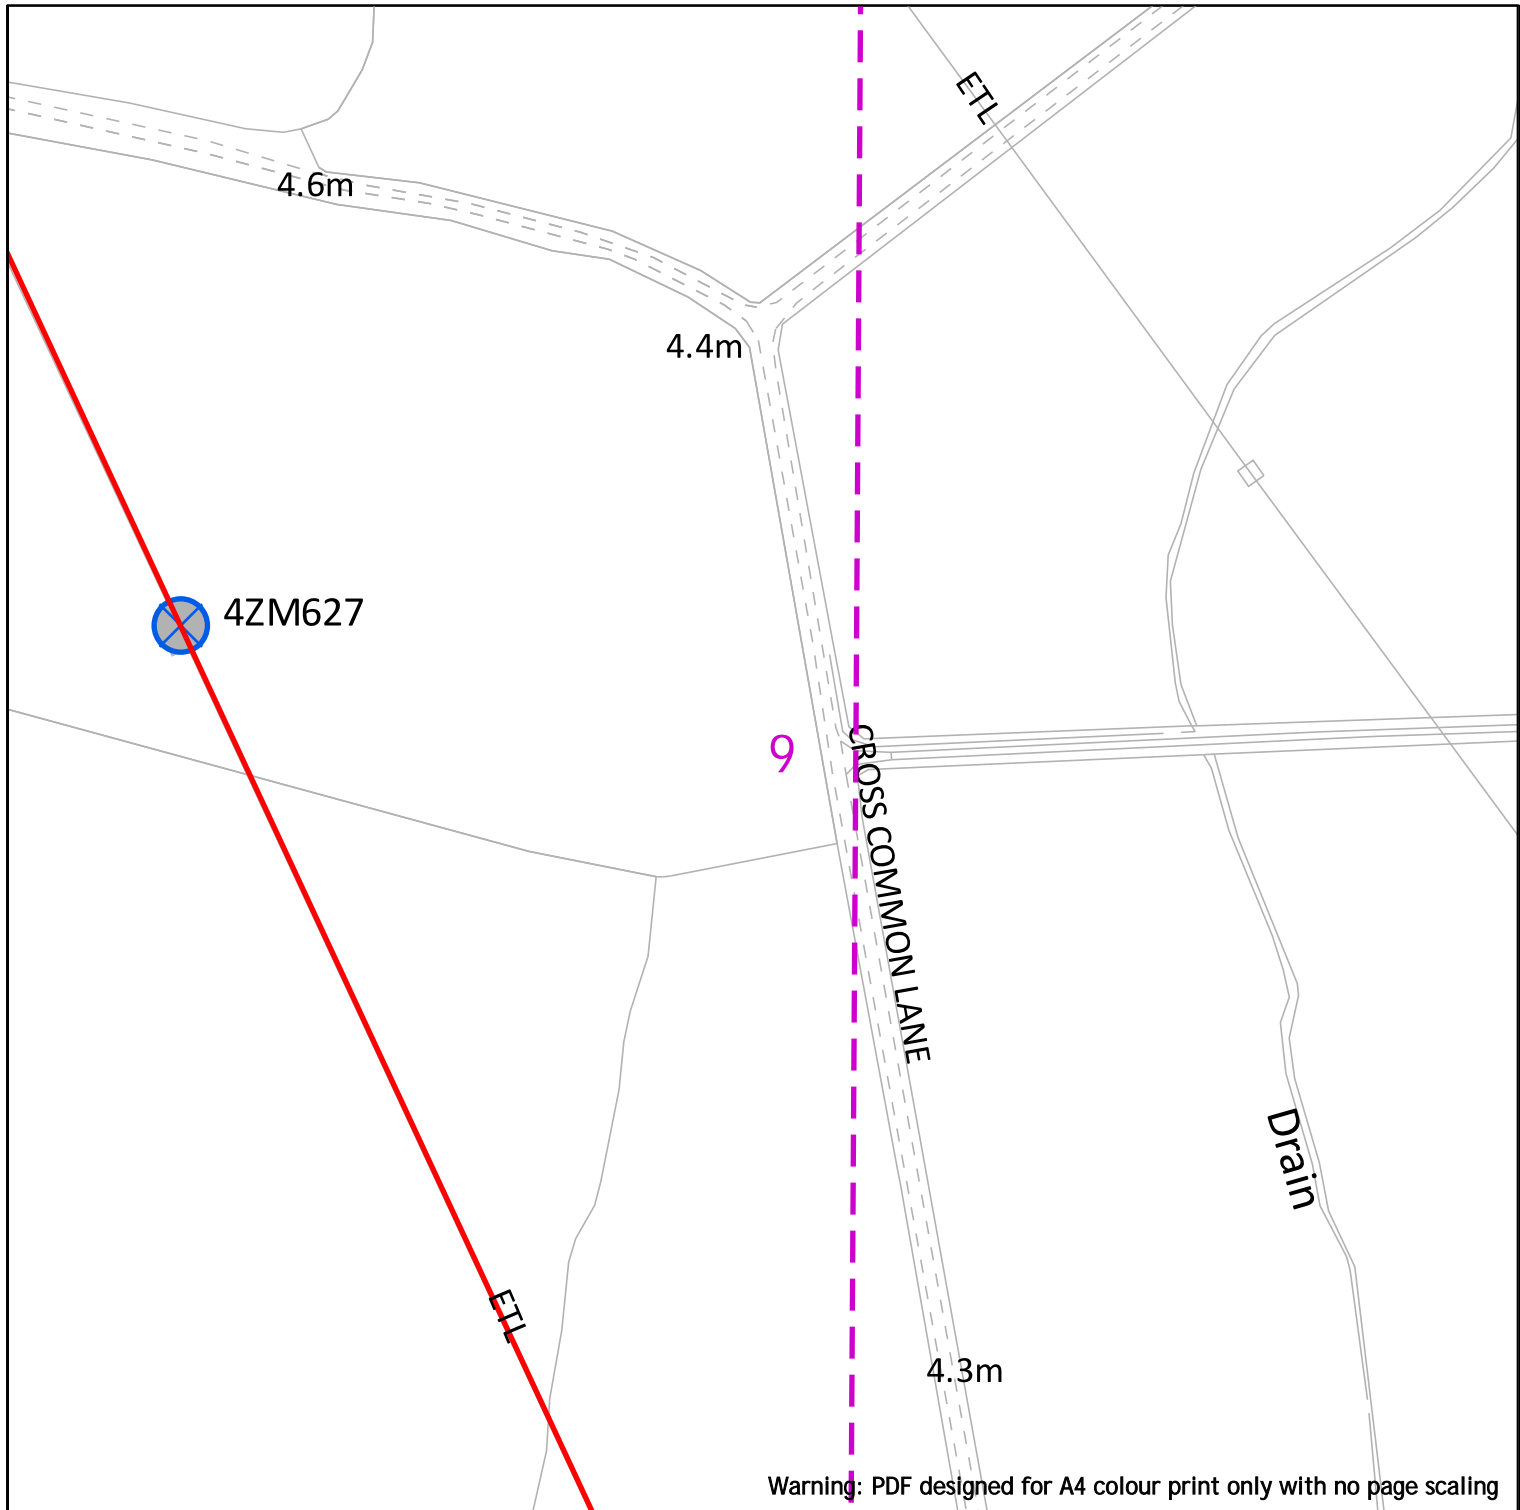

nationalgrid



**EXTREME CAUTION - HIGH VOLTAGE
RISK OF DEATH OR SERIOUS INJURY**

NationalGrid House
Warwick Technology Park
Gallows Hill
Warwick
CV34 6DA

AssetProtection@NationalGrid.com

Date Requested: 08/05/2023
Job Reference: 29406937
Site Location: 479891 384296
Requested by: Mr Ben Evans

Your Scheme/Reference: LM
203570/DK - 4

Scale: 1:2500 (When plotted at A4)

Dig Sites Area: Line:

Underground Cables


Overhead Lines

Fibre Cables

IMPORTANT NOTICES

This plan shows those pipes owned by National Grid Electricity Transmission plc in its role as a Licensed Electricity Transporter (ET). Electricity cables owned by other ETs, or otherwise privately owned, may be present in this area. Information with regards to such cables should be obtained from the relevant owners. The information shown on this plan is given without warranty, the accuracy thereof cannot be guaranteed. Ancillary equipment such as cooling systems and communication cables are not shown but their presence should be anticipated. No liability of any kind whatsoever is accepted by National Grid Electricity Transmission plc or their agents, servants or contractors for any error or omission. Safe digging practices, in accordance with HS(G)47, must be used to verify and establish the actual position of cables and other apparatus on site before any mechanical plant is used. It is your responsibility to ensure that this information is provided to all persons (either direct labour or contractors) working for you on or near electricity apparatus. The information included on this plan should not be referred to beyond a period of 28 days from the date of issue.

National Grid Electricity Emergency Number: 0800 40 40 90
Available 24 hours, 7 days/week. Calls may be recorded and monitored

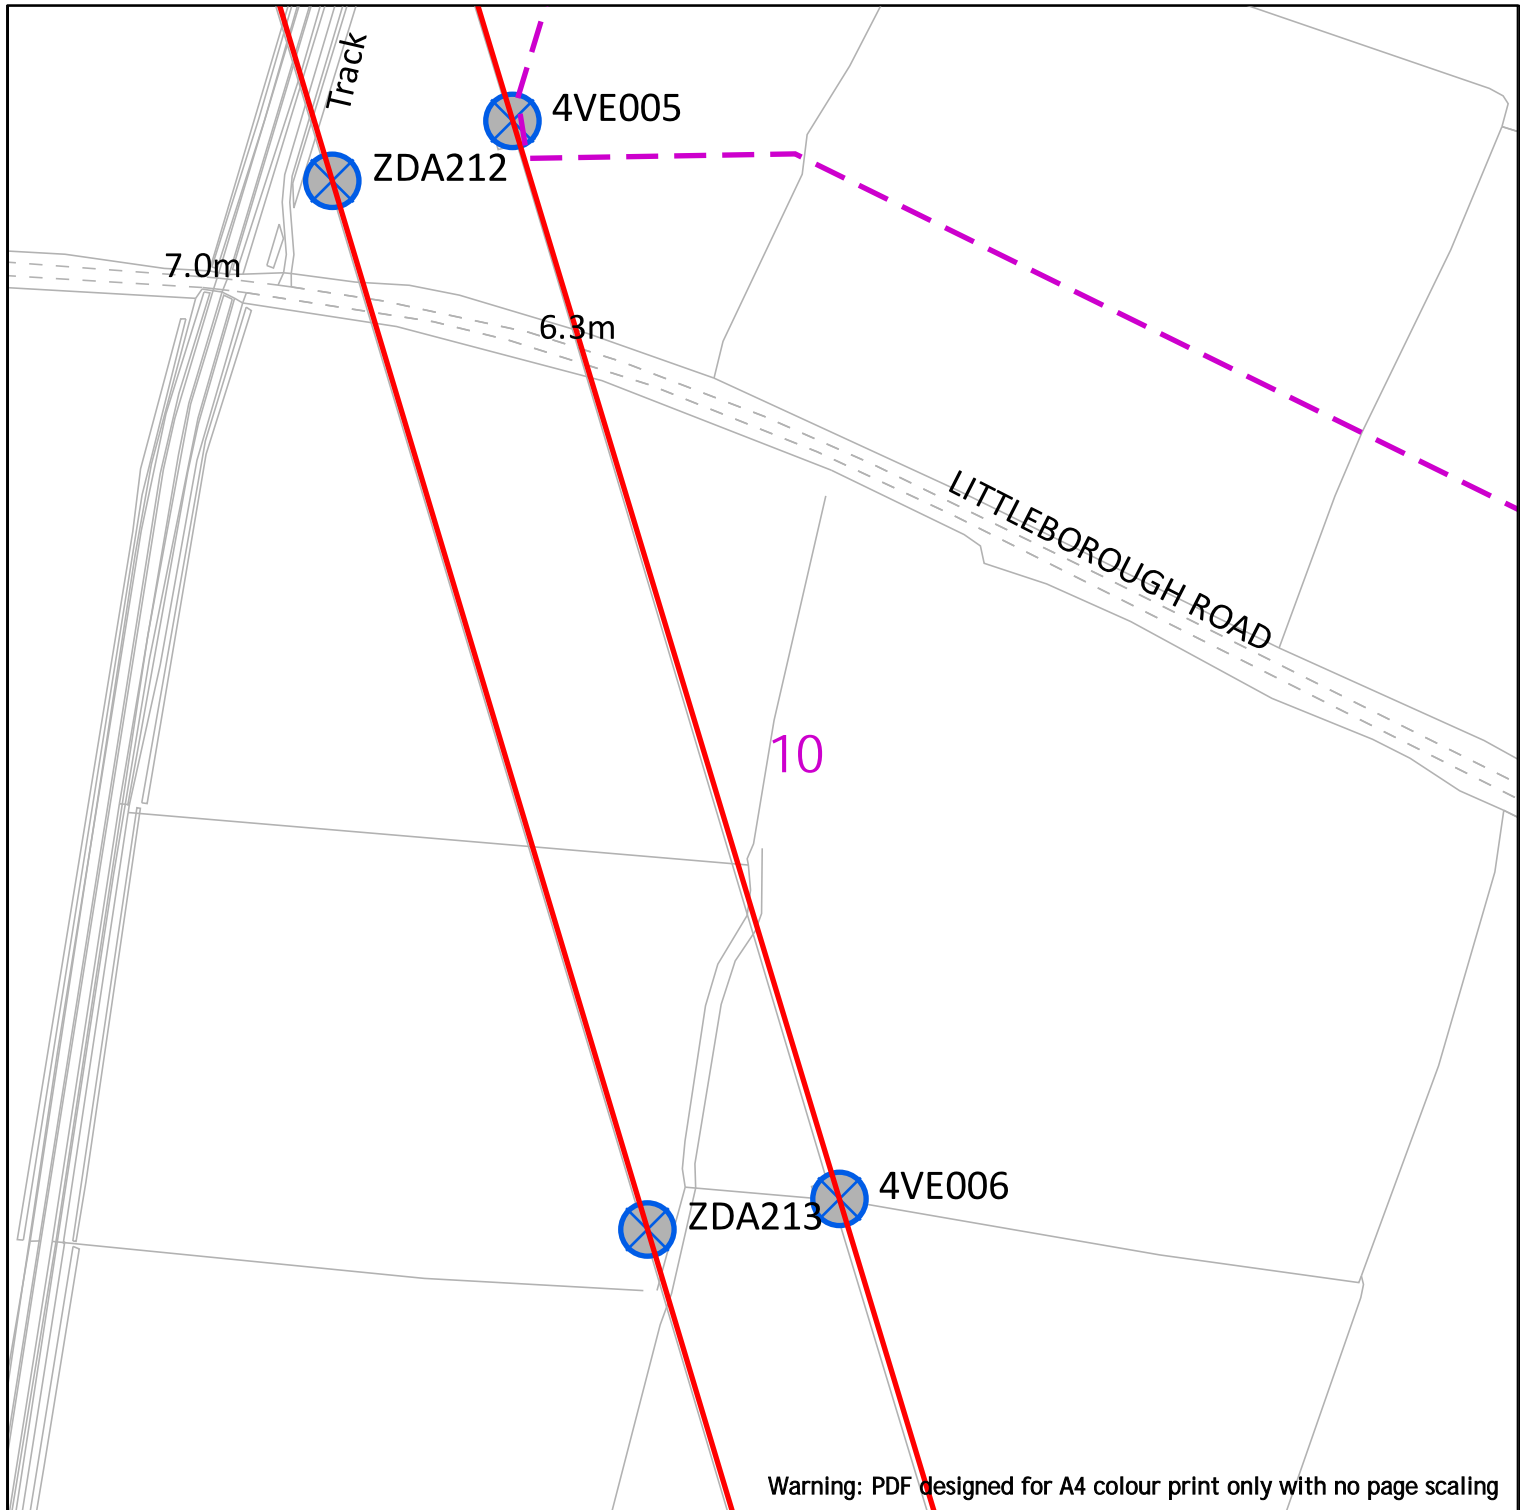

Warning: PDF designed for A4 colour print only with no page scaling



**EXTREME CAUTION - HIGH VOLTAGE
RISK OF DEATH OR SERIOUS INJURY**

NationalGrid House
Warwick Technology Park
Gallows Hill
Warwick
CV34 6DA

AssetProtection@NationalGrid.com

Date Requested: 08/05/2023
Job Reference: 29406937
Site Location: 479891 384296
Requested by: Mr Ben Evans

Your Scheme/Reference: LM
203570/DK - 4


Dig Sites: Area: Line:

Underground Cables
 Overhead Lines
 Fibre Cables

IMPORTANT NOTICES
This plan shows those pipes owned by National Grid Electricity Transmission plc in its role as a Licensed Electricity Transporter (ET). Electricity cables owned by other ETs, or otherwise privately owned, may be present in this area. Information with regards to such cables should be obtained from the relevant owners. The information shown on this plan is given without warranty, the accuracy thereof cannot be guaranteed. Ancillary equipment such as cooling systems and communication cables are not shown but their presence should be anticipated. No liability of any kind whatsoever is accepted by National Grid Electricity Transmission plc or their agents, servants or contractors for any error or omission. Safe digging practices, in accordance with HS(G)47, must be used to verify and establish the actual position of cables and other apparatus on site before any mechanical plant is used. It is your responsibility to ensure that this information is provided to all persons (either direct labour or contractors) working for you on or near electricity apparatus. The information included on this plan should not be referred to beyond a period of 28 days from the date of issue.

National Grid Electricity Emergency Number: 0800 40 40 90
Available 24 hours, 7 days/week. Calls may be recorded and monitored

Scale: 1:2500 (When plotted at A4)

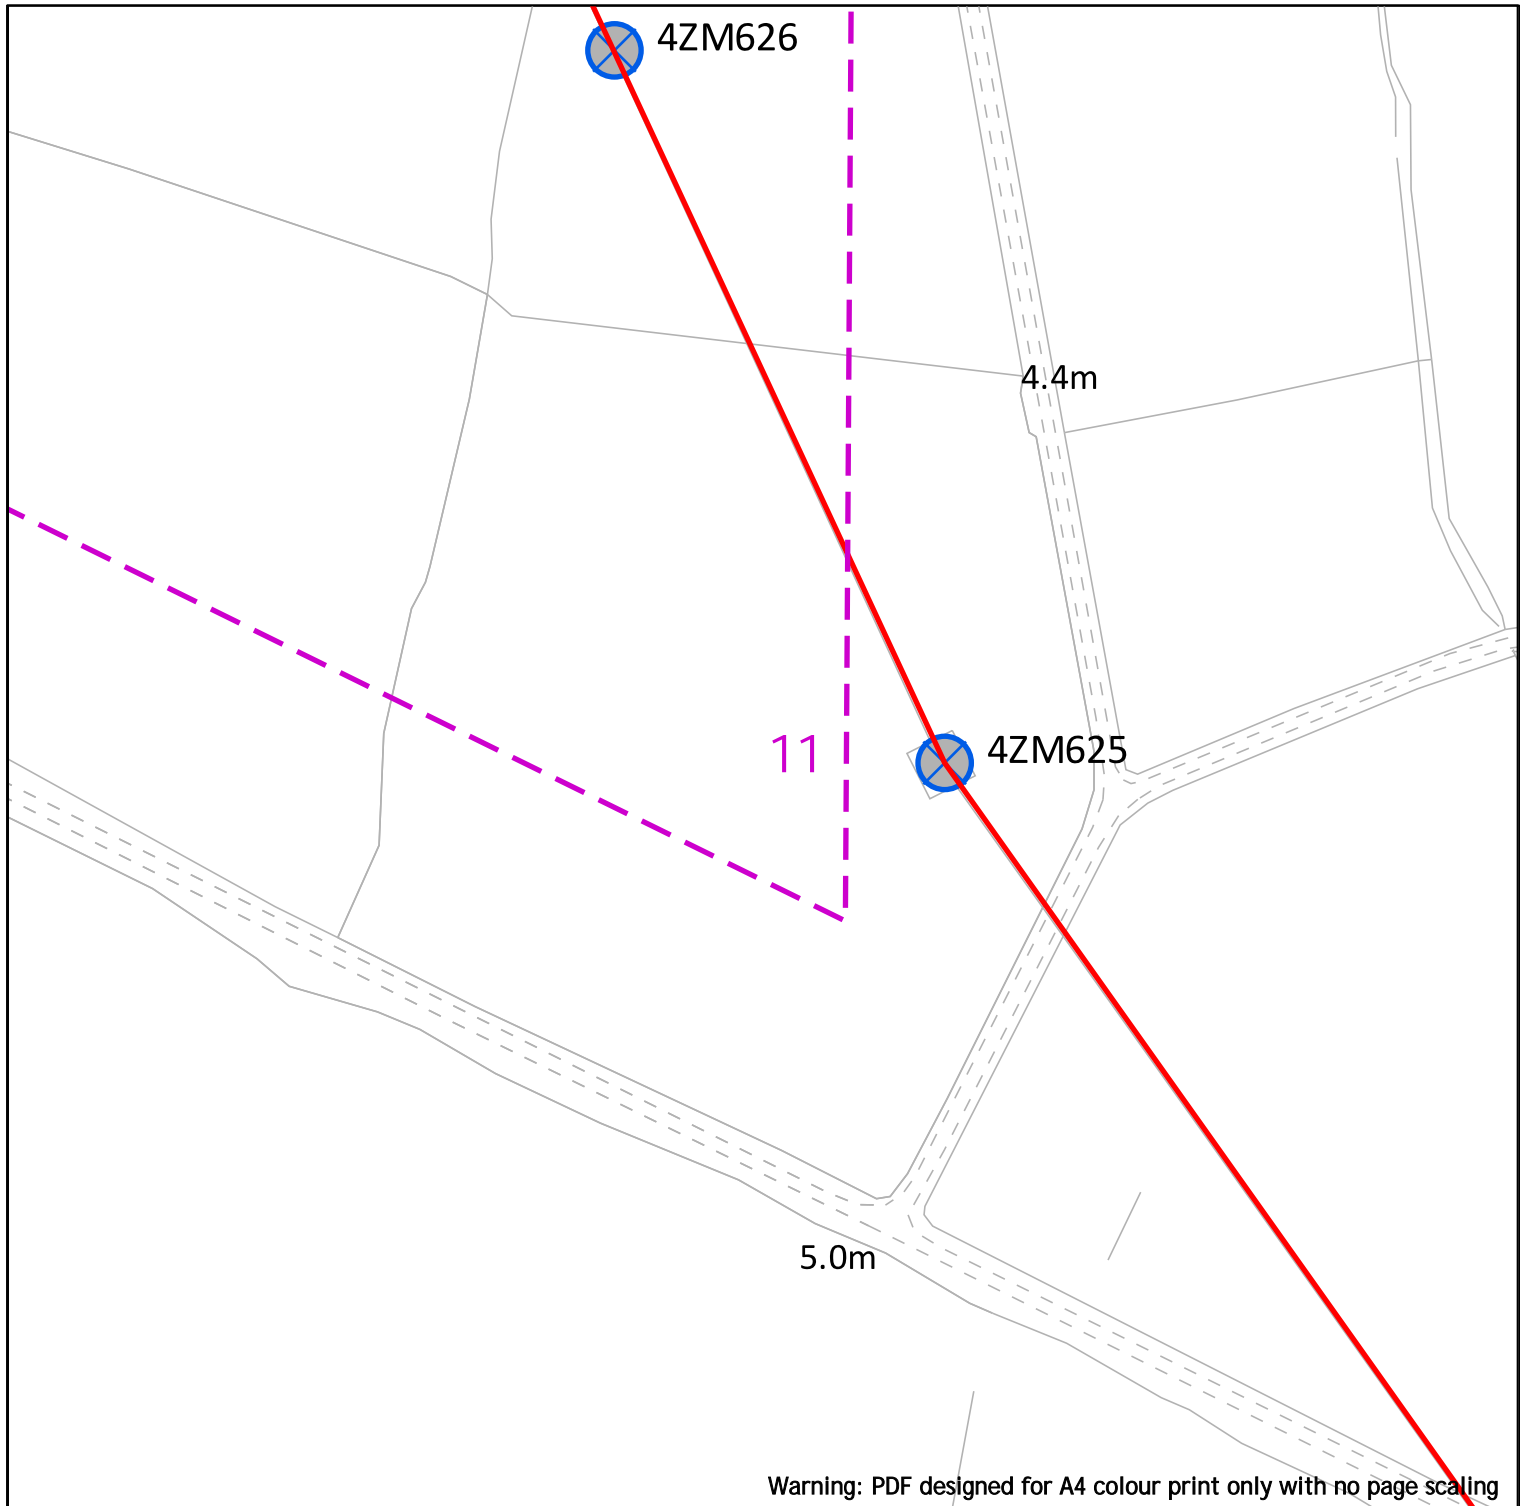

Warning: PDF designed for A4 colour print only with no page scaling

nationalgrid



**EXTREME CAUTION - HIGH VOLTAGE
RISK OF DEATH OR SERIOUS INJURY**

NationalGrid House
Warwick Technology Park
Gallows Hill
Warwick
CV34 6DA

AssetProtection@NationalGrid.com

Dig Sites: Area: Line:

Underground Cables
 Overhead Lines
 Fibre Cables

Date Requested: 08/05/2023
Job Reference: 29406937
Site Location: 479891 384296
Requested by: Mr Ben Evans

Your Scheme/Reference: LM
203570/DK - 4

IMPORTANT NOTICES
This plan shows those pipes owned by National Grid Electricity Transmission plc in its role as a Licensed Electricity Transporter (ET). Electricity cables owned by other ETs, or otherwise privately owned, may be present in this area. Information with regards to such cables should be obtained from the relevant owners. The information shown on this plan is given without warranty, the accuracy thereof cannot be guaranteed. Ancillary equipment such as cooling systems and communication cables are not shown but their presence should be anticipated. No liability of any kind whatsoever is accepted by National Grid Electricity Transmission plc or their agents, servants or contractors for any error or omission. Safe digging practices, in accordance with HS(G)47, must be used to verify and establish the actual position of cables and other apparatus on site before any mechanical plant is used. It is your responsibility to ensure that this information is provided to all persons (either direct labour or contractors) working for you on or near electricity apparatus. The information included on this plan should not be referred to beyond a period of 28 days from the date of issue.

National Grid Electricity Emergency Number: 0800 40 40 90
Available 24 hours, 7 days/week. Calls may be recorded and monitored

Scale: 1:2500 (When plotted at A4)

ENQUIRY SUMMARY

Received Date

08/05/2023 9:33

Work Start Date

30/05/2023

Your Reference

LM 203570/DK - 4

Location

Centre Point: 479891 384296

X Extent:

Y Extent:

Postcode: DN229HH

Map Options

Paper Size: A4

Orientation: PORTRAIT

Scale: 1:2500

Real World Extents: 1568m x 1602m

Enquirer Details

Organisation Name: Atkins - Utility Solutions

Contact Name: Ben Evans

Email Address: searches.utilitysolutions@atkinglobal.com

Telephone: 01454662086

Address: The Hub, 500 Park Avenue, Aztec West, , Bristol, BS32 4RZ

Enquiry Type

Initial Enquiry

Activity Type

Utility Works



Work Types

Single excavations site (deeper than 1.5m)

Notes/Works Description (if supplied)

Site Contact Name (if supplied)

Site Contact Number (if supplied)

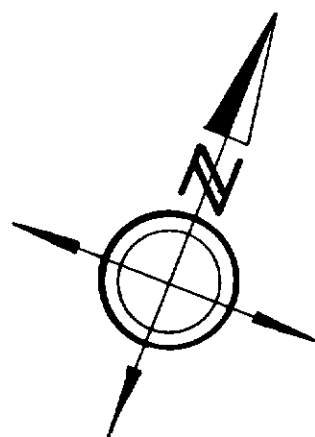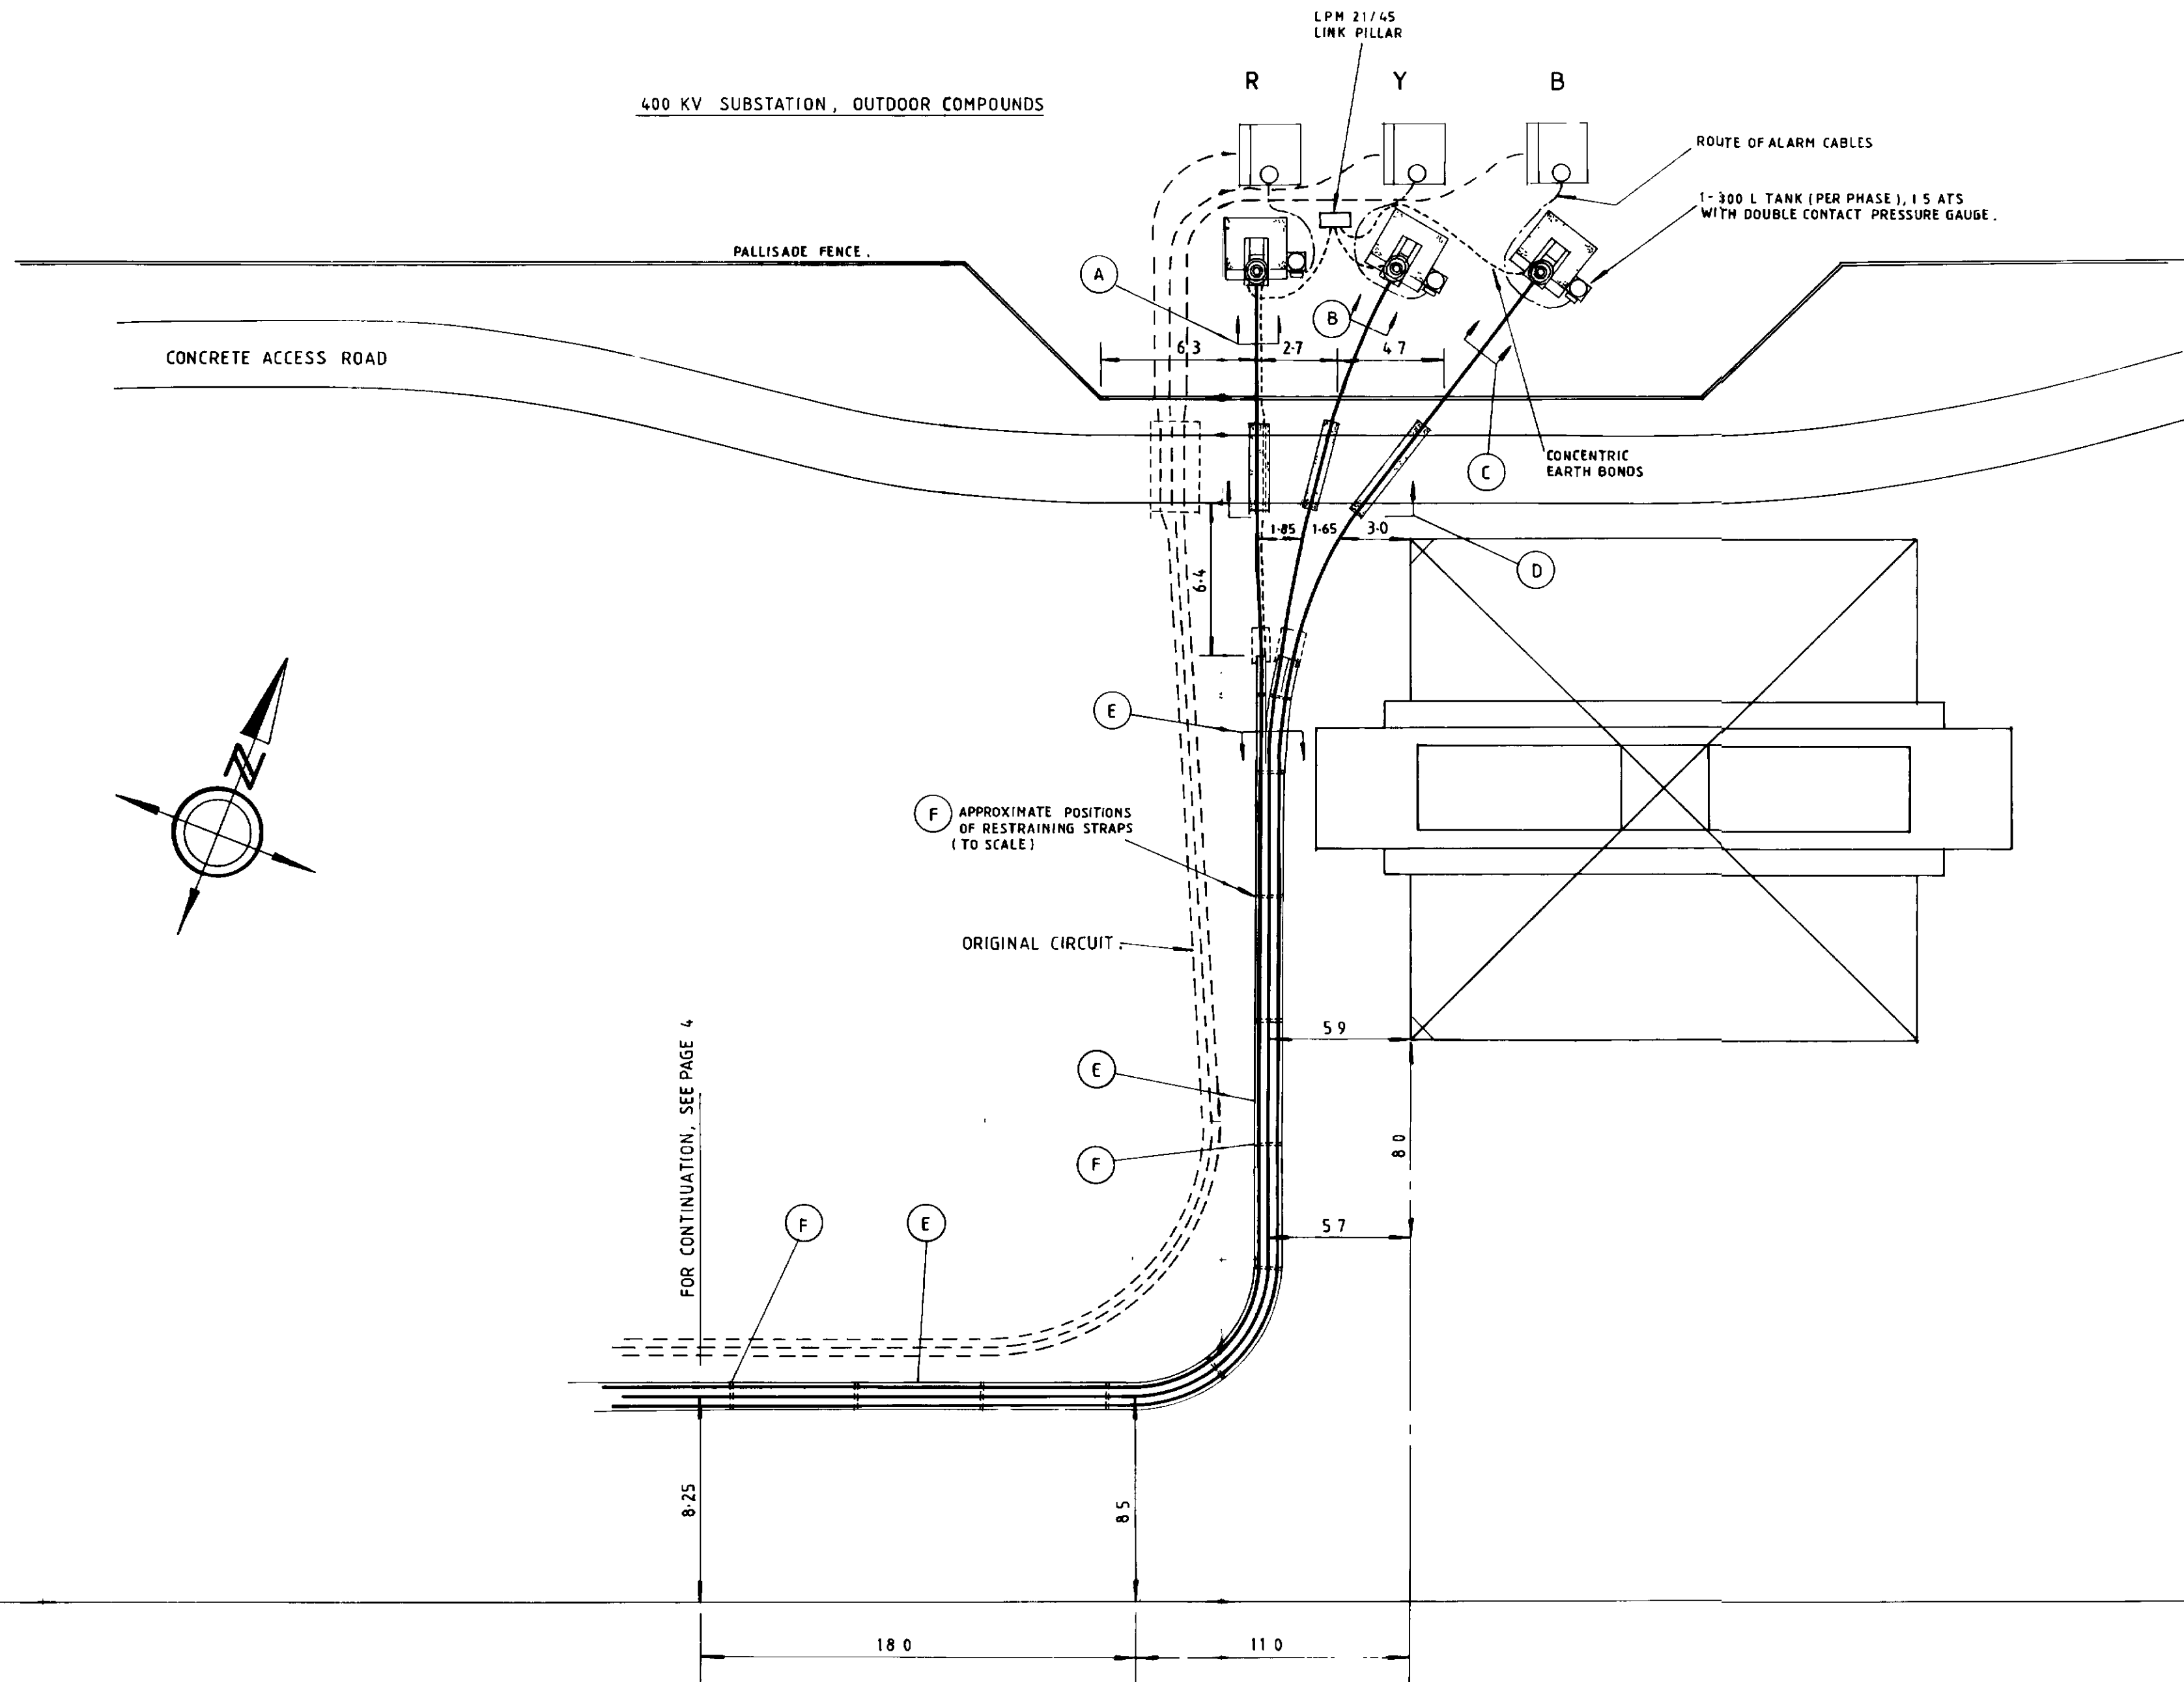


NATIONAL GRID CO.

WEST BURTON, 400 KV SUBSTATION.
400 KV HIGH MARNHAM CIRCUIT,
DUPLICATE UNDERGROUND CABLES

DRAWN	S.P.	DATE	9/10/96
CHECKED	JCA	DATE	27-2-77
N.G.C. CONTRACT No.	C/CCN/CA018		
PIRELLI CONTRACT No.	ABM C50		

SCALE: 1/200
DRG No.
KM-C50/P3

MN 70/17299 SHT3

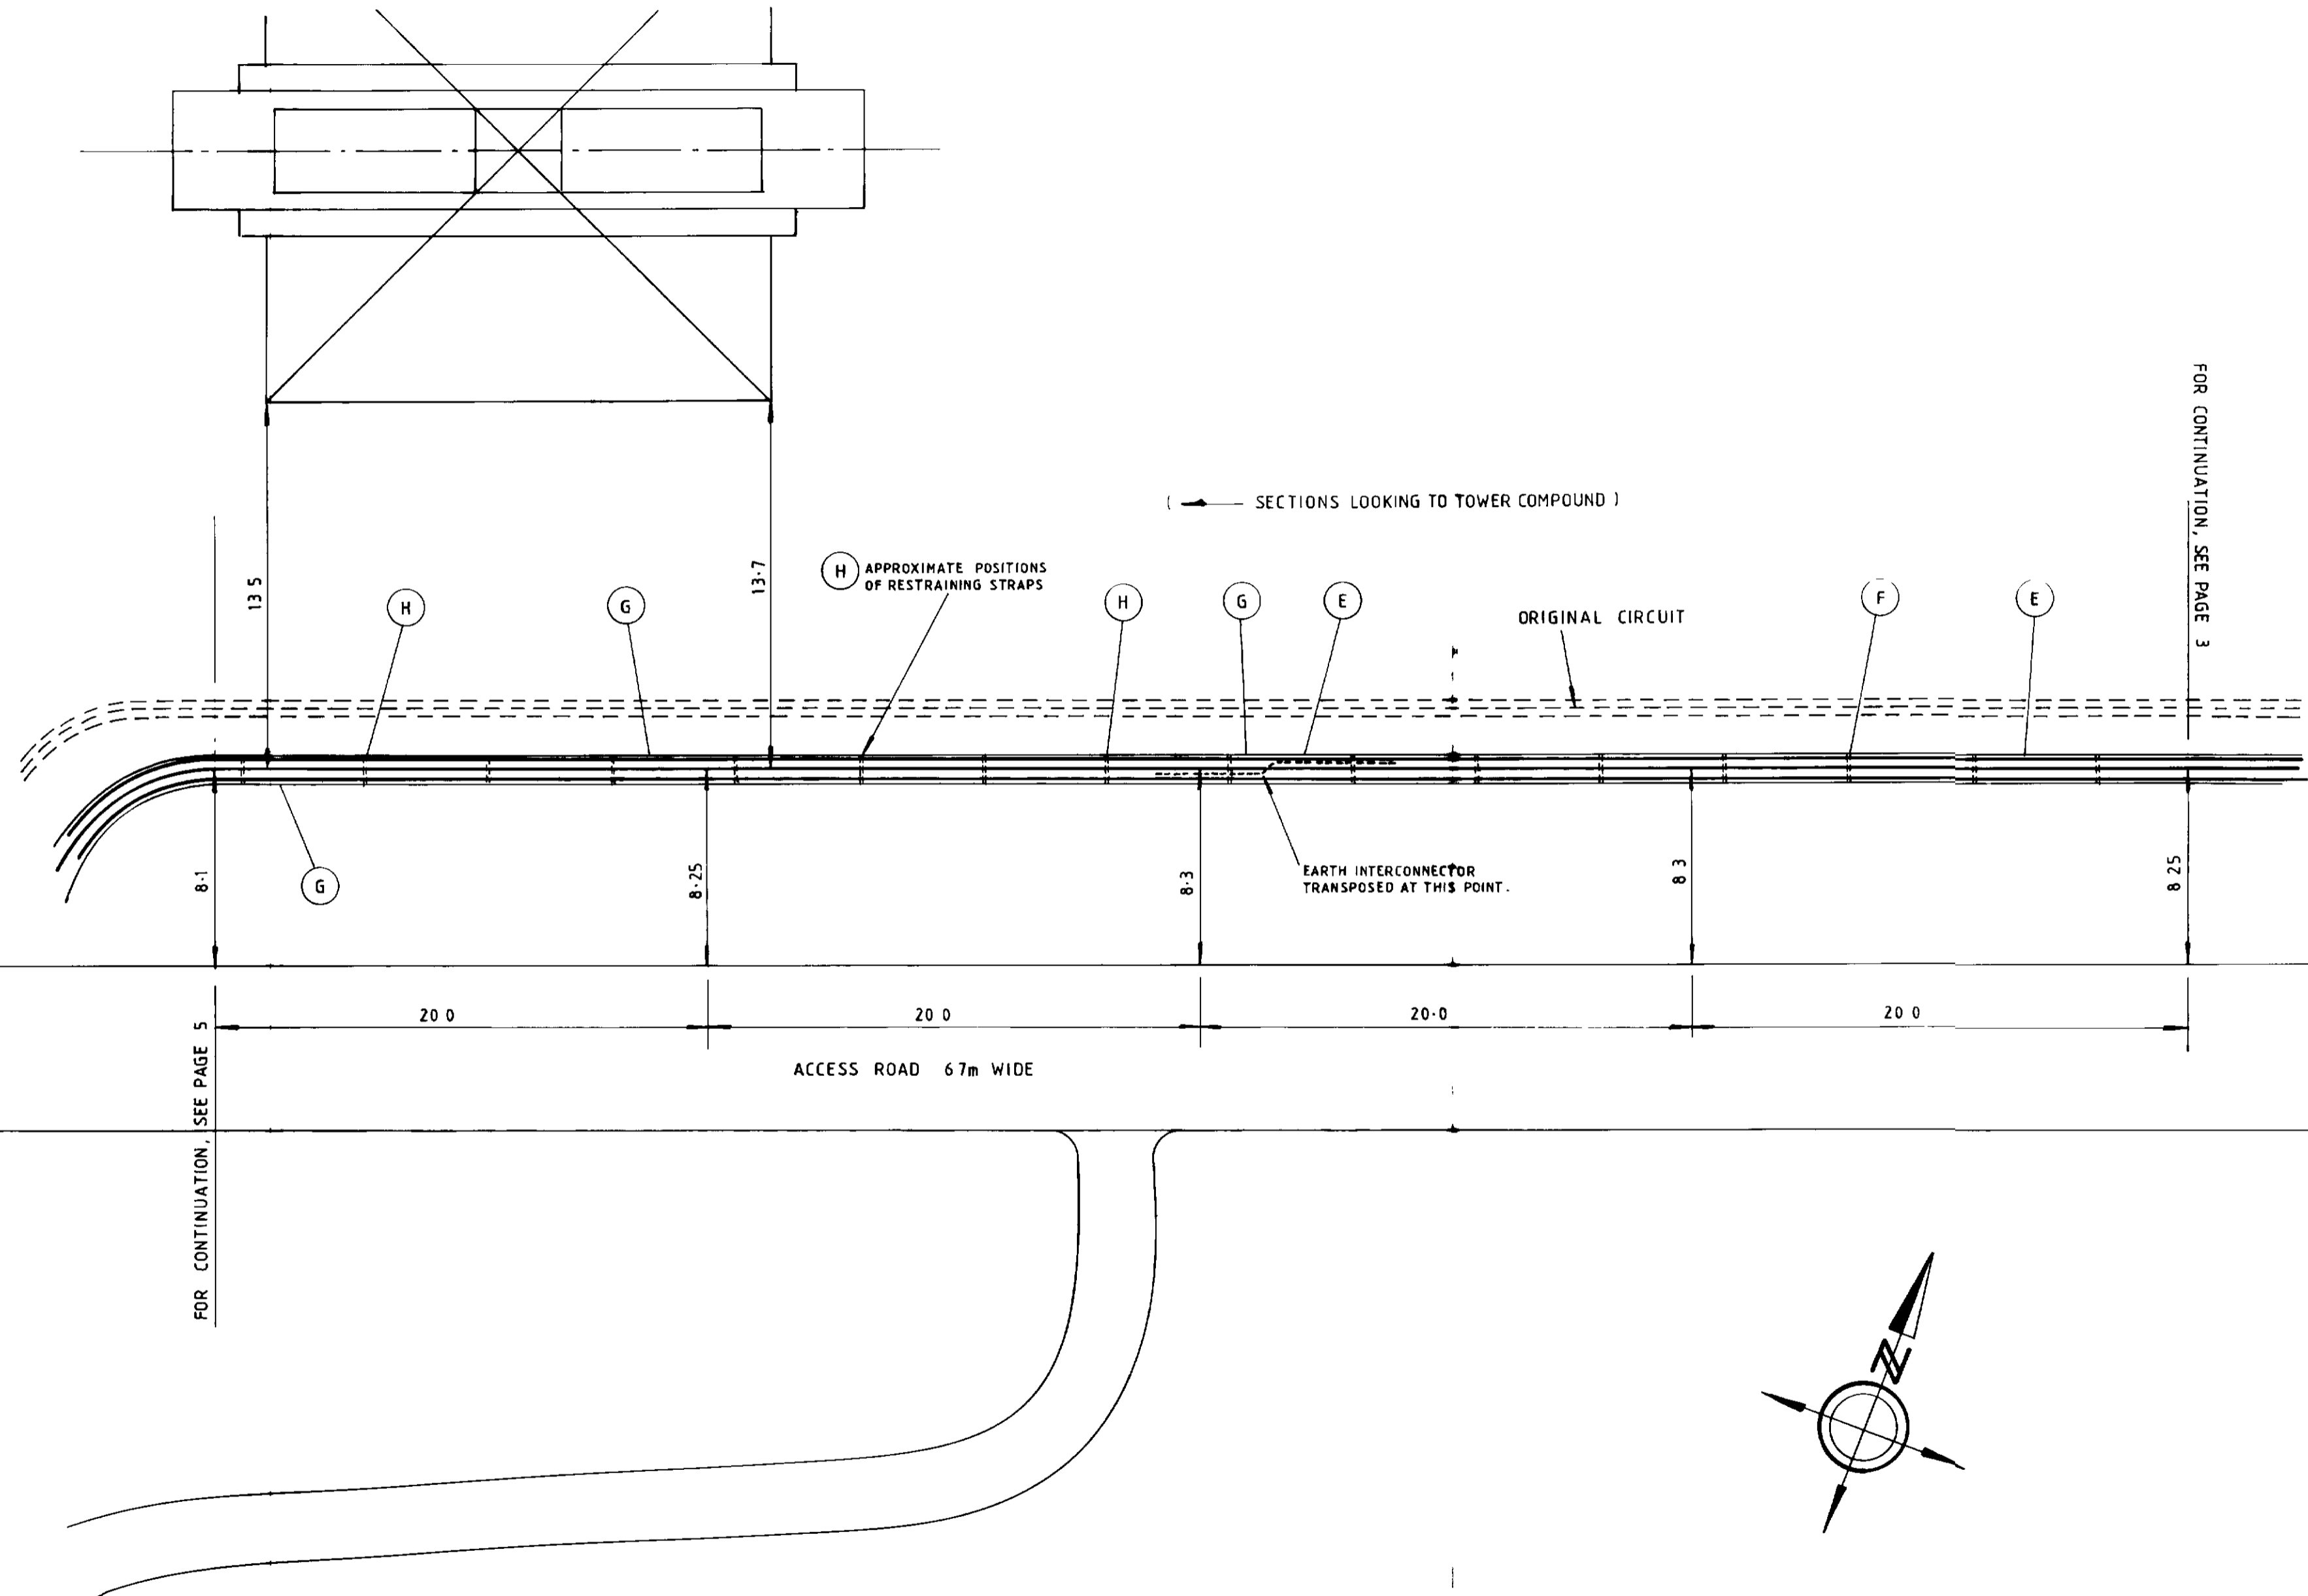

FOR CONTINUATION, SEE PAGE 5

FOR CONTINUATION, SEE PAGE 3


(← SECTIONS LOOKING TO TOWER COMPOUND)

(H) APPROXIMATE POSITIONS OF RESTRAINING STRAPS

ORIGINAL CIRCUIT

EARTH INTERCONNECTOR TRANSPOSED AT THIS POINT.

ACCESS ROAD 67m WIDE


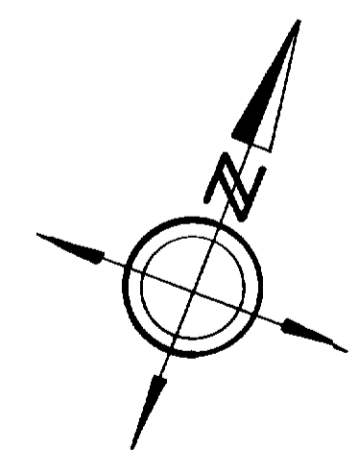


NATIONAL GRID CO.

WEST BURTON, 400 KV SUBSTATION.
400 KV HIGH MARNHAM CIRCUIT,
DUPLICATE UNDERGROUND CABLES

DRAWN	S.P.	DATE	8/10/96
CHECKED	JCA	DATE	27-2-97
N.G.C. CONTRACT No.	C/CCN/CA018		
PIRELLI CONTRACT No.	ABM C50		

SCALE: 1/200
DRG No.
KM-C50/P4

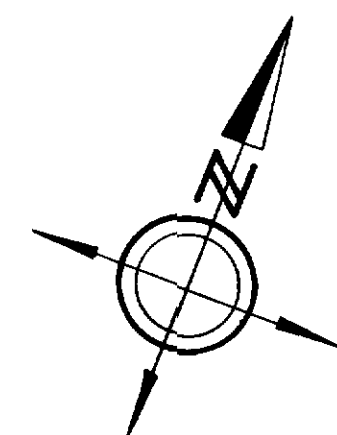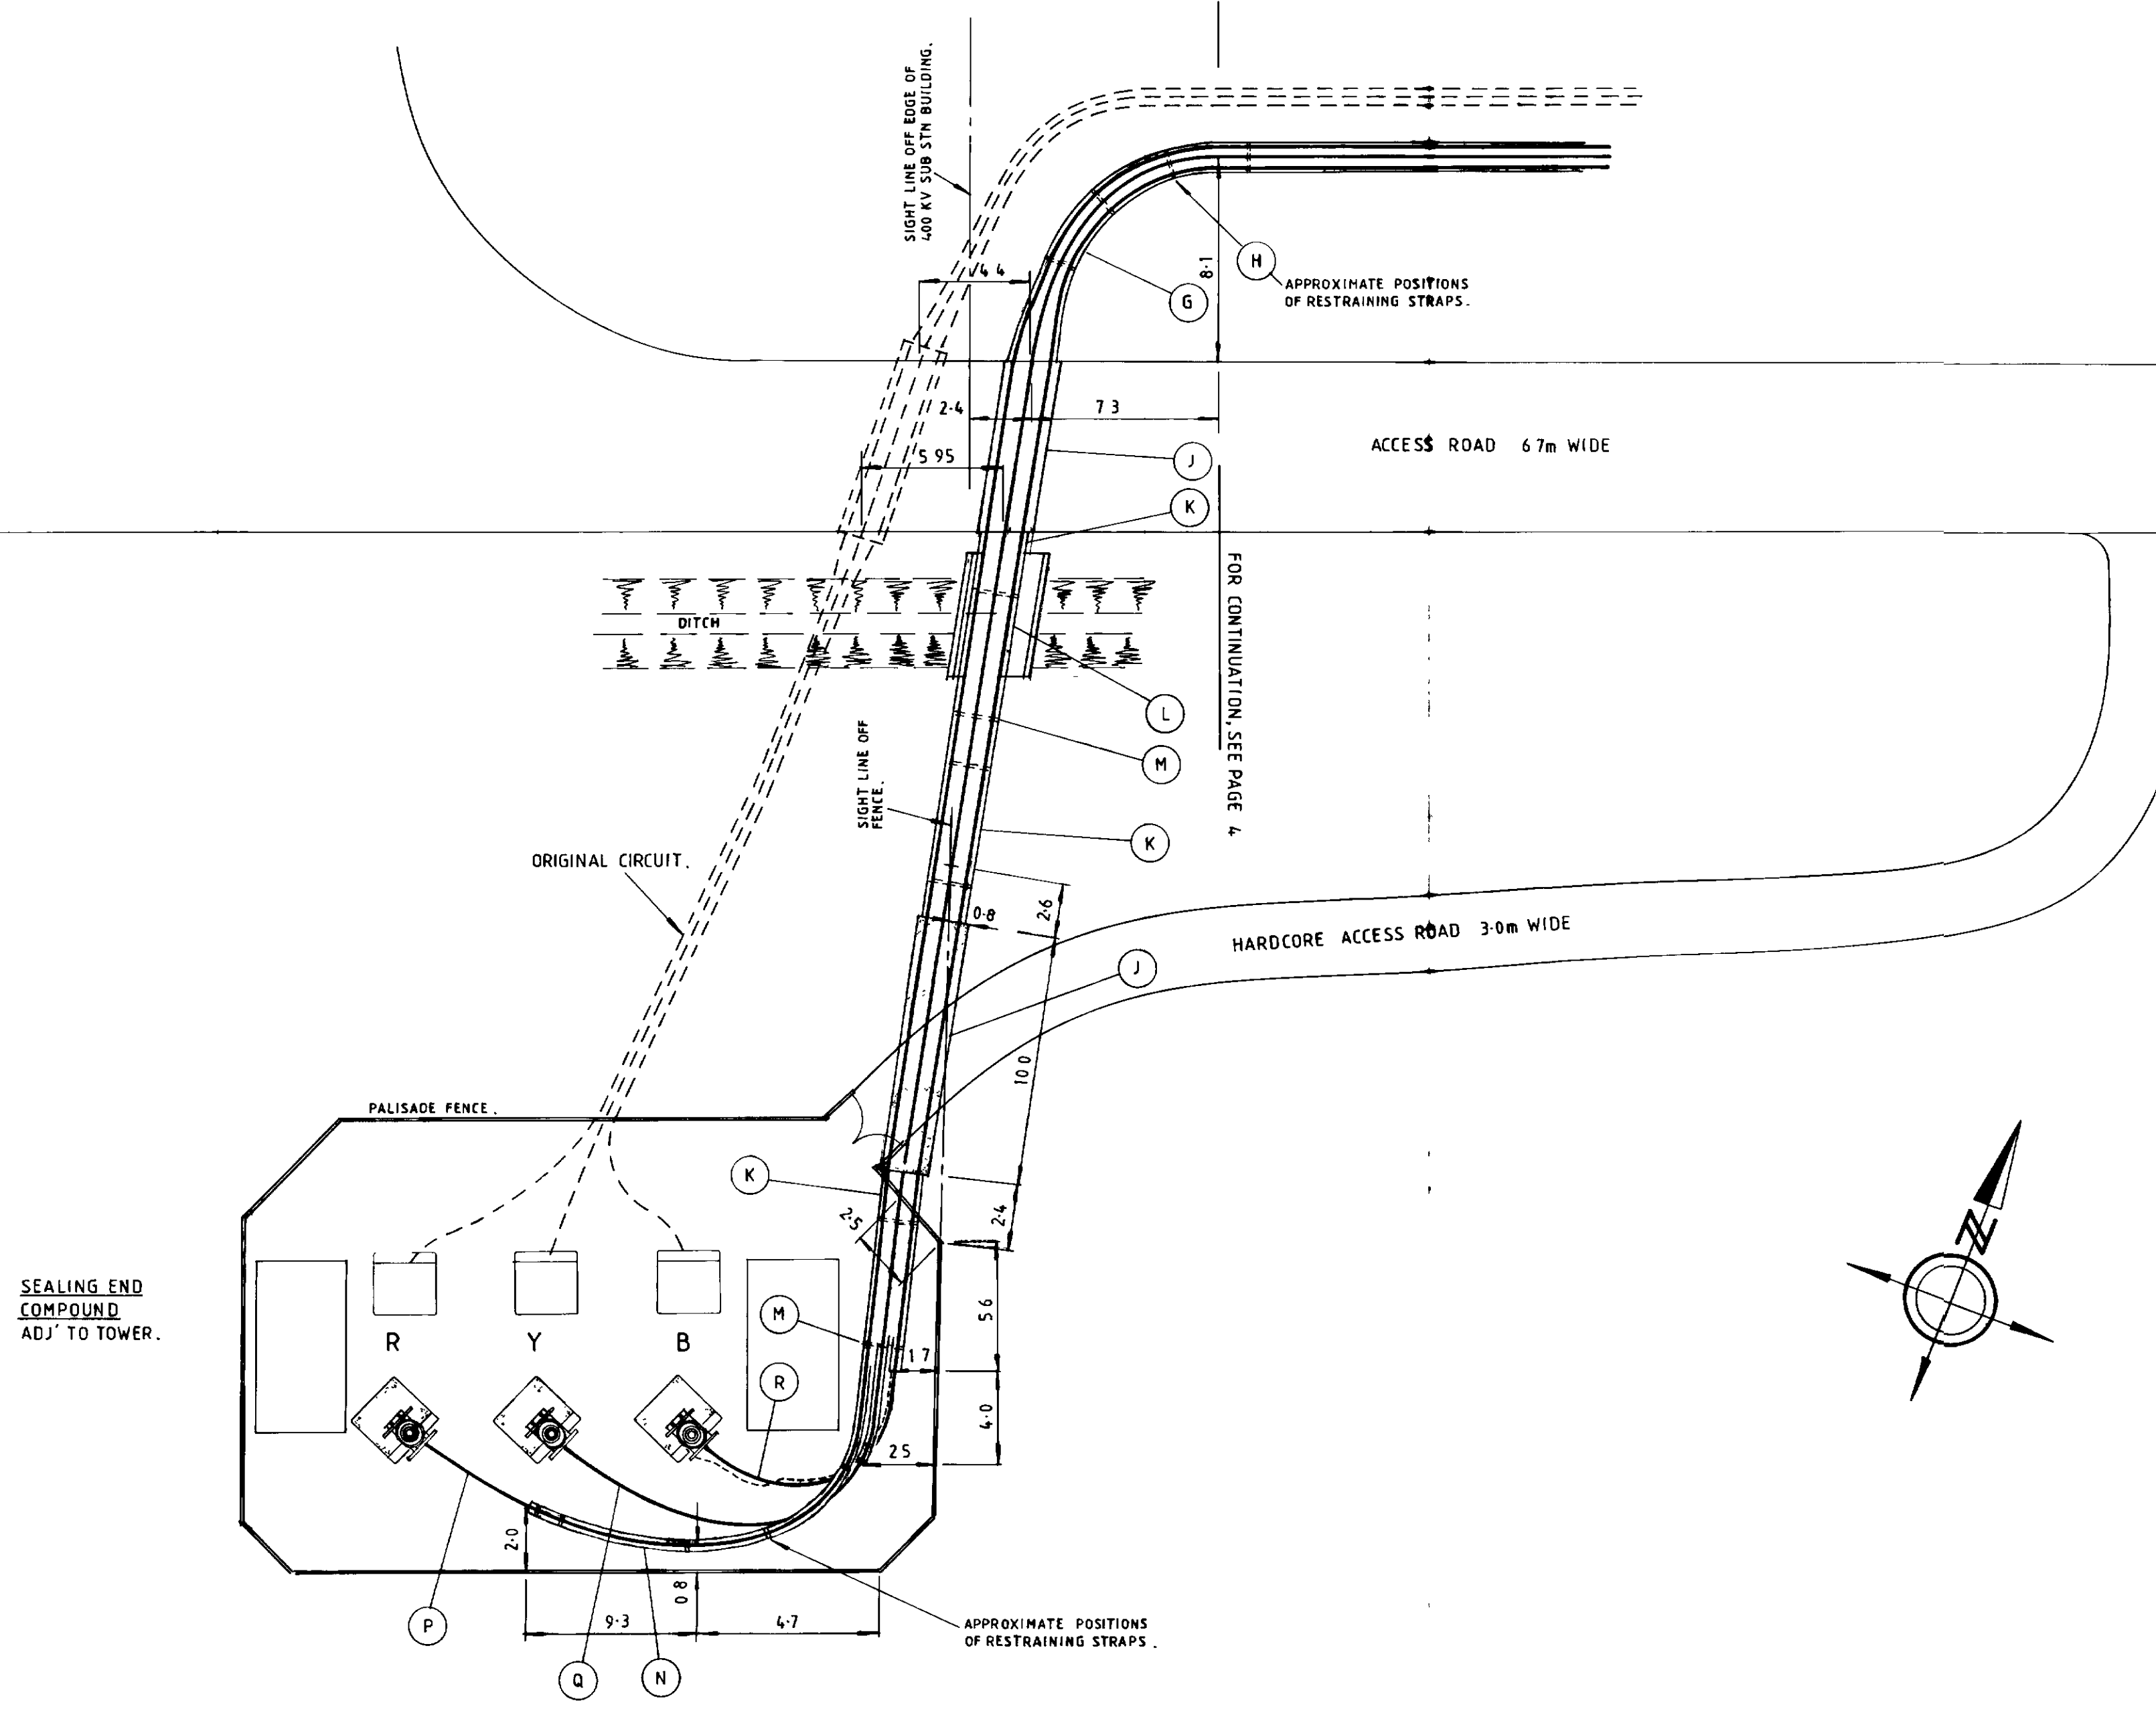


NATIONAL GRID CO.

WEST BURTON, 400 KV SUBSTATION.
400 KV HIGH MARNHAM CIRCUIT,
DUPLICATE UNDERGROUND CABLES





DRAWN	S.P.	DATE	7/10/96	SCALE:	1/200
CHECKED	SCA	DATE	27-2-97	DRG No.	
N.G.C. CONTRACT No.	C/CCN/CA018				
PIRELLI CONTRACT No.	ABM C50		KM-C50/P5		

70/17299 SHT5 [MN]

ALL SECTIONS LOOKING TO TOWER COMPOUND EXCEPT SECTIONS A,B,C & D

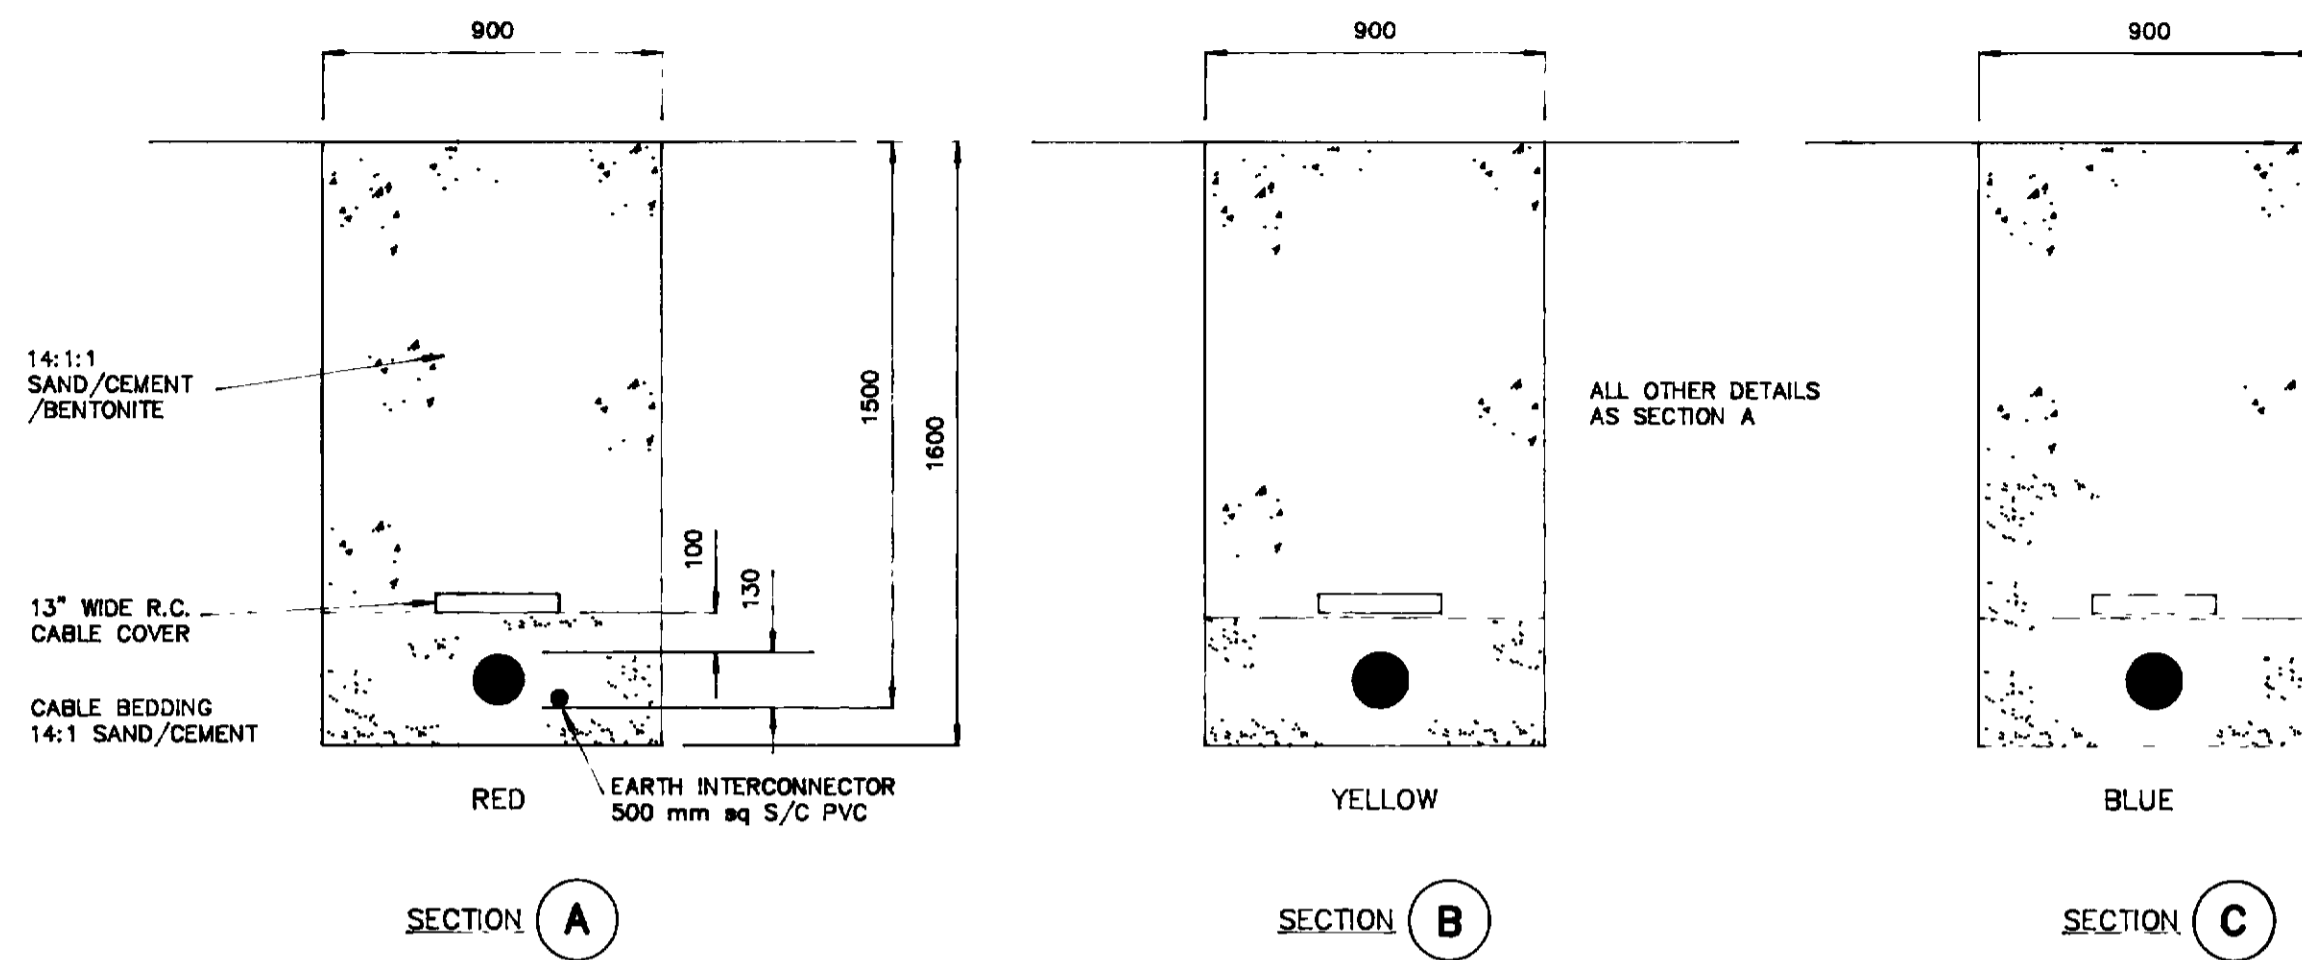

ALL OTHER DETAILS AS SECTION A

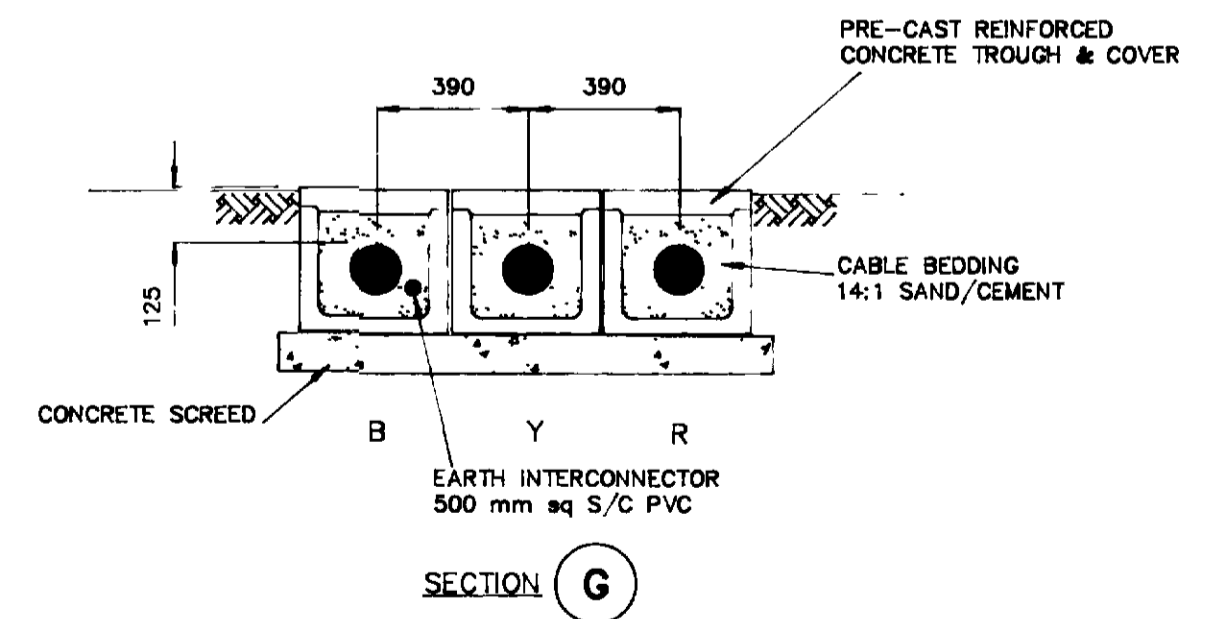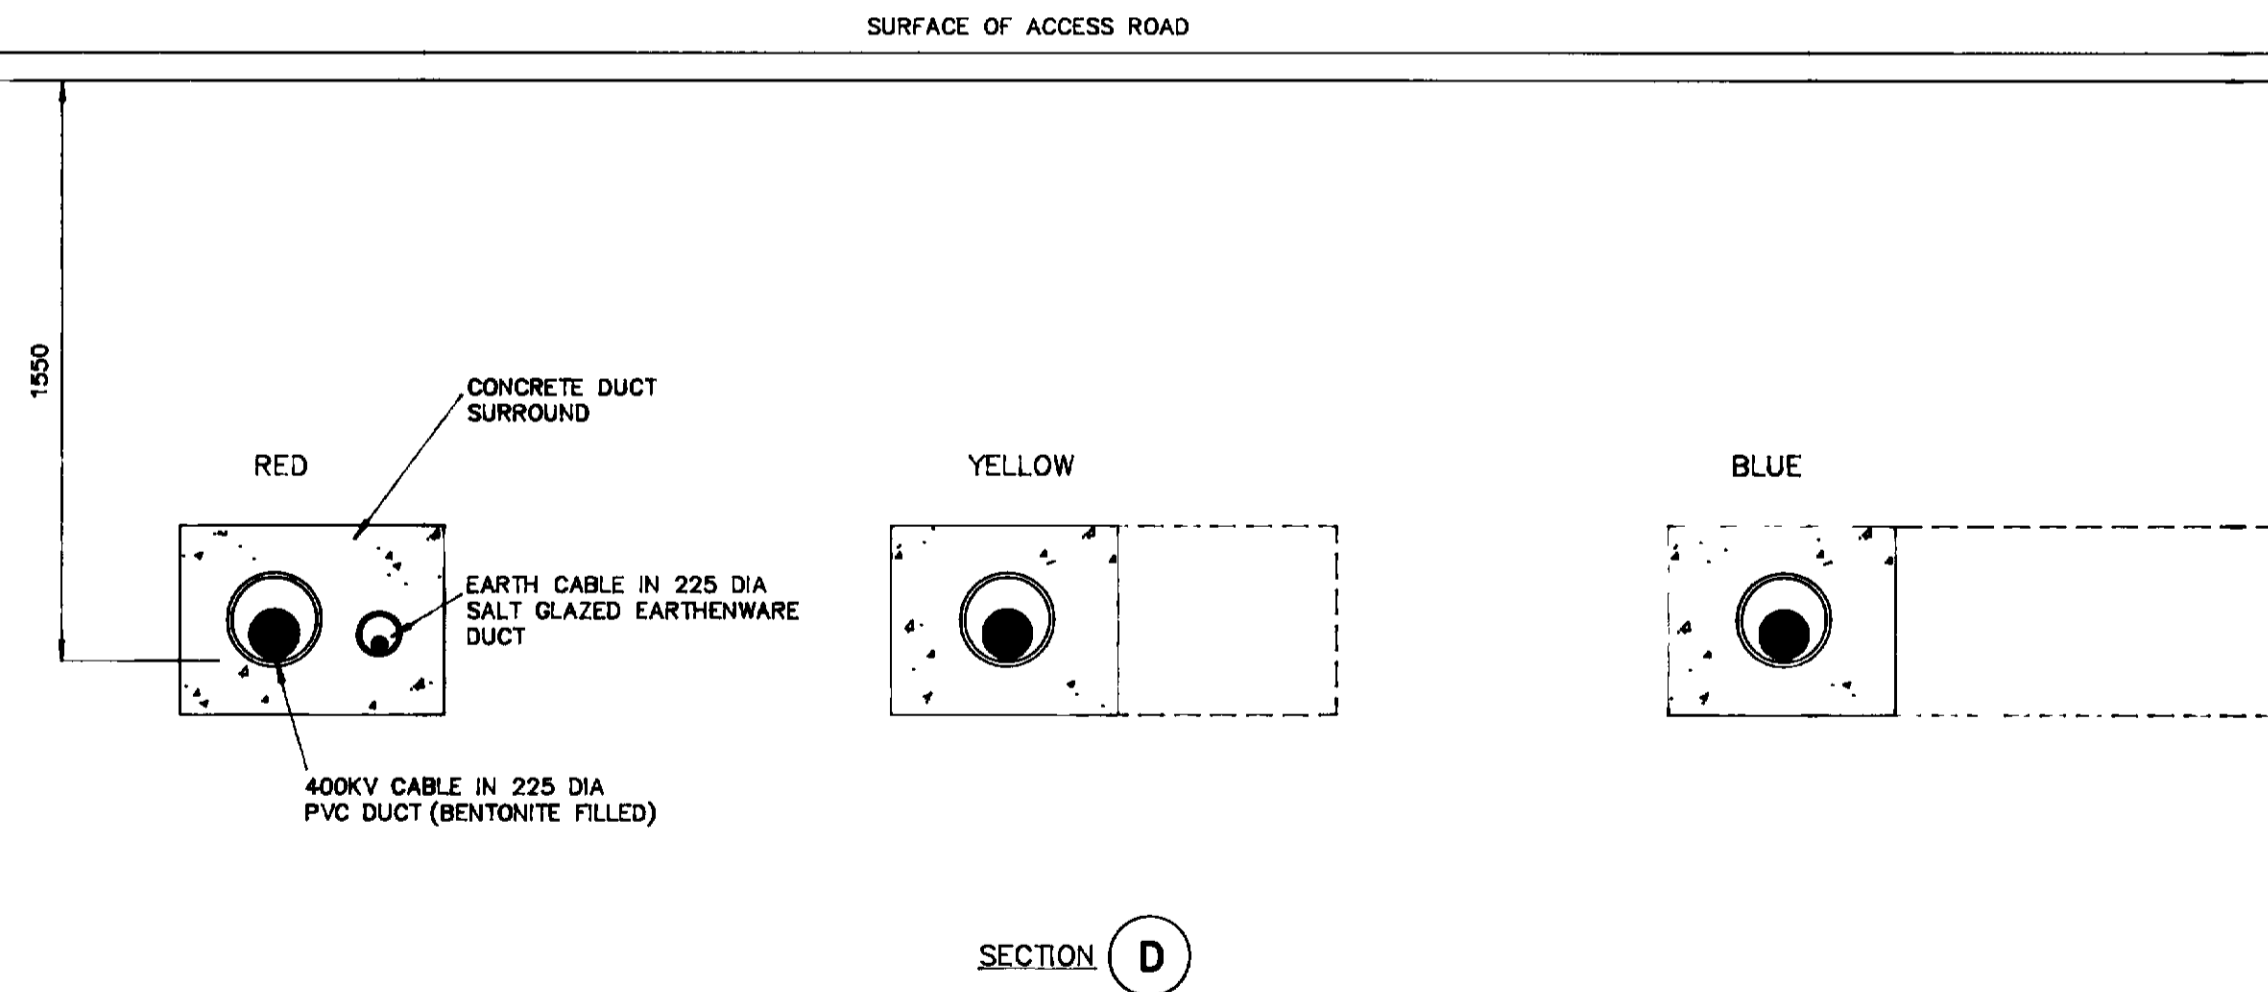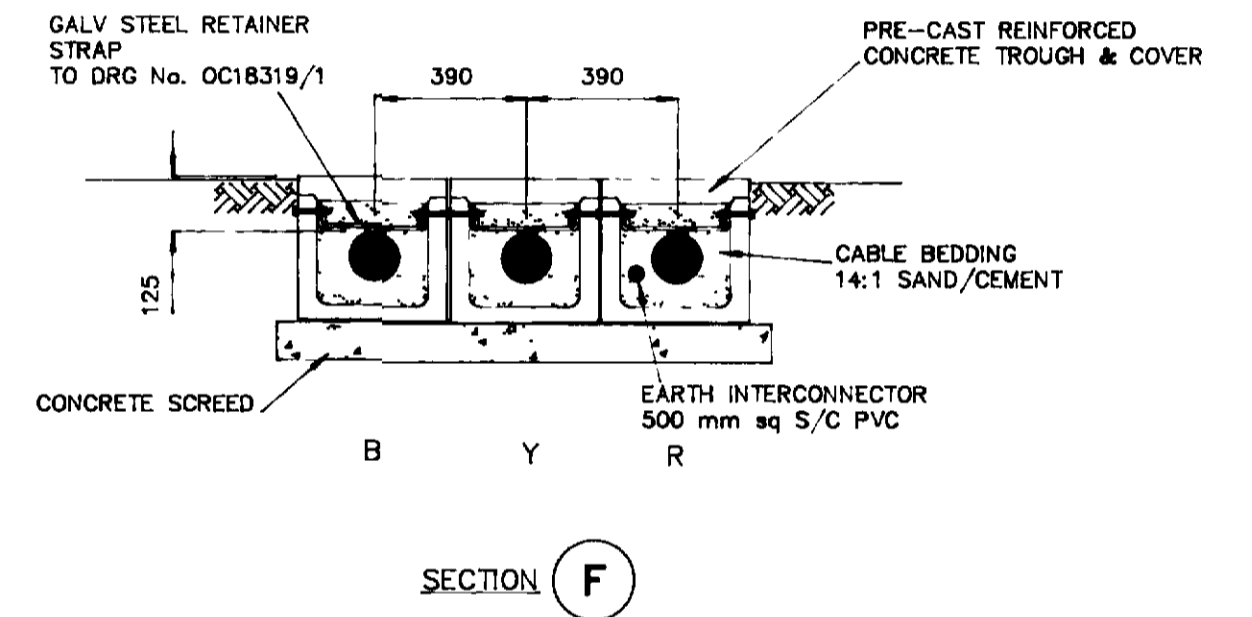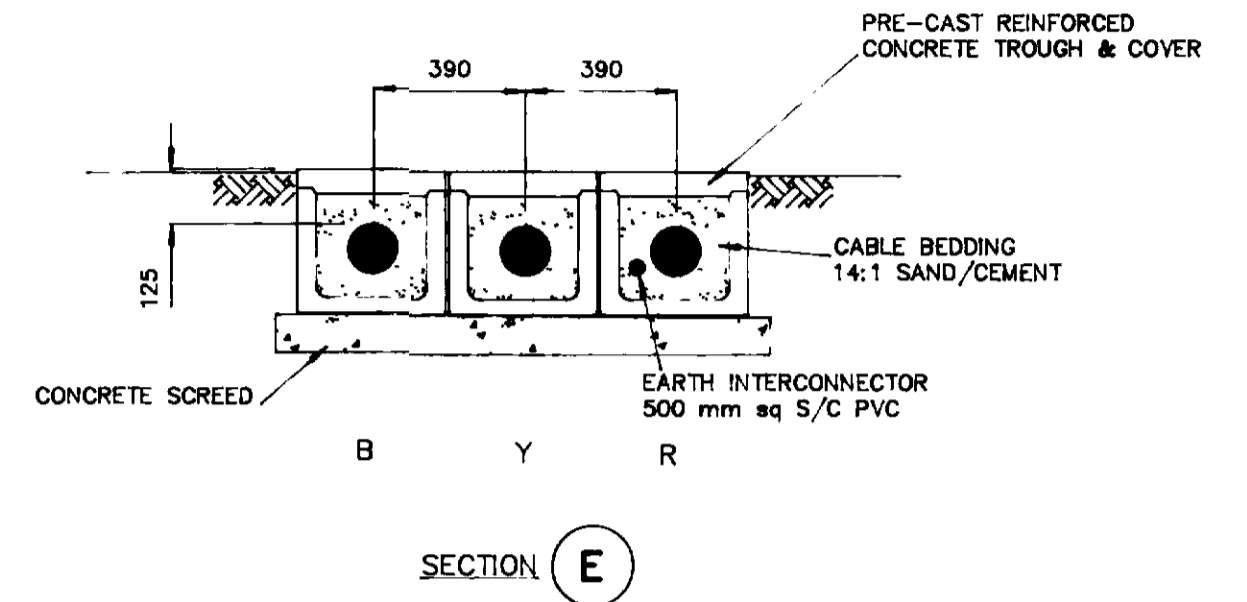










NATIONAL GRID CO.

WEST BURTON, 400 KV SUBSTATION.
400 KV HIGH MARNHAM CIRCUIT,
DUPLICATE UNDERGROUND CABLES

DRAWN	S.P.	DATE	11-11-96	SCALE:	1/20
CHECKED	JCA	DATE	27-2-97	DRG No.	
N.G.C. CONTRACT No	C/CCN/CA018				
PIRELLI CONTRACT No	ABM C50				

KM-C50/P6

70/17299 SHT6

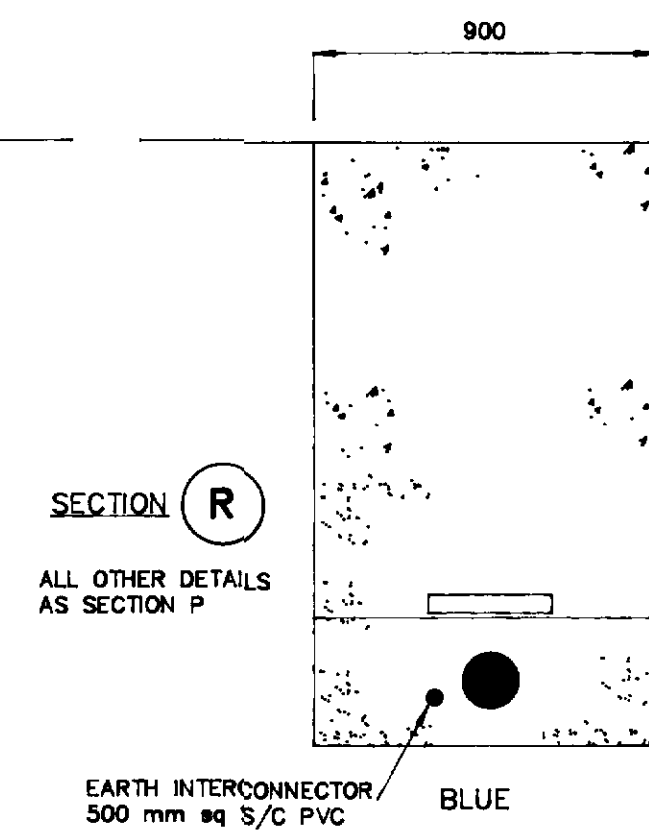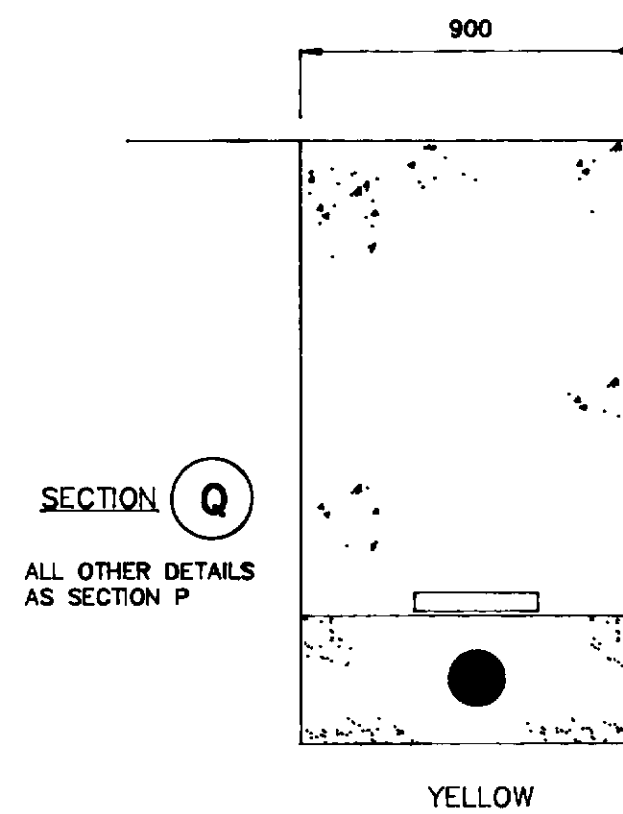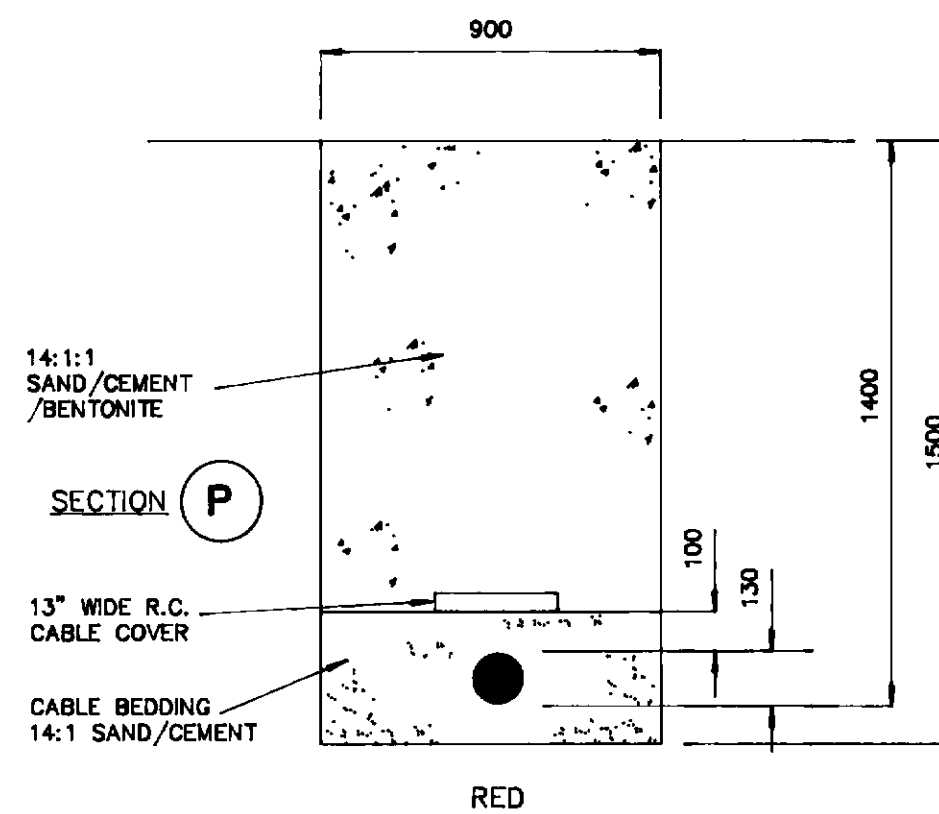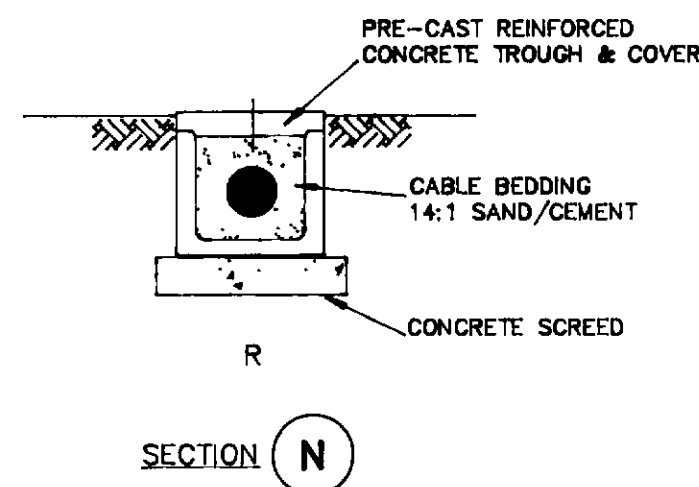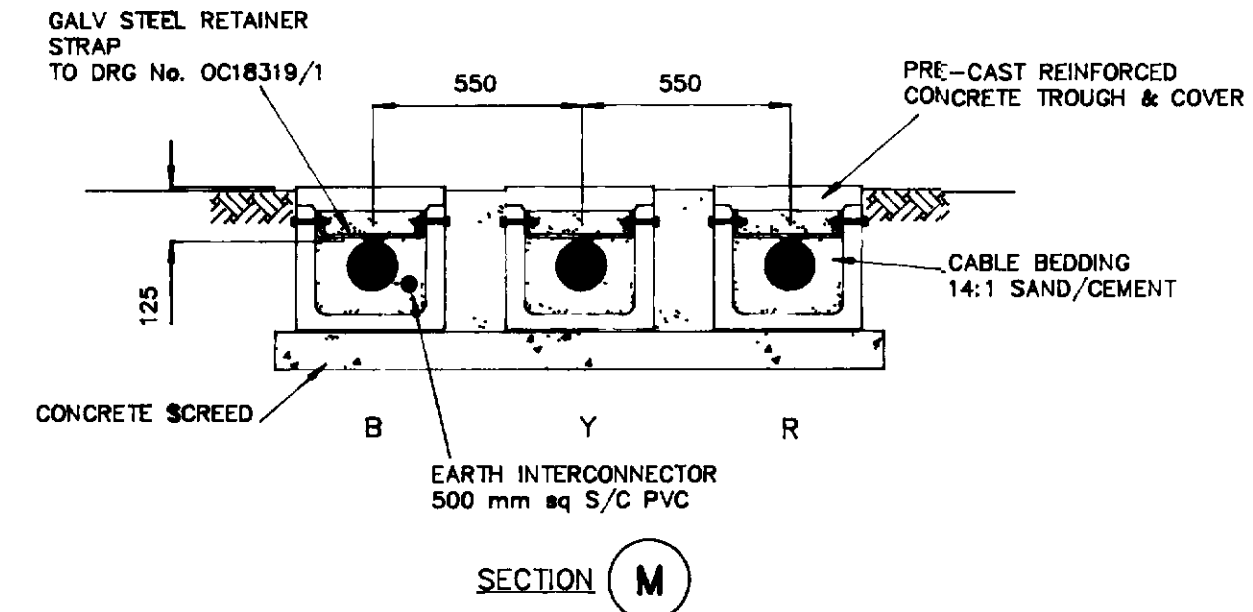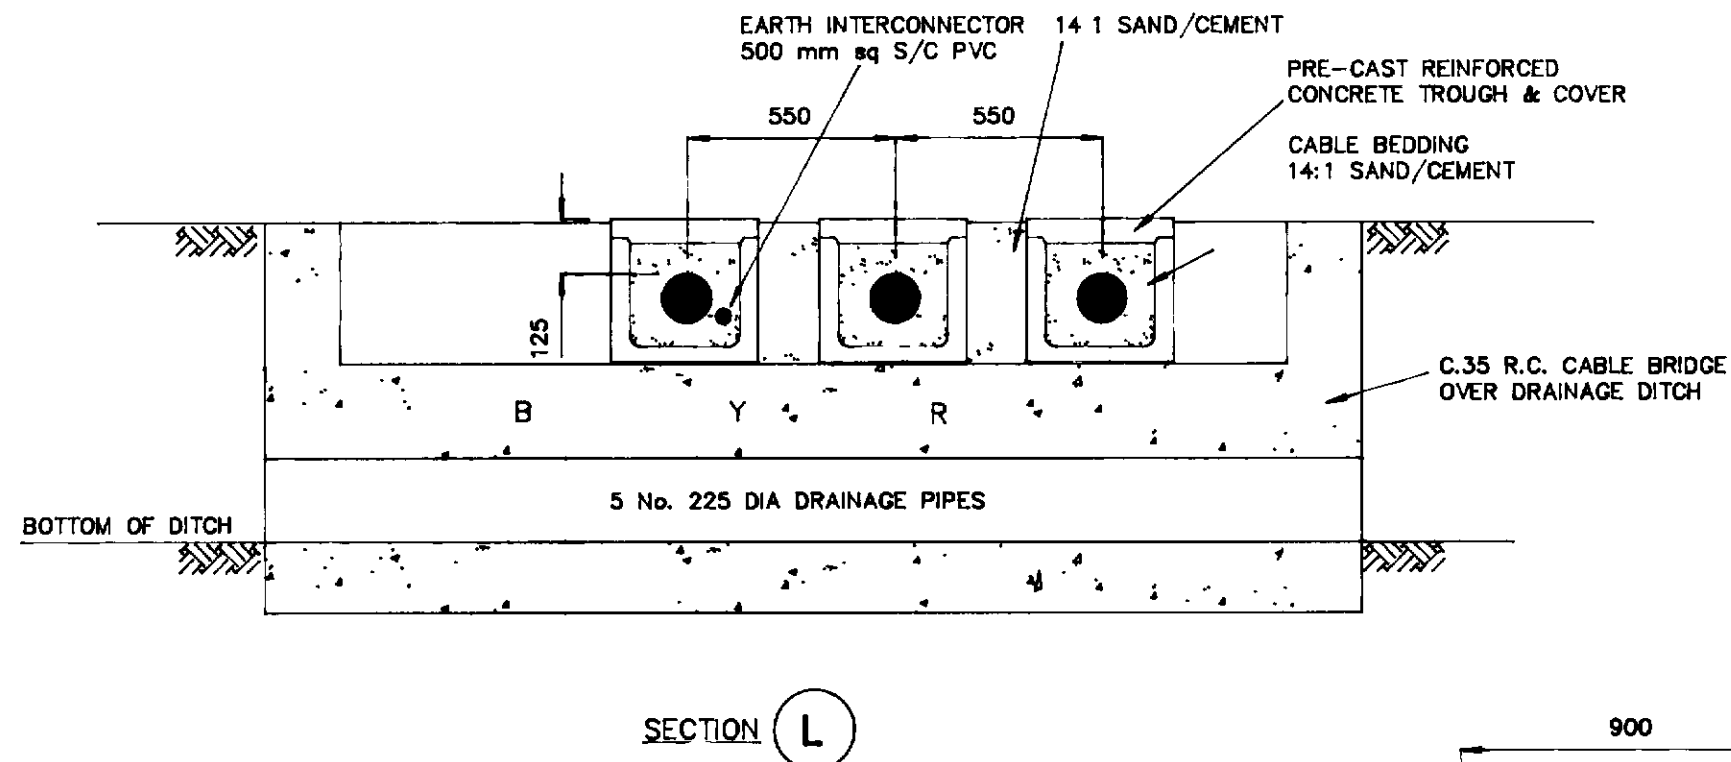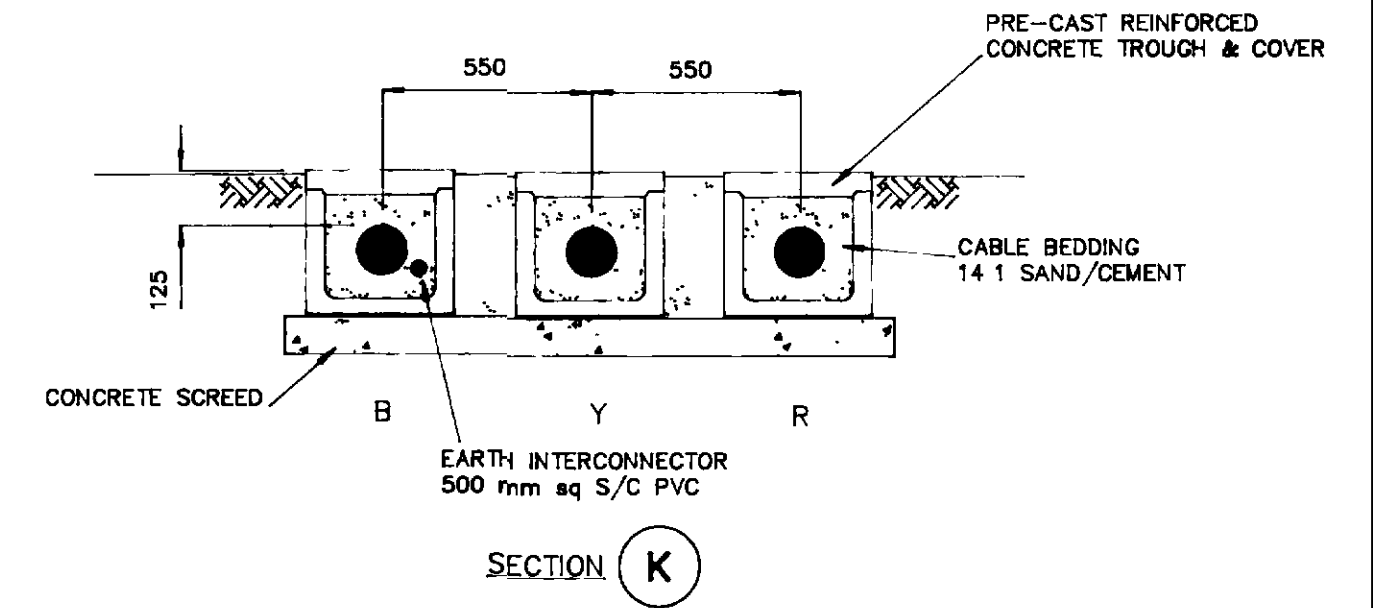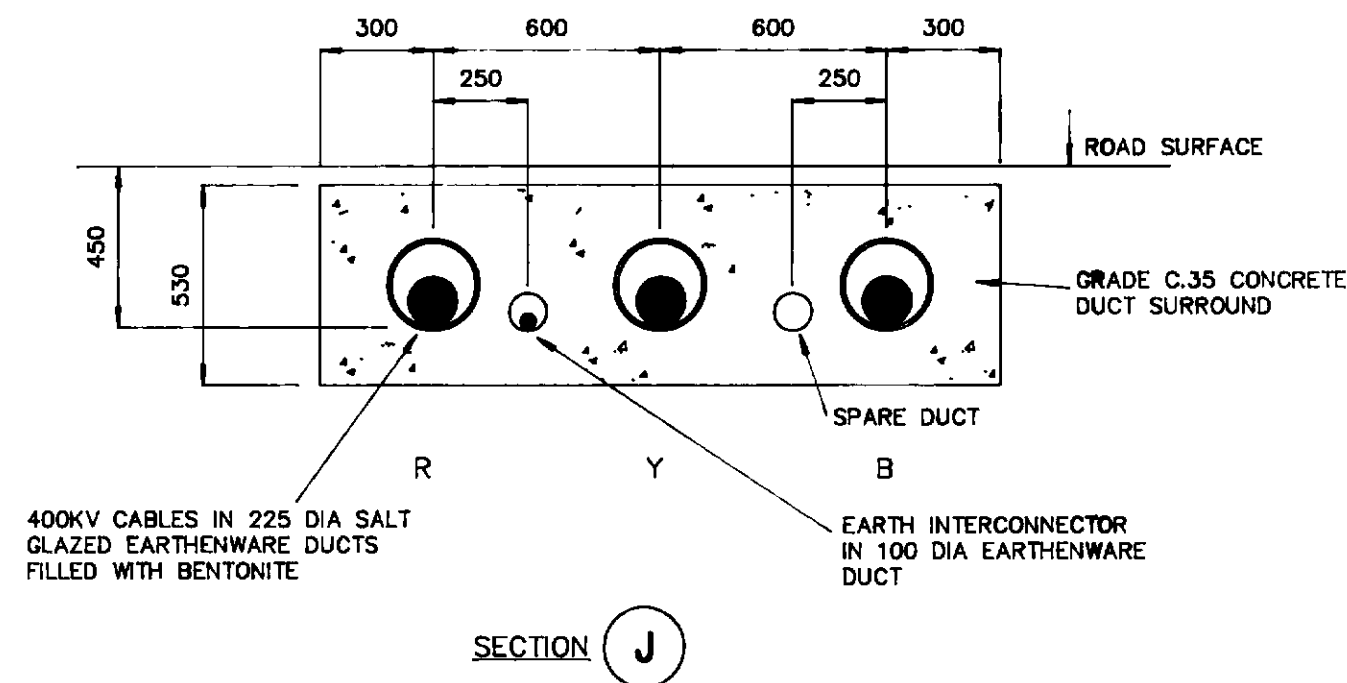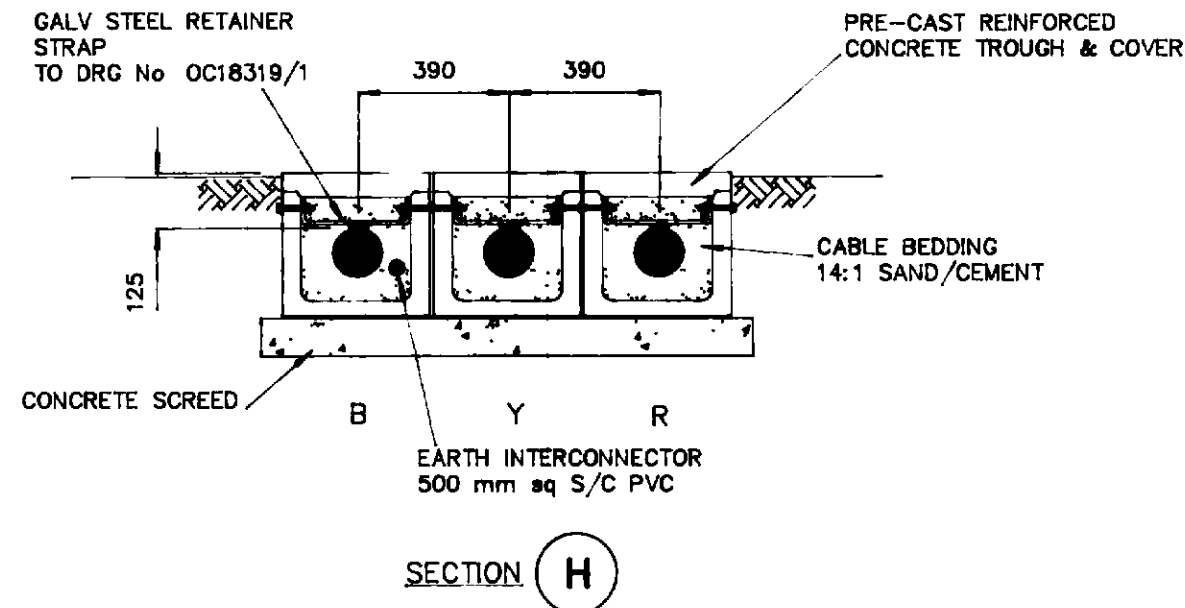

NATIONAL GRID CO.

WEST BURTON, 400 KV SUBSTATION.
400 KV HIGH MARNHAM CIRCUIT,
DUPLICATE UNDERGROUND CABLES

DRAWN	S.P.	DATE	11-11-96	SCALE:	1/20
CHECKED	JEA	DATE	27-2-97	DRG No.	
N.G.C CONTRACT No	C/CCN/CA018				
PIRELLI CONTRACT No.	ABM C50				

KM-C50/P7

70/17299 SHT7

Our Ref: 29406940 LM 203570/DK - 5

Monday, 08 May 2023

Ben Evans
The Hub, 500 Park Avenue, Aztec West

Bristol
BS32 4RZ

National Grid House
Warwick Technology Park
Gallows Hill, Warwick
CV34 6DA

Electricity Emergency Number:
0800 40 40 90*
*Available 24 hours, 7 days/week.
Calls may be recorded and monitored.
www.nationalgrid.com

Asset Protection
Gas Transmission
National Grid
Warwick
Email: assetprotection@nationalgrid.com

National Grid Electricity – High Risk Response Letter

Dear Sir/ Madam,

An assessment has been carried out with respect to National Grid Electricity Transmission plc's apparatus and the proposed work location. Based on the location entered into the system for assessment the area has been found to be within the High Risk zone from National Grid Electricity Transmission plc's apparatus and **Must Not Proceed** without further assessment by Asset Protection.

Could you please send a works description (including how deep you are excavating) and any plans including any commencement dates to the following email address assetprotection@nationalgrid.com including the LSBUD enquiry reference number.

Failure to provide this information will result in a delay to your works being assessed.

Please note this response and any attached map(s) are valid for 28 days from date of this letter. A new enquiry will need to be submitted into LSBUD if the requested information above is not supplied within 28 days.

Yours sincerely,

Asset Protection

Your Responsibilities and Obligations

The "Assessment" Section below outlines the detailed requirements that must be followed when planning or undertaking you activities at this location.

It is your responsibility to ensure that the information you have submitted is accurate and that all relevant documents including links are provided to all persons (either direct labour or contractors) working for you near National Grid Electricity Transmission plc's apparatus, e.g. as contained within the Construction (Design and Management) Regulations.

This assessment solely relates to National Grid Electricity Transmission plc (NGET)

This assessment does **NOT** include:

- National Grid's legal interest (easements or wayleaves) in the land which restricts activity in proximity to National Grid's assets in private land. You must obtain details of any such restrictions from the landowner in the first instance and if in doubt contact Asset Protection.
- Recently installed apparatus
- National Grid Gas plc.
- Apparatus owned by other organisations, e.g. Cadent, other gas distribution operators, local electricity companies, other utilities, etc.

It is **YOUR** responsibility to take into account whether the items listed above may be present and if they could be affected by your proposed activities.

This communication does not constitute any formal agreement or consent for any proposed development work; either generally or with regard to National Grid Electricity Transmission plc easements or wayleaves nor any planning or building regulations applications.

National Grid Electricity Transmission plc or their agents, servants or contractors do not accept any liability for any losses arising under or in connection with this information. This limit on liability applies to all and any claims in contract, tort (including negligence), misrepresentation (excluding fraudulent misrepresentation), breach of statutory duty or otherwise. This limit on liability does not exclude or restrict liability where prohibited by the law nor does it supersede the express terms of any related agreements.

If you require further assistance please contact the Asset Protection team via e-mail (assetprotection@nationalgrid.com) or via the contact details at the top of this response.

Assessment

Affected Apparatus

The apparatus that has been identified as being in the vicinity of your proposed works is:

- Electricity Transmission Overhead Line apparatus.

Requirements

Over Head Lines

BEFORE carrying out any work you must:

(N.B. Works only to be undertaken when contact has been made and response received from Asset Protection)

- Carefully read these requirements including the attached guidance documents and maps showing the location of apparatus.
- Contact the landowner and ensure any proposed works in private land do not infringe National Grid Electricity Transmission plc's legal rights (i.e. easements or wayleaves). If the works are in the road or footpath the relevant local authority should be contacted.
- Ensure that all persons, including direct labour and contractors, working for you on or near National Grid Electricity Transmission plc's apparatus follow the requirements of the HSE Guidance Notes HSG47 - 'Avoiding Danger from Underground Services' and GS6 – 'Avoidance of danger from overhead electric power lines'. This guidance can be downloaded free of charge at www.hse.gov.uk
- In line with the above guidance, verify and establish the actual position of mains, pipes, cables, services and other apparatus on site before any activities are undertaken.

DURING any work you must:

- Comply with all guidance for working within the vicinity of overhead lines as detailed within the guidance documents listed below.
- Comply with all guidance relating to general activities and any specific guidance for each asset type as specified in the Guidance Section below.
- Ensure that access to National Grid Electricity Transmission plc's apparatus is maintained at all times.
- Prevent the placing of heavy construction plant, equipment, materials or the passage of heavy vehicles over National Grid Electricity Transmission plc's apparatus unless specifically agreed with National Grid Electricity Transmission plc's apparatus in advance.
- Exercise extreme caution if slab (mass) concrete is encountered during excavation works as this maybe protecting or supporting National Grid Electricity Transmission plc's apparatus.

Underground Cables

BEFORE carrying out any work you must:

(N.B. Works only to be undertaken when contact has been made and response received from Asset Protection)

- Refer to the attached cable profile drawings which provide details about the location of National Grid's high voltage underground cables.
- Carefully read these requirements including the attached guidance documents and maps showing the location of apparatus.
- Contact the landowner and ensure any proposed works in private land do not infringe National Grid Electricity Transmission plc's legal rights (i.e. easements or wayleaves). If the works are in the road or footpath the relevant local authority should be contacted.
- Ensure that all persons, including direct labour and contractors, working for you on or near infringe National Grid Electricity Transmission plc's follow the requirements of the HSE Guidance Notes HS(G)47 "Avoiding Danger From Underground Services". This guidance can be downloaded free of charge at www.hse.gov.uk
- In line with the above guidance, verify and establish the actual position of mains, pipes, cables,

National Grid is a trading name for:

National Grid Electricity Transmission plc

Registered Office: 1-3 Strand, London WC2N 5EH

Registered in England and Wales, No 2366977

services and other apparatus on site before any activities are undertaken.

DURING any work you must:

- Comply with all guidance for working within the vicinity of Electricity Underground Cables as detailed within the guidance documents listed below.
- Comply with all guidance relating to general activities and any specific guidance for each asset type as specified in the Guidance Section below.
- Ensure that access to National Grid Electricity Transmission plc's apparatus is maintained at all times.
- Prevent the placing of heavy construction plant, equipment, materials or the passage of heavy vehicles over National Grid Electricity Transmission plc's apparatus unless specifically agreed with National Grid Electricity Transmission plc's in advance.
- Exercise extreme caution if slab (mass) concrete is encountered during excavation works as this maybe protecting or supporting National Grid Electricity Transmission plc's apparatus.

GUIDANCE

National Grid Electricity Transmission Network data

- The Network map for National Grid Electricity Transmission assets can be downloaded at the following link in GIS format.

<https://www.nationalgrid.com/uk/electricity-transmission/network-and-infrastructure/network-route-maps>

Buried Cables

- National Grid's underground cables are protected by a Deed of grant; Easement; Wayleave Agreement or the provisions of the New Roads and Street Works Act. Which provide full right of access to retain, maintain, repair and inspect our asset. Hence we require that no permanent structures are to be built over our cables or within the easement strip.
- Ground levels above our cables must not be altered in any way. Any alterations to the depth of our cables will subsequently alter the rating of the circuit and can compromise the reliability, efficiency and safety of our electricity network.
- The supplied detailed route records should not be taken as positive indication of the cable location. This can only be determined by digging trial holes. Where trial holes are dug the concrete and / or polymeric cable protection tiles must not be disturbed.
- The normal recommendation is to keep 2 metres clear either side of the 1 metre wide trench containing the AC cable.
- National Grid should be made aware of the works starting and may put in place a representative to monitor the works. The works should be carried out in accordance with the recommendations in document HS (G) 47 available from the HSE web site.
- The relocation of existing underground cables is not normally feasible on grounds of cost, operation and maintenance and environmental impact and we believe that successful development can take place in their vicinity.
- The information supplied is given in good faith and only as a guide to the location of our underground cables. The accuracy of this information cannot be guaranteed. The physical presence of such cables may also be evident from physical protection measures such as ducts or concrete protection tiles. The person(s) responsible for planning, supervising and carrying out work in proximity to our cable(s) shall be liable to us, as cable(s) owner, as well as to any third party who may be affected in any way by any loss or damage resulting from their failure to locate and avoid any damage to such a cable(s).
- The relevant guidance in relation to working safely near to existing underground cables is contained within the Health and Safety Executive's (www.hse.gov.uk) Guidance HS(G)47 "Avoiding Danger From Underground Services" and all relevant site staff should make sure that they are both aware of and understand this guidance.
- Our cables are normally buried to a depth of 0.9 metres to the protective covers but this depth can vary depending on location (bridges may have cables 100mm below surface level)..The specific cable route record drawings show further details along the route of the particular cable. The cable route drawings are attached to this letter for your information.
- Cables installed in cable tunnels, whilst less likely to be affected by surface or shallow works may be affected by activities such as piling.
- National Grid assets can be adversely affected by vibration and can provide guidance on the acceptable levels of vibration due to piling and other construction related operations in the vicinity of national grid assets
- Ground cover above our cables should not be reduced or increased without consultation with National Grid.

National Grid is a trading name for:

National Grid Electricity Transmission plc

Registered Office: 1-3 Strand, London WC2N 5EH

Registered in England and Wales, No 2366977

- If a landscaping scheme is proposed as part of the works, we request that no trees and shrubs are planted either directly above or within 3 metres of the existing underground cable, as ultimately the roots may grow to cause damage to the cable.

Cables Tunnels


- National Grid's underground cable tunnels are protected by the provisions of a Wayleave/Easement or the New Roads and Street Works Act. This provides full right of access to retain, maintain, repair and inspect our asset.
- Further information and guidance regarding National Grid Cable Tunnels is available on our website at <https://www.nationalgrid.com/uk/electricity-transmission/document/121061/download>
- National Grid requires that the clearances indicated in the guidance document linked above are maintained at all times. Should it be necessary to enter the exclusion zone discussion/ agreement with National Grid is required to ensure the integrity of their tunnel asset and the high voltage cables is not compromised.
- Ground levels above our cable tunnels must not be altered in any way without prior agreement with National Grid; any alterations to the depth of our tunnels can compromise its integrity which could have an adverse impact on the reliability, efficiency and safety of our electricity network.
- Any works which would create high levels of vibration such as piling would need to be assessed by National Grid to ensure it has limited impact on our cable tunnels. National Grid can advise on acceptable vibration limits.

Overhead Lines

- National Grid's Overhead Line/s is protected by a Deed of Easement/Wayleave Agreement which provides full right of access to retain, maintain, repair and inspect our asset.
- The submitted proposed design does not change after the date of this letter. Any design change that moves the proposal closer to National Grid Overhead Line Assets shall be submitted for assessment.
- Statutory electrical safety clearances shall be maintained at all times. National Grid recommends that no permanent structures are built directly beneath our overhead lines. These distances are set out in EN 43 – 8 Technical Specification for "Overhead Line Clearances Issue 5 (2019). To purchase & download EN 43 – 8 Technical Specification for "Overhead Line Clearances Issue 5 (2019) go to <https://www.ena-eng.org/ENA-Docs/>
- Any changes in ground levels which are proposed either beneath or in close proximity to our existing overhead lines would serve to reduce safety clearances. Safety clearances to existing overhead lines must be maintained in all circumstances.
- To view the Development Near Overhead Lines Document.
<https://www.nationalgridet.com/document/130626/download>
- To view the National Grid Third Party Guidance for working near National Grid Electricity Transmission equipment.
<https://www.nationalgridet.com/sites/et/files/documents/Working%20near%20electricity%20equipment.pdf>

- The relevant guidance in relation to working safely near to existing overhead lines is contained within the Health and Safety Executive's (www.hse.gov.uk) Guidance Note GS 6 "Avoidance of Danger from Overhead Electric Lines."
- If a landscaping scheme is proposed as part of the proposal, only slow and low growing species of trees and shrubs shall be planted beneath and adjacent to the existing overhead line to reduce the risk of growth to a height which compromises statutory safety clearances.
- Drilling or excavation works shall not be undertaken if they have the potential to disturb or adversely affect the foundations or "pillars of support" of our towers. These foundations extend beyond the base of the tower. Pillar of Support drawings shall be obtained using the contact details above.
- Due to the scale, bulk and cost of the transmission equipment required to operate at 275kV or 400kV we only support proposals for the relocation of existing high voltage overhead lines where such proposals directly facilitate a major development or infrastructure project of national importance which has been identified as such by government.
- To promote the successful development of sites crossed by existing overhead lines, and the creation of well-designed places, National Grid has produced 'Design guidelines for development near pylons and high voltage overhead power lines', which look at how to create high quality development near overhead lines and offer practical solutions which can assist in avoiding the unnecessary sterilisation of land in the vicinity of high voltage overhead lines.
- Further information regarding our undergrounding policy and development near transmission overhead lines is available on our website at: <https://www.nationalgridet.com/network-and-assets/planning-and-development>

Overview map of worksite

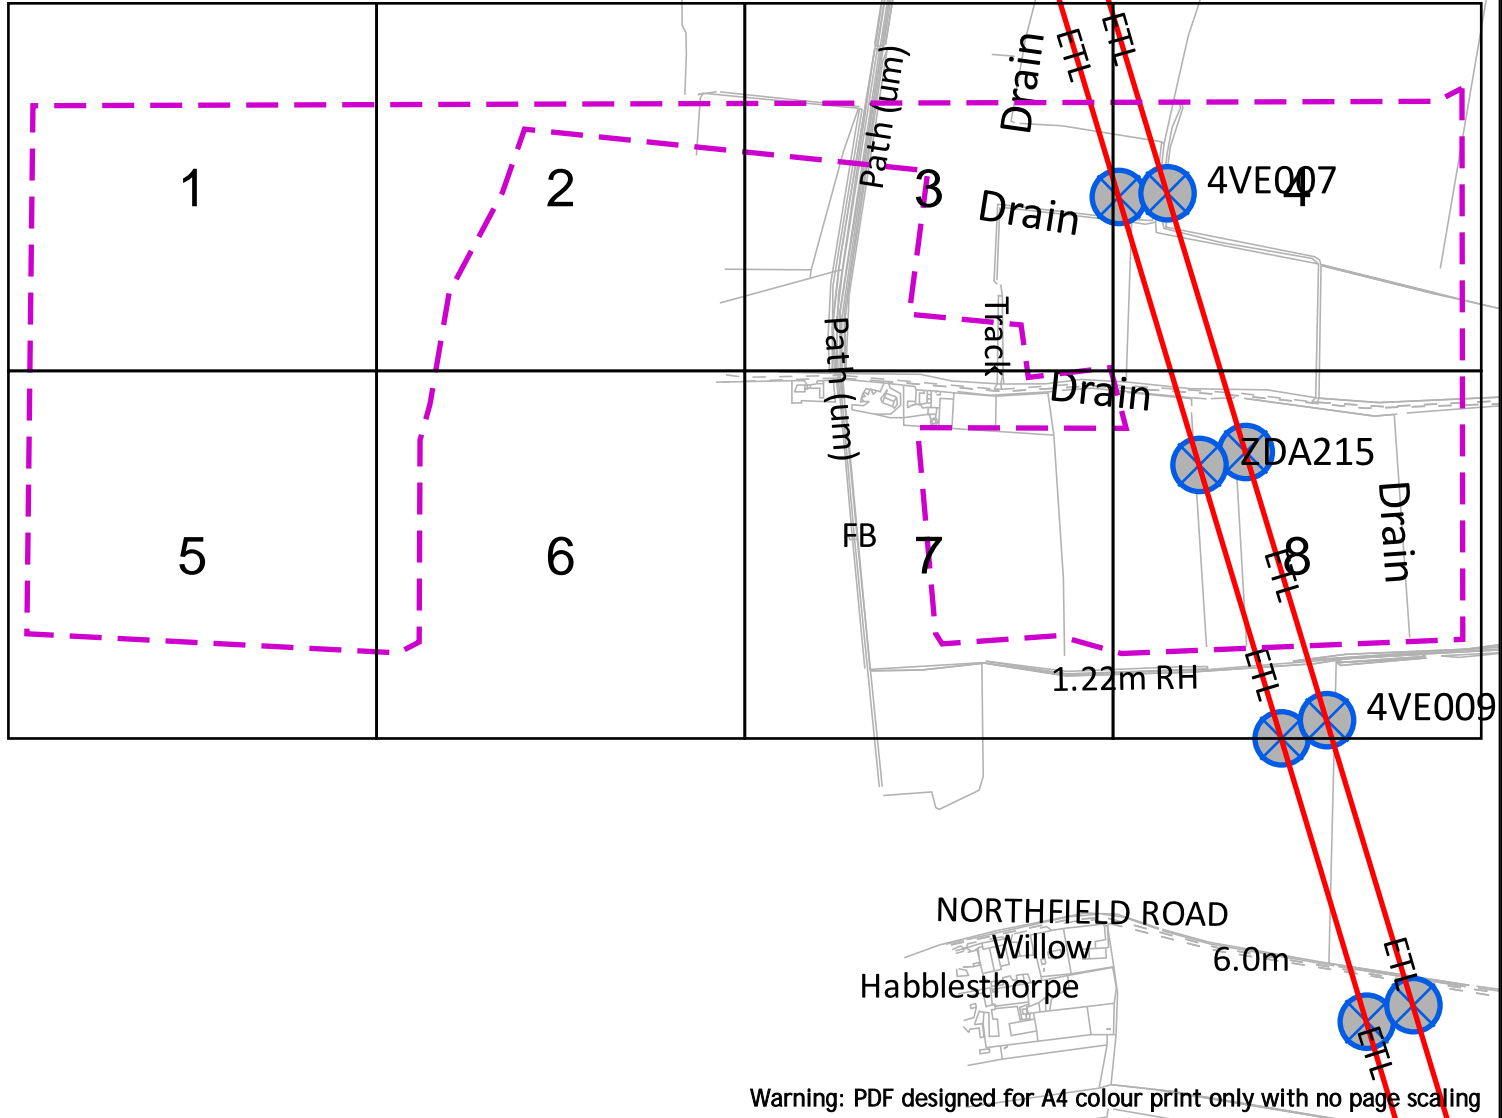

Warning: PDF designed for A4 colour print only with no page scaling



**EXTREME CAUTION - HIGH VOLTAGE
RISK OF DEATH OR SERIOUS INJURY**

- Dig Sites
- Area:
- Line:
- Underground Cables
- Overhead Lines
- Fibre Cables

NationalGrid House
Warwick Technology Park
Gallows Hill
Warwick
CV34 6DA

AssetProtection@NationalGrid.com

Date Requested: 08/05/2023
Job Reference: 29406940
Site Location: 478486 383020
Requested by: Mr Ben Evans

Your Scheme/Reference: LM
203570/DK - 5

IMPORTANT NOTICES
This plan shows those pipes owned by National Grid Electricity Transmission plc in its role as a Licensed Electricity Transporter (ET). Electricity cables owned by other ETs, or otherwise privately owned, may be present in this area. Information with regards to such cables should be obtained from the relevant owners. The information shown on this plan is given without warranty, the accuracy thereof cannot be guaranteed. Ancillary equipment such as cooling systems and communication cables are not shown but their presence should be anticipated. No liability of any kind whatsoever is accepted by National Grid Electricity Transmission plc or their agents, servants or contractors for any error or omission. Safe digging practices, in accordance with HS(G)47, must be used to verify and establish the actual position of cables and other apparatus on site before any mechanical plant is used. It is your responsibility to ensure that this information is provided to all persons (either direct labour or contractors) working for you on or near electricity apparatus. The information included on this plan should not be referred to beyond a period of 28 days from the date of issue.

National Grid Electricity Emergency Number: 0800 40 40 90
Available 24 hours, 7 days/week. Calls may be recorded and monitored


Scale: 1:10250 (When plotted at A4)

Warning: PDF designed for A4 colour print only with no page scaling

nationalgrid



**EXTREME CAUTION - HIGH VOLTAGE
RISK OF DEATH OR SERIOUS INJURY**

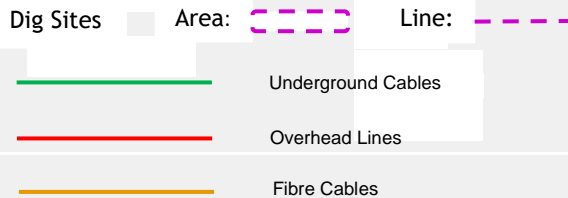

NationalGrid House
Warwick Technology Park
Gallows Hill
Warwick
CV34 6DA

AssetProtection@NationalGrid.com

Date Requested: 08/05/2023
Job Reference: 29406940
Site Location: 478486 383020
Requested by: Mr Ben Evans

Your Scheme/Reference: LM
203570/DK - 5

IMPORTANT NOTICES


This plan shows those pipes owned by National Grid Electricity Transmission plc in its role as a Licensed Electricity Transporter (ET). Electricity cables owned by other ETs, or otherwise privately owned, may be present in this area. Information with regards to such cables should be obtained from the relevant owners. The information shown on this plan is given without warranty, the accuracy thereof cannot be guaranteed. Ancillary equipment such as cooling systems and communication cables are not shown but their presence should be anticipated. No liability of any kind whatsoever is accepted by National Grid Electricity Transmission plc or their agents, servants or contractors for any error or omission. Safe digging practices, in accordance with HS(G)47, must be used to verify and establish the actual position of cables and other apparatus on site before any mechanical plant is used. It is your responsibility to ensure that this information is provided to all persons (either direct labour or contractors) working for you on or near electricity apparatus. The information included on this plan should not be referred to beyond a period of 28 days from the date of issue.

National Grid Electricity Emergency Number: 0800 40 40 90

Available 24 hours, 7 days/week. Calls may be recorded and monitored

Scale: 1:2500 (When plotted at A4)

Crown Copyright © - Reproduced by permission of Ordnance Survey on behalf of HMSO. And database right 2023. All rights reserved. Ordnance Survey Licence number 0100059731.

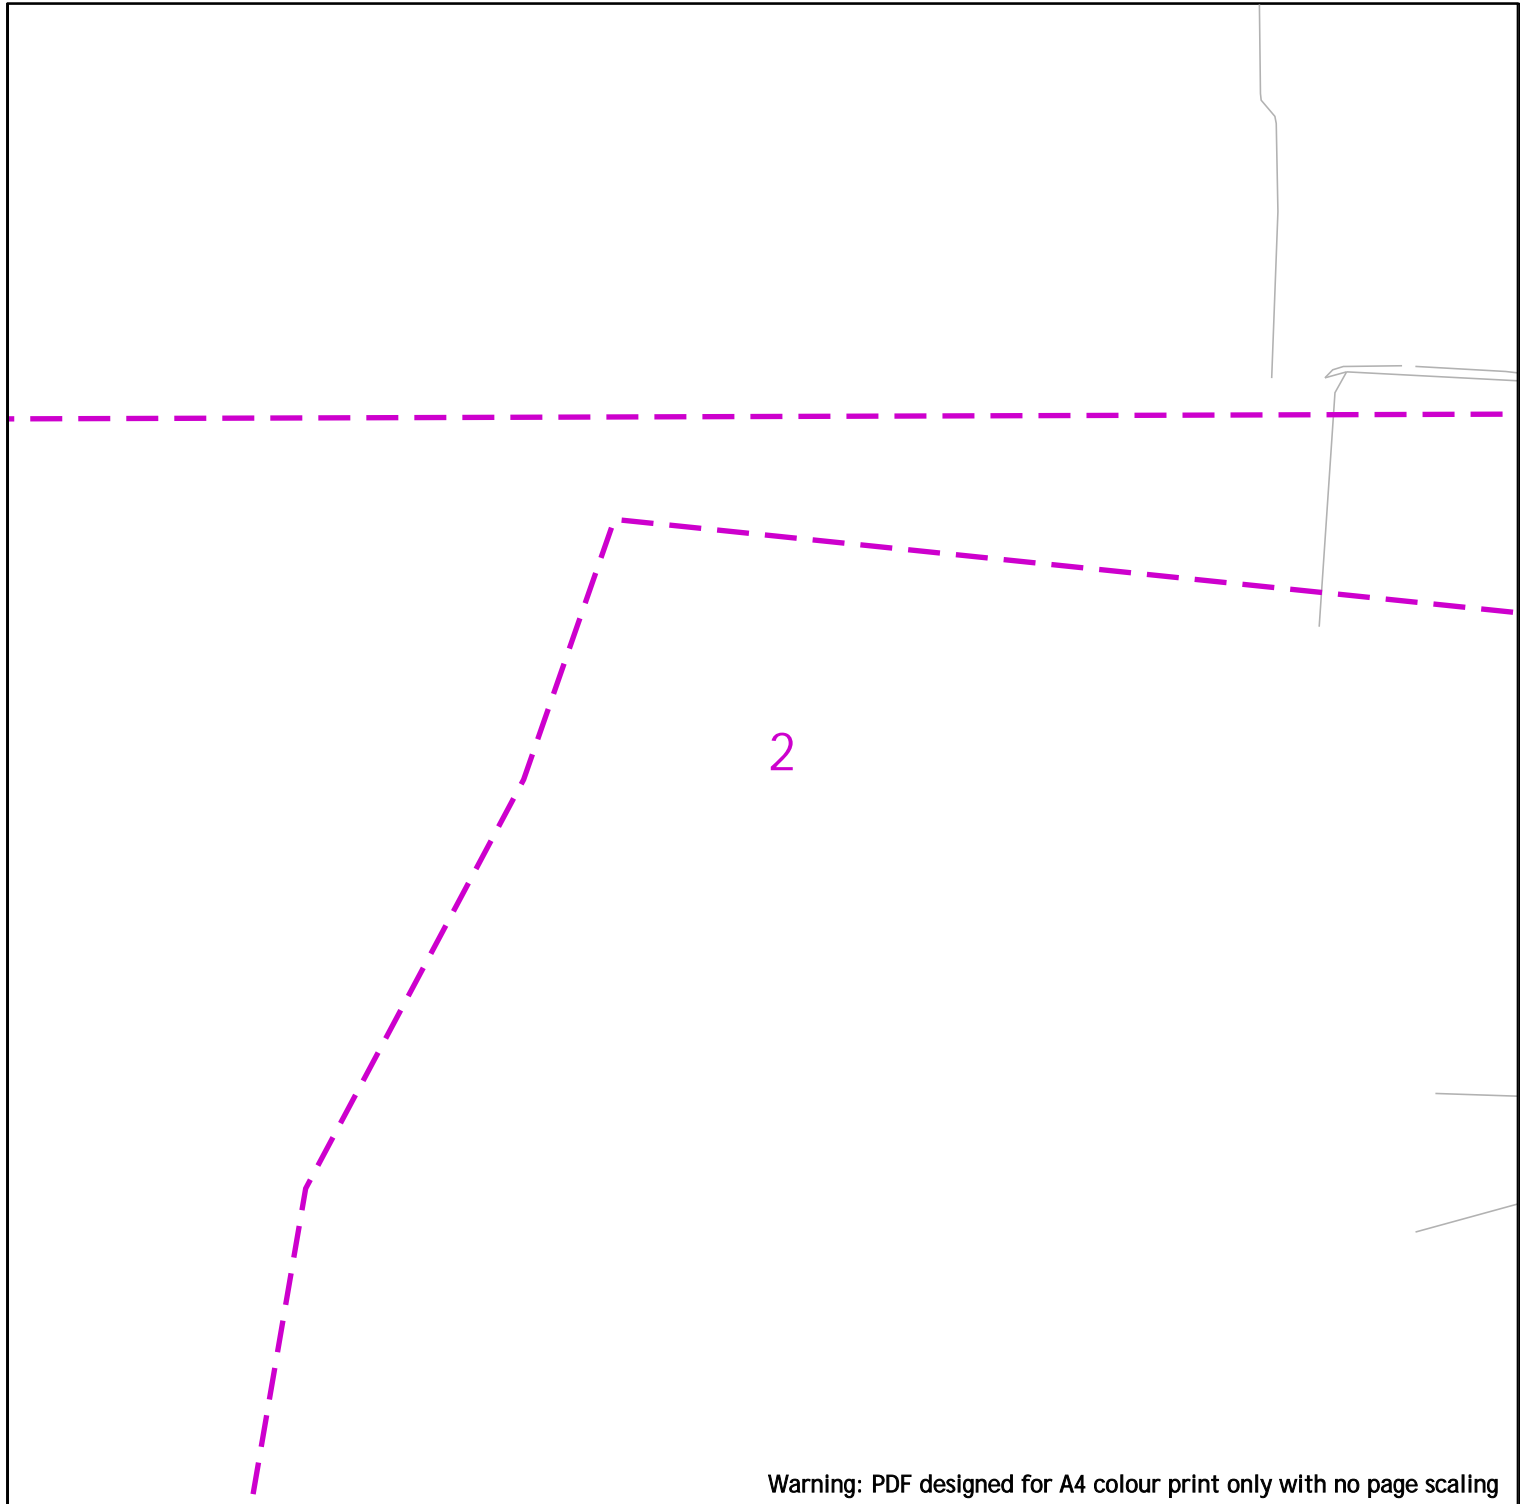

Warning: PDF designed for A4 colour print only with no page scaling



**EXTREME CAUTION - HIGH VOLTAGE
RISK OF DEATH OR SERIOUS INJURY**

Dig Sites Area: Line:

- Underground Cables
- Overhead Lines
- Fibre Cables

NationalGrid House
Warwick Technology Park
Gallows Hill
Warwick
CV34 6DA

AssetProtection@NationalGrid.com

Date Requested: 08/05/2023
Job Reference: 29406940
Site Location: 478486 383020
Requested by: Mr Ben Evans



Your Scheme/Reference: LM
203570/DK - 5

IMPORTANT NOTICES

This plan shows those pipes owned by National Grid Electricity Transmission plc in its role as a Licensed Electricity Transporter (ET). Electricity cables owned by other ETs, or otherwise privately owned, may be present in this area. Information with regards to such cables should be obtained from the relevant owners. The information shown on this plan is given without warranty, the accuracy thereof cannot be guaranteed. Ancillary equipment such as cooling systems and communication cables are not shown but their presence should be anticipated. No liability of any kind whatsoever is accepted by National Grid Electricity Transmission plc or their agents, servants or contractors for any error or omission. Safe digging practices, in accordance with HS(G)47, must be used to verify and establish the actual position of cables and other apparatus on site before any mechanical plant is used. It is your responsibility to ensure that this information is provided to all persons (either direct labour or contractors) working for you on or near electricity apparatus. The information included on this plan should not be referred to beyond a period of 28 days from the date of issue.

National Grid Electricity Emergency Number: 0800 40 40 90
Available 24 hours, 7 days/week. Calls may be recorded and monitored

Scale: 1:2500 (When plotted at A4)

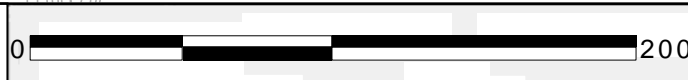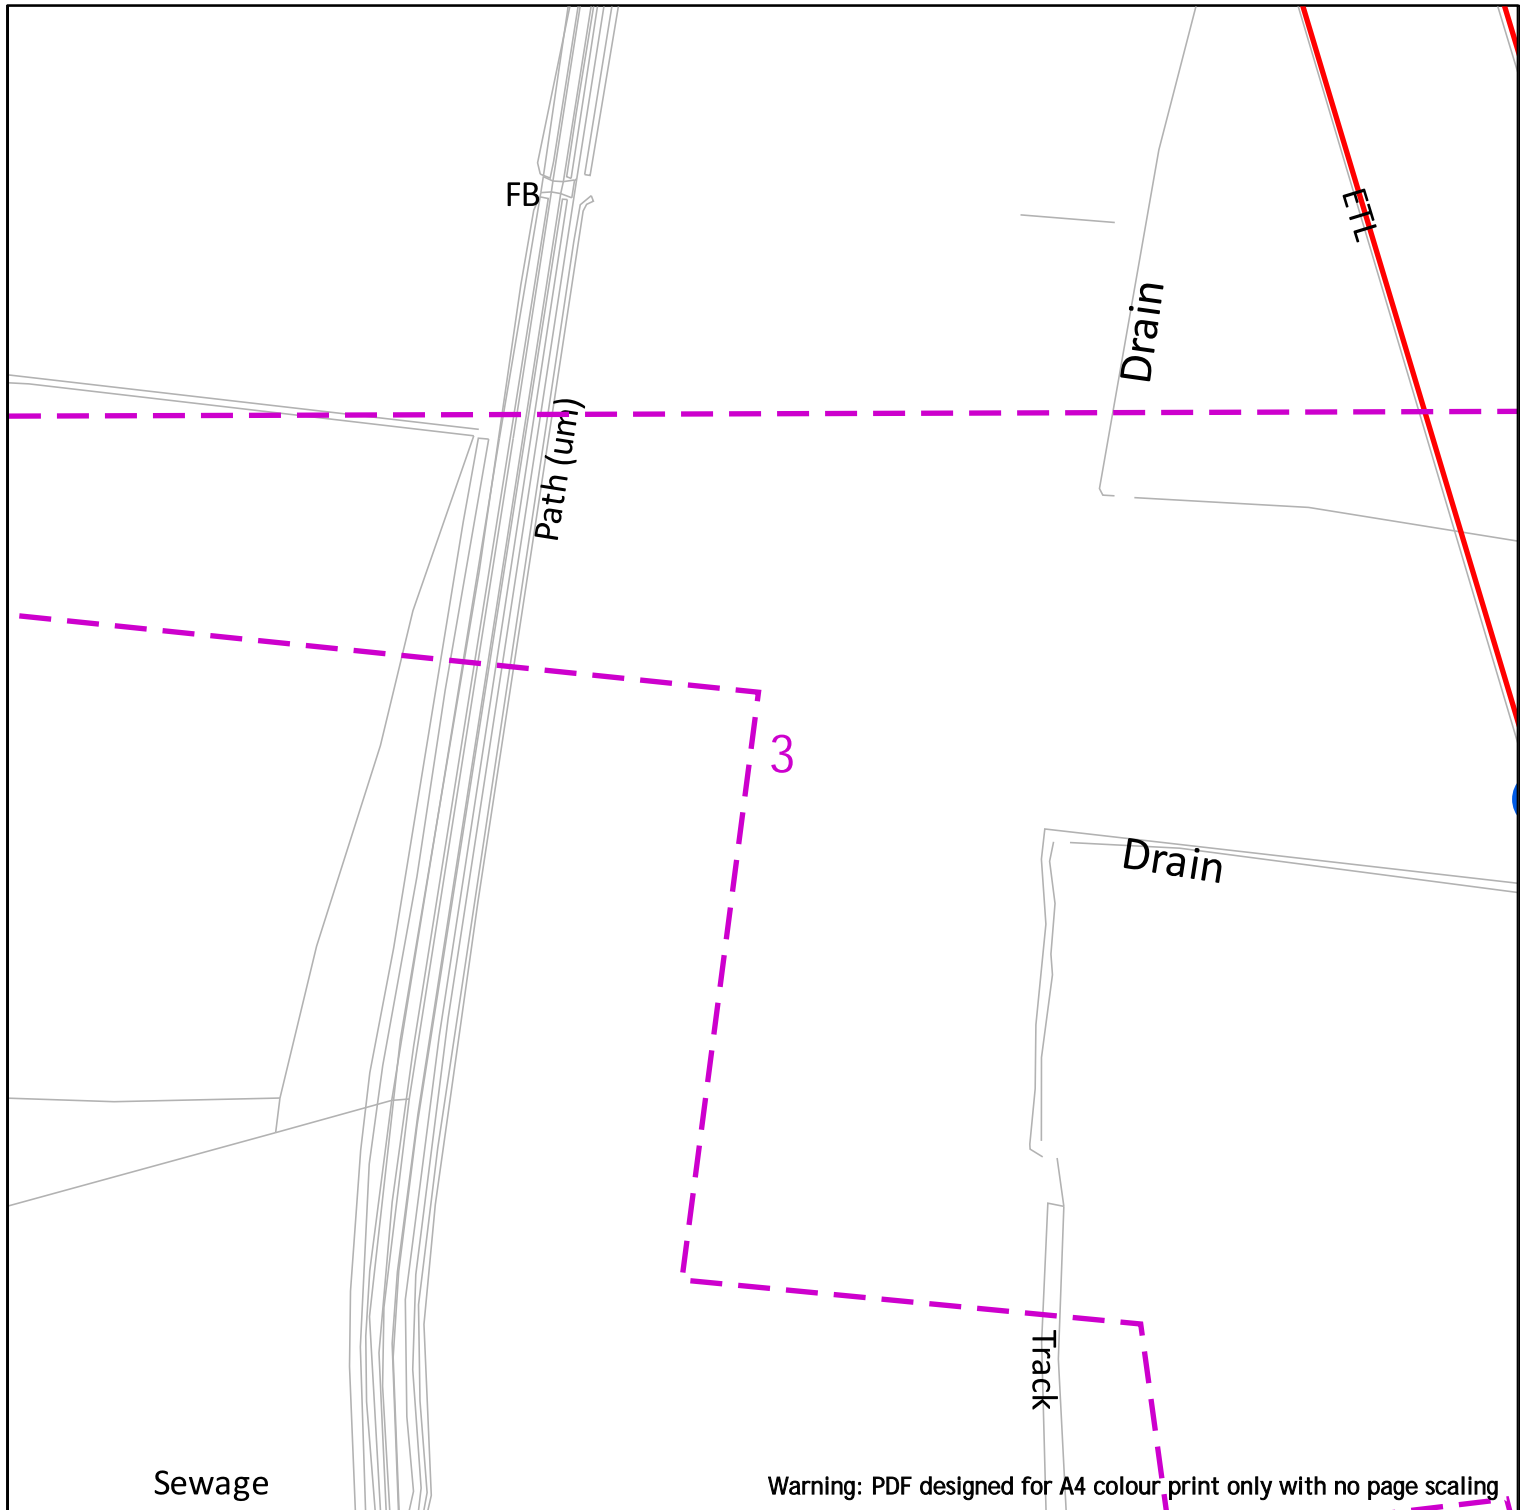

**EXTREME CAUTION - HIGH VOLTAGE
RISK OF DEATH OR SERIOUS INJURY**

Dig Sites Area: Line:

Underground Cables

Overhead Lines

Fibre Cables


NationalGrid House
Warwick Technology Park
Gallows Hill
Warwick
CV34 6DA
AssetProtection@NationalGrid.com

Date Requested: 08/05/2023
Job Reference: 29406940
Site Location: 478486 383020
Requested by: Mr Ben Evans
Your Scheme/Reference: LM
203570/DK - 5

IMPORTANT NOTICES
This plan shows those pipes owned by National Grid Electricity Transmission plc in its role as a Licensed Electricity Transporter (ET). Electricity cables owned by other ETs, or otherwise privately owned, may be present in this area. Information with regards to such cables should be obtained from the relevant owners. The information shown on this plan is given without warranty, the accuracy thereof cannot be guaranteed. Ancillary equipment such as cooling systems and communication cables are not shown but their presence should be anticipated. No liability of any kind whatsoever is accepted by National Grid Electricity Transmission plc or their agents, servants or contractors for any error or omission. Safe digging practices, in accordance with HS(G)47, must be used to verify and establish the actual position of cables and other apparatus on site before any mechanical plant is used. It is your responsibility to ensure that this information is provided to all persons (either direct labour or contractors) working for you on or near electricity apparatus. The information included on this plan should not be referred to beyond a period of 28 days from the date of issue.

National Grid Electricity Emergency Number: 0800 40 40 90
Available 24 hours, 7 days/week. Calls may be recorded and monitored

Scale: 1:2500 (When plotted at A4)

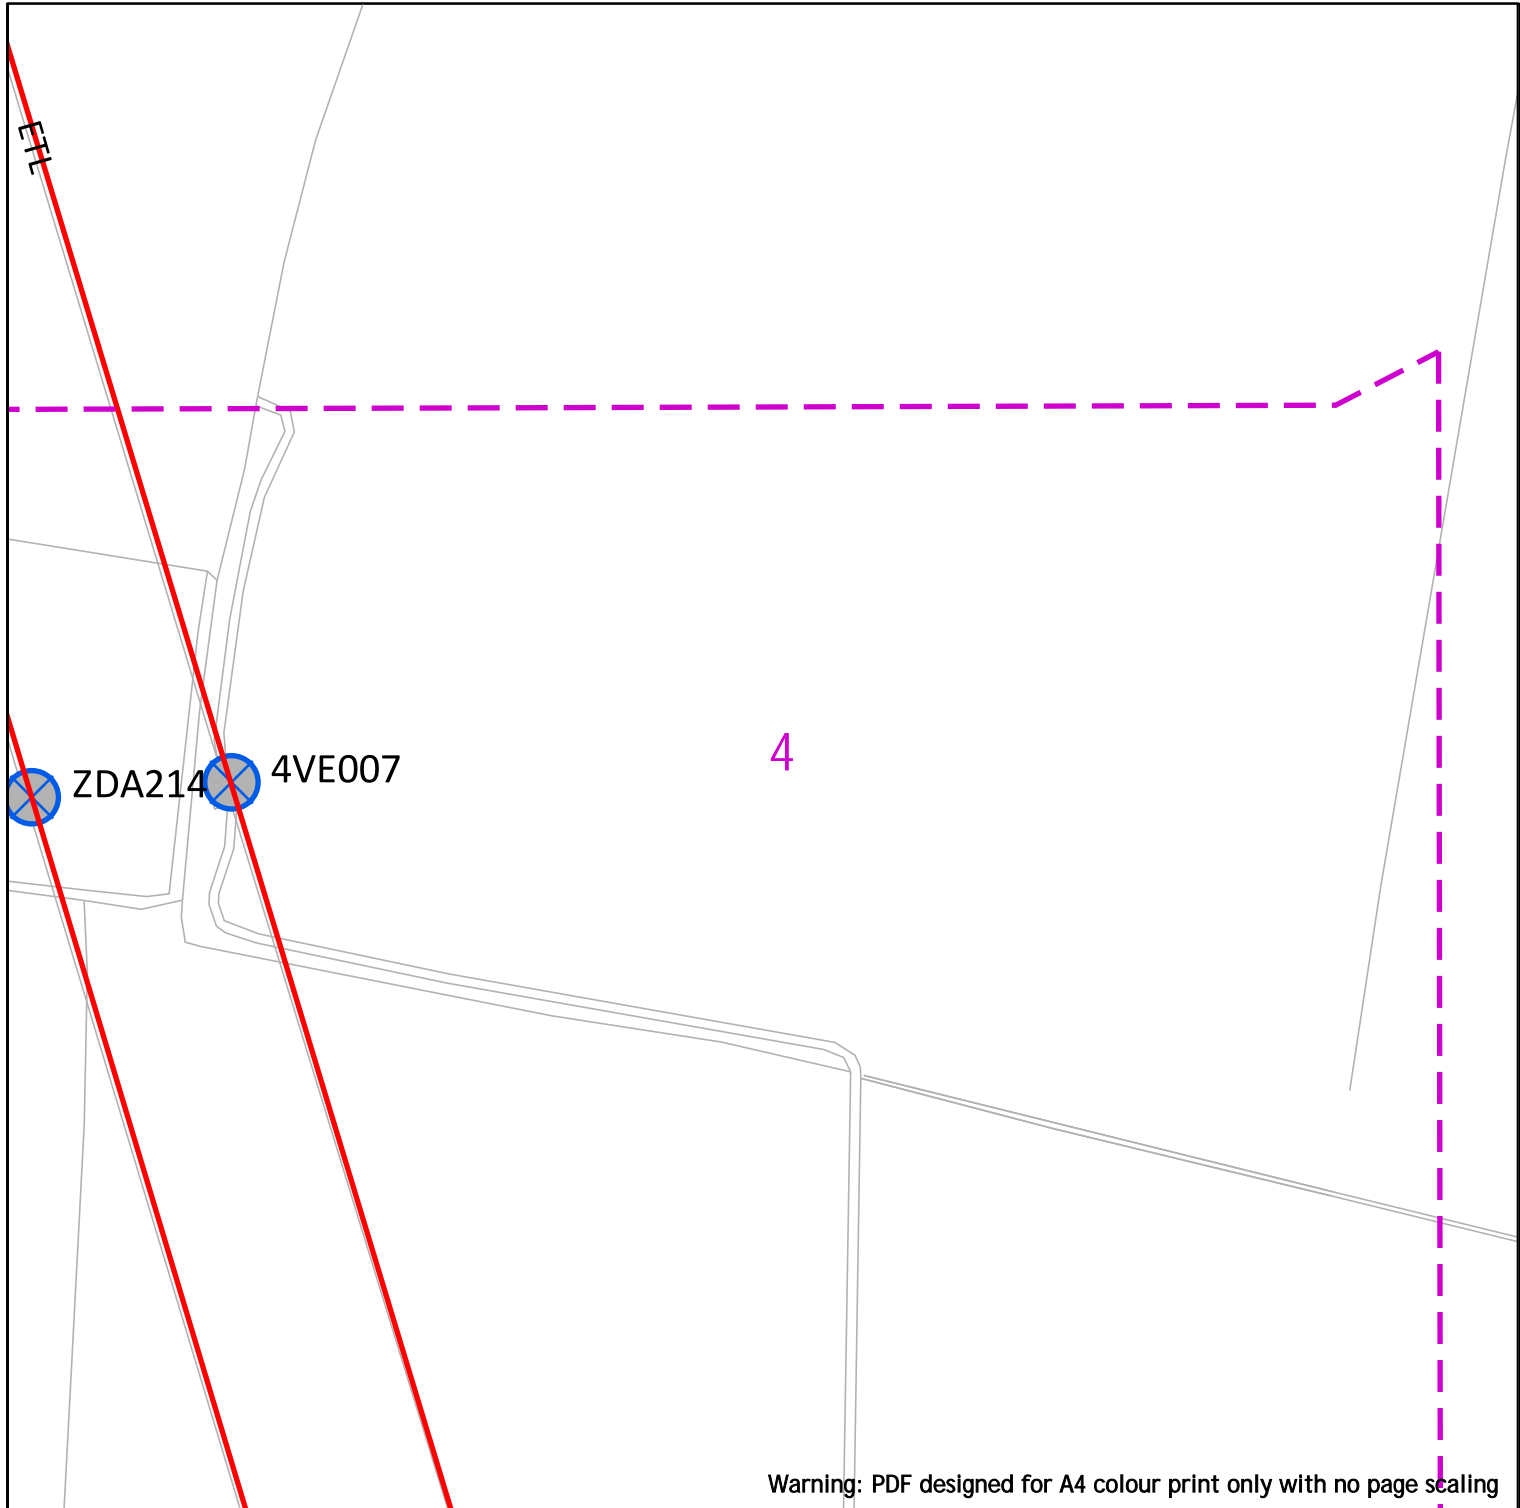

Warning: PDF designed for A4 colour print only with no page scaling

nationalgrid



**EXTREME CAUTION - HIGH VOLTAGE
RISK OF DEATH OR SERIOUS INJURY**

Dig Sites Area: Line:

 Underground Cables

 Overhead Lines

 Fibre Cables

NationalGrid House
Warwick Technology Park
Gallows Hill
Warwick
CV34 6DA

AssetProtection@NationalGrid.com

Date Requested: 08/05/2023
Job Reference: 29406940
Site Location: 478486 383020
Requested by: Mr Ben Evans

Your Scheme/Reference: LM
203570/DK - 5

IMPORTANT NOTICES
This plan shows those pipes owned by National Grid Electricity Transmission plc in its role as a Licensed Electricity Transporter (ET). Electricity cables owned by other ETs, or otherwise privately owned, may be present in this area. Information with regards to such cables should be obtained from the relevant owners. The information shown on this plan is given without warranty, the accuracy thereof cannot be guaranteed. Ancillary equipment such as cooling systems and communication cables are not shown but their presence should be anticipated. No liability of any kind whatsoever is accepted by National Grid Electricity Transmission plc or their agents, servants or contractors for any error or omission. Safe digging practices, in accordance with HS(G)47, must be used to verify and establish the actual position of cables and other apparatus on site before any mechanical plant is used. It is your responsibility to ensure that this information is provided to all persons (either direct labour or contractors) working for you on or near electricity apparatus. The information included on this plan should not be referred to beyond a period of 28 days from the date of issue.

National Grid Electricity Emergency Number: 0800 40 40 90
Available 24 hours, 7 days/week. Calls may be recorded and monitored

Scale: 1:2500 (When plotted at A4)

5

Warning: PDF designed for A4 colour print only with no page scaling


nationalgrid



**EXTREME CAUTION - HIGH VOLTAGE
RISK OF DEATH OR SERIOUS INJURY**

NationalGrid House
Warwick Technology Park
Gallows Hill
Warwick
CV34 6DA

AssetProtection@NationalGrid.com

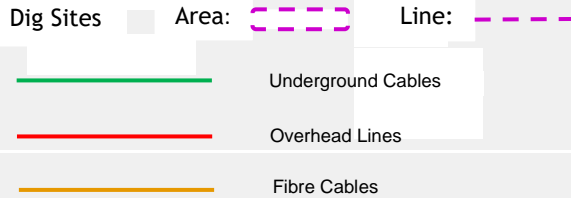


Date Requested: 08/05/2023
Job Reference: 29406940
Site Location: 478486 383020
Requested by: Mr Ben Evans

Your Scheme/Reference: LM
203570/DK - 5






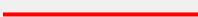

IMPORTANT NOTICES
This plan shows those pipes owned by National Grid Electricity Transmission plc in its role as a Licensed Electricity Transporter (ET). Electricity cables owned by other ETs, or otherwise privately owned, may be present in this area. Information with regards to such cables should be obtained from the relevant owners. The information shown on this plan is given without warranty, the accuracy thereof cannot be guaranteed. Ancillary equipment such as cooling systems and communication cables are not shown but their presence should be anticipated. No liability of any kind whatsoever is accepted by National Grid Electricity Transmission plc or their agents, servants or contractors for any error or omission. Safe digging practices, in accordance with HS(G)47, must be used to verify and establish the actual position of cables and other apparatus on site before any mechanical plant is used. It is your responsibility to ensure that this information is provided to all persons (either direct labour or contractors) working for you on or near electricity apparatus. The information included on this plan should not be referred to beyond a period of 28 days from the date of issue.

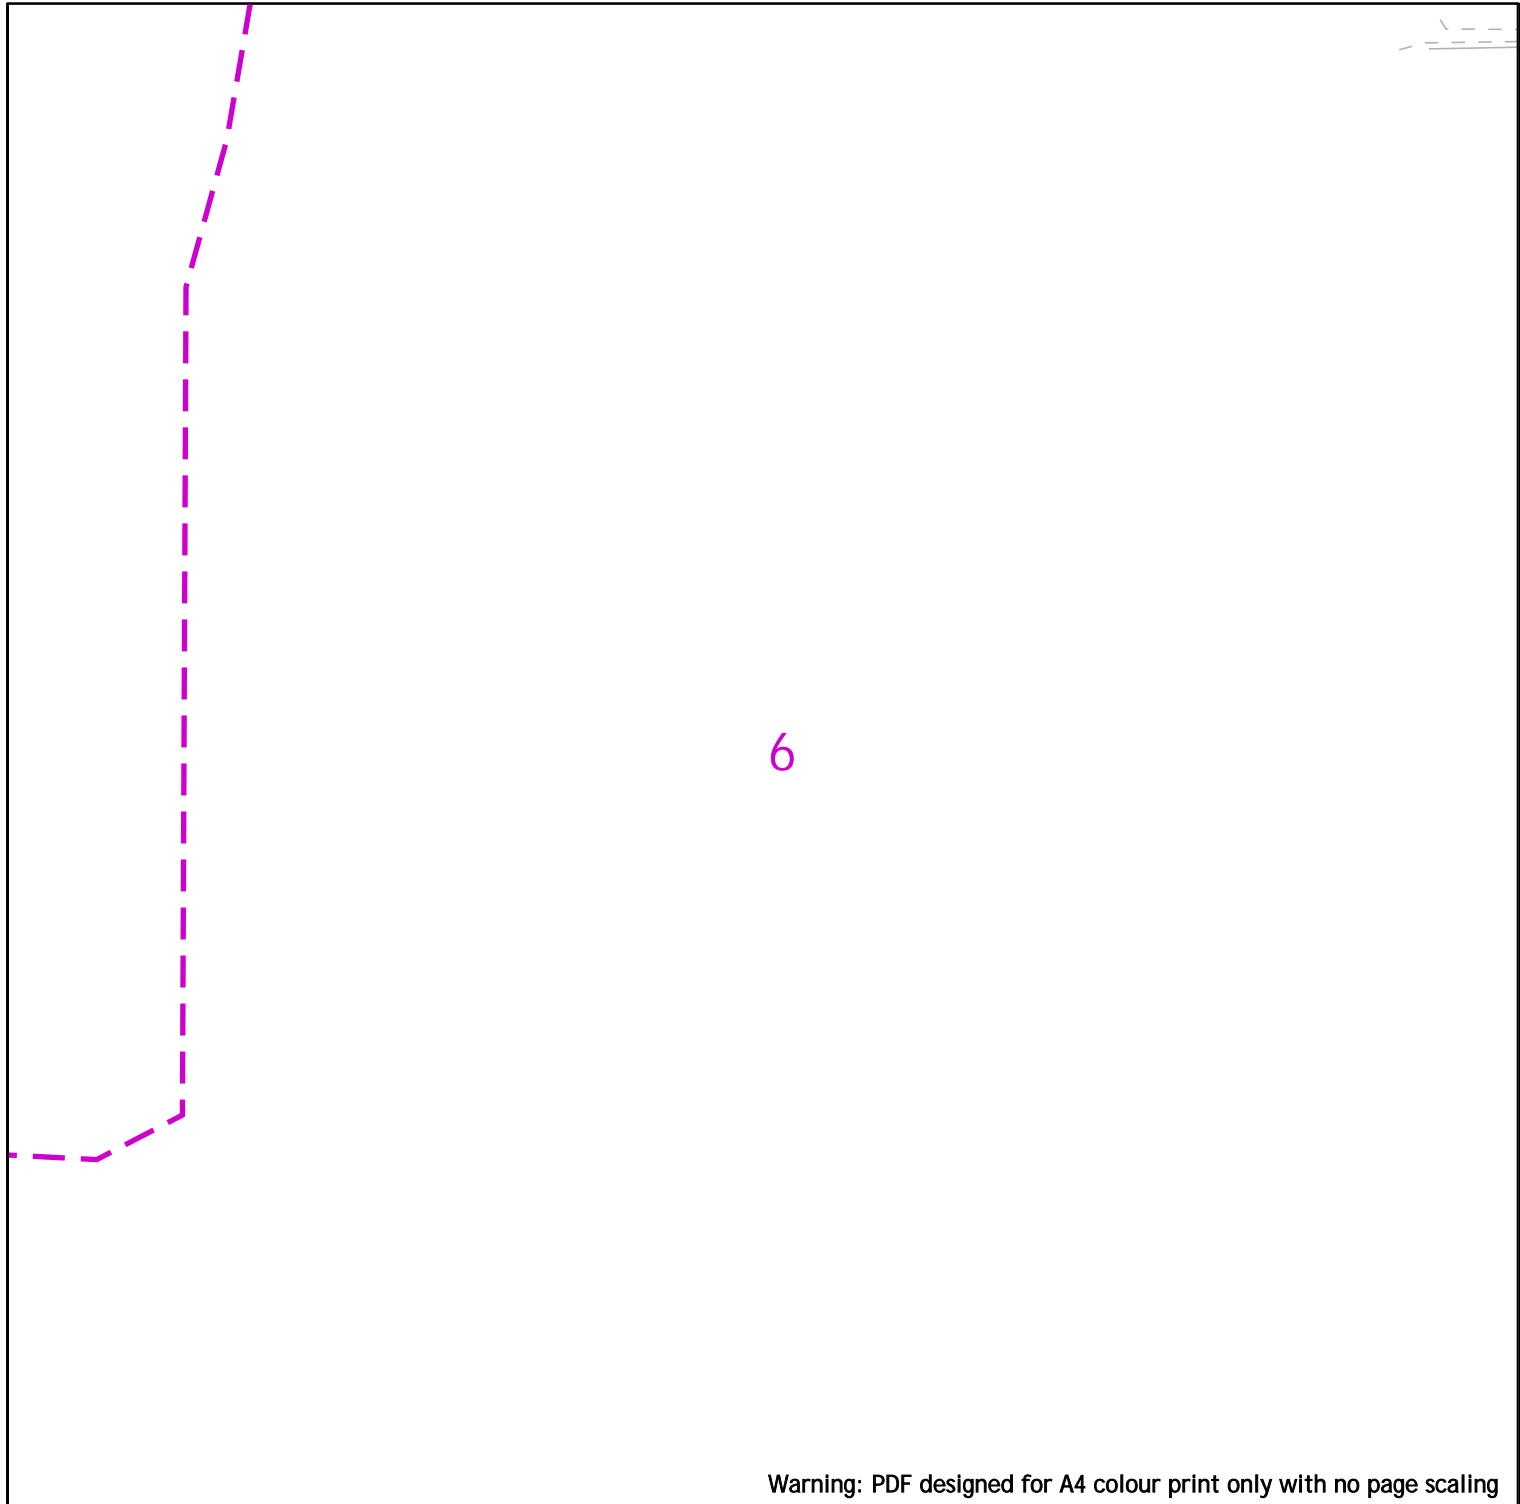
National Grid Electricity Emergency Number: 0800 40 40 90
Available 24 hours, 7 days/week. Calls may be recorded and monitored

Scale: 1:2500 (When plotted at A4)



Warning: PDF designed for A4 colour print only with no page scaling

	 <div style="background-color: red; color: white; padding: 2px; text-align: center; font-weight: bold;"> EXTREME CAUTION - HIGH VOLTAGE **RISK OF DEATH OR SERIOUS INJURY** </div>
<p>NationalGrid House Warwick Technology Park Gallows Hill Warwick CV34 6DA</p> <p>AssetProtection@NationalGrid.com</p>	<p>Dig Sites Area:  Line: </p> <p> Underground Cables</p> <p> Overhead Lines</p> <p> Fibre Cables</p>
<p>Date Requested: 08/05/2023 Job Reference: 29406940 Site Location: 478486 383020 Requested by: Mr Ben Evans</p> <p>Your Scheme/Reference: LM 203570/DK - 5</p> <p>Scale: 1:2500 (When plotted at A4)</p>	<p>IMPORTANT NOTICES This plan shows those pipes owned by National Grid Electricity Transmission plc in its role as a Licensed Electricity Transporter (ET). Electricity cables owned by other ETs, or otherwise privately owned, may be present in this area. Information with regards to such cables should be obtained from the relevant owners. The information shown on this plan is given without warranty, the accuracy thereof cannot be guaranteed. Ancillary equipment such as cooling systems and communication cables are not shown but their presence should be anticipated. No liability of any kind whatsoever is accepted by National Grid Electricity Transmission plc or their agents, servants or contractors for any error or omission. Safe digging practices, in accordance with HS(G)47, must be used to verify and establish the actual position of cables and other apparatus on site before any mechanical plant is used. It is your responsibility to ensure that this information is provided to all persons (either direct labour or contractors) working for you on or near electricity apparatus. The information included on this plan should not be referred to beyond a period of 28 days from the date of issue.</p> <p style="text-align: center; color: red; font-weight: bold;"> National Grid Electricity Emergency Number: 0800 40 40 90 Available 24 hours, 7 days/week. Calls may be recorded and monitored </p> <p style="font-size: small; text-align: center;"> Crown Copyright © - Reproduced by permission of Ordnance Survey on behalf of HMSO. And database right 2023. All rights reserved. Ordnance Survey Licence number 0100059731. </p>

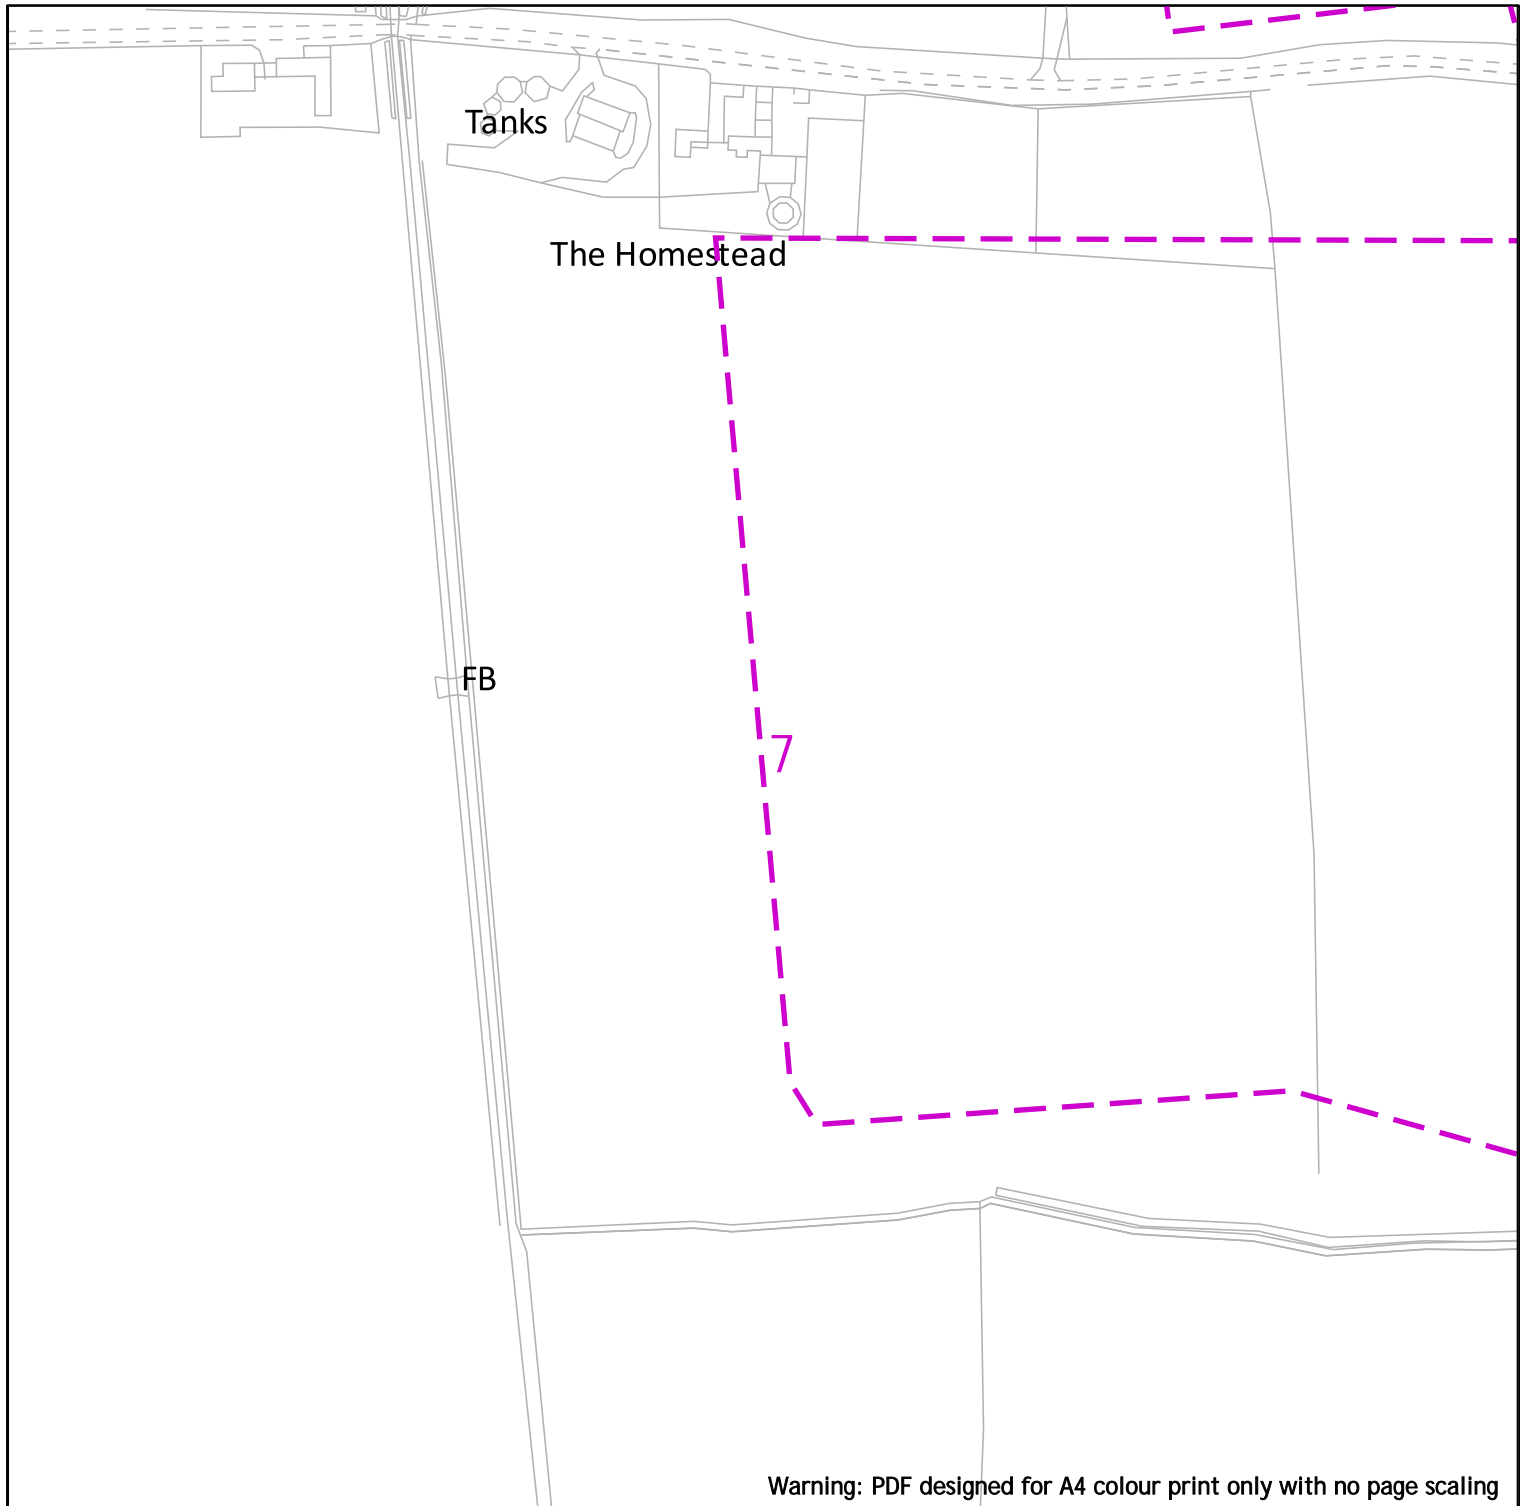

Warning: PDF designed for A4 colour print only with no page scaling



**EXTREME CAUTION - HIGH VOLTAGE
RISK OF DEATH OR SERIOUS INJURY**

Dig Sites	Area:	Line:
	Underground Cables	
	Overhead Lines	
	Fibre Cables	

NationalGrid House
Warwick Technology Park
Gallows Hill
Warwick
CV34 6DA

AssetProtection@NationalGrid.com

Date Requested: 08/05/2023
Job Reference: 29406940
Site Location: 478486 383020
Requested by: Mr Ben Evans


Your Scheme/Reference: LM
203570/DK - 5

IMPORTANT NOTICES

This plan shows those pipes owned by National Grid Electricity Transmission plc in its role as a Licensed Electricity Transporter (ET). Electricity cables owned by other ETs, or otherwise privately owned, may be present in this area. Information with regards to such cables should be obtained from the relevant owners. The information shown on this plan is given without warranty, the accuracy thereof cannot be guaranteed. Ancillary equipment such as cooling systems and communication cables are not shown but their presence should be anticipated. No liability of any kind whatsoever is accepted by National Grid Electricity Transmission plc or their agents, servants or contractors for any error or omission. Safe digging practices, in accordance with HS(G)47, must be used to verify and establish the actual position of cables and other apparatus on site before any mechanical plant is used. It is your responsibility to ensure that this information is provided to all persons (either direct labour or contractors) working for you on or near electricity apparatus. The information included on this plan should not be referred to beyond a period of 28 days from the date of issue.

National Grid Electricity Emergency Number: 0800 40 40 90
Available 24 hours, 7 days/week. Calls may be recorded and monitored

Scale: 1:2500 (When plotted at A4)

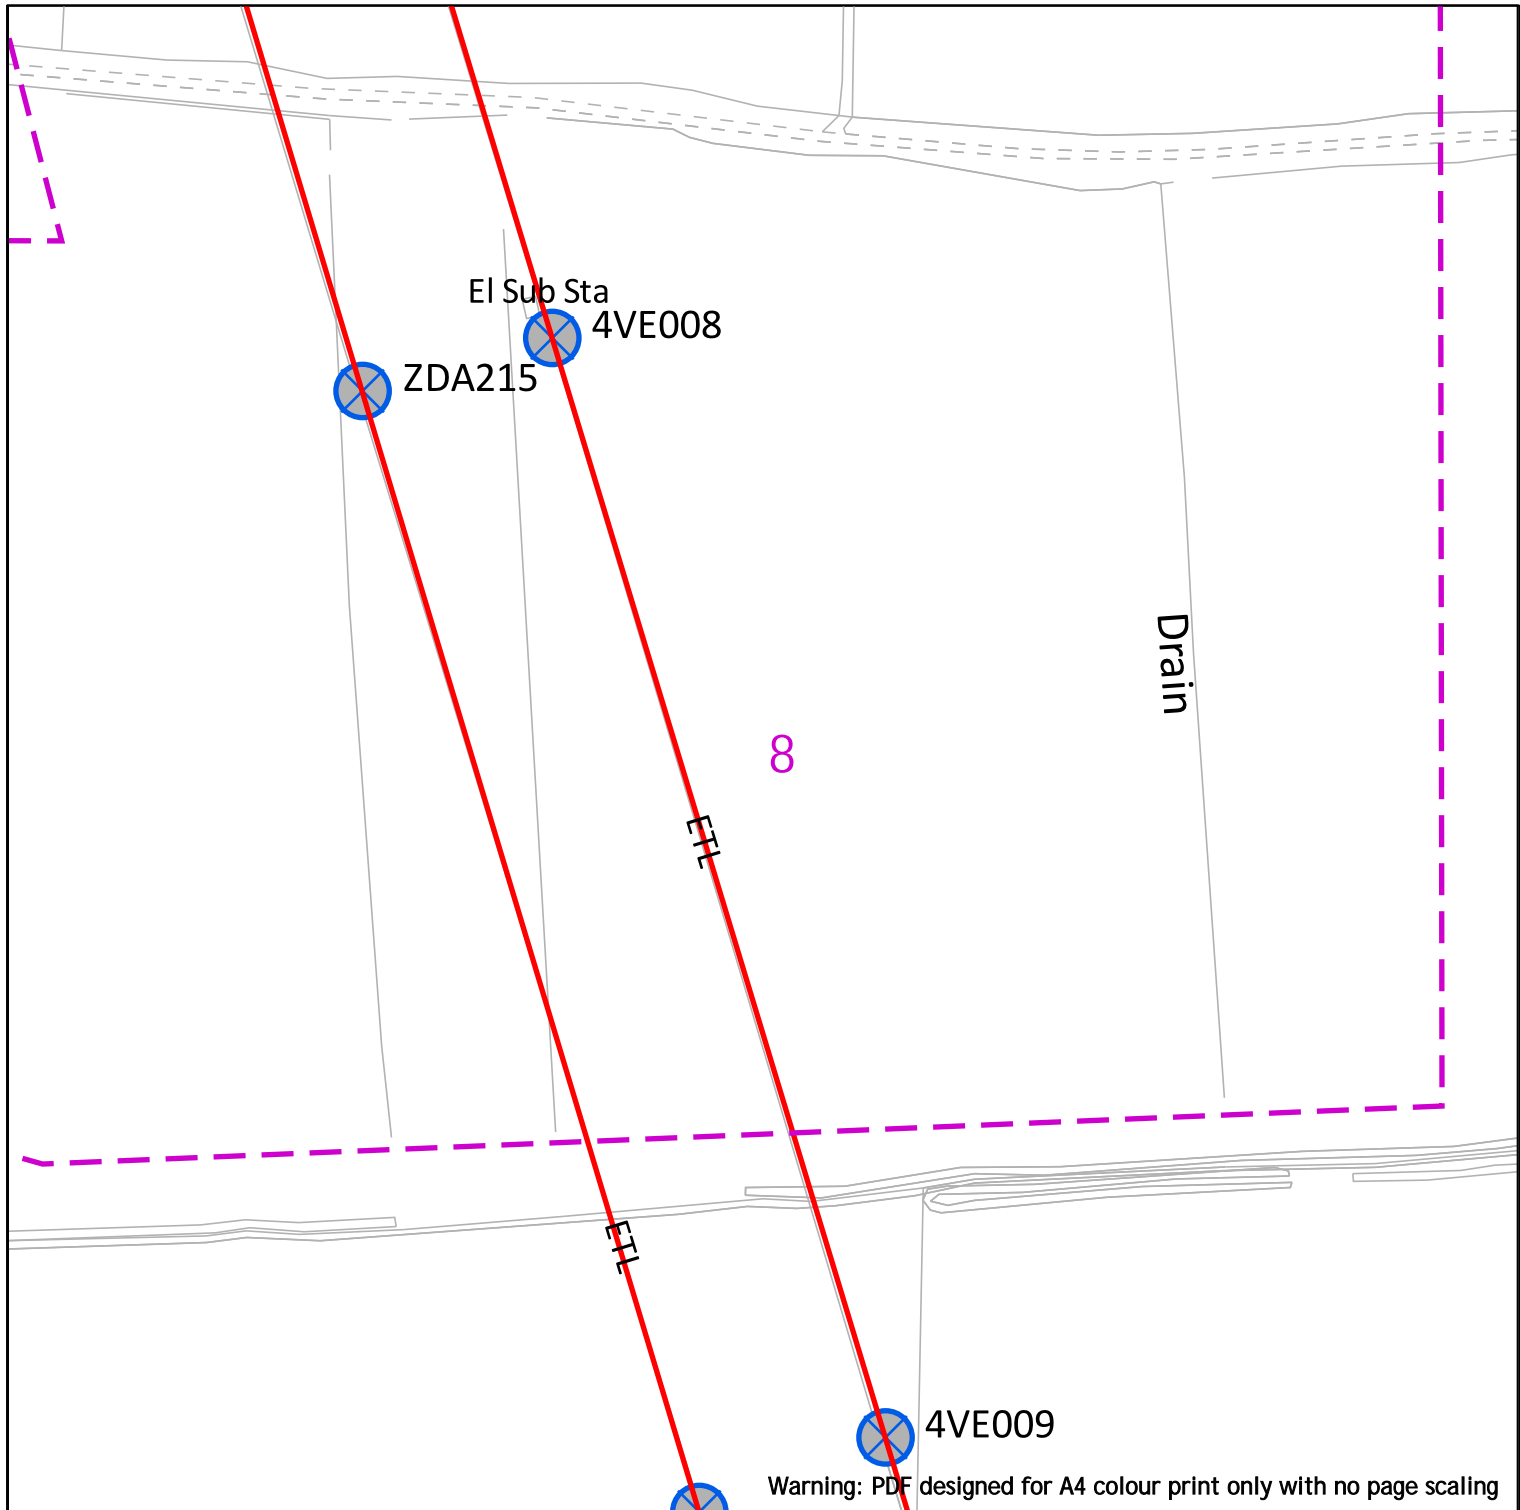

Warning: PDF designed for A4 colour print only with no page scaling

nationalgrid



**EXTREME CAUTION - HIGH VOLTAGE
RISK OF DEATH OR SERIOUS INJURY**

NationalGrid House
Warwick Technology Park
Gallows Hill
Warwick
CV34 6DA

AssetProtection@NationalGrid.com

Date Requested: 08/05/2023
Job Reference: 29406940
Site Location: 478486 383020
Requested by: Mr Ben Evans

Your Scheme/Reference: LM
203570/DK - 5

Dig Sites Area: Line:

 Underground Cables

 Overhead Lines

 Fibre Cables

IMPORTANT NOTICES

This plan shows those pipes owned by National Grid Electricity Transmission plc in its role as a Licensed Electricity Transporter (ET). Electricity cables owned by other ETs, or otherwise privately owned, may be present in this area. Information with regards to such cables should be obtained from the relevant owners. The information shown on this plan is given without warranty, the accuracy thereof cannot be guaranteed. Ancillary equipment such as cooling systems and communication cables are not shown but their presence should be anticipated. No liability of any kind whatsoever is accepted by National Grid Electricity Transmission plc or their agents, servants or contractors for any error or omission. Safe digging practices, in accordance with HS(G)47, must be used to verify and establish the actual position of cables and other apparatus on site before any mechanical plant is used. It is your responsibility to ensure that this information is provided to all persons (either direct labour or contractors) working for you on or near electricity apparatus. The information included on this plan should not be referred to beyond a period of 28 days from the date of issue.

National Grid Electricity Emergency Number: 0800 40 40 90
Available 24 hours, 7 days/week. Calls may be recorded and monitored

Scale: 1:2500 (When plotted at A4)

ENQUIRY SUMMARY

Received Date

08/05/2023 9:34

Work Start Date

30/05/2023

Your Reference

LM 203570/DK - 5

Location

Centre Point: 478486 383020

X Extent:

Y Extent:

Postcode: DN229HF

Map Options

Paper Size: A4

Orientation: PORTRAIT

Scale: 1:2500

Real World Extents: 1947m x 766m

Enquirer Details

Organisation Name: Atkins - Utility Solutions

Contact Name: Ben Evans

Email Address: searches.utilitysolutions@atkinglobal.com

Telephone: 01454662086

Address: The Hub, 500 Park Avenue, Aztec West, , Bristol, BS32 4RZ

Enquiry Type

Initial Enquiry

Activity Type

Utility Works

Work Types

Single excavations site (deeper than 1.5m)

Notes/Works Description (if supplied)

Site Contact Name (if supplied)

Site Contact Number (if supplied)

Our Ref: 29406941 LM 203570/DK - 6

Monday, 08 May 2023

Ben Evans
The Hub, 500 Park Avenue, Aztec West

Bristol
BS32 4RZ

National Grid House
Warwick Technology Park
Gallows Hill, Warwick
CV34 6DA

Electricity Emergency Number:
0800 40 40 90*
*Available 24 hours, 7 days/week.
Calls may be recorded and monitored.
www.nationalgrid.com

Asset Protection
Gas Transmission
National Grid
Warwick
Email: assetprotection@nationalgrid.com

National Grid Electricity – High Risk Response Letter

Dear Sir/ Madam,

An assessment has been carried out with respect to National Grid Electricity Transmission plc's apparatus and the proposed work location. Based on the location entered into the system for assessment the area has been found to be within the High Risk zone from National Grid Electricity Transmission plc's apparatus and **Must Not Proceed** without further assessment by Asset Protection.

Could you please send a works description (including how deep you are excavating) and any plans including any commencement dates to the following email address assetprotection@nationalgrid.com including the LSBUD enquiry reference number.

Failure to provide this information will result in a delay to your works being assessed.

Please note this response and any attached map(s) are valid for 28 days from date of this letter. A new enquiry will need to be submitted into LSBUD if the requested information above is not supplied within 28 days.

Yours sincerely,

Asset Protection

Your Responsibilities and Obligations

The "Assessment" Section below outlines the detailed requirements that must be followed when planning or undertaking your activities at this location.

It is your responsibility to ensure that the information you have submitted is accurate and that all relevant documents including links are provided to all persons (either direct labour or contractors) working for you near National Grid Electricity Transmission plc's apparatus, e.g. as contained within the Construction (Design and Management) Regulations.

This assessment solely relates to National Grid Electricity Transmission plc (NGET)

This assessment does **NOT** include:

- National Grid's legal interest (easements or wayleaves) in the land which restricts activity in proximity to National Grid's assets in private land. You must obtain details of any such restrictions from the landowner in the first instance and if in doubt contact Asset Protection.
- Recently installed apparatus
- National Grid Gas plc.
- Apparatus owned by other organisations, e.g. Cadent, other gas distribution operators, local electricity companies, other utilities, etc.

It is **YOUR** responsibility to take into account whether the items listed above may be present and if they could be affected by your proposed activities.

This communication does not constitute any formal agreement or consent for any proposed development work; either generally or with regard to National Grid Electricity Transmission plc easements or wayleaves nor any planning or building regulations applications.

National Grid Electricity Transmission plc or their agents, servants or contractors do not accept any liability for any losses arising under or in connection with this information. This limit on liability applies to all and any claims in contract, tort (including negligence), misrepresentation (excluding fraudulent misrepresentation), breach of statutory duty or otherwise. This limit on liability does not exclude or restrict liability where prohibited by the law nor does it supersede the express terms of any related agreements.

If you require further assistance please contact the Asset Protection team via e-mail (assetprotection@nationalgrid.com) or via the contact details at the top of this response.

Assessment

Affected Apparatus

The apparatus that has been identified as being in the vicinity of your proposed works is:

- Electricity Transmission Overhead Line apparatus.

Requirements

Over Head Lines

BEFORE carrying out any work you must:

(N.B. Works only to be undertaken when contact has been made and response received from Asset Protection)

- Carefully read these requirements including the attached guidance documents and maps showing the location of apparatus.
- Contact the landowner and ensure any proposed works in private land do not infringe National Grid Electricity Transmission plc's legal rights (i.e. easements or wayleaves). If the works are in the road or footpath the relevant local authority should be contacted.
- Ensure that all persons, including direct labour and contractors, working for you on or near National Grid Electricity Transmission plc's apparatus follow the requirements of the HSE Guidance Notes HSG47 - 'Avoiding Danger from Underground Services' and GS6 – 'Avoidance of danger from overhead electric power lines'. This guidance can be downloaded free of charge at www.hse.gov.uk
- In line with the above guidance, verify and establish the actual position of mains, pipes, cables, services and other apparatus on site before any activities are undertaken.

DURING any work you must:

- Comply with all guidance for working within the vicinity of overhead lines as detailed within the guidance documents listed below.
- Comply with all guidance relating to general activities and any specific guidance for each asset type as specified in the Guidance Section below.
- Ensure that access to National Grid Electricity Transmission plc's apparatus is maintained at all times.
- Prevent the placing of heavy construction plant, equipment, materials or the passage of heavy vehicles over National Grid Electricity Transmission plc's apparatus unless specifically agreed with National Grid Electricity Transmission plc's apparatus in advance.
- Exercise extreme caution if slab (mass) concrete is encountered during excavation works as this maybe protecting or supporting National Grid Electricity Transmission plc's apparatus.

Underground Cables

BEFORE carrying out any work you must:

(N.B. Works only to be undertaken when contact has been made and response received from Asset Protection)

- Refer to the attached cable profile drawings which provide details about the location of National Grid's high voltage underground cables.
- Carefully read these requirements including the attached guidance documents and maps showing the location of apparatus.
- Contact the landowner and ensure any proposed works in private land do not infringe National Grid Electricity Transmission plc's legal rights (i.e. easements or wayleaves). If the works are in the road or footpath the relevant local authority should be contacted.
- Ensure that all persons, including direct labour and contractors, working for you on or near infringe National Grid Electricity Transmission plc's follow the requirements of the HSE Guidance Notes HS(G)47 "Avoiding Danger From Underground Services". This guidance can be downloaded free of charge at www.hse.gov.uk
- In line with the above guidance, verify and establish the actual position of mains, pipes, cables,

National Grid is a trading name for:

National Grid Electricity Transmission plc

Registered Office: 1-3 Strand, London WC2N 5EH

Registered in England and Wales, No 2366977

services and other apparatus on site before any activities are undertaken.

DURING any work you must:

- Comply with all guidance for working within the vicinity of Electricity Underground Cables as detailed within the guidance documents listed below.
- Comply with all guidance relating to general activities and any specific guidance for each asset type as specified in the Guidance Section below.
- Ensure that access to National Grid Electricity Transmission plc's apparatus is maintained at all times.
- Prevent the placing of heavy construction plant, equipment, materials or the passage of heavy vehicles over National Grid Electricity Transmission plc's apparatus unless specifically agreed with National Grid Electricity Transmission plc's in advance.
- Exercise extreme caution if slab (mass) concrete is encountered during excavation works as this maybe protecting or supporting National Grid Electricity Transmission plc's apparatus.

GUIDANCE

National Grid Electricity Transmission Network data

- The Network map for National Grid Electricity Transmission assets can be downloaded at the following link in GIS format.

<https://www.nationalgrid.com/uk/electricity-transmission/network-and-infrastructure/network-route-maps>

Buried Cables

- National Grid's underground cables are protected by a Deed of grant; Easement; Wayleave Agreement or the provisions of the New Roads and Street Works Act. Which provide full right of access to retain, maintain, repair and inspect our asset. Hence we require that no permanent structures are to be built over our cables or within the easement strip.
- Ground levels above our cables must not be altered in any way. Any alterations to the depth of our cables will subsequently alter the rating of the circuit and can compromise the reliability, efficiency and safety of our electricity network.
- The supplied detailed route records should not be taken as positive indication of the cable location. This can only be determined by digging trial holes. Where trial holes are dug the concrete and / or polymeric cable protection tiles must not be disturbed.
- The normal recommendation is to keep 2 metres clear either side of the 1 metre wide trench containing the AC cable.
- National Grid should be made aware of the works starting and may put in place a representative to monitor the works. The works should be carried out in accordance with the recommendations in document HS (G) 47 available from the HSE web site.
- The relocation of existing underground cables is not normally feasible on grounds of cost, operation and maintenance and environmental impact and we believe that successful development can take place in their vicinity.
- The information supplied is given in good faith and only as a guide to the location of our underground cables. The accuracy of this information cannot be guaranteed. The physical presence of such cables may also be evident from physical protection measures such as ducts or concrete protection tiles. The person(s) responsible for planning, supervising and carrying out work in proximity to our cable(s) shall be liable to us, as cable(s) owner, as well as to any third party who may be affected in any way by any loss or damage resulting from their failure to locate and avoid any damage to such a cable(s).
- The relevant guidance in relation to working safely near to existing underground cables is contained within the Health and Safety Executive's (www.hse.gov.uk) Guidance HS(G)47 "Avoiding Danger From Underground Services" and all relevant site staff should make sure that they are both aware of and understand this guidance.
- Our cables are normally buried to a depth of 0.9 metres to the protective covers but this depth can vary depending on location (bridges may have cables 100mm below surface level)..The specific cable route record drawings show further details along the route of the particular cable. The cable route drawings are attached to this letter for your information.
- Cables installed in cable tunnels, whilst less likely to be affected by surface or shallow works may be affected by activities such as piling.
- National Grid assets can be adversely affected by vibration and can provide guidance on the acceptable levels of vibration due to piling and other construction related operations in the vicinity of national grid assets
- Ground cover above our cables should not be reduced or increased without consultation with National Grid.

National Grid is a trading name for:

National Grid Electricity Transmission plc

Registered Office: 1-3 Strand, London WC2N 5EH

Registered in England and Wales, No 2366977

- If a landscaping scheme is proposed as part of the works, we request that no trees and shrubs are planted either directly above or within 3 metres of the existing underground cable, as ultimately the roots may grow to cause damage to the cable.

Cables Tunnels


- National Grid's underground cable tunnels are protected by the provisions of a Wayleave/Easement or the New Roads and Street Works Act. This provides full right of access to retain, maintain, repair and inspect our asset.
- Further information and guidance regarding National Grid Cable Tunnels is available on our website at <https://www.nationalgrid.com/uk/electricity-transmission/document/121061/download>
- National Grid requires that the clearances indicated in the guidance document linked above are maintained at all times. Should it be necessary to enter the exclusion zone discussion/ agreement with National Grid is required to ensure the integrity of their tunnel asset and the high voltage cables is not compromised.
- Ground levels above our cable tunnels must not be altered in any way without prior agreement with National Grid; any alterations to the depth of our tunnels can compromise its integrity which could have an adverse impact on the reliability, efficiency and safety of our electricity network.
- Any works which would create high levels of vibration such as piling would need to be assessed by National Grid to ensure it has limited impact on our cable tunnels. National Grid can advise on acceptable vibration limits.

Overhead Lines

- National Grid's Overhead Line/s is protected by a Deed of Easement/Wayleave Agreement which provides full right of access to retain, maintain, repair and inspect our asset.
- The submitted proposed design does not change after the date of this letter. Any design change that moves the proposal closer to National Grid Overhead Line Assets shall be submitted for assessment.
- Statutory electrical safety clearances shall be maintained at all times. National Grid recommends that no permanent structures are built directly beneath our overhead lines. These distances are set out in EN 43 – 8 Technical Specification for "Overhead Line Clearances Issue 5 (2019). To purchase & download EN 43 – 8 Technical Specification for "Overhead Line Clearances Issue 5 (2019) go to <https://www.ena-eng.org/ENA-Docs/>
- Any changes in ground levels which are proposed either beneath or in close proximity to our existing overhead lines would serve to reduce safety clearances. Safety clearances to existing overhead lines must be maintained in all circumstances.
- To view the Development Near Overhead Lines Document.
<https://www.nationalgridet.com/document/130626/download>
- To view the National Grid Third Party Guidance for working near National Grid Electricity Transmission equipment.
<https://www.nationalgridet.com/sites/et/files/documents/Working%20near%20electricity%20equipment.pdf>

- The relevant guidance in relation to working safely near to existing overhead lines is contained within the Health and Safety Executive's (www.hse.gov.uk) Guidance Note GS 6 "Avoidance of Danger from Overhead Electric Lines."
- If a landscaping scheme is proposed as part of the proposal, only slow and low growing species of trees and shrubs shall be planted beneath and adjacent to the existing overhead line to reduce the risk of growth to a height which compromises statutory safety clearances.
- Drilling or excavation works shall not be undertaken if they have the potential to disturb or adversely affect the foundations or "pillars of support" of our towers. These foundations extend beyond the base of the tower. Pillar of Support drawings shall be obtained using the contact details above.
- Due to the scale, bulk and cost of the transmission equipment required to operate at 275kV or 400kV we only support proposals for the relocation of existing high voltage overhead lines where such proposals directly facilitate a major development or infrastructure project of national importance which has been identified as such by government.
- To promote the successful development of sites crossed by existing overhead lines, and the creation of well-designed places, National Grid has produced 'Design guidelines for development near pylons and high voltage overhead power lines', which look at how to create high quality development near overhead lines and offer practical solutions which can assist in avoiding the unnecessary sterilisation of land in the vicinity of high voltage overhead lines.
- Further information regarding our undergrounding policy and development near transmission overhead lines is available on our website at: <https://www.nationalgridet.com/network-and-assets/planning-and-development>


Overview map of worksite

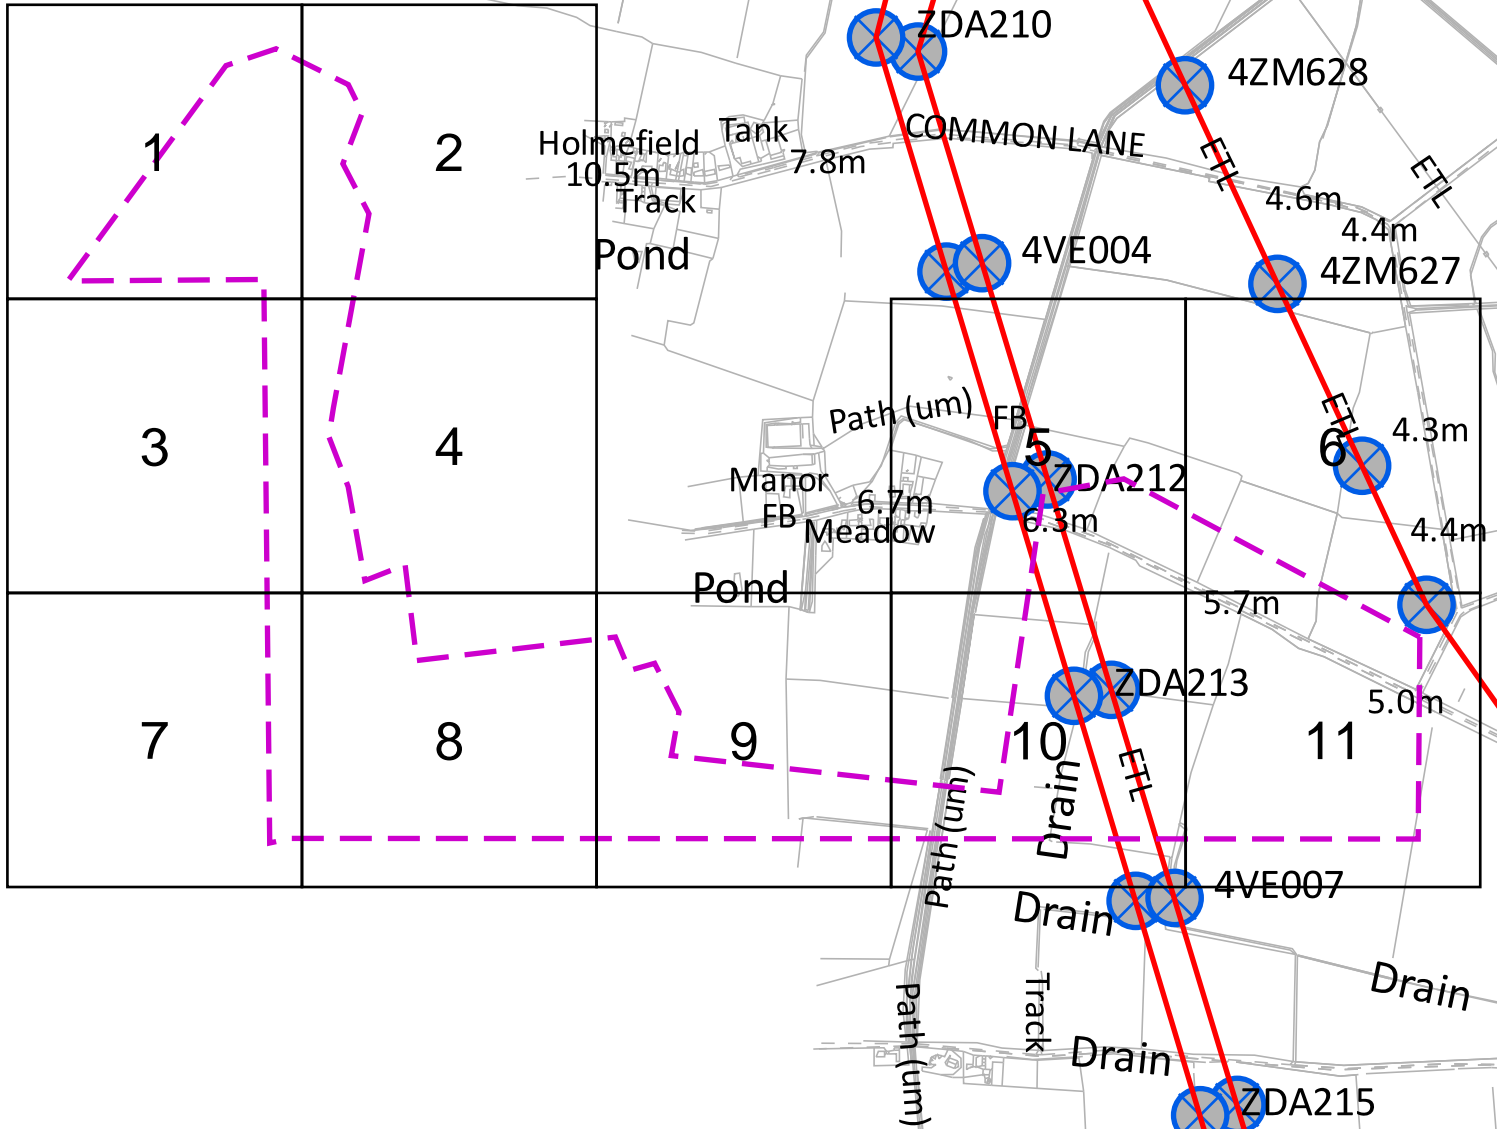

Warning: PDF designed for A4 colour print only with no page scaling



**EXTREME CAUTION - HIGH VOLTAGE
RISK OF DEATH OR SERIOUS INJURY**

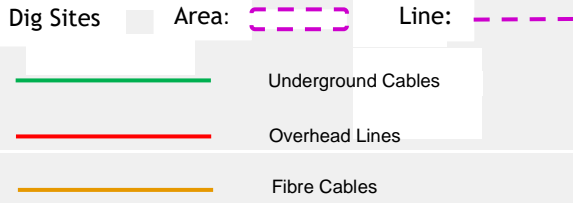

NationalGrid House
Warwick Technology Park
Gallows Hill
Warwick
CV34 6DA

AssetProtection@NationalGrid.com


Date Requested: 08/05/2023
Job Reference: 29406941
Site Location: 478276 384020
Requested by: Mr Ben Evans

Your Scheme/Reference: LM
203570/DK - 6

IMPORTANT NOTICES
This plan shows those pipes owned by National Grid Electricity Transmission plc in its role as a Licensed Electricity Transporter (ET). Electricity cables owned by other ETs, or otherwise privately owned, may be present in this area. Information with regards to such cables should be obtained from the relevant owners. The information shown on this plan is given without warranty, the accuracy thereof cannot be guaranteed. Ancillary equipment such as cooling systems and communication cables are not shown but their presence should be anticipated. No liability of any kind whatsoever is accepted by National Grid Electricity Transmission plc or their agents, servants or contractors for any error or omission. Safe digging practices, in accordance with HS(G)47, must be used to verify and establish the actual position of cables and other apparatus on site before any mechanical plant is used. It is your responsibility to ensure that this information is provided to all persons (either direct labour or contractors) working for you on or near electricity apparatus. The information included on this plan should not be referred to beyond a period of 28 days from the date of issue.

National Grid Electricity Emergency Number: 0800 40 40 90
Available 24 hours, 7 days/week. Calls may be recorded and monitored

Scale: 1:12813 (When plotted at A4)

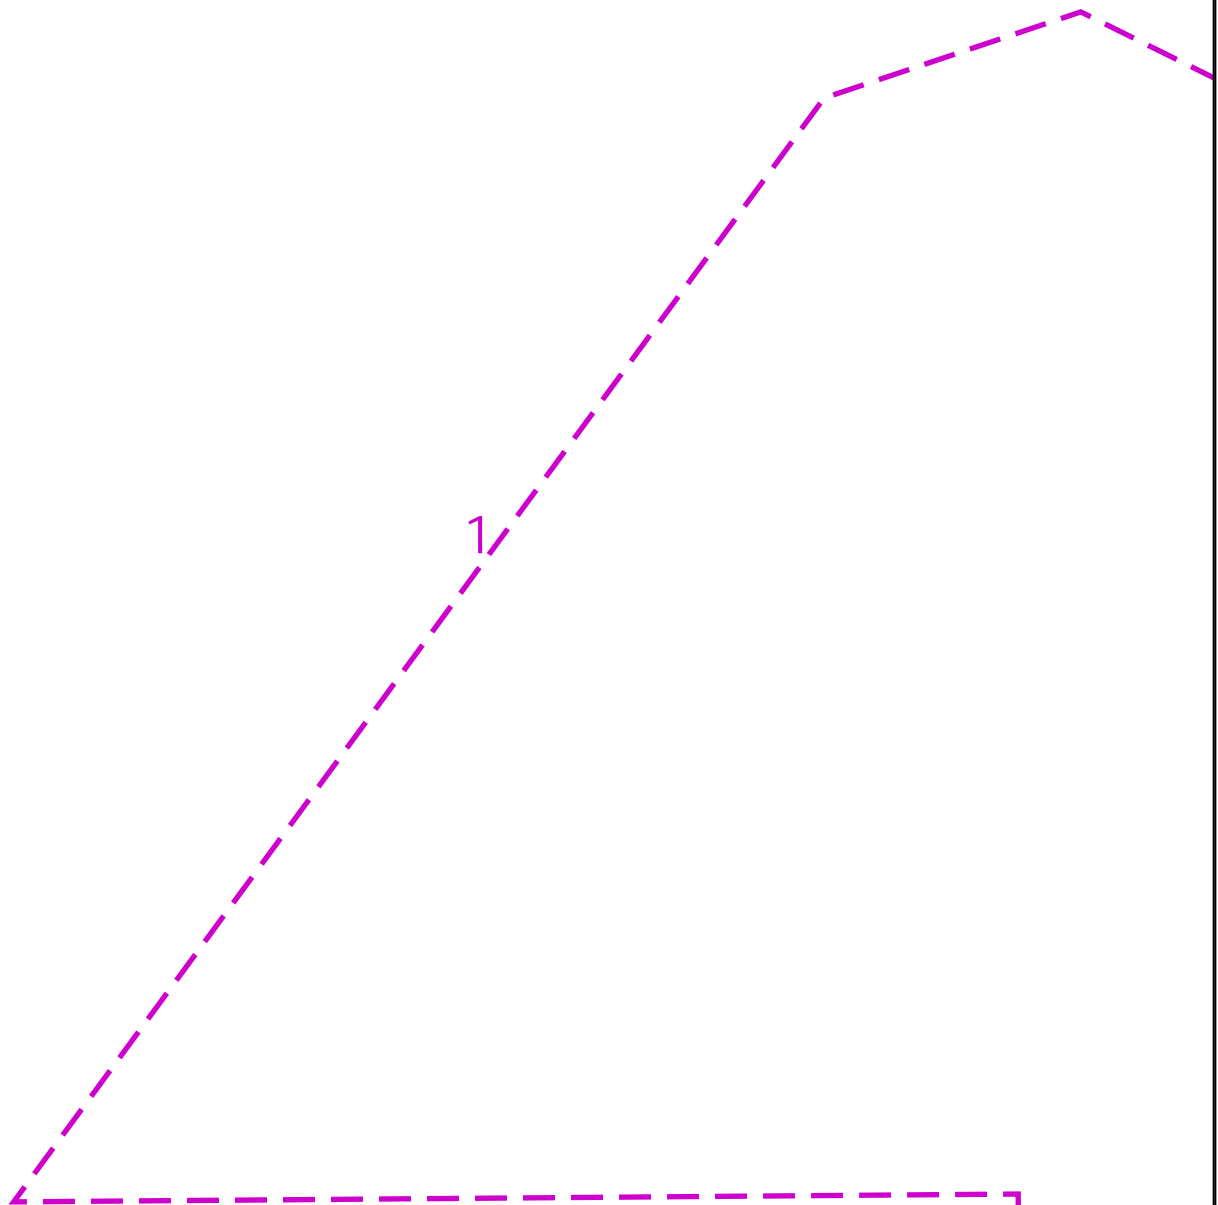


Warning: PDF designed for A4 colour print only with no page scaling

nationalgrid



**EXTREME CAUTION - HIGH VOLTAGE
RISK OF DEATH OR SERIOUS INJURY**

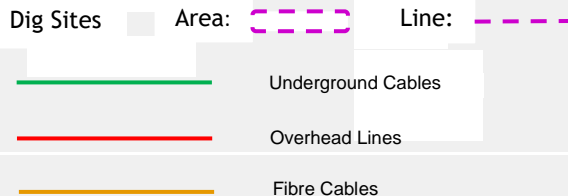

NationalGrid House
Warwick Technology Park
Gallows Hill
Warwick
CV34 6DA

AssetProtection@NationalGrid.com

Date Requested: 08/05/2023
Job Reference: 29406941
Site Location: 478276 384020
Requested by: Mr Ben Evans

Your Scheme/Reference: LM
203570/DK - 6

IMPORTANT NOTICES

This plan shows those pipes owned by National Grid Electricity Transmission plc in its role as a Licensed Electricity Transporter (ET). Electricity cables owned by other ETs, or otherwise privately owned, may be present in this area. Information with regards to such cables should be obtained from the relevant owners. The information shown on this plan is given without warranty, the accuracy thereof cannot be guaranteed. Ancillary equipment such as cooling systems and communication cables are not shown but their presence should be anticipated. No liability of any kind whatsoever is accepted by National Grid Electricity Transmission plc or their agents, servants or contractors for any error or omission. Safe digging practices, in accordance with HS(G)47, must be used to verify and establish the actual position of cables and other apparatus on site before any mechanical plant is used. It is your responsibility to ensure that this information is provided to all persons (either direct labour or contractors) working for you on or near electricity apparatus. The information included on this plan should not be referred to beyond a period of 28 days from the date of issue.

National Grid Electricity Emergency Number: 0800 40 40 90

Available 24 hours, 7 days/week. Calls may be recorded and monitored

Scale: 1:2500 (When plotted at A4)



Warning: PDF designed for A4 colour print only with no page scaling

nationalgrid

NationalGrid House
 Warwick Technology Park
 Gallows Hill
 Warwick
 CV34 6DA

AssetProtection@NationalGrid.com

0 200

**EXTREME CAUTION - HIGH VOLTAGE
 RISK OF DEATH OR SERIOUS INJURY**

Dig Sites Area: Line:

 Underground Cables

 Overhead Lines

 Fibre Cables

Date Requested: 08/05/2023
 Job Reference: 29406941
 Site Location: 478276 384020
 Requested by: Mr Ben Evans

Your Scheme/Reference: LM
 203570/DK - 6

Scale: 1:2500 (When plotted at A4)

IMPORTANT NOTICES
 This plan shows those pipes owned by National Grid Electricity Transmission plc in its role as a Licensed Electricity Transporter (ET). Electricity cables owned by other ETs, or otherwise privately owned, may be present in this area. Information with regards to such cables should be obtained from the relevant owners. The information shown on this plan is given without warranty, the accuracy thereof cannot be guaranteed. Ancillary equipment such as cooling systems and communication cables are not shown but their presence should be anticipated. No liability of any kind whatsoever is accepted by National Grid Electricity Transmission plc or their agents, servants or contractors for any error or omission. Safe digging practices, in accordance with HS(G)47, must be used to verify and establish the actual position of cables and other apparatus on site before any mechanical plant is used. It is your responsibility to ensure that this information is provided to all persons (either direct labour or contractors) working for you on or near electricity apparatus. The information included on this plan should not be referred to beyond a period of 28 days from the date of issue.

National Grid Electricity Emergency Number: 0800 40 40 90
 Available 24 hours, 7 days/week. Calls may be recorded and monitored

Crown Copyright © - Reproduced by permission of Ordnance Survey on behalf of HMSO. And database right 2023. All rights reserved. Ordnance Survey Licence number 0100059731.

3



Warning: PDF designed for A4 colour print only with no page scaling



**EXTREME CAUTION - HIGH VOLTAGE
RISK OF DEATH OR SERIOUS INJURY**

Dig Sites Area: Line:

Underground Cables

Overhead Lines

Fibre Cables

NationalGrid House
 Warwick Technology Park
 Gallows Hill
 Warwick
 CV34 6DA
 AssetProtection@NationalGrid.com

Date Requested: 08/05/2023
 Job Reference: 29406941
 Site Location: 478276 384020
 Requested by: Mr Ben Evans
 Your Scheme/Reference: LM
 203570/DK - 6

IMPORTANT NOTICES

This plan shows those pipes owned by National Grid Electricity Transmission plc in its role as a Licensed Electricity Transporter (ET). Electricity cables owned by other ETs, or otherwise privately owned, may be present in this area. Information with regards to such cables should be obtained from the relevant owners. The information shown on this plan is given without warranty, the accuracy thereof cannot be guaranteed. Ancillary equipment such as cooling systems and communication cables are not shown but their presence should be anticipated. No liability of any kind whatsoever is accepted by National Grid Electricity Transmission plc or their agents, servants or contractors for any error or omission. Safe digging practices, in accordance with HS(G)47, must be used to verify and establish the actual position of cables and other apparatus on site before any mechanical plant is used. It is your responsibility to ensure that this information is provided to all persons (either direct labour or contractors) working for you on or near electricity apparatus. The information included on this plan should not be referred to beyond a period of 28 days from the date of issue.

National Grid Electricity Emergency Number: 0800 40 40 90
 Available 24 hours, 7 days/week. Calls may be recorded and monitored

Scale: 1:2500 (When plotted at A4)



4

Warning: PDF designed for A4 colour print only with no page scaling



**EXTREME CAUTION - HIGH VOLTAGE
RISK OF DEATH OR SERIOUS INJURY**

Dig Sites	Area:	Line:
	Underground Cables	
	Overhead Lines	
	Fibre Cables	

NationalGrid House
Warwick Technology Park
Gallows Hill
Warwick
CV34 6DA

AssetProtection@NationalGrid.com

Date Requested: 08/05/2023
Job Reference: 29406941
Site Location: 478276 384020
Requested by: Mr Ben Evans


Your Scheme/Reference: LM
203570/DK - 6

Scale: 1:2500 (When plotted at A4)

IMPORTANT NOTICES
This plan shows those pipes owned by National Grid Electricity Transmission plc in its role as a Licensed Electricity Transporter (ET). Electricity cables owned by other ETs, or otherwise privately owned, may be present in this area. Information with regards to such cables should be obtained from the relevant owners. The information shown on this plan is given without warranty, the accuracy thereof cannot be guaranteed. Ancillary equipment such as cooling systems and communication cables are not shown but their presence should be anticipated. No liability of any kind whatsoever is accepted by National Grid Electricity Transmission plc or their agents, servants or contractors for any error or omission. Safe digging practices, in accordance with HS(G)47, must be used to verify and establish the actual position of cables and other apparatus on site before any mechanical plant is used. It is your responsibility to ensure that this information is provided to all persons (either direct labour or contractors) working for you on or near electricity apparatus. The information included on this plan should not be referred to beyond a period of 28 days from the date of issue.

National Grid Electricity Emergency Number: 0800 40 40 90
Available 24 hours, 7 days/week. Calls may be recorded and monitored

Crown Copyright © - Reproduced by permission of Ordnance Survey on behalf of HMSO. And database right 2023. All rights reserved. Ordnance Survey Licence number 0100059731.

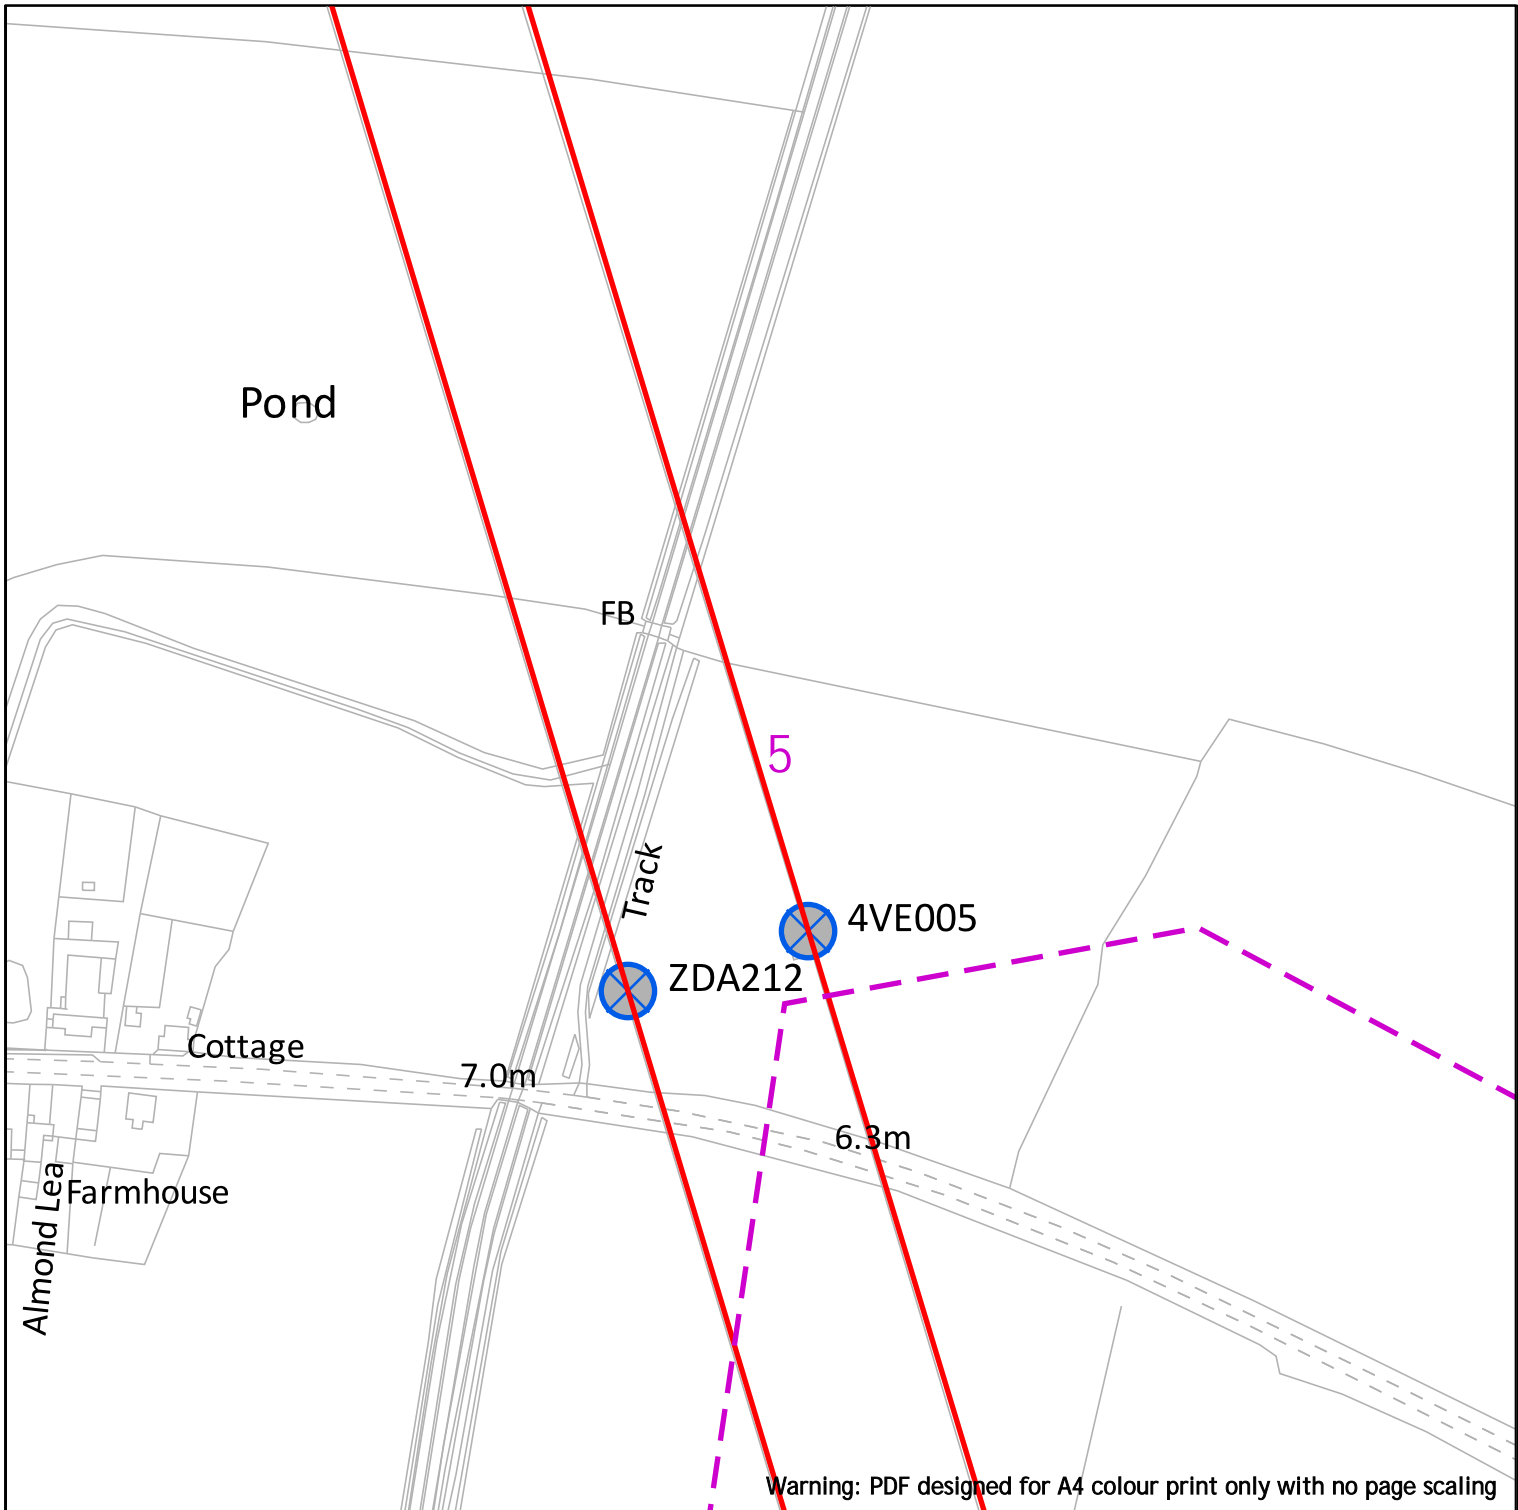

Warning: PDF designed for A4 colour print only with no page scaling



**EXTREME CAUTION - HIGH VOLTAGE
RISK OF DEATH OR SERIOUS INJURY**

Dig Sites	Area:	Line:
	Underground Cables	
	Overhead Lines	
	Fibre Cables	

NationalGrid House
Warwick Technology Park
Gallows Hill
Warwick
CV34 6DA

AssetProtection@NationalGrid.com


Date Requested: 08/05/2023
Job Reference: 29406941
Site Location: 478276 384020
Requested by: Mr Ben Evans

Your Scheme/Reference: LM
203570/DK - 6

IMPORTANT NOTICES
This plan shows those pipes owned by National Grid Electricity Transmission plc in its role as a Licensed Electricity Transporter (ET). Electricity cables owned by other ETs, or otherwise privately owned, may be present in this area. Information with regards to such cables should be obtained from the relevant owners. The information shown on this plan is given without warranty, the accuracy thereof cannot be guaranteed. Ancillary equipment such as cooling systems and communication cables are not shown but their presence should be anticipated. No liability of any kind whatsoever is accepted by National Grid Electricity Transmission plc or their agents, servants or contractors for any error or omission. Safe digging practices, in accordance with HS(G)47, must be used to verify and establish the actual position of cables and other apparatus on site before any mechanical plant is used. It is your responsibility to ensure that this information is provided to all persons (either direct labour or contractors) working for you on or near electricity apparatus. The information included on this plan should not be referred to beyond a period of 28 days from the date of issue.

National Grid Electricity Emergency Number: 0800 40 40 90
Available 24 hours, 7 days/week. Calls may be recorded and monitored

Scale: 1:2500 (When plotted at A4)

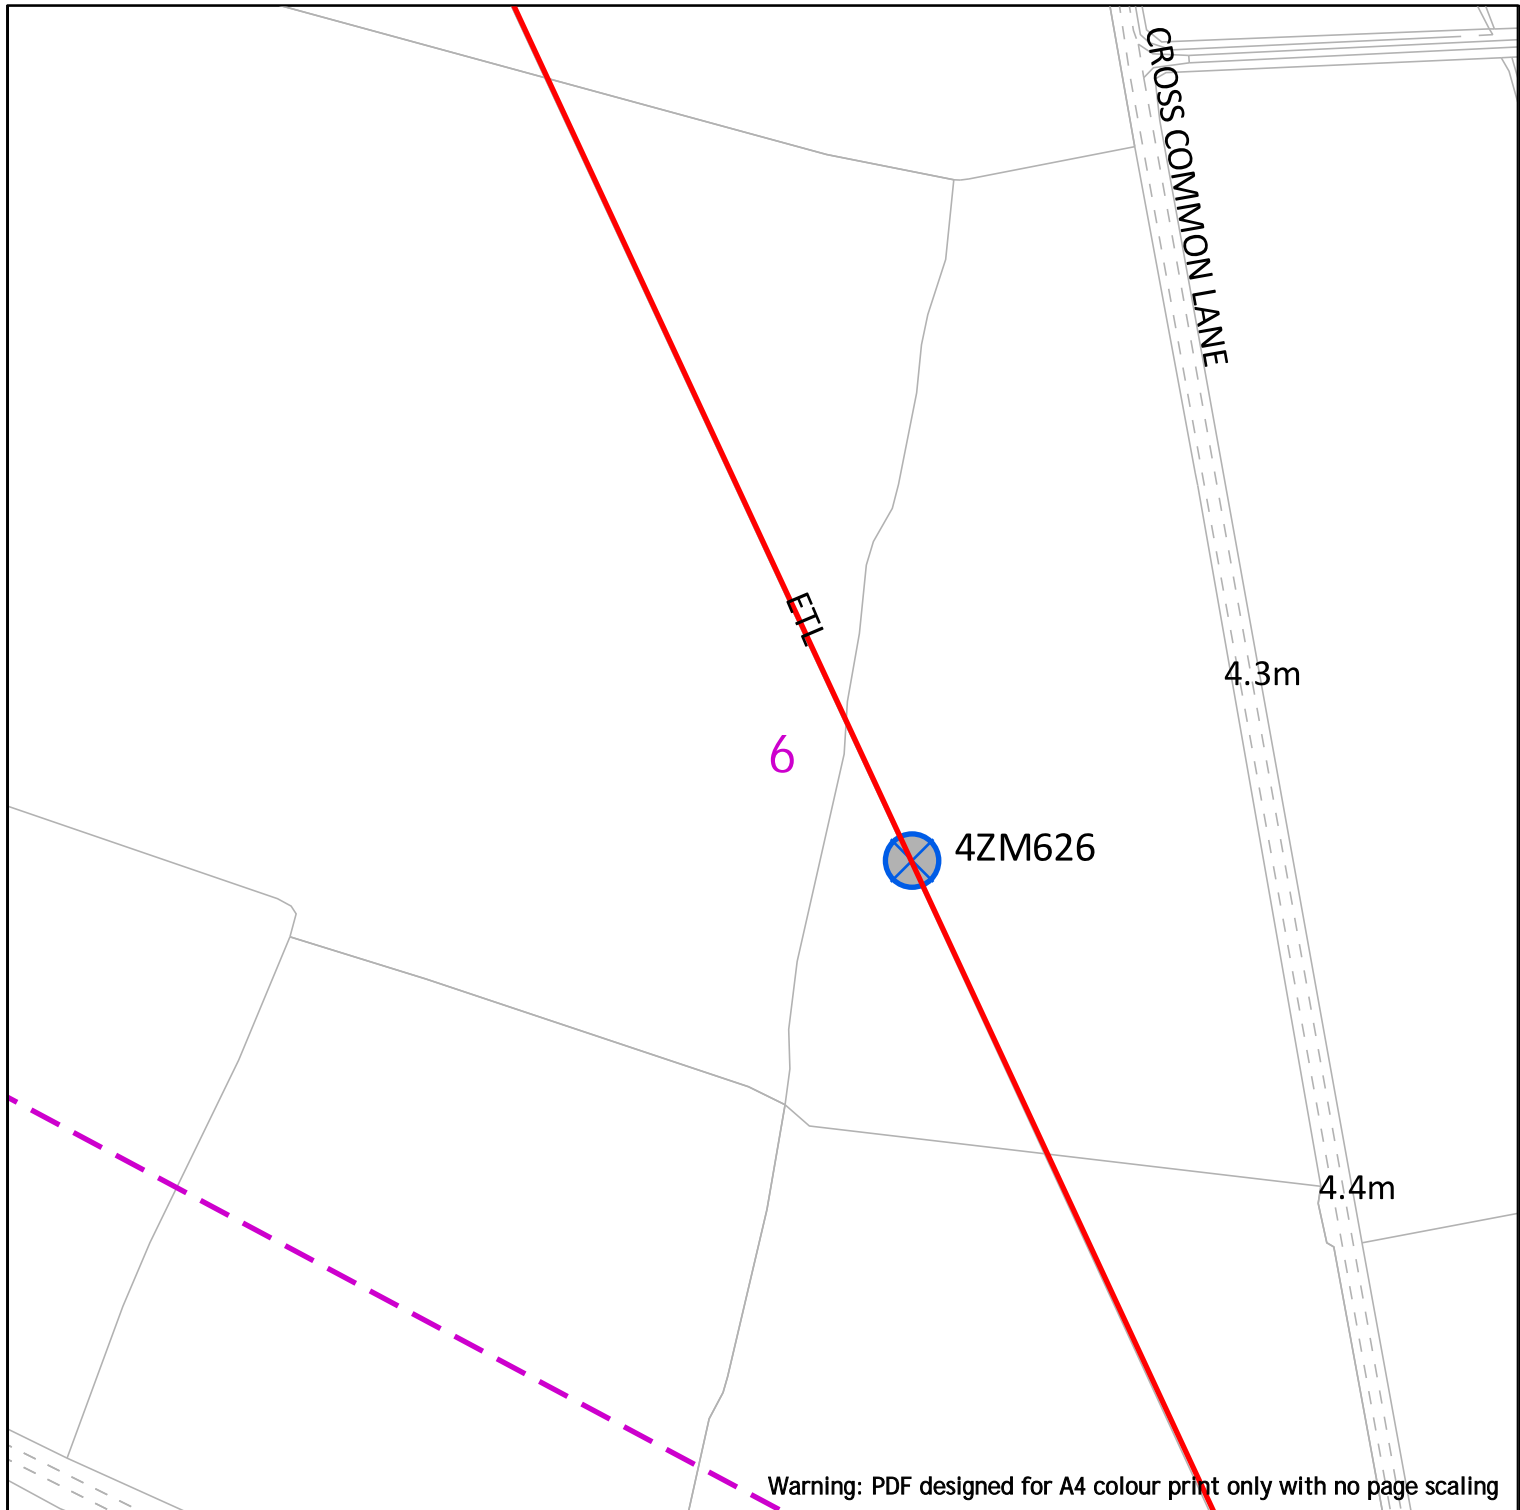

Warning: PDF designed for A4 colour print only with no page scaling




**EXTREME CAUTION - HIGH VOLTAGE
RISK OF DEATH OR SERIOUS INJURY**

NationalGrid House
Warwick Technology Park
Gallows Hill
Warwick
CV34 6DA

AssetProtection@NationalGrid.com

Date Requested: 08/05/2023
Job Reference: 29406941
Site Location: 478276 384020
Requested by: Mr Ben Evans

Your Scheme/Reference: LM
203570/DK - 6

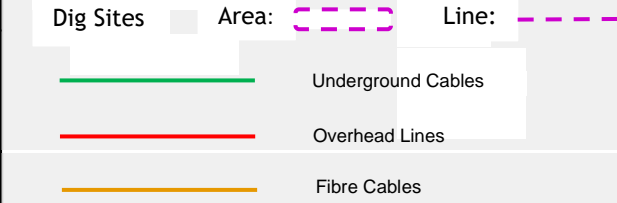

IMPORTANT NOTICES
This plan shows those pipes owned by National Grid Electricity Transmission plc in its role as a Licensed Electricity Transporter (ET). Electricity cables owned by other ETs, or otherwise privately owned, may be present in this area. Information with regards to such cables should be obtained from the relevant owners. The information shown on this plan is given without warranty, the accuracy thereof cannot be guaranteed. Ancillary equipment such as cooling systems and communication cables are not shown but their presence should be anticipated. No liability of any kind whatsoever is accepted by National Grid Electricity Transmission plc or their agents, servants or contractors for any error or omission. Safe digging practices, in accordance with HS(G)47, must be used to verify and establish the actual position of cables and other apparatus on site before any mechanical plant is used. It is your responsibility to ensure that this information is provided to all persons (either direct labour or contractors) working for you on or near electricity apparatus. The information included on this plan should not be referred to beyond a period of 28 days from the date of issue.

National Grid Electricity Emergency Number: 0800 40 40 90
Available 24 hours, 7 days/week. Calls may be recorded and monitored

Scale: 1:2500 (When plotted at A4)

7



Warning: PDF designed for A4 colour print only with no page scaling



**EXTREME CAUTION - HIGH VOLTAGE
RISK OF DEATH OR SERIOUS INJURY**

Dig Sites Area: Line:

- Underground Cables
- Overhead Lines
- Fibre Cables

NationalGrid House
 Warwick Technology Park
 Gallows Hill
 Warwick
 CV34 6DA
 AssetProtection@NationalGrid.com


Date Requested: 08/05/2023
 Job Reference: 29406941
 Site Location: 478276 384020
 Requested by: Mr Ben Evans
 Your Scheme/Reference: LM
 203570/DK - 6

Scale: 1:2500 (When plotted at A4)

IMPORTANT NOTICES

This plan shows those pipes owned by National Grid Electricity Transmission plc in its role as a Licensed Electricity Transporter (ET). Electricity cables owned by other ETs, or otherwise privately owned, may be present in this area. Information with regards to such cables should be obtained from the relevant owners. The information shown on this plan is given without warranty, the accuracy thereof cannot be guaranteed. Ancillary equipment such as cooling systems and communication cables are not shown but their presence should be anticipated. No liability of any kind whatsoever is accepted by National Grid Electricity Transmission plc or their agents, servants or contractors for any error or omission. Safe digging practices, in accordance with HS(G)47, must be used to verify and establish the actual position of cables and other apparatus on site before any mechanical plant is used. It is your responsibility to ensure that this information is provided to all persons (either direct labour or contractors) working for you on or near electricity apparatus. The information included on this plan should not be referred to beyond a period of 28 days from the date of issue.

National Grid Electricity Emergency Number: 0800 40 40 90
 Available 24 hours, 7 days/week. Calls may be recorded and monitored

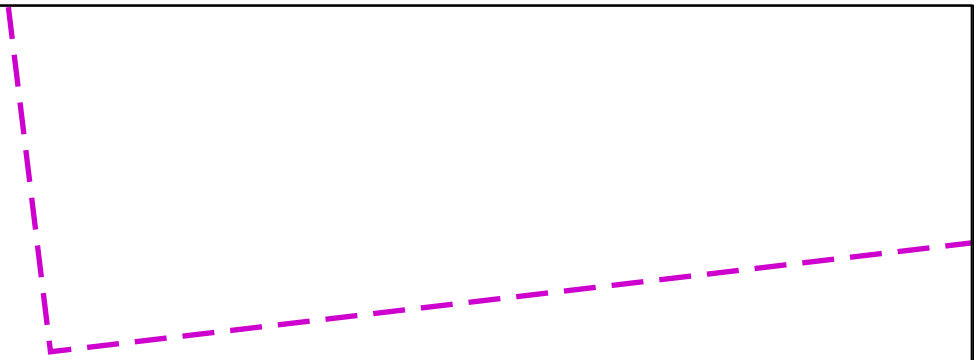

8

Warning: PDF designed for A4 colour print only with no page scaling

nationalgrid



**EXTREME CAUTION - HIGH VOLTAGE
RISK OF DEATH OR SERIOUS INJURY**

Dig Sites Area: Line:

- Underground Cables
- Overhead Lines
- Fibre Cables

NationalGrid House
Warwick Technology Park
Gallows Hill
Warwick
CV34 6DA

AssetProtection@NationalGrid.com

Date Requested: 08/05/2023
Job Reference: 29406941
Site Location: 478276 384020
Requested by: Mr Ben Evans

Your Scheme/Reference: LM
203570/DK - 6

IMPORTANT NOTICES

This plan shows those pipes owned by National Grid Electricity Transmission plc in its role as a Licensed Electricity Transporter (ET). Electricity cables owned by other ETs, or otherwise privately owned, may be present in this area. Information with regards to such cables should be obtained from the relevant owners. The information shown on this plan is given without warranty, the accuracy thereof cannot be guaranteed. Ancillary equipment such as cooling systems and communication cables are not shown but their presence should be anticipated. No liability of any kind whatsoever is accepted by National Grid Electricity Transmission plc or their agents, servants or contractors for any error or omission. Safe digging practices, in accordance with HS(G)47, must be used to verify and establish the actual position of cables and other apparatus on site before any mechanical plant is used. It is your responsibility to ensure that this information is provided to all persons (either direct labour or contractors) working for you on or near electricity apparatus. The information included on this plan should not be referred to beyond a period of 28 days from the date of issue.

National Grid Electricity Emergency Number: 0800 40 40 90

Available 24 hours, 7 days/week. Calls may be recorded and monitored

Scale: 1:2500 (When plotted at A4)

Pond

9

Warning: PDF designed for A4 colour print only with no page scaling

nationalgrid



**EXTREME CAUTION - HIGH VOLTAGE
RISK OF DEATH OR SERIOUS INJURY**

Dig Sites Area: Line:

- Underground Cables
- Overhead Lines
- Fibre Cables

NationalGrid House
Warwick Technology Park
Gallows Hill
Warwick
CV34 6DA

AssetProtection@NationalGrid.com

Date Requested: 08/05/2023
Job Reference: 29406941
Site Location: 478276 384020
Requested by: Mr Ben Evans

Your Scheme/Reference: LM
203570/DK - 6


IMPORTANT NOTICES

This plan shows those pipes owned by National Grid Electricity Transmission plc in its role as a Licensed Electricity Transporter (ET). Electricity cables owned by other ETs, or otherwise privately owned, may be present in this area. Information with regards to such cables should be obtained from the relevant owners. The information shown on this plan is given without warranty, the accuracy thereof cannot be guaranteed. Ancillary equipment such as cooling systems and communication cables are not shown but their presence should be anticipated. No liability of any kind whatsoever is accepted by National Grid Electricity Transmission plc or their agents, servants or contractors for any error or omission. Safe digging practices, in accordance with HS(G)47, must be used to verify and establish the actual position of cables and other apparatus on site before any mechanical plant is used. It is your responsibility to ensure that this information is provided to all persons (either direct labour or contractors) working for you on or near electricity apparatus. The information included on this plan should not be referred to beyond a period of 28 days from the date of issue.

National Grid Electricity Emergency Number: 0800 40 40 90

Available 24 hours, 7 days/week. Calls may be recorded and monitored

Scale: 1:2500 (When plotted at A4)

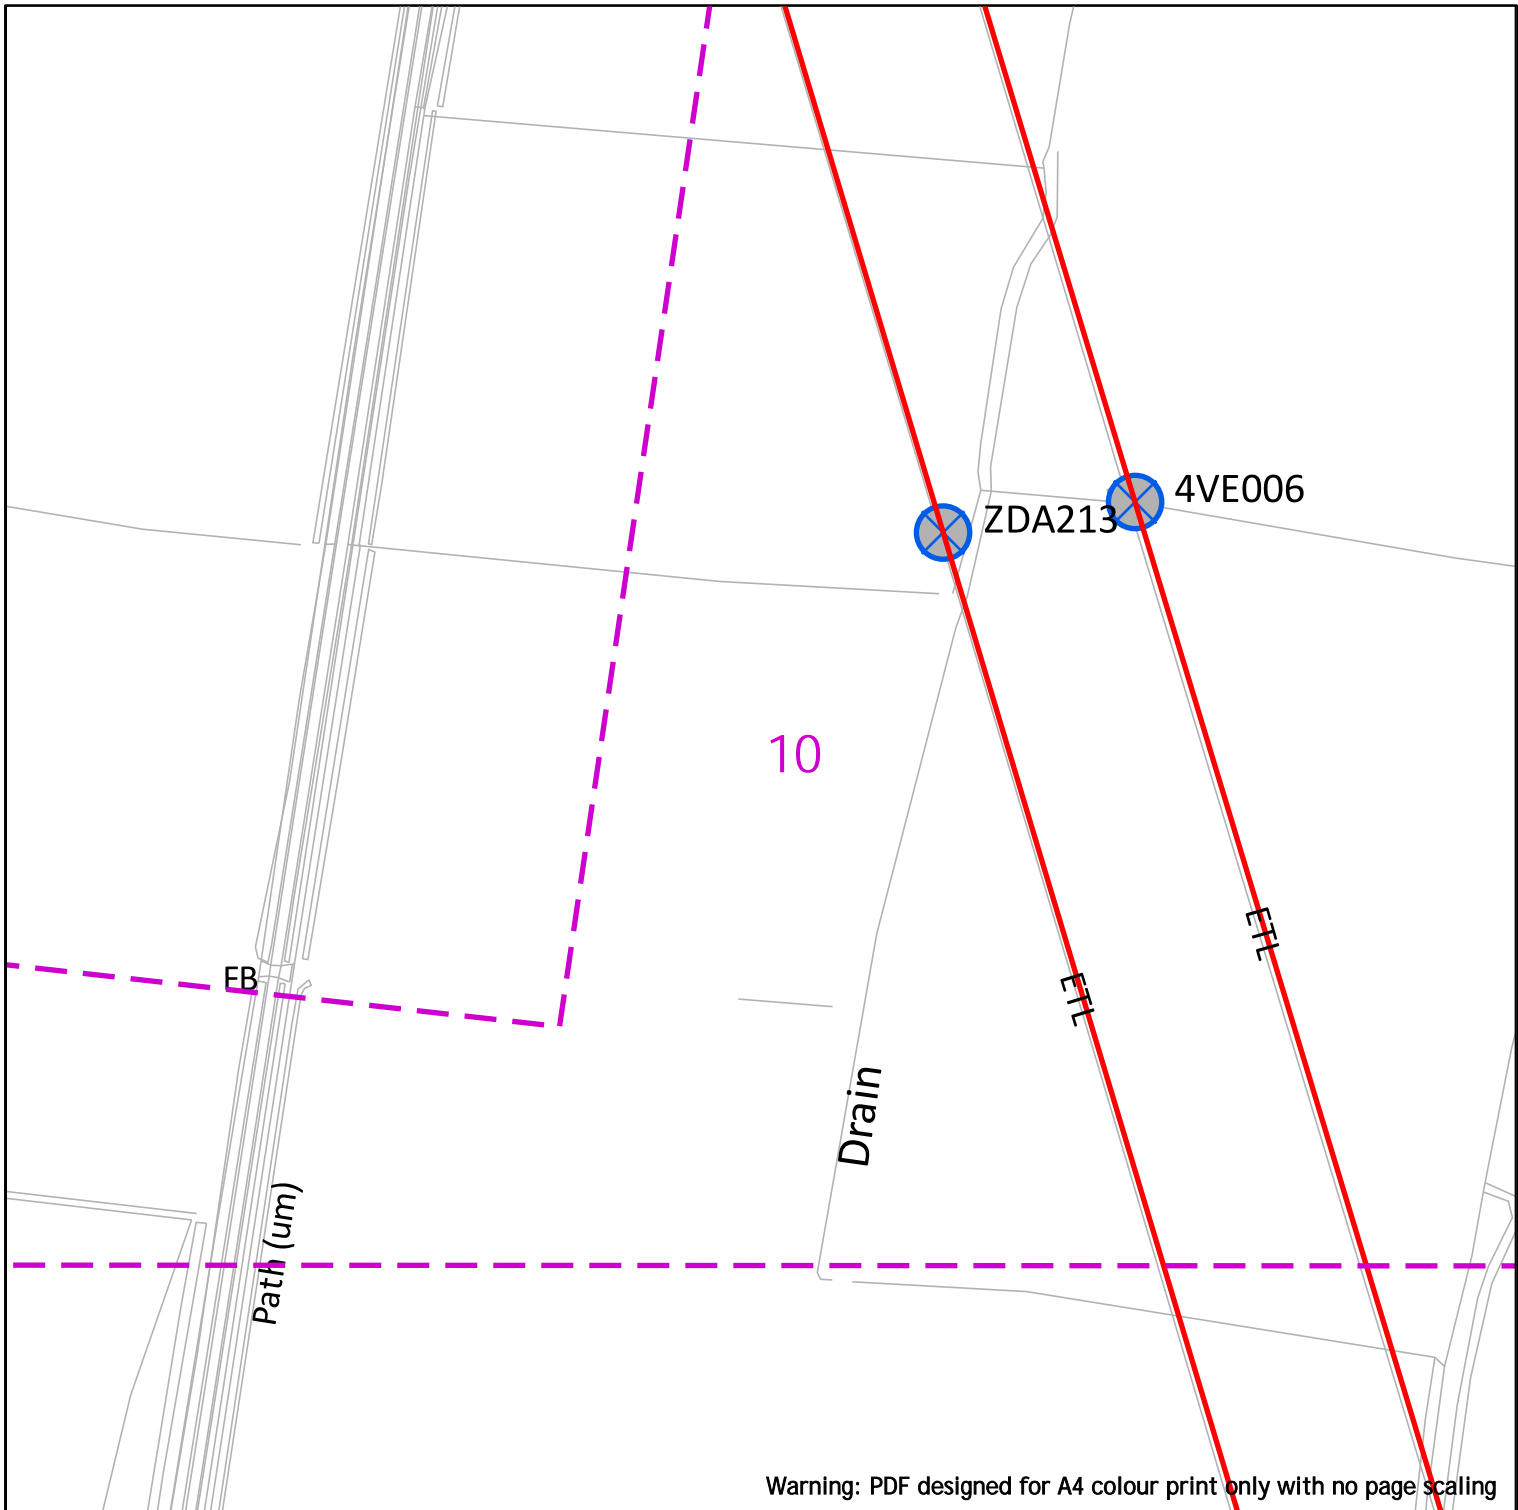

**EXTREME CAUTION - HIGH VOLTAGE
RISK OF DEATH OR SERIOUS INJURY**



Dig Sites	Area:	Line:
	Underground Cables	
	Overhead Lines	
	Fibre Cables	

NationalGrid House
Warwick Technology Park
Gallows Hill
Warwick
CV34 6DA

AssetProtection@NationalGrid.com


Date Requested: 08/05/2023
Job Reference: 29406941
Site Location: 478276 384020
Requested by: Mr Ben Evans

Your Scheme/Reference: LM
203570/DK - 6

IMPORTANT NOTICES
This plan shows those pipes owned by National Grid Electricity Transmission plc in its role as a Licensed Electricity Transporter (ET). Electricity cables owned by other ETs, or otherwise privately owned, may be present in this area. Information with regards to such cables should be obtained from the relevant owners. The information shown on this plan is given without warranty, the accuracy thereof cannot be guaranteed. Ancillary equipment such as cooling systems and communication cables are not shown but their presence should be anticipated. No liability of any kind whatsoever is accepted by National Grid Electricity Transmission plc or their agents, servants or contractors for any error or omission. Safe digging practices, in accordance with HS(G)47, must be used to verify and establish the actual position of cables and other apparatus on site before any mechanical plant is used. It is your responsibility to ensure that this information is provided to all persons (either direct labour or contractors) working for you on or near electricity apparatus. The information included on this plan should not be referred to beyond a period of 28 days from the date of issue.

National Grid Electricity Emergency Number: 0800 40 40 90
Available 24 hours, 7 days/week. Calls may be recorded and monitored

Scale: 1:2500 (When plotted at A4)

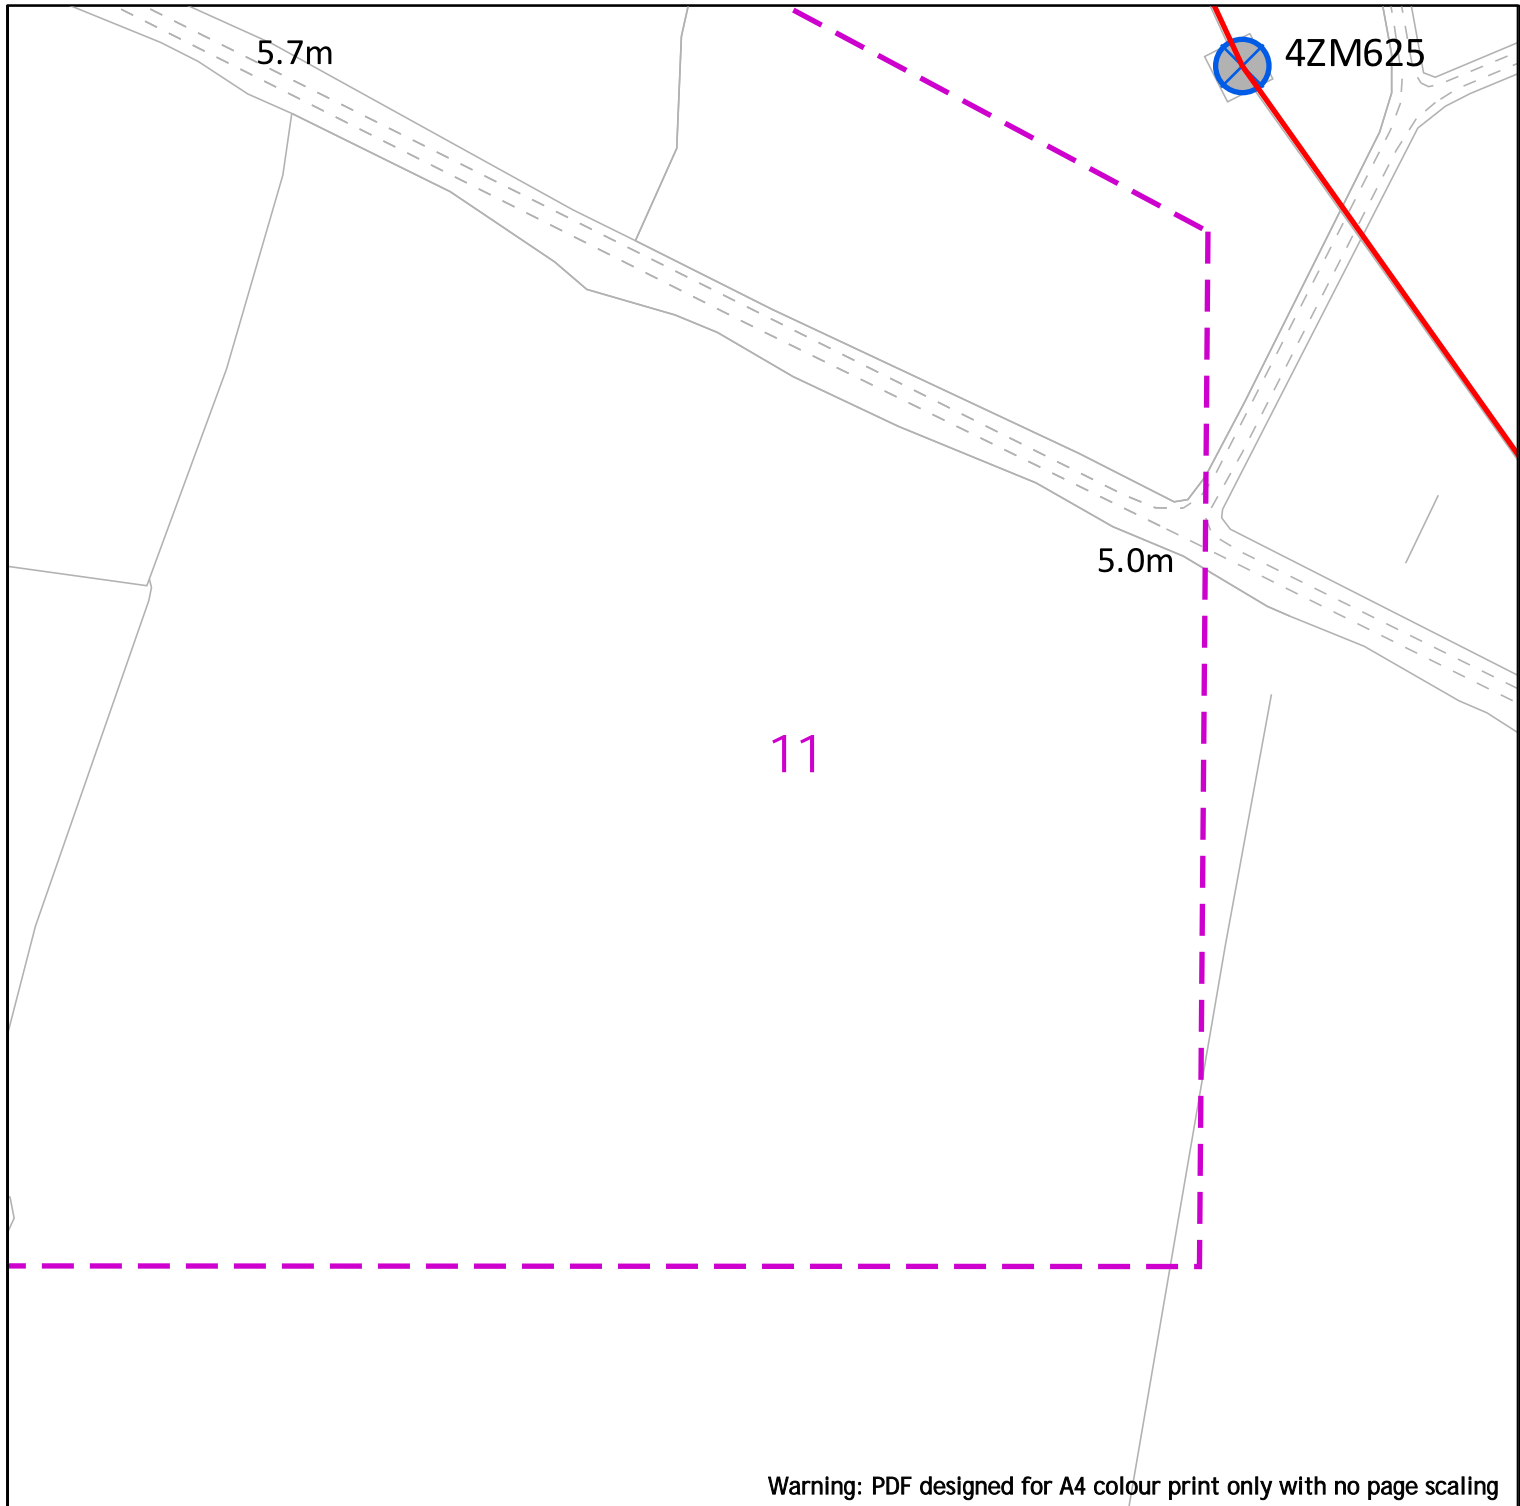

Warning: PDF designed for A4 colour print only with no page scaling

		<p>EXTREME CAUTION - HIGH VOLTAGE **RISK OF DEATH OR SERIOUS INJURY**</p>
<p>NationalGrid House Warwick Technology Park Gallows Hill Warwick CV34 6DA AssetProtection@NationalGrid.com</p>	<p>Dig Sites Area: Line: </p> <p> Underground Cables</p> <p> Overhead Lines</p> <p> Fibre Cables</p>	
<p>Date Requested: 08/05/2023 Job Reference: 29406941 Site Location: 478276 384020 Requested by: Mr Ben Evans Your Scheme/Reference: LM 203570/DK - 6</p>	<p>IMPORTANT NOTICES This plan shows those pipes owned by National Grid Electricity Transmission plc in its role as a Licensed Electricity Transporter (ET). Electricity cables owned by other ETs, or otherwise privately owned, may be present in this area. Information with regards to such cables should be obtained from the relevant owners. The information shown on this plan is given without warranty, the accuracy thereof cannot be guaranteed. Ancillary equipment such as cooling systems and communication cables are not shown but their presence should be anticipated. No liability of any kind whatsoever is accepted by National Grid Electricity Transmission plc or their agents, servants or contractors for any error or omission. Safe digging practices, in accordance with HS(G)47, must be used to verify and establish the actual position of cables and other apparatus on site before any mechanical plant is used. It is your responsibility to ensure that this information is provided to all persons (either direct labour or contractors) working for you on or near electricity apparatus. The information included on this plan should not be referred to beyond a period of 28 days from the date of issue.</p> <p style="text-align: center;">National Grid Electricity Emergency Number: 0800 40 40 90 Available 24 hours, 7 days/week. Calls may be recorded and monitored</p> <p style="font-size: small; text-align: center;">Crown Copyright © - Reproduced by permission of Ordnance Survey on behalf of HMSO. And database right 2023. All rights reserved. Ordnance Survey Licence number 0100059731.</p>	

Scale: 1:2500 (When plotted at A4)

ENQUIRY SUMMARY

Received Date

08/05/2023 9:34

Work Start Date

30/05/2023

Your Reference

LM 203570/DK - 6

Location

Centre Point: 478276 384020

X Extent:

Y Extent:

Postcode: DN229HQ

Map Options

Paper Size: A4

Orientation: PORTRAIT

Scale: 1:2500

Real World Extents: 2291m x 1346m

Enquirer Details

Organisation Name: Atkins - Utility Solutions

Contact Name: Ben Evans

Email Address: searches.utilitysolutions@atkinglobal.com

Telephone: 01454662086

Address: The Hub, 500 Park Avenue, Aztec West, , Bristol, BS32 4RZ

Enquiry Type

Initial Enquiry

Activity Type

Utility Works

Work Types

Single excavations site (deeper than 1.5m)

Notes/Works Description (if supplied)

Site Contact Name (if supplied)

Site Contact Number (if supplied)

Our Ref: 29406951 LM 203570/DK - 12

Monday, 08 May 2023

Ben Evans
The Hub, 500 Park Avenue, Aztec West

Bristol
BS32 4RZ

National Grid House
Warwick Technology Park
Gallows Hill, Warwick
CV34 6DA

Electricity Emergency Number:
0800 40 40 90*
*Available 24 hours, 7 days/week.
Calls may be recorded and monitored.
www.nationalgrid.com

Asset Protection
Gas Transmission
National Grid
Warwick
Email: assetprotection@nationalgrid.com

National Grid Electricity – No Assets Affected

Dear Sir/ Madam,

An assessment has been carried out with respect to NGET apparatus and the proposed work location. Based on the search area entered in the LSBUD system for assessment the search area has been found to not affect any NGET apparatus.

Please note this response and any attached map(s) are valid for 28 days

Yours sincerely

Asset Protection Team

Your Responsibilities and Obligations

It is your responsibility to ensure that the information you have submitted is accurate and that all relevant documents including links are provided to all persons (either direct labour or contractors) working for you near National Grid Electricity Transmission plc's apparatus, as legally required including under the Construction (Design and Management) Regulations 2015.


The assessment solely relates to the physical apparatus of National Grid Electricity Transmission plc (NGET)
It does **NOT** cover:

- Apparatus owned by other people or organisations, e.g., Cadent, other gas distribution operators, local electricity companies, other utilities, landowners etc
- Apparatus owned by National Grid Gas plc.
- NGET's legal rights and interests (such as those contained in easements or wayleaves) in or concerning the land, which restrict activity in proximity to NGET's assets in private land. You must obtain details of any such restrictions from the landowner in the first instance and/or from HM Land Registry and/or you should seek legal advice. If in doubt, contact Asset Protection.

It is **YOUR** responsibility to consider whether any of the items or factors listed above may be present or relevant and if they could be affected by your proposed activities.

NGET or its agents, servants or contractors do not accept any liability for any losses arising under or in connection with this information. This limit on liability applies to all and any claims in contract, tort (including negligence), misrepresentation (excluding fraudulent misrepresentation), breach of statutory duty or otherwise. This limit on liability does not exclude or restrict liability, which is prohibited by law, nor does it supersede the express terms of any related agreements.


Overview map of worksite

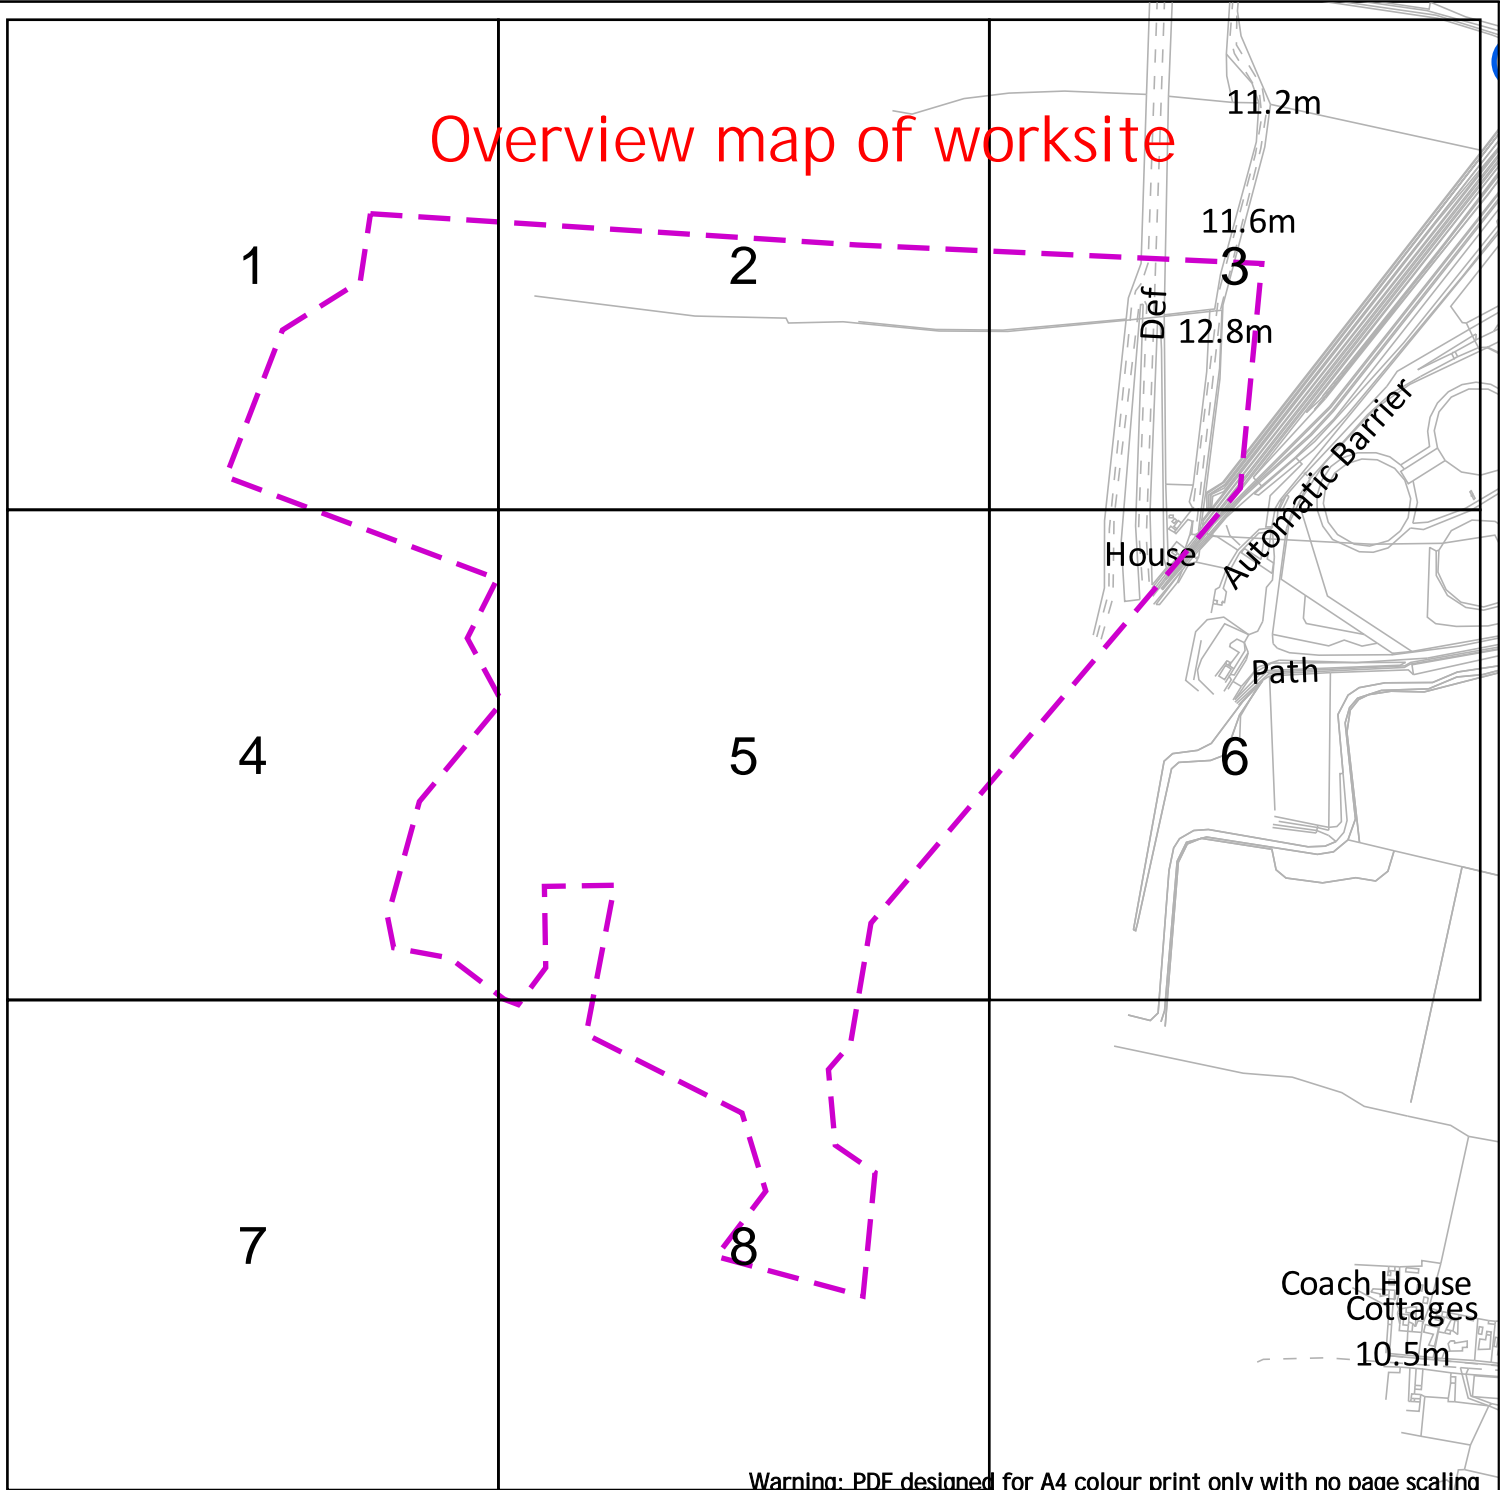

Warning: PDF designed for A4 colour print only with no page scaling

nationalgrid

**EXTREME CAUTION - HIGH VOLTAGE
RISK OF DEATH OR SERIOUS INJURY**

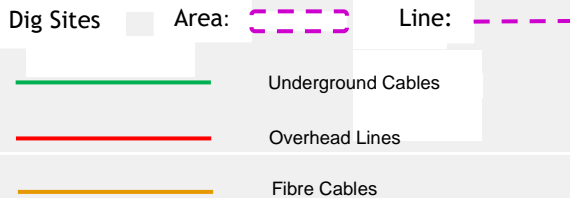

NationalGrid House
Warwick Technology Park
Gallows Hill
Warwick
CV34 6DA

AssetProtection@NationalGrid.com

Date Requested: 08/05/2023
Job Reference: 29406951
Site Location: 478132 385125
Requested by: Mr Ben Evans


Your Scheme/Reference: LM
203570/DK - 12

IMPORTANT NOTICES
This plan shows those pipes owned by National Grid Electricity Transmission plc in its role as a Licensed Electricity Transporter (ET). Electricity cables owned by other ETs, or otherwise privately owned, may be present in this area. Information with regards to such cables should be obtained from the relevant owners. The information shown on this plan is given without warranty, the accuracy thereof cannot be guaranteed. Ancillary equipment such as cooling systems and communication cables are not shown but their presence should be anticipated. No liability of any kind whatsoever is accepted by National Grid Electricity Transmission plc or their agents, servants or contractors for any error or omission. Safe digging practices, in accordance with HS(G)47, must be used to verify and establish the actual position of cables and other apparatus on site before any mechanical plant is used. It is your responsibility to ensure that this information is provided to all persons (either direct labour or contractors) working for you on or near electricity apparatus. The information included on this plan should not be referred to beyond a period of 28 days from the date of issue.

National Grid Electricity Emergency Number: 0800 40 40 90
Available 24 hours, 7 days/week. Calls may be recorded and monitored

Scale: 1:7688 (When plotted at A4)

Crown Copyright © - Reproduced by permission of Ordnance Survey on behalf of HMSO. And database right 2023. All rights reserved. Ordnance Survey Licence number 0100059731.

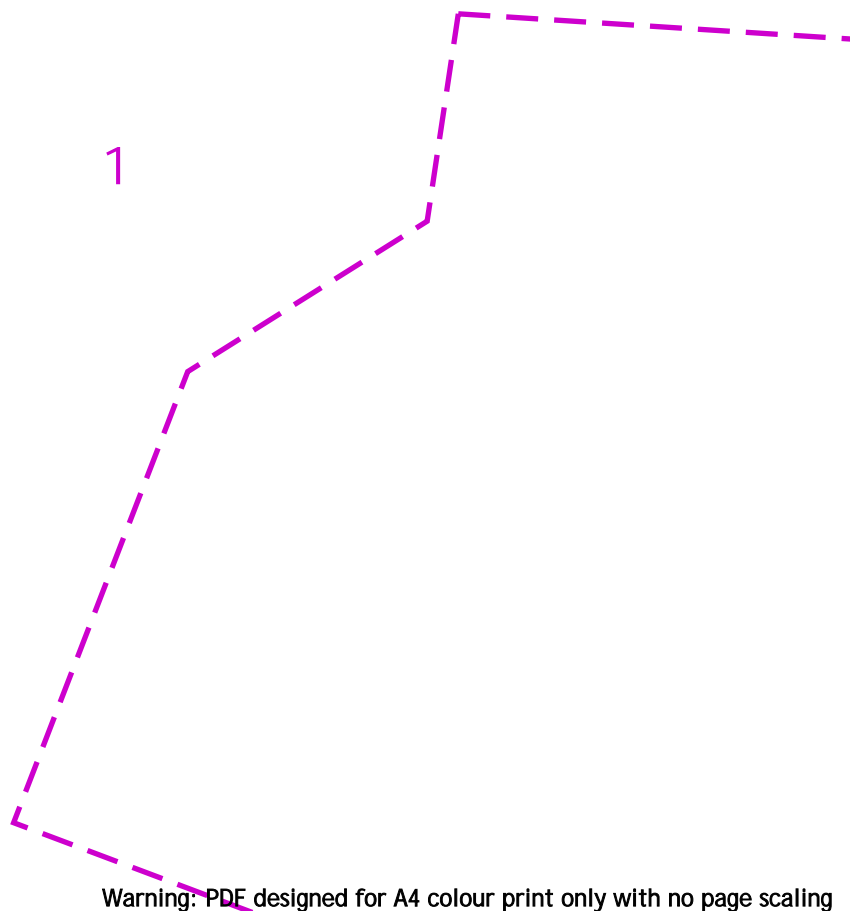

Warning: PDF designed for A4 colour print only with no page scaling



**EXTREME CAUTION - HIGH VOLTAGE
RISK OF DEATH OR SERIOUS INJURY**

Dig Sites	Area:	Line:
	Underground Cables	
	Overhead Lines	
	Fibre Cables	

NationalGrid House
Warwick Technology Park
Gallows Hill
Warwick
CV34 6DA

AssetProtection@NationalGrid.com

Date Requested: 08/05/2023
Job Reference: 29406951
Site Location: 478132 385125
Requested by: Mr Ben Evans

Your Scheme/Reference: LM
203570/DK - 12

IMPORTANT NOTICES

This plan shows those pipes owned by National Grid Electricity Transmission plc in its role as a Licensed Electricity Transporter (ET). Electricity cables owned by other ETs, or otherwise privately owned, may be present in this area. Information with regards to such cables should be obtained from the relevant owners. The information shown on this plan is given without warranty, the accuracy thereof cannot be guaranteed. Ancillary equipment such as cooling systems and communication cables are not shown but their presence should be anticipated. No liability of any kind whatsoever is accepted by National Grid Electricity Transmission plc or their agents, servants or contractors for any error or omission. Safe digging practices, in accordance with HS(G)47, must be used to verify and establish the actual position of cables and other apparatus on site before any mechanical plant is used. It is your responsibility to ensure that this information is provided to all persons (either direct labour or contractors) working for you on or near electricity apparatus. The information included on this plan should not be referred to beyond a period of 28 days from the date of issue.

National Grid Electricity Emergency Number: 0800 40 40 90
Available 24 hours, 7 days/week. Calls may be recorded and monitored

Scale: 1:2500 (When plotted at A4)



Warning: PDF designed for A4 colour print only with no page scaling

nationalgrid

NationalGrid House
 Warwick Technology Park
 Gallows Hill
 Warwick
 CV34 6DA

AssetProtection@NationalGrid.com

0 200

Dig Sites Area: Line:

Underground Cables

Overhead Lines

Fibre Cables

EXTREME CAUTION - HIGH VOLTAGE
****RISK OF DEATH OR SERIOUS INJURY****


Date Requested: 08/05/2023
 Job Reference: 29406951
 Site Location: 478132 385125
 Requested by: Mr Ben Evans

Your Scheme/Reference: LM
 203570/DK - 12

IMPORTANT NOTICES
 This plan shows those pipes owned by National Grid Electricity Transmission plc in its role as a Licensed Electricity Transporter (ET). Electricity cables owned by other ETs, or otherwise privately owned, may be present in this area. Information with regards to such cables should be obtained from the relevant owners. The information shown on this plan is given without warranty, the accuracy thereof cannot be guaranteed. Ancillary equipment such as cooling systems and communication cables are not shown but their presence should be anticipated. No liability of any kind whatsoever is accepted by National Grid Electricity Transmission plc or their agents, servants or contractors for any error or omission. Safe digging practices, in accordance with HS(G)47, must be used to verify and establish the actual position of cables and other apparatus on site before any mechanical plant is used. It is your responsibility to ensure that this information is provided to all persons (either direct labour or contractors) working for you on or near electricity apparatus. The information included on this plan should not be referred to beyond a period of 28 days from the date of issue.

National Grid Electricity Emergency Number: 0800 40 40 90
 Available 24 hours, 7 days/week. Calls may be recorded and monitored

Scale: 1:2500 (When plotted at A4)

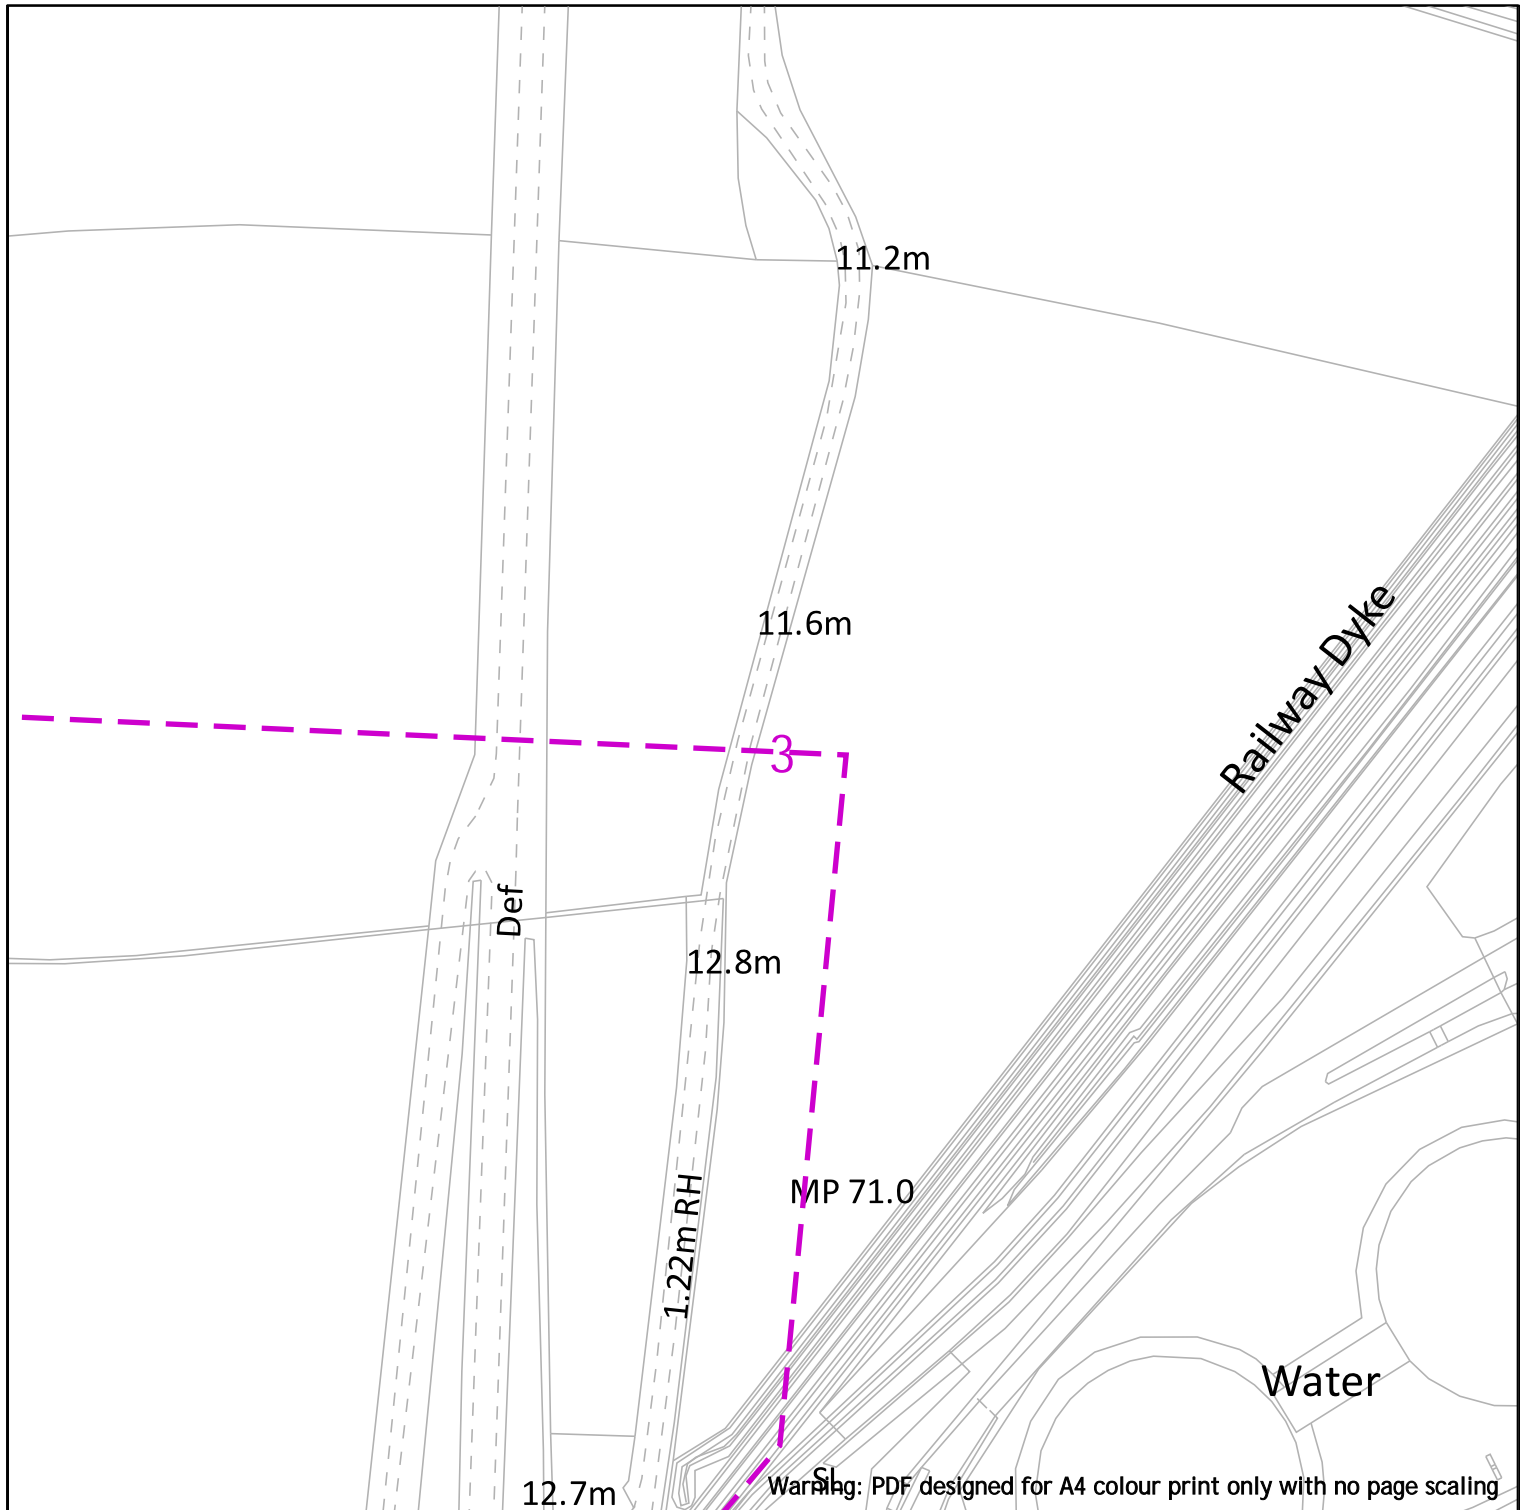

Warning: PDF designed for A4 colour print only with no page scaling

nationalgrid



**EXTREME CAUTION - HIGH VOLTAGE
RISK OF DEATH OR SERIOUS INJURY**

NationalGrid House
Warwick Technology Park
Gallows Hill
Warwick
CV34 6DA

AssetProtection@NationalGrid.com

Date Requested: 08/05/2023
Job Reference: 29406951
Site Location: 478132 385125
Requested by: Mr Ben Evans

Your Scheme/Reference: LM
203570/DK - 12

Scale: 1:2500 (When plotted at A4)

- Dig Sites Area:
- Underground Cables
- Overhead Lines
- Fibre Cables

IMPORTANT NOTICES

This plan shows those pipes owned by National Grid Electricity Transmission plc in its role as a Licensed Electricity Transporter (ET). Electricity cables owned by other ETs, or otherwise privately owned, may be present in this area. Information with regards to such cables should be obtained from the relevant owners. The information shown on this plan is given without warranty, the accuracy thereof cannot be guaranteed. Ancillary equipment such as cooling systems and communication cables are not shown but their presence should be anticipated. No liability of any kind whatsoever is accepted by National Grid Electricity Transmission plc or their agents, servants or contractors for any error or omission. Safe digging practices, in accordance with HS(G)47, must be used to verify and establish the actual position of cables and other apparatus on site before any mechanical plant is used. It is your responsibility to ensure that this information is provided to all persons (either direct labour or contractors) working for you on or near electricity apparatus. The information included on this plan should not be referred to beyond a period of 28 days from the date of issue.

National Grid Electricity Emergency Number: 0800 40 40 90
Available 24 hours, 7 days/week. Calls may be recorded and monitored

4

Warning: PDF designed for A4 colour print only with no page scaling



**EXTREME CAUTION - HIGH VOLTAGE
RISK OF DEATH OR SERIOUS INJURY**

Dig Sites Area: Line:

 Underground Cables

 Overhead Lines

 Fibre Cables

NationalGrid House
 Warwick Technology Park
 Gallows Hill
 Warwick
 CV34 6DA

AssetProtection@NationalGrid.com

Date Requested: 08/05/2023
 Job Reference: 29406951
 Site Location: 478132 385125
 Requested by: Mr Ben Evans

Your Scheme/Reference: LM
 203570/DK - 12

IMPORTANT NOTICES

This plan shows those pipes owned by National Grid Electricity Transmission plc in its role as a Licensed Electricity Transporter (ET). Electricity cables owned by other ETs, or otherwise privately owned, may be present in this area. Information with regards to such cables should be obtained from the relevant owners. The information shown on this plan is given without warranty, the accuracy thereof cannot be guaranteed. Ancillary equipment such as cooling systems and communication cables are not shown but their presence should be anticipated. No liability of any kind whatsoever is accepted by National Grid Electricity Transmission plc or their agents, servants or contractors for any error or omission. Safe digging practices, in accordance with HS(G)47, must be used to verify and establish the actual position of cables and other apparatus on site before any mechanical plant is used. It is your responsibility to ensure that this information is provided to all persons (either direct labour or contractors) working for you on or near electricity apparatus. The information included on this plan should not be referred to beyond a period of 28 days from the date of issue.

National Grid Electricity Emergency Number: 0800 40 40 90
 Available 24 hours, 7 days/week. Calls may be recorded and monitored

Scale: 1:2500 (When plotted at A4)

5

Warning: PDF designed for A4 colour print only with no page scaling

nationalgrid



**EXTREME CAUTION - HIGH VOLTAGE
RISK OF DEATH OR SERIOUS INJURY**

Dig Sites Area: Line:

 Underground Cables

 Overhead Lines

 Fibre Cables

NationalGrid House
 Warwick Technology Park
 Gallows Hill
 Warwick
 CV34 6DA

AssetProtection@NationalGrid.com


Date Requested: 08/05/2023
 Job Reference: 29406951
 Site Location: 478132 385125
 Requested by: Mr Ben Evans

Your Scheme/Reference: LM
 203570/DK - 12

IMPORTANT NOTICES
 This plan shows those pipes owned by National Grid Electricity Transmission plc in its role as a Licensed Electricity Transporter (ET). Electricity cables owned by other ETs, or otherwise privately owned, may be present in this area. Information with regards to such cables should be obtained from the relevant owners. The information shown on this plan is given without warranty, the accuracy thereof cannot be guaranteed. Ancillary equipment such as cooling systems and communication cables are not shown but their presence should be anticipated. No liability of any kind whatsoever is accepted by National Grid Electricity Transmission plc or their agents, servants or contractors for any error or omission. Safe digging practices, in accordance with HS(G)47, must be used to verify and establish the actual position of cables and other apparatus on site before any mechanical plant is used. It is your responsibility to ensure that this information is provided to all persons (either direct labour or contractors) working for you on or near electricity apparatus. The information included on this plan should not be referred to beyond a period of 28 days from the date of issue.

National Grid Electricity Emergency Number: 0800 40 40 90
 Available 24 hours, 7 days/week. Calls may be recorded and monitored

Scale: 1:2500 (When plotted at A4)

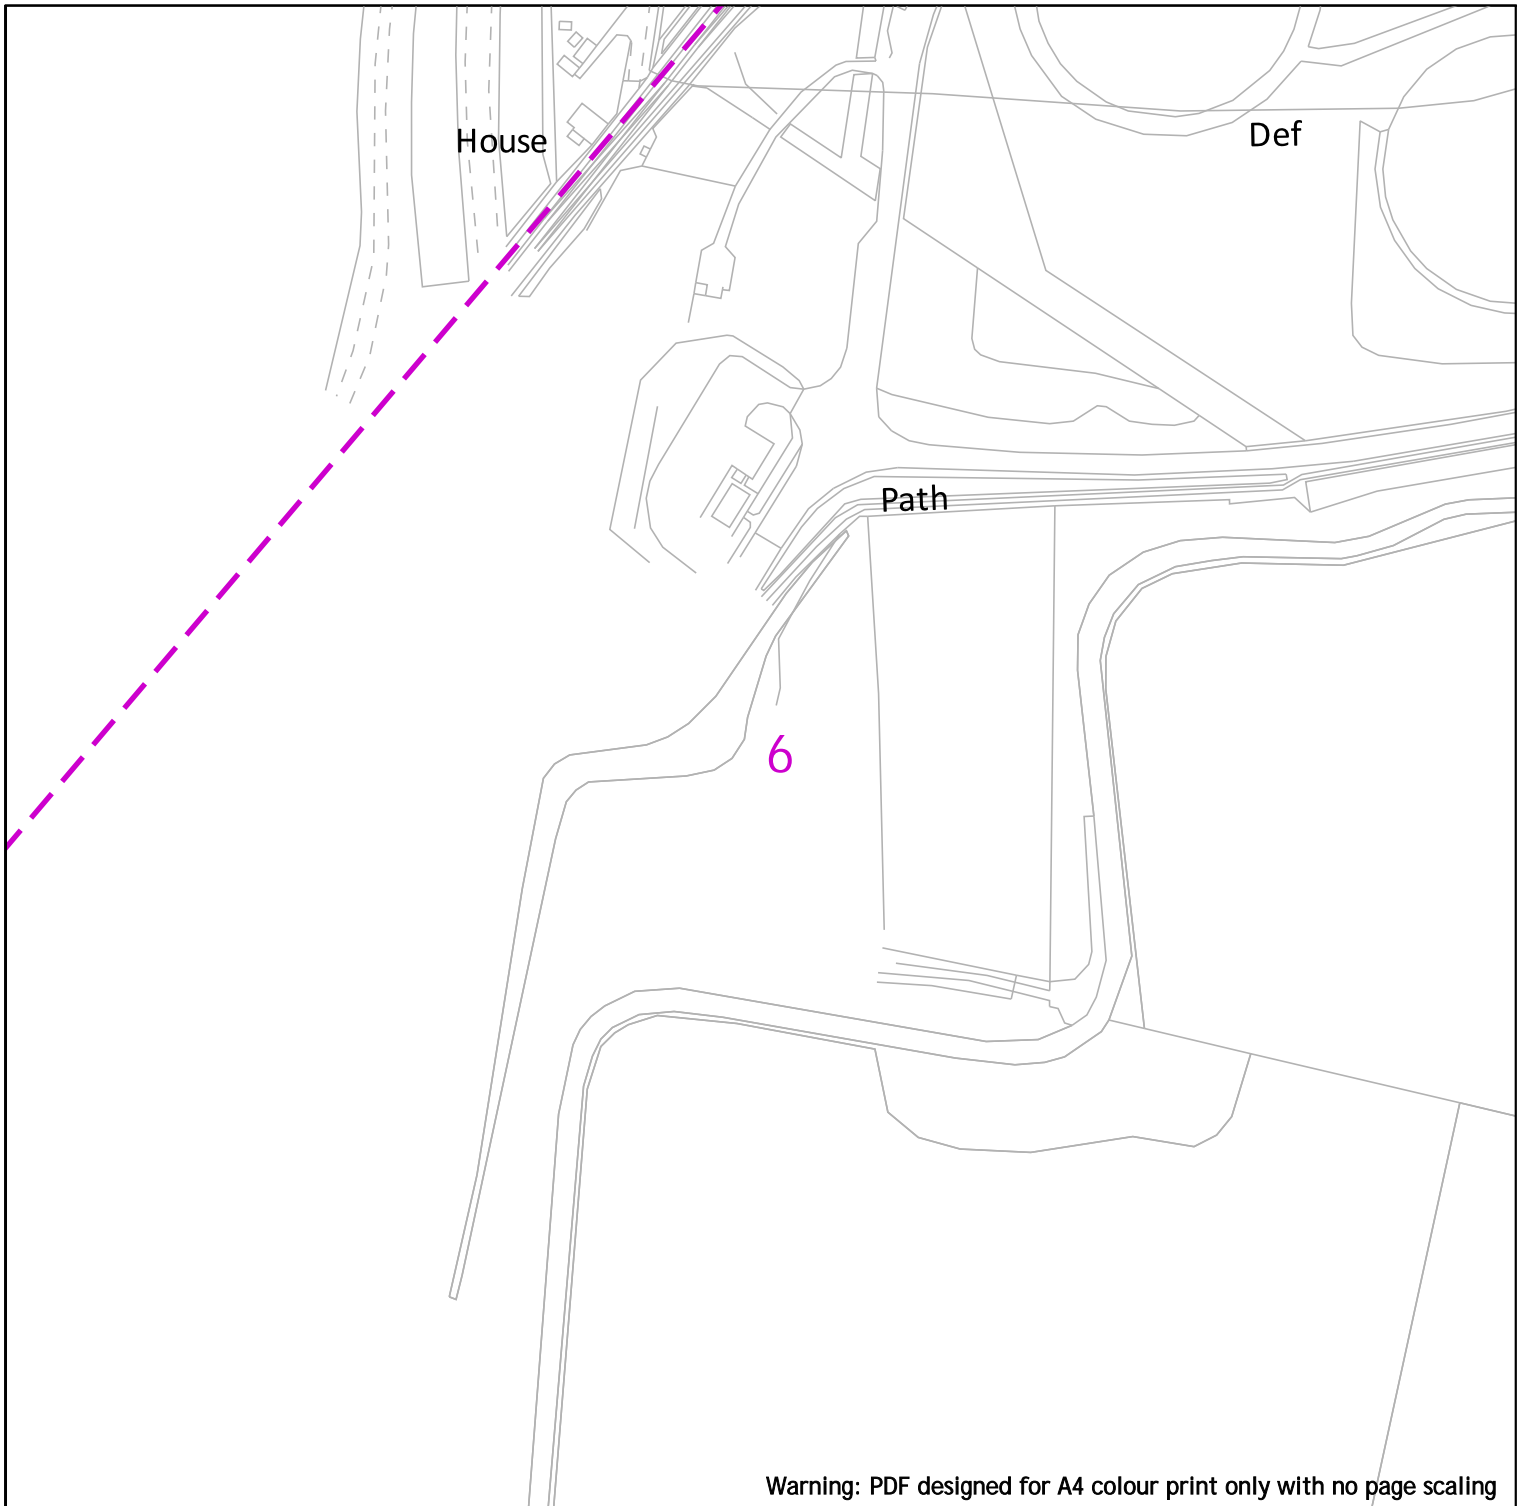

Warning: PDF designed for A4 colour print only with no page scaling

nationalgrid



**EXTREME CAUTION - HIGH VOLTAGE
RISK OF DEATH OR SERIOUS INJURY**

- Dig Sites Area: Line:
- Underground Cables
- Overhead Lines
- Fibre Cables

NationalGrid House
Warwick Technology Park
Gallows Hill
Warwick
CV34 6DA

AssetProtection@NationalGrid.com

Date Requested: 08/05/2023
Job Reference: 29406951
Site Location: 478132 385125
Requested by: Mr Ben Evans

Your Scheme/Reference: LM
203570/DK - 12

IMPORTANT NOTICES
This plan shows those pipes owned by National Grid Electricity Transmission plc in its role as a Licensed Electricity Transporter (ET). Electricity cables owned by other ETs, or otherwise privately owned, may be present in this area. Information with regards to such cables should be obtained from the relevant owners. The information shown on this plan is given without warranty, the accuracy thereof cannot be guaranteed. Ancillary equipment such as cooling systems and communication cables are not shown but their presence should be anticipated. No liability of any kind whatsoever is accepted by National Grid Electricity Transmission plc or their agents, servants or contractors for any error or omission. Safe digging practices, in accordance with HS(G)47, must be used to verify and establish the actual position of cables and other apparatus on site before any mechanical plant is used. It is your responsibility to ensure that this information is provided to all persons (either direct labour or contractors) working for you on or near electricity apparatus. The information included on this plan should not be referred to beyond a period of 28 days from the date of issue.

National Grid Electricity Emergency Number: 0800 40 40 90
Available 24 hours, 7 days/week. Calls may be recorded and monitored


Scale: 1:2500 (When plotted at A4)

Crown Copyright © - Reproduced by permission of Ordnance Survey on behalf of HMSO. And database right 2023. All rights reserved. Ordnance Survey Licence number 0100059731.

Warning: PDF designed for A4 colour print only with no page scaling



**EXTREME CAUTION - HIGH VOLTAGE
RISK OF DEATH OR SERIOUS INJURY**

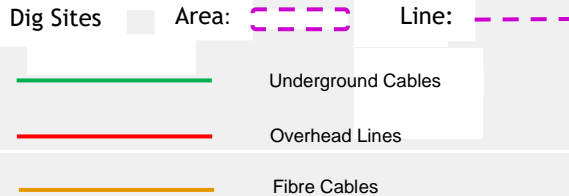

NationalGrid House
 Warwick Technology Park
 Gallows Hill
 Warwick
 CV34 6DA

AssetProtection@NationalGrid.com

Date Requested: 08/05/2023
 Job Reference: 29406951
 Site Location: 478132 385125
 Requested by: Mr Ben Evans


Your Scheme/Reference: LM
 203570/DK - 12

Scale: 1:2500 (When plotted at A4)

IMPORTANT NOTICES

This plan shows those pipes owned by National Grid Electricity Transmission plc in its role as a Licensed Electricity Transporter (ET). Electricity cables owned by other ETs, or otherwise privately owned, may be present in this area. Information with regards to such cables should be obtained from the relevant owners. The information shown on this plan is given without warranty, the accuracy thereof cannot be guaranteed. Ancillary equipment such as cooling systems and communication cables are not shown but their presence should be anticipated. No liability of any kind whatsoever is accepted by National Grid Electricity Transmission plc or their agents, servants or contractors for any error or omission. Safe digging practices, in accordance with HS(G)47, must be used to verify and establish the actual position of cables and other apparatus on site before any mechanical plant is used. It is your responsibility to ensure that this information is provided to all persons (either direct labour or contractors) working for you on or near electricity apparatus. The information included on this plan should not be referred to beyond a period of 28 days from the date of issue.

National Grid Electricity Emergency Number: 0800 40 40 90
 Available 24 hours, 7 days/week. Calls may be recorded and monitored

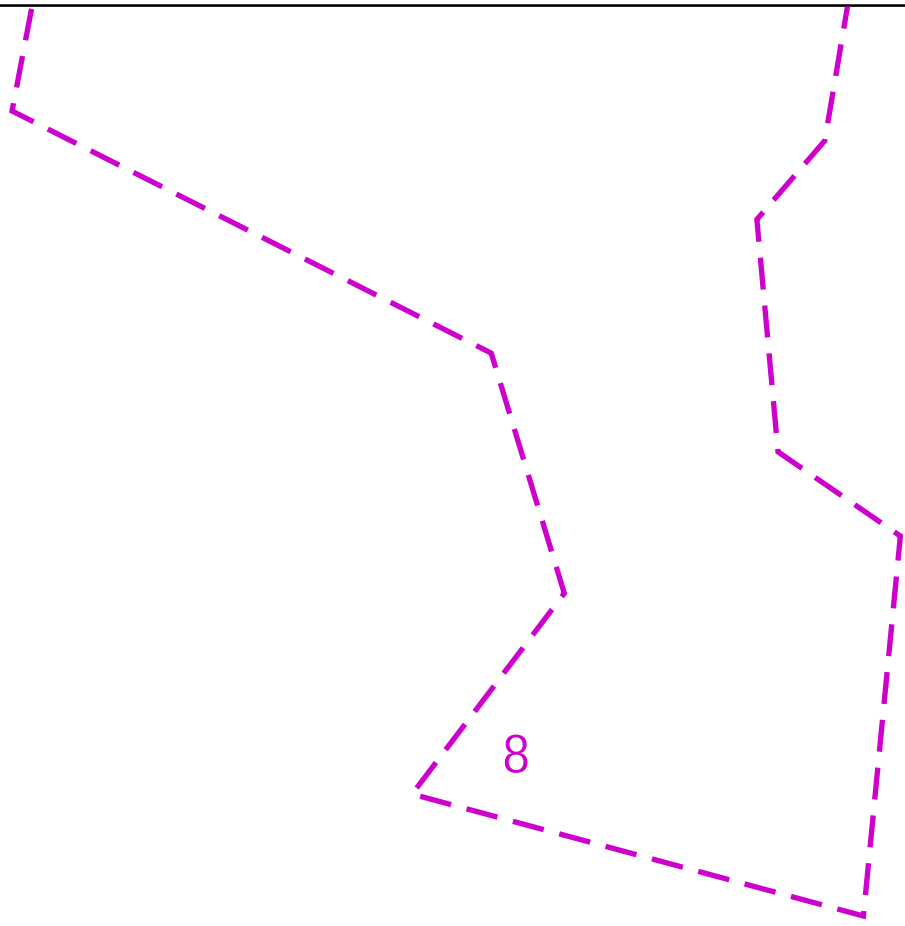

Warning: PDF designed for A4 colour print only with no page scaling



**EXTREME CAUTION - HIGH VOLTAGE
RISK OF DEATH OR SERIOUS INJURY**

Dig Sites Area: Line:

 Underground Cables

 Overhead Lines

 Fibre Cables

NationalGrid House
Warwick Technology Park
Gallows Hill
Warwick
CV34 6DA

AssetProtection@NationalGrid.com

Date Requested: 08/05/2023
Job Reference: 29406951
Site Location: 478132 385125
Requested by: Mr Ben Evans

Your Scheme/Reference: LM
203570/DK - 12

IMPORTANT NOTICES

This plan shows those pipes owned by National Grid Electricity Transmission plc in its role as a Licensed Electricity Transporter (ET). Electricity cables owned by other ETs, or otherwise privately owned, may be present in this area. Information with regards to such cables should be obtained from the relevant owners. The information shown on this plan is given without warranty, the accuracy thereof cannot be guaranteed. Ancillary equipment such as cooling systems and communication cables are not shown but their presence should be anticipated. No liability of any kind whatsoever is accepted by National Grid Electricity Transmission plc or their agents, servants or contractors for any error or omission. Safe digging practices, in accordance with HS(G)47, must be used to verify and establish the actual position of cables and other apparatus on site before any mechanical plant is used. It is your responsibility to ensure that this information is provided to all persons (either direct labour or contractors) working for you on or near electricity apparatus. The information included on this plan should not be referred to beyond a period of 28 days from the date of issue.

National Grid Electricity Emergency Number: 0800 40 40 90
Available 24 hours, 7 days/week. Calls may be recorded and monitored

Scale: 1:2500 (When plotted at A4)

ENQUIRY SUMMARY

Received Date

08/05/2023 9:34

Work Start Date

30/05/2023

Your Reference

LM 203570/DK - 12

Location

Centre Point: 478132 385125

X Extent:

Y Extent:

Postcode: DN229BN

Map Options

Paper Size: A4

Orientation: PORTRAIT

Scale: 1:2500

Real World Extents: 1053m x 1100m

Enquirer Details

Organisation Name: Atkins - Utility Solutions

Contact Name: Ben Evans

Email Address: searches.utilitysolutions@atkinglobal.com

Telephone: 01454662086

Address: The Hub, 500 Park Avenue, Aztec West, , Bristol, BS32 4RZ

Enquiry Type

Initial Enquiry

Activity Type

Utility Works


Work Types

Single excavations site (deeper than 1.5m)

Notes/Works Description (if supplied)

Site Contact Name (if supplied)

Site Contact Number (if supplied)

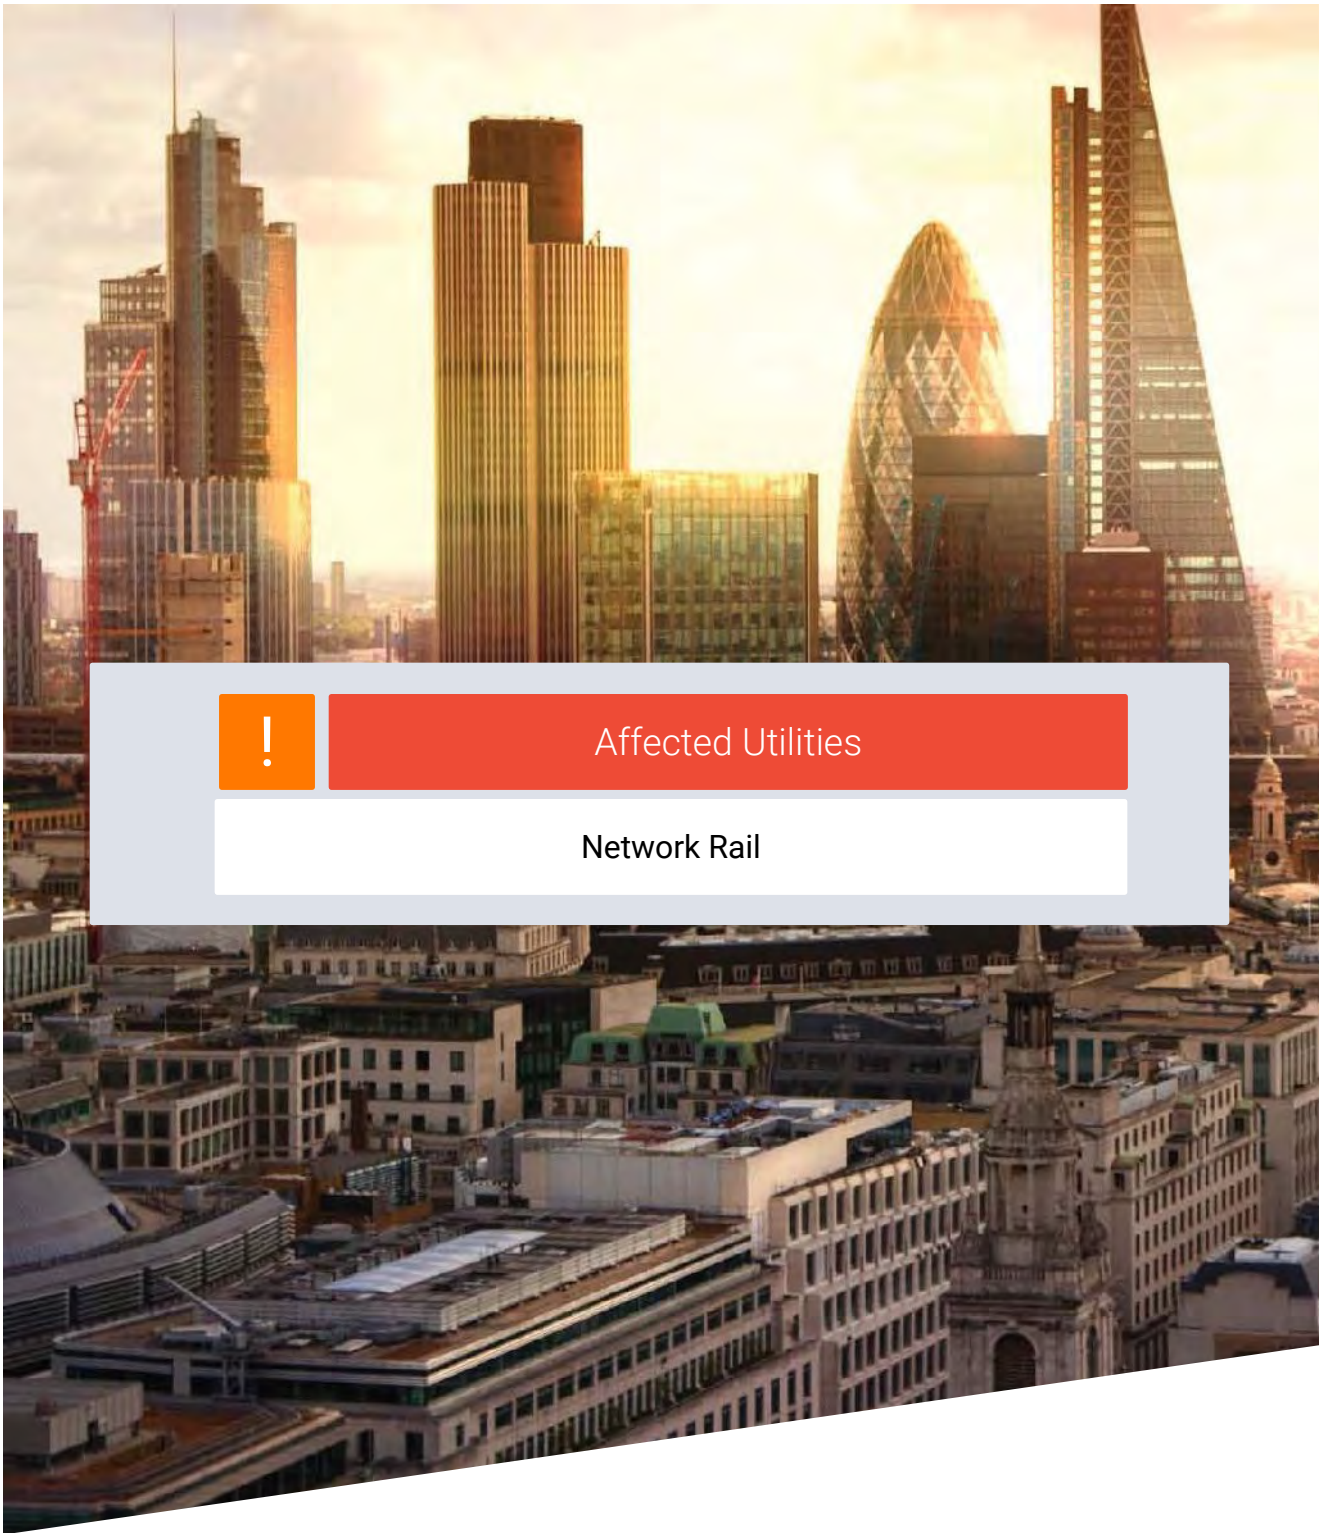

Affected Utilities

Network Rail



Sir/Madam

Please find information available as per the checklist.

NOT

MUST

-

MUST

-


-

I the

ASPRO

&

MUST

Buried Services Information Checklist			
Your Ref	203570	Our Order Ref	168506
Network Rail Record Type	Category	Enclosed Yes/No	Notes (e.g. Nil Return)
Asset Protection National Map	Contact Ino	Y	
Hazard Directory	Hazard	Y	
Site Map	GIS Systems	Y	
eB - Corporate records management system	National Records Group	Y	
Network Rail - Drainage	GIS Systems	Y	
National Records Group - Civils Records	National Records Group	Y	

NIL RETURN: After interrogating the information made available to us, no records containing buried services information have been returned for this worksite. However, reference must be made to the guidelines supplied with this buried services search, which contain important information on safe working practices.



Please complete a development questionnaire and submit it to the relevant route email address found on the map below

The Asset Protection Project Managers lead dedicated teams in providing advice to the public who are planning activities on or near the railway.
The teams deal with a multitude of issues including neighbouring construction sites, utility works, bridge works, domestic maintenance, new road schemes, inspection and surveying and works within the designated precautionary area of level crossings.
* It does not cover subjects such as emergencies, Town & Country Planning, property Sales or complaints.

SCOTLAND

Network Rail
Asset Protection Team
Floor 2, Buchanan House
58 Port Dundas Road
Glasgow
G4 0LQ

Tel- 0141 555 4087
Manager: Raymond Sheridan

NEW ENQUIRIES
AssetProtectionScotland@networkrail.co.uk

NORTH & EAST AND EAST COAST (NORTH) ROUTES

Network Rail
Asset Protection Team
George Stephenson House
Toft Green
York
YO1 6JT

Tel- 07922 019905
Manager: Roland Kettle

NEW ENQUIRIES
AssetProtectionEastern@networkrail.co.uk

NORTH WEST

Network Rail
Asset Protection Team
Floor 1, Square One
4 Travis Street
Manchester
M1 2NY

Tel- 0161 880 3706
Manager: Aime-Dawn White

NEW ENQUIRIES
AssetProtectionLNNorth@networkrail.co.uk

WALES

Network Rail
St. Patrick's House
17 Penarth Road
Cardiff
CF10 5ZA

Tel- 0330 857 7288
Manager: James O'Gorman

NEW ENQUIRIES
AssetProtectionWales@networkrail.co.uk

WESTERN

Network Rail
Asset Protection Team
5th Floor, Western House
1 Holtbrook Way
Swindon
SN1 1BD

Tel- 0330 857 7127
Manager: James O'Gorman

NEW ENQUIRIES
AssetProtectionWestern@networkrail.co.uk

WESSEX

Network Rail
Wessex Asset Protection Team
4th Floor, Waterloo General Offices
Waterloo Station
London
SE1 8SW

Tel- 0330 854 0648
Manager: Peter Barron

NEW ENQUIRIES
AssetProtectionWessex@networkrail.co.uk

SUSSEX

Network Rail
Asset Protection Team
Network Rail
Floor 2C
1 Puddle Dock
London
EC4V 3DS

Tel-
Manager: Logan Subramaniam

NEW ENQUIRIES
AssetProtectionLondonSouthEast@networkrail.co.uk

EAST MIDLANDS AND EAST COAST (SOUTH) ROUTES

Network Rail
Asset Protection Team
John Ellis House
Nelson Street
Derby
DE1 2RU

Tel- 07922 019905
Manager: Darrell Simpson

NEW ENQUIRIES
AssetProtectionEastern@networkrail.co.uk

ANGLIA

Network Rail
Asset Protection Team
11th Floor, One Stratford Place
Montfichet Road
Stratford, London
E20 1EJ

Tel- 07922 017393 (available 08:30-16:30)
0203 356 2510
Manager: David Kang Gil

CENTRAL & WEST COAST MAINLINE SOUTH

Network Rail
Asset Protection Team
Floor 2, The Quadrant MK
Elder Gate
Milton Keynes
MK9 1EN

Tel- 07920 509043 (Contactable Mon-Fri 08:30-16:30hrs)
Manager: Michael Lightwing

NEW ENQUIRIES
AssetProtectionLNNWSouth@networkrail.co.uk

KENT

Network Rail
Asset Protection Team
Network Rail
Floor 2C
1 Puddle Dock
London
EC4V 3DS

Tel-
Manager: Logan Subramaniam

NEW ENQUIRIES
AssetProtectionLondonSouthEast@networkrail.co.uk

Network Rail (High Speed)

Website location: Network Rail / Industry and Partners / Network interface - High Speed 1

NEW ENQUIRIES
AssetProtectionHighSpeed1@networkrail.co.uk

LEGEND

UK Postcode (within single NR Territory)

UK Postcode (split between NR Territories)

Rail Network

Please note that the route boundaries for the North West & Central Region are currently under review, and therefore this layer represents the latest available data in our systems. The representation of North West & Central regional boundaries in this layer may not represent latest boundary position. Care should be taken when using this information as this information is currently not being updated.

ASPRO NATIONAL MAP

CLIENT:	TECHNICAL AUTHORITY		
JOB NO.:	10519.112	USE TYPE:	[OFFICIAL]
SCALE:	1:3,000,000 @ A3	DATE:	10/08/2022
VERSION:	01	PRODUCED BY:	AS
		QA BY:	N/A



Asset Information Services

Contains Ordnance Survey data © Crown copyright and database right 2022. Licence No: 0100040692

GeospatialReportingAnalysis@NetworkRail.co.uk

Corporate GIS data is subject to frequent updates therefore any data exported from the corporate GIS system is a static representation of the data at the time of export, and should be treated as such. No warranty or guarantee is given as to the absolute accuracy or completeness of this information. Network Rail disclaims any responsibility for any loss, damage or inconvenience howsoever caused arising out of or as a consequence of reliance on this information in any context.



Order ID: 168506

ELR	Start Mileage	End Mileage
TYB1	68.0356	69.1507
WBC	-0.0721	0.0626
MAC3	68.0375	71.0367



National Hazard Directory

Terms and Conditions

The National Hazard Directory (NHD) is issued by Network Rail to provide information on those hazards recorded as present on Network Rail's infrastructure. Its purpose is to alert users to the typical hazards they may come across whilst working on Network Rail's Infrastructure. The National Hazard Directory is maintained by Network Rail to provide its employees and contractors with information on known hazards present on the infrastructure in order to assist in the identification of the associated risks working 'on or near the line'.

The records are updated regularly and therefore Network Rail believe that the contents are reasonably accurate at the time of issue, but some of the information can vary in age and accuracy so for that reason Network Rail will give no warranty as to the suitability of its use. It is recommended that all searches (in particular for buried services) should be conducted together with a site specific risk assessment/site visit, taking into account the requirements of the appropriate track safety rules, rule books/industry standards and so on. Network Rail will accept no liability in respect of the content or subsequent use of the National Hazard Directory or any of the information contained within.

Users of the Directory must note that when working on or near the line that the appropriate requirements of the Rule Book, especially the provisions of the track safety rules, must be applied as appropriate to the activity concerned.

OnTrac Ltd does not warrant the use of the Network Rail National Hazard Directory or any of the information contained within and no representations or warranties are made as to completeness or accuracy of the data. The data should be used for reference purposes only. Accordingly, OnTrac Ltd will accept no responsibility for loss of profit or for any indirect, incidental or consequential damages.

National Hazard Directory

Customised Report

Search Criteria: ELR(s) = TYB1; Mileage From = 68.0356; Mileage To = 69.1507; Hazard Code(s) = HB, HBA, HBC, HBCS, HBD, HBE, HBF, HBFR, HBFS, HBG, HBI, HBL, HBM, HBN, HBO, HBP, HBR, HBS, HBSW, HBT, HBU, HBW, HCT, HU, HXE
Date: 04/05/2023

2 Hazards found.

ELR	ELR Name	Mileage From	Mileage To	Hazard Code	Hazard Description	Local Name	Track ID	Free Text
TYB1	CLARBOROUGH JN - COTTAM CEGB (TORKSEY BRANCH)	69.0110	69.0110	HBW	Buried Water Main			High Pressure Water Pipeline. RT Document: RTP LP NO 401/401A. ACROSS TRACKS BR AGT 2646 RT PROP DEED REF
TYB1	CLARBOROUGH JN - COTTAM CEGB (TORKSEY BRANCH)	69.0110	69.0110	HBW	Buried Water Main			High Pressure Water Pipeline. RT Document: RTP LP NO 401/401A. ACROSS TRACKS 2/231/521 RT PROP FILE REF NER AGT 5147 RT PROP DEED REF

National Hazard Directory

Customised Report

Search Criteria: ELR(s) = WBC; Mileage From = -0.0721; Mileage To = 0.0626; Hazard Code(s) = HB, HBA, HBC, HBCS, HBD, HBE, HBF, HBFR, HBFS, HBG, HBI, HBL, HBM, HBN, HBO, HBP, HBR, HBS, HBSW, HBT, HBU, HBW, HCT, HU, HXE
Date: 04/05/2023

1 Hazards found.

ELR	ELR Name	Mileage From	Mileage To	Hazard Code	Hazard Description	Local Name	Track ID	Free Text
WBC	WEST BURTON (CEGB SIDINGS)	0.0054	0.0054	HB	Buried Service			High Pressure Pipeline

National Hazard Directory


Customised Report

Search Criteria: ELR(s) = MAC3; Mileage From = 68.0375; Mileage To = 71.0367; Hazard Code(s) = HB, HBA, HBC, HBCS, HBD, HBE, HBF, HBFR, HBFS, HBG, HBI, HBL, HBM, HBN, HBO, HBP, HBR, HBS, HBSW, HBT, HBU, HBW, HCT, HU, HXE
Date: 04/05/2023



12 Hazards found.

ELR	ELR Name	Mileage From	Mileage To	Hazard Code	Hazard Description	Local Name	Track ID	Free Text
MAC3	DEEPCAR (BSC) - CLEETHORPES	64.1021	94.0924	HB	Buried Service			High Tension Cable. RT Document: RTP LP NO.358. 21172/0014 RT PROP MENTOR REF~ NORTH SIDE OF RAILWAY
MAC3	DEEPCAR (BSC) - CLEETHORPES	68.0704	68.0704	HBE	Buried Electrical Cables	Clarborough Relay Room (REB)		Electricity Cable.
MAC3	DEEPCAR (BSC) - CLEETHORPES	68.0704	68.0704	HB	Buried Service	Clarborough Relay Room (REB)		High Tension Cable. Telecom
MAC3	DEEPCAR (BSC) - CLEETHORPES	69.1370	69.1392	HBW	Buried Water Main			High Pressure Water Pipeline. RT Document: RTP LP NO.397. 24296/0010 RT PROP MENTOR REF ANGLED ACROSS RAILWAY
MAC3	DEEPCAR (BSC) - CLEETHORPES	70.0660	70.0660	HBW	Buried Water Main			High Pressure Water Pipeline. RT Document: RTP LP NO.397. NO INFORMATION
MAC3	DEEPCAR (BSC) - CLEETHORPES	70.0668	70.0876	HBE	Buried Electrical Cables			Electricity Cable. RT Document: RTP LP NO.397. 24296/0002 RT PROP MENTOR REF NORTH SIDE OF RAILWAY
MAC3	DEEPCAR (BSC) - CLEETHORPES	70.1142	70.1322	HBE	Buried Electrical Cables			Electricity Cable. 132kv. RT Document: RTP LP NO.397. 24296/0002 RT PROP MENTOR REF NORTH SIDE OF RAILWAY
MAC3	DEEPCAR (BSC) - CLEETHORPES	70.1402	71.0118	HBO	Buried Oil Pipe	Government Pipelines & Storage Syst. Network Pipe	All/Multiple Tracks	Near West Burton Power Station. Follows alongside track at start mileage and crosses at end mileage. Record Centre Document Location: A264/3 121/7. For more information contact Records Centre 03 743347.
MAC3	DEEPCAR (BSC) - CLEETHORPES	70.1562	70.1578	HBW	Buried Water Main	STURTON LEVEL CROSSING		High Pressure Water Pipeline. Diameter=4". RT Document: RTP LP NO.397. 24296/0007 RT PROP MENTOR REF SOUTH SIDE OF RAILWAY AND ACROSS AT END MILE
MAC3	DEEPCAR (BSC) - CLEETHORPES	70.1584	70.1584	HBW	Buried Water Main			High Pressure Water Pipeline. RT Document: RTP LP NO.397. NO INFORMATION
MAC3	DEEPCAR (BSC) - CLEETHORPES	70.1584	70.1584	HBW	Buried Water Main			High Pressure Water Pipeline. RT Document: RTP LP NO.397. AGT DATED 17.3.1965 LINCOLN AND DISTRICT WATER BOARD
MAC3	DEEPCAR (BSC) - CLEETHORPES	70.1628	70.1628	HB	Buried Service			High Pressure Pipeline

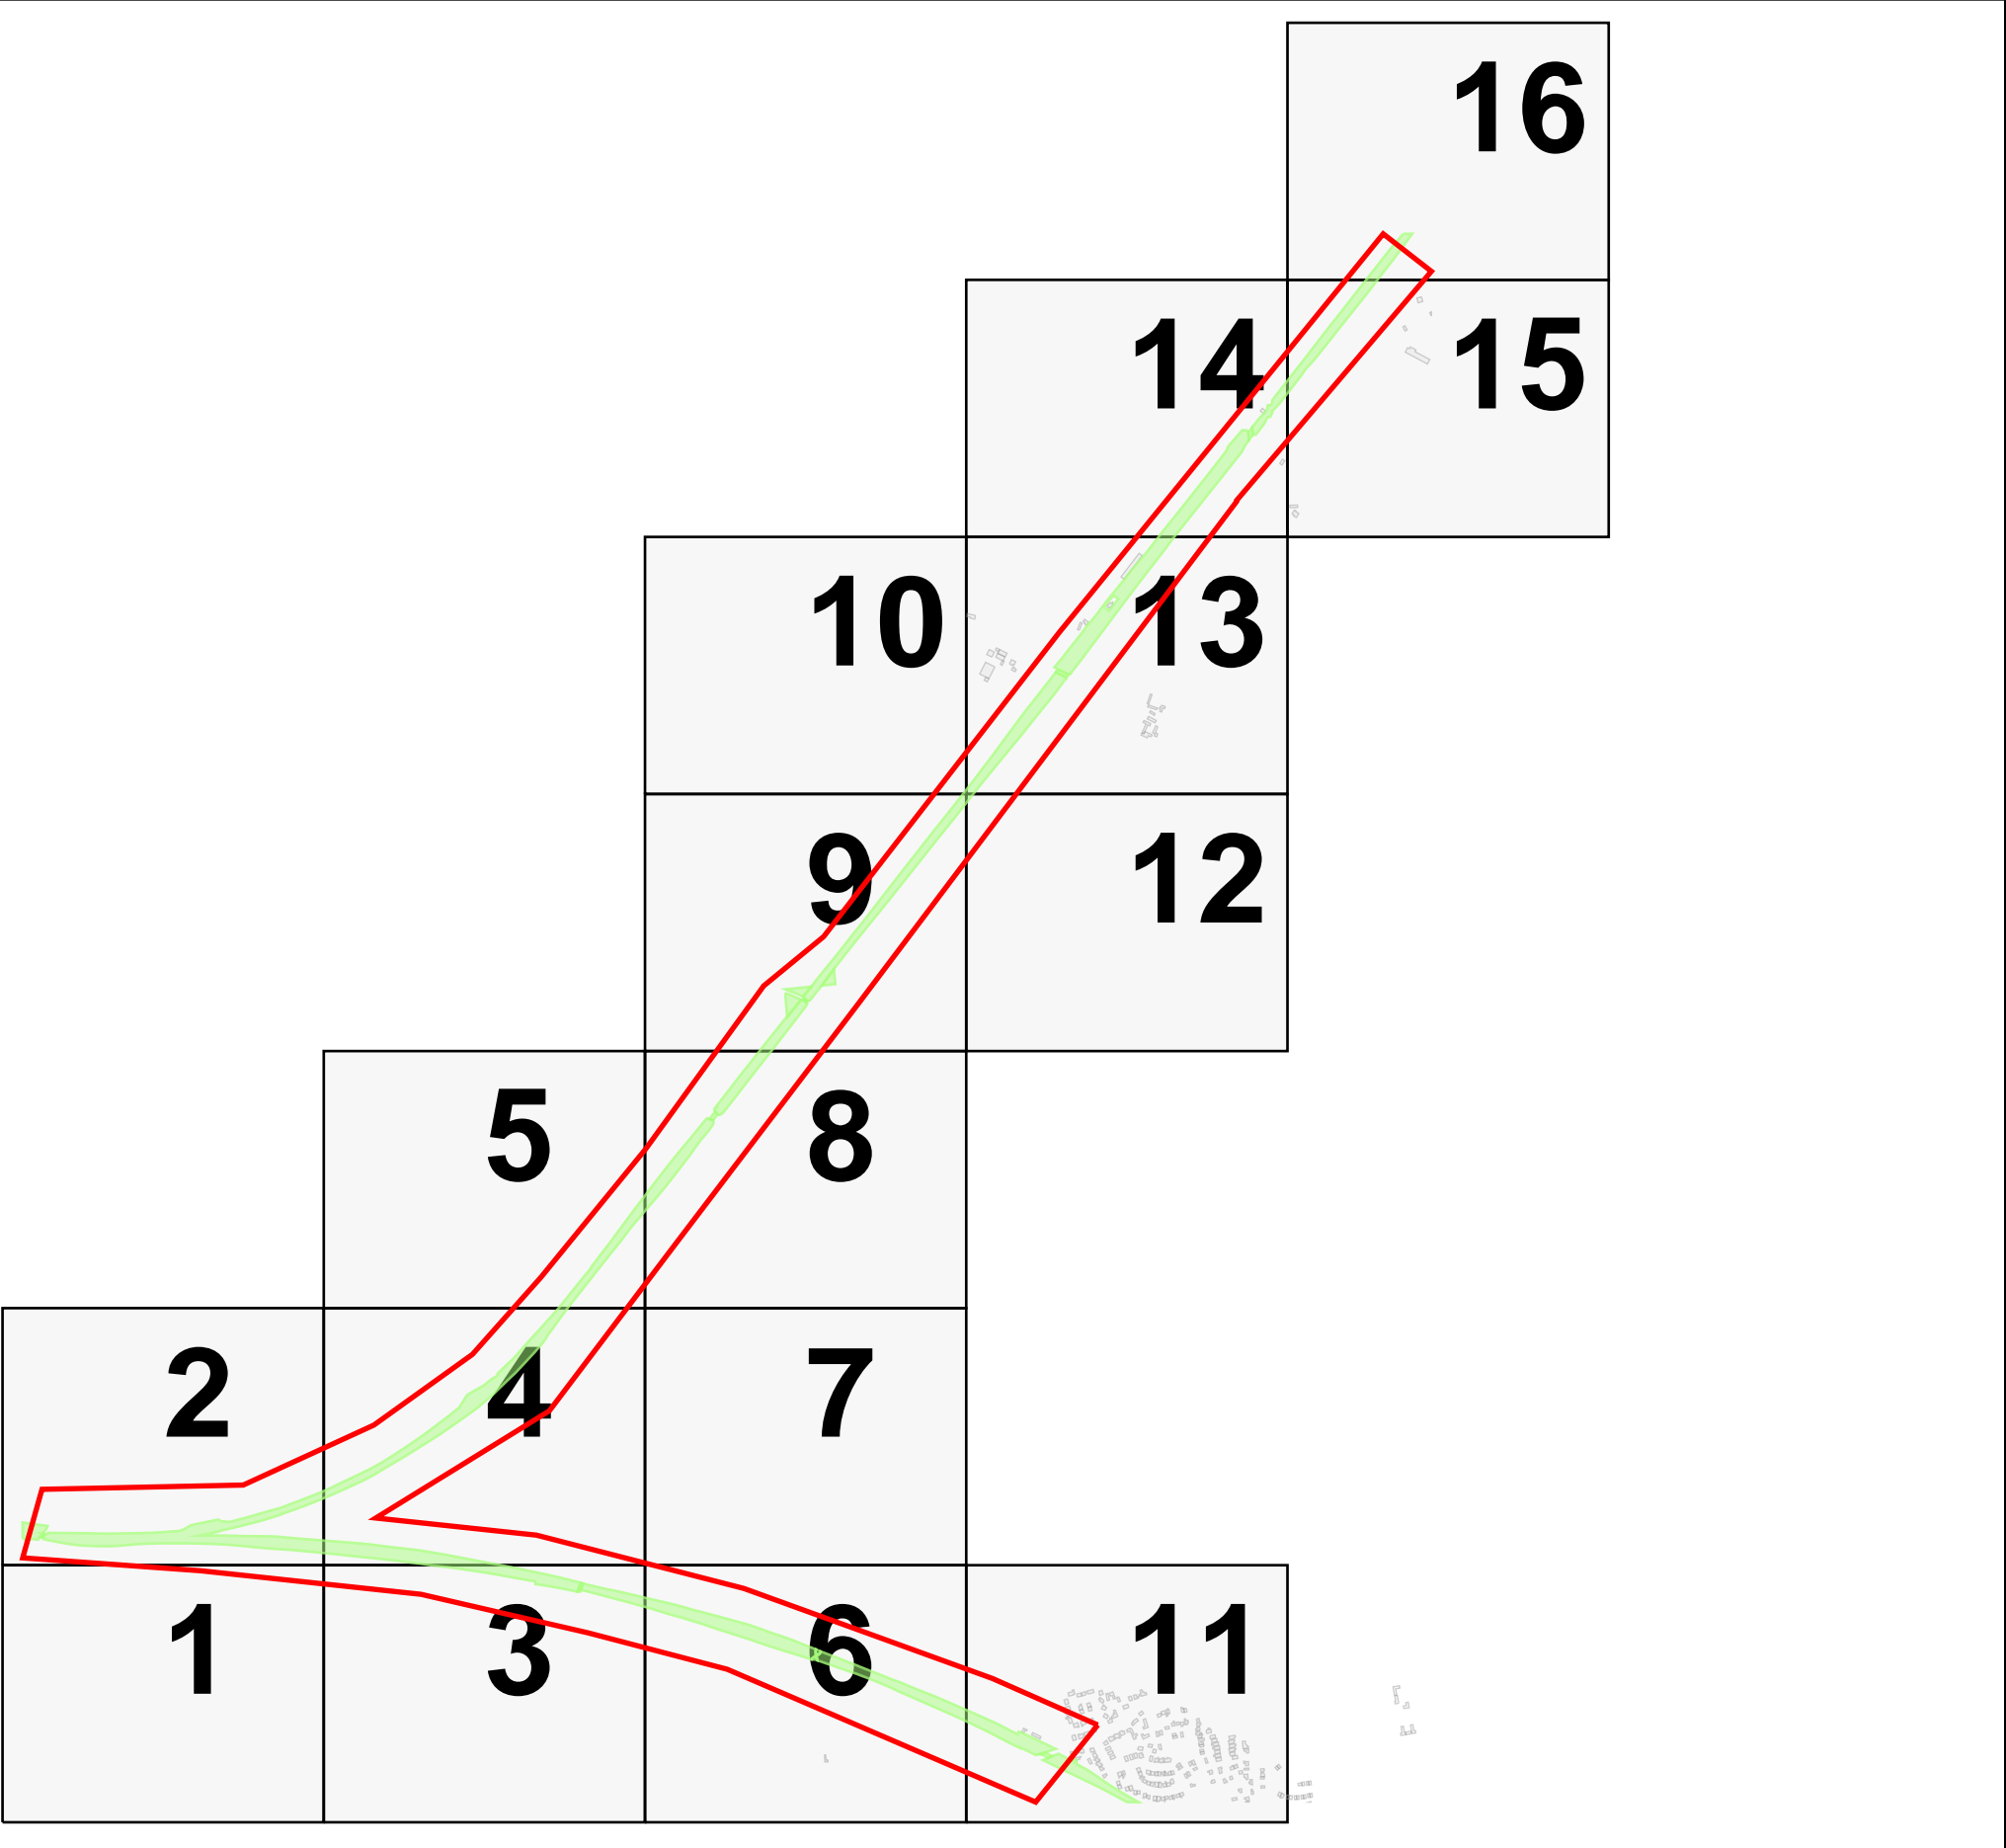Page Navigation Index Map (1:2500 scale maps)



Legend

-  Network Rail Company Ownership Boundary
-  Order Polygon

Order ID: 168506


Plot Date: 04/05/23



User Drawn Polygon / Area of Interest - Order ID : 168506

Legend

- Company Ownership
 - Freehold Ownership
 - Leasehold Ownership
 - Prohibitive Interest
 - Bridge (Rail over Rail)
 - Bridge (Rail over River)
 - Bridge (Rail over Road)
 - Bridge (Road over Rail)
 - Level Crossing
 - Tunnel
- Order Polygon

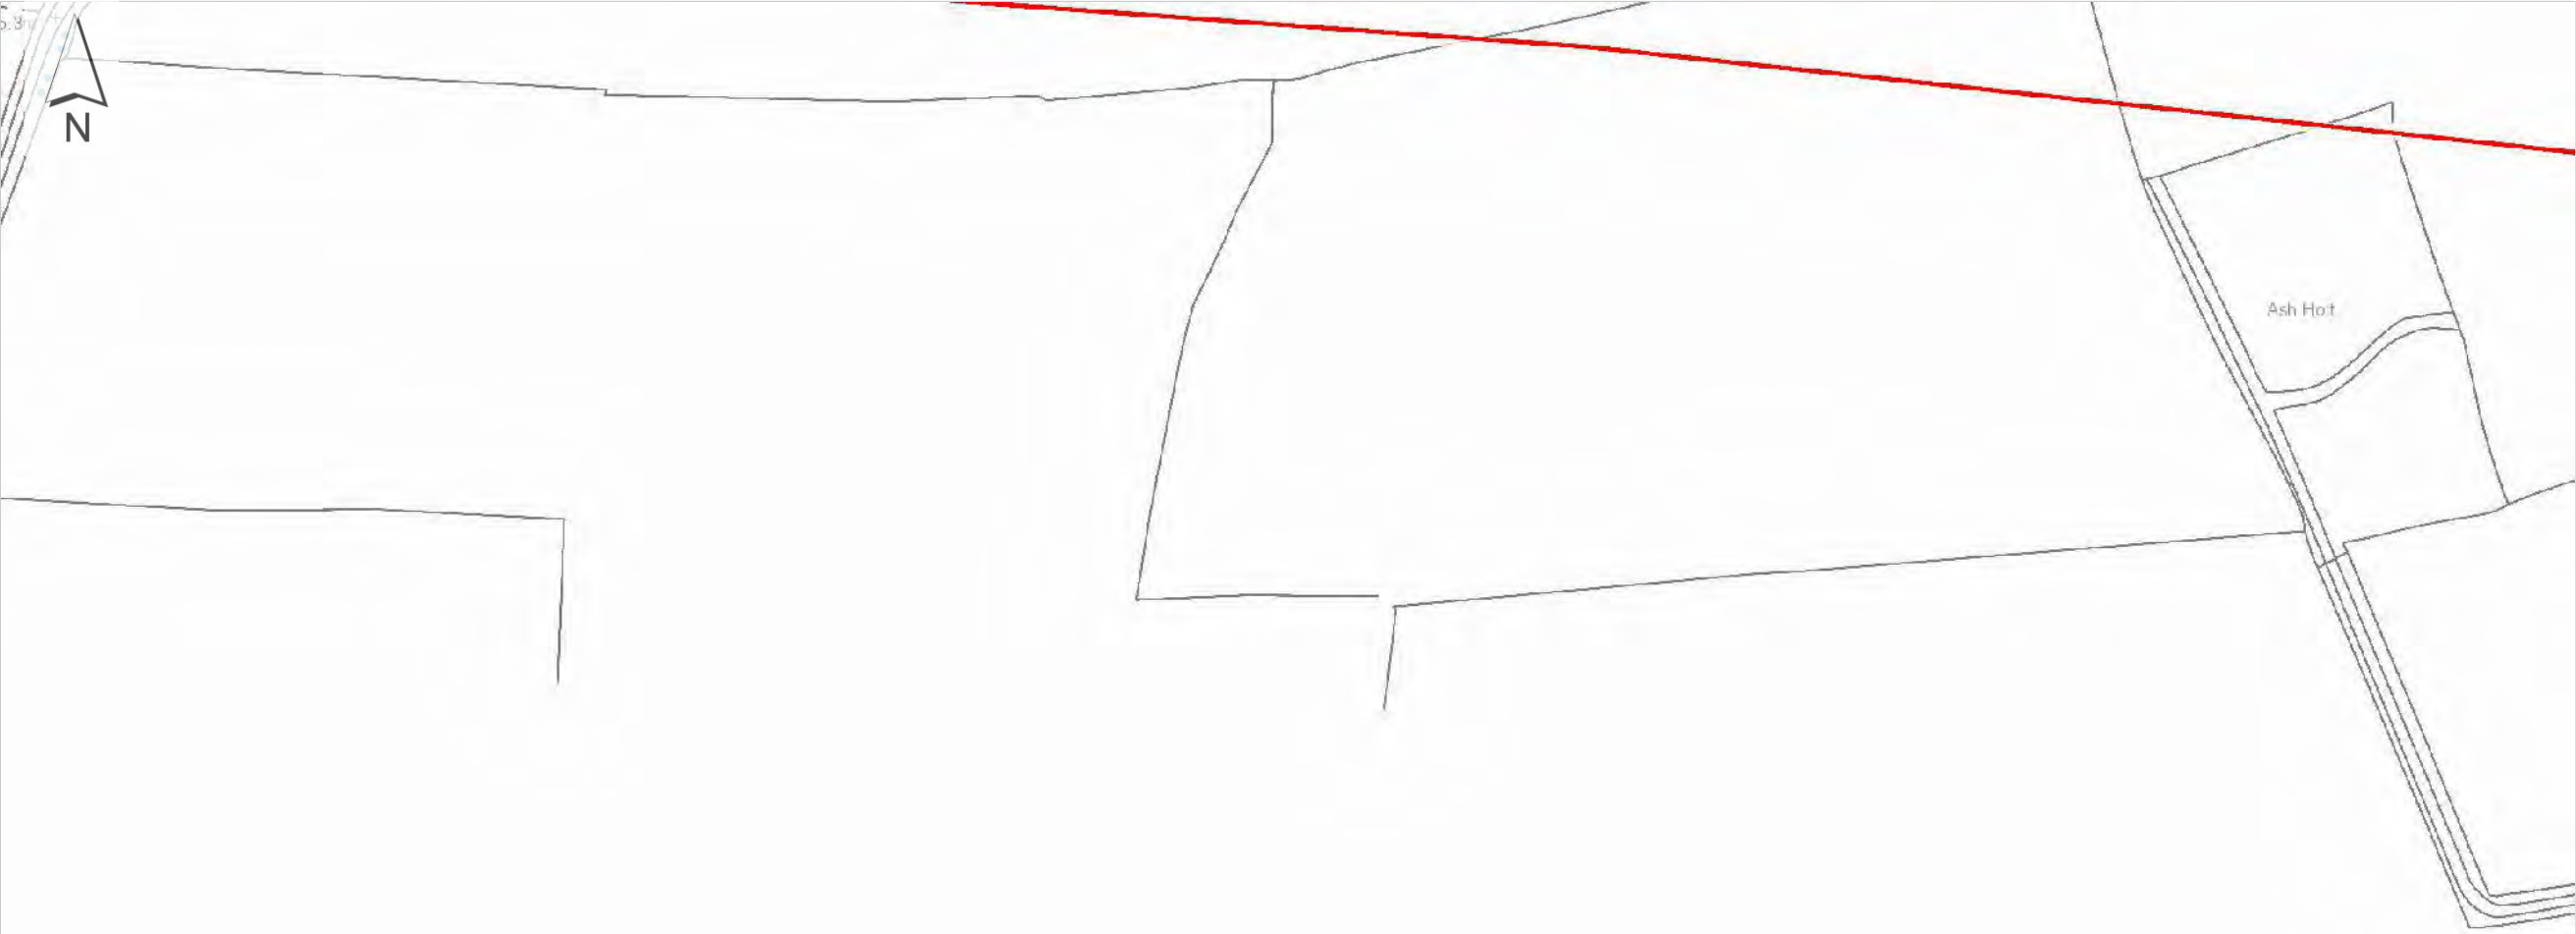

Nearest station:
Gainsborough Lea Road

Order ID: 168506


Order Ref: 168506
Plot Scale: 1:2500
Page Index: 1
Centre X, Y: 475856, 382158
Plot Date: 04/05/23



User Drawn Polygon / Area of Interest - Order ID : 168506

Legend

- Freehold Ownership
- Leasehold Ownership
- Prohibitive Interest
- Bridge (Rail over Rail)
- Bridge (Rail over River)
- Bridge (Rail over Road)
- Bridge (Road over Rail)
- Level Crossing
- Tunnel
- Order Polygon

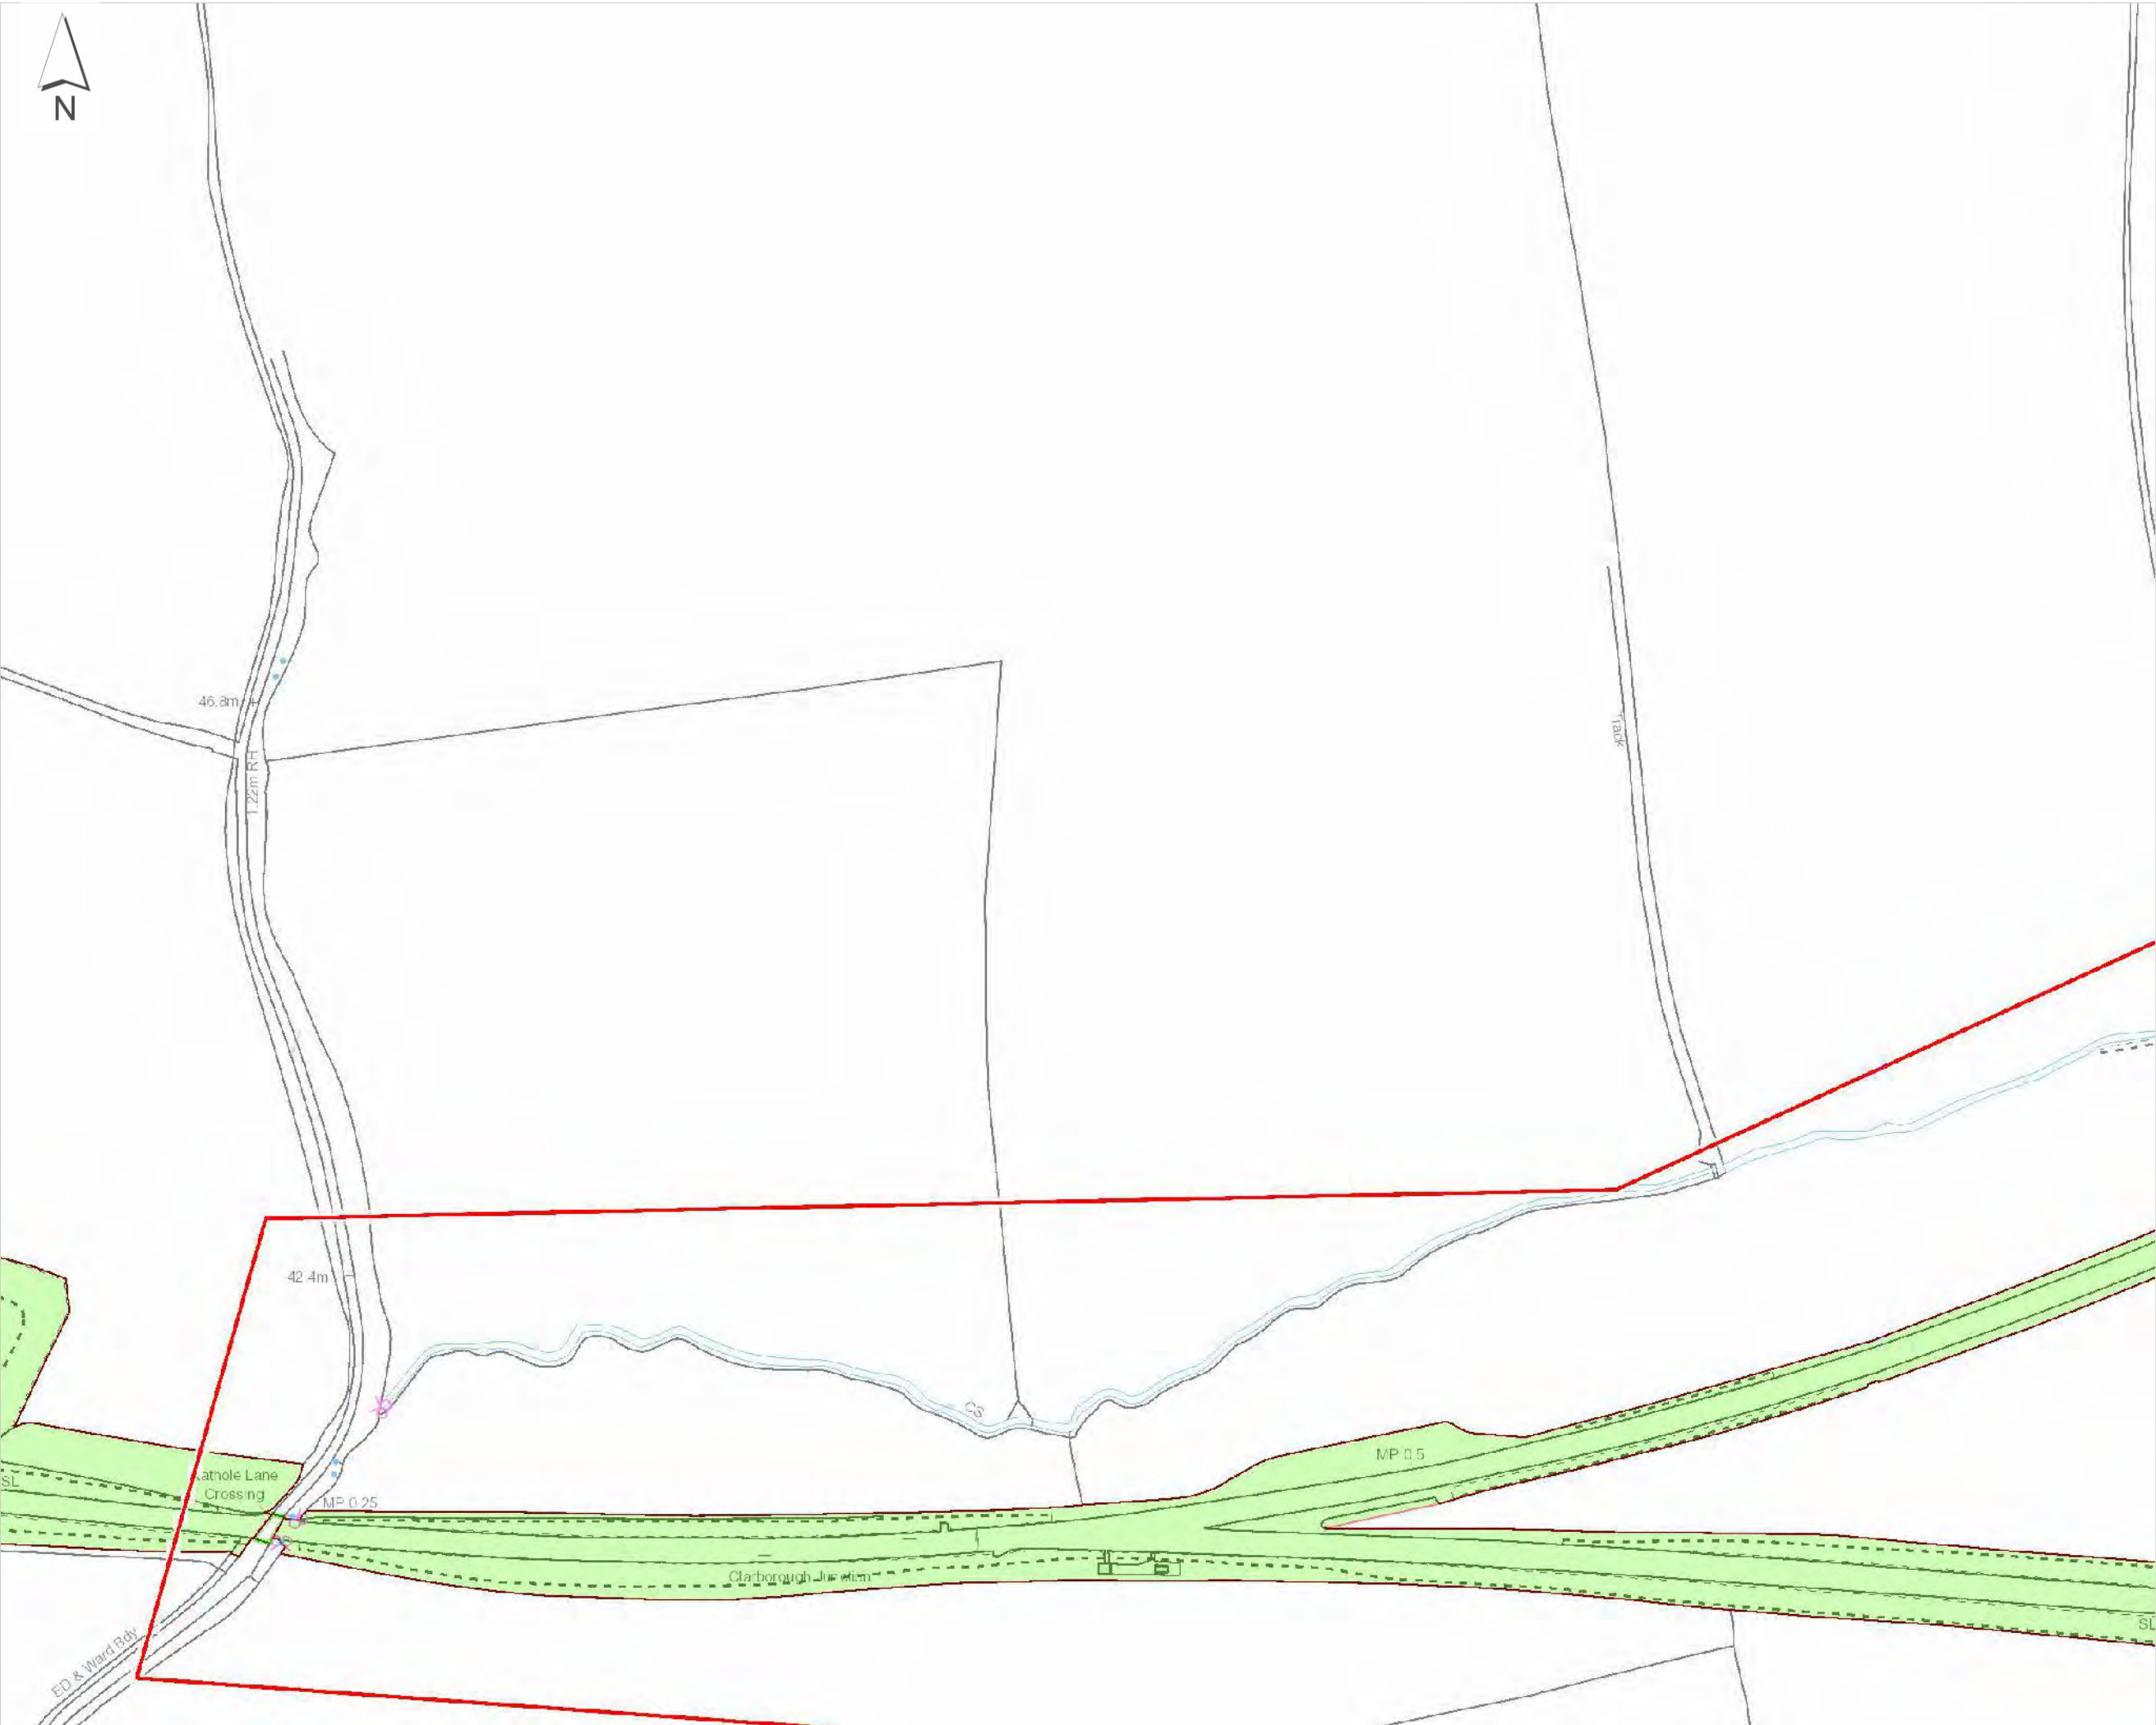

Nearest station:
Gainsborough Lea Road

Order ID: 168506

Order Ref: 168506
Plot Scale: 1:2500
Page Index: 2
Centre X, Y: 475856, 382793
Plot Date: 04/05/23



User Drawn Polygon / Area of Interest - Order ID : 168506

Legend

- Company Ownership**
- Freehold Ownership
- Leasehold Ownership
- Prohibitive Interest
- Bridge (Rail over Rail)
- Bridge (Rail over River)
- Bridge (Rail over Road)
- Bridge (Road over Rail)
- Level Crossing
- Tunnel
- Order Polygon



Nearest station:
Gainsborough Lea Road

Order ID: 168506

Order Ref: 168506
Plot Scale: 1:2500
Page Index: 3
Centre X, Y: 476650, 382158
Plot Date: 04/05/23




User Drawn Polygon / Area of Interest - Order ID : 168506



Legend

- Company Ownership
 - Freehold Ownership
 - Leasehold Ownership
 - Prohibitive Interest
 - Bridge (Rail over Rail)
 - Bridge (Rail over River)
 - Bridge (Rail over Road)
 - Bridge (Road over Rail)
 - Level Crossing
 - Tunnel
 - Order Polygon

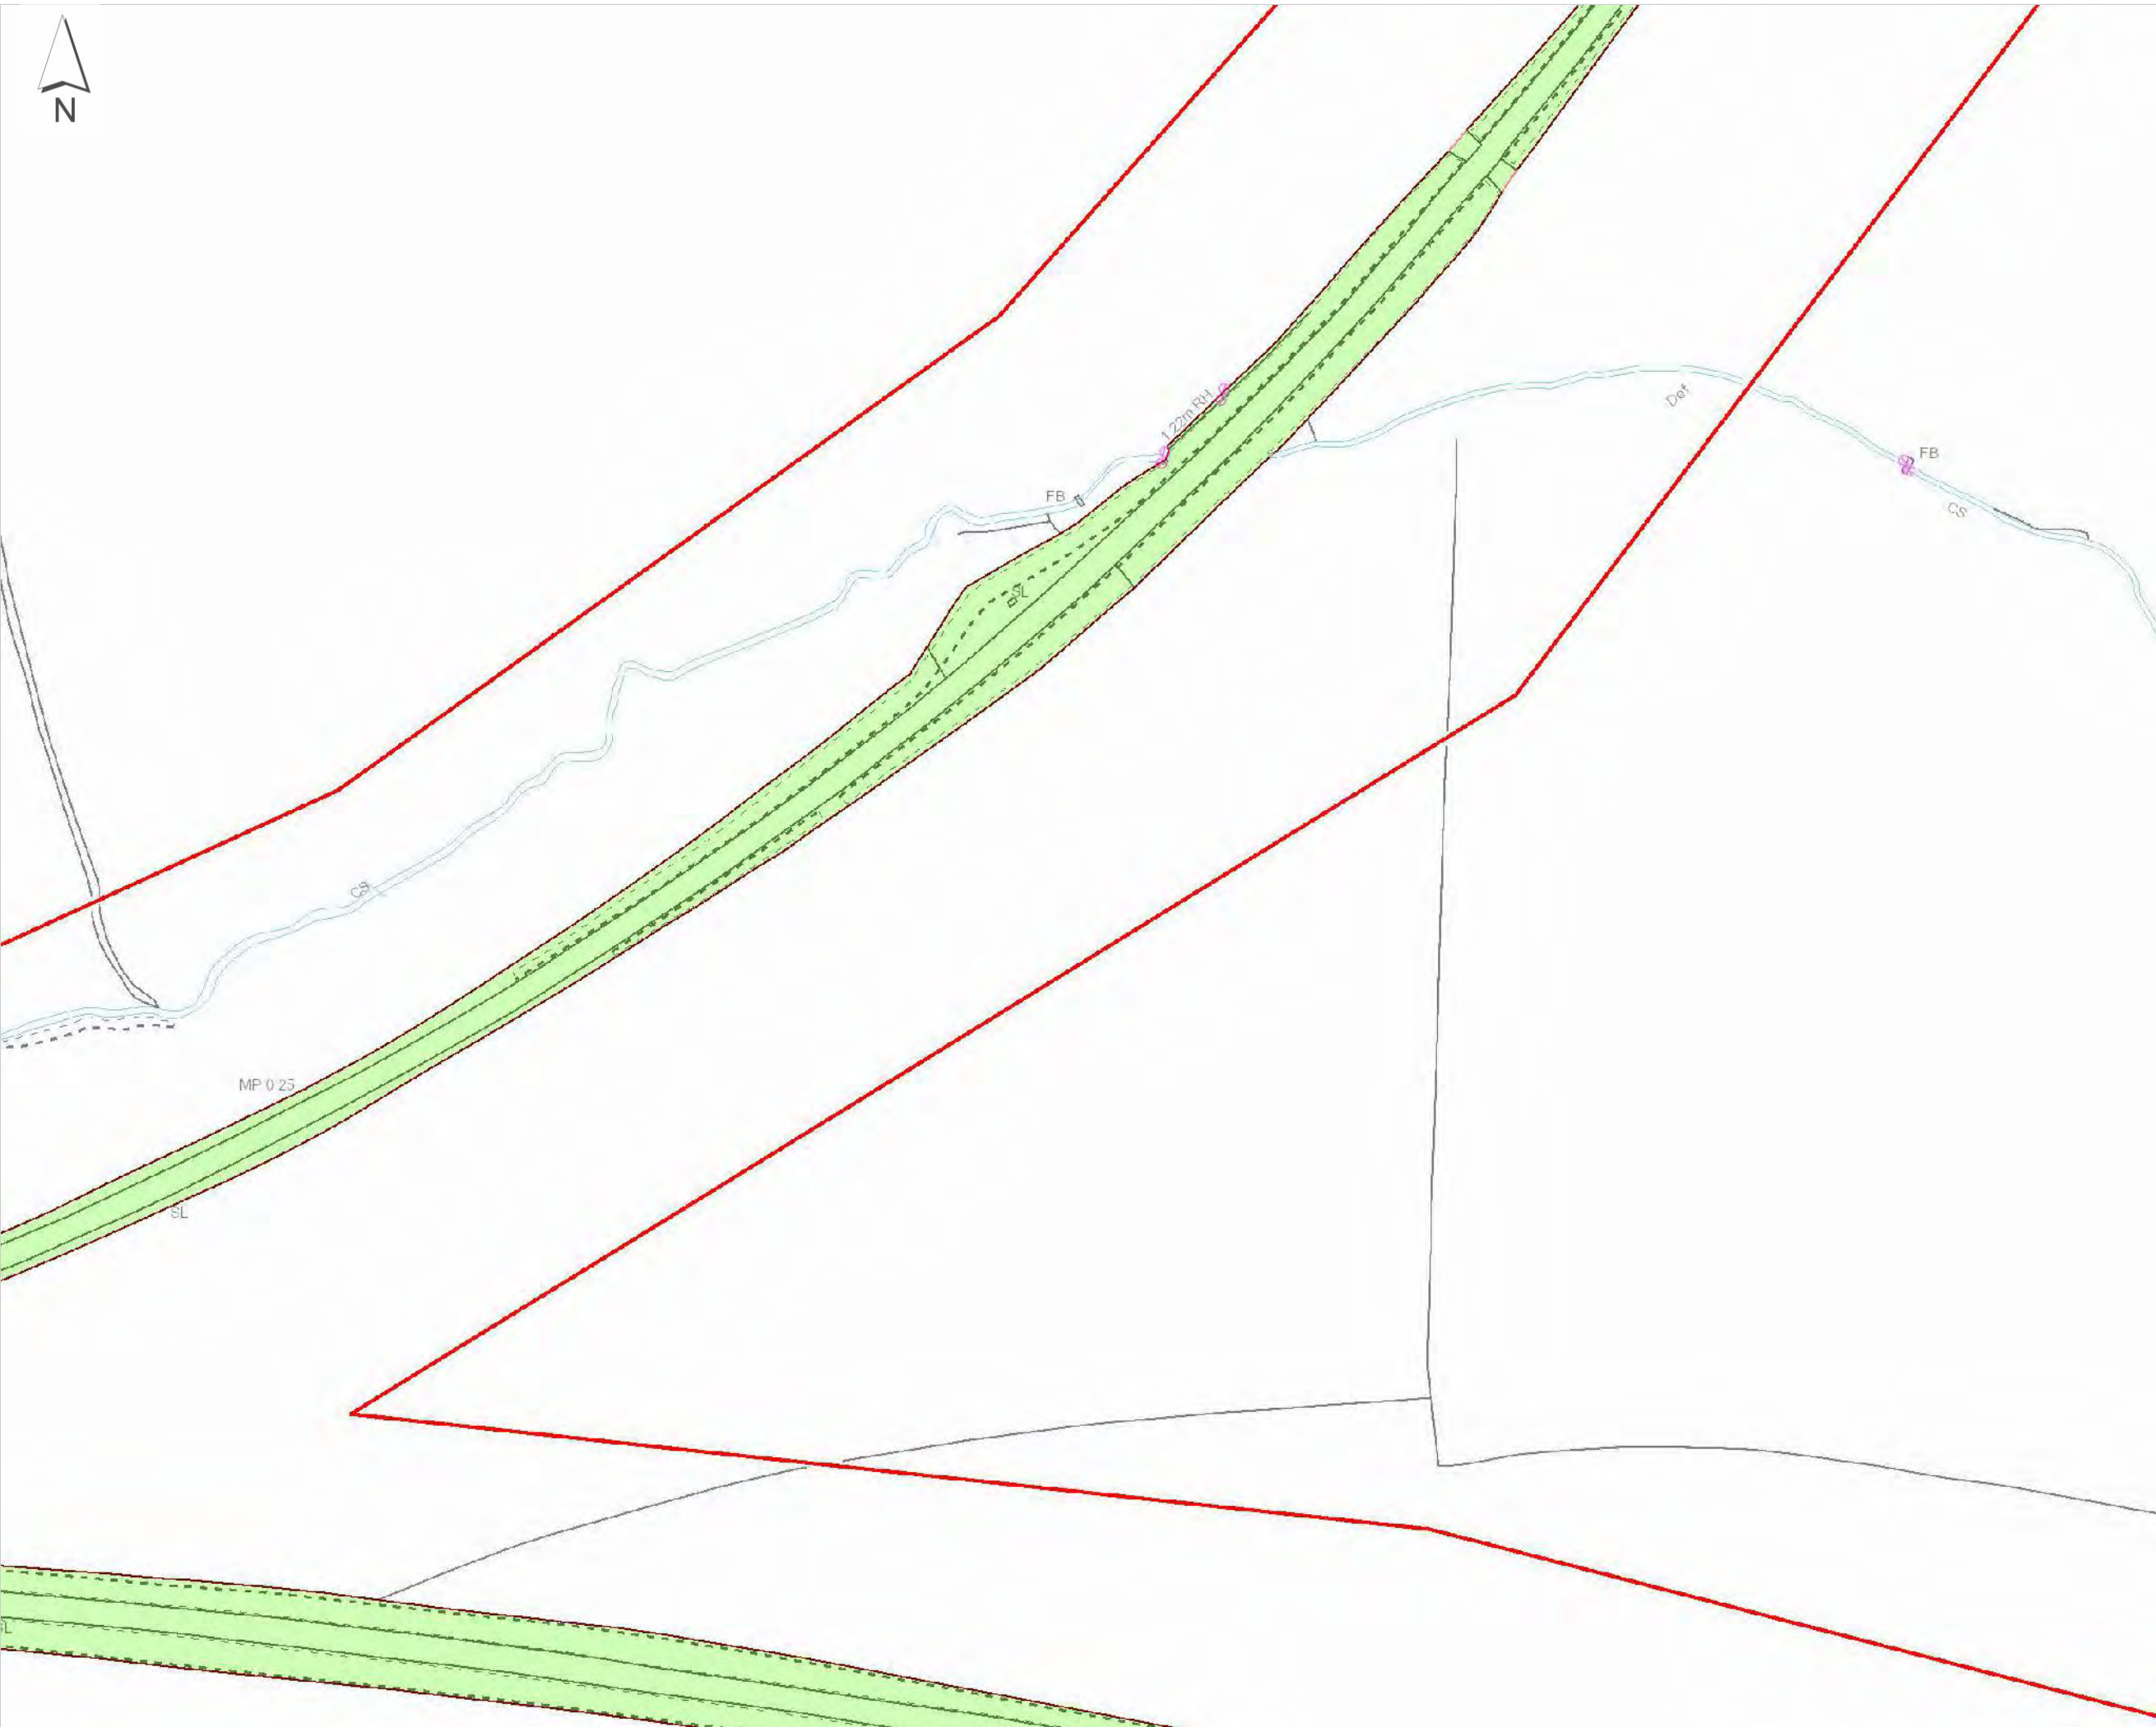

Nearest station:
Gainsborough Lea Road

Order ID: 168506

Order Ref: 168506
Plot Scale: 1:2500
Page Index: 4
Centre X, Y: 476650, 382793
Plot Date: 04/05/23



Crown copyright and database rights 2023
Ordnance Survey 0100040692

User Drawn Polygon / Area of Interest - Order ID : 168506



Legend

- Company Ownership
 - Freehold Ownership
 - Leasehold Ownership
 - Prohibitive Interest
 - Bridge (Rail over Rail)
 - Bridge (Rail over River)
 - Bridge (Rail over Road)
 - Bridge (Road over Rail)
 - Level Crossing
 - Tunnel
- Order Polygon



Nearest station:
Gainsborough Lea Road

Order ID: 168506

Order Ref: 168506
Plot Scale: 1:2500
Page Index: 5
Centre X, Y: 476650, 383428
Plot Date: 04/05/23



User Drawn Polygon / Area of Interest - Order ID : 168506

Legend

- Company Ownership
 - Freehold Ownership
 - Leasehold Ownership
 - Prohibitive Interest
 - Bridge (Rail over Rail)
 - Bridge (Rail over River)
 - Bridge (Rail over Road)
 - Bridge (Road over Rail)
 - Level Crossing
 - Tunnel
 - Order Polygon



Nearest station:
Gainsborough Lea Road

Order ID: 168506

Order Ref: 168506
Plot Scale: 1:2500
Page Index: 6
Centre X, Y: 477444, 382158
Plot Date: 04/05/23



User Drawn Polygon / Area of Interest - Order ID : 168506



Legend

- Company Ownership**
- Freehold Ownership
- Leasehold Ownership
- Prohibitive Interest
- Bridge (Rail over Rail)
- Bridge (Rail over River)
- Bridge (Rail over Road)
- Bridge (Road over Rail)
- Level Crossing
- Tunnel
- Order Polygon

Nearest station:
Gainsborough Lea Road

Order ID: 168506

Order Ref: 168506
Plot Scale: 1:2500
Page Index: 7
Centre X, Y: 477444, 382793
Plot Date: 04/05/23




Crown copyright and database rights 2023
Ordnance Survey 0100040692

User Drawn Polygon / Area of Interest - Order ID : 168506

Legend

- Company Ownership**
- Freehold Ownership
- Leasehold Ownership
- Prohibitive Interest
- Bridge (Rail over Rail)
- Bridge (Rail over River)
- Bridge (Rail over Road)
- Bridge (Road over Rail)
- Level Crossing
- Tunnel
- Order Polygon

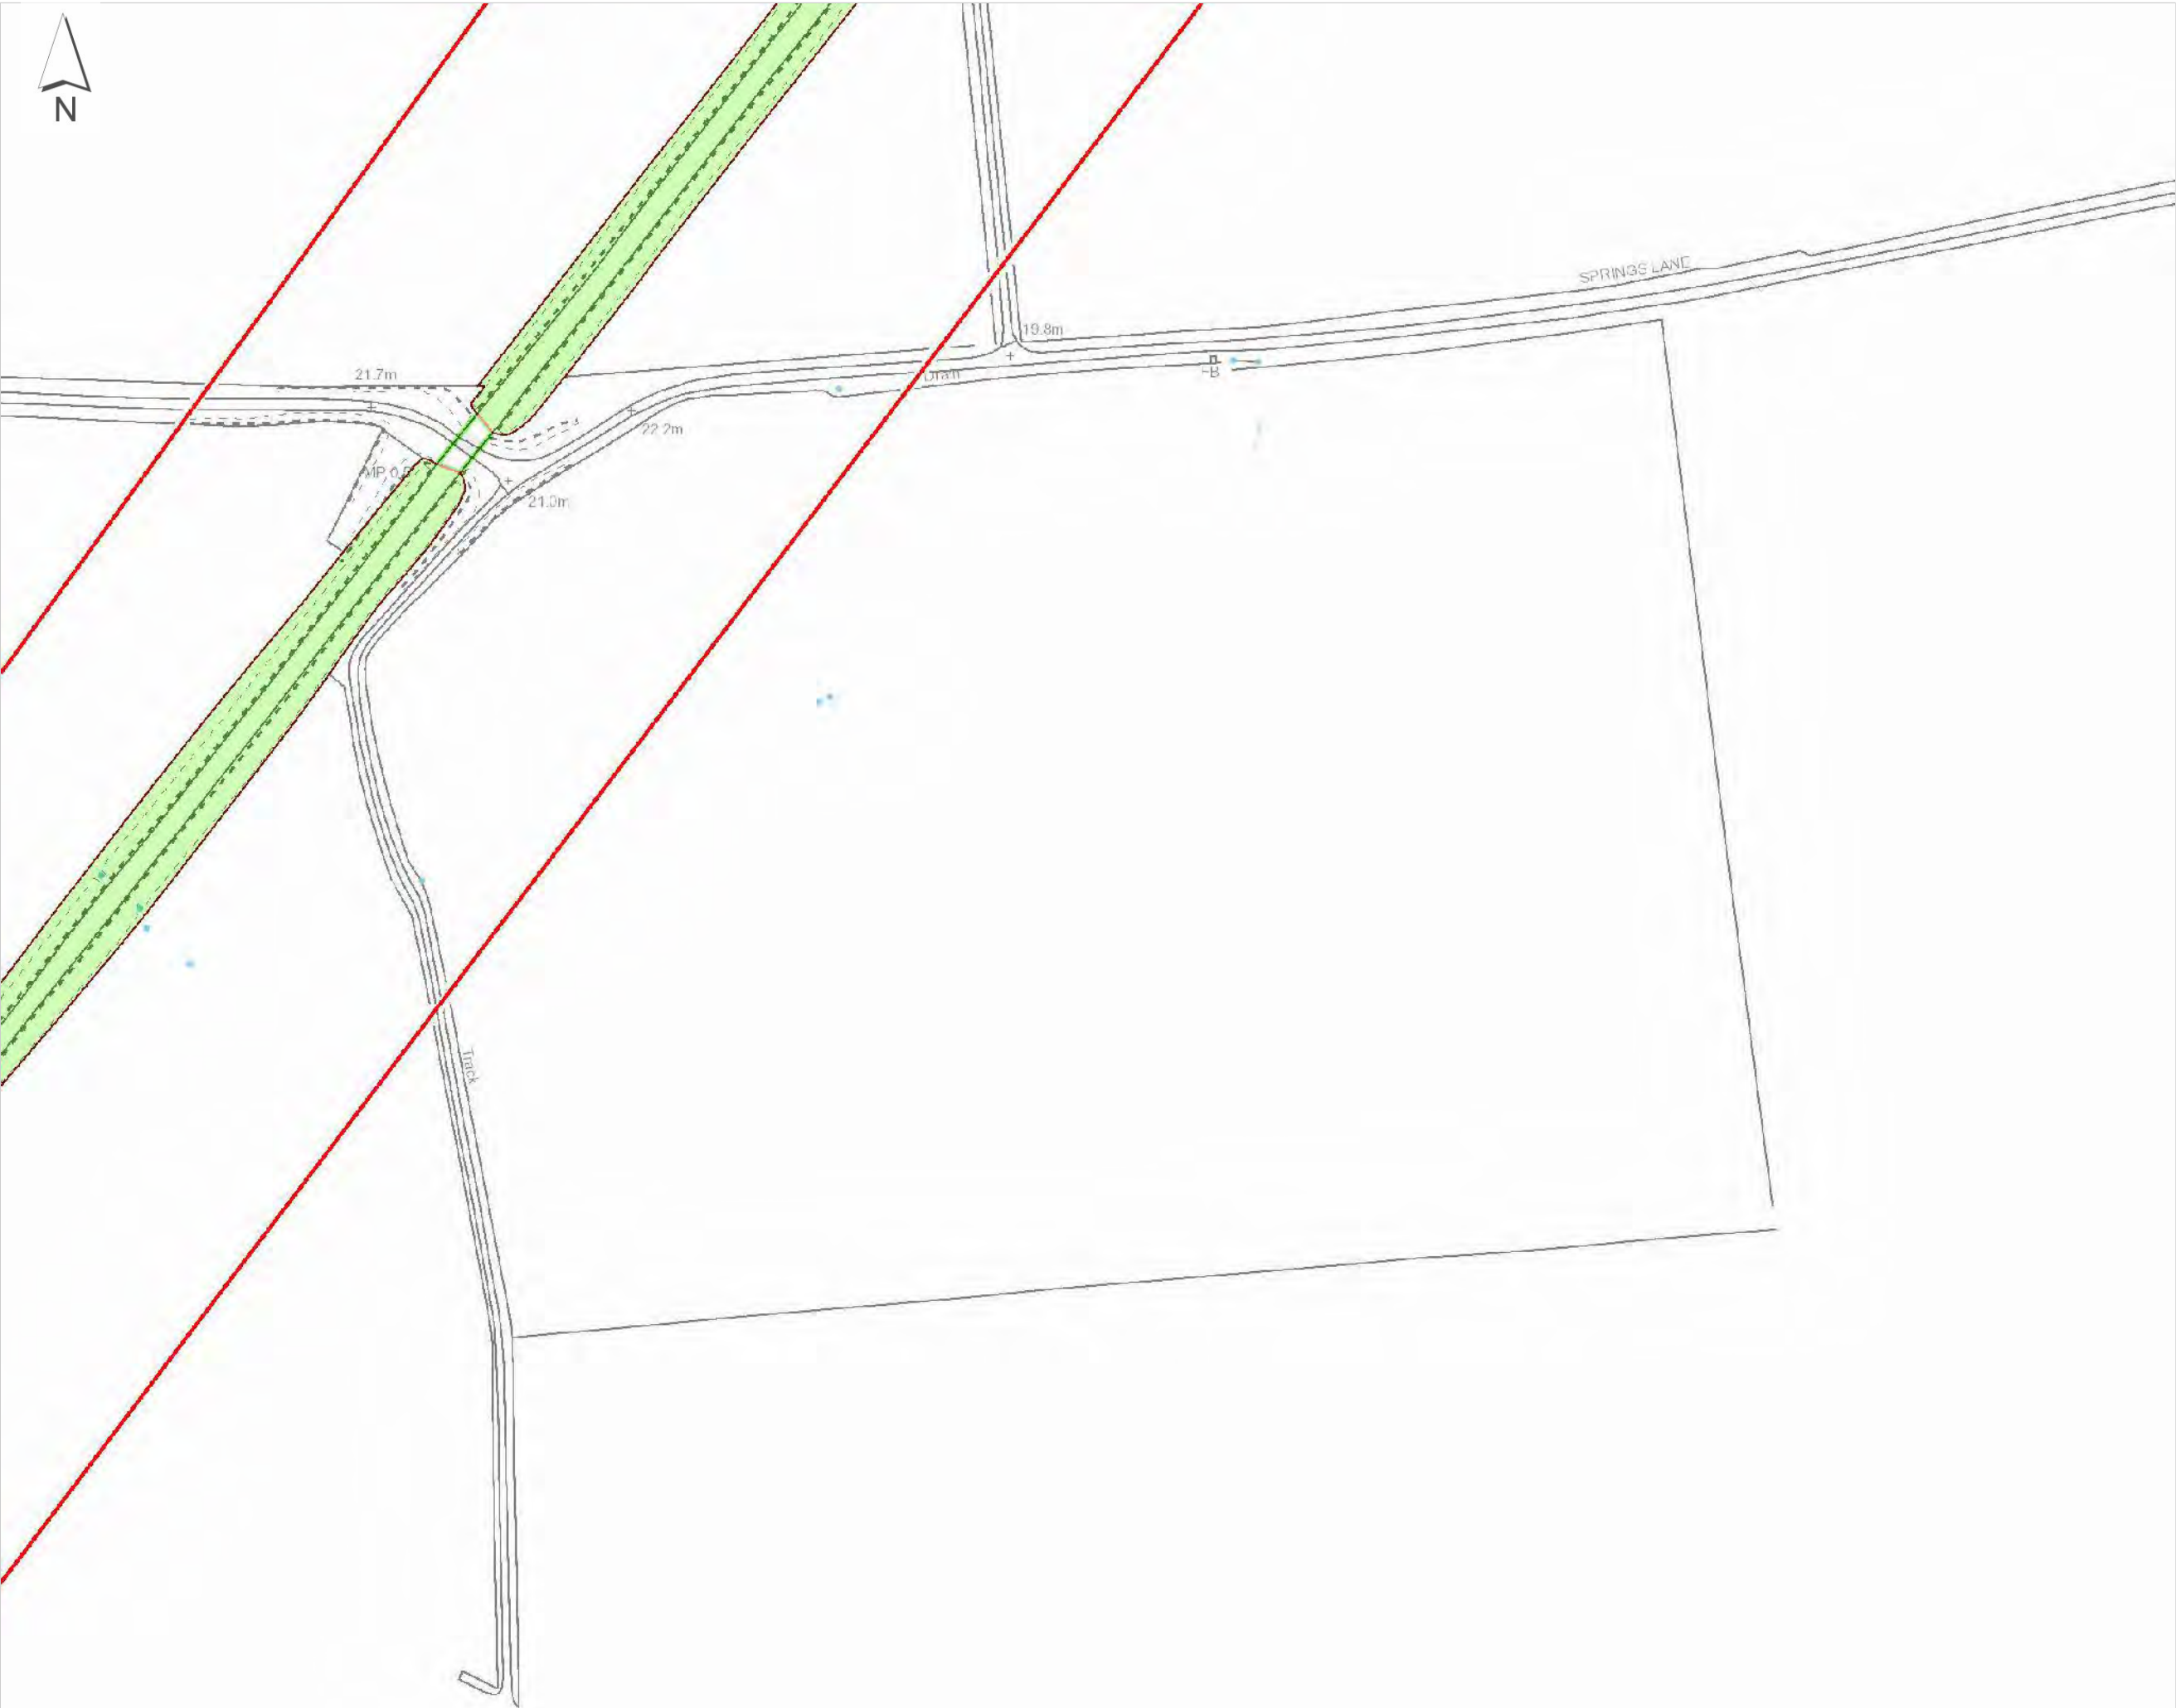

Nearest station:
Gainsborough Lea Road

Order ID: 168506

Order Ref: 168506
Plot Scale: 1:2500
Page Index: 8
Centre X, Y: 477444, 383428
Plot Date: 04/05/23




User Drawn Polygon / Area of Interest - Order ID : 168506



Legend

- Company Ownership
 - Freehold Ownership
 - Leasehold Ownership
 - Prohibitive Interest
 - Bridge (Rail over Rail)
 - Bridge (Rail over River)
 - Bridge (Rail over Road)
 - Bridge (Road over Rail)
 - Level Crossing
 - Tunnel
 - Order Polygon

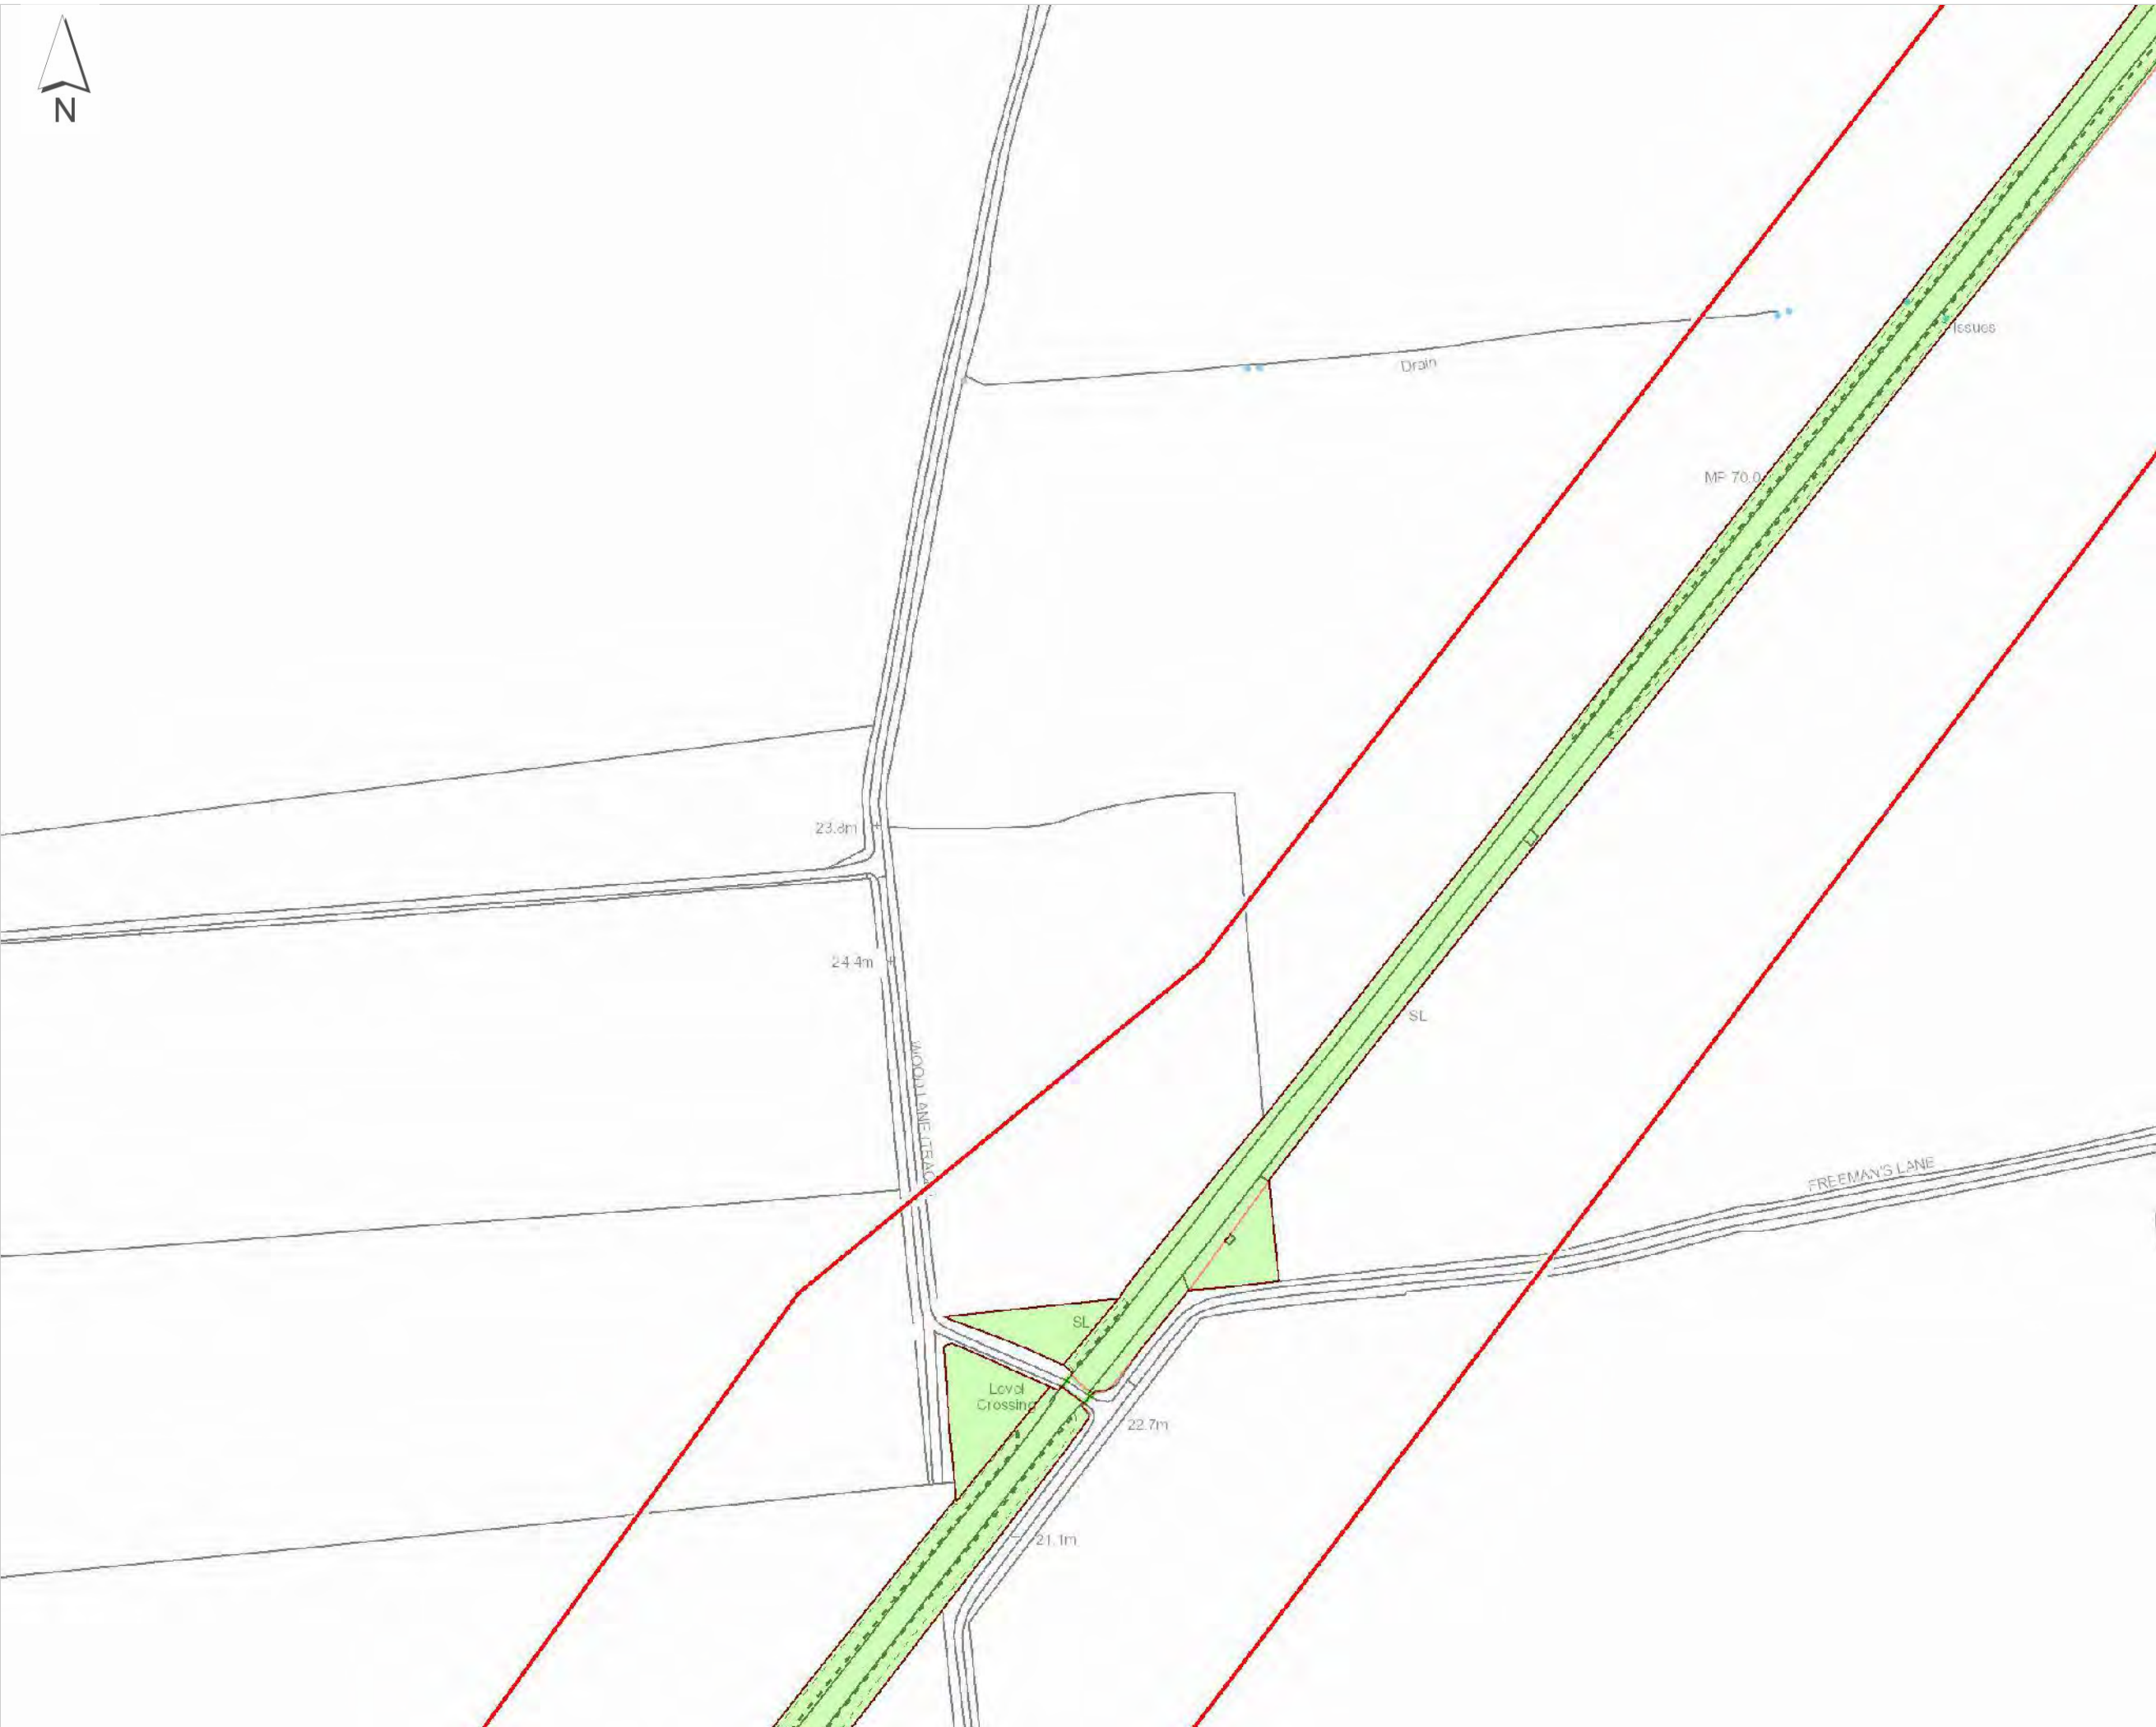

Nearest station:
Gainsborough Lea Road

Order ID: 168506

Order Ref: 168506
Plot Scale: 1:2500
Page Index: 9
Centre X, Y: 477444, 384063
Plot Date: 04/05/23




Crown copyright and database
rights 2023
Ordnance Survey 0100040692

User Drawn Polygon / Area of Interest - Order ID : 168506



Legend

- Freehold Ownership
- Leasehold Ownership
- Prohibitive Interest
- Bridge (Rail over Rail)
- Bridge (Rail over River)
- Bridge (Rail over Road)
- Bridge (Road over Rail)
- Level Crossing
- Tunnel
- Order Polygon

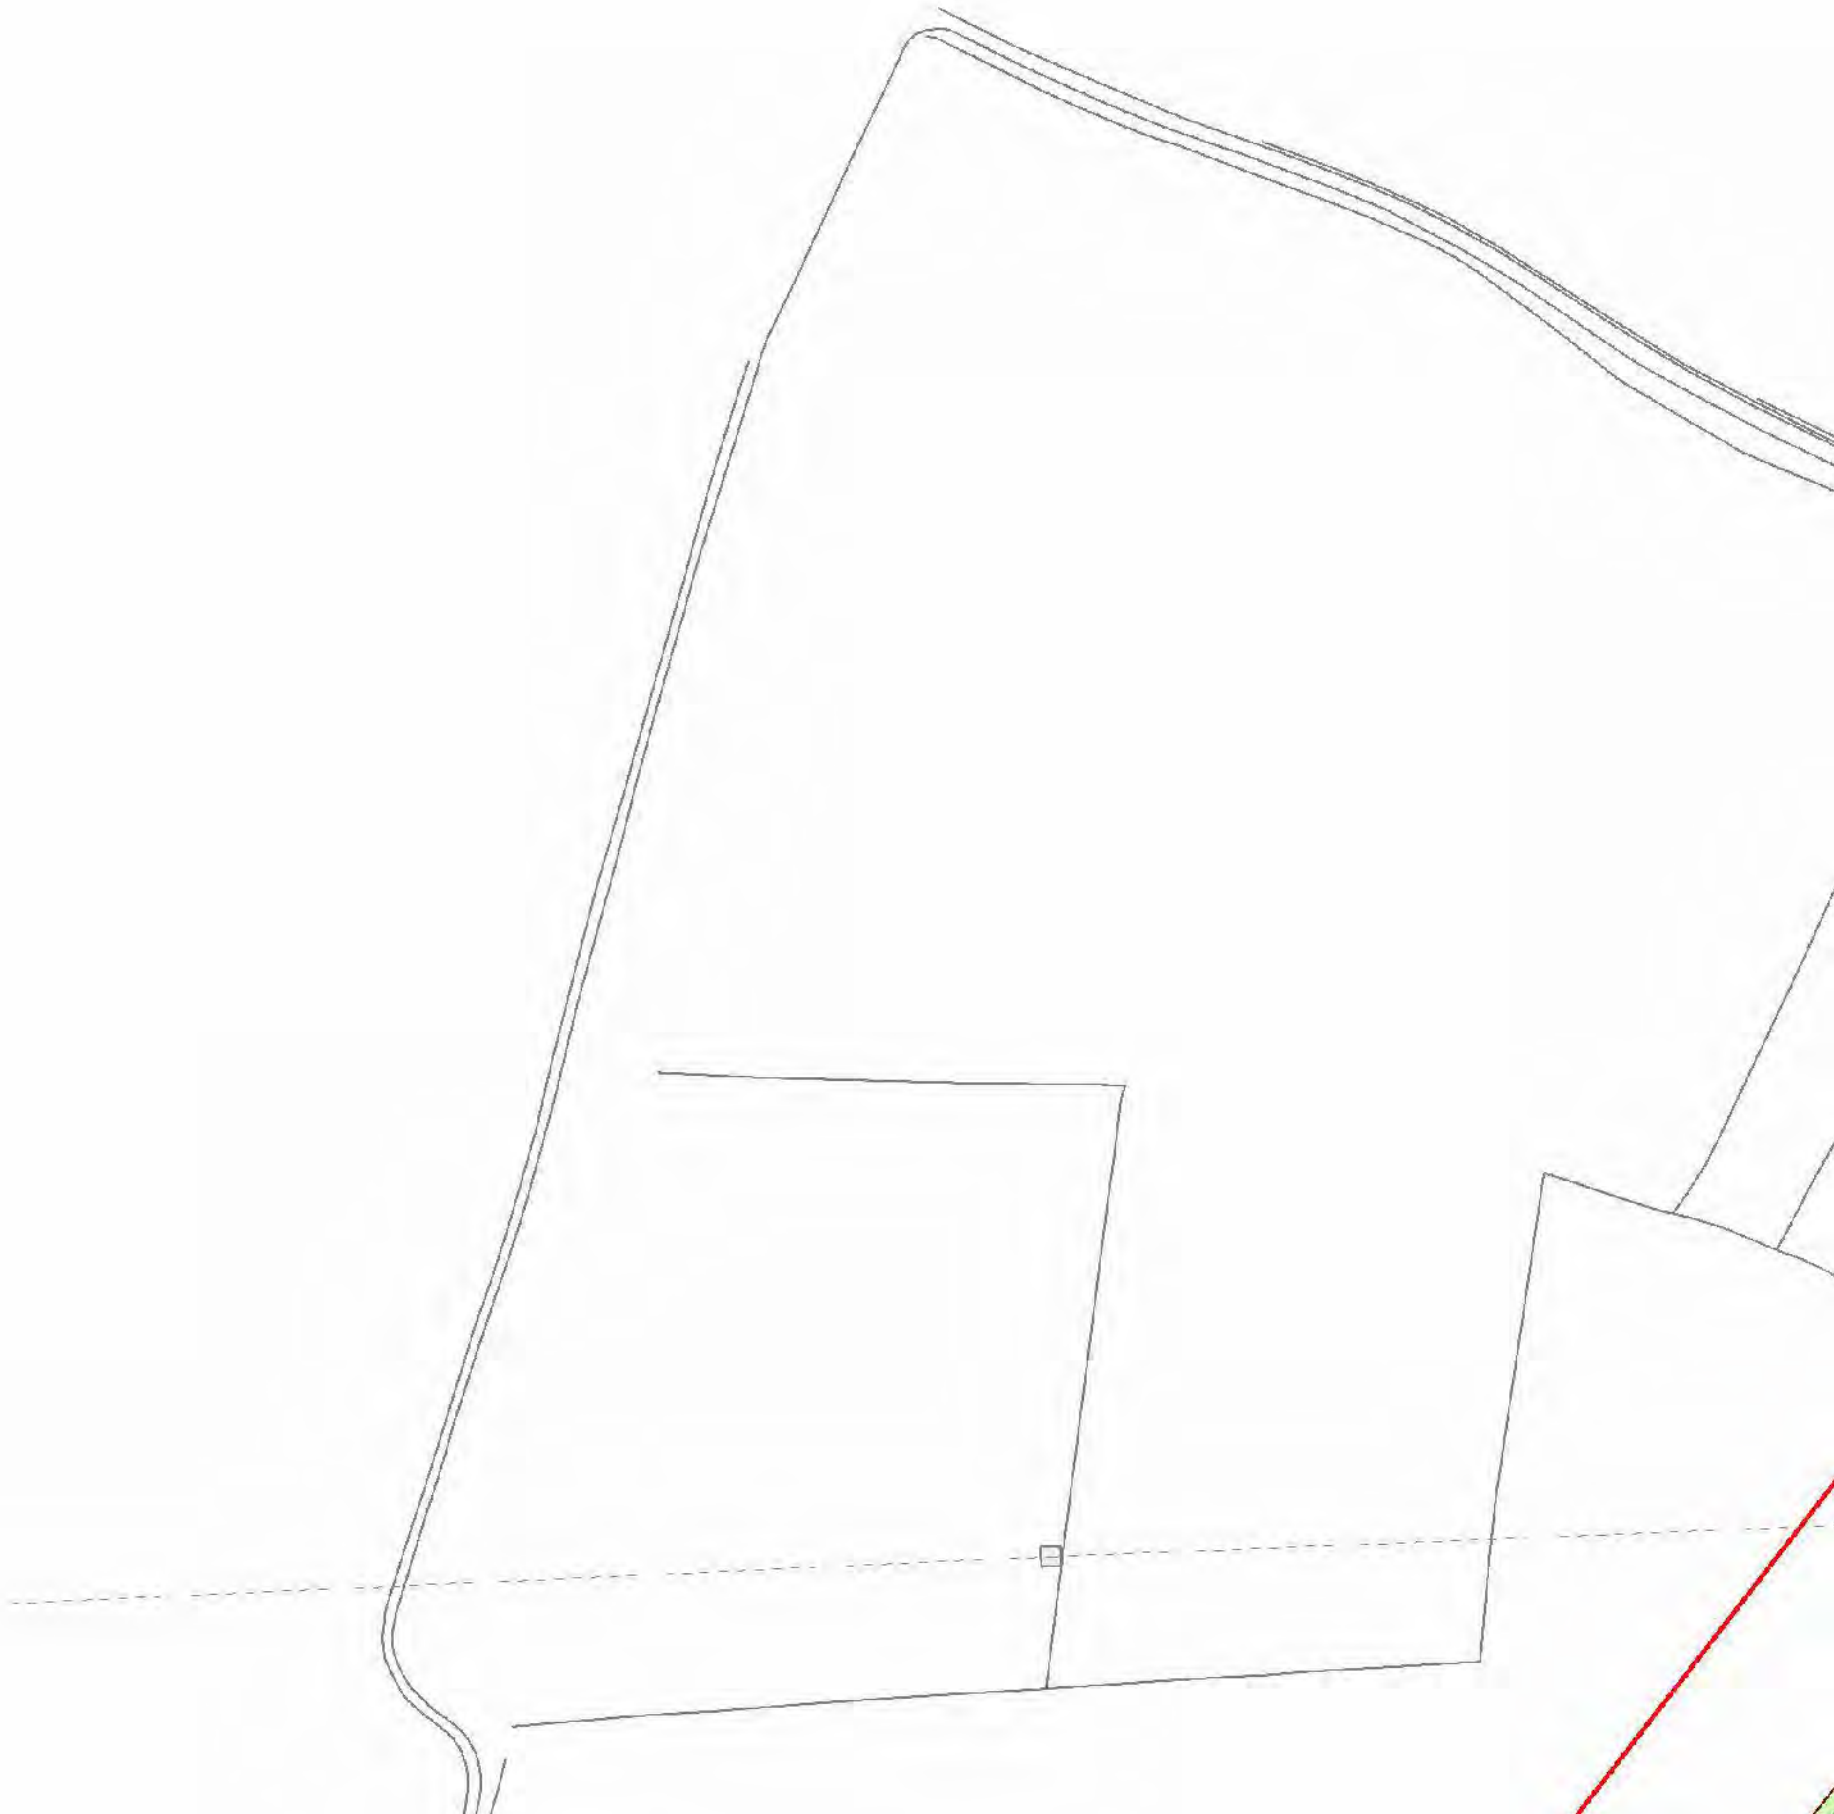

Nearest station:
Gainsborough Lea Road

Order ID: 168506

Order Ref: 168506
Plot Scale: 1:2500
Page Index: 10
Centre X, Y: 477444, 384698
Plot Date: 04/05/23



Crown copyright and database rights 2023
Ordnance Survey 0100040692

User Drawn Polygon / Area of Interest - Order ID : 168506



Legend

- Company Ownership**
- Freehold Ownership
- Leasehold Ownership
- Prohibitive Interest
- Bridge (Rail over Rail)
- Bridge (Rail over River)
- Bridge (Rail over Road)
- Bridge (Road over Rail)
- Level Crossing
- Tunnel
- Order Polygon



Nearest station:
Gainsborough Lea Road

Order ID: 168506

Order Ref: 168506
Plot Scale: 1:2500
Page Index: 11
Centre X, Y: 478238, 382158
Plot Date: 04/05/23



Crown copyright and database rights 2023
Ordnance Survey 0100040692

User Drawn Polygon / Area of Interest - Order ID : 168506


Legend

- Company Ownership**
- Freehold Ownership
 - Leasehold Ownership
 - Prohibitive Interest
 - Bridge (Rail over Rail)
 - Bridge (Rail over River)
 - Bridge (Rail over Road)
 - Bridge (Road over Rail)
 - Level Crossing
 - Tunnel
 - Order Polygon

Nearest station:
Gainsborough Lea Road

Order ID: 168506

Order Ref: 168506
Plot Scale: 1:2500
Page Index: 12
Centre X, Y: 478238, 384063
Plot Date: 04/05/23

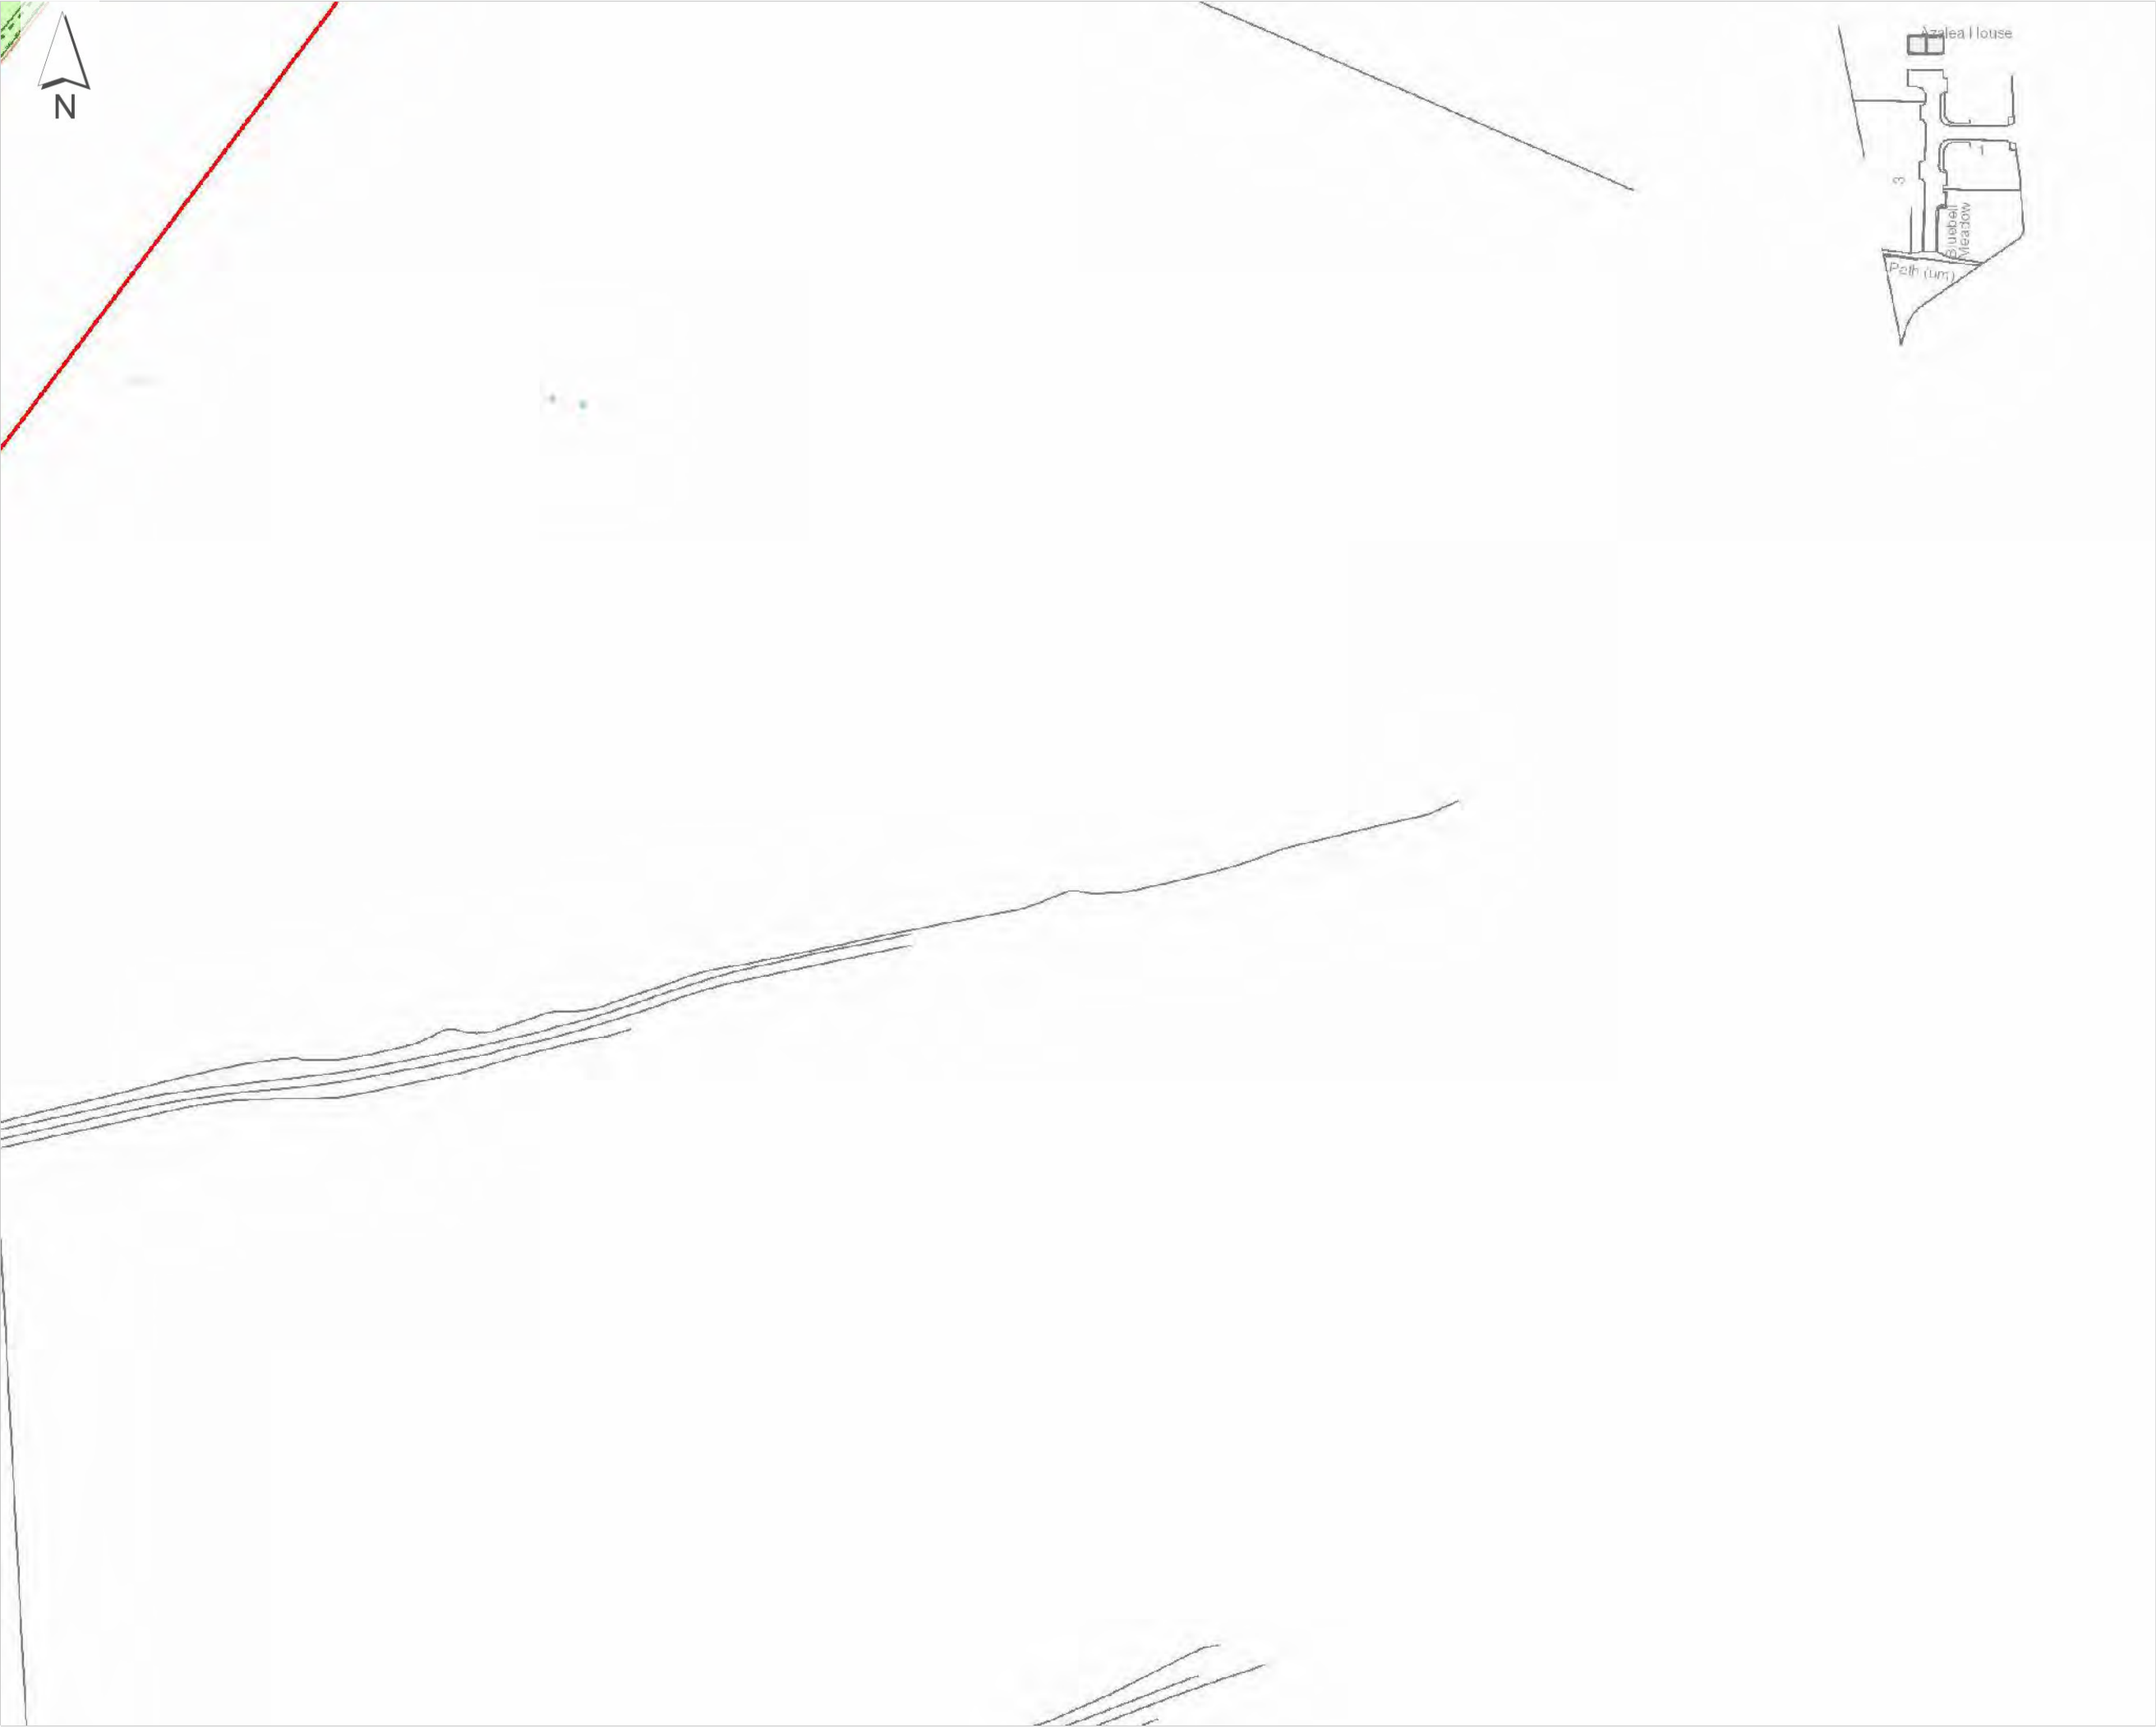

User Drawn Polygon / Area of Interest - Order ID : 168506

Legend

- Company Ownership
 - Freehold Ownership
 - Leasehold Ownership
 - Prohibitive Interest
 - Bridge (Rail over Rail)
 - Bridge (Rail over River)
 - Bridge (Rail over Road)
 - Bridge (Road over Rail)
 - Level Crossing
 - Tunnel
 - Order Polygon



Nearest station:
Gainsborough Lea Road

Order ID: 168506

Order Ref: 168506
Plot Scale: 1:2500
Page Index: 13
Centre X, Y: 478238, 384698
Plot Date: 04/05/23



User Drawn Polygon / Area of Interest - Order ID : 168506



Legend

- Company Ownership**
- Freehold Ownership
- Leasehold Ownership
- Prohibitive Interest
- Bridge (Rail over Rail)
- Bridge (Rail over River)
- Bridge (Rail over Road)
- Bridge (Road over Rail)
- Level Crossing
- Tunnel
- Order Polygon



Nearest station:
Gainsborough Lea Road

Order ID: 168506

Order Ref: 168506
Plot Scale: 1:2500
Page Index: 14
Centre X, Y: 478238, 385333
Plot Date: 04/05/23



Crown copyright and database rights 2023
Ordnance Survey 0100040692

User Drawn Polygon / Area of Interest - Order ID : 168506

Legend

- Company Ownership
 - Freehold Ownership
 - Leasehold Ownership
 - Prohibitive Interest
 - Bridge (Rail over Rail)
 - Bridge (Rail over River)
 - Bridge (Rail over Road)
 - Bridge (Road over Rail)
 - Level Crossing
 - Tunnel
 - Order Polygon



Nearest station:
Gainsborough Lea Road

Order ID: 168506

Order Ref: 168506
Plot Scale: 1:2500
Page Index: 15
Centre X, Y: 479031, 385333
Plot Date: 04/05/23



User Drawn Polygon / Area of Interest - Order ID : 168506



Legend

- Company Ownership
 - Freehold Ownership
 - Leasehold Ownership
 - Prohibitive Interest
 - Bridge (Rail over Rail)
 - Bridge (Rail over River)
 - Bridge (Rail over Road)
 - Bridge (Road over Rail)
 - Level Crossing
 - Tunnel
 - Order Polygon



Nearest station:
Gainsborough Lea Road


Order ID: 168506

Order Ref: 168506
Plot Scale: 1:2500
Page Index: 16
Centre X, Y: 479031, 385968
Plot Date: 04/05/23





Crown copyright and database rights 2023
Ordnance Survey 0100040692

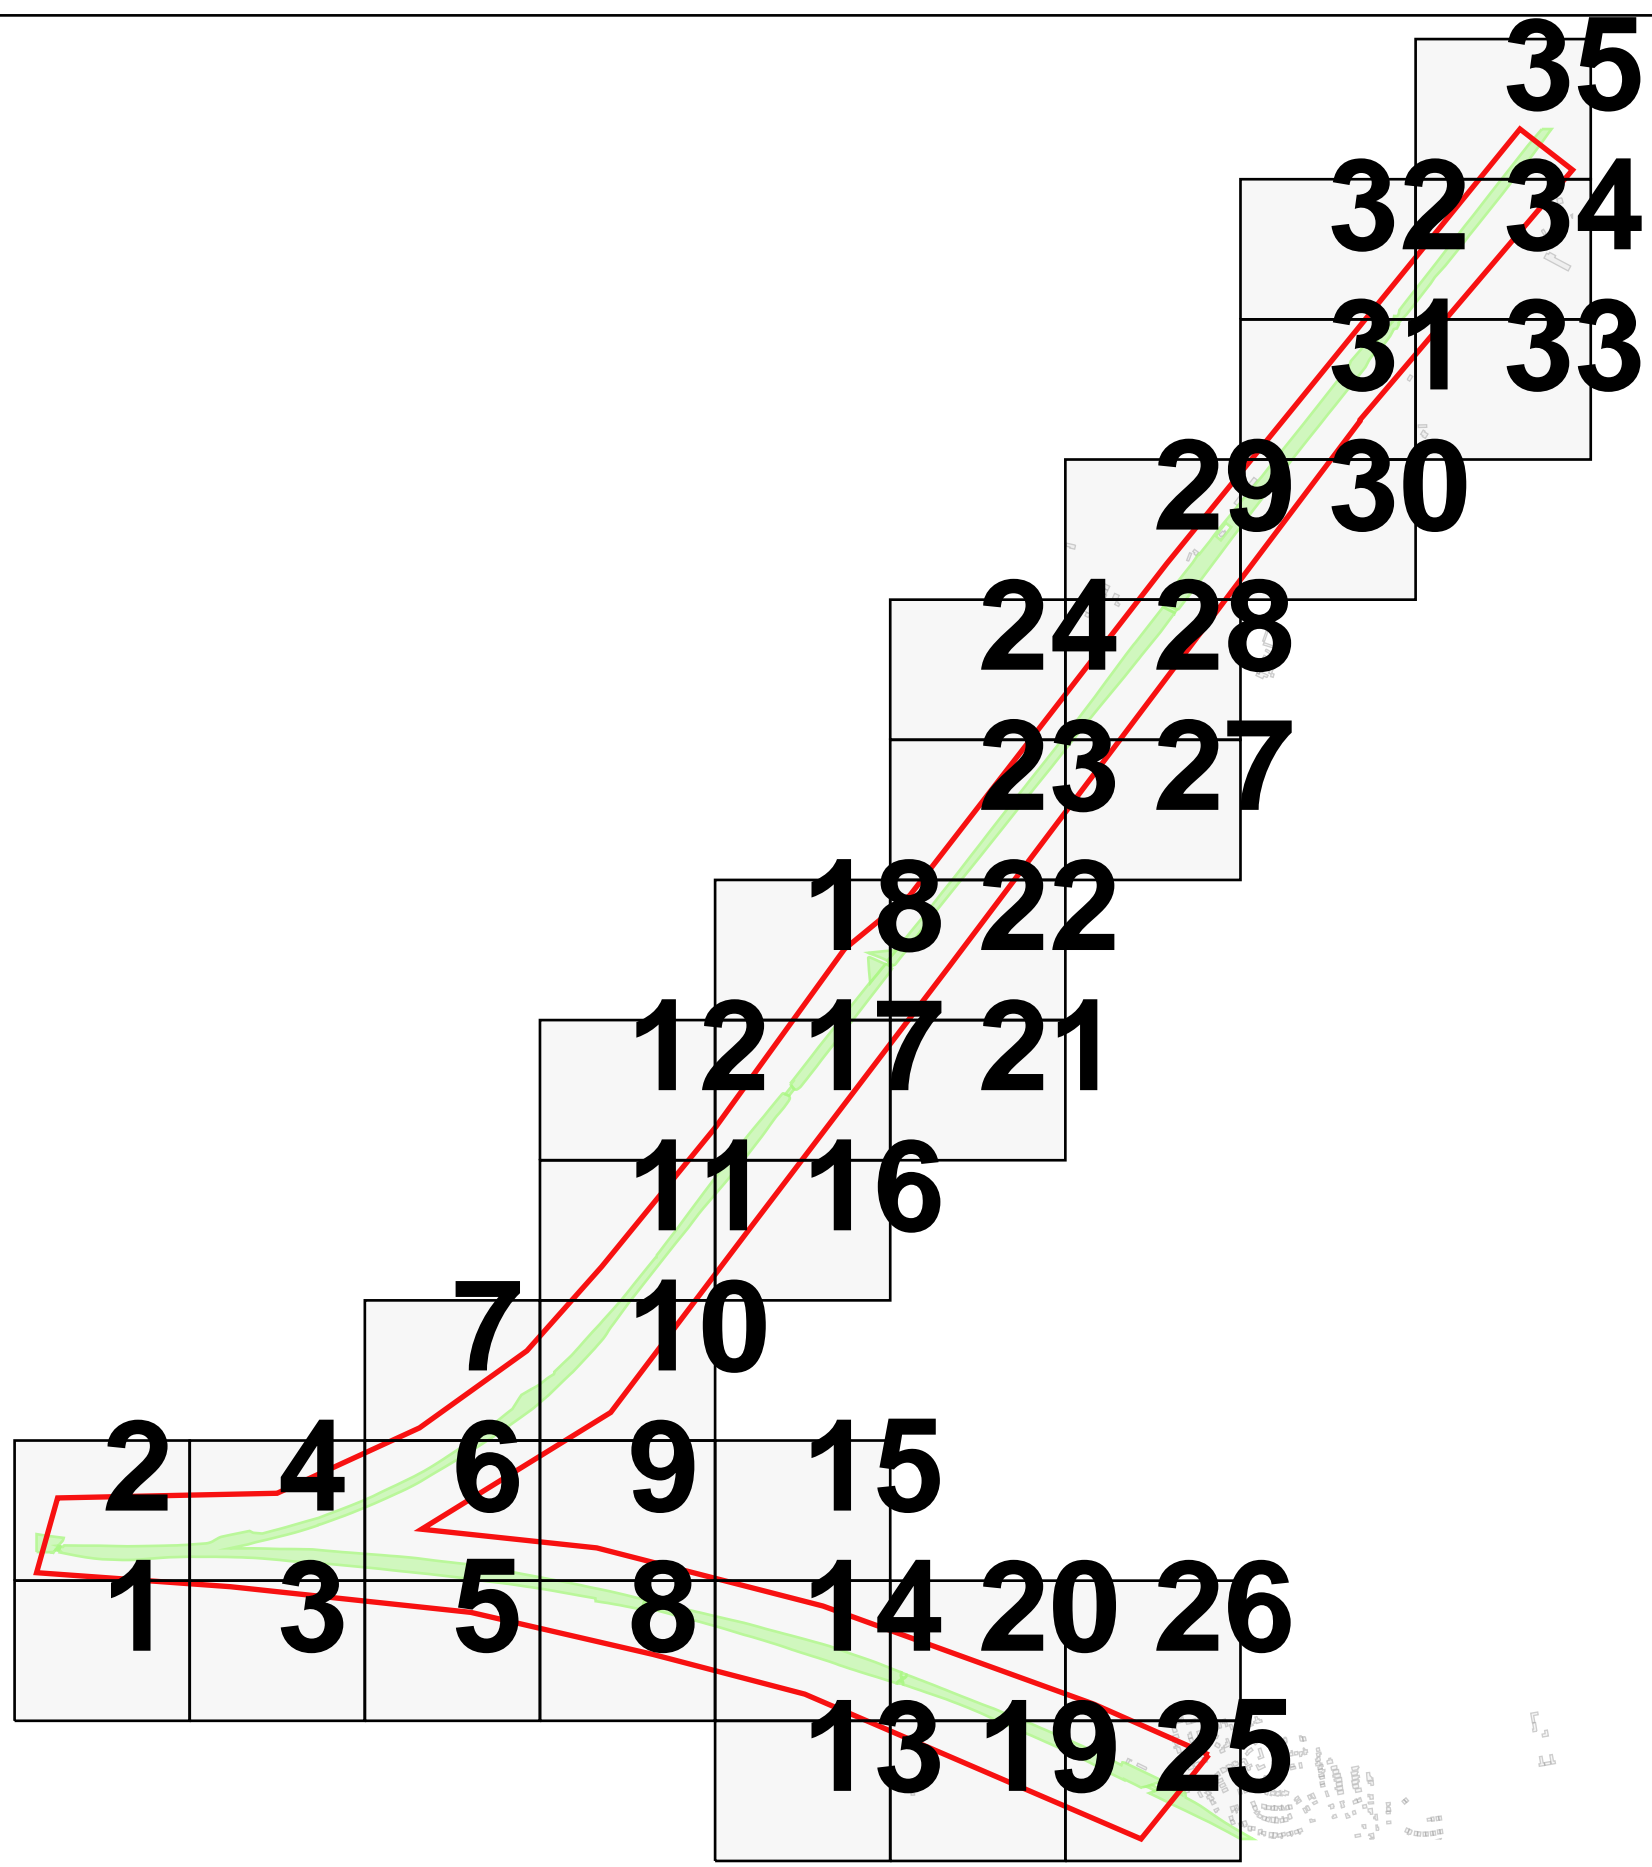Page Navigation Index Map (1:1250 scale maps)




Legend

-  Network Rail Company Ownership Boundary
-  Order Polygon

Order ID: 168506


Plot Date: 04/05/23



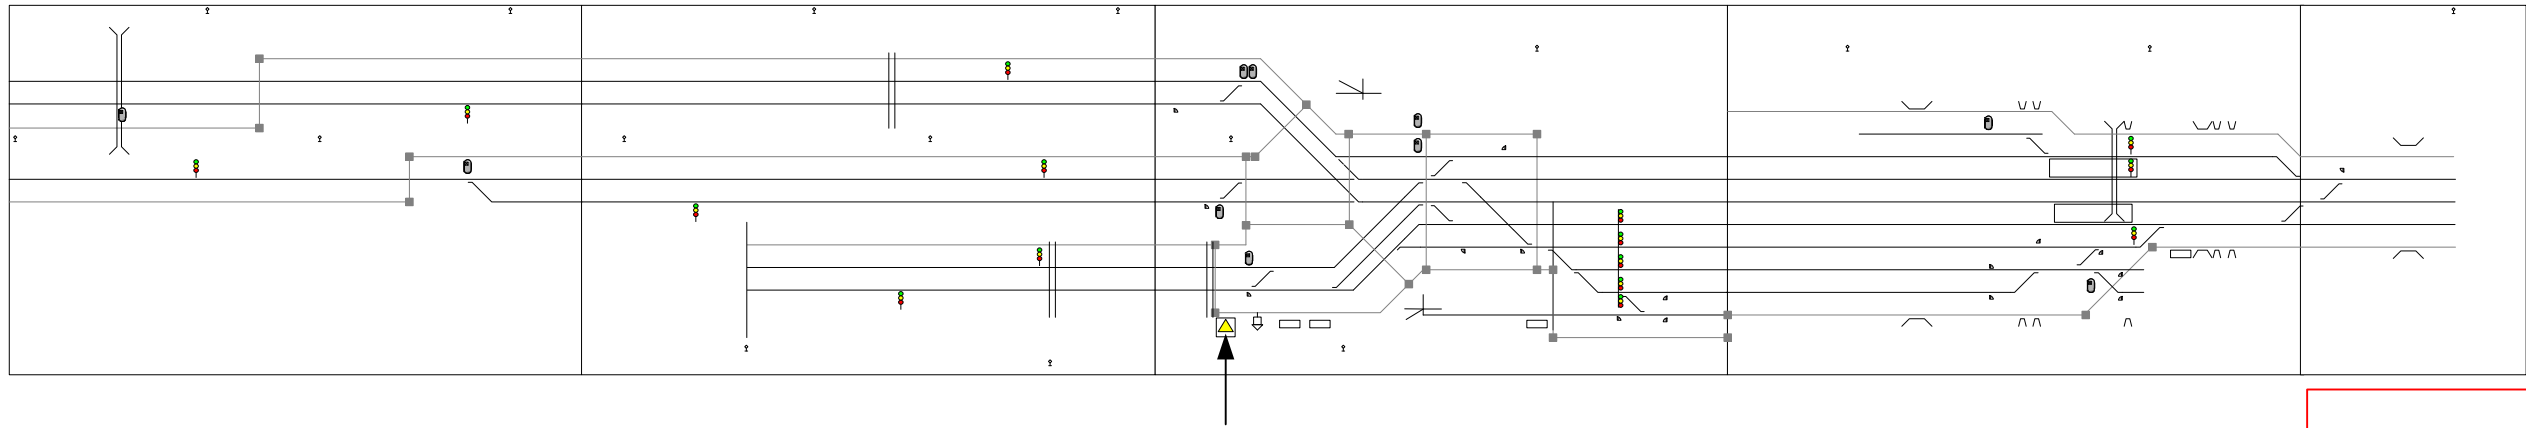

AS BUILT


Network Rail

 


AS BUILT






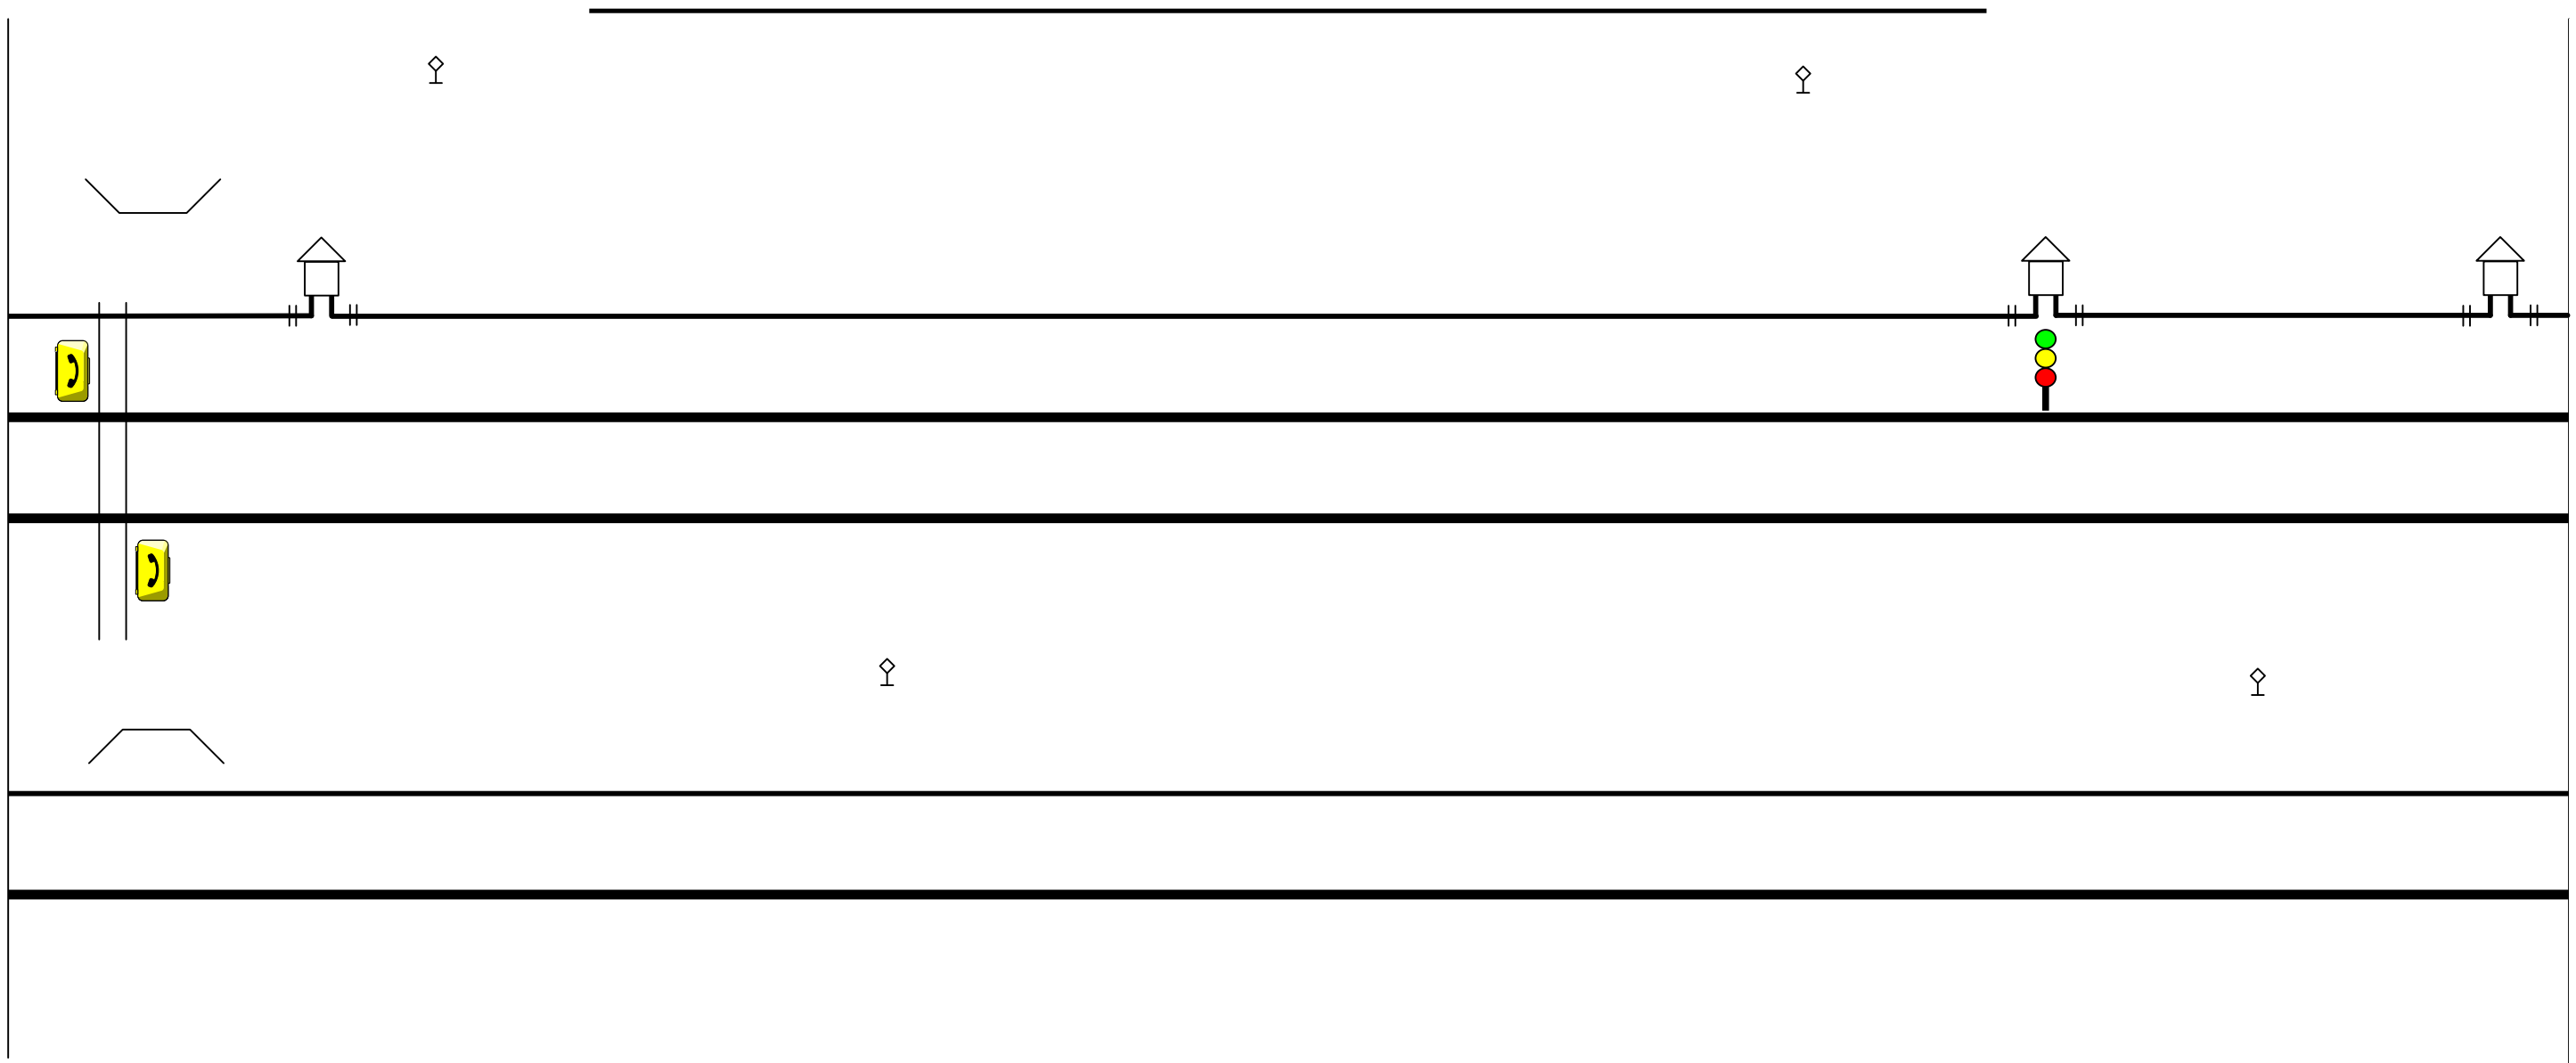


AS BUILT

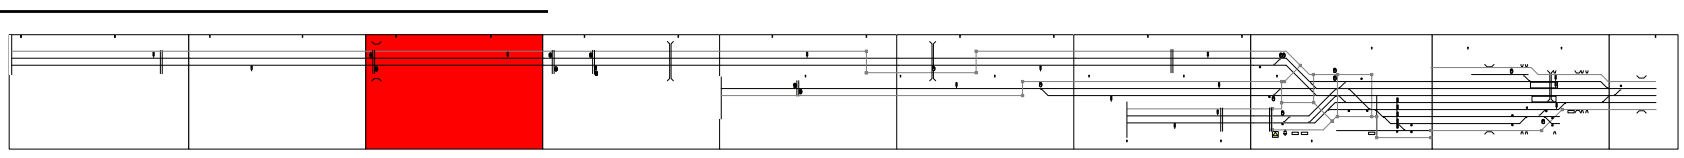


Network Rail

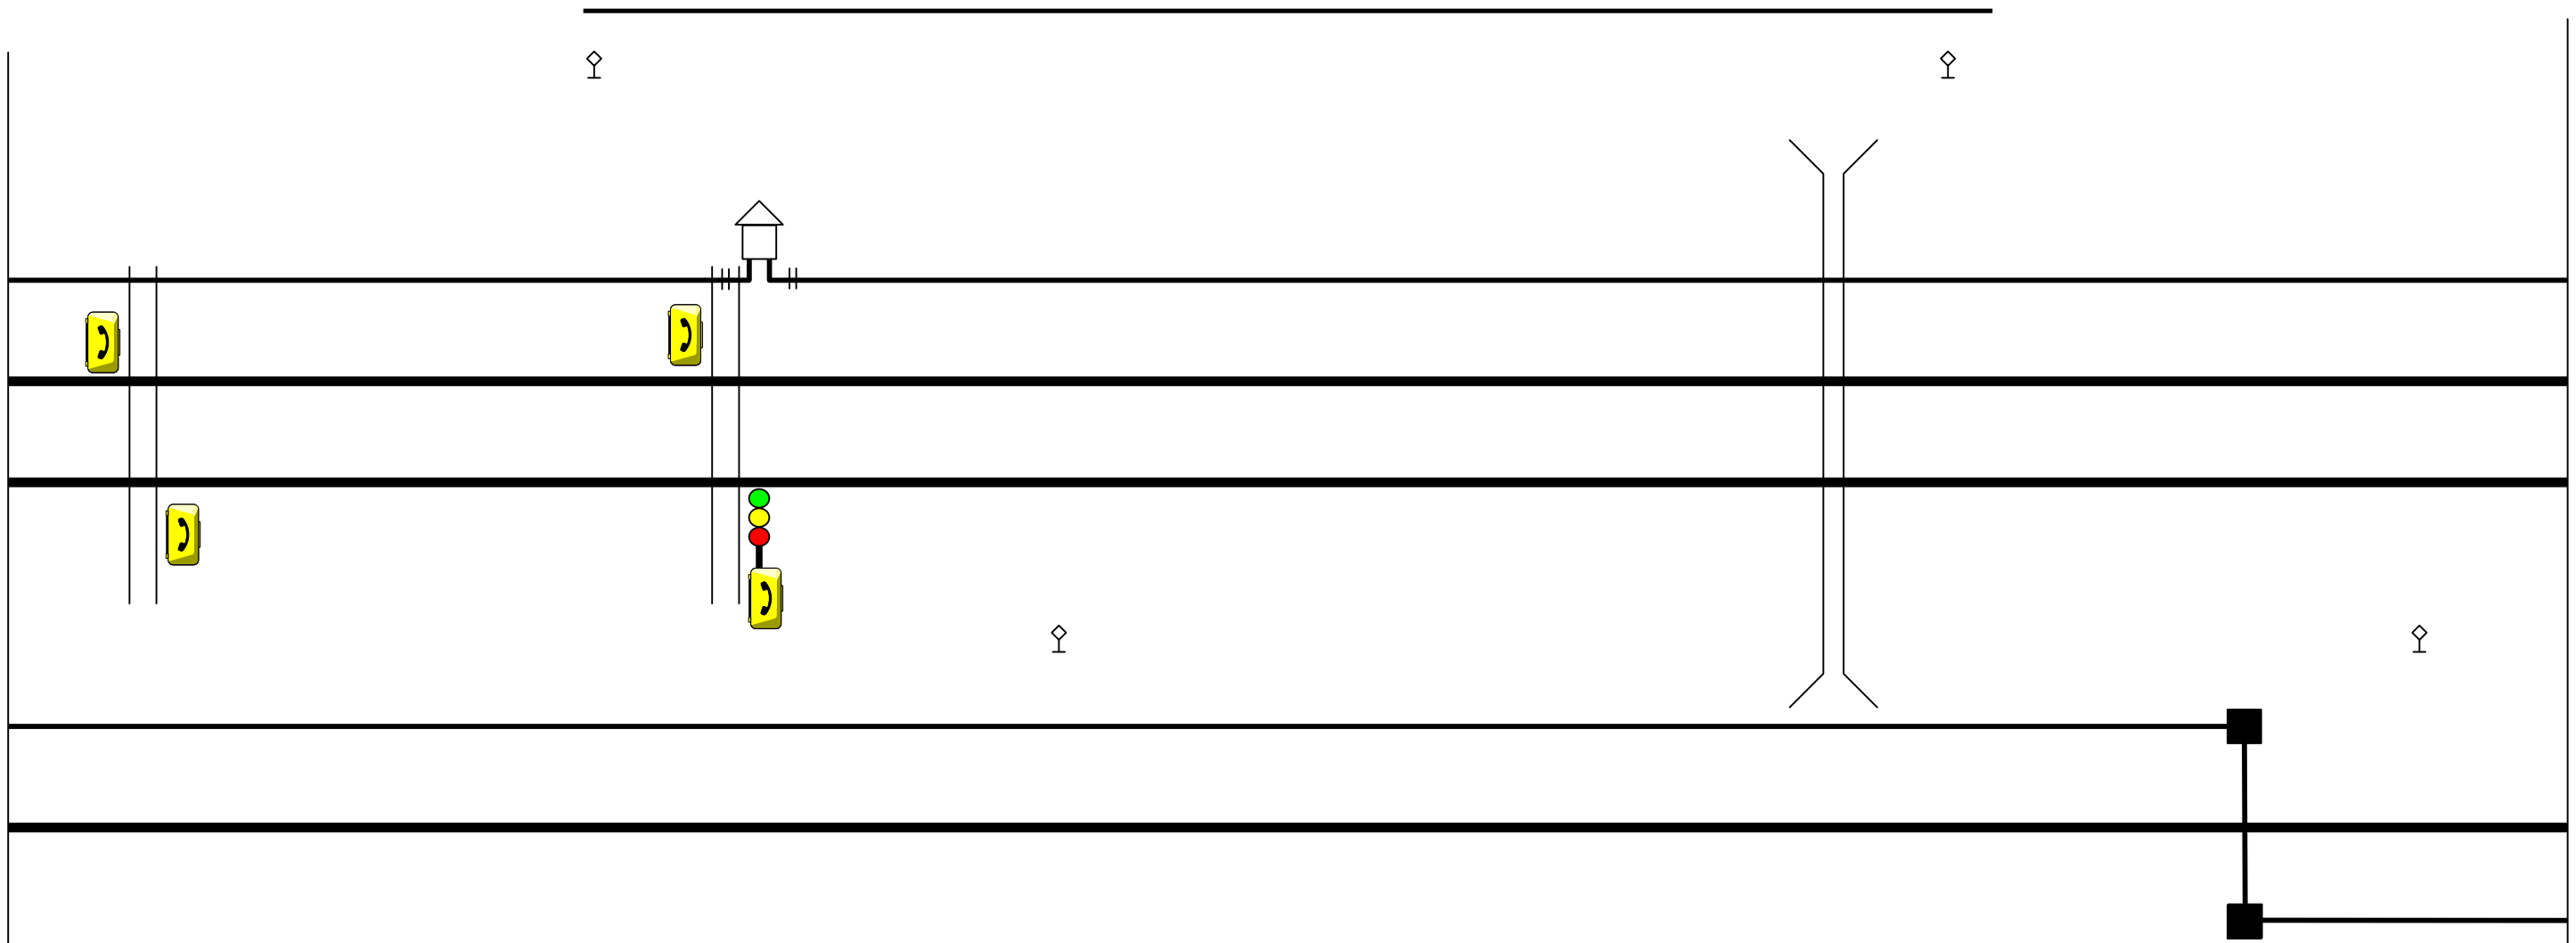


AS BUILT

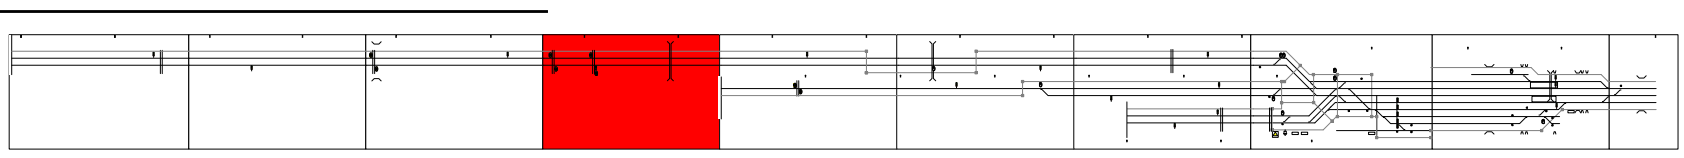




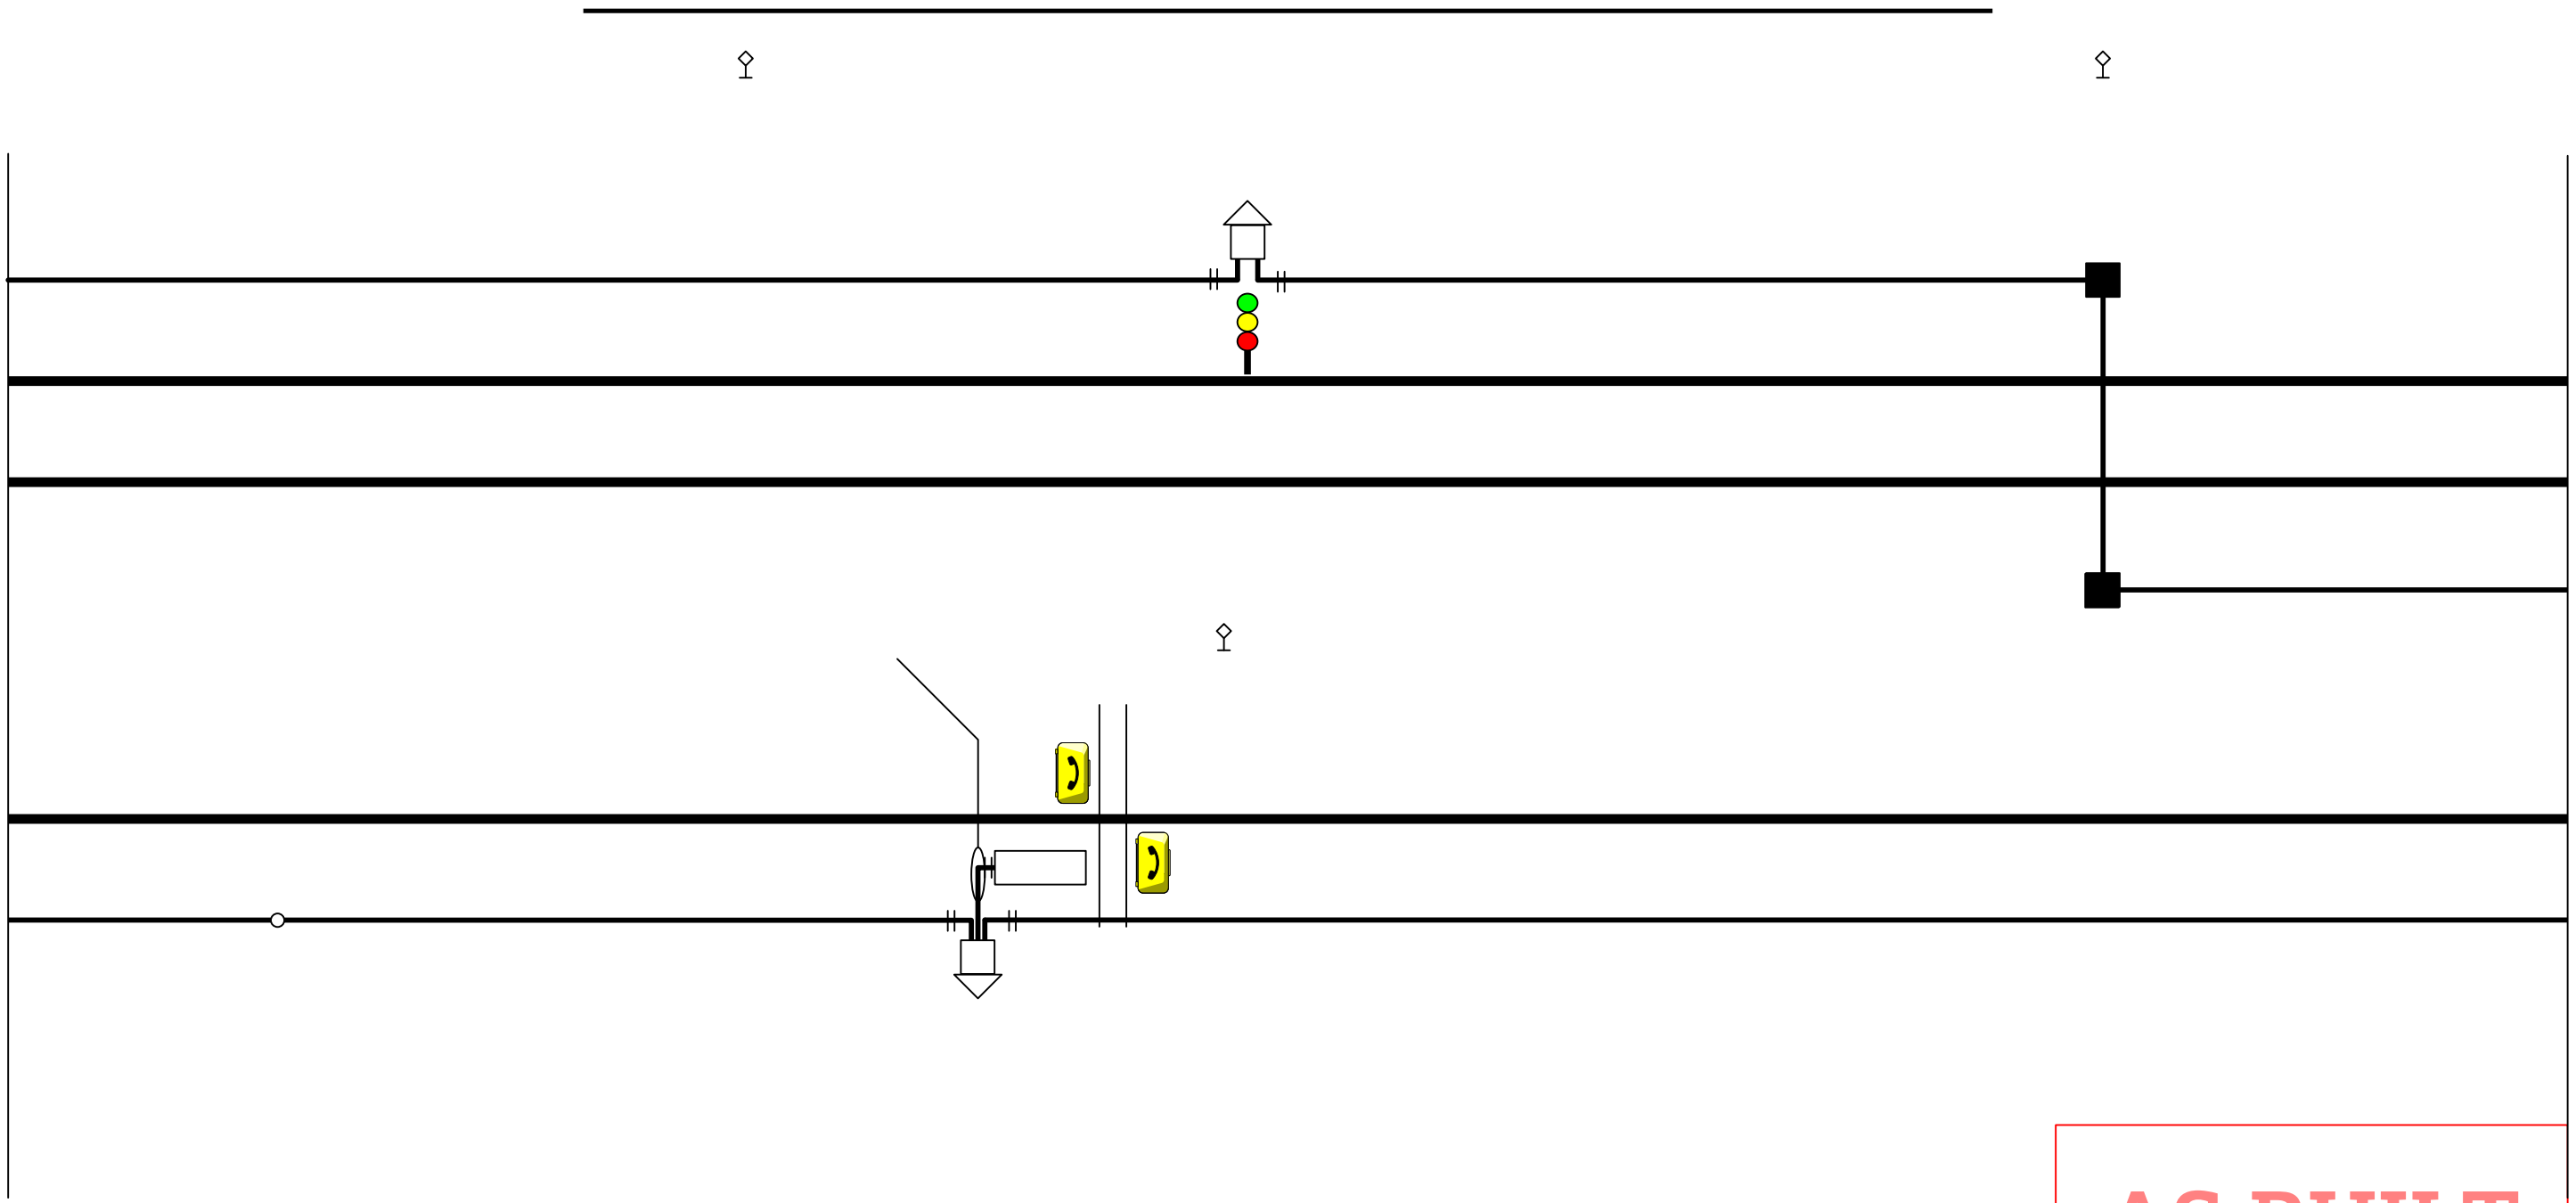


AS BUILT

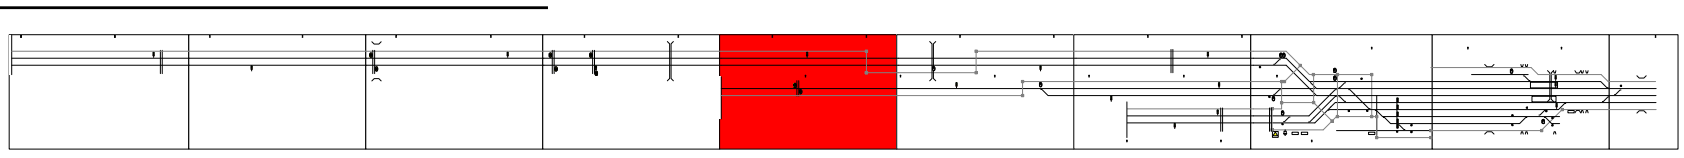




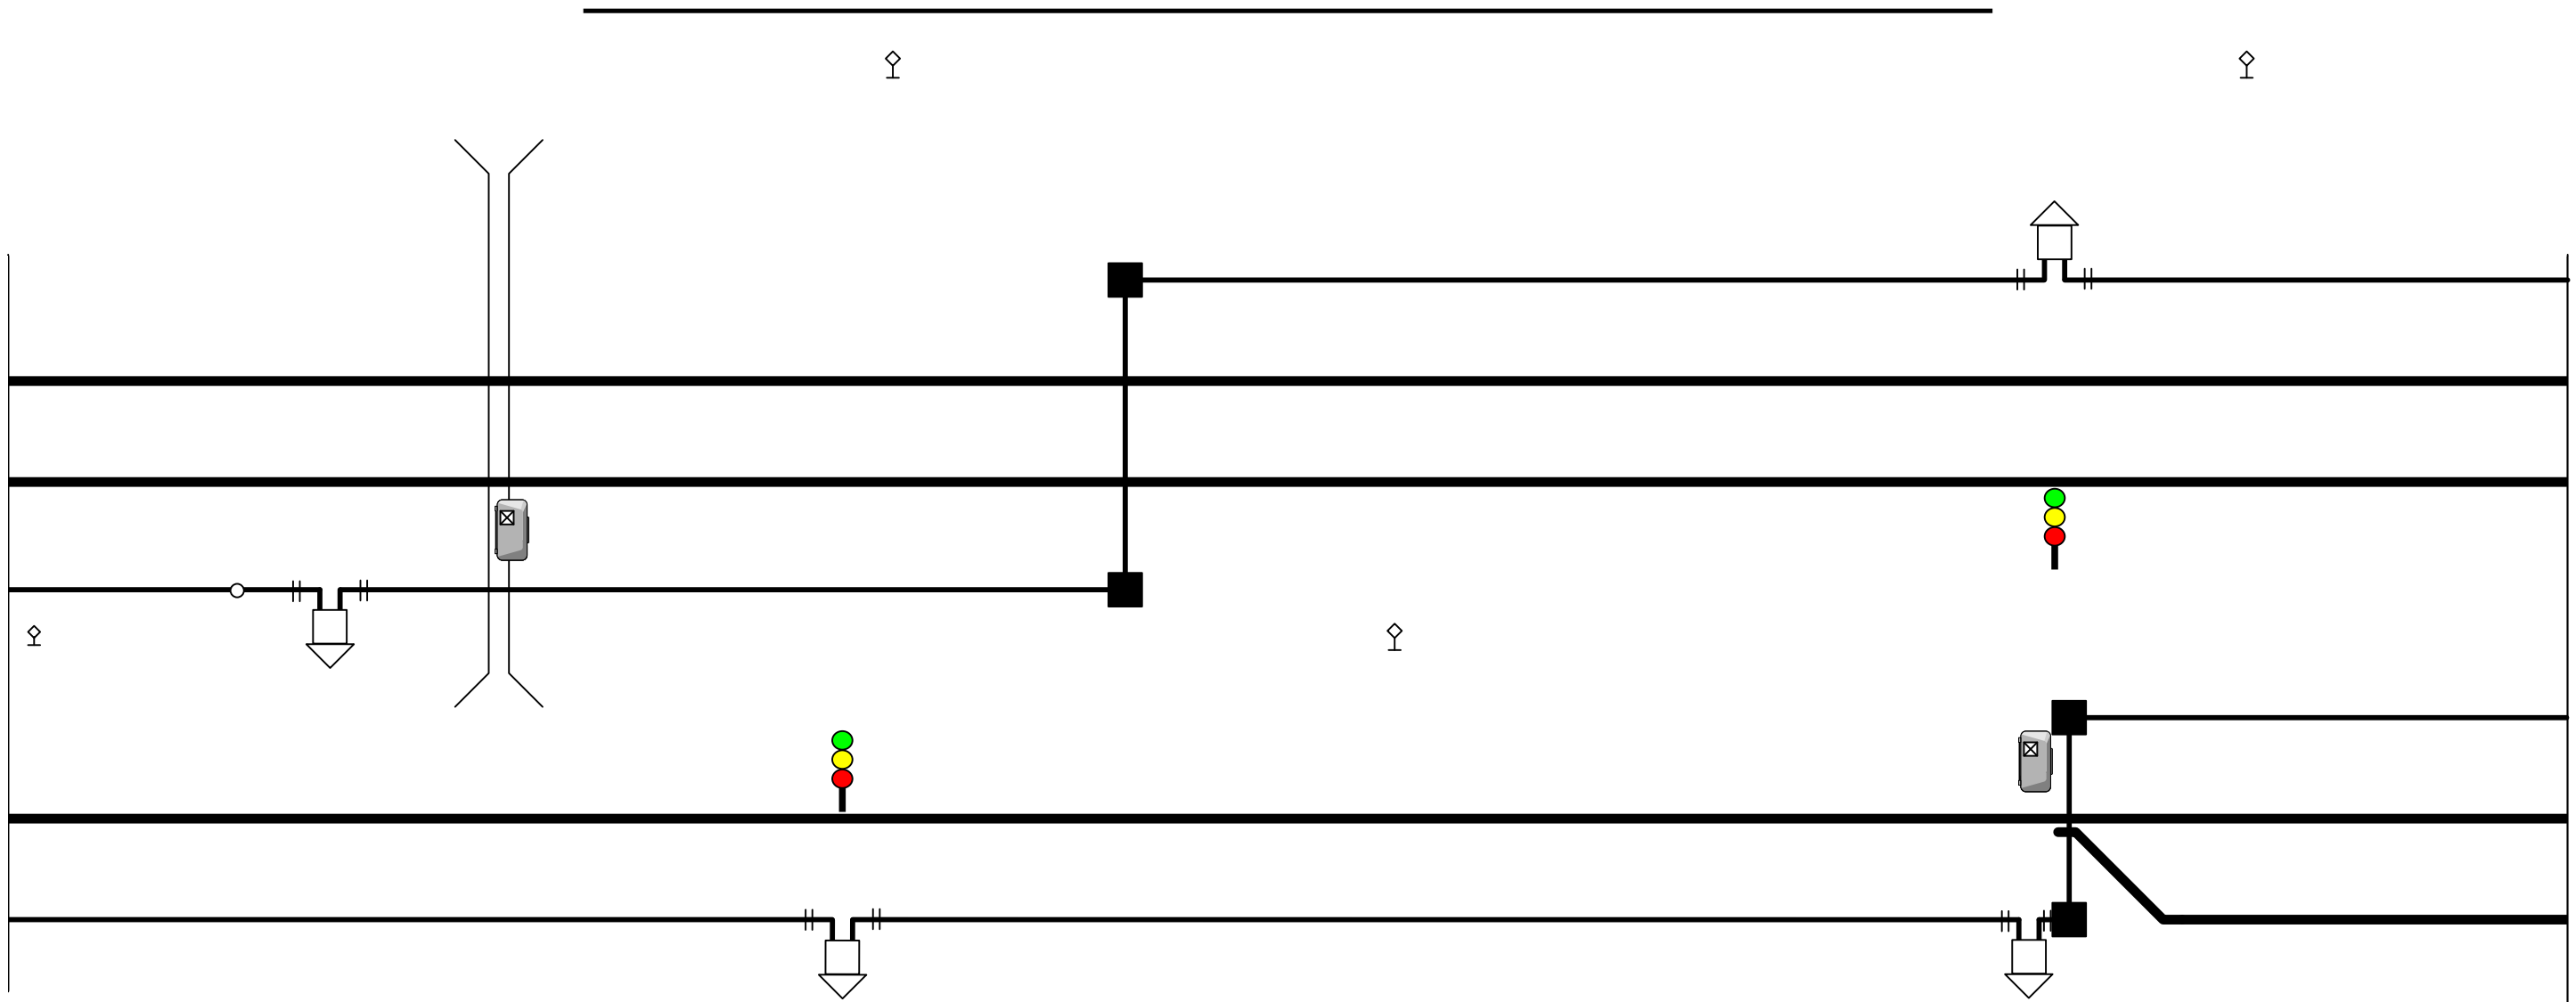


AS BUILT

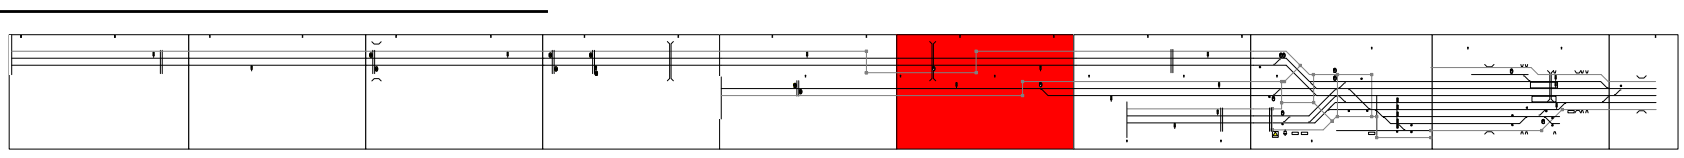




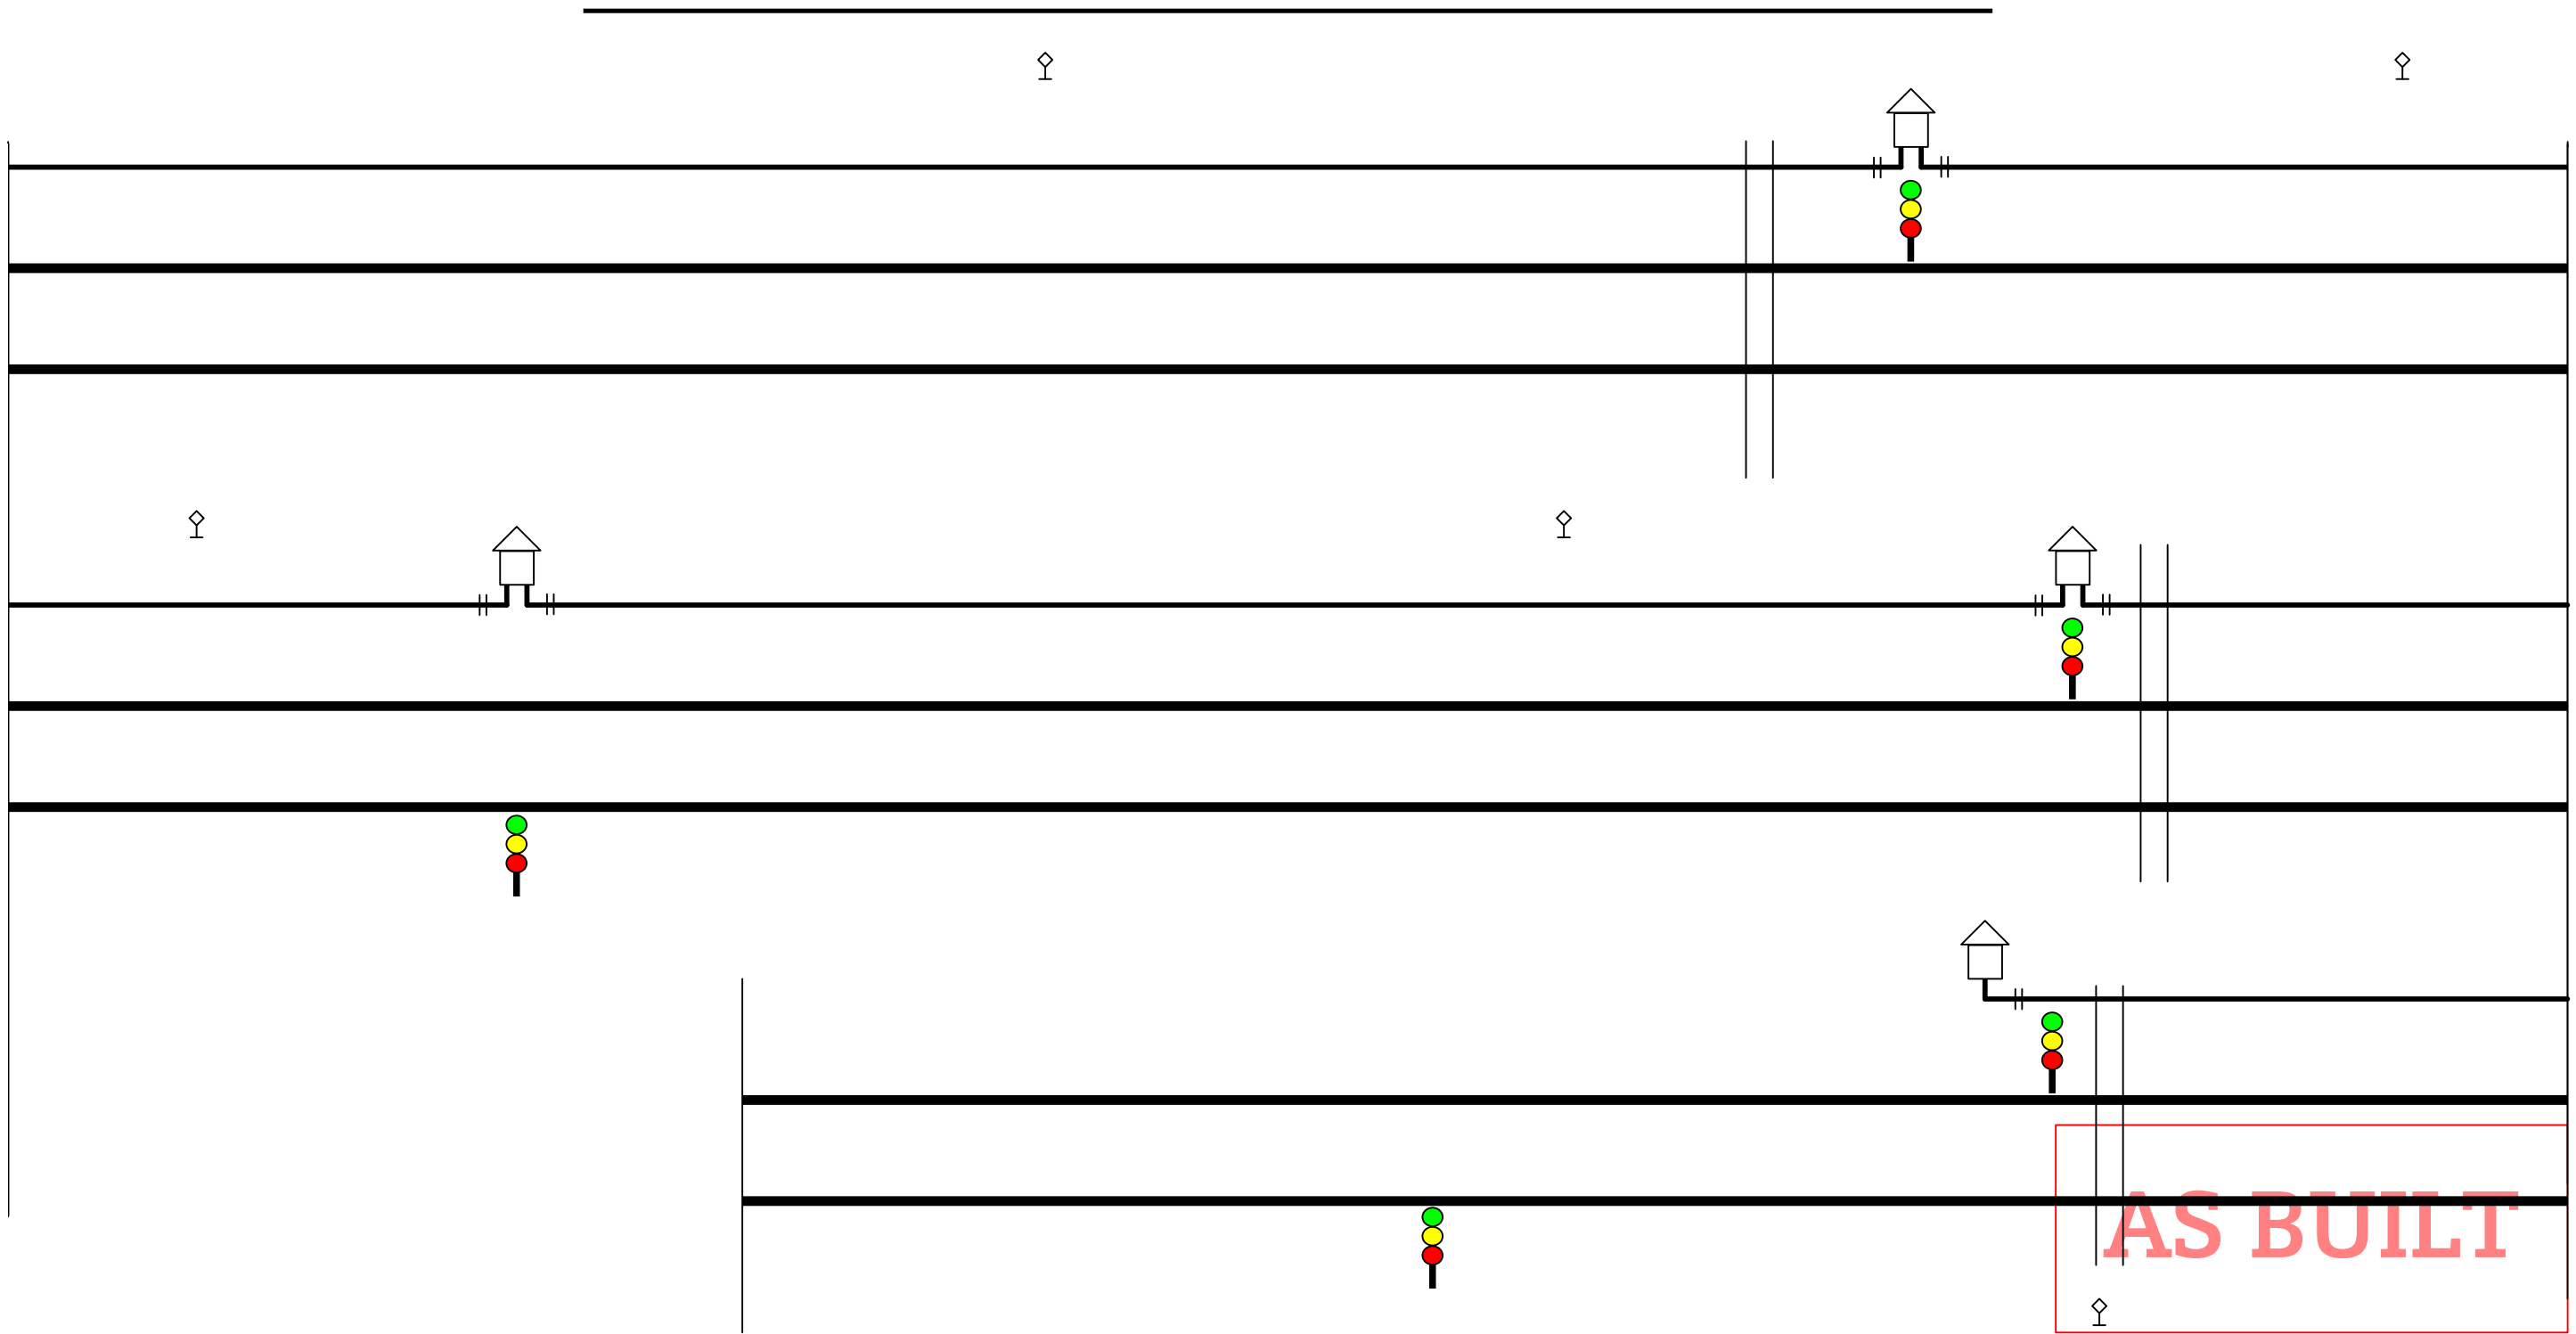

AS BUILT

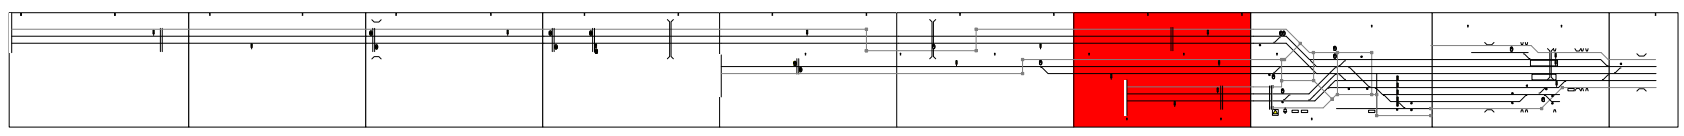




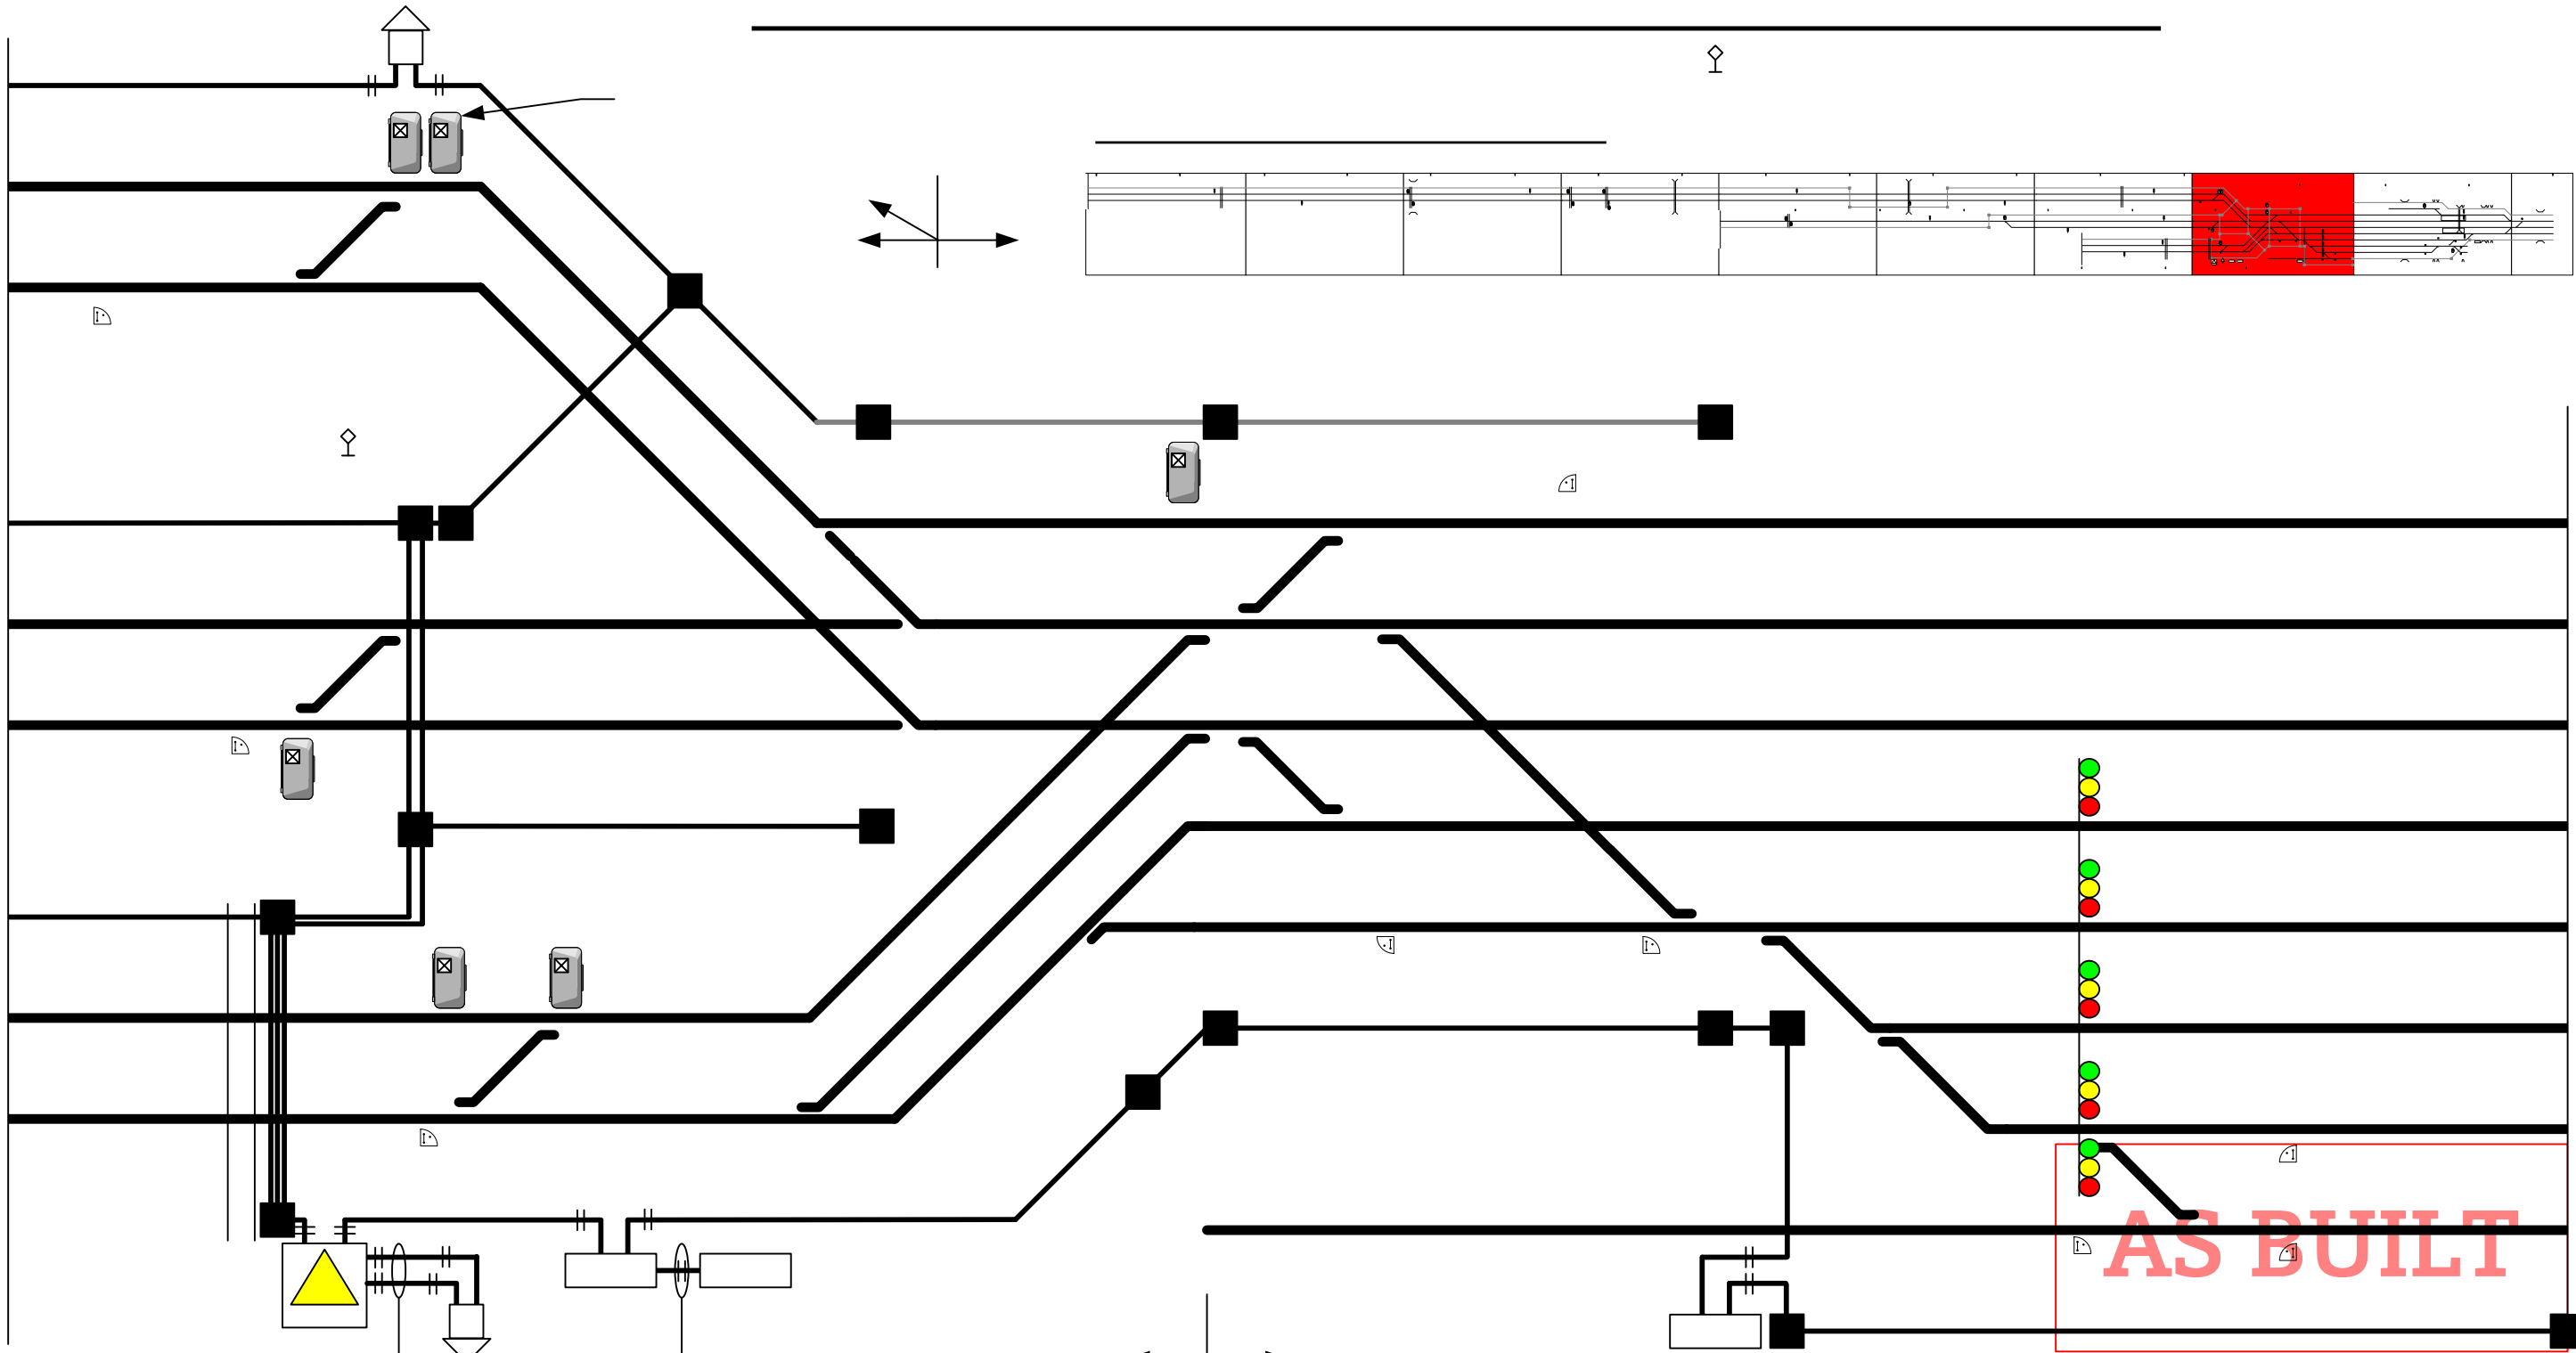


AS BUILT




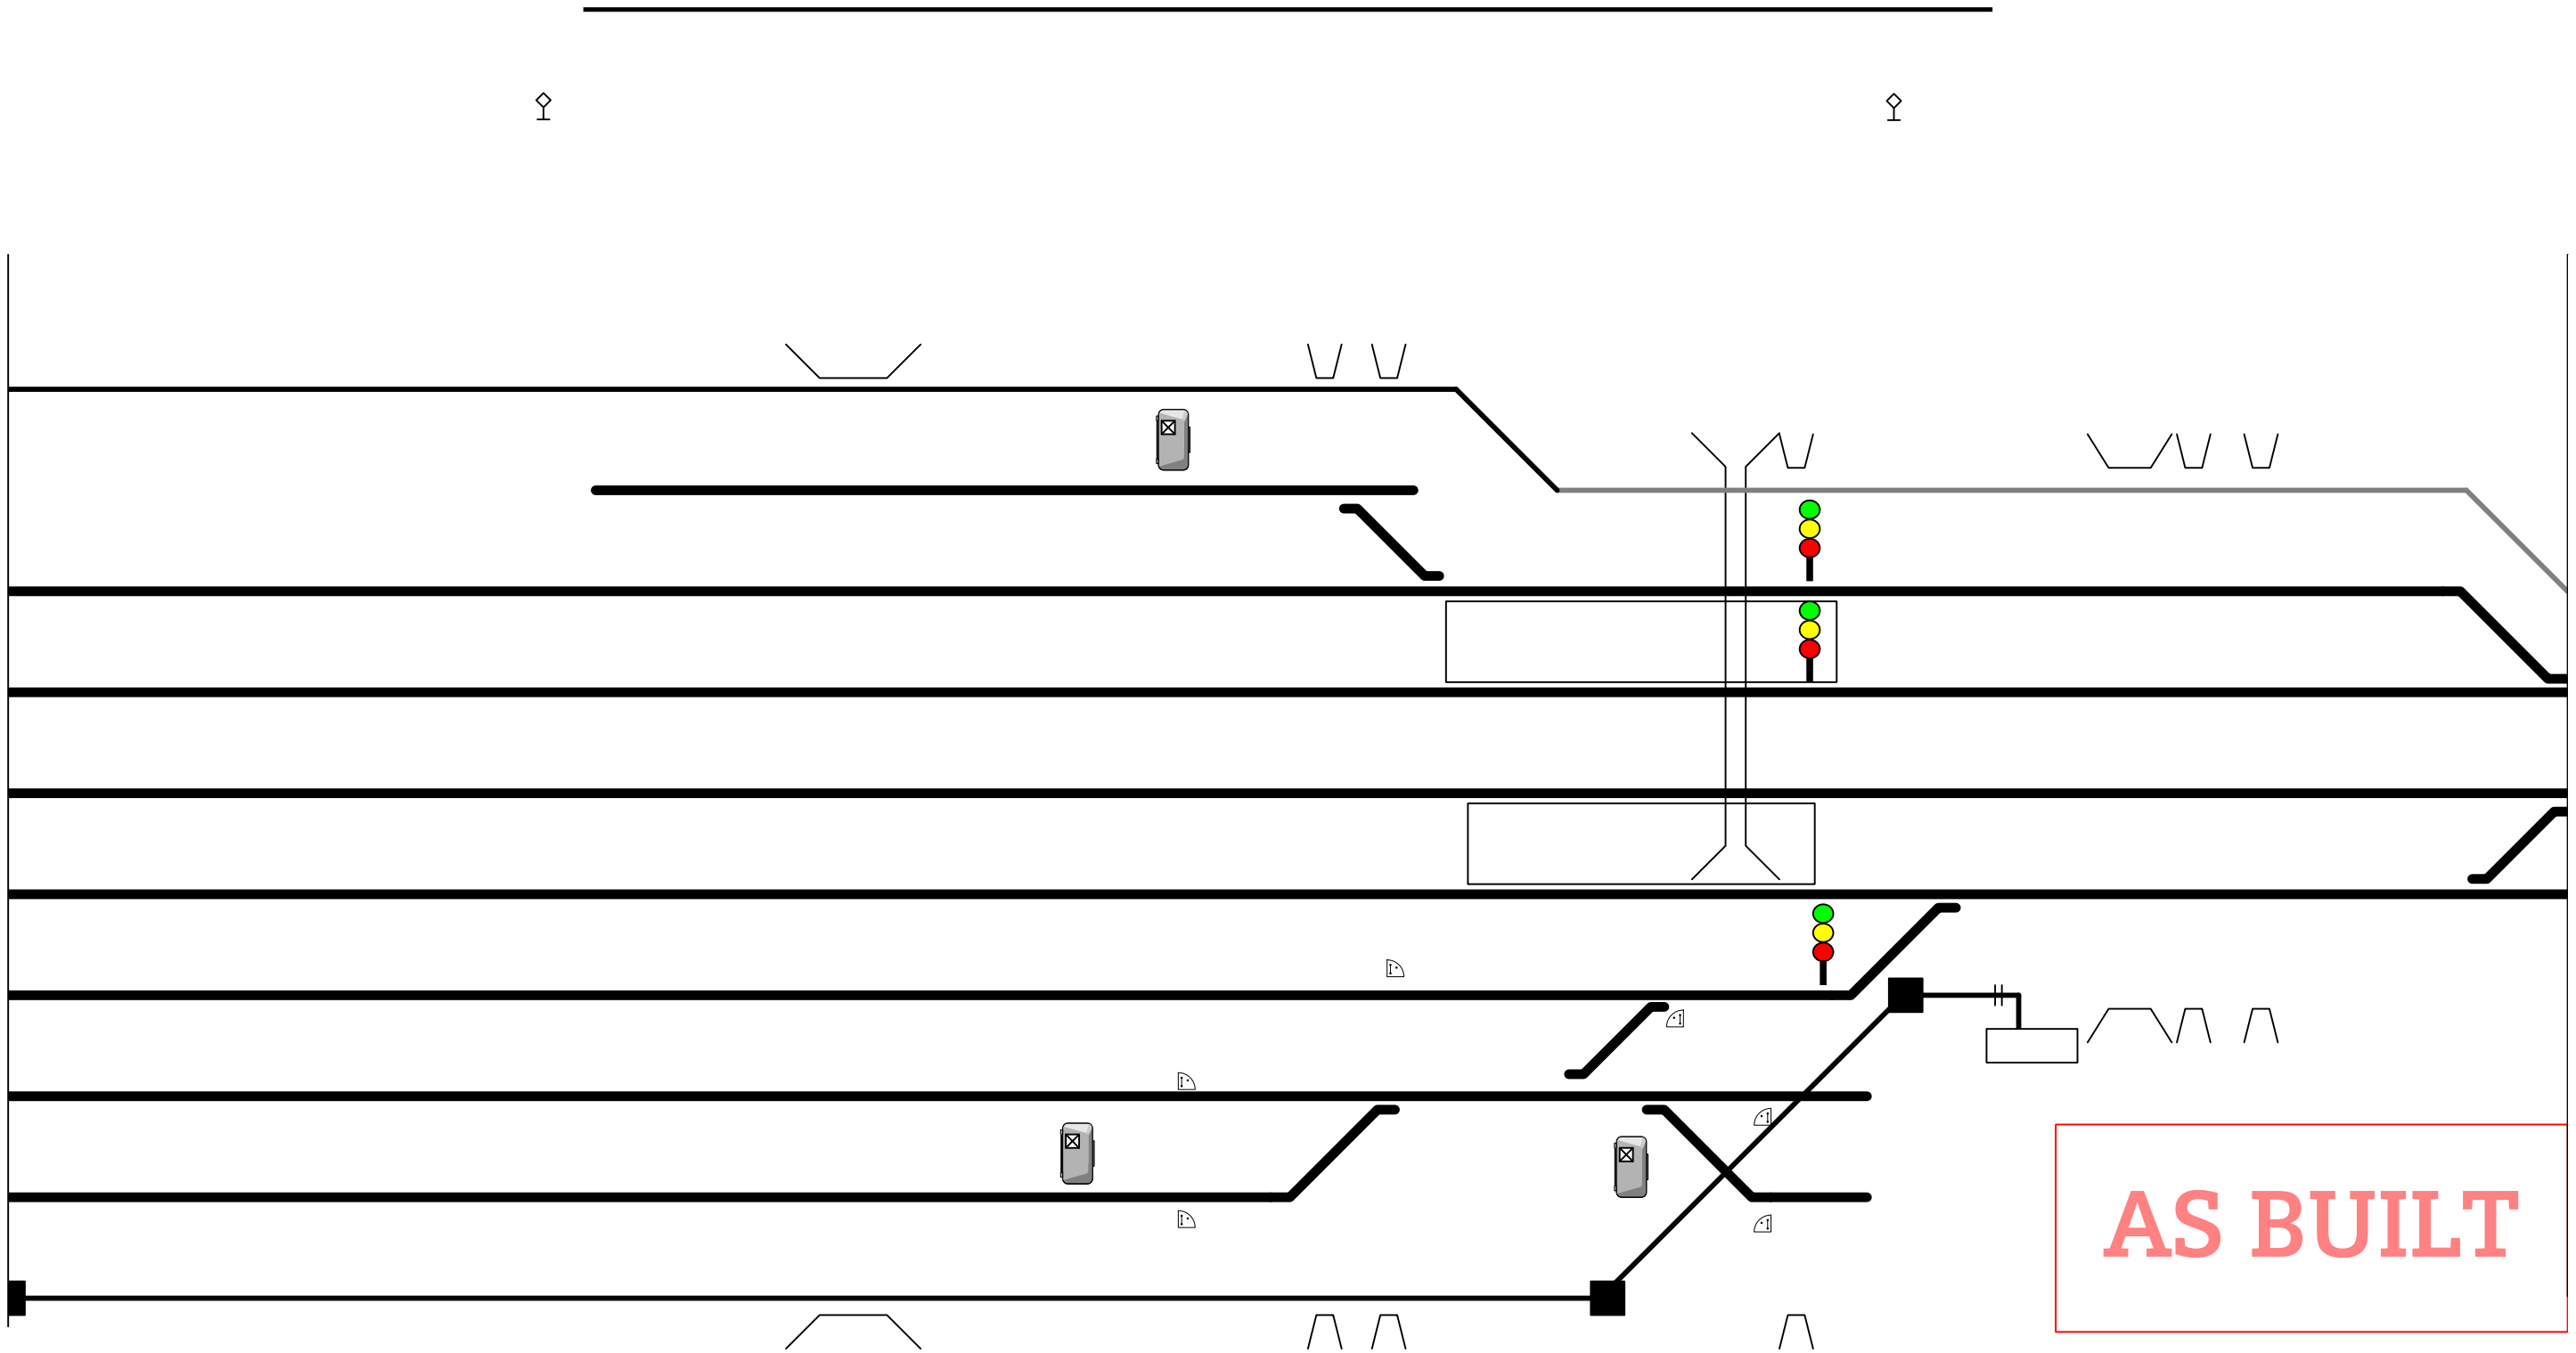


AS BUILT

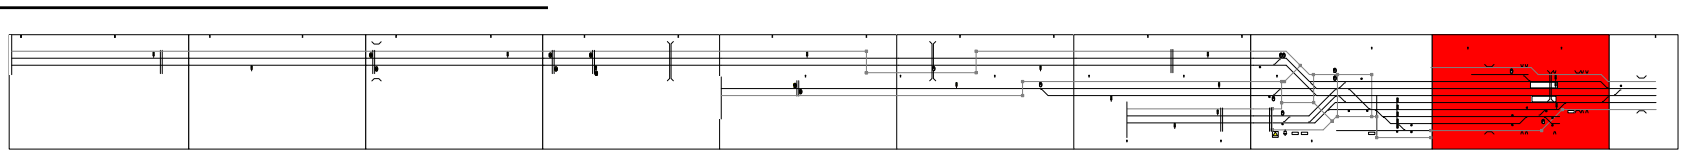




 

AS BUILT

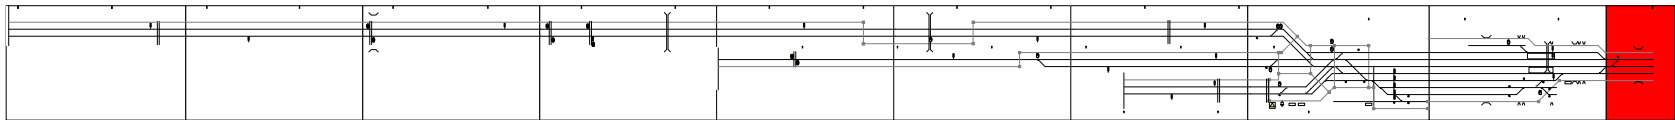



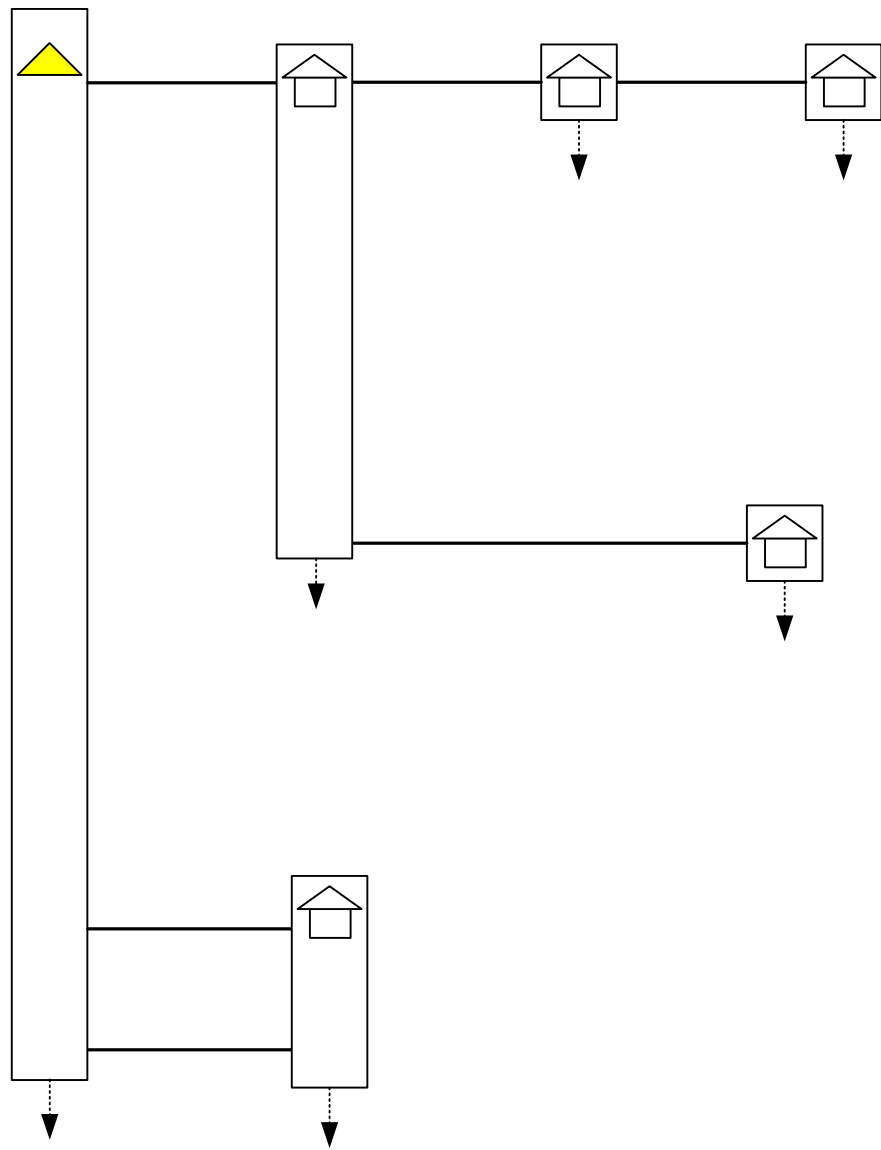

AS BUILT



Network Rail - Drainage

Legend

- Company Ownership**
 - Freehold Ownership
 - Leasehold Ownership
 - Prohibitive Interest
 - Bridge (Rail over Rail)
 - Bridge (Rail over River)
 - Bridge (Rail over Road)
 - Bridge (Road over Rail)
 - Level Crossing
 - Level Crossing
 - Tunnel
 - Order Polygon
- DB Asset Line
- DC Asset Line
- Chamber (DD)
- Outfall (DK)
- Inflow (DL)
- Point (DM)
- Soakaway (DN)
- Pond (DY)
- Structure (DZ)
- Channel (ELR, Mileage)
- Channel (Coordinates)
- Covered Channel (ELR, Mileage)
- Covered Channel (Coordinates)
- Culvert (ELR, Mileage)
- Culvert (Coordinates)
- Granular Drain (ELR, Mileage)
- Granular Drain (Coordinates)
- Pipe (ELR and Mileage)
- Pipe (Coordinates)
- Syphon (ELR, Mileage)
- Syphon (Coordinates)


Order Ref: 168506
Plot Scale: 1:1250
Page Index: 1
Centre X, Y: 475658, 382317
Plot Date: 04/05/23



Network Rail - Drainage

Legend

- Company Ownership**
- Freehold Ownership
 - Leasehold Ownership
 - Prohibitive Interest
 - Bridge (Rail over Rail)
 - Bridge (Rail over River)
 - Bridge (Rail over Road)
 - Bridge (Road over Rail)
 - Level Crossing
 - Tunnel
 - Order Polygon
- DB Asset Line**
- DB Asset Line
 - DC Asset Line
 - Chamber (DD)
 - ▲ Outfall (DK)
 - Inflow (DL)
 - + Point (DM)
 - ◆ Soakaway (DN)
 - ★ Pond (DY)
 - Structure (DZ)
 - Channel (ELR, Mileage)
 - Channel (Coordinates)
 - Covered Channel (ELR, Mileage)
 - Covered Channel (Coordinates)
 - Culvert (ELR, Mileage)
 - Culvert (Coordinates)
 - Granular Drain (ELR, Mileage)
 - Granular Drain (Coordinates)
 - Pipe (ELR and Mileage)
 - Pipe (Coordinates)
 - Syphon (ELR, Mileage)
 - Syphon (Coordinates)

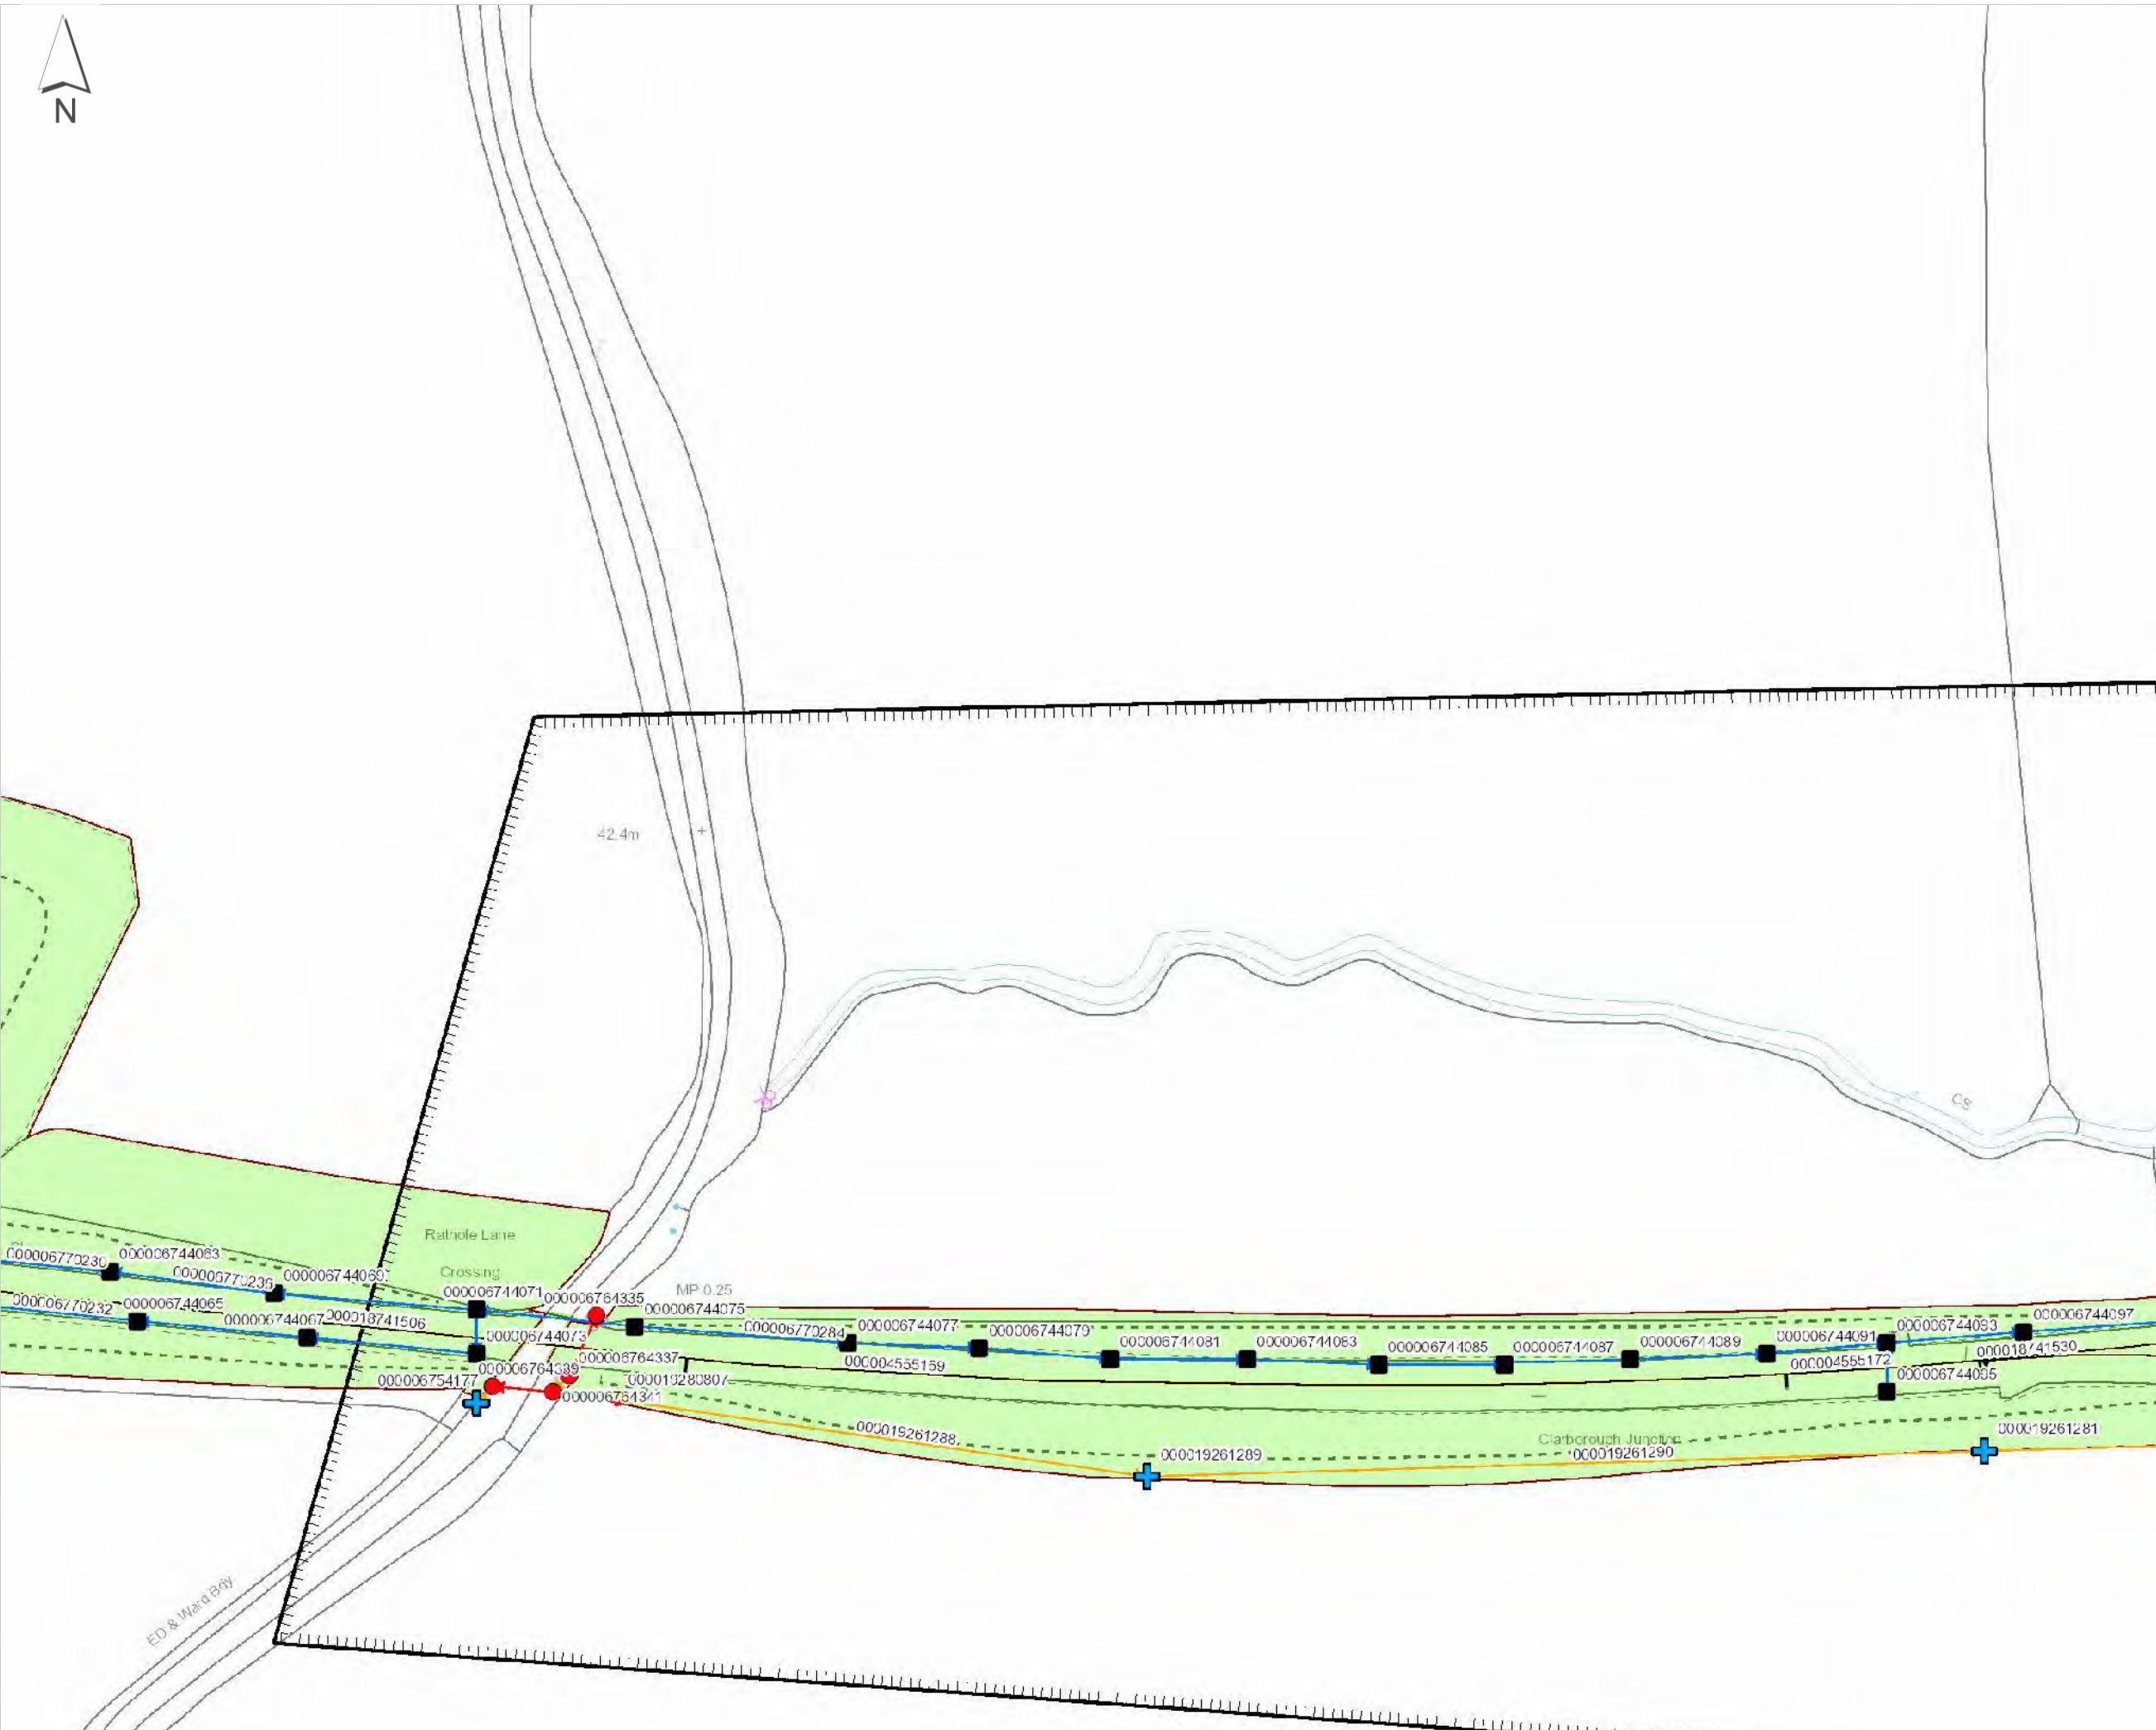

Order Ref: 168506
 Plot Scale: 1:1250
 Page Index: 2
 Centre X, Y: 475658, 382634
 Plot Date: 04/05/23




Crown copyright and database rights 2023
 Ordnance Survey 0100040692

Network Rail - Drainage

Legend

- Company Ownership**
 - Freehold Ownership
 - Leasehold Ownership
 - Prohibitive Interest
 - Bridge (Rail over Rail)
 - Bridge (Rail over River)
 - Bridge (Rail over Road)
 - Bridge (Road over Rail)
 - Level Crossing
 - Tunnel
 - Order Polygon
- DB Asset Line
- DC Asset Line
- Chamber (DD)
- Outfall (DK)
- Inflow (DL)
- Point (DM)
- Soakaway (DN)
- Pond (DY)
- Structure (DZ)
- Channel (ELR, Mileage)
- Channel (Coordinates)
- Covered Channel (ELR, Mileage)
- Covered Channel (Coordinates)
- Culvert (ELR, Mileage)
- Culvert (Coordinates)
- Granular Drain (ELR, Mileage)
- Granular Drain (Coordinates)
- Pipe (ELR and Mileage)
- Pipe (Coordinates)
- Syphon (ELR, Mileage)
- Syphon (Coordinates)

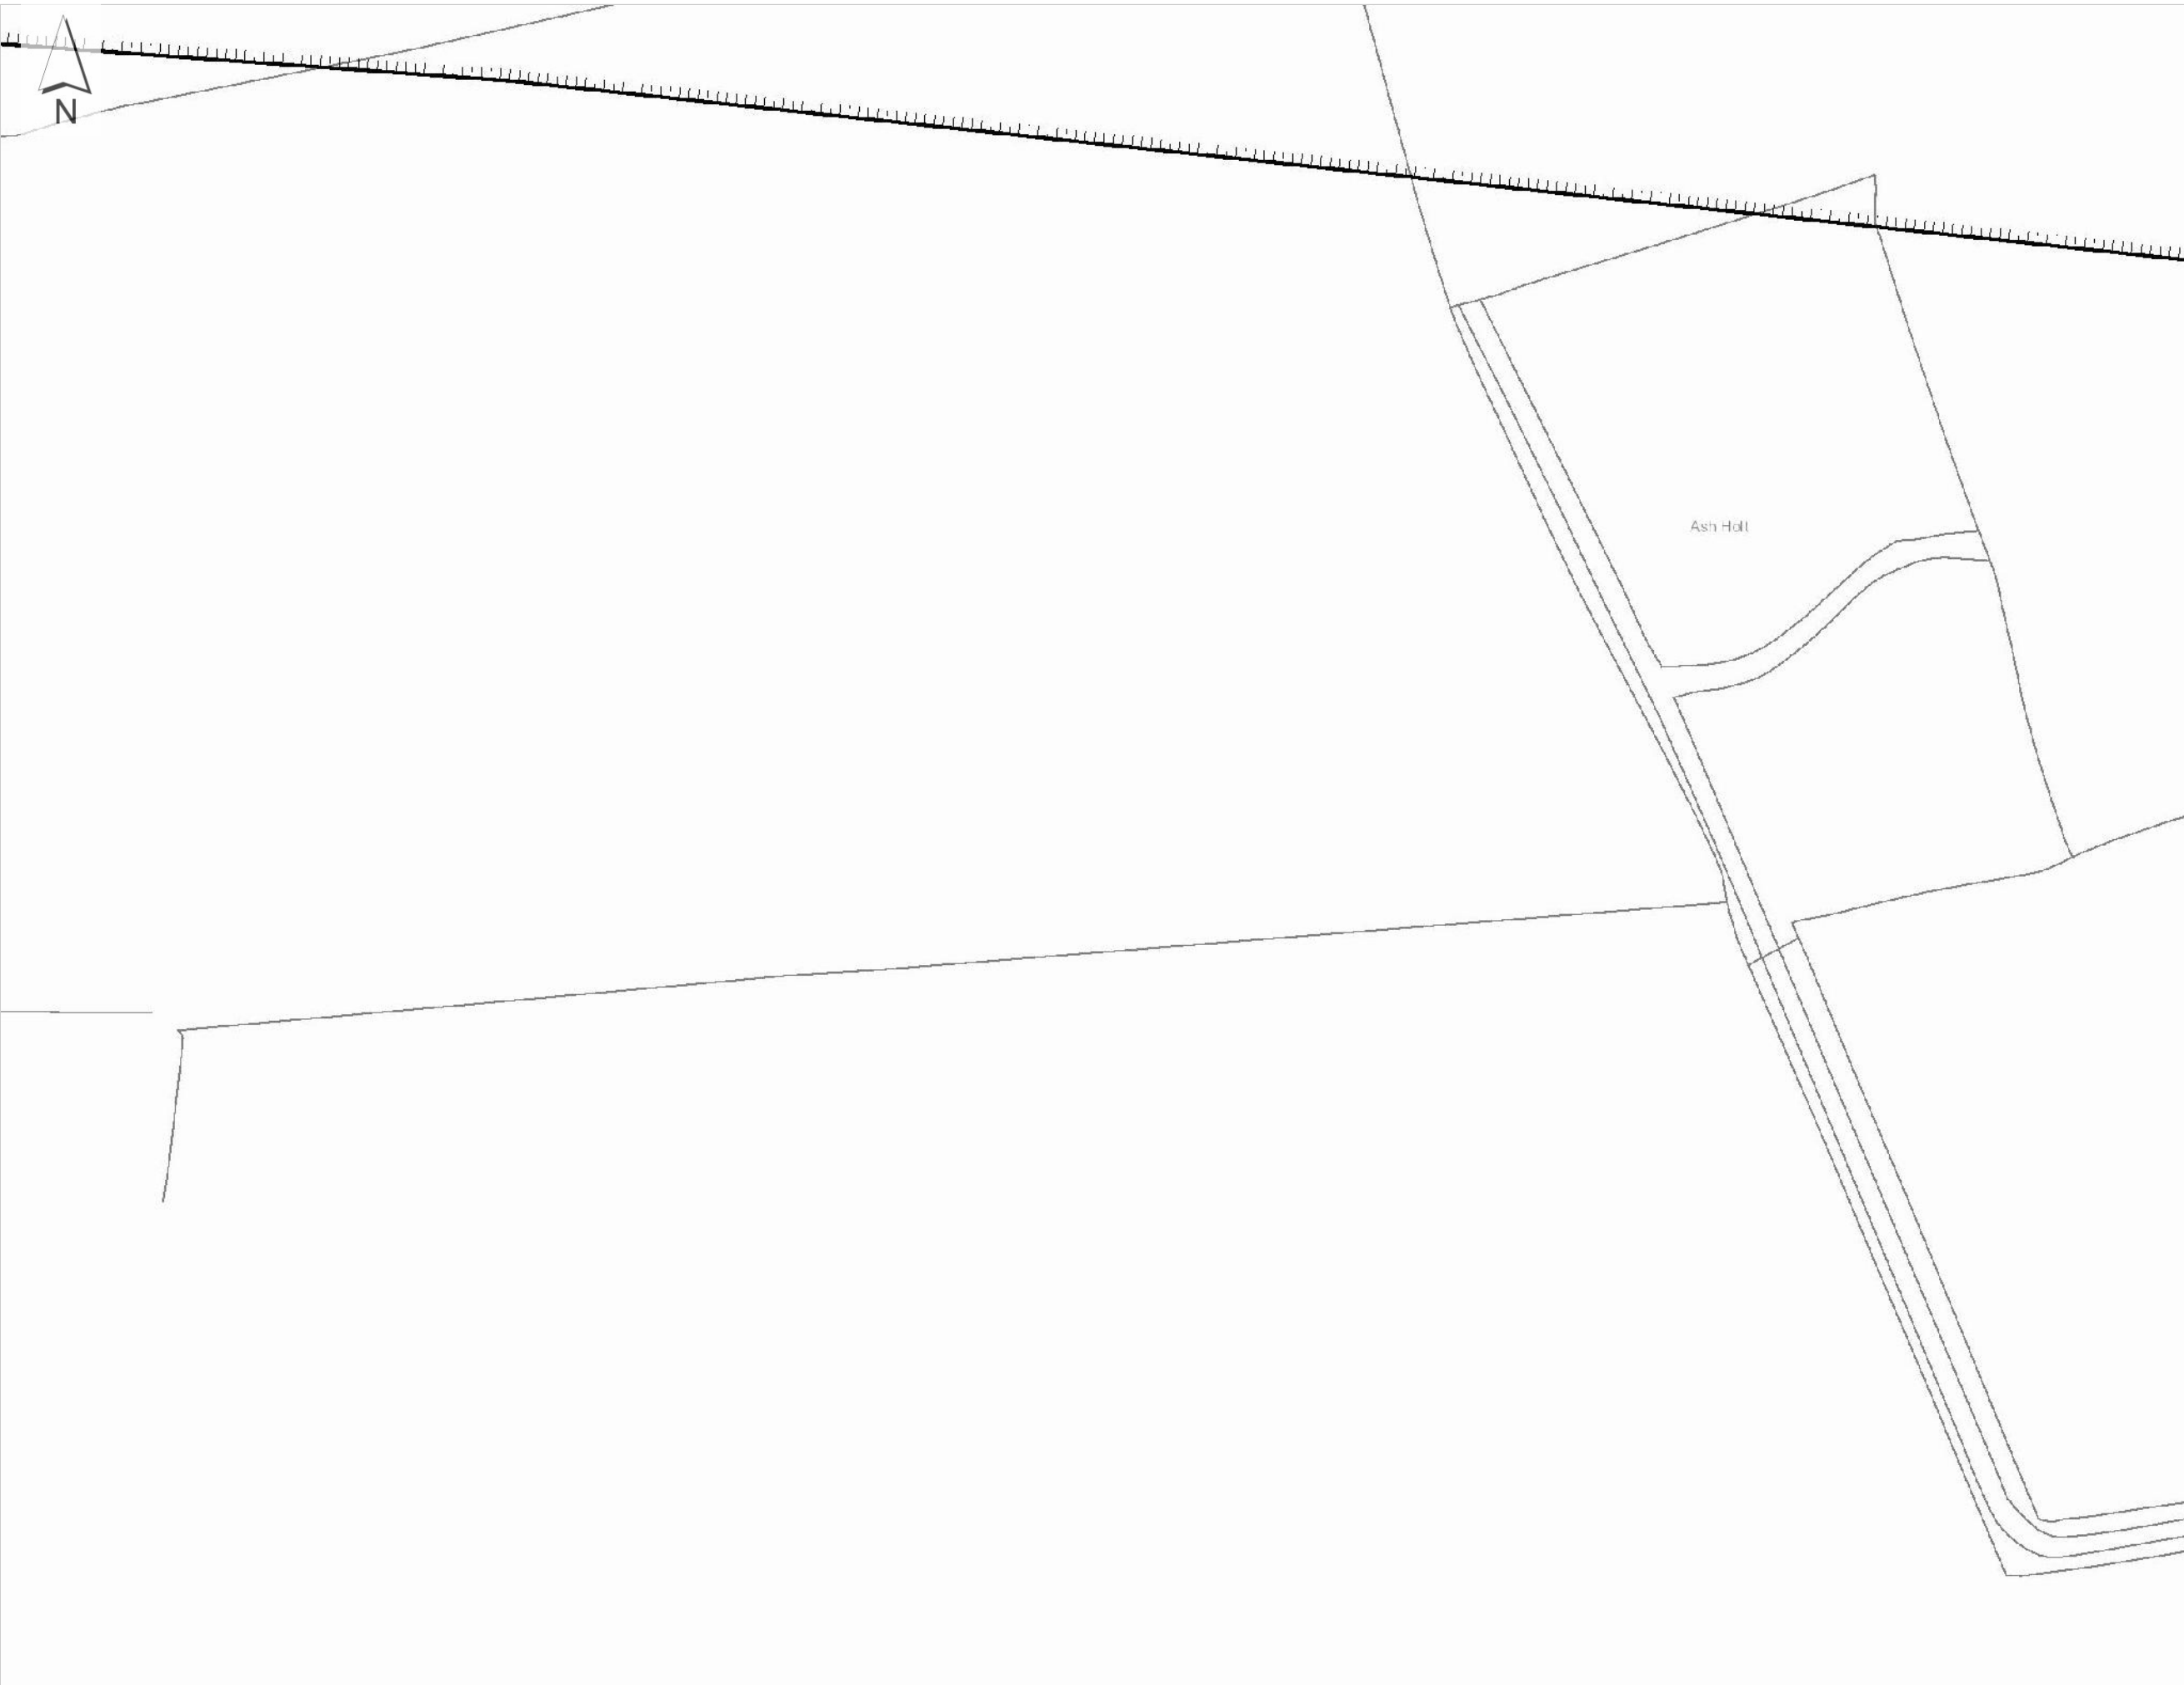

Order Ref: 168506
Plot Scale: 1:1250
Page Index: 3
Centre X, Y: 476055, 382317
Plot Date: 04/05/23



Network Rail - Drainage

Legend

- Company Ownership**
- Freehold Ownership
 - Leasehold Ownership
 - Prohibitive Interest
 - Bridge (Rail over Rail)
 - Bridge (Rail over River)
 - Bridge (Rail over Road)
 - Bridge (Road over Rail)
 - Level Crossing
 - Tunnel
 - Order Polygon
-
- ⋈ DB Asset Line
 - ┌ DC Asset Line
 - Chamber (DD)
 - ▲ Outfall (DK)
 - Inflow (DL)
 - + Point (DM)
 - ◆ Soakaway (DN)
 - ★ Pond (DY)
 - Structure (DZ)
 - ┌ Channel (ELR, Mileage)
 - ┌ Channel (Coordinates)
 - ┌ Covered Channel (ELR, Mileage)
 - ┌ Covered Channel (Coordinates)
 - ┌ Culvert (ELR, Mileage)
 - ┌ Culvert (Coordinates)
 - ┌ Granular Drain (ELR, Mileage)
 - ┌ Granular Drain (Coordinates)
 - ┌ Pipe (ELR and Mileage)
 - ┌ Pipe (Coordinates)
 - ┌ Syphon (ELR, Mileage)
 - ┌ Syphon (Coordinates)



Order Ref: 168506
 Plot Scale: 1:1250
 Page Index: 4
 Centre X, Y: 476055, 382634
 Plot Date: 04/05/23



Network Rail - Drainage



Legend

- Company Ownership**
- Freehold Ownership
 - Leasehold Ownership
 - + Prohibitive Interest
 - Bridge (Rail over Rail)
 - Bridge (Rail over River)
 - Bridge (Rail over Road)
 - Bridge (Road over Rail)
 - Level Crossing
 - Tunnel
 - Order Polygon
- DB Asset Line**
- DB Asset Line
 - DC Asset Line
 - Chamber (DD)
 - ▲ Outfall (DK)
 - Inflow (DL)
 - + Point (DM)
 - ◆ Soakaway (DN)
 - ★ Pond (DY)
 - Structure (DZ)
- Channel (ELR, Mileage)**
- Channel (ELR, Mileage)
 - Channel (Coordinates)
 - Covered Channel (ELR, Mileage)
 - Covered Channel (Coordinates)
 - Culvert (ELR, Mileage)
 - Culvert (Coordinates)
 - Granular Drain (ELR, Mileage)
 - Granular Drain (Coordinates)
 - Pipe (ELR and Mileage)
 - Pipe (Coordinates)
 - Syphon (ELR, Mileage)
 - Syphon (Coordinates)

Order Ref: 168506
 Plot Scale: 1:1250
 Page Index: 5
 Centre X, Y: 476452, 382317
 Plot Date: 04/05/23




Crown copyright and database rights 2023
 Ordnance Survey 0100040692



Network Rail - Drainage

Legend

- Company Ownership**
- Freehold Ownership
 - Leasehold Ownership
 - Prohibitive Interest
 - Bridge (Rail over Rail)
 - Bridge (Rail over River)
 - Bridge (Rail over Road)
 - Bridge (Road over Rail)
 - Level Crossing
 - Tunnel
- Order Polygon**
- ✦ DB Asset Line
 - ┌ DC Asset Line
 - Chamber (DD)
 - ▲ Outfall (DK)
 - Inflow (DL)
 - + Point (DM)
 - ◆ Soakaway (DN)
 - ★ Pond (DY)
 - Structure (DZ)
 - ┌ Channel (ELR, Mileage)
 - ┌ Channel (Coordinates)
 - ┌ Covered Channel (ELR, Mileage)
 - ┌ Covered Channel (Coordinates)
 - ┌ Culvert (ELR, Mileage)
 - ┌ Culvert (Coordinates)
 - ┌ Granular Drain (ELR, Mileage)
 - ┌ Granular Drain (Coordinates)
 - ┌ Pipe (ELR and Mileage)
 - ┌ Pipe (Coordinates)
 - ┌ Syphon (ELR, Mileage)
 - ┌ Syphon (Coordinates)

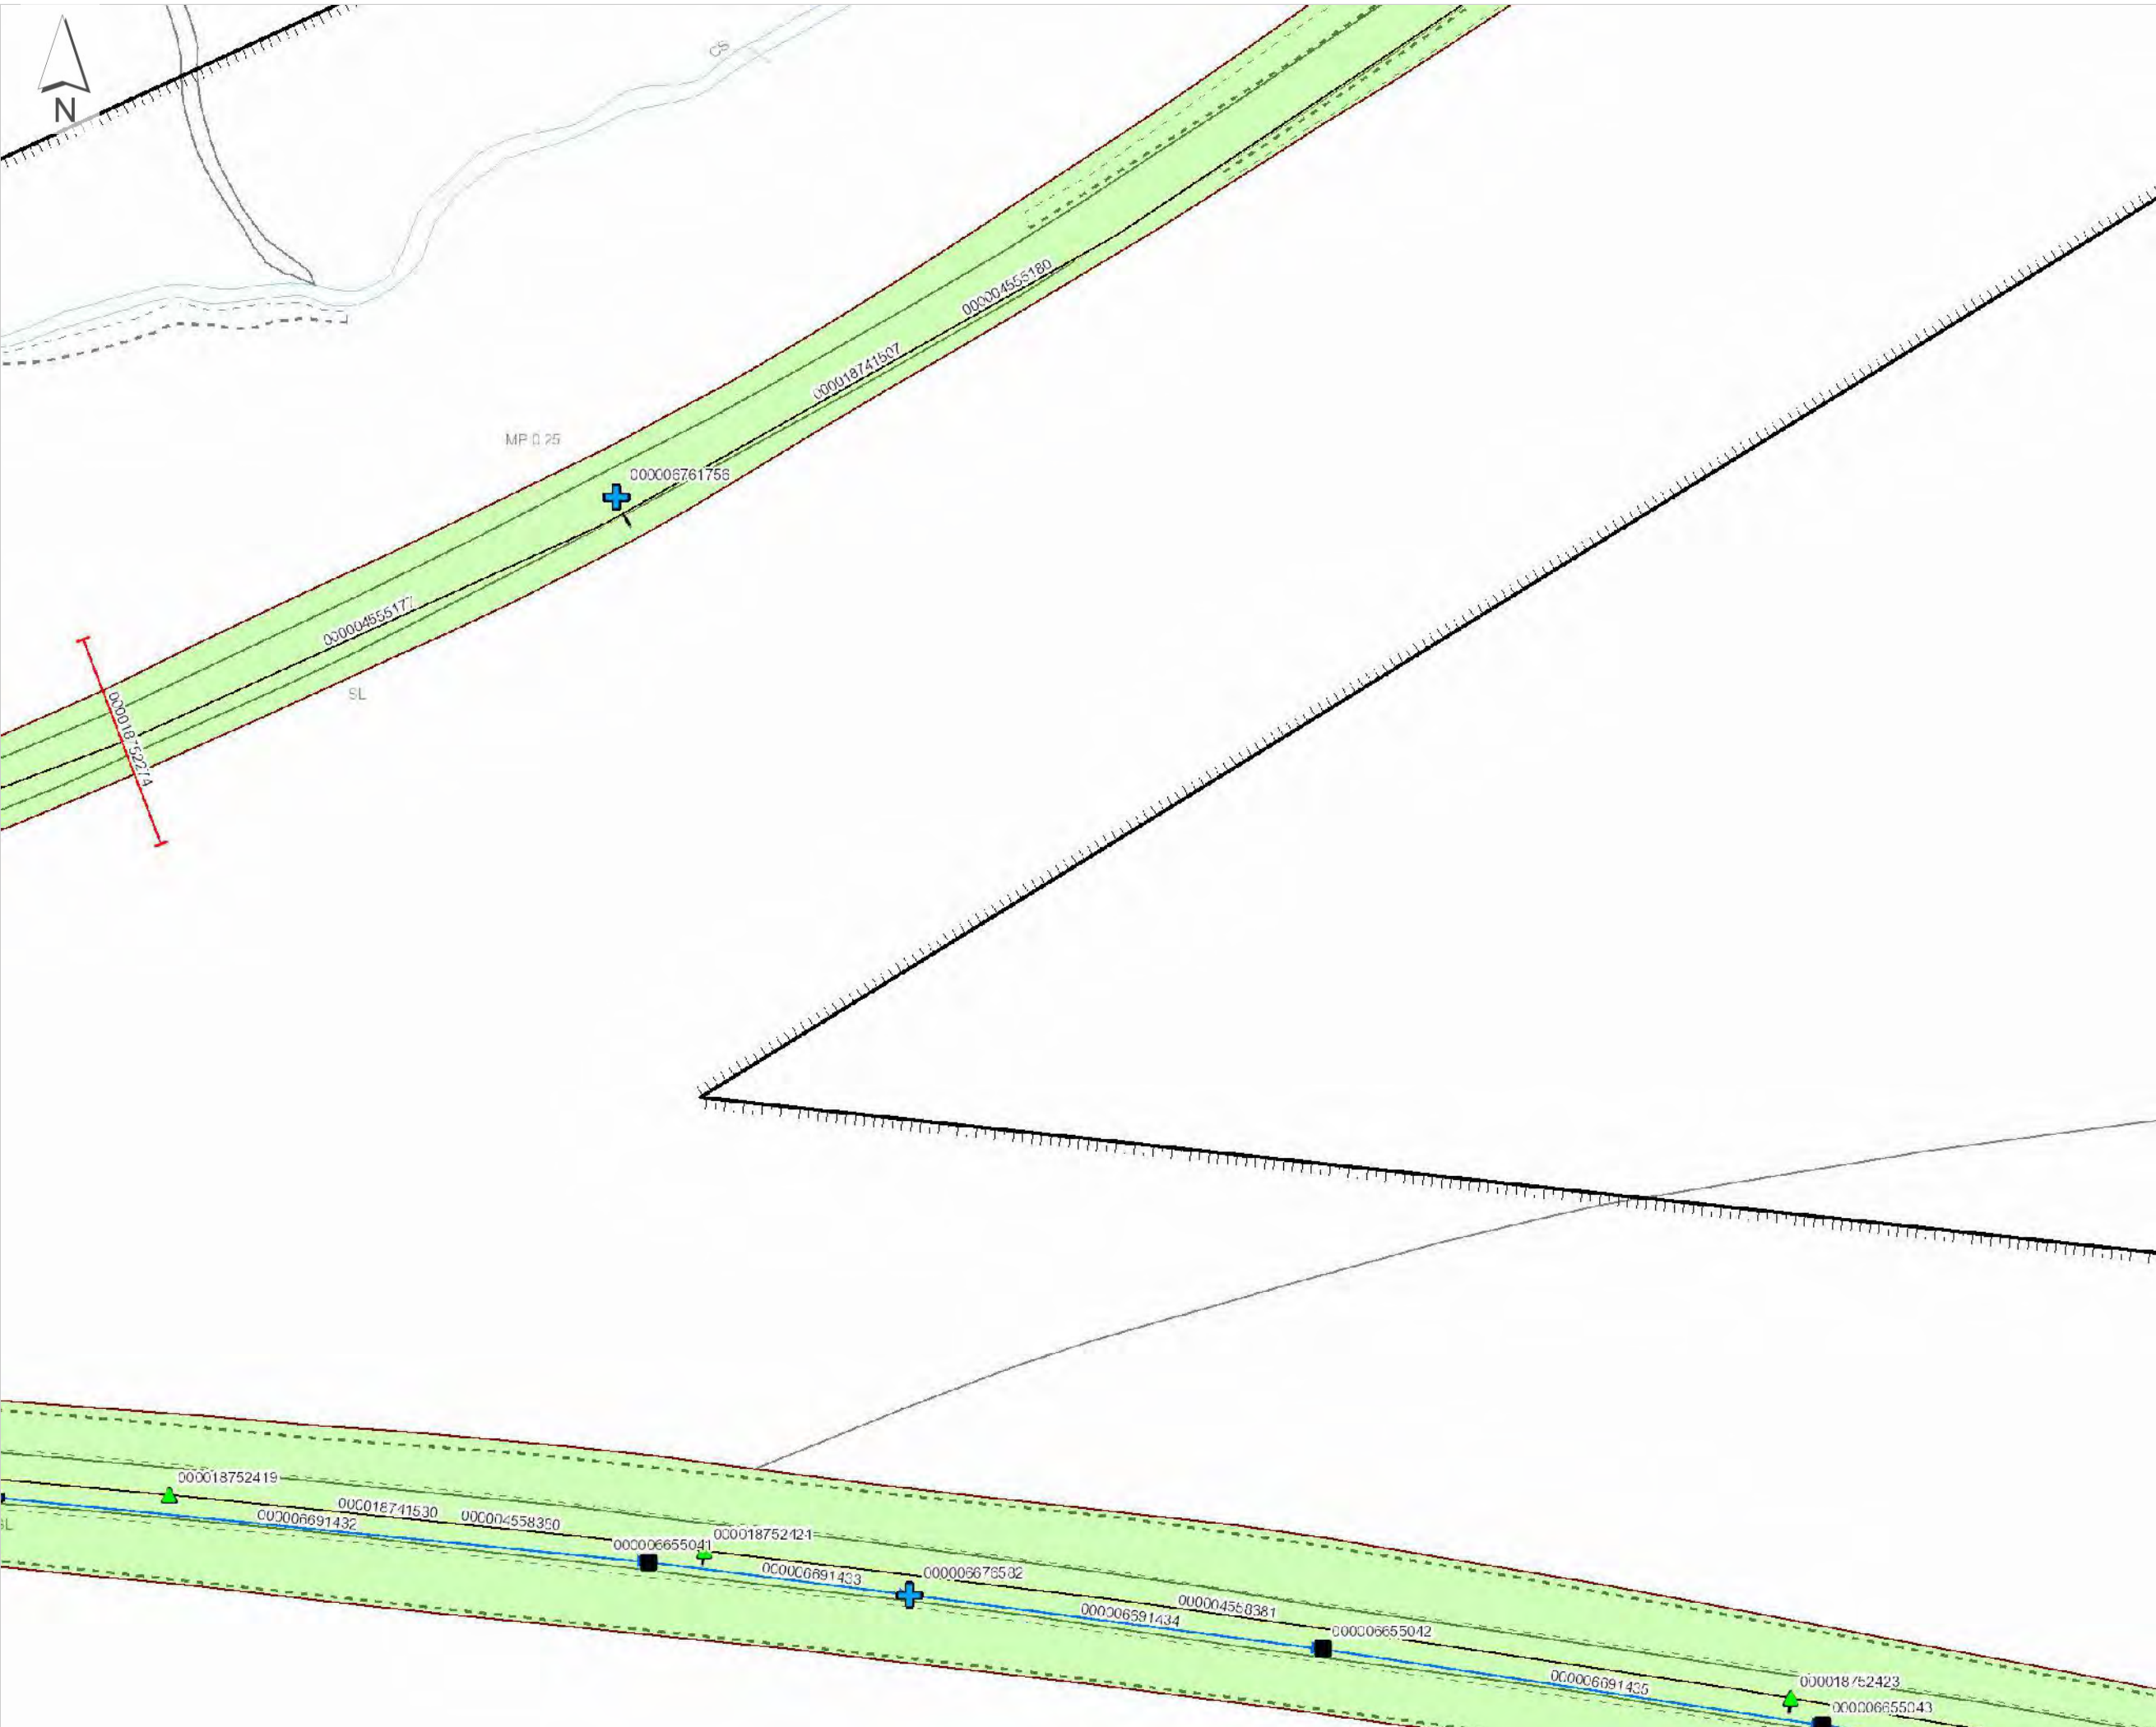

Order Ref: 168506
 Plot Scale: 1:1250
 Page Index: 6
 Centre X, Y: 476452, 382634
 Plot Date: 04/05/23



Crown copyright and database rights 2023
 Ordnance Survey 0100040692

Network Rail - Drainage




Legend

- Company Ownership**
- Freehold Ownership
 - Leasehold Ownership
 - Prohibitive Interest
 - Bridge (Rail over Rail)
 - Bridge (Rail over River)
 - Bridge (Rail over Road)
 - Bridge (Road over Rail)
 - Level Crossing
 - Tunnel
 - Order Polygon
- DB Asset Line**
- DB Asset Line
 - DC Asset Line
 - Chamber (DD)
 - Outfall (DK)
 - Inflow (DL)
 - Point (DM)
 - Soakaway (DN)
 - Pond (DY)
 - Structure (DZ)
- Channel (ELR, Mileage)**
- Channel (ELR, Mileage)
 - Channel (Coordinates)
 - Covered Channel (ELR, Mileage)
 - Covered Channel (Coordinates)
 - Culvert (ELR, Mileage)
 - Culvert (Coordinates)
 - Granular Drain (ELR, Mileage)
 - Granular Drain (Coordinates)
 - Pipe (ELR and Mileage)
 - Pipe (Coordinates)
 - Syphon (ELR, Mileage)
 - Syphon (Coordinates)

Order Ref: 168506
 Plot Scale: 1:1250
 Page Index: 7
 Centre X, Y: 476452, 382952
 Plot Date: 04/05/23



Crown copyright and database rights 2023
 Ordnance Survey 0100040692

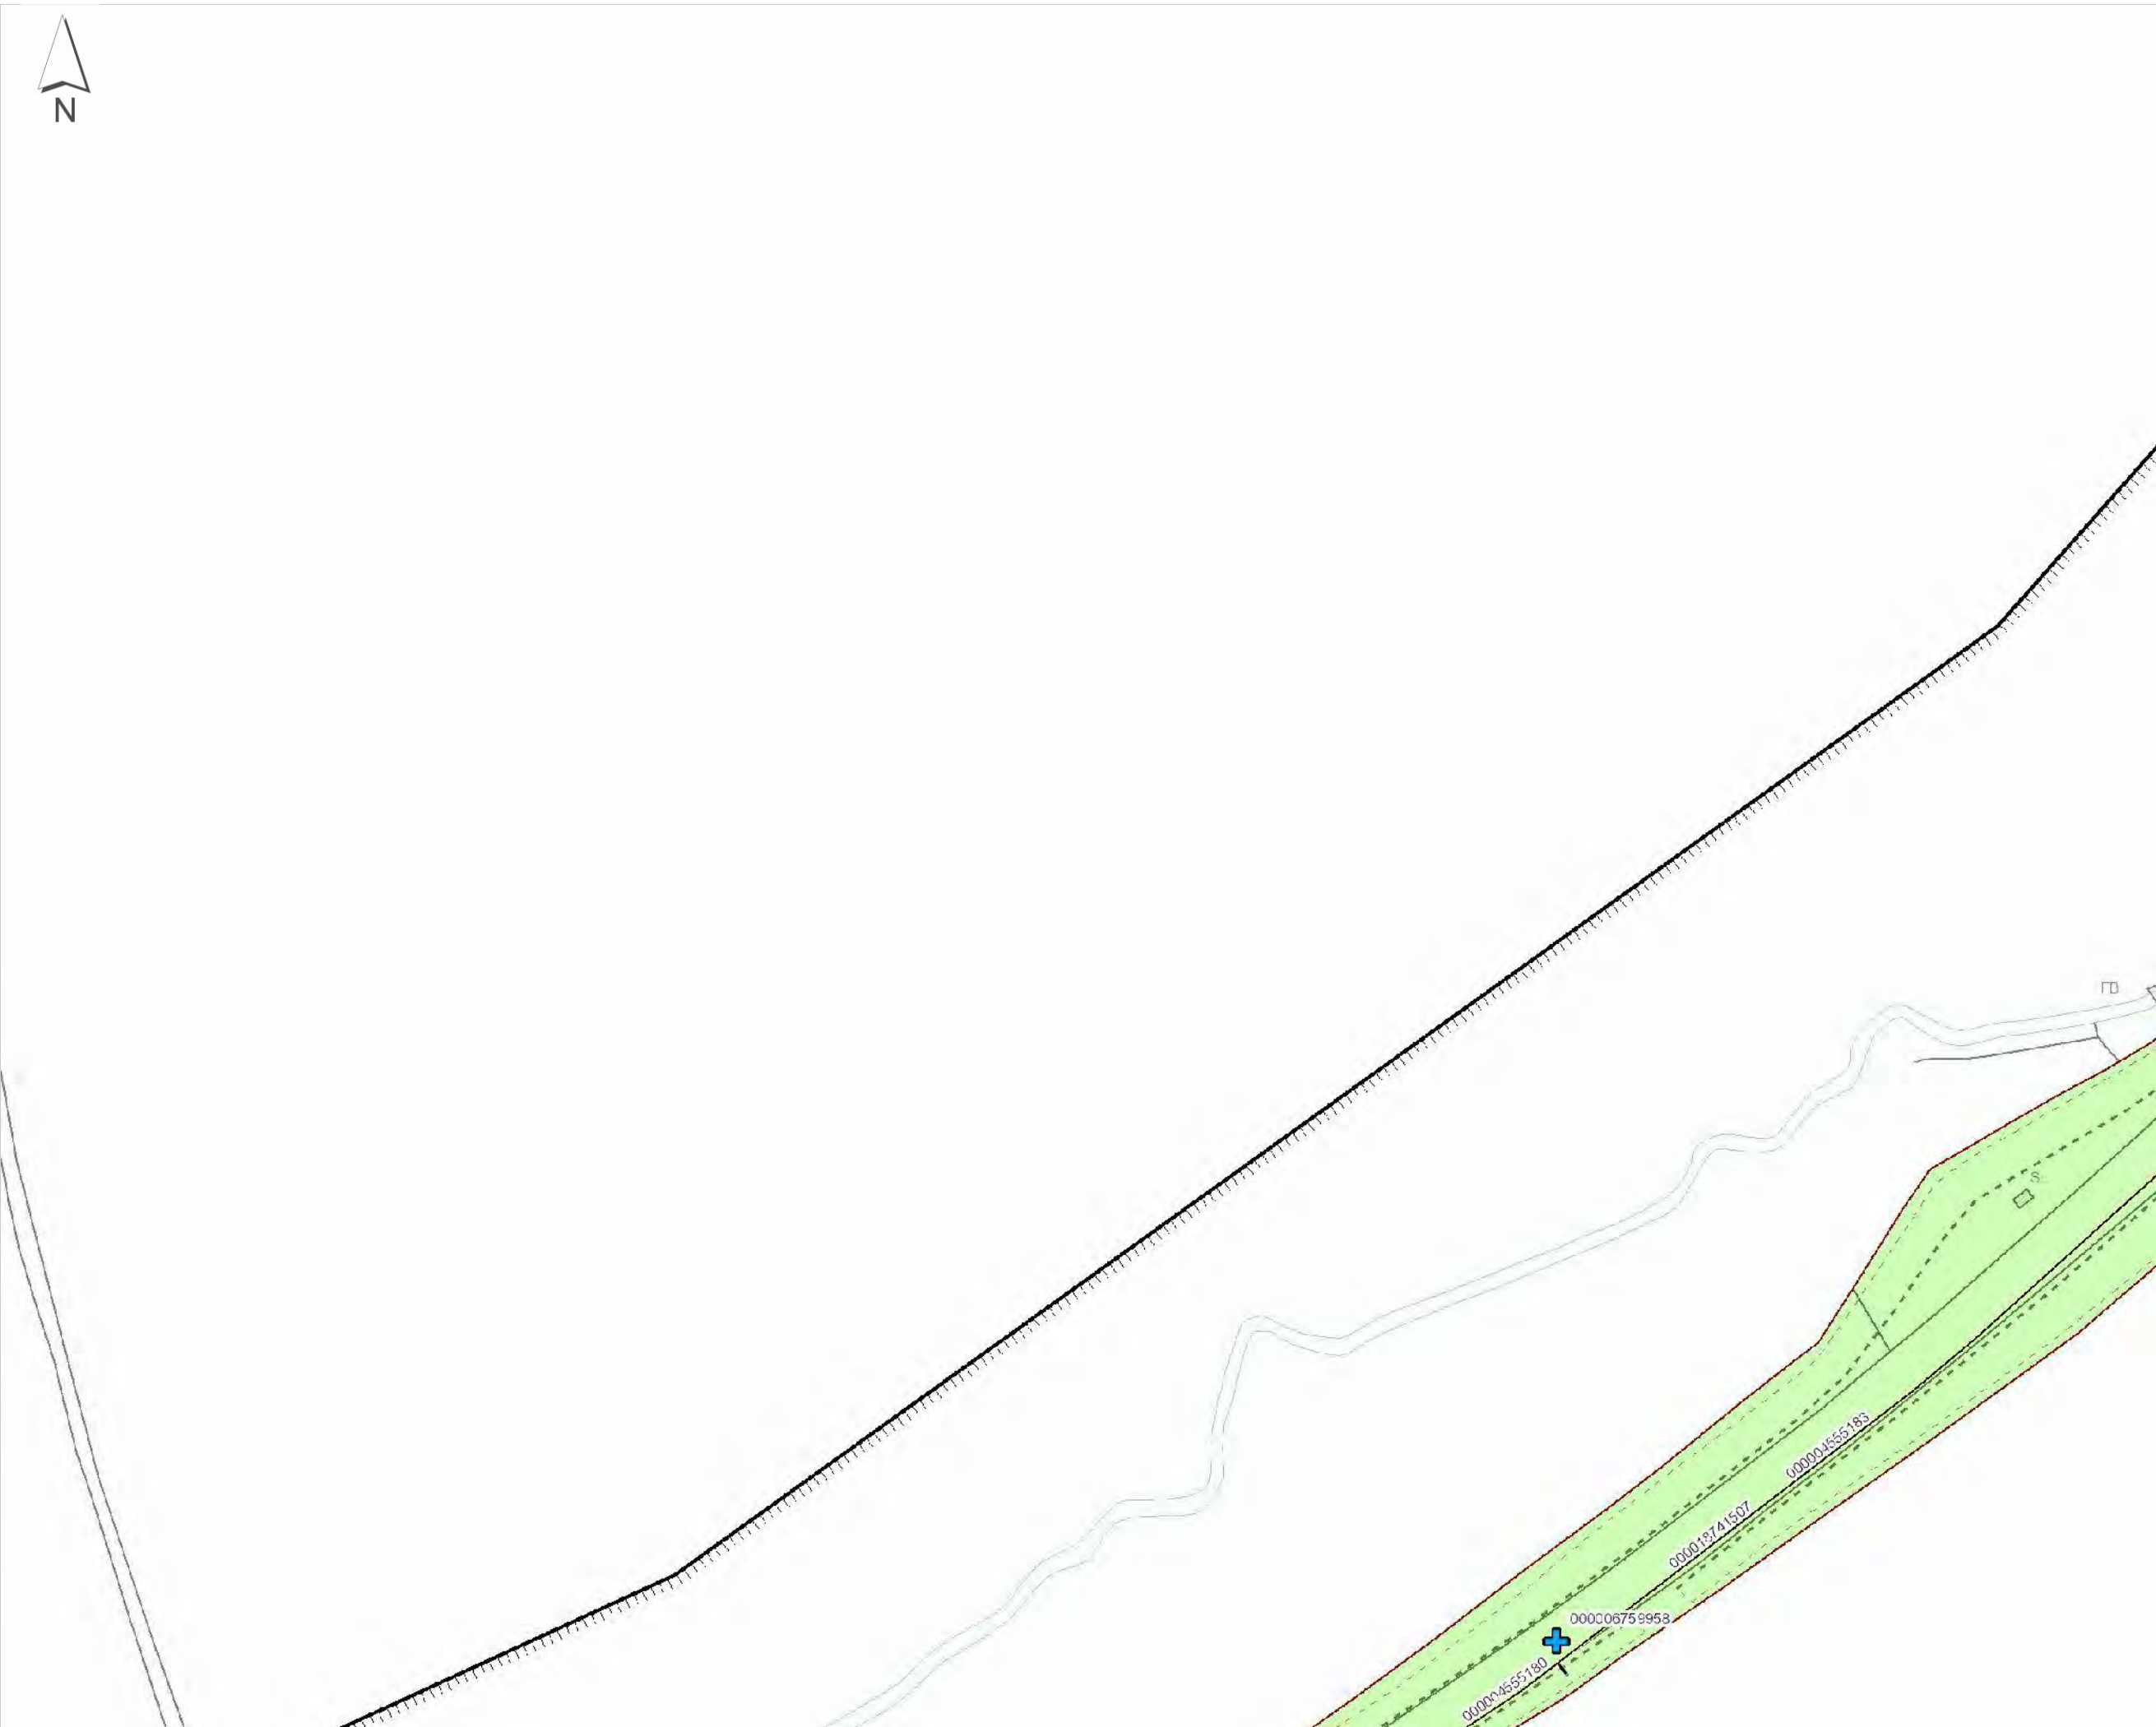

Network Rail - Drainage


Legend

- Company Ownership**
- Freehold Ownership
 - Leasehold Ownership
 - Prohibitive Interest
 - Bridge (Rail over Rail)
 - Bridge (Rail over River)
 - Bridge (Rail over Road)
 - Bridge (Road over Rail)
 - Level Crossing
 - Tunnel
 - Order Polygon
- DB Asset Line**
- DB Asset Line
 - DC Asset Line
 - Chamber (DD)
 - ▲ Outfall (DK)
 - Inflow (DL)
 - + Point (DM)
 - ◆ Soakaway (DN)
 - ★ Pond (DY)
 - Structure (DZ)
- Channel (ELR, Mileage)**
- Channel (ELR, Mileage)
 - Channel (Coordinates)
 - Covered Channel (ELR, Mileage)
 - Covered Channel (Coordinates)
- Culvert (ELR, Mileage)**
- Culvert (ELR, Mileage)
 - Culvert (Coordinates)
- Granular Drain (ELR, Mileage)**
- Granular Drain (ELR, Mileage)
 - Granular Drain (Coordinates)
- Pipe (ELR and Mileage)**
- Pipe (ELR and Mileage)
 - Pipe (Coordinates)
- Syphon (ELR, Mileage)**
- Syphon (ELR, Mileage)
 - Syphon (Coordinates)

Order Ref: 168506
 Plot Scale: 1:1250
 Page Index: 8
 Centre X, Y: 476849, 382317
 Plot Date: 04/05/23



Crown copyright and database rights 2023
 Ordnance Survey 0100040692

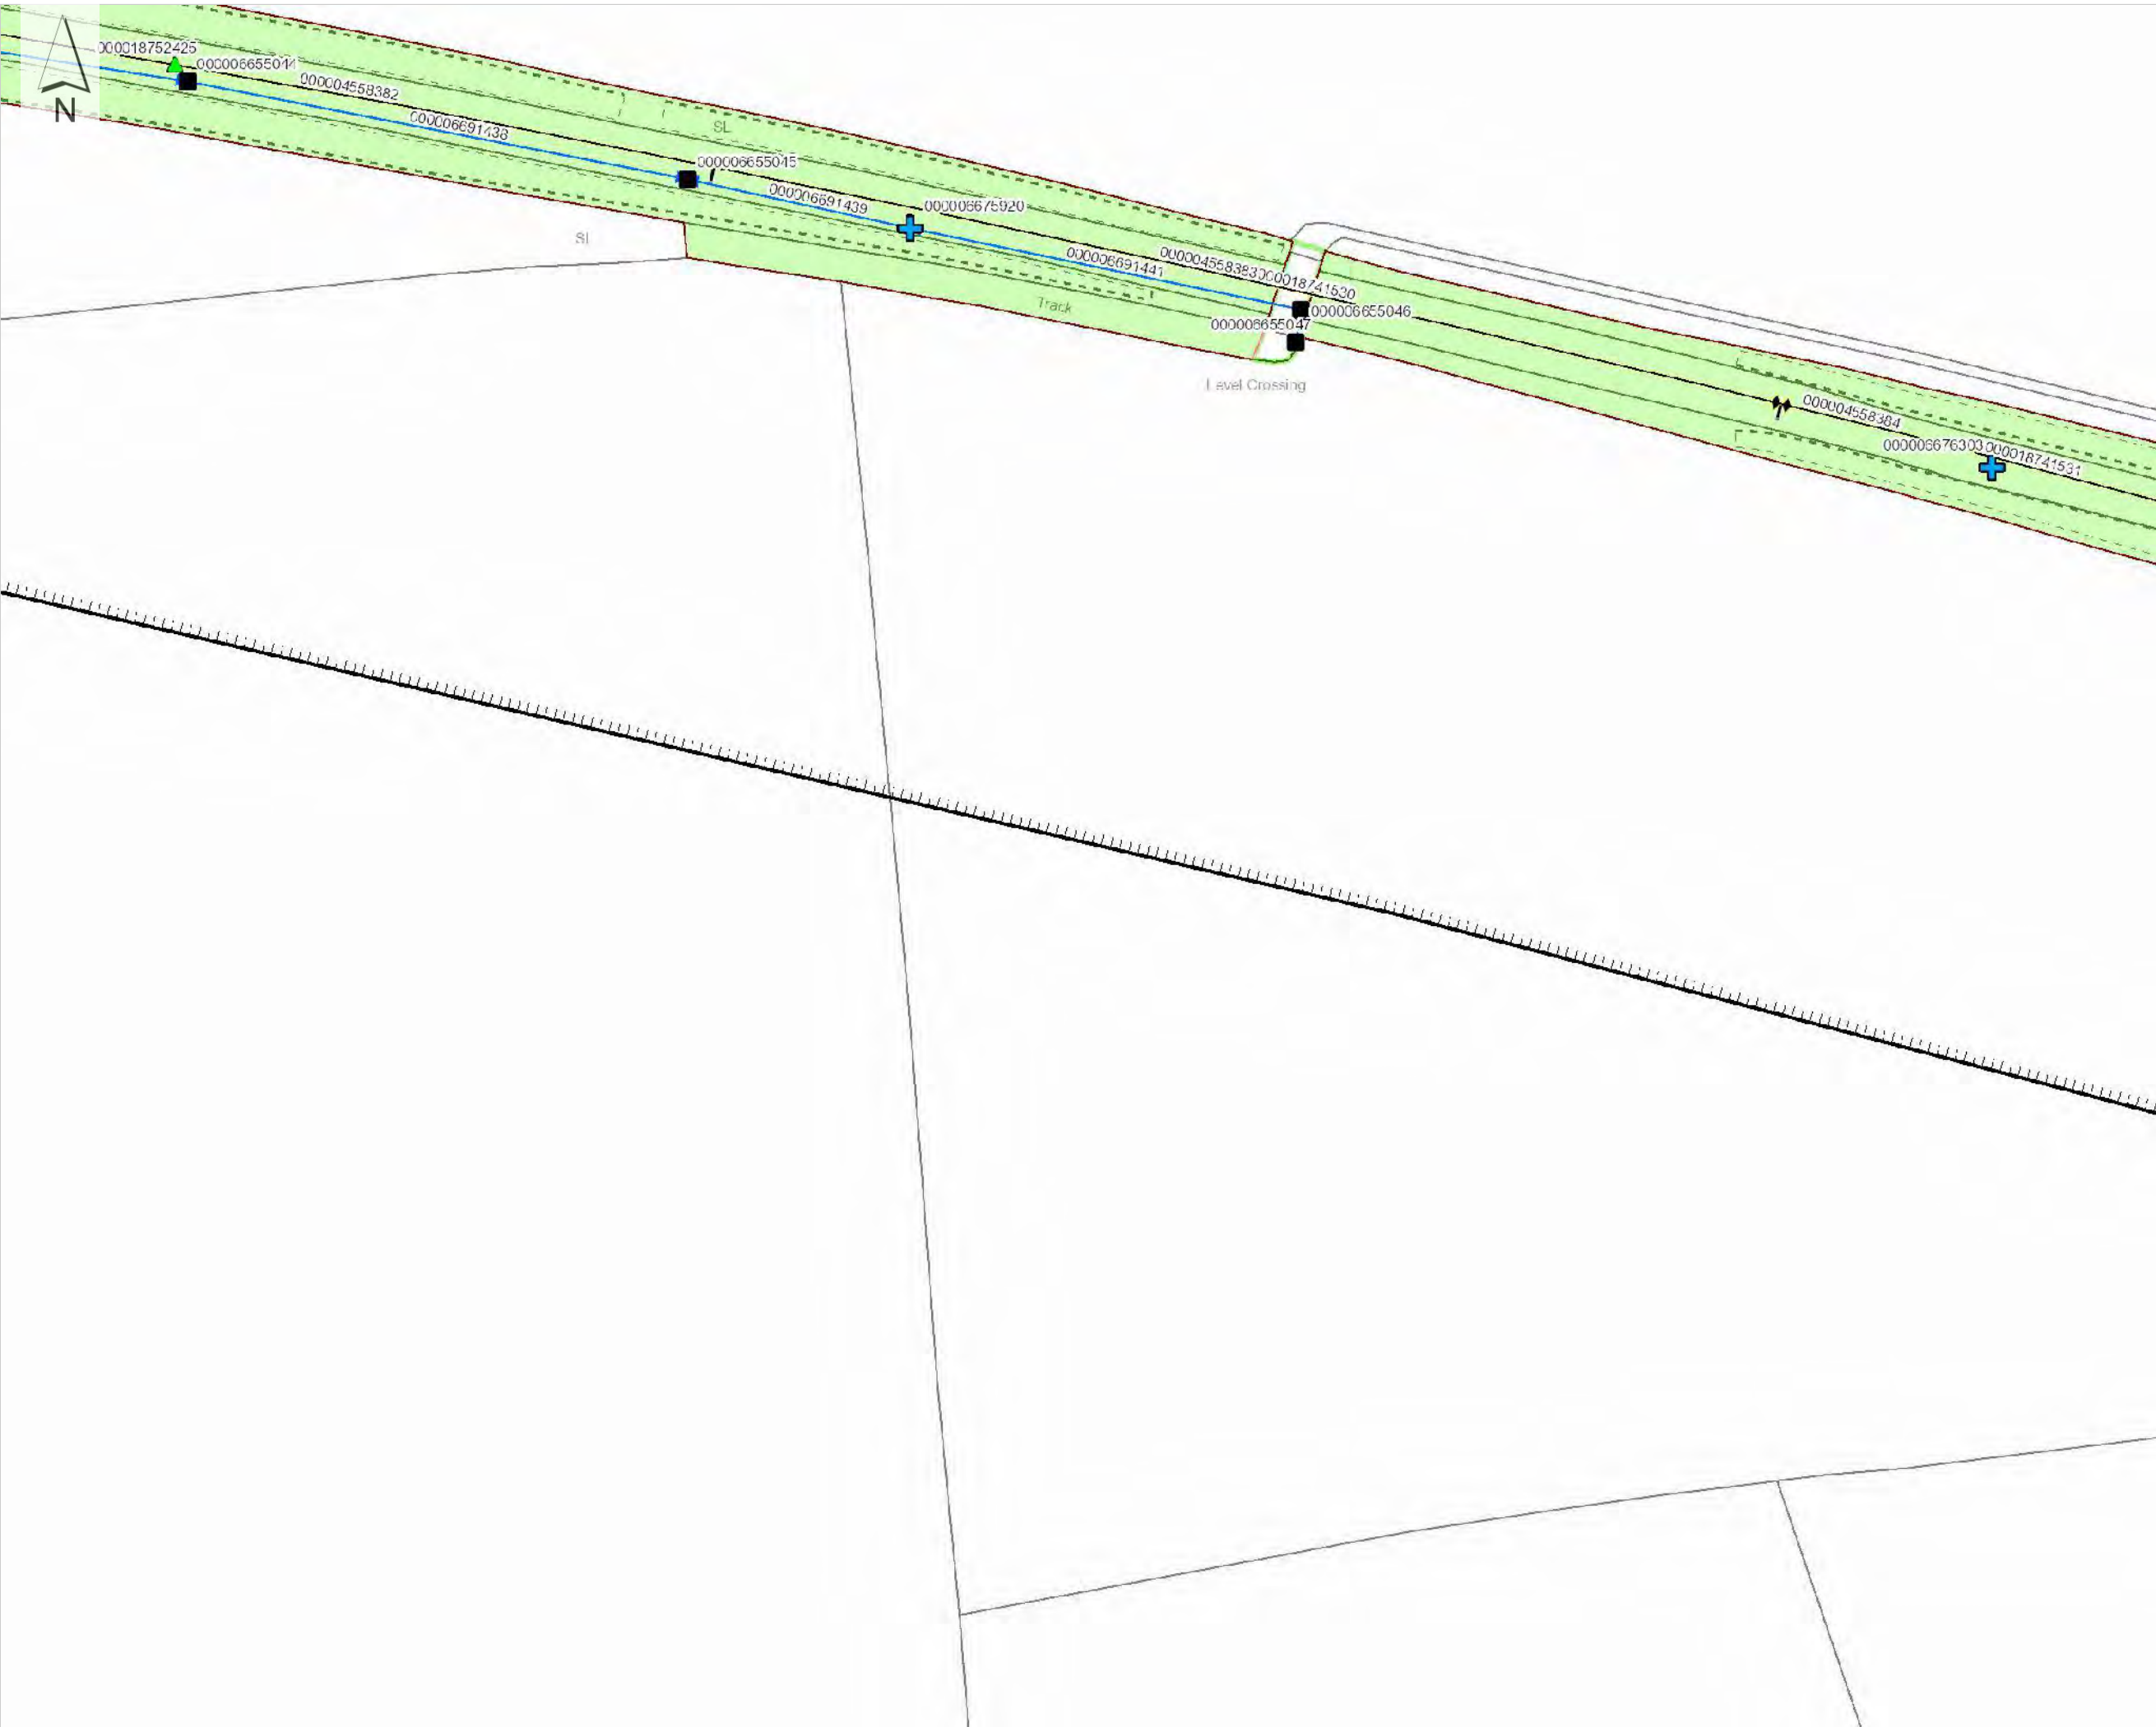

Network Rail - Drainage


Legend

- Company Ownership**
 - Freehold Ownership
 - Leasehold Ownership
 - Prohibitive Interest
 - Bridge (Rail over Rail)
 - Bridge (Rail over River)
 - Bridge (Rail over Road)
 - Bridge (Road over Rail)
 - Level Crossing
 - Tunnel
 - Order Polygon
- DB Asset Line
- DC Asset Line
- Chamber (DD)
- Outfall (DK)
- Inflow (DL)
- Point (DM)
- Soakaway (DN)
- Pond (DY)
- Structure (DZ)
- Channel (ELR, Mileage)
- Channel (Coordinates)
- Covered Channel (ELR, Mileage)
- Covered Channel (Coordinates)
- Culvert (ELR, Mileage)
- Culvert (Coordinates)
- Granular Drain (ELR, Mileage)
- Granular Drain (Coordinates)
- Pipe (ELR and Mileage)
- Pipe (Coordinates)
- Syphon (ELR, Mileage)
- Syphon (Coordinates)

Order Ref: 168506
Plot Scale: 1:1250
Page Index: 9
Centre X, Y: 476849, 382634
Plot Date: 04/05/23



Crown copyright and database rights 2023
Ordnance Survey 0100040692

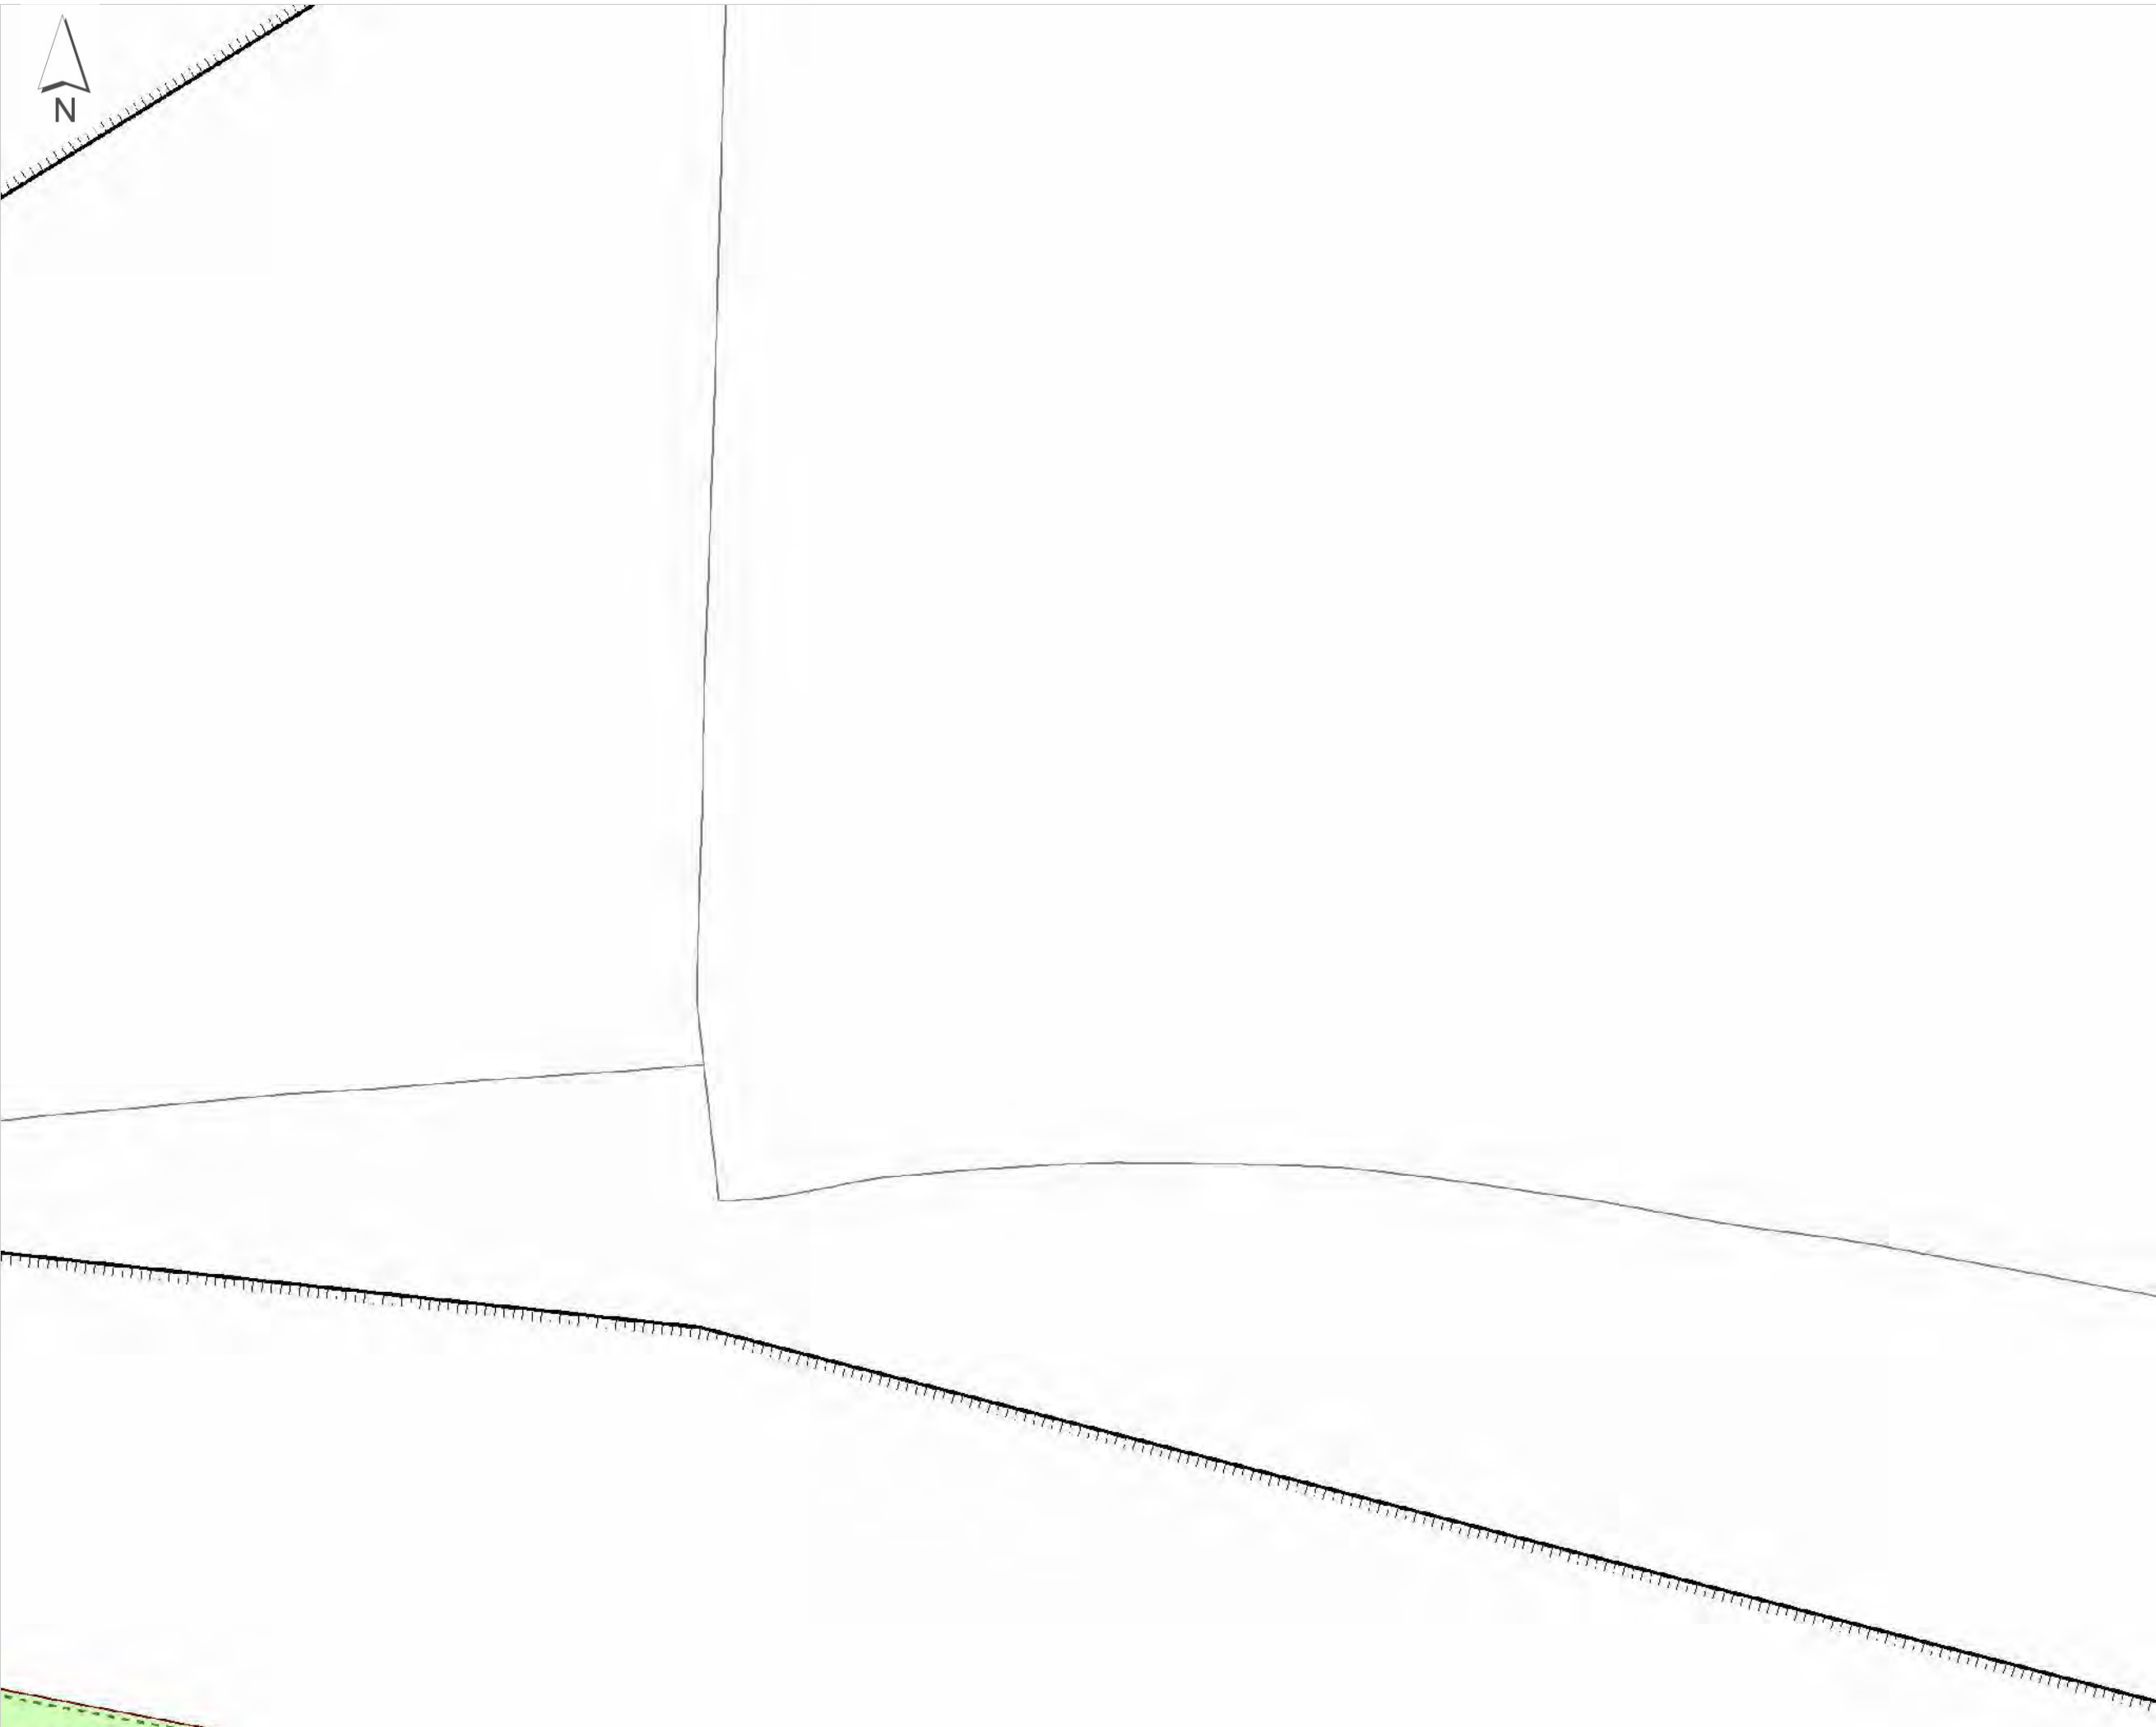

Network Rail - Drainage

Legend

- Company Ownership**
- Freehold Ownership
 - Leasehold Ownership
 - Prohibitive Interest
 - Bridge (Rail over Rail)
 - Bridge (Rail over River)
 - Bridge (Rail over Road)
 - Bridge (Road over Rail)
 - Level Crossing
 - Tunnel
 - Order Polygon
- DB Asset Line**
- DB Asset Line
 - DC Asset Line
 - Chamber (DD)
 - Outfall (DK)
 - Inflow (DL)
 - Point (DM)
 - Soakaway (DN)
 - Pond (DY)
 - Structure (DZ)
 - Channel (ELR, Mileage)
 - Channel (Coordinates)
 - Covered Channel (ELR, Mileage)
 - Covered Channel (Coordinates)
 - Culvert (ELR, Mileage)
 - Culvert (Coordinates)
 - Granular Drain (ELR, Mileage)
 - Granular Drain (Coordinates)
 - Pipe (ELR and Mileage)
 - Pipe (Coordinates)
 - Syphon (ELR, Mileage)
 - Syphon (Coordinates)



Order Ref: 168506
 Plot Scale: 1:1250
 Page Index: 10
 Centre X, Y: 476849, 382952
 Plot Date: 04/05/23




Network Rail - Drainage



Legend

- Company Ownership**
- Freehold Ownership
 - Leasehold Ownership
 - + Prohibitive Interest
 - Bridge (Rail over Rail)
 - Bridge (Rail over River)
 - Bridge (Rail over Road)
 - Bridge (Road over Rail)
 - Level Crossing
 - Tunnel
 - Order Polygon
- DB Asset Line**
- DB Asset Line
 - DC Asset Line
 - Chamber (DD)
 - ▲ Outfall (DK)
 - Inflow (DL)
 - + Point (DM)
 - ◆ Soakaway (DN)
 - ★ Pond (DY)
 - Structure (DZ)
- Channel (ELR, Mileage)**
- Channel (ELR, Mileage)
 - Channel (Coordinates)
 - Covered Channel (ELR, Mileage)
 - Covered Channel (Coordinates)
 - Culvert (ELR, Mileage)
 - Culvert (Coordinates)
 - Granular Drain (ELR, Mileage)
 - Granular Drain (Coordinates)
 - Pipe (ELR and Mileage)
 - Pipe (Coordinates)
 - Syphon (ELR, Mileage)
 - Syphon (Coordinates)

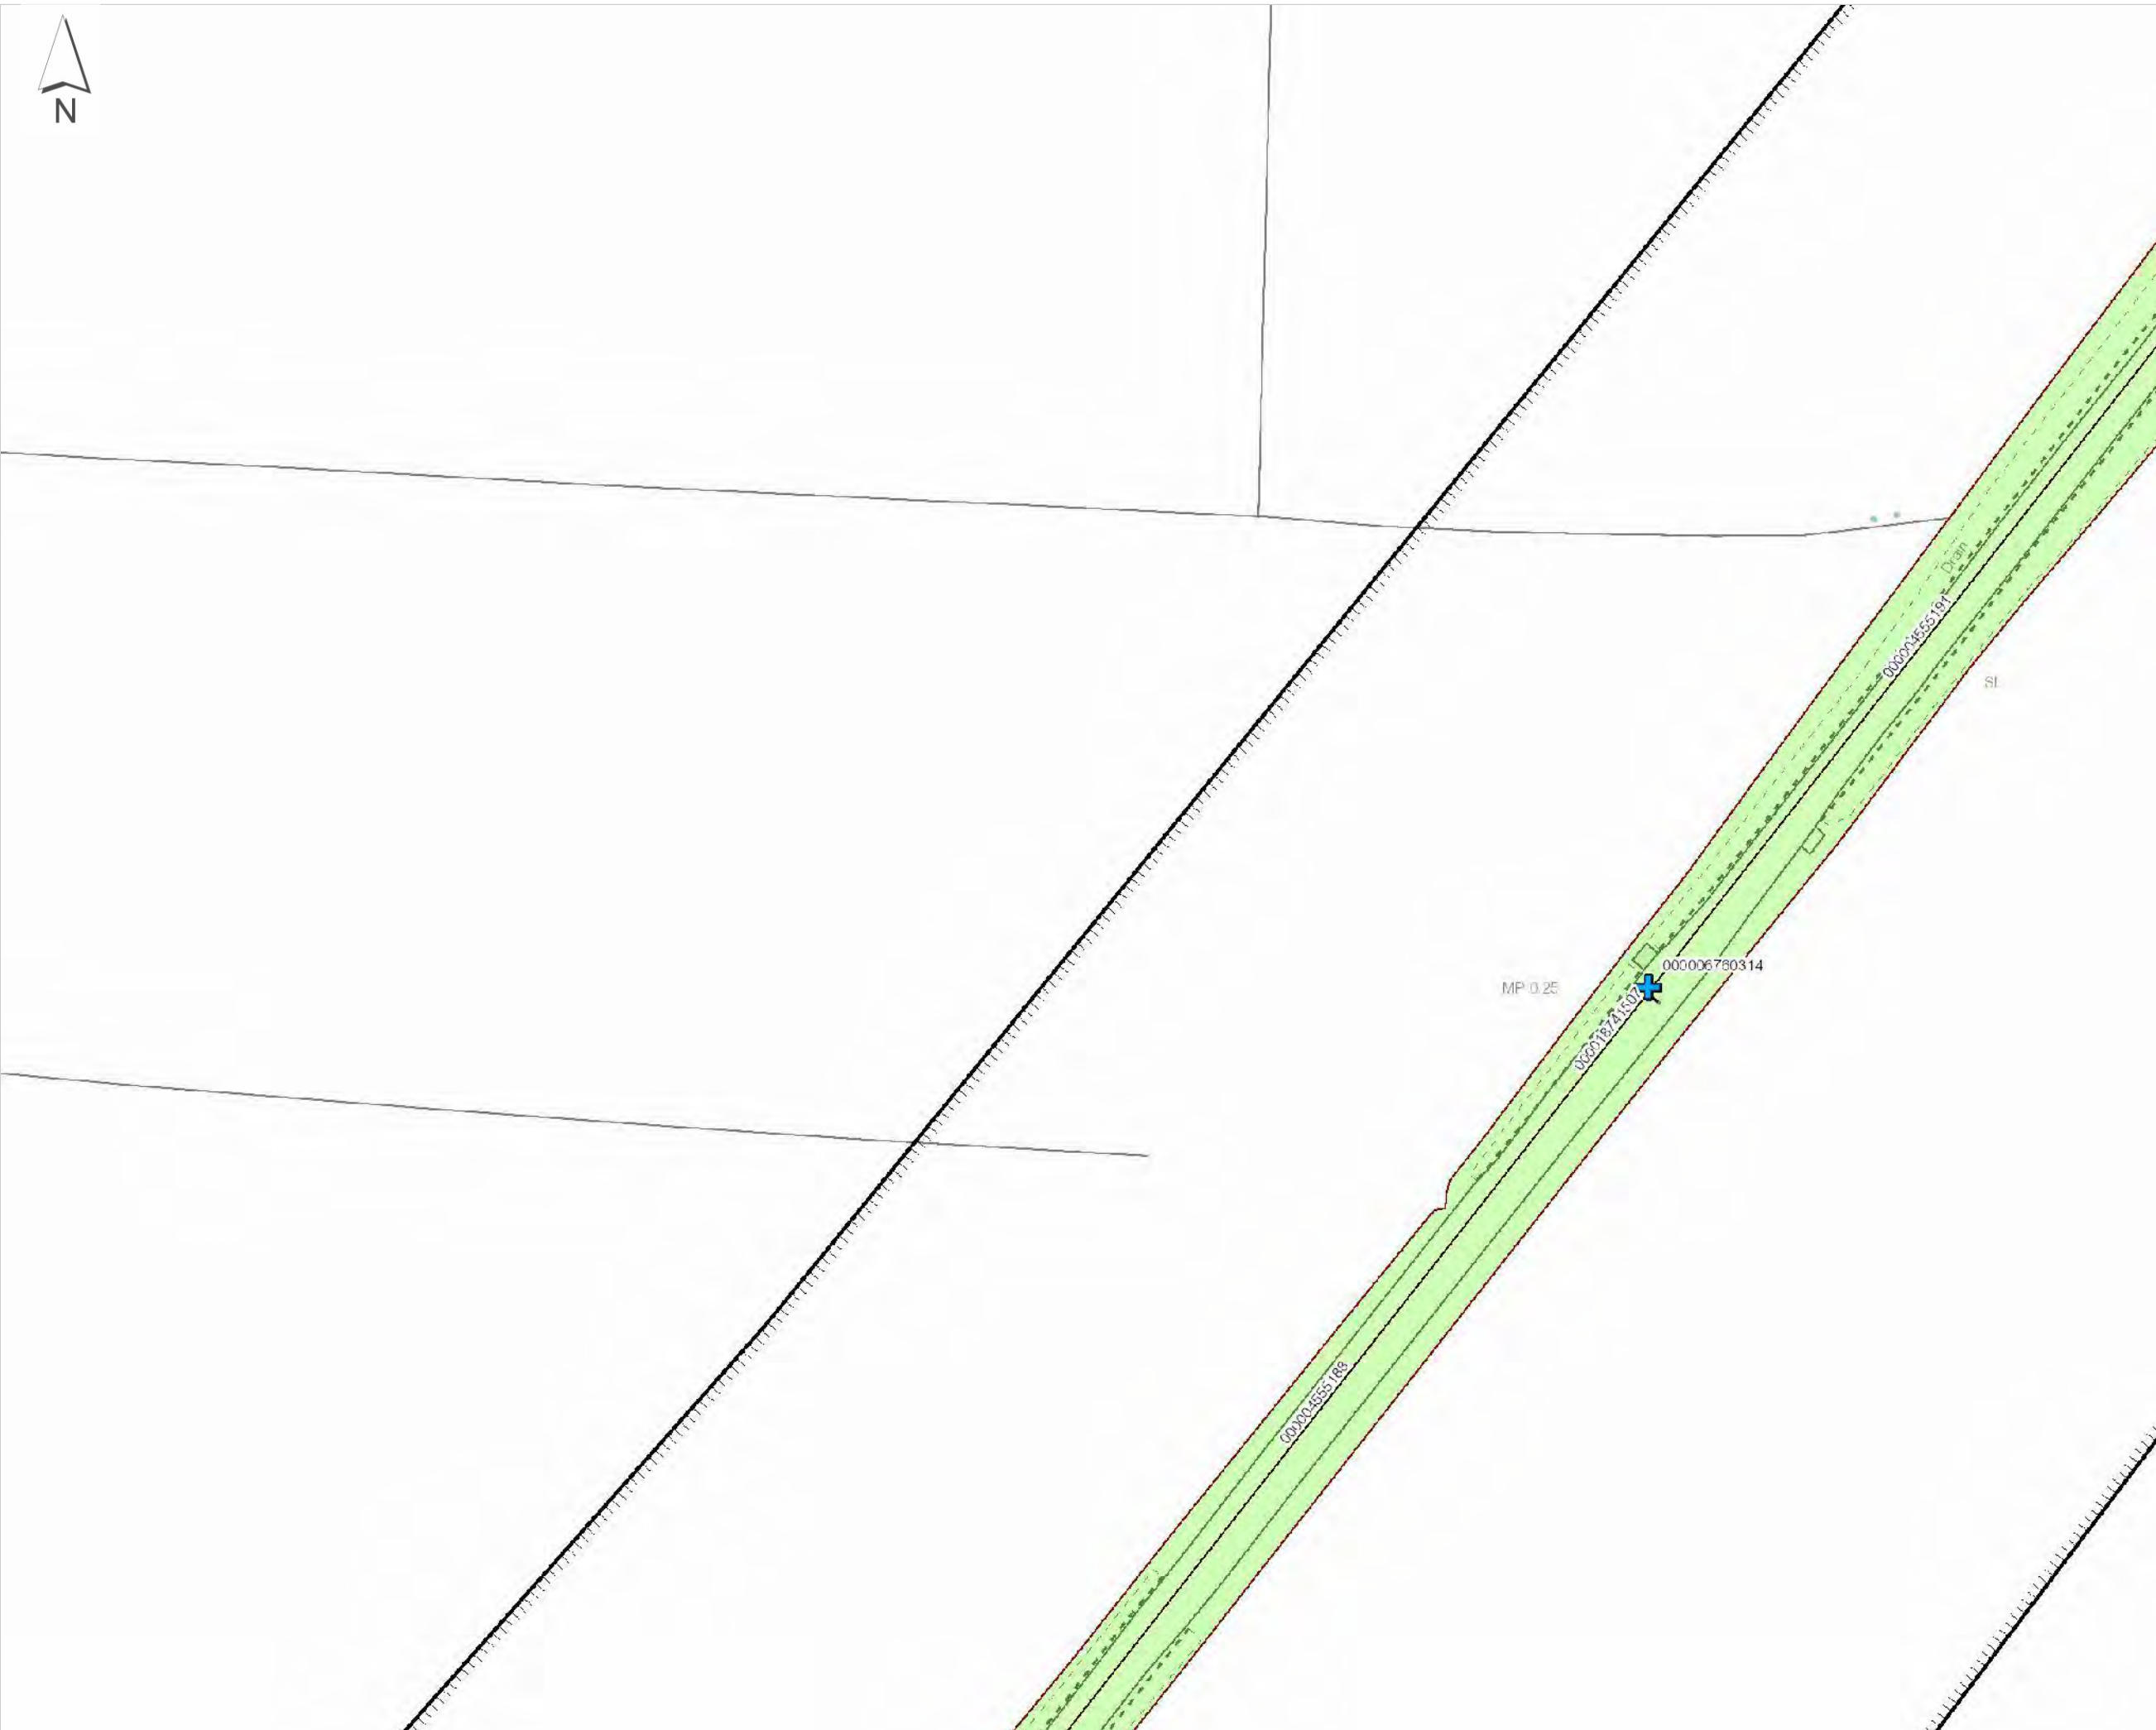

Order Ref: 168506
 Plot Scale: 1:1250
 Page Index: 11
 Centre X, Y: 476849, 383269
 Plot Date: 04/05/23



Crown copyright and database rights 2023
 Ordnance Survey 0100040692

Network Rail - Drainage



Legend

- Company Ownership**
 - Freehold Ownership
 - Leasehold Ownership
 - Prohibitive Interest
 - Bridge (Rail over Rail)
 - Bridge (Rail over River)
 - Bridge (Rail over Road)
 - Bridge (Road over Rail)
 - Level Crossing
 - Tunnel
 - Order Polygon
- DB Asset Line
- DC Asset Line
- Chamber (DD)
- Outfall (DK)
- Inflow (DL)
- Point (DM)
- Soakaway (DN)
- Pond (DY)
- Structure (DZ)
- Channel (ELR, Mileage)
- Channel (Coordinates)
- Covered Channel (ELR, Mileage)
- Covered Channel (Coordinates)
- Culvert (ELR, Mileage)
- Culvert (Coordinates)
- Granular Drain (ELR, Mileage)
- Granular Drain (Coordinates)
- Pipe (ELR and Mileage)
- Pipe (Coordinates)
- Syphon (ELR, Mileage)
- Syphon (Coordinates)

31.2m

28.0m

Order Ref: 168506
Plot Scale: 1:1250
Page Index: 12
Centre X, Y: 476849, 383587
Plot Date: 04/05/23



Crown copyright and database rights 2023
Ordnance Survey 0100040692

Network Rail - Drainage



Legend

- Company Ownership**
 - Freehold Ownership
 - Leasehold Ownership
 - Prohibitive Interest
 - Bridge (Rail over Rail)
 - Bridge (Rail over River)
 - Bridge (Rail over Road)
 - Bridge (Road over Rail)
 - Level Crossing
 - Tunnel
 - Order Polygon
- DB Asset Line
- DC Asset Line
- Chamber (DD)
- Outfall (DK)
- Inflow (DL)
- Point (DM)
- Soakaway (DN)
- Pond (DY)
- Structure (DZ)
- Channel (ELR, Mileage)
- Channel (Coordinates)
- Covered Channel (ELR, Mileage)
- Covered Channel (Coordinates)
- Culvert (ELR, Mileage)
- Culvert (Coordinates)
- Granular Drain (ELR, Mileage)
- Granular Drain (Coordinates)
- Pipe (ELR and Mileage)
- Pipe (Coordinates)
- Syphon (ELR, Mileage)
- Syphon (Coordinates)

Order Ref: 168506
Plot Scale: 1:1250
Page Index: 13
Centre X, Y: 477246, 381999
Plot Date: 04/05/23



Crown copyright and database
rights 2023
Ordnance Survey 0100040692

Network Rail - Drainage

Legend

- Company Ownership**
- Freehold Ownership
 - Leasehold Ownership
 - + Prohibitive Interest
 - Bridge (Rail over Rail)
 - Bridge (Rail over River)
 - Bridge (Rail over Road)
 - Bridge (Road over Rail)
 - Level Crossing
 - Tunnel
 - Order Polygon
- DB Asset Line**
- DB Asset Line
 - DC Asset Line
 - Chamber (DD)
 - ▲ Outfall (DK)
 - Inflow (DL)
 - + Point (DM)
 - ◆ Soakaway (DN)
 - ★ Pond (DY)
 - Structure (DZ)
- Channel (ELR, Mileage)**
- Channel (ELR, Mileage)
 - Channel (Coordinates)
 - Covered Channel (ELR, Mileage)
 - Covered Channel (Coordinates)
- Culvert (ELR, Mileage)**
- Culvert (ELR, Mileage)
 - Culvert (Coordinates)
- Granular Drain (ELR, Mileage)**
- Granular Drain (ELR, Mileage)
 - Granular Drain (Coordinates)
- Pipe (ELR and Mileage)**
- Pipe (ELR and Mileage)
 - Pipe (Coordinates)
- Syphon (ELR, Mileage)**
- Syphon (ELR, Mileage)
 - Syphon (Coordinates)

Order Ref: 168506
 Plot Scale: 1:1250
 Page Index: 14
 Centre X, Y: 477246, 382317
 Plot Date: 04/05/23



Crown copyright and database rights 2023
 Ordnance Survey 0100040692



Network Rail - Drainage



Legend

- Company Ownership**
 - Freehold Ownership
 - Leasehold Ownership
 - Prohibitive Interest
 - Bridge (Rail over Rail)
 - Bridge (Rail over River)
 - Bridge (Rail over Road)
 - Bridge (Road over Rail)
 - Level Crossing
 - Tunnel
 - Order Polygon
- DB Asset Line
- DC Asset Line
- Chamber (DD)
- Outfall (DK)
- Inflow (DL)
- Point (DM)
- Soakaway (DN)
- Pond (DY)
- Structure (DZ)
- Channel (ELR, Mileage)
- Channel (Coordinates)
- Covered Channel (ELR, Mileage)
- Covered Channel (Coordinates)
- Culvert (ELR, Mileage)
- Culvert (Coordinates)
- Granular Drain (ELR, Mileage)
- Granular Drain (Coordinates)
- Pipe (ELR and Mileage)
- Pipe (Coordinates)
- Syphon (ELR, Mileage)
- Syphon (Coordinates)

Order Ref: 168506
Plot Scale: 1:1250
Page Index: 15
Centre X, Y: 477246, 382634
Plot Date: 04/05/23



Crown copyright and database
rights 2023
Ordnance Survey 0100040692

Network Rail - Drainage

Legend

- Company Ownership**
- Freehold Ownership
 - Leasehold Ownership
 - Prohibitive Interest
 - Bridge (Rail over Rail)
 - Bridge (Rail over River)
 - Bridge (Rail over Road)
 - Bridge (Road over Rail)
 - Level Crossing
 - Tunnel
 - Order Polygon
- DB Asset Line**
- DB Asset Line
 - DC Asset Line
 - Chamber (DD)
 - Outfall (DK)
 - Inflow (DL)
 - Point (DM)
 - Soakaway (DN)
 - Pond (DY)
 - Structure (DZ)
- Channel (ELR, Mileage)**
- Channel (ELR, Mileage)
 - Channel (Coordinates)
 - Covered Channel (ELR, Mileage)
 - Covered Channel (Coordinates)
 - Culvert (ELR, Mileage)
 - Culvert (Coordinates)
 - Granular Drain (ELR, Mileage)
 - Granular Drain (Coordinates)
 - Pipe (ELR and Mileage)
 - Pipe (Coordinates)
 - Syphon (ELR, Mileage)
 - Syphon (Coordinates)

Order Ref: 168506
 Plot Scale: 1:1250
 Page Index: 16
 Centre X, Y: 477246, 383269
 Plot Date: 04/05/23



Crown copyright and database rights 2023
 Ordnance Survey 0100040692




Network Rail - Drainage



Legend

- Company Ownership**
- Freehold Ownership
 - Leasehold Ownership
 - + Prohibitive Interest
 - Bridge (Rail over Rail)
 - Bridge (Rail over River)
 - Bridge (Rail over Road)
 - Bridge (Road over Rail)
 - Level Crossing
 - Tunnel
 - Order Polygon
- DB Asset Line**
- DB Asset Line
 - DC Asset Line
 - Chamber (DD)
 - ▲ Outfall (DK)
 - Inflow (DL)
 - + Point (DM)
 - ◆ Soakaway (DN)
 - ★ Pond (DY)
 - Structure (DZ)
- Channel (ELR, Mileage)**
- Channel (ELR, Mileage)
 - Channel (Coordinates)
 - Covered Channel (ELR, Mileage)
 - Covered Channel (Coordinates)
 - Culvert (ELR, Mileage)
 - Culvert (Coordinates)
 - Granular Drain (ELR, Mileage)
 - Granular Drain (Coordinates)
 - Pipe (ELR and Mileage)
 - Pipe (Coordinates)
 - Syphon (ELR, Mileage)
 - Syphon (Coordinates)

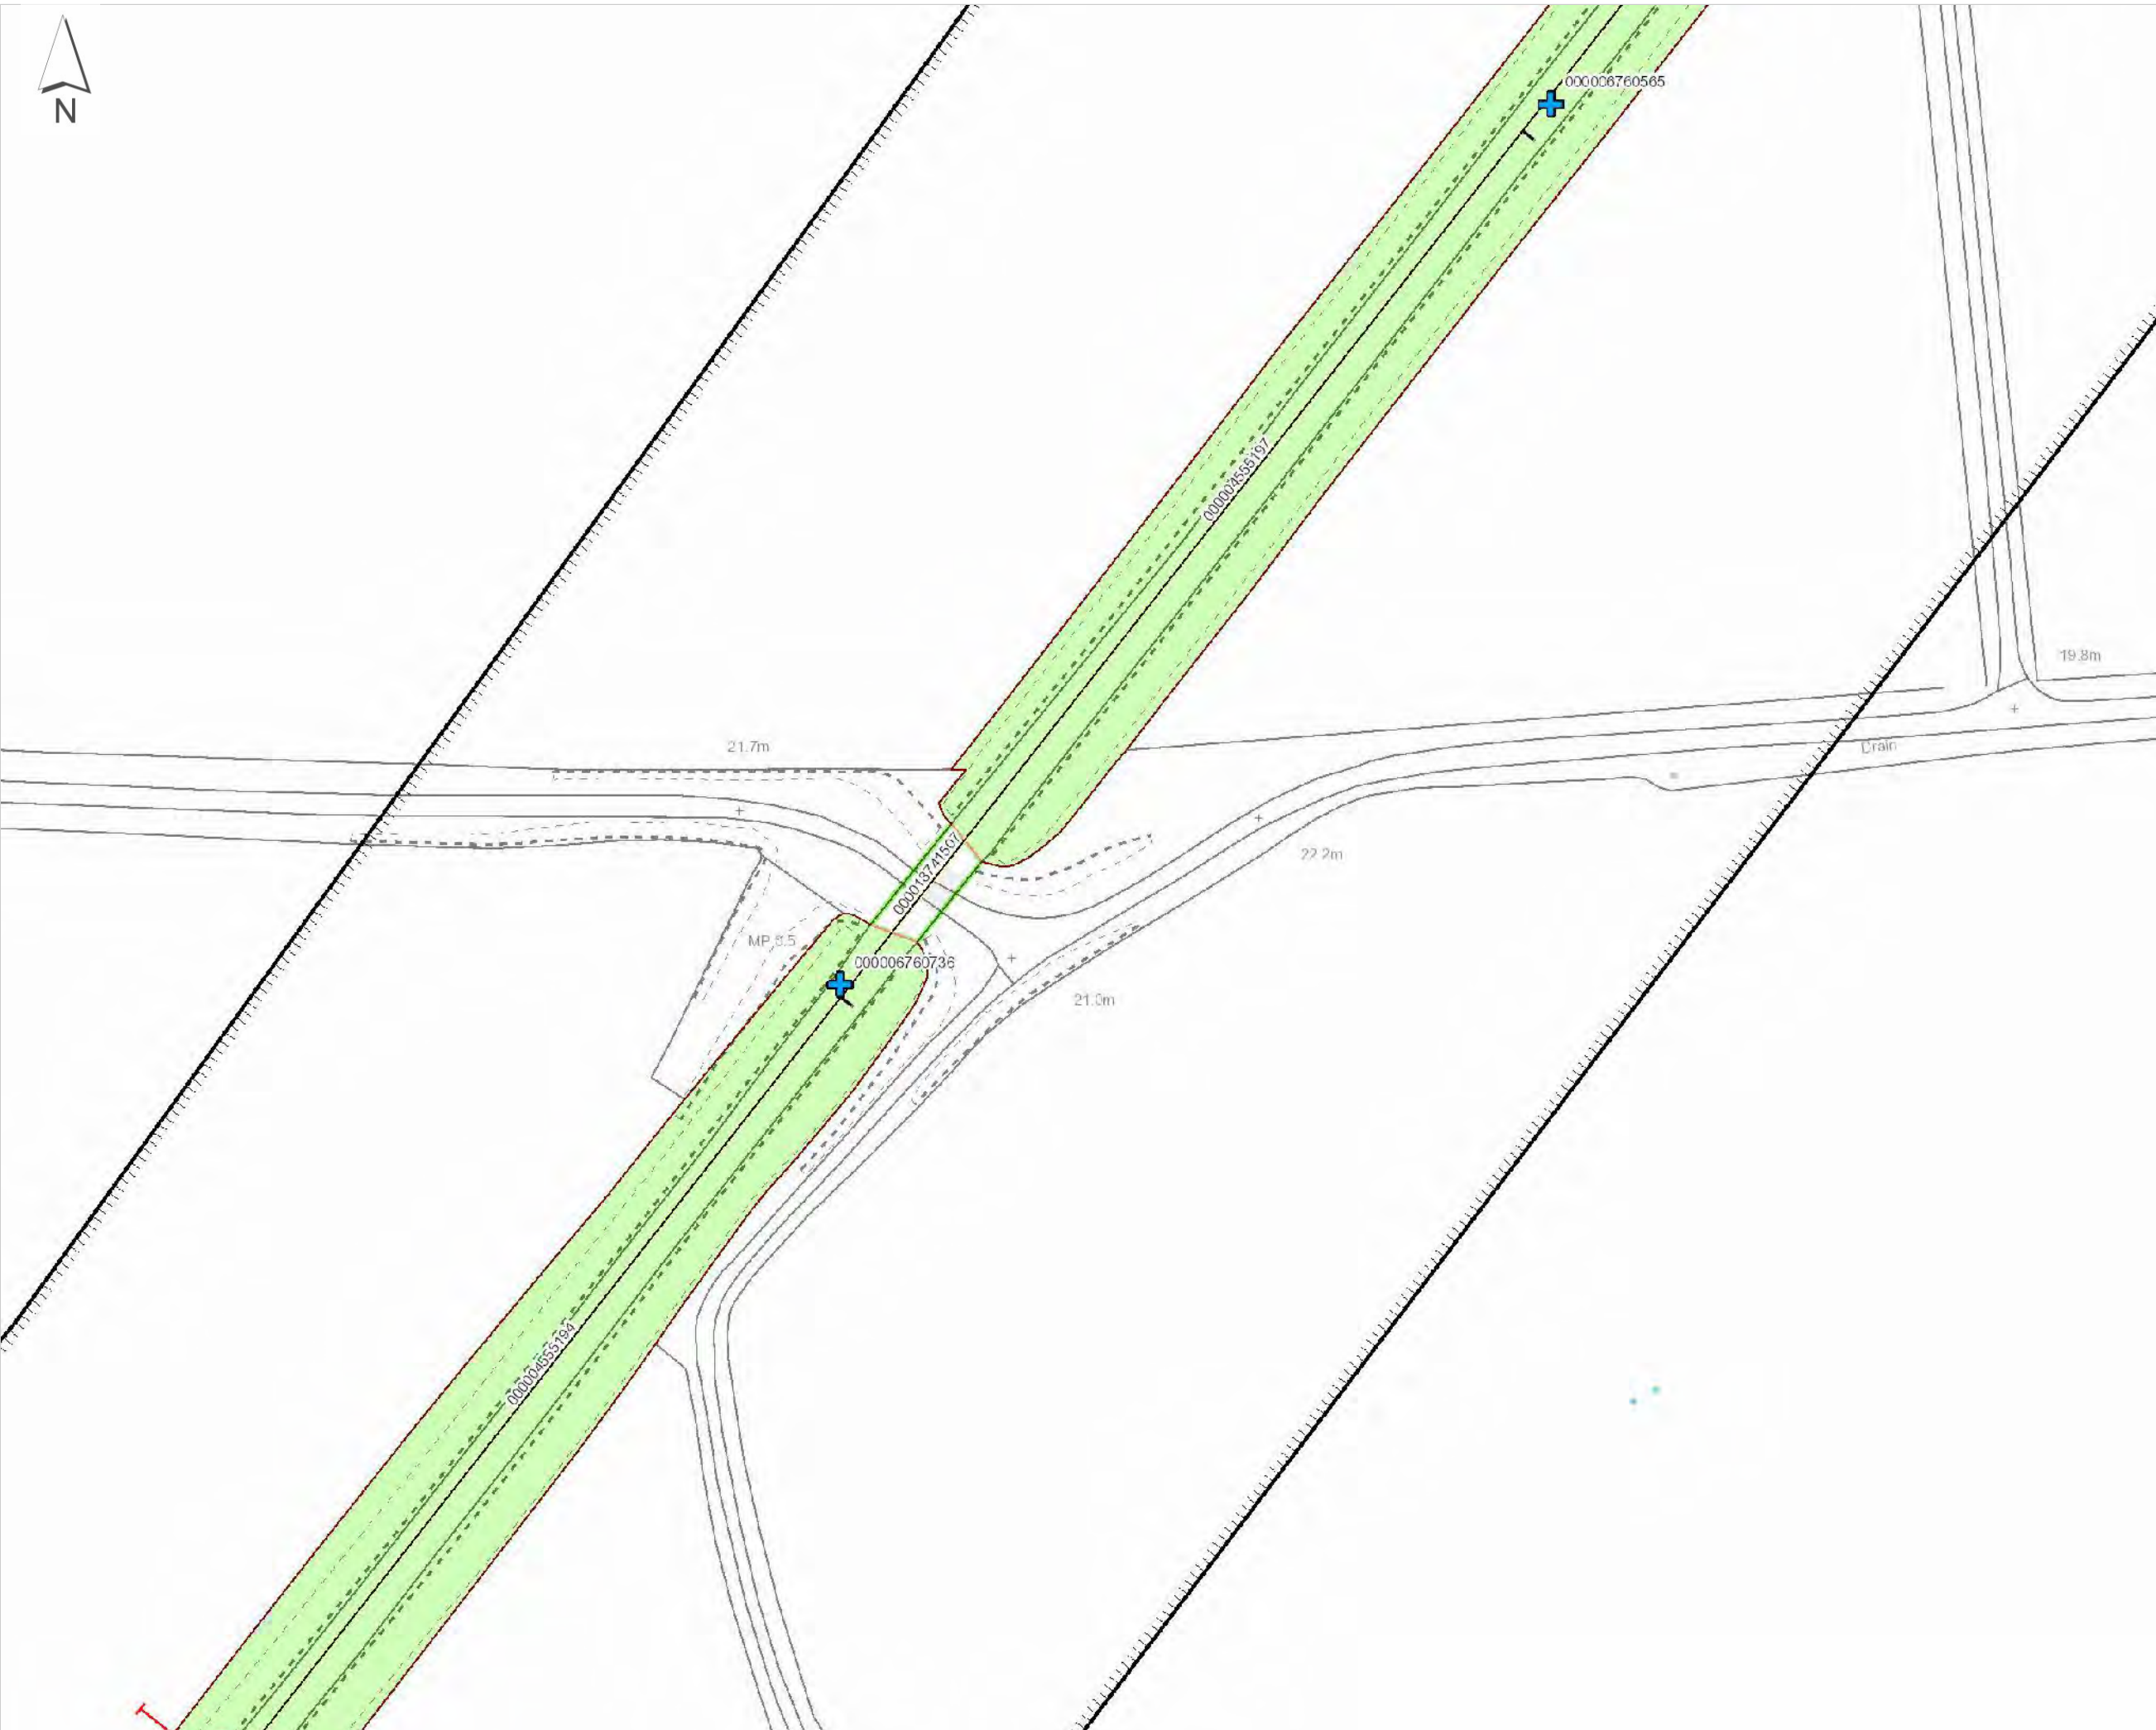

Order Ref: 168506
 Plot Scale: 1:1250
 Page Index: 17
 Centre X, Y: 477246, 383587
 Plot Date: 04/05/23



Crown copyright and database rights 2023
 Ordnance Survey 0100040692

Network Rail - Drainage

Legend

- Company Ownership**
- Freehold Ownership
 - Leasehold Ownership
 - Prohibitive Interest
 - Bridge (Rail over Rail)
 - Bridge (Rail over River)
 - Bridge (Rail over Road)
 - Bridge (Road over Rail)
 - Level Crossing
 - Tunnel
 - Order Polygon
- DB Asset Line**
- DB Asset Line
 - DC Asset Line
 - Chamber (DD)
 - ▲ Outfall (DK)
 - Inflow (DL)
 - + Point (DM)
 - ◆ Soakaway (DN)
 - ★ Pond (DY)
 - Structure (DZ)
 - Channel (ELR, Mileage)
 - Channel (Coordinates)
 - Covered Channel (ELR, Mileage)
 - Covered Channel (Coordinates)
 - Culvert (ELR, Mileage)
 - Culvert (Coordinates)
 - Granular Drain (ELR, Mileage)
 - Granular Drain (Coordinates)
 - Pipe (ELR and Mileage)
 - Pipe (Coordinates)
 - Syphon (ELR, Mileage)
 - Syphon (Coordinates)



Order Ref: 168506
 Plot Scale: 1:1250
 Page Index: 18
 Centre X, Y: 477246, 383904
 Plot Date: 04/05/23



Network Rail - Drainage

Legend

- Company Ownership**
- Freehold Ownership
 - Leasehold Ownership
 - Prohibitive Interest
 - Bridge (Rail over Rail)
 - Bridge (Rail over River)
 - Bridge (Rail over Road)
 - Bridge (Road over Rail)
 - Level Crossing
 - Tunnel
 - Order Polygon
- DB Asset Line**
- DB Asset Line
 - DC Asset Line
 - Chamber (DD)
 - ▲ Outfall (DK)
 - Inflow (DL)
 - + Point (DM)
 - ◆ Soakaway (DN)
 - ★ Pond (DY)
 - Structure (DZ)
 - Channel (ELR, Mileage)
 - Channel (Coordinates)
 - Covered Channel (ELR, Mileage)
 - Covered Channel (Coordinates)
 - Culvert (ELR, Mileage)
 - Culvert (Coordinates)
 - Granular Drain (ELR, Mileage)
 - Granular Drain (Coordinates)
 - Pipe (ELR and Mileage)
 - Pipe (Coordinates)
 - Syphon (ELR, Mileage)
 - Syphon (Coordinates)



Order Ref: 168506
 Plot Scale: 1:1250
 Page Index: 19
 Centre X, Y: 477642, 381999
 Plot Date: 04/05/23



Network Rail - Drainage



Legend

- Company Ownership**
- Freehold Ownership
 - Leasehold Ownership
 - Prohibitive Interest
 - Bridge (Rail over Rail)
 - Bridge (Rail over River)
 - Bridge (Rail over Road)
 - Bridge (Road over Rail)
 - Level Crossing
 - Tunnel
 - Order Polygon
-
- ✦ DB Asset Line
 - ┌ DC Asset Line
 - Chamber (DD)
 - ▲ Outfall (DK)
 - Inflow (DL)
 - + Point (DM)
 - ◆ Soakaway (DN)
 - ★ Pond (DY)
 - Structure (DZ)
 - ┌ Channel (ELR, Mileage)
 - └ Channel (Coordinates)
 - ┌ Covered Channel (ELR, Mileage)
 - └ Covered Channel (Coordinates)
 - ┌ Culvert (ELR, Mileage)
 - └ Culvert (Coordinates)
 - ┌ Granular Drain (ELR, Mileage)
 - └ Granular Drain (Coordinates)
 - ┌ Pipe (ELR and Mileage)
 - └ Pipe (Coordinates)
 - ┌ Syphon (ELR, Mileage)
 - └ Syphon (Coordinates)



Order Ref: 168506
 Plot Scale: 1:1250
 Page Index: 20
 Centre X, Y: 477642, 382317
 Plot Date: 04/05/23




Crown copyright and database rights 2023
 Ordnance Survey 0100040692

Network Rail - Drainage

Legend

- Company Ownership**
- Freehold Ownership
 - Leasehold Ownership
 - Prohibitive Interest
 - Bridge (Rail over Rail)
 - Bridge (Rail over River)
 - Bridge (Rail over Road)
 - Bridge (Road over Rail)
 - Level Crossing
 - Tunnel
 - Order Polygon
- DB Asset Line**
- DB Asset Line
- DC Asset Line**
- DC Asset Line
- Chamber (DD)
 - Outfall (DK)
 - Inflow (DL)
 - Point (DM)
 - Soakaway (DN)
 - Pond (DY)
 - Structure (DZ)
 - Channel (ELR, Mileage)
 - Channel (Coordinates)
 - Covered Channel (ELR, Mileage)
 - Covered Channel (Coordinates)
 - Culvert (ELR, Mileage)
 - Culvert (Coordinates)
 - Granular Drain (ELR, Mileage)
 - Granular Drain (Coordinates)
 - Pipe (ELR and Mileage)
 - Pipe (Coordinates)
 - Syphon (ELR, Mileage)
 - Syphon (Coordinates)

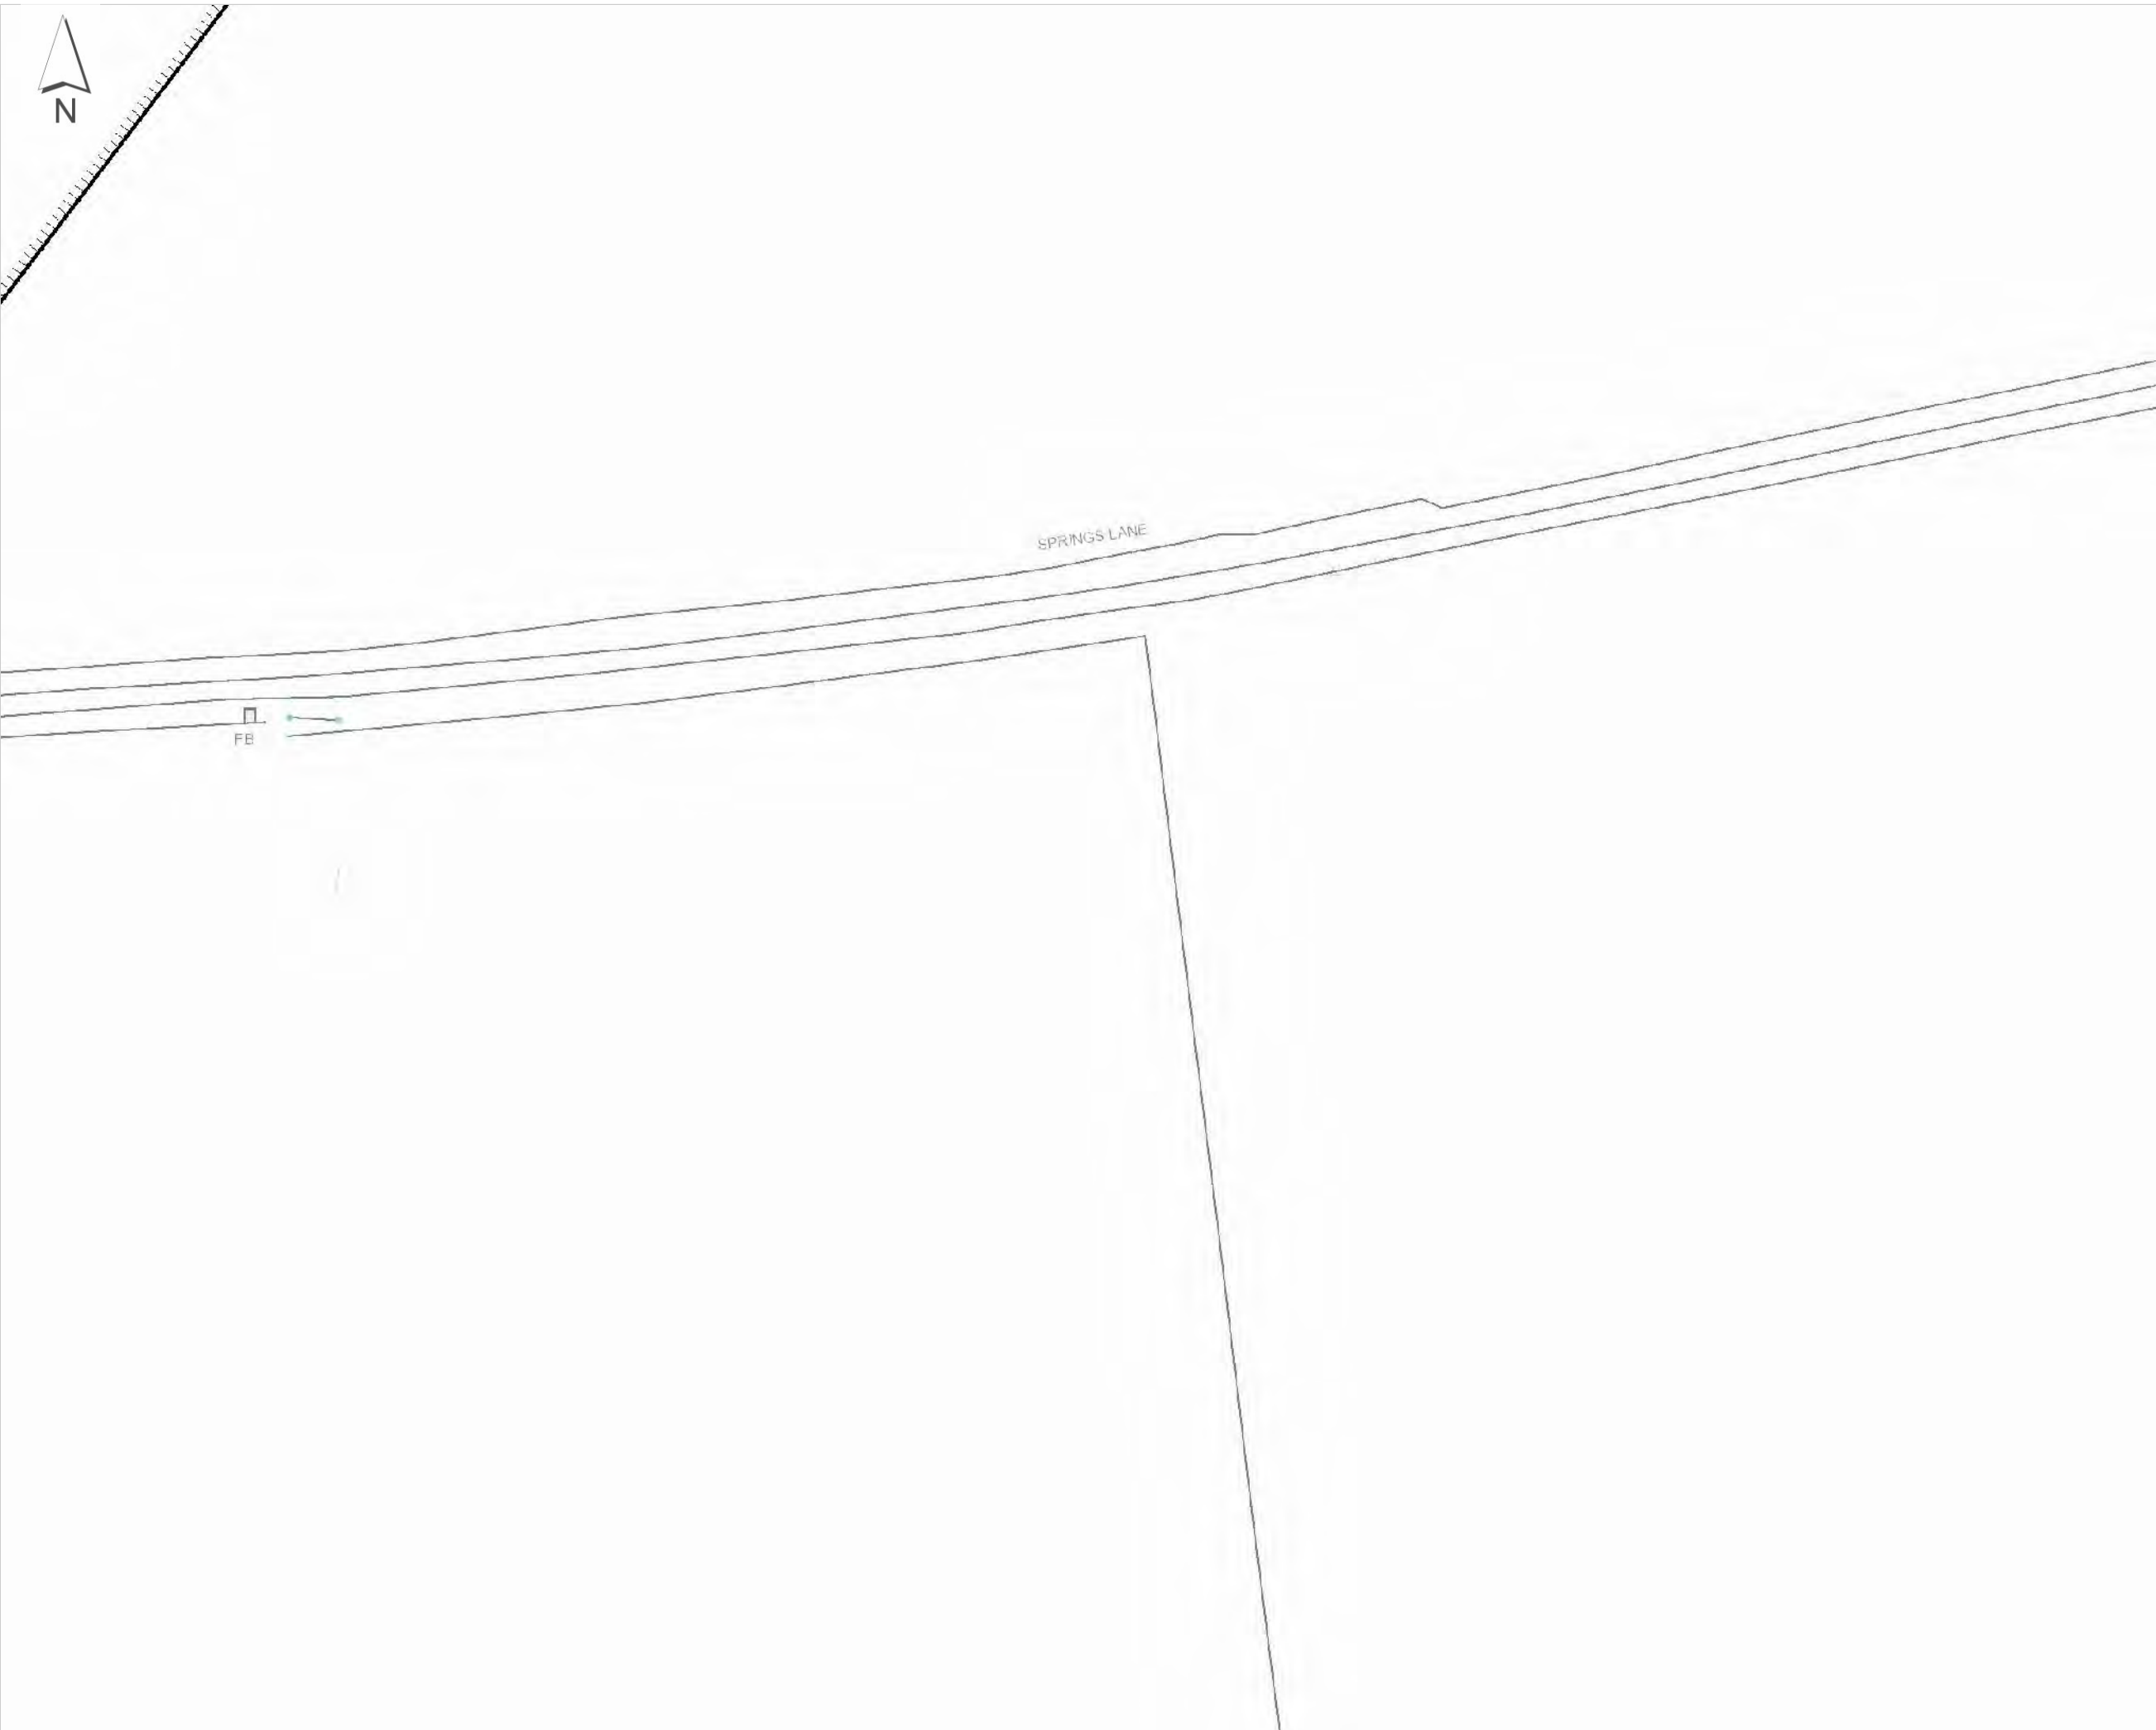

Order Ref: 168506
 Plot Scale: 1:1250
 Page Index: 21
 Centre X, Y: 477642, 383587
 Plot Date: 04/05/23



Network Rail - Drainage

Legend

- Company Ownership**
- Freehold Ownership
 - Leasehold Ownership
 - + Prohibitive Interest
 - Bridge (Rail over Rail)
 - Bridge (Rail over River)
 - Bridge (Rail over Road)
 - Bridge (Road over Rail)
 - Level Crossing
 - Tunnel
 - Order Polygon
- DB Asset Line**
- DB Asset Line
 - DC Asset Line
 - Chamber (DD)
 - ▲ Outfall (DK)
 - Inflow (DL)
 - + Point (DM)
 - ◆ Soakaway (DN)
 - ★ Pond (DY)
 - Structure (DZ)
 - Channel (ELR, Mileage)
 - Channel (Coordinates)
 - Covered Channel (ELR, Mileage)
 - Covered Channel (Coordinates)
 - Culvert (ELR, Mileage)
 - Culvert (Coordinates)
 - Granular Drain (ELR, Mileage)
 - Granular Drain (Coordinates)
 - Pipe (ELR and Mileage)
 - Pipe (Coordinates)
 - Syphon (ELR, Mileage)
 - Syphon (Coordinates)



Order Ref: 168506
 Plot Scale: 1:1250
 Page Index: 22
 Centre X, Y: 477642, 383904
 Plot Date: 04/05/23



Crown copyright and database rights 2023
 Ordnance Survey 0100040692

Network Rail - Drainage



Legend

- Company Ownership**
- Freehold Ownership
 - Leasehold Ownership
 - + Prohibitive Interest
 - Bridge (Rail over Rail)
 - Bridge (Rail over River)
 - Bridge (Rail over Road)
 - Bridge (Road over Rail)
 - Level Crossing
 - Tunnel
 - Order Polygon
- DB Asset Line**
- + DB Asset Line
 - DC Asset Line
 - Chamber (DD)
 - ▲ Outfall (DK)
 - Inflow (DL)
 - + Point (DM)
 - ◆ Soakaway (DN)
 - ★ Pond (DY)
 - Structure (DZ)
 - ┌ Channel (ELR, Mileage)
 - └ Channel (Coordinates)
 - ┌ Covered Channel (ELR, Mileage)
 - └ Covered Channel (Coordinates)
 - ┌ Culvert (ELR, Mileage)
 - └ Culvert (Coordinates)
 - ┌ Granular Drain (ELR, Mileage)
 - └ Granular Drain (Coordinates)
 - ┌ Pipe (ELR and Mileage)
 - └ Pipe (Coordinates)
 - ┌ Syphon (ELR, Mileage)
 - └ Syphon (Coordinates)



Order Ref: 168506
 Plot Scale: 1:1250
 Page Index: 23
 Centre X, Y: 477642, 384222
 Plot Date: 04/05/23



Crown copyright and database rights 2023
 Ordnance Survey 0100040692

Network Rail - Drainage



Legend

- Company Ownership**
 - Freehold Ownership
 - Leasehold Ownership
 - Prohibitive Interest
 - Bridge (Rail over Rail)
 - Bridge (Rail over River)
 - Bridge (Rail over Road)
 - Bridge (Road over Rail)
 - Level Crossing
 - Tunnel
 - Order Polygon
- DB Asset Line
- DC Asset Line
- Chamber (DD)
- Outfall (DK)
- Inflow (DL)
- Point (DM)
- Soakaway (DN)
- Pond (DY)
- Structure (DZ)
- Channel (ELR, Mileage)
- Channel (Coordinates)
- Covered Channel (ELR, Mileage)
- Covered Channel (Coordinates)
- Culvert (ELR, Mileage)
- Culvert (Coordinates)
- Granular Drain (ELR, Mileage)
- Granular Drain (Coordinates)
- Pipe (ELR and Mileage)
- Pipe (Coordinates)
- Syphon (ELR, Mileage)
- Syphon (Coordinates)

Order Ref: 168506
Plot Scale: 1:1250
Page Index: 24
Centre X, Y: 477642, 384539
Plot Date: 04/05/23



Crown copyright and database rights 2023
Ordnance Survey 0100040692

Network Rail - Drainage

Legend

- Company Ownership**
- Freehold Ownership
 - Leasehold Ownership
 - Prohibitive Interest
 - Bridge (Rail over Rail)
 - Bridge (Rail over River)
 - Bridge (Rail over Road)
 - Bridge (Road over Rail)
 - Level Crossing
 - Tunnel
 - Order Polygon
- DB Asset Line**
- DC Asset Line
 - Chamber (DD)
 - ▲ Outfall (DK)
 - Inflow (DL)
 - + Point (DM)
 - ◆ Soakaway (DN)
 - ★ Pond (DY)
 - Structure (DZ)
- Channel (ELR, Mileage)**
- Channel (ELR, Mileage)
 - Channel (Coordinates)
- Covered Channel (ELR, Mileage)**
- Covered Channel (ELR, Mileage)
 - Covered Channel (Coordinates)
- Culvert (ELR, Mileage)**
- Culvert (ELR, Mileage)
 - Culvert (Coordinates)
- Granular Drain (ELR, Mileage)**
- Granular Drain (ELR, Mileage)
 - Granular Drain (Coordinates)
- Pipe (ELR and Mileage)**
- Pipe (ELR and Mileage)
 - Pipe (Coordinates)
- Syphon (ELR, Mileage)**
- Syphon (ELR, Mileage)
 - Syphon (Coordinates)



Order Ref: 168506
 Plot Scale: 1:1250
 Page Index: 25
 Centre X, Y: 478039, 381999
 Plot Date: 04/05/23



Crown copyright and database rights 2023
 Ordnance Survey 0100040692

Network Rail - Drainage



Legend

- Company Ownership**
 - Freehold Ownership
 - Leasehold Ownership
 - Prohibitive Interest
 - Bridge (Rail over Rail)
 - Bridge (Rail over River)
 - Bridge (Rail over Road)
 - Bridge (Road over Rail)
 - Level Crossing
 - Tunnel
 - Order Polygon
- DB Asset Line
- DC Asset Line
- Chamber (DD)
- Outfall (DK)
- Inflow (DL)
- Point (DM)
- Soakaway (DN)
- Pond (DY)
- Structure (DZ)
- Channel (ELR, Mileage)
- Channel (Coordinates)
- Covered Channel (ELR, Mileage)
- Covered Channel (Coordinates)
- Culvert (ELR, Mileage)
- Culvert (Coordinates)
- Granular Drain (ELR, Mileage)
- Granular Drain (Coordinates)
- Pipe (ELR and Mileage)
- Pipe (Coordinates)
- Syphon (ELR, Mileage)
- Syphon (Coordinates)

Order Ref: 168506
Plot Scale: 1:1250
Page Index: 26
Centre X, Y: 478039, 382317
Plot Date: 04/05/23



Crown copyright and database rights 2023
Ordnance Survey 0100040692
























Network Rail - Drainage

Legend

Company Ownership

-  Freehold Ownership
-  Leasehold Ownership
-  Prohibitive Interest
-  Bridge (Rail over Rail)
-  Bridge (Rail over River)
-  Bridge (Rail over Road)
-  Bridge (Road over Rail)
-  Level Crossing
-  Tunnel
-  Order Polygon

-  DB Asset Line
-  DC Asset Line
-  Chamber (DD)
-  Outfall (DK)
-  Inflow (DL)
-  Point (DM)
-  Soakaway (DN)
-  Pond (DY)
-  Structure (DZ)
-  Channel (ELR, Mileage)
-  Channel (Coordinates)
-  Covered Channel (ELR, Mileage)
-  Covered Channel (Coordinates)
-  Culvert (ELR, Mileage)
-  Culvert (Coordinates)
-  Granular Drain (ELR, Mileage)
-  Granular Drain (Coordinates)
-  Pipe (ELR and Mileage)
-  Pipe (Coordinates)
-  Syphon (ELR, Mileage)
-  Syphon (Coordinates)

Order Ref: 168506
Plot Scale: 1:1250
Page Index: 27
Centre X, Y: 478039, 384222
Plot Date: 04/05/23



Network Rail - Drainage

Legend

- Company Ownership**
- Freehold Ownership
 - Leasehold Ownership
 - Prohibitive Interest
 - Bridge (Rail over Rail)
 - Bridge (Rail over River)
 - Bridge (Rail over Road)
 - Bridge (Road over Rail)
 - Level Crossing
 - Tunnel
- Order Polygon**
- ✦ DB Asset Line
 - ┌ DC Asset Line
 - Chamber (DD)
 - ▲ Outfall (DK)
 - Inflow (DL)
 - + Point (DM)
 - ◆ Soakaway (DN)
 - ★ Pond (DY)
 - Structure (DZ)
 - ┌ Channel (ELR, Mileage)
 - ┌ Channel (Coordinates)
 - ┌ Covered Channel (ELR, Mileage)
 - ┌ Covered Channel (Coordinates)
 - ┌ Culvert (ELR, Mileage)
 - ┌ Culvert (Coordinates)
 - ┌ Granular Drain (ELR, Mileage)
 - ┌ Granular Drain (Coordinates)
 - ┌ Pipe (ELR and Mileage)
 - ┌ Pipe (Coordinates)
 - ┌ Syphon (ELR, Mileage)
 - ┌ Syphon (Coordinates)



Order Ref: 168506
 Plot Scale: 1:1250
 Page Index: 28
 Centre X, Y: 478039, 384539
 Plot Date: 04/05/23



Crown copyright and database rights 2023
 Ordnance Survey 0100040692

Network Rail - Drainage



Legend

- Company Ownership**
- Freehold Ownership
 - Leasehold Ownership
 - Prohibitive Interest
 - Bridge (Rail over Rail)
 - Bridge (Rail over River)
 - Bridge (Rail over Road)
 - Bridge (Road over Rail)
 - Level Crossing
 - Tunnel
 - Order Polygon
- DB Asset Line**
- ✦ DB Asset Line
 - ┌ DC Asset Line
 - Chamber (DD)
 - ▲ Outfall (DK)
 - Inflow (DL)
 - + Point (DM)
 - ◆ Soakaway (DN)
 - ★ Pond (DY)
 - Structure (DZ)
- Channel (ELR, Mileage)**
- ┌ Channel (ELR, Mileage)
 - ┌ Channel (Coordinates)
 - ┌ Covered Channel (ELR, Mileage)
 - ┌ Covered Channel (Coordinates)
 - ┌ Culvert (ELR, Mileage)
 - ┌ Culvert (Coordinates)
 - ┌ Granular Drain (ELR, Mileage)
 - ┌ Granular Drain (Coordinates)
 - ┌ Pipe (ELR and Mileage)
 - ┌ Pipe (Coordinates)
 - ┌ Syphon (ELR, Mileage)
 - ┌ Syphon (Coordinates)



Order Ref: 168506
 Plot Scale: 1:1250
 Page Index: 29
 Centre X, Y: 478039, 384857
 Plot Date: 04/05/23



Crown copyright and database rights 2023
 Ordnance Survey 0100040692

Network Rail - Drainage

Legend

- Company Ownership**
- Freehold Ownership
 - Leasehold Ownership
 - + Prohibitive Interest
 - Bridge (Rail over Rail)
 - Bridge (Rail over River)
 - Bridge (Rail over Road)
 - Bridge (Road over Rail)
 - Level Crossing
 - Tunnel
 - Order Polygon
- DB Asset Line**
- + DB Asset Line
- DC Asset Line**
- ┌ DC Asset Line
- Chamber (DD)**
- Chamber (DD)
- Outfall (DK)**
- ▲ Outfall (DK)
- Inflow (DL)**
- Inflow (DL)
- Point (DM)**
- + Point (DM)
- Soakaway (DN)**
- ◆ Soakaway (DN)
- Pond (DY)**
- ★ Pond (DY)
- Structure (DZ)**
- Structure (DZ)
- Channel (ELR, Mileage)**
- ┌ Channel (ELR, Mileage)
- Channel (Coordinates)**
- ┌ Channel (Coordinates)
- Covered Channel (ELR, Mileage)**
- ┌ Covered Channel (ELR, Mileage)
- Covered Channel (Coordinates)**
- ┌ Covered Channel (Coordinates)
- Culvert (ELR, Mileage)**
- ┌ Culvert (ELR, Mileage)
- Culvert (Coordinates)**
- ┌ Culvert (Coordinates)
- Granular Drain (ELR, Mileage)**
- ┌ Granular Drain (ELR, Mileage)
- Granular Drain (Coordinates)**
- ┌ Granular Drain (Coordinates)
- Pipe (ELR and Mileage)**
- ┌ Pipe (ELR and Mileage)
- Pipe (Coordinates)**
- ┌ Pipe (Coordinates)
- Syphon (ELR, Mileage)**
- ┌ Syphon (ELR, Mileage)
- Syphon (Coordinates)**
- ┌ Syphon (Coordinates)

Order Ref: 168506
 Plot Scale: 1:1250
 Page Index: 30
 Centre X, Y: 478436, 384857
 Plot Date: 04/05/23



Crown copyright and database rights 2023
 Ordnance Survey 0100040692



Network Rail - Drainage



Legend

- Company Ownership**
- Freehold Ownership
 - Leasehold Ownership
 - + Prohibitive Interest
 - Bridge (Rail over Rail)
 - Bridge (Rail over River)
 - Bridge (Rail over Road)
 - Bridge (Road over Rail)
 - Level Crossing
 - Tunnel
 - Order Polygon
- DB Asset Line**
- DB Asset Line
 - DC Asset Line
 - Chamber (DD)
 - ▲ Outfall (DK)
 - Inflow (DL)
 - + Point (DM)
 - ◆ Soakaway (DN)
 - ★ Pond (DY)
 - Structure (DZ)
- Channel (ELR, Mileage)**
- Channel (ELR, Mileage)
 - Channel (Coordinates)
- Covered Channel (ELR, Mileage)**
- Covered Channel (ELR, Mileage)
 - Covered Channel (Coordinates)
- Culvert (ELR, Mileage)**
- Culvert (ELR, Mileage)
 - Culvert (Coordinates)
- Granular Drain (ELR, Mileage)**
- Granular Drain (ELR, Mileage)
 - Granular Drain (Coordinates)
- Pipe (ELR and Mileage)**
- Pipe (ELR and Mileage)
 - Pipe (Coordinates)
- Syphon (ELR, Mileage)**
- Syphon (ELR, Mileage)
 - Syphon (Coordinates)

Order Ref: 168506
 Plot Scale: 1:1250
 Page Index: 31
 Centre X, Y: 478436, 385174
 Plot Date: 04/05/23



Network Rail - Drainage



Legend

- Company Ownership**
- Freehold Ownership
 - Leasehold Ownership
 - Prohibitive Interest
 - Bridge (Rail over Rail)
 - Bridge (Rail over River)
 - Bridge (Rail over Road)
 - Bridge (Road over Rail)
 - Level Crossing
 - Tunnel
 - Order Polygon
- DB Asset Line**
- DB Asset Line
 - DC Asset Line
 - Chamber (DD)
 - Outfall (DK)
 - Inflow (DL)
 - Point (DM)
 - Soakaway (DN)
 - Pond (DY)
 - Structure (DZ)
 - Channel (ELR, Mileage)
 - Channel (Coordinates)
 - Covered Channel (ELR, Mileage)
 - Covered Channel (Coordinates)
 - Culvert (ELR, Mileage)
 - Culvert (Coordinates)
 - Granular Drain (ELR, Mileage)
 - Granular Drain (Coordinates)
 - Pipe (ELR and Mileage)
 - Pipe (Coordinates)
 - Syphon (ELR, Mileage)
 - Syphon (Coordinates)



Order Ref: 168506
 Plot Scale: 1:1250
 Page Index: 32
 Centre X, Y: 478436, 385492
 Plot Date: 04/05/23



Crown copyright and database rights 2023
 Ordnance Survey 0100040692

Network Rail - Drainage

Legend

- Company Ownership**
 - Freehold Ownership
 - Leasehold Ownership
 - Prohibitive Interest
 - Bridge (Rail over Rail)
 - Bridge (Rail over River)
 - Bridge (Rail over Road)
 - Bridge (Road over Rail)
 - Level Crossing
 - Tunnel
 - Order Polygon
- DB Asset Line
- DC Asset Line
- Chamber (DD)
- Outfall (DK)
- Inflow (DL)
- Point (DM)
- Soakaway (DN)
- Pond (DY)
- Structure (DZ)
- Channel (ELR, Mileage)
- Channel (Coordinates)
- Covered Channel (ELR, Mileage)
- Covered Channel (Coordinates)
- Culvert (ELR, Mileage)
- Culvert (Coordinates)
- Granular Drain (ELR, Mileage)
- Granular Drain (Coordinates)
- Pipe (ELR and Mileage)
- Pipe (Coordinates)
- Syphon (ELR, Mileage)
- Syphon (Coordinates)

Order Ref: 168506
Plot Scale: 1:1250
Page Index: 33
Centre X, Y: 478833, 385174
Plot Date: 04/05/23



Crown copyright and database rights 2023
Ordnance Survey 0100040692



Network Rail - Drainage

Legend

- Company Ownership**
- Freehold Ownership
 - Leasehold Ownership
 - + Prohibitive Interest
 - Bridge (Rail over Rail)
 - Bridge (Rail over River)
 - Bridge (Rail over Road)
 - Bridge (Road over Rail)
 - Level Crossing
 - Tunnel
 - Order Polygon
-
- + DB Asset Line
 - ┌ DC Asset Line
 - Chamber (DD)
 - ▲ Outfall (DK)
 - Inflow (DL)
 - + Point (DM)
 - ◆ Soakaway (DN)
 - ★ Pond (DY)
 - Structure (DZ)
 - ┌ Channel (ELR, Mileage)
 - ┌ Channel (Coordinates)
 - ┌ Covered Channel (ELR, Mileage)
 - ┌ Covered Channel (Coordinates)
 - ┌ Culvert (ELR, Mileage)
 - ┌ Culvert (Coordinates)
 - ┌ Granular Drain (ELR, Mileage)
 - ┌ Granular Drain (Coordinates)
 - ┌ Pipe (ELR and Mileage)
 - ┌ Pipe (Coordinates)
 - ┌ Syphon (ELR, Mileage)
 - ┌ Syphon (Coordinates)



Order Ref: 168506
 Plot Scale: 1:1250
 Page Index: 34
 Centre X, Y: 478833, 385492
 Plot Date: 04/05/23



Crown copyright and database rights 2023
 Ordnance Survey 0100040692

Network Rail - Drainage

Legend



- Company Ownership**
- Freehold Ownership
 - Leasehold Ownership
 - + Prohibitive Interest
 - Bridge (Rail over Rail)
 - Bridge (Rail over River)
 - Bridge (Rail over Road)
 - Bridge (Road over Rail)
 - Level Crossing
 - Tunnel
- Order Polygon**
- ⊢ DB Asset Line
 - ┌ DC Asset Line
 - Chamber (DD)
 - ▲ Outfall (DK)
 - Inflow (DL)
 - + Point (DM)
 - ◆ Soakaway (DN)
 - ★ Pond (DY)
 - Structure (DZ)
 - ┌ Channel (ELR, Mileage)
 - ┌ Channel (Coordinates)
 - ┌ Covered Channel (ELR, Mileage)
 - ┌ Covered Channel (Coordinates)
 - ┌ Culvert (ELR, Mileage)
 - ┌ Culvert (Coordinates)
 - ┌ Granular Drain (ELR, Mileage)
 - ┌ Granular Drain (Coordinates)
 - ┌ Pipe (ELR and Mileage)
 - ┌ Pipe (Coordinates)
 - ┌ Syphon (ELR, Mileage)
 - ┌ Syphon (Coordinates)







Order Ref: 168506
 Plot Scale: 1:1250
 Page Index: 35
 Centre X, Y: 478833, 385809
 Plot Date: 04/05/23



Crown copyright and database rights 2023
 Ordnance Survey 0100040692

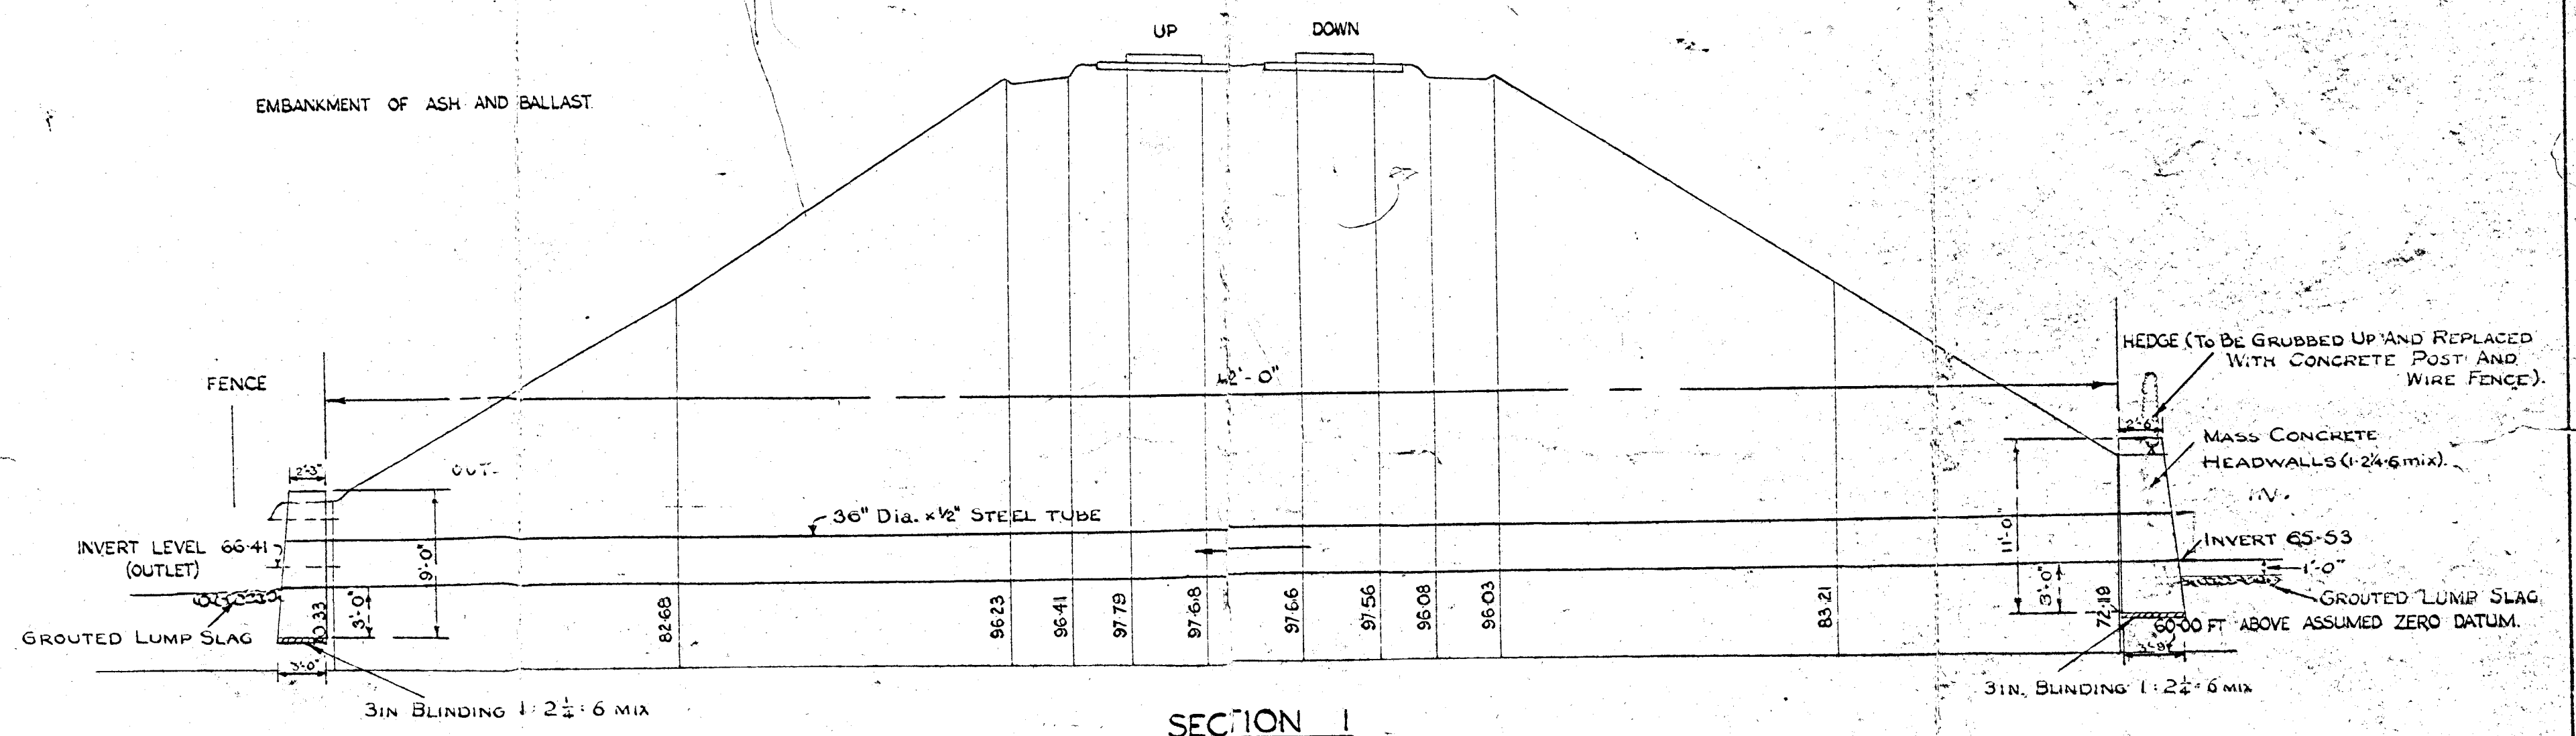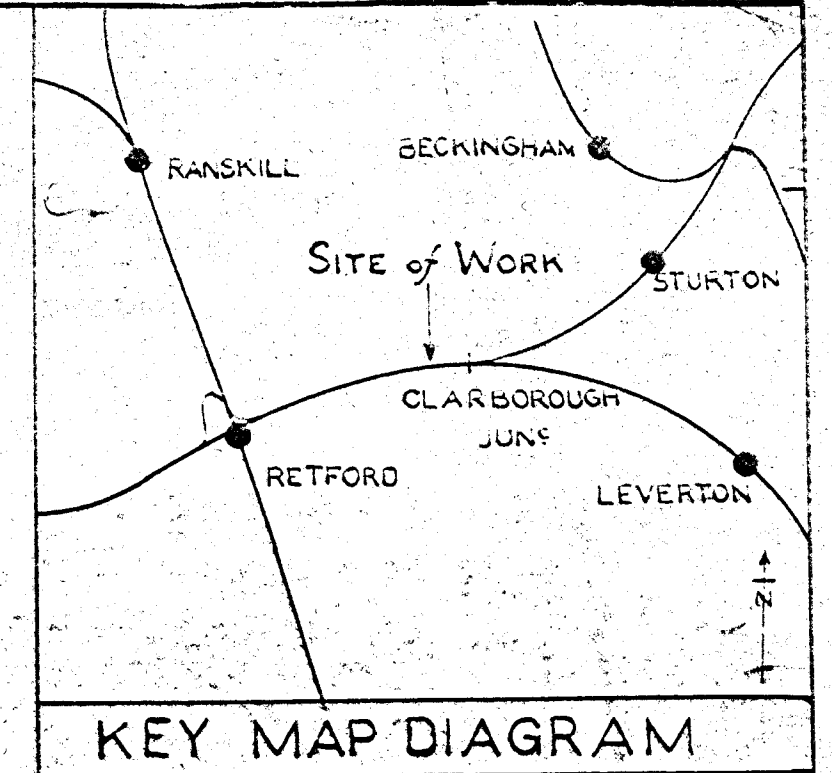


New Invert Level
65.03

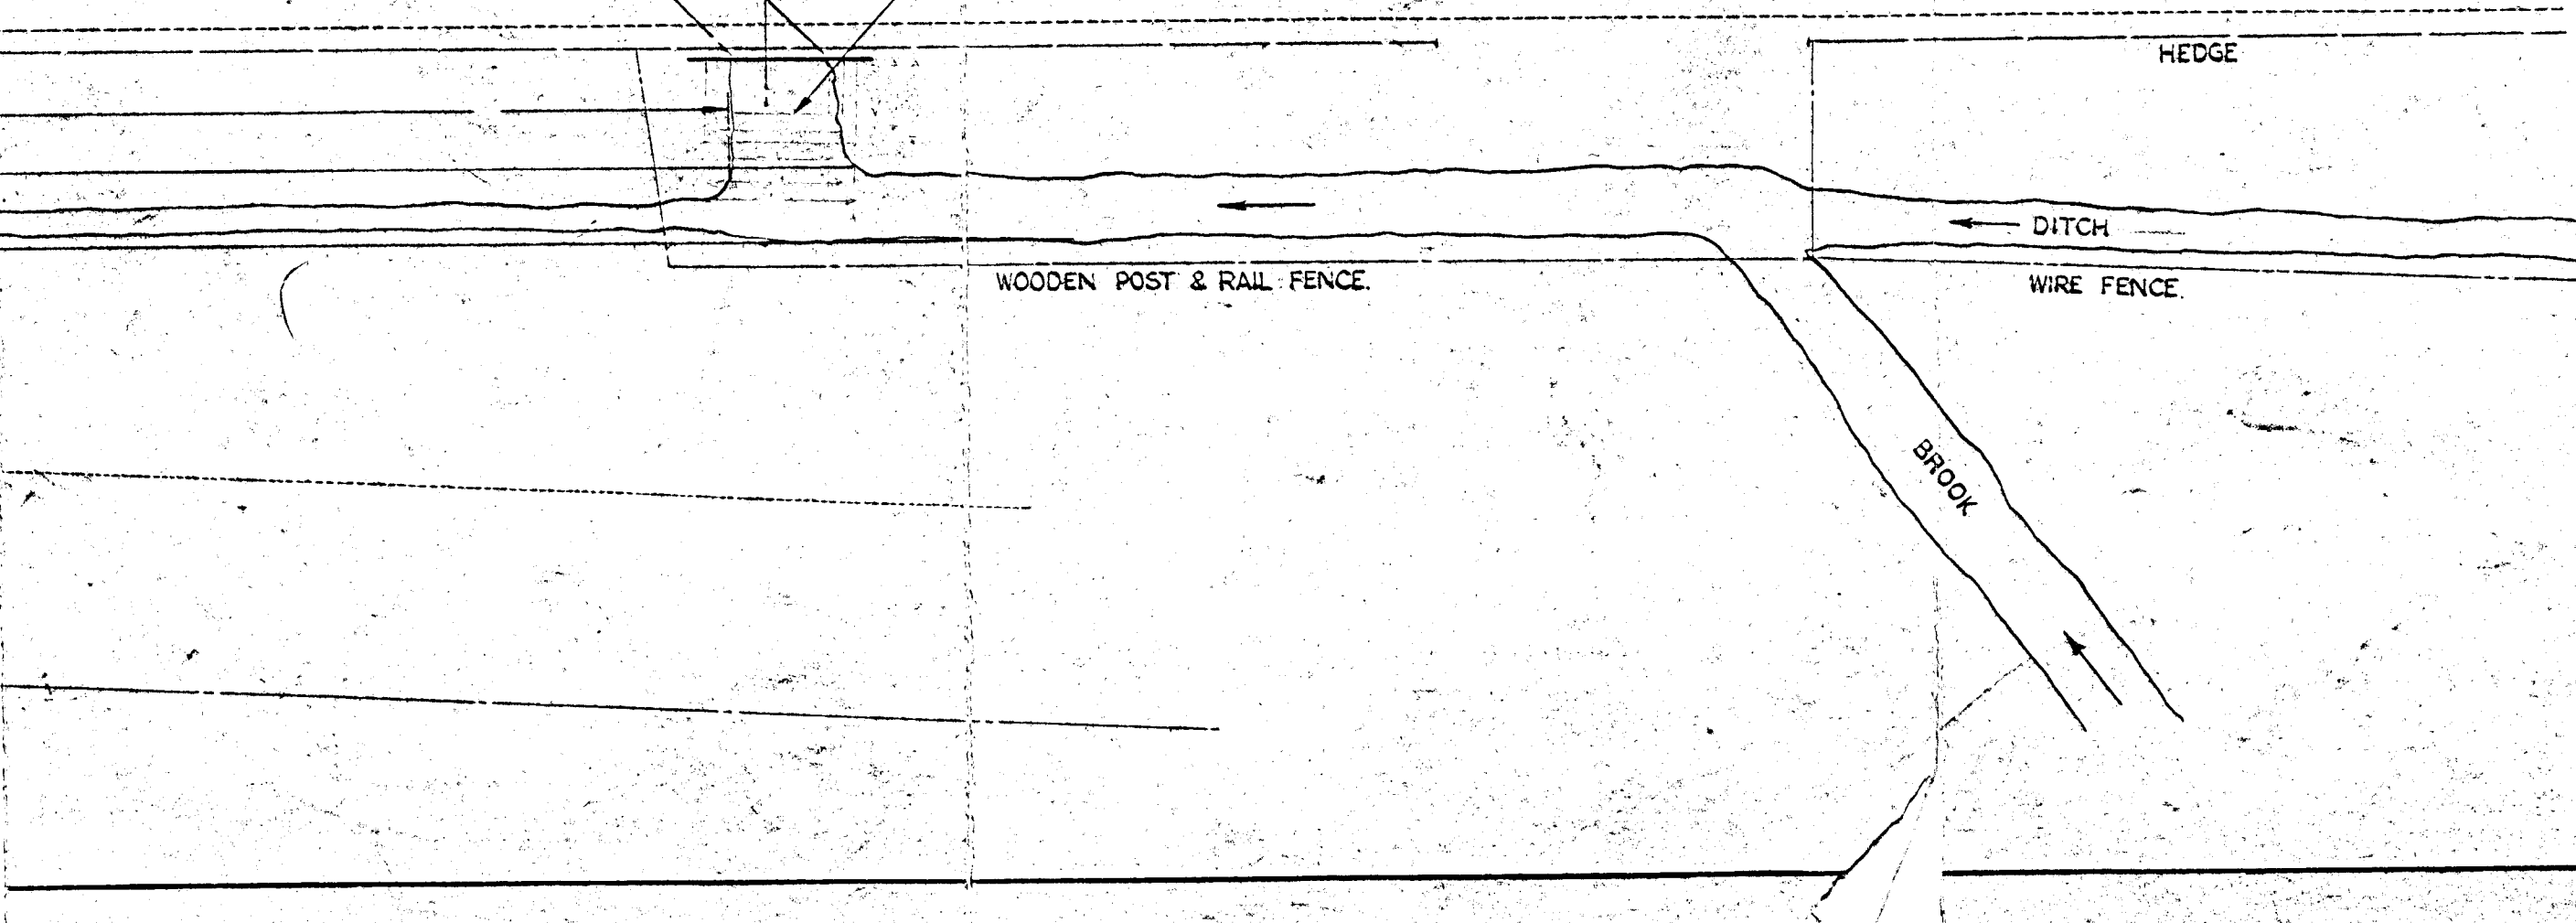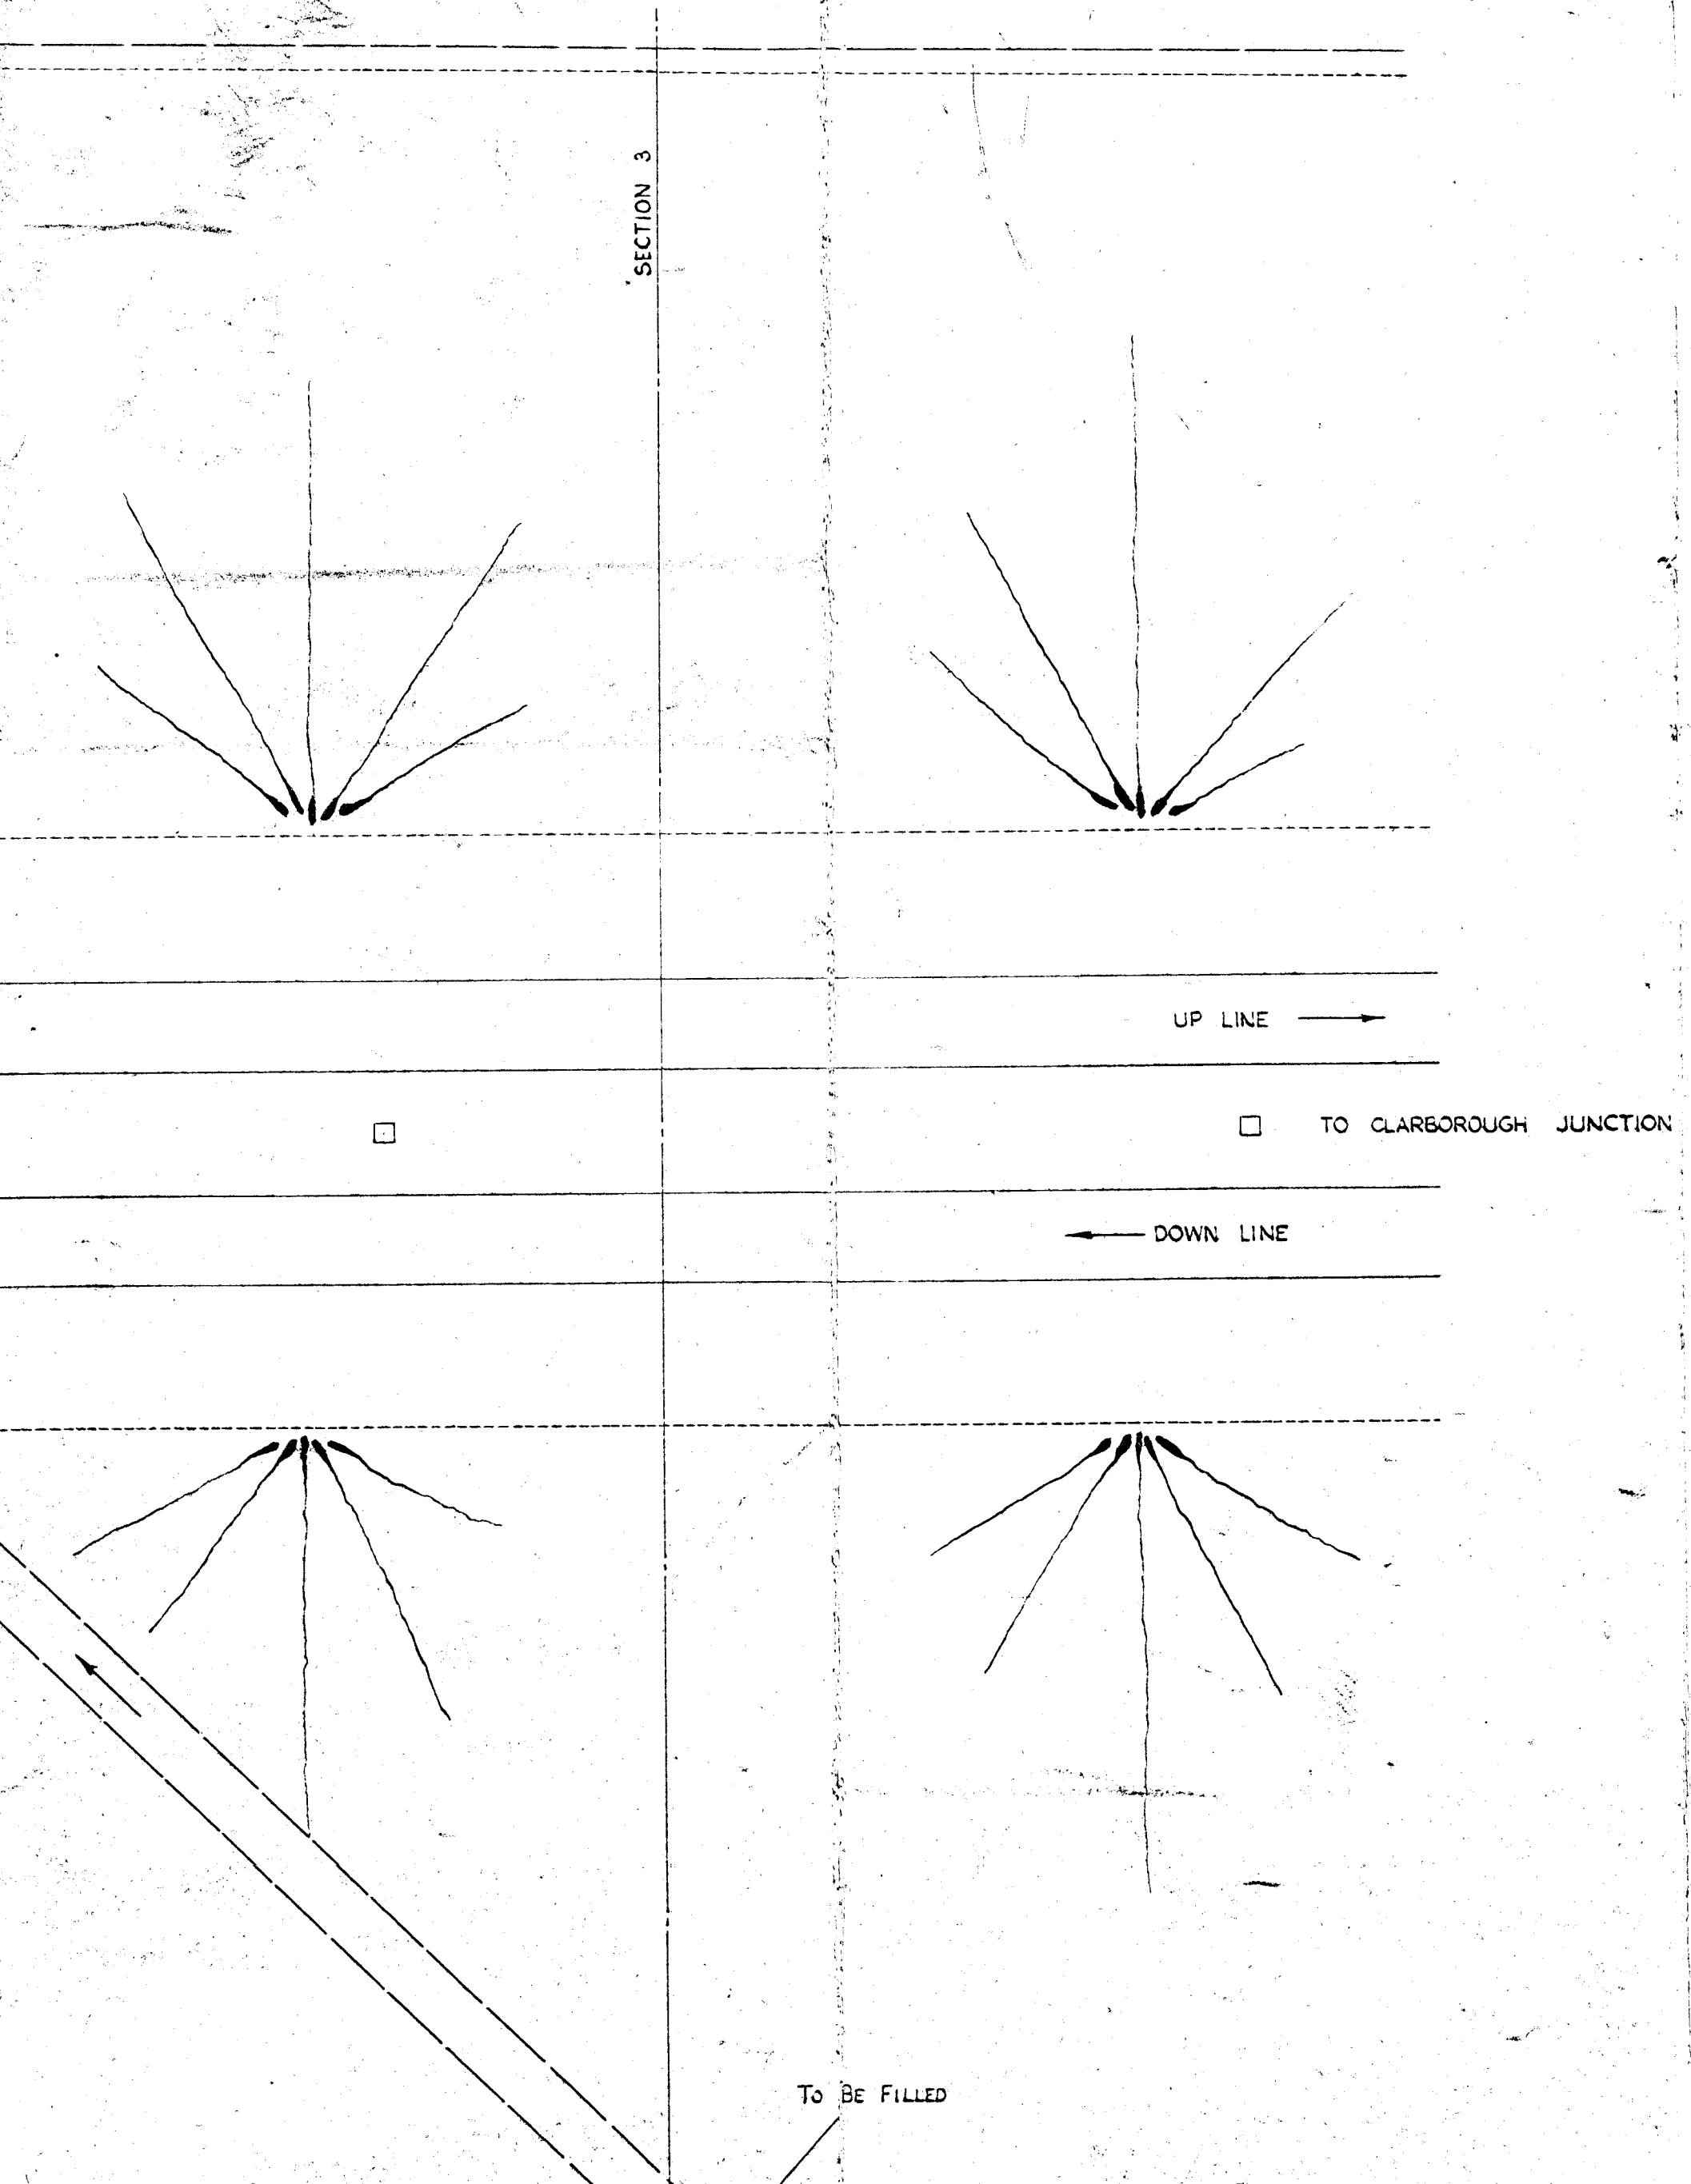
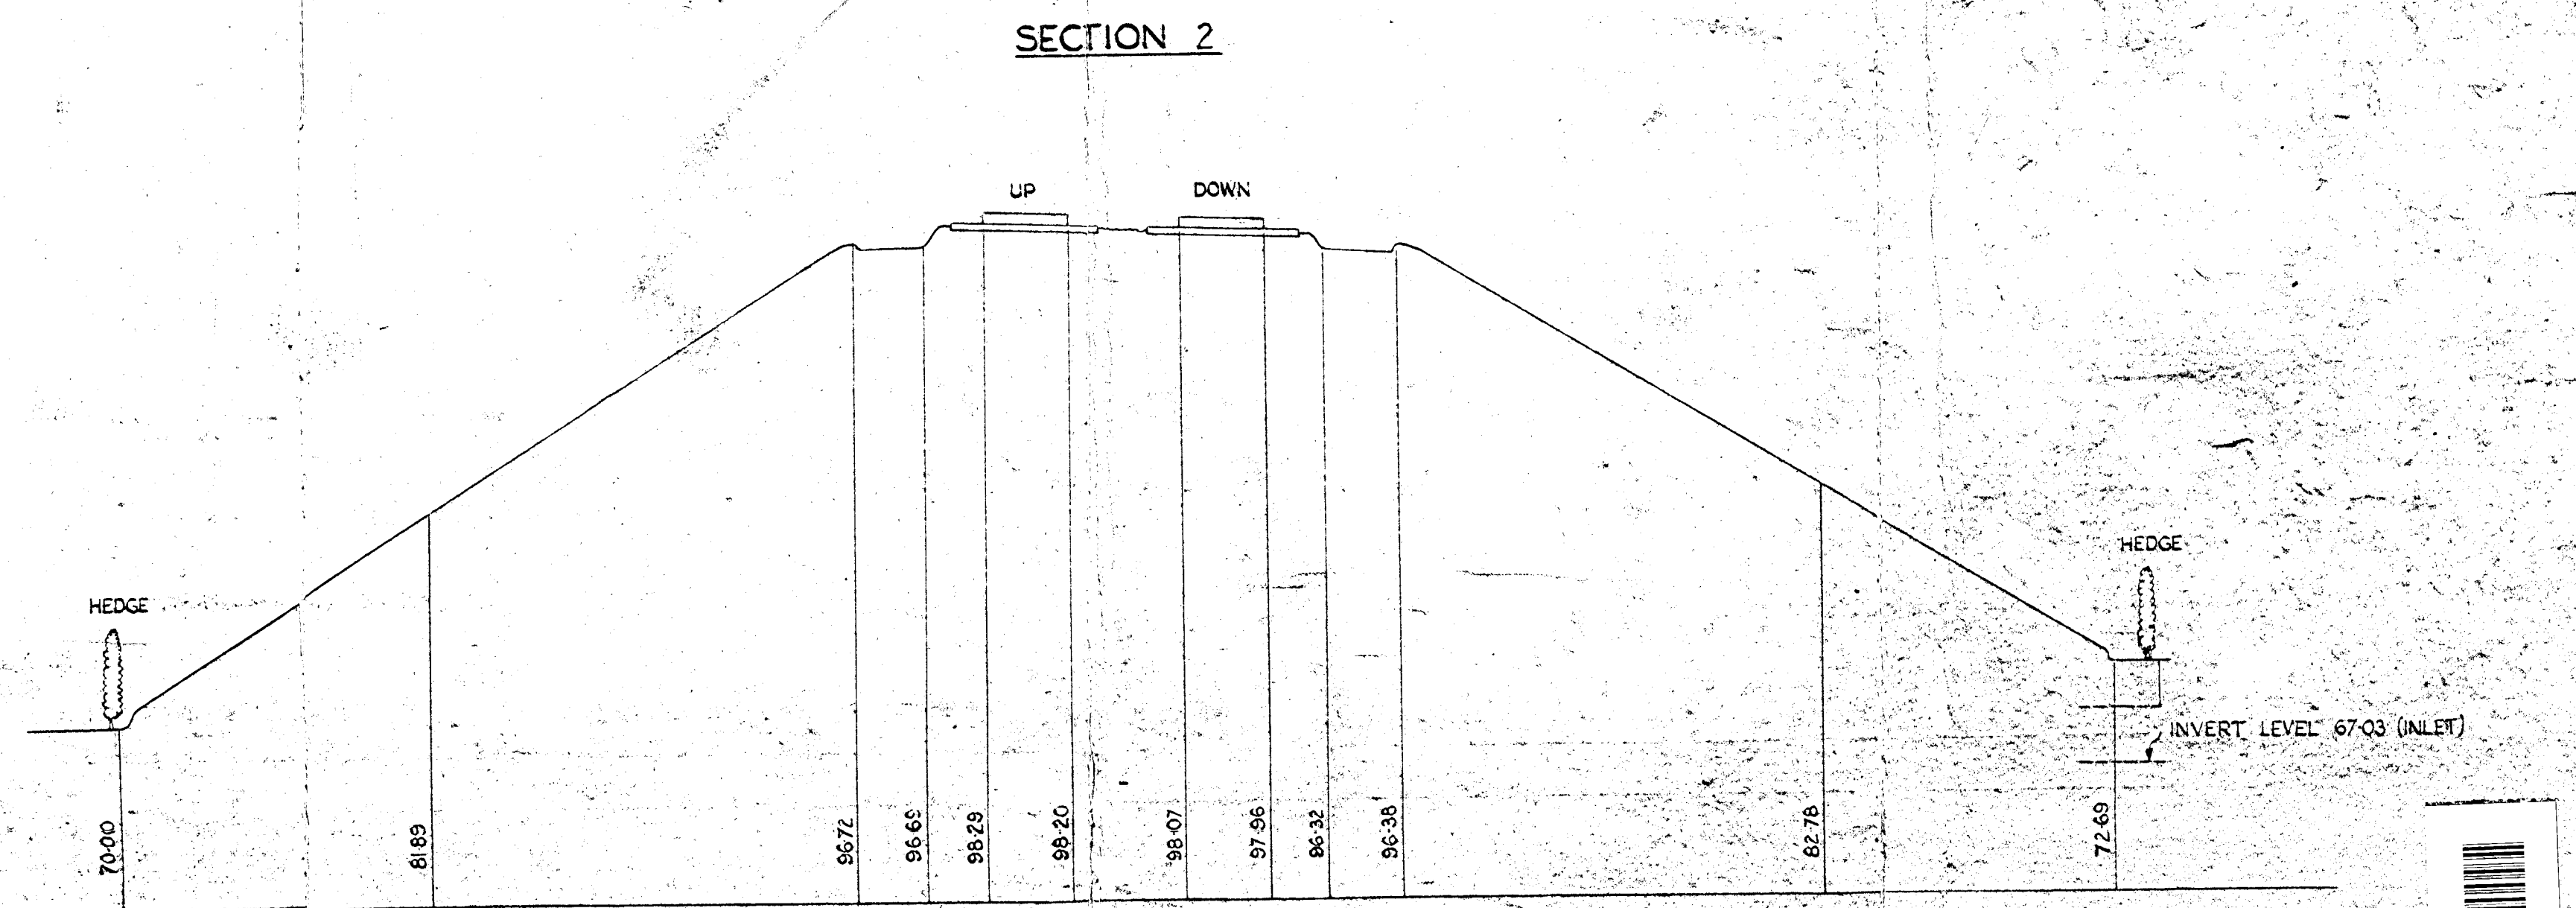
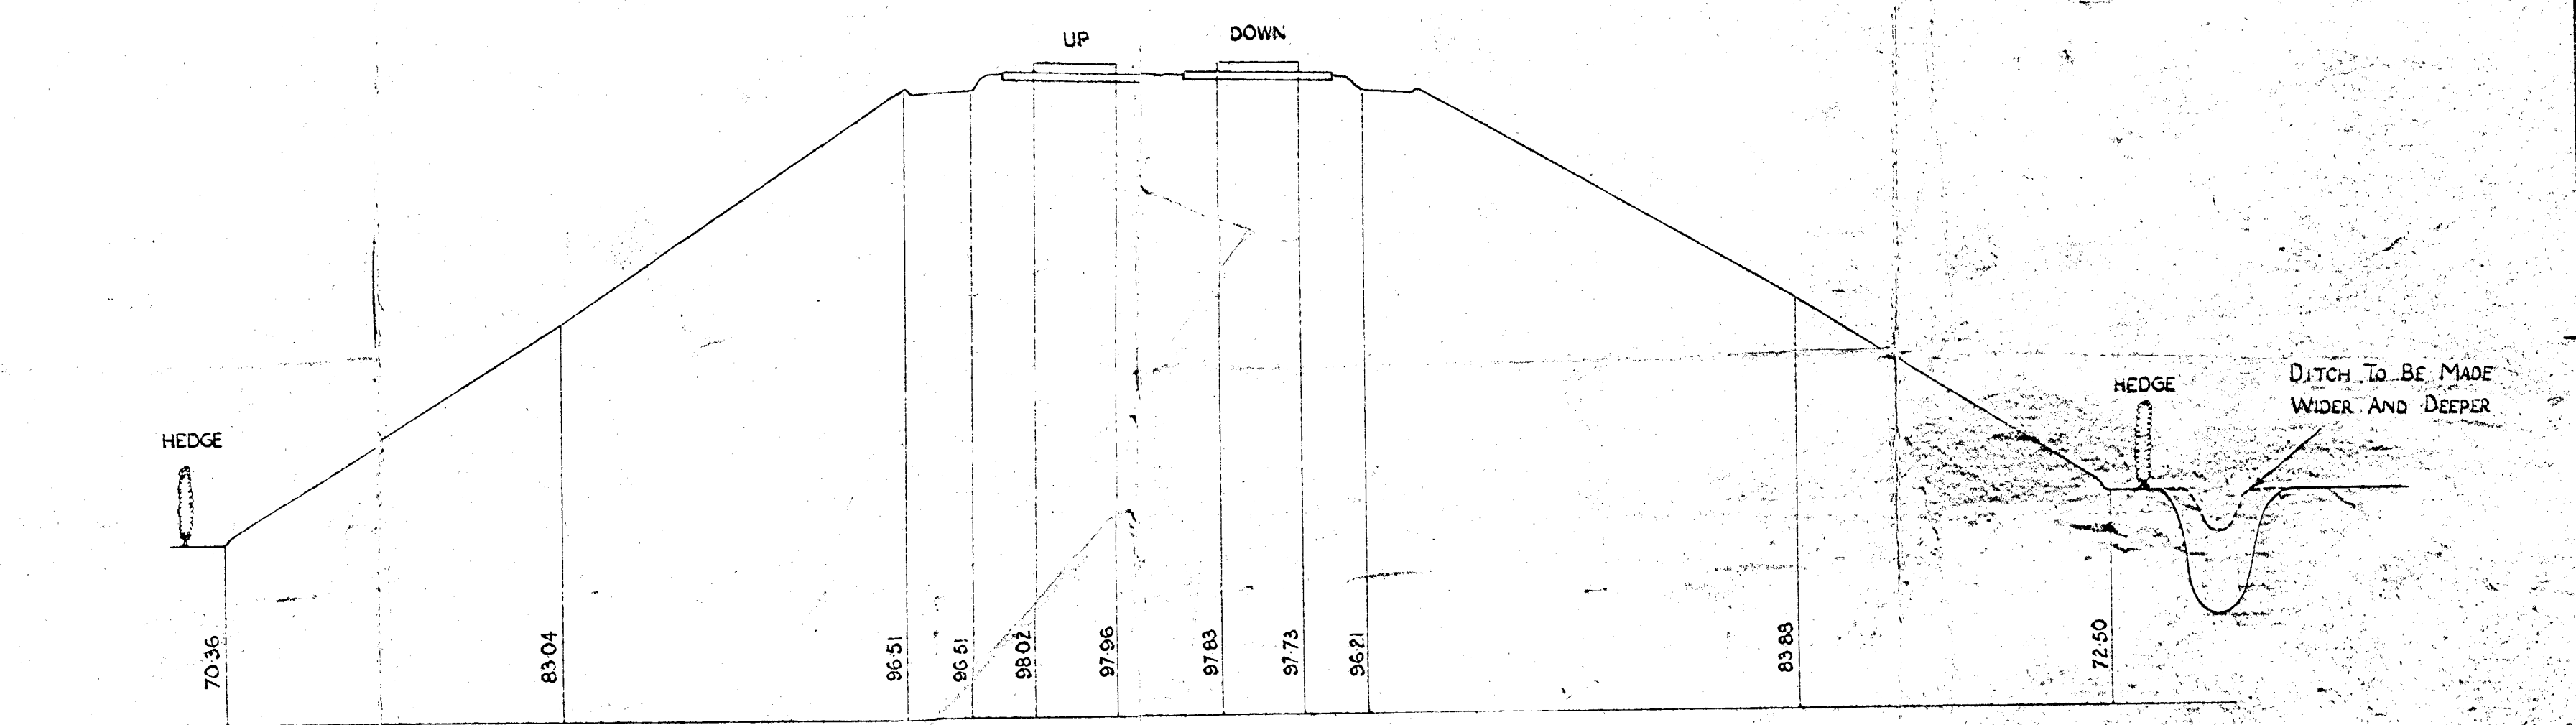


SCALE : HORIZONTAL 1/4" = 1 FT.
VERTICAL 1/8" = 1 FT.

B.M. TAKEN ON TOP OF 2 MP - ASSUMED VALUE 10000 FT.
(A.O.D. NEWLYN 74.80 FT.)

B.T.C. BRITISH RAILWAYS CHIEF CIVIL ENGINEER'S DEPT.		EASTERN REGION KING'S CROSS STATION	
REVISED	BETWEEN RETFORD AND CLARBOROUGH JUNC.		
CULVERT AT 66M-20 CHS			
PROPOSED REPLACEMENT BY			
THRUST BORE			
D.E. CORRES. CCE	APPROVED	SCALES	
ME 35573		1/4" = 1 FT.	
J.C.F.	J.C.F.	DE'S 59 LDR 122/1	
P.L.	W.B.E.	No. 22	
SHEET 1 OF 1	CHIEF CIVIL ENGINEER	CCE'S 59 LME 96	
		No.	

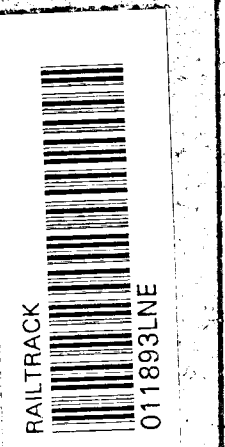

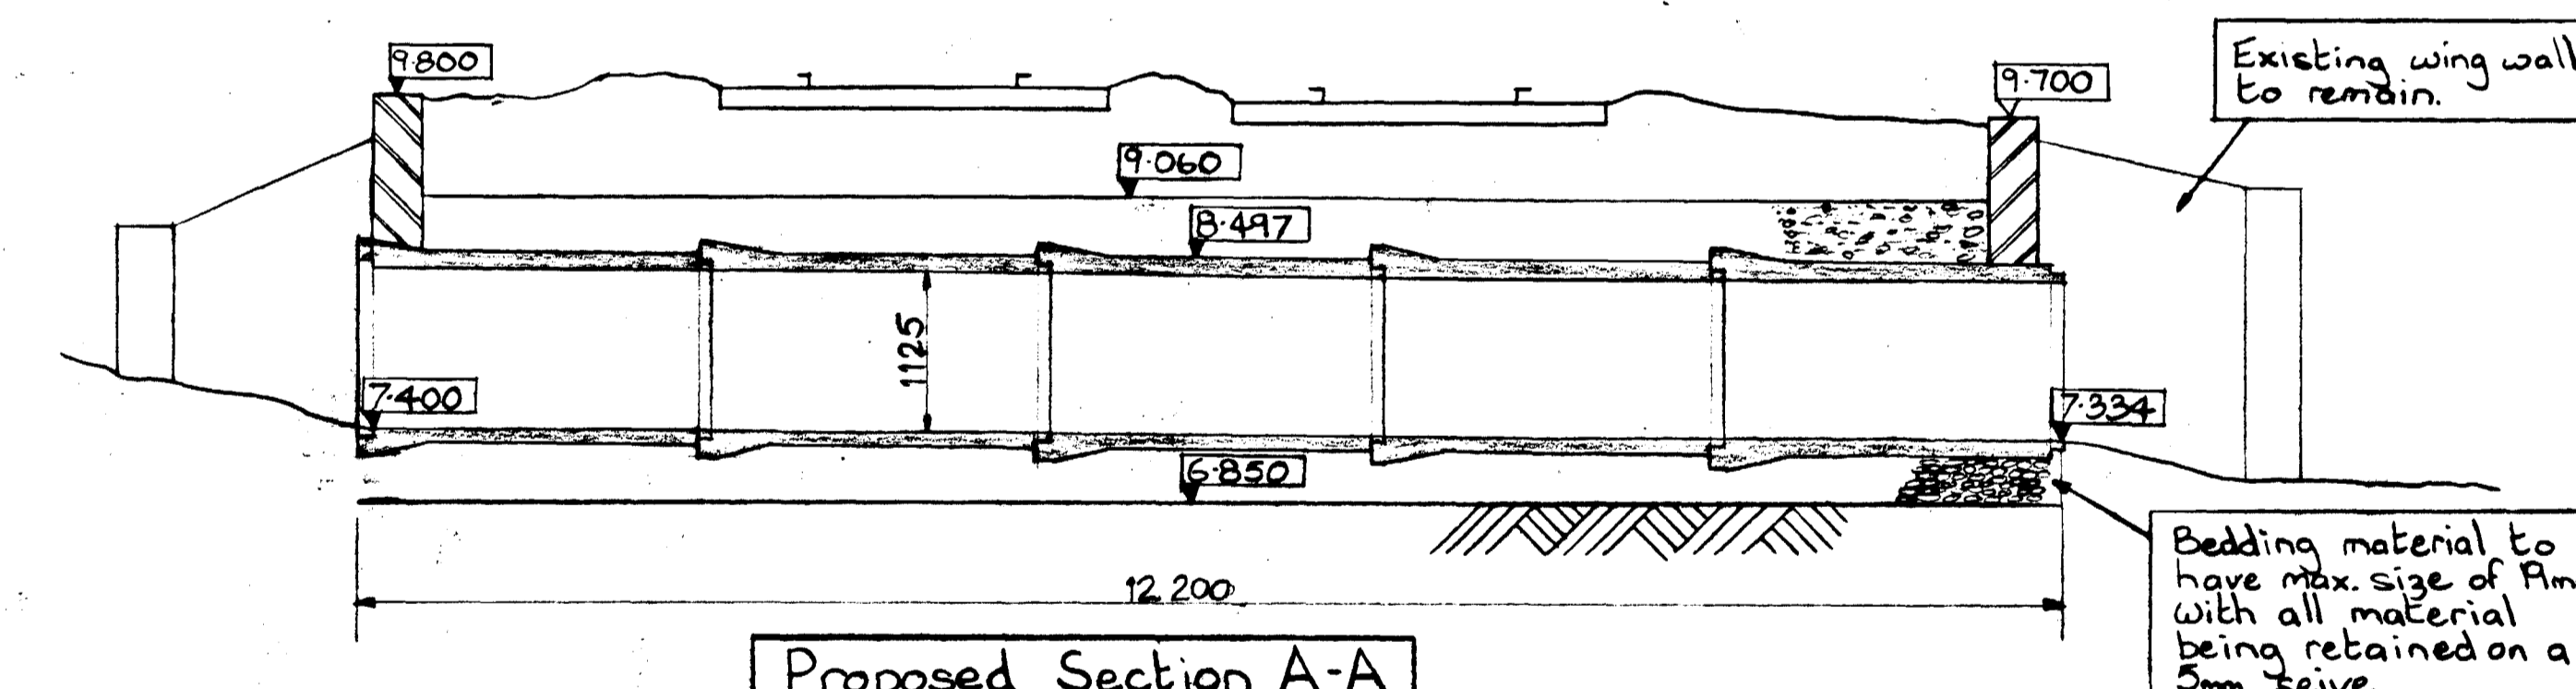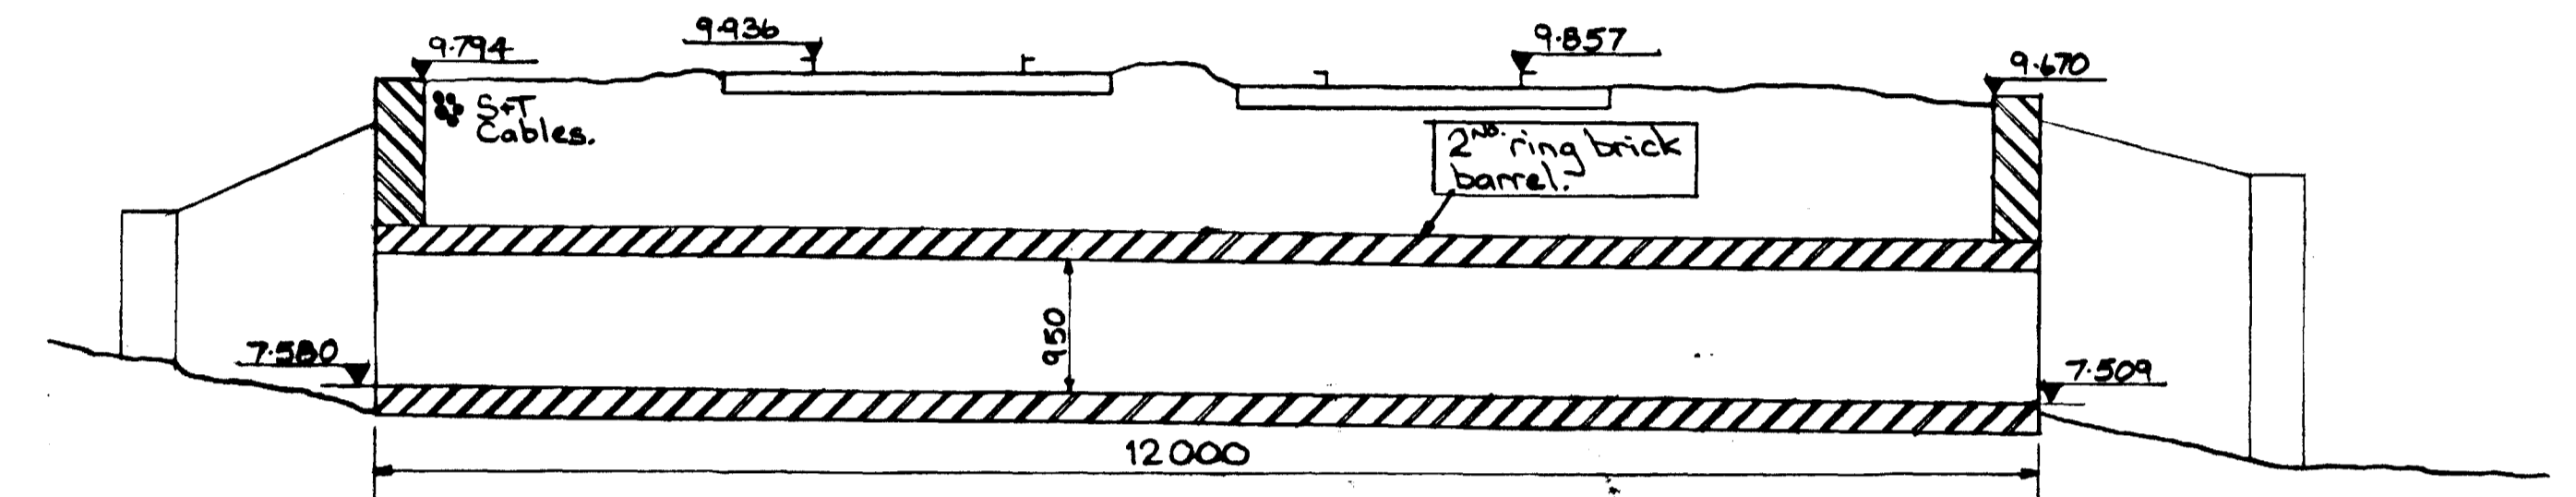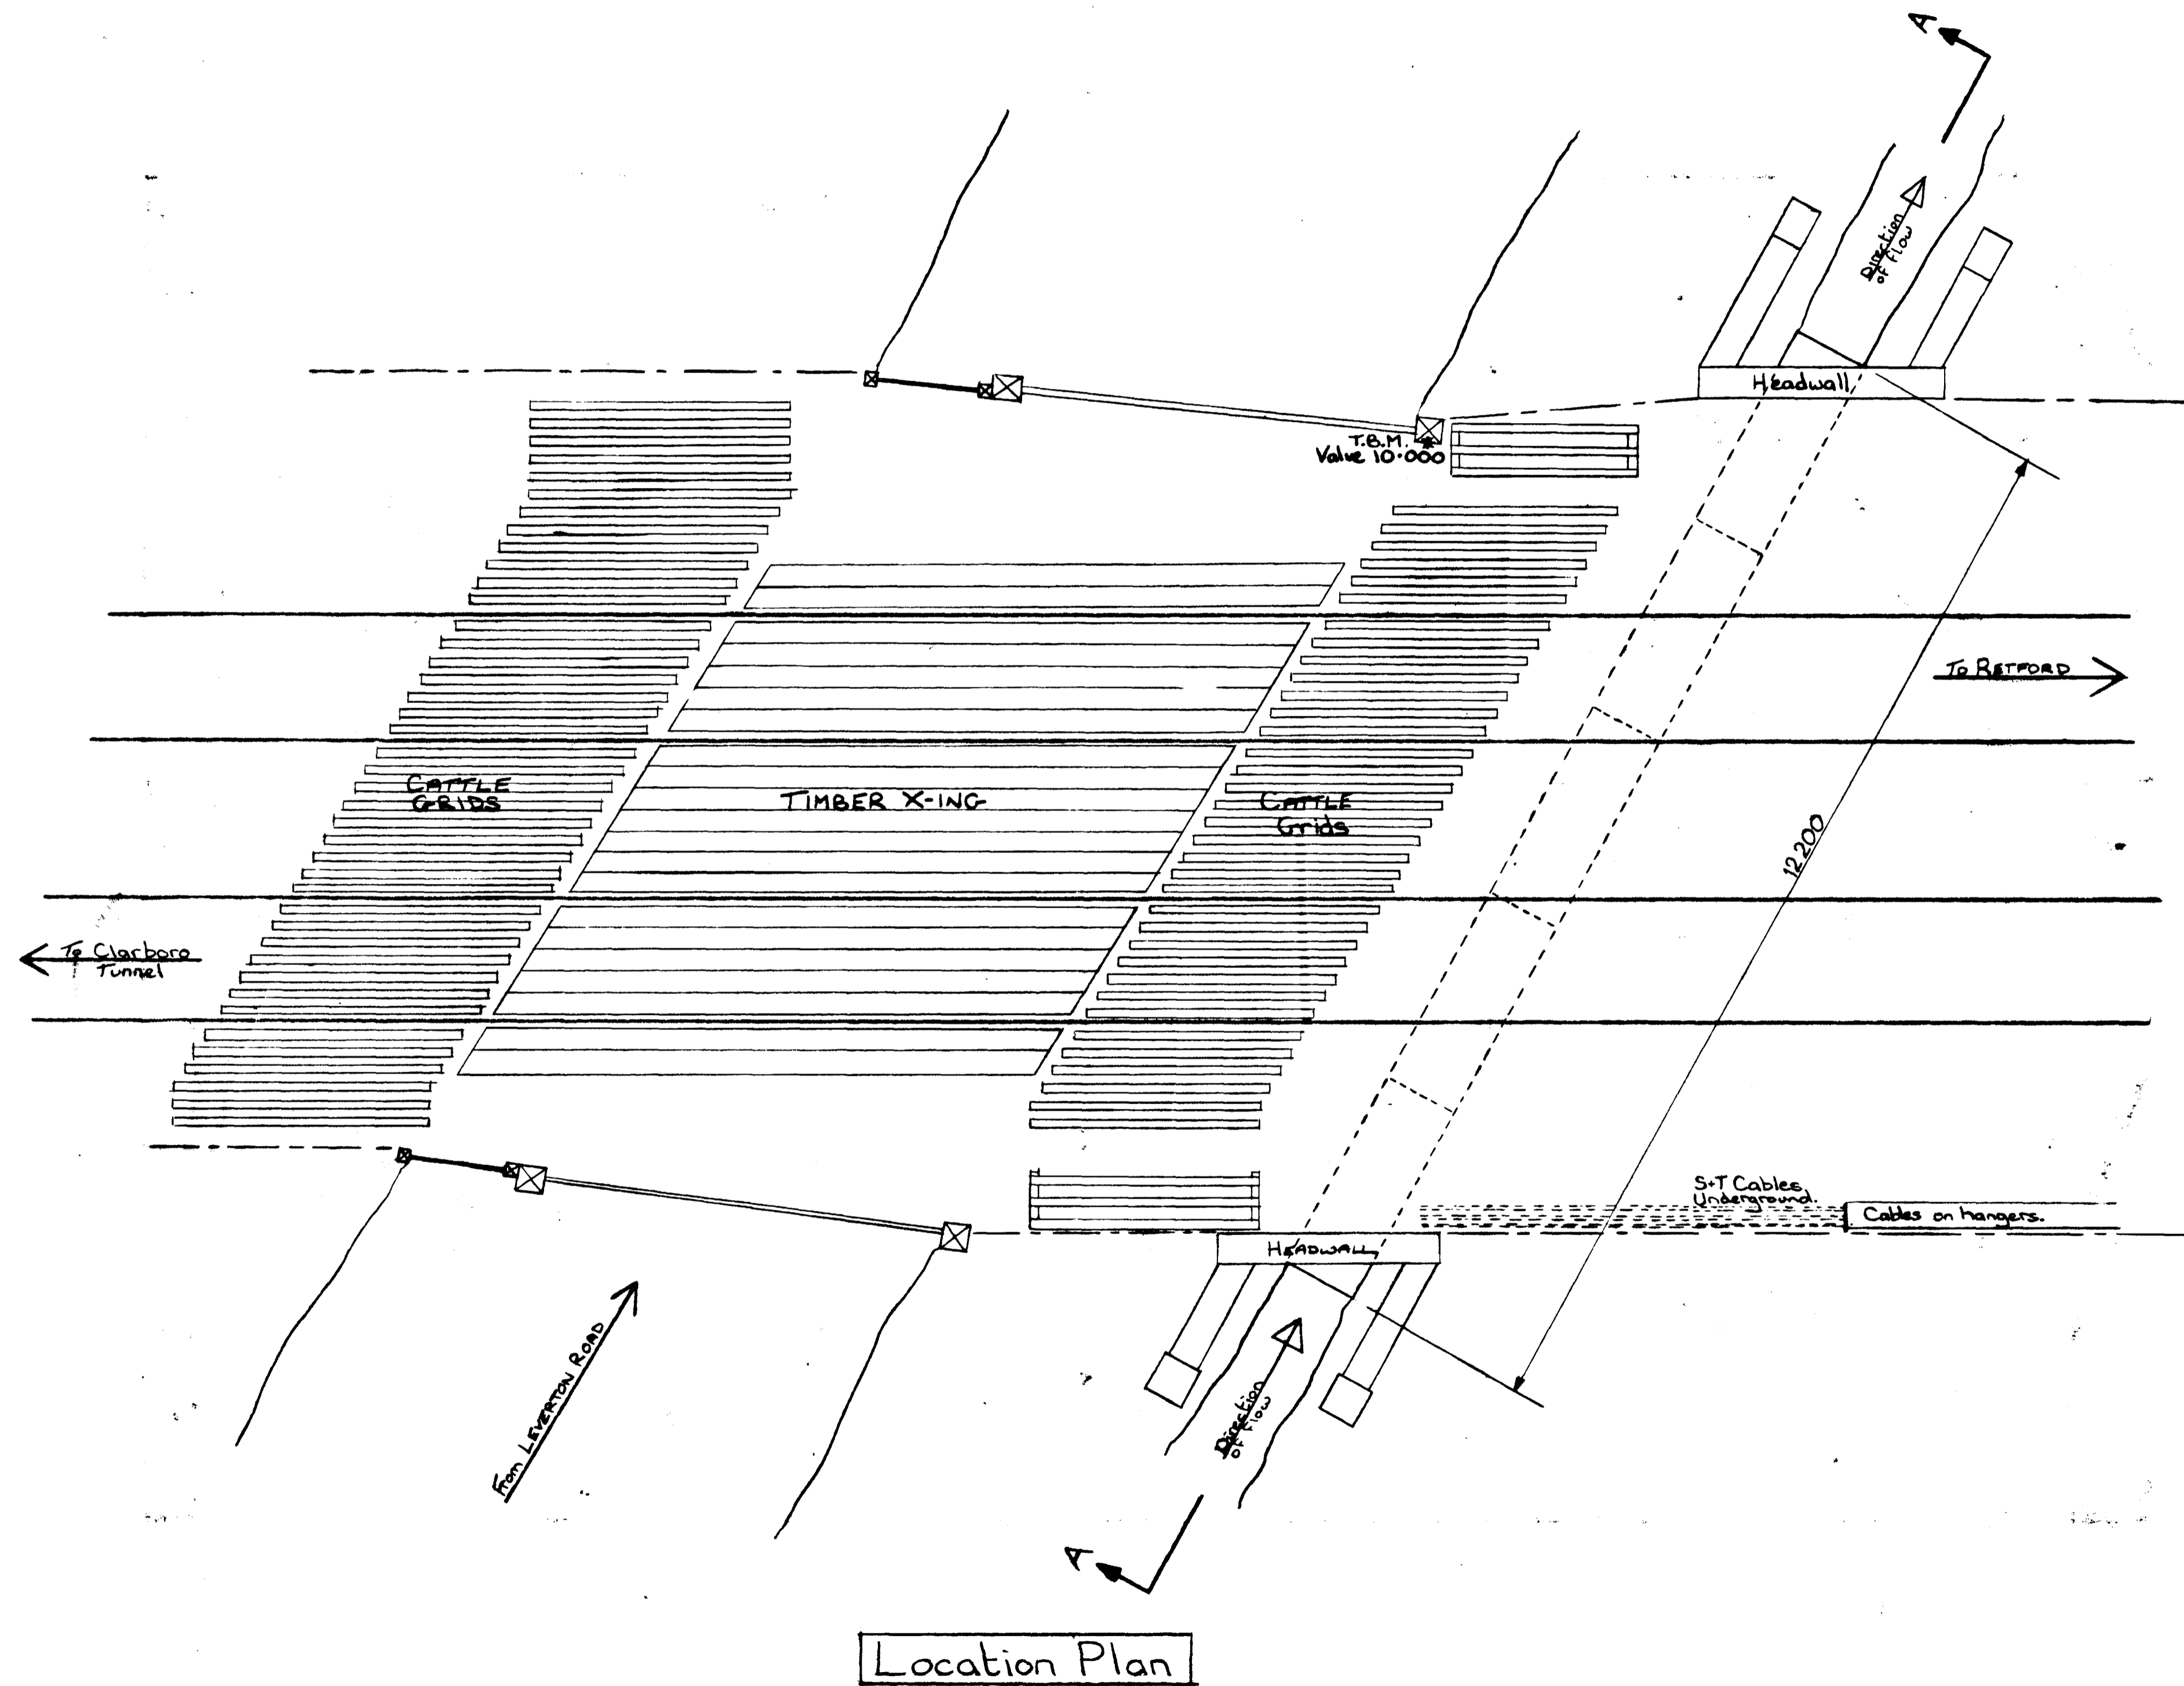


- NOTES**
- Existing culvert to be renewed using 5" 1125 diam x 2440 lg. spun concrete pipes from A.R.C. Ltd.
 - Pipe sections to be sealed with rolling ring gaskets.
 - Cover material to be well compacted hardcore.
 - Headwalls to be rebuilt in brick post reconstruction. Temporary retention of fill material is necessary.

Letter	Date	Description of revisions	By
British Railways Board Area Civil Engineer British Rail Eastern Sheaf House Leadmill Road Sheffield S1 2BQ Telephone 0742-720002			
AB	AB		
Re			
7-2-89			Area Civil Engineer
RAT-HOLE CULVERT AT 68m 19ch, RETFORD To Gainsborough Line.			
Scale	1:50		
File Numbers			
Drawing Number	89:SD:13		



Date of issue	16.12.93
Checked	T.L.
Approved	[Signature]

TA 238 106

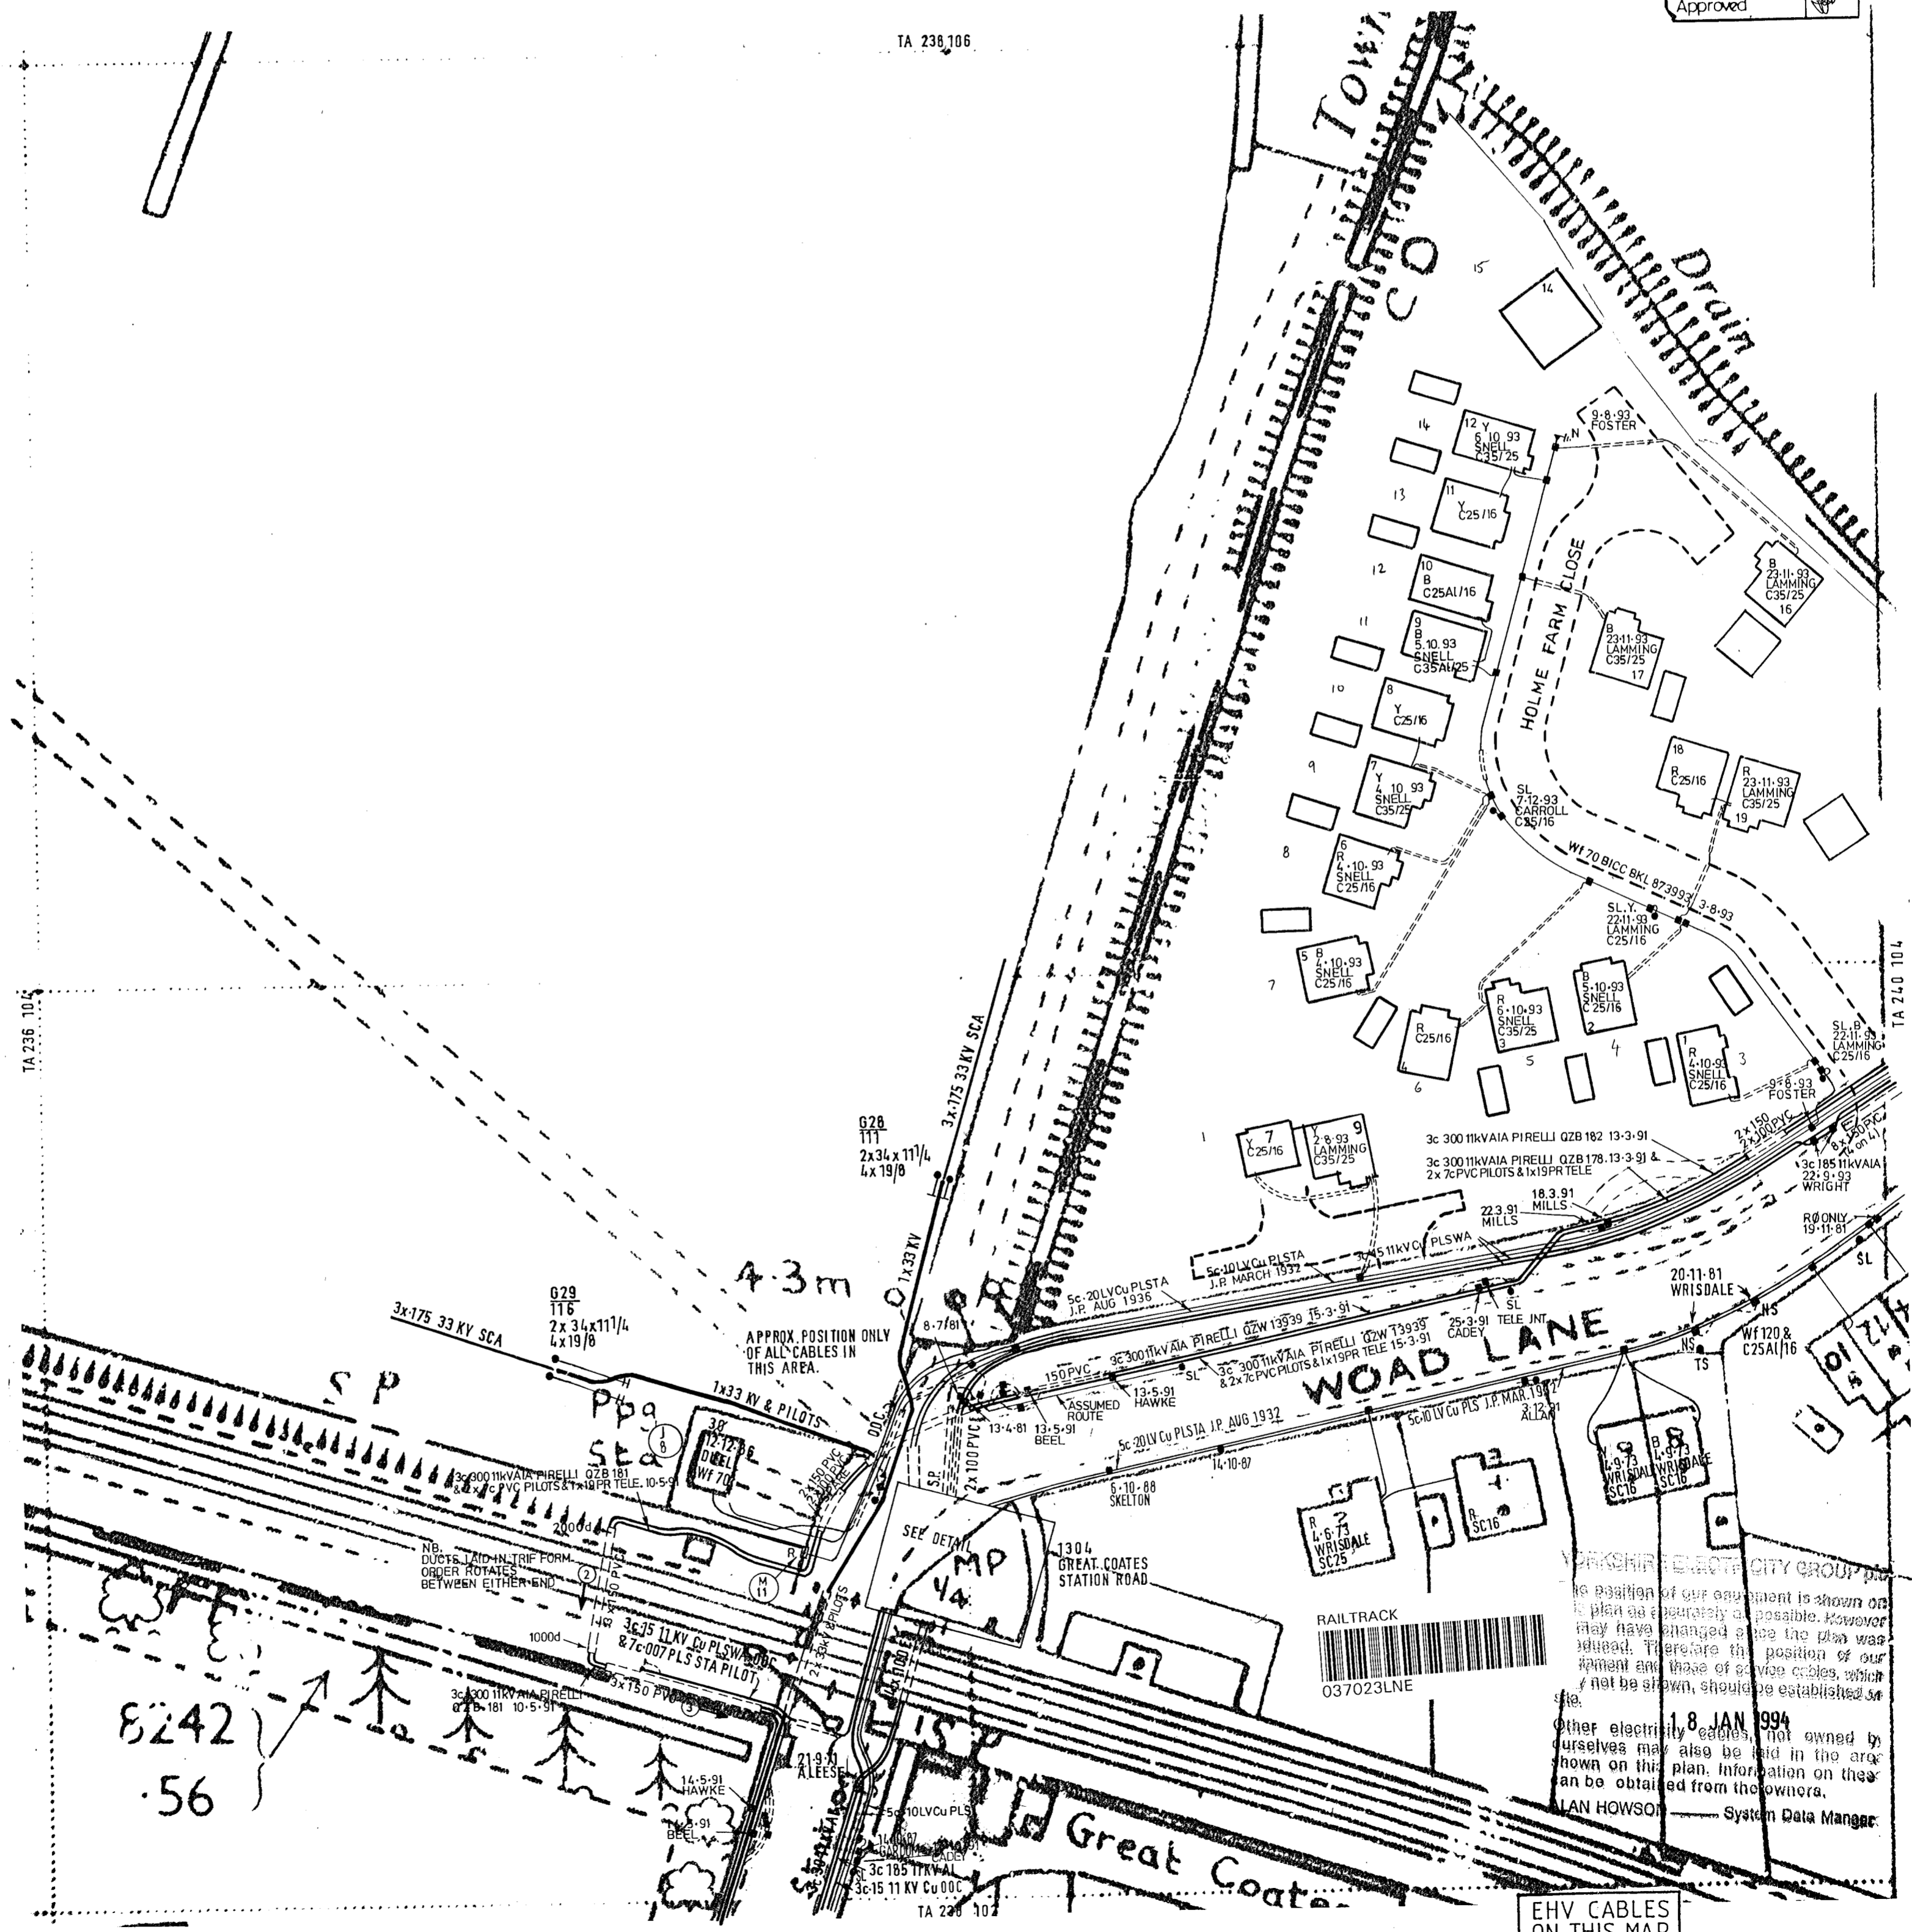

8242
56

YORKSHIRE ELECTRICITY GROUP
 The position of our equipment is shown on this plan as far as possible. However, it may have changed since the plan was issued. Therefore the position of our equipment and those of service cables, which are not shown, should be established on site.
 18 JAN 1994
 Other electricity cables, not owned by ourselves may also be laid in the area shown on this plan. Information on their location can be obtained from the owners.
 LAN HOWSON
 System Data Manager

EHV CABLES ON THIS MAP